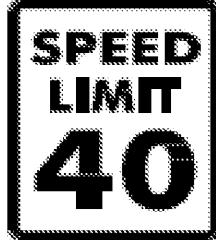


DIRECTION	MILEPOINT	LOCATION CODE (SHEET 2)	SIGN CODE	WIDTH (IN)	HEIGHT (IN)	SHEETING REMARKS	SIGN LEGEND	NEW SIGNS		EXISTING SIGNS				EXIST POST		NUMBER OF NEW POSTS	SQUARE STEEL (IN)			TUBULAR STEEL Ø (IN)					SIGN FRAME REQUIRED	REMARKS	SIGN DETAIL			
								"A"	"B"	RETAIN	SALVAGE FROM	SALVAGE TO	REMOVE	RETAIN	REMOVE		1.75	2.00	2.50	FOUNDATION	3.00	3.50	4.00	5.00			DETAIL IN SHS	DETAIL ON SHEET NUMBER	DETAIL ON STD SHEET NUMBER	
																	(LB / FT)				(LB / FT)									
																	1.88	2.42	3.35		7.60	9.00	10.80	14.60						
BARRE TOWN VT 14							FY-FLUORESCENT YELLOW FYG-FLUORESCENT YELLOW GREEN															"SHS"-STANDARD HIGHWAY SIGNS								
SB	1.450	G	VR-017	24	24		LEGAL LOAD LIMIT 24000 LBS			1				X									TH-59, SNOWBRIDGE RD (SOUTH)							
SB	1.445	H	R1-1	24	24		STOP			1				X									TH-59, SNOWBRIDGE RD (SOUTH)							
SB	1.440	F	R2-1	24	30							1		X																
		F	R2-1	24	30			5.00								1		X							X					
SB	1.000	F	R2-1	24	30							1		X																
		F	R2-1	24	30			5.00								1		X							X					
SB	0.540	F	R2-1	24	30							1		X																
		F	R2-1	24	30			5.00								1		X							X					
SB	0.050	F	W11-10	30	30		TRUCK ENTERING SYMBOL			1				X									ASSEMBLY HAS SOLAR FLASHING BEACON ATTACHED							
		F	S4-4M	24	10		WHEN FLASHING (YELLOW BKGRND)			1																				
SIGN SUMMARY SHEET							SHEET TOTALS	15.00	0.00	4	0	0	3	0	0	3	45								PROJECT NAME: Hartford-East Montpelier VT14					
								SF	SF	EA	EA	EA	EA	EA	EA	EA	FT								PROJECT NUMBER: STPG SIGN(21)					
							VERMONT AGENCY OF TRANSPORTATION																				FILE NAME: Barre Town.xls			
							TOWN TOTALS						583.8	0.0	48.0	9.0	9.0	115	0.0	0.0	89	1335.0								PLOT DATE: 6/18/2009
																							DRAWN BY: T. Guazzoni							
																							CHECKED BY: S. Menard							
																							SHEET 135 OF 162							