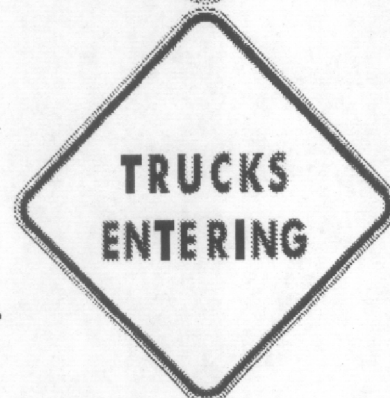
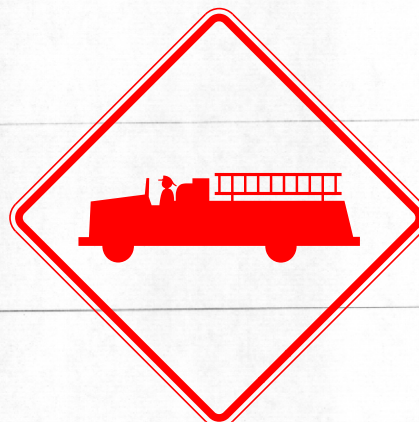
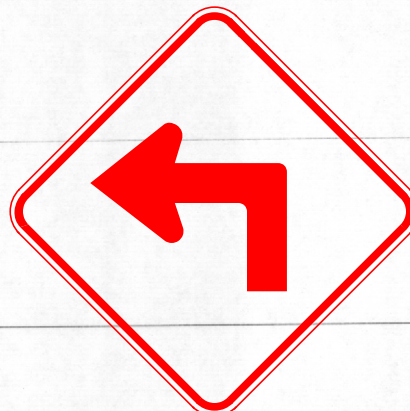


DIRECTION	MILEPOINT	LOCATION CODE (SHEET 2)	SIGN CODE	WIDTH (IN)	HEIGHT (IN)	SHEETING REMARKS	SIGN LEGEND	NEW SIGNS		EXISTING SIGNS			EXIST POST		NUMBER OF NEW POSTS	SQUARE STEEL (IN)			TUBULAR STEEL Ø (IN)				SIGN FRAME REQUIRED	REMARKS	SIGN DETAIL				
								"A"	"B"	RETAIN	SALVAGE FROM	SALVAGE TO	REMOVE	RETAIN		REMOVE	1.75	2.00	2.50	FOUNDATION	3.00	3.50			4.00	5.00	DETAIL IN SHS	DETAIL ON SHEET NUMBER	DETAIL ON STD SHEET NUMBER
																	(LB / FT)				(LB / FT)								
																	1.88	2.42	3.35		7.60	9.00			10.80	14.60			
WESTON VT 100							FY-FLUORESCENT YELLOW FYG-FLUORESCENT YELLOW GREEN														"SHS"-STANDARD HIGHWAY SIGNS								
SB	0.145	F	VW-060	30	30	HIDDEN DRIVES							1		X														
SB	0.100	F	VW-202	30	30									1		X													
		F	VW-060	30	30				6.25								2		X					INSTALL HIDDEN DRIVES ABOVE TRUCKS ENTERING SIGN			E-154		
		F	VW-202	30	30				6.25																	E-154			
NB	3.216	A	VW-054	30	30			6.25									I						THIS NEW SIGN WAS ADDED TO THE PROJECT PER REQUEST OF M. MILLER, TRAFFIC OPS.						
		C	VR-052	12	18																			PAID ON SHEET #176. INSTALLED UNDER SIGN ABOVE					
NB	3.384	A	WII-8	30	30				I							X								SIGN RETAINED					
SB	3.298	F	VW-054	30	30					6.25															THIS SIGN WAS ADDED ON 4/26/11. SEE NOTE ON SHEET #188.				
		F	WI-IL	30	30						I	I	I																
		F	WI3-I	18	18						I	I	I		X		I												
SB	3.220	G	VR-052	12	18			1.50							X								THIS NEW SIGN WAS INSTALLED ON 7/27/11 AS PER REQUEST OF M. MILLER, TRAFFIC OPS.						
SIGN SUMMARY SHEET							SHEET TOTALS	26.50 12.50	0.00	1 0	2 0	2 0	4 2	0	0	4 2	30						PROJECT NAME: Stamford-Andover VT100						
							SF	SF	EA	EA	EA	EA	EA	EA	EA	EA	FT							PROJECT NUMBER: STPG SIGN(20)					
VERMONT AGENCY OF TRANSPORTATION							TOWN TOTALS	774.4	0.0	26.0	12.0	12.0	139	0.0	0.0	140	2100.0				FILE NAME: Weston.xls	PLOT DATE: 8/6/2009							
																				PROJECT MANAGER: N. Avery	DRAWN BY: T. Guazzoni								
																				DESIGNED BY: J. Kelly	CHECKED BY: T. Guazzoni								
																				WESTON SHEET 23	SHEET 194	OF 198							