


TEMPORARY 4" WHITE LINE, PAINT
DURABLE 4" WHITE LINE (OPTION BID ITEM)
262+50 TO 264+50 SOLID LT
262+50 TO 270+90 SOLID RT
265+30 TO 274+50 SOLID LT
271+70 TO 274+50 SOLID RT

TH 79 CURVE (1)
DELTA = 21° 18' 21"
D = 114° 35' 30"
R = 50.00'
T = 9.41'
L = 18.59'
E = 0.88'
BANK = NC

TEMPORARY 4" YELLOW LINE, PAINT
DURABLE 4" YELLOW LINE (OPTION BID ITEM)
262+50 TO 264+70 SOLID LT & RT
265+10 TO 271+10 SOLID LT & RT
271+23 TO 271+30 DOUBLE SOLID RT (TH 8)
271+50 TO 274+50 SOLID LT & RT

TEMPORARY 24" STOP BAR, PAINT
DURABLE 24" STOP BAR (OPTION BID ITEM)
271+31 TO 271+61 RT (TH 8)
TEMPORARY LETTER OR SYMBOL, PAINT
DURABLE LETTER OR SYMBOL (OPTION BID ITEM)
271+34 RT - "STOP" (TH 8)

RELOCATE MAILBOX, SINGLE SUPPORT
272+85 LT
REMOVING SIGNS
AS SHOWN - 3
ERECTING SALVAGED SIGNS
AS SHOWN - 3

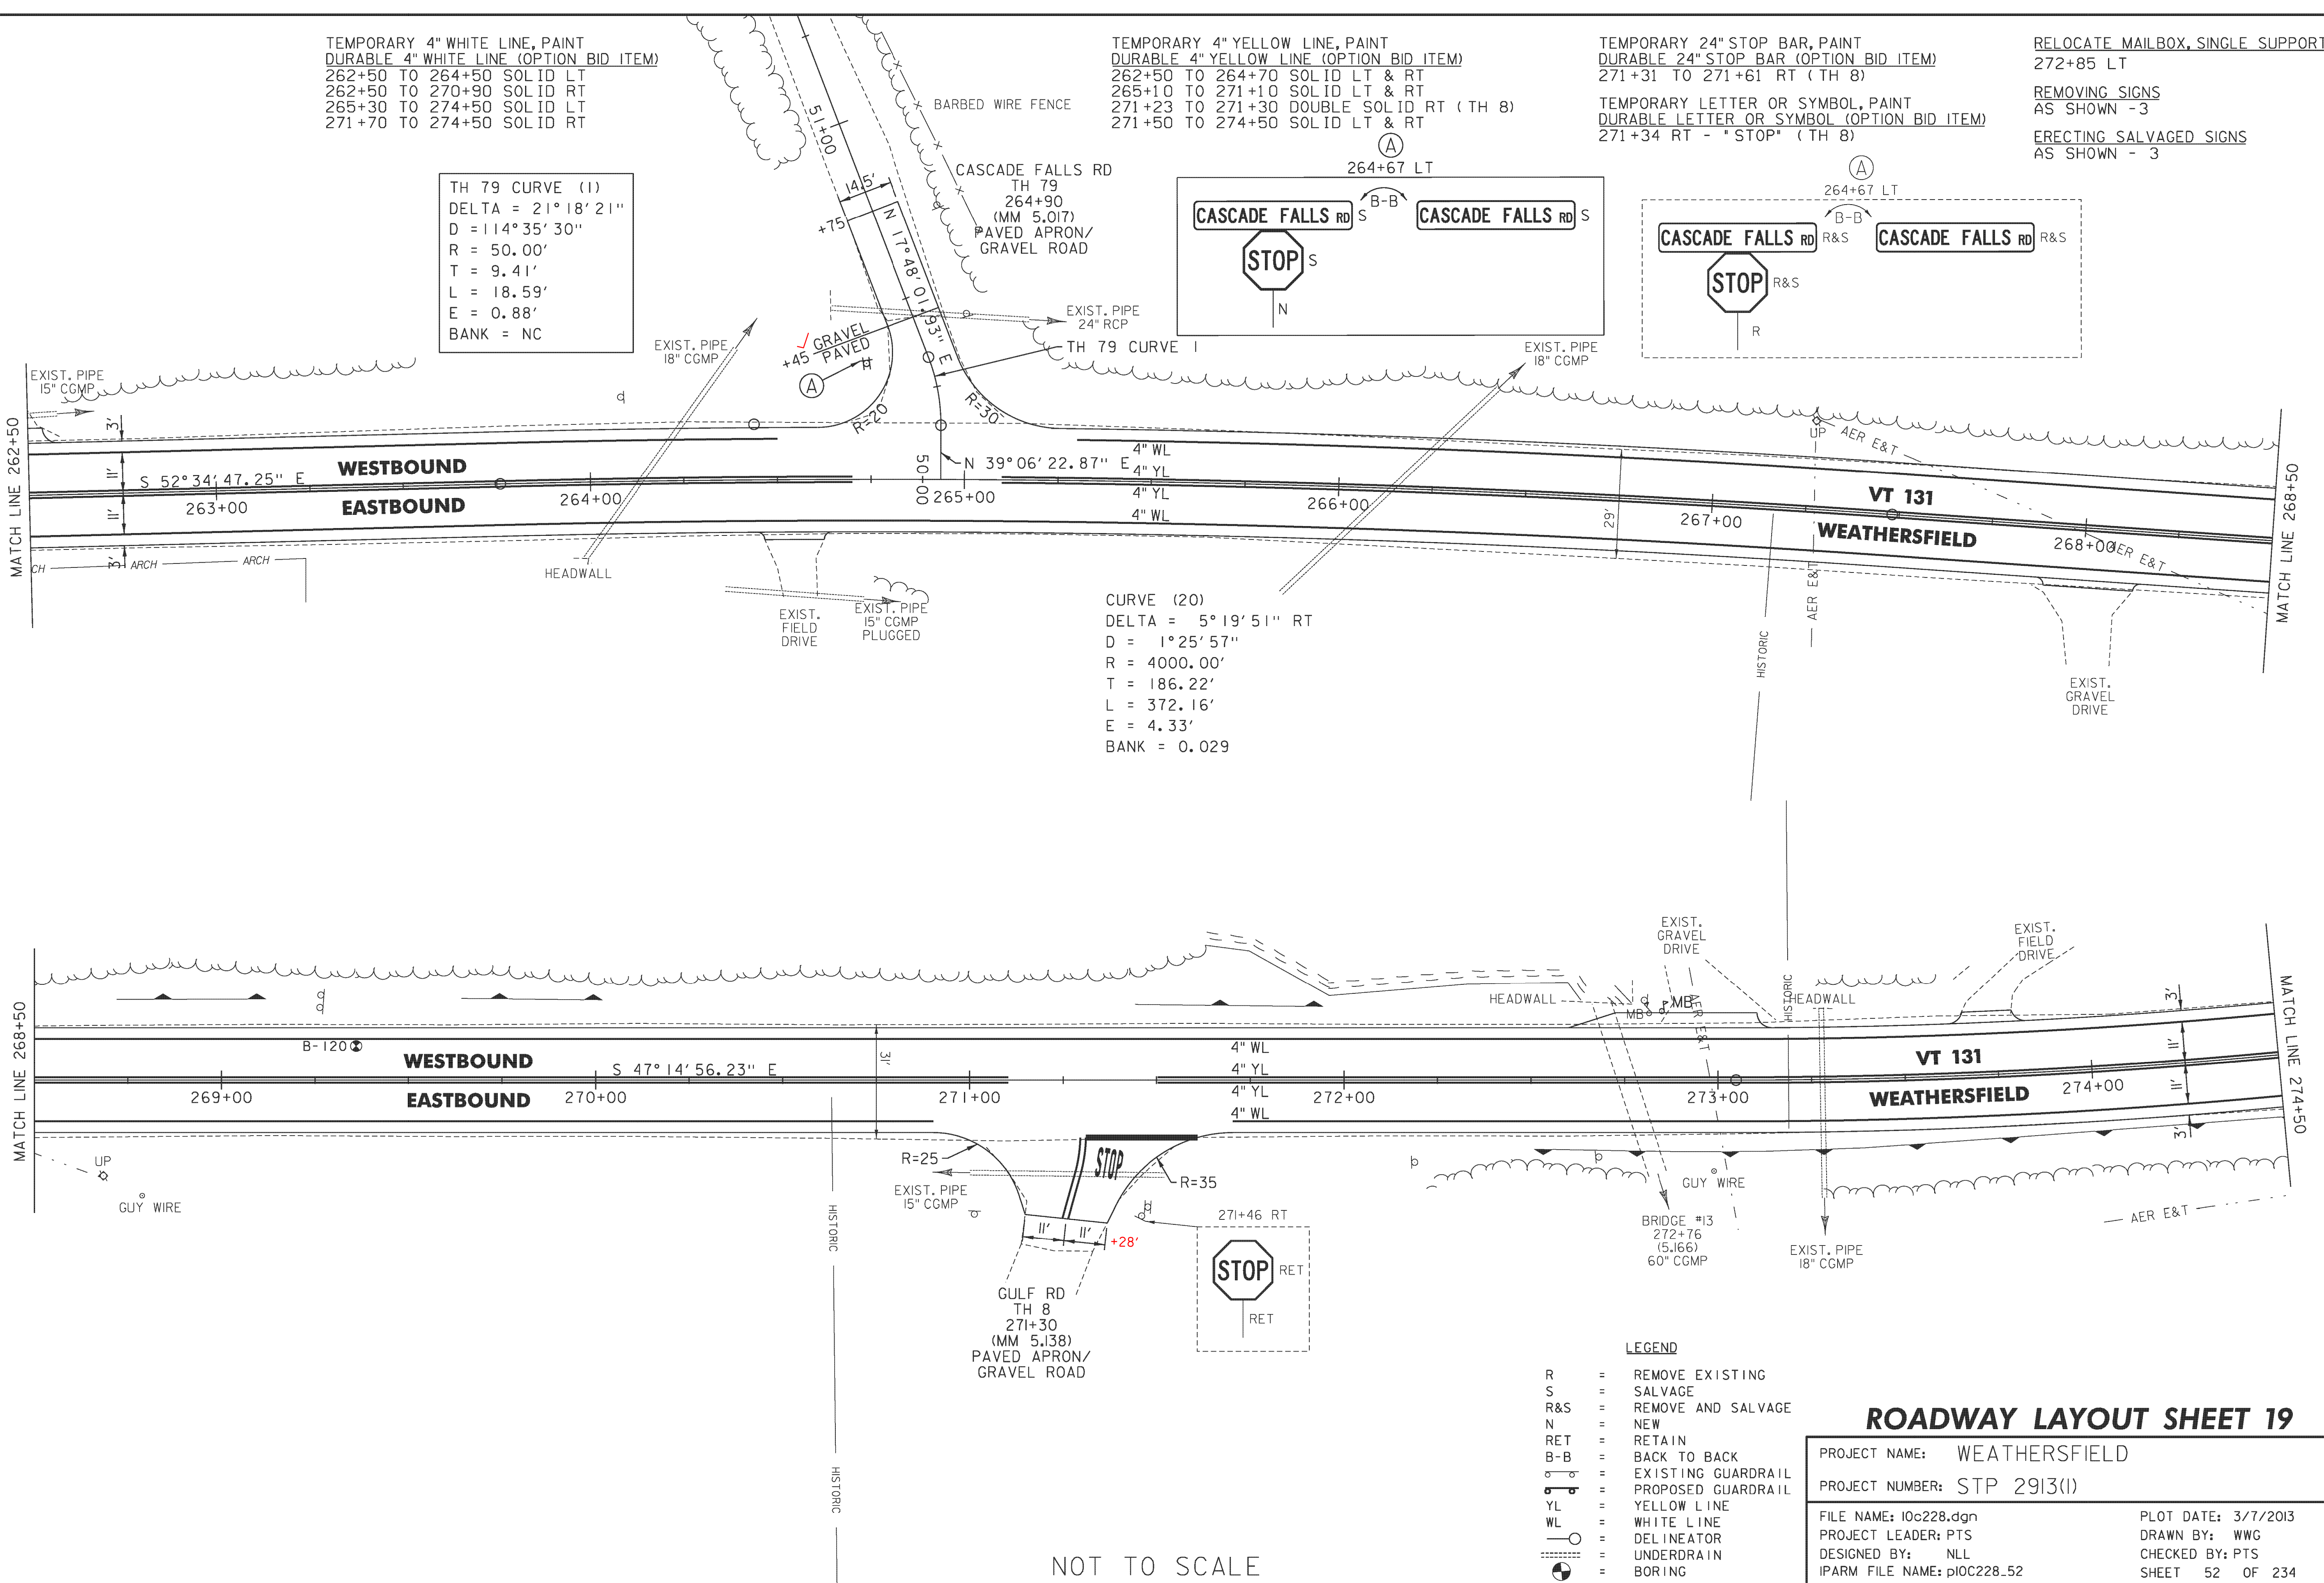

NOT TO SCALE

LEGEND

- R = REMOVE EXISTING
- S = SALVAGE
- R&S = REMOVE AND SALVAGE
- N = NEW
- RET = RETAIN
- B-B = BACK TO BACK
- = EXISTING GUARDRAIL
- = PROPOSED GUARDRAIL
- YL = YELLOW LINE
- WL = WHITE LINE
- = DELINEATOR
- = UNDERDRAIN
- = BORING

ROADWAY LAYOUT SHEET 19

PROJECT NAME:	WEATHERSFIELD
PROJECT NUMBER:	STP 2913(1)
FILE NAME:	I0c228.dgn
PROJECT LEADER:	PTS
DESIGNED BY:	NLL
IPARM FILE NAME:	pI0C228.52
PLOT DATE:	3/7/2013
DRAWN BY:	WWG
CHECKED BY:	PTS
SHEET	52 OF 234