

TEMPORARY 4" YELLOW LINE, PAINT
DURABLE 4" YELLOW LINE (OPTION BID ITEM)


80+50	TO	83+30	SOL ID	LT & RT
83+70	TO	85+55	SOL ID	LT & RT
85+95	TO	86+50	SOL ID	LT & RT

6 INCH UNDERDRAIN PIPE
80+50 TO 81+75 RT
85+00 TO 86+50 LT

STEEL BEAM GUARDRAIL, GALVANIZED
W/8 FEET POSTS
85+67 TO 86+50 RT

ANCHOR FOR STEEL BEAM RAIL
85+67 RT

<u>REMOVAL AND DISPOSAL OF GUARDRAIL</u>	<u>REMOVING SIGNS</u>
85+89 TO 86+50 RT	AS SHOWN - 4
<u>DELINEATOR WITH STEEL POST</u>	<u>ERECTING SALVAGED SIGNS</u>
85+67 RT	AS SHOWN - 4

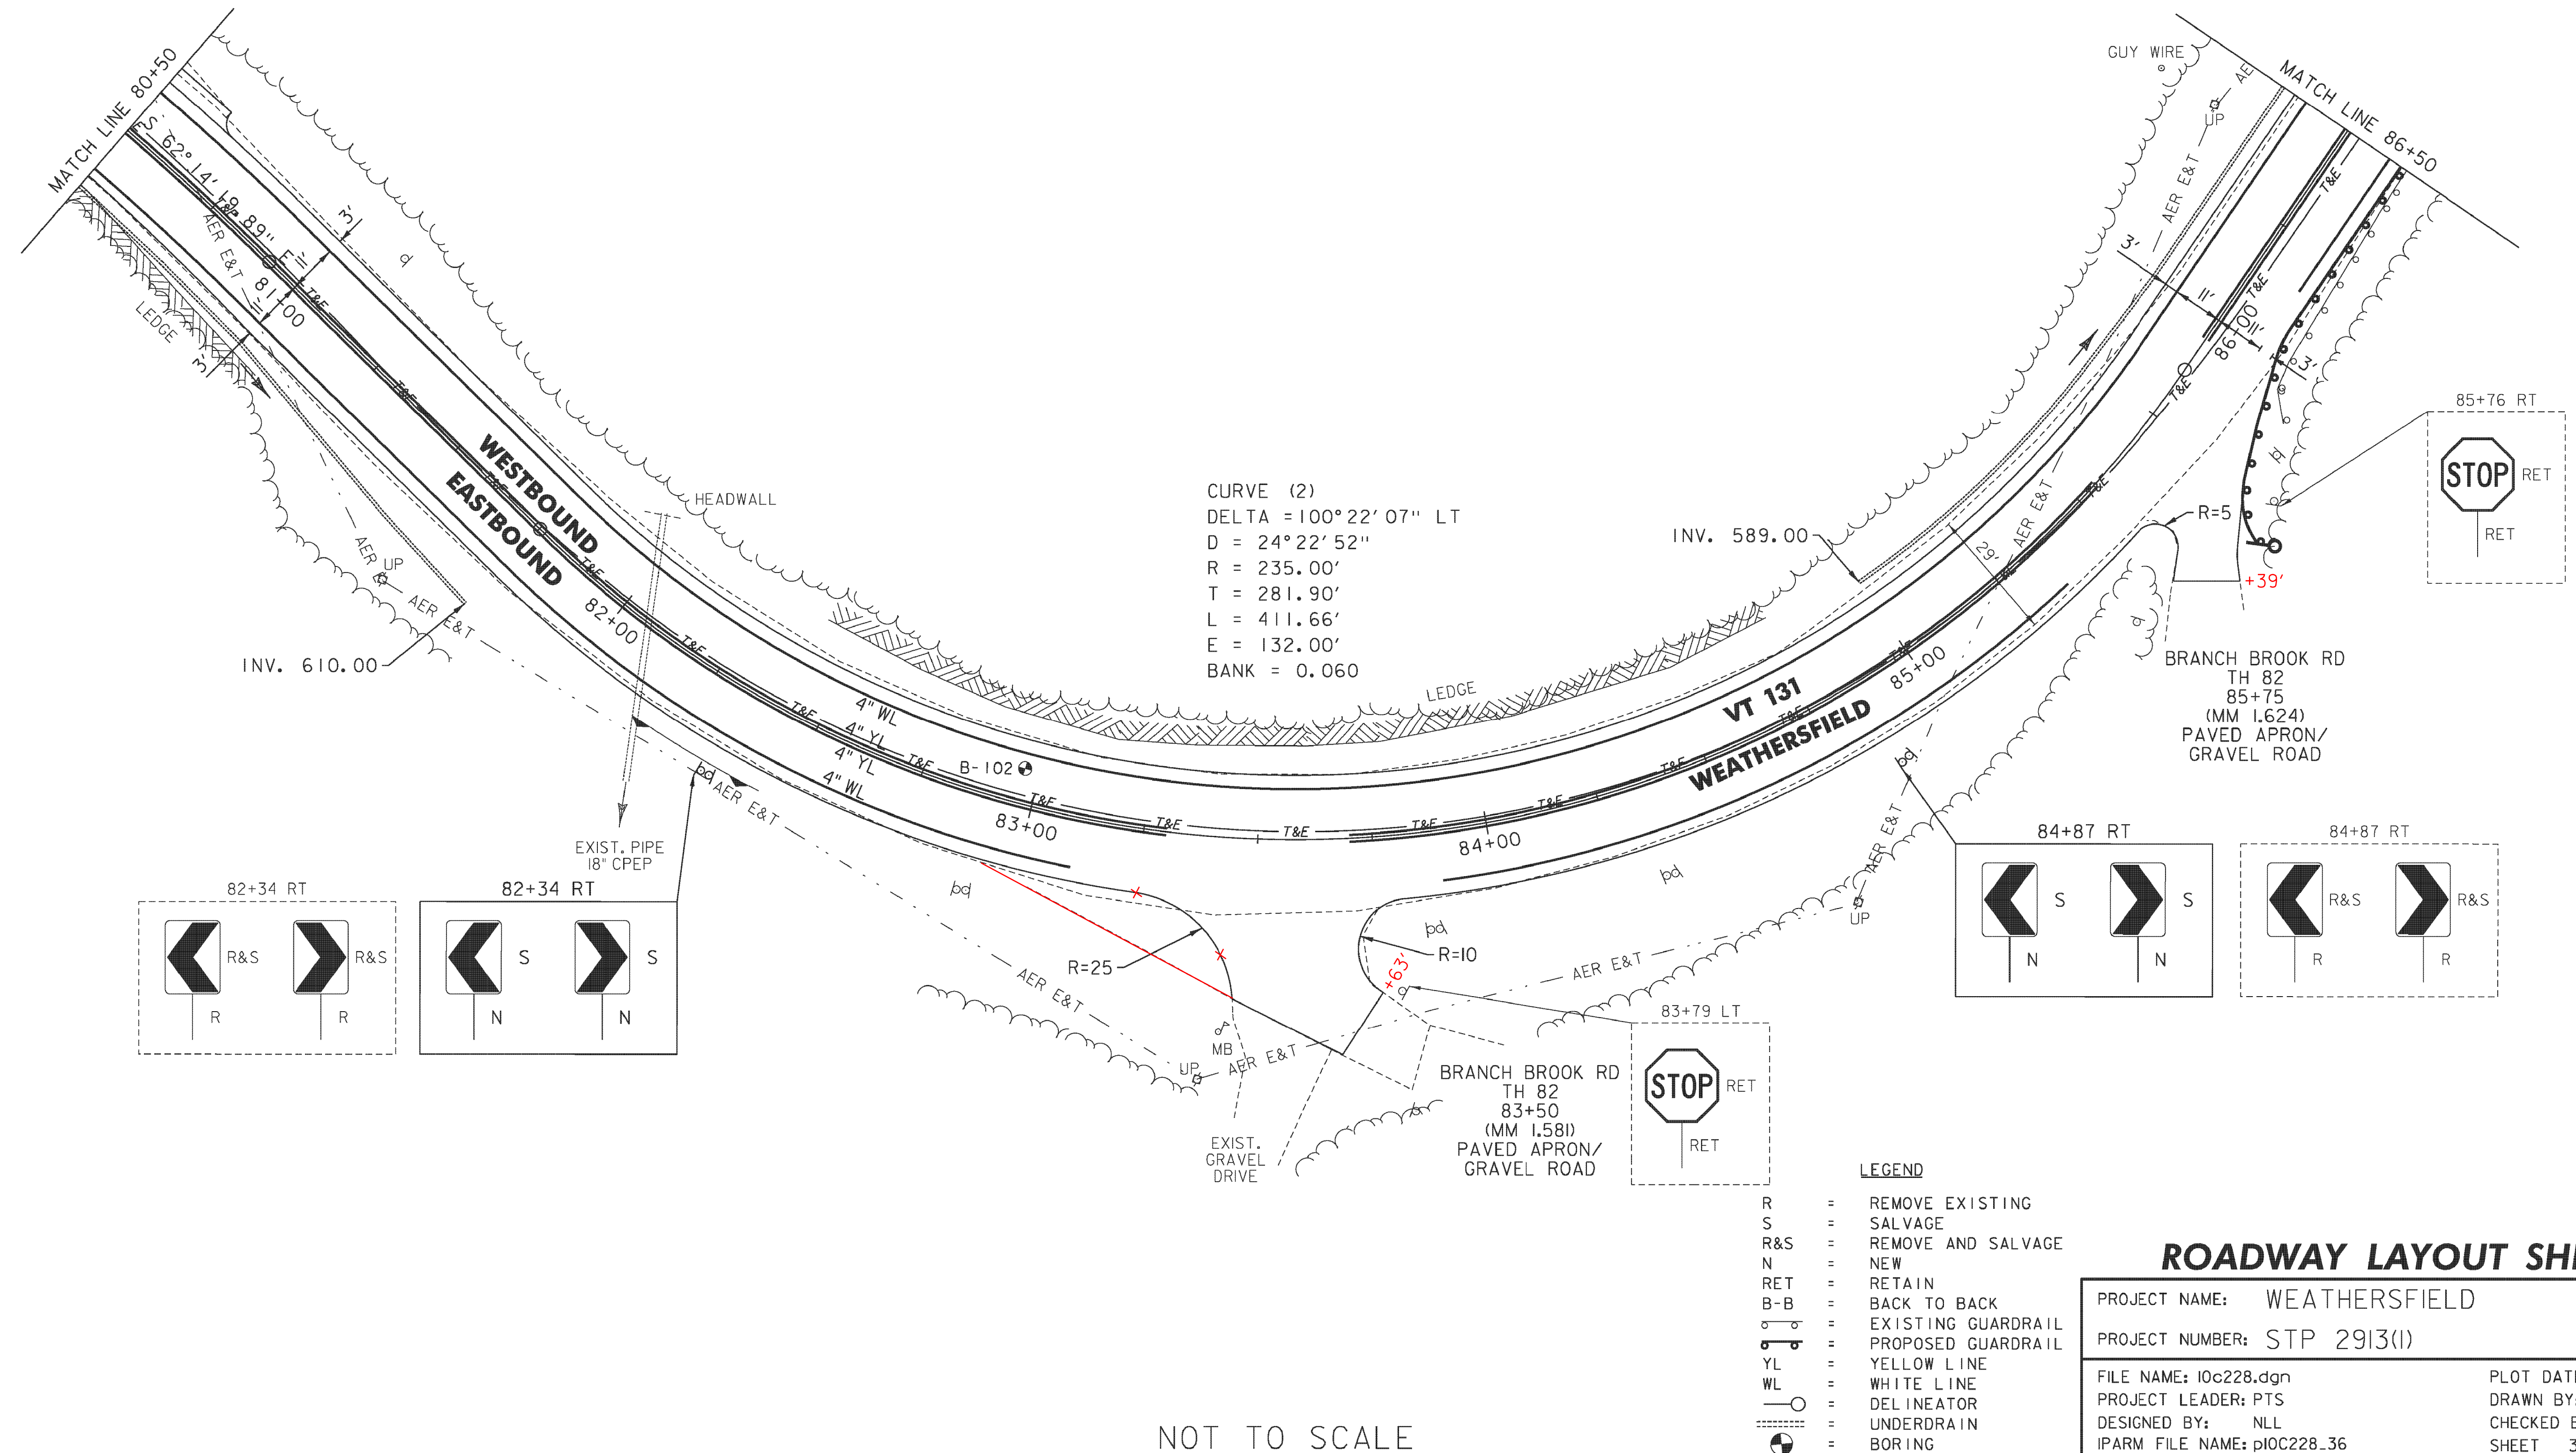

NOT TO SCALE