

TEMPORARY 4" WHITE LINE, PAINT
DURABLE 4" WHITE LINE (OPTION BID ITEM)
109+50 TO 118+83 SOLID LT
109+50 TO 121+50 SOLID RT
118+83 TO 119+13 SOLID LT (TH 11)
119+34 TO 119+64 SOLID LT (TH 11)
119+64 TO 121+50 SOLID LT

TEMPORARY 4" YELLOW LINE, PAINT
DURABLE 4" YELLOW LINE (OPTION BID ITEM)
109+50 TO 119+05 SOLID LT & RT
119+23 DOUBLE SOLID LT (TH 11)
119+45 TO 121+50 SOLID LT & RT

TEMPORARY 24" STOP BAR, PAINT
DURABLE 24" STOP BAR (OPTION BID ITEM)
119+02 TO 119+23 LT (TH 11)

TEMPORARY LETTER OR SYMBOL, PAINT
DURABLE LETTER OR SYMBOL (OPTION BID ITEM)
119+17 LT - "STOP" (TH 11)



6 INCH UNDERDRAIN PIPE
113+50 TO 115+30 RT

STONE FILL, TYPE I
GEOTEXTILE UNDER STONE FILL
115+00 TO 116+00 LT

STEEL BEAM GUARDRAIL, GALVANIZED
W/8 FEET POSTS
112+25 TO 117+25 LT

ANCHOR FOR STEEL BEAM RAIL
112+25 LT
117+25 LT

REMOVAL AND DISPOSAL OF GUARDRAIL
112+29 TO 116+72 LT
DELINEATOR WITH STEEL POST
112+25 LT
117+25 LT

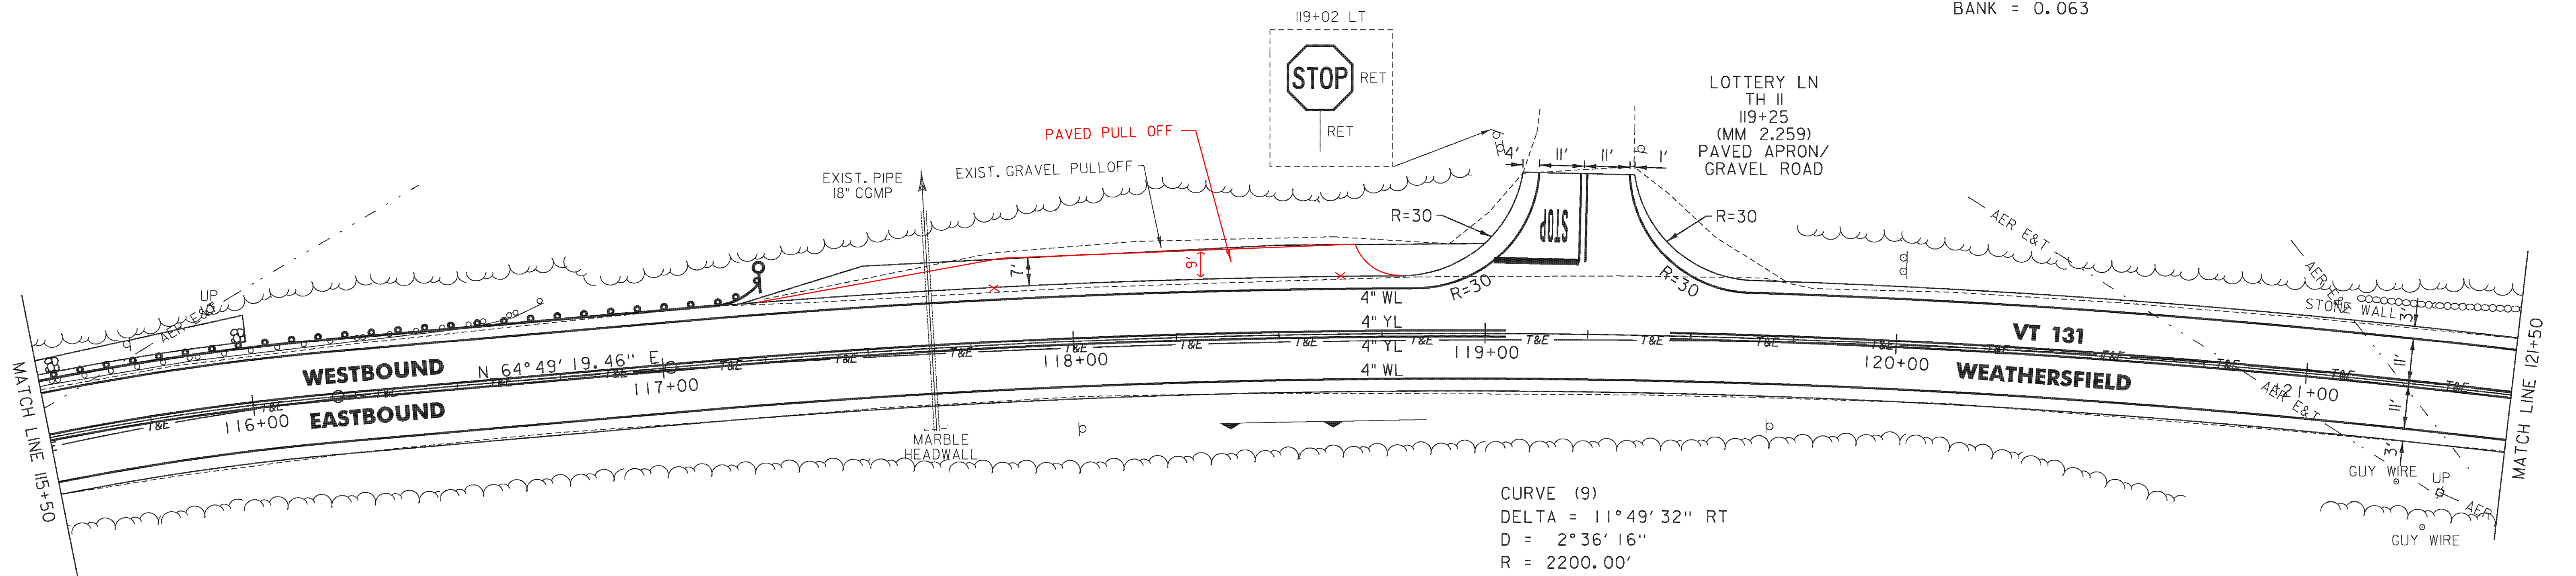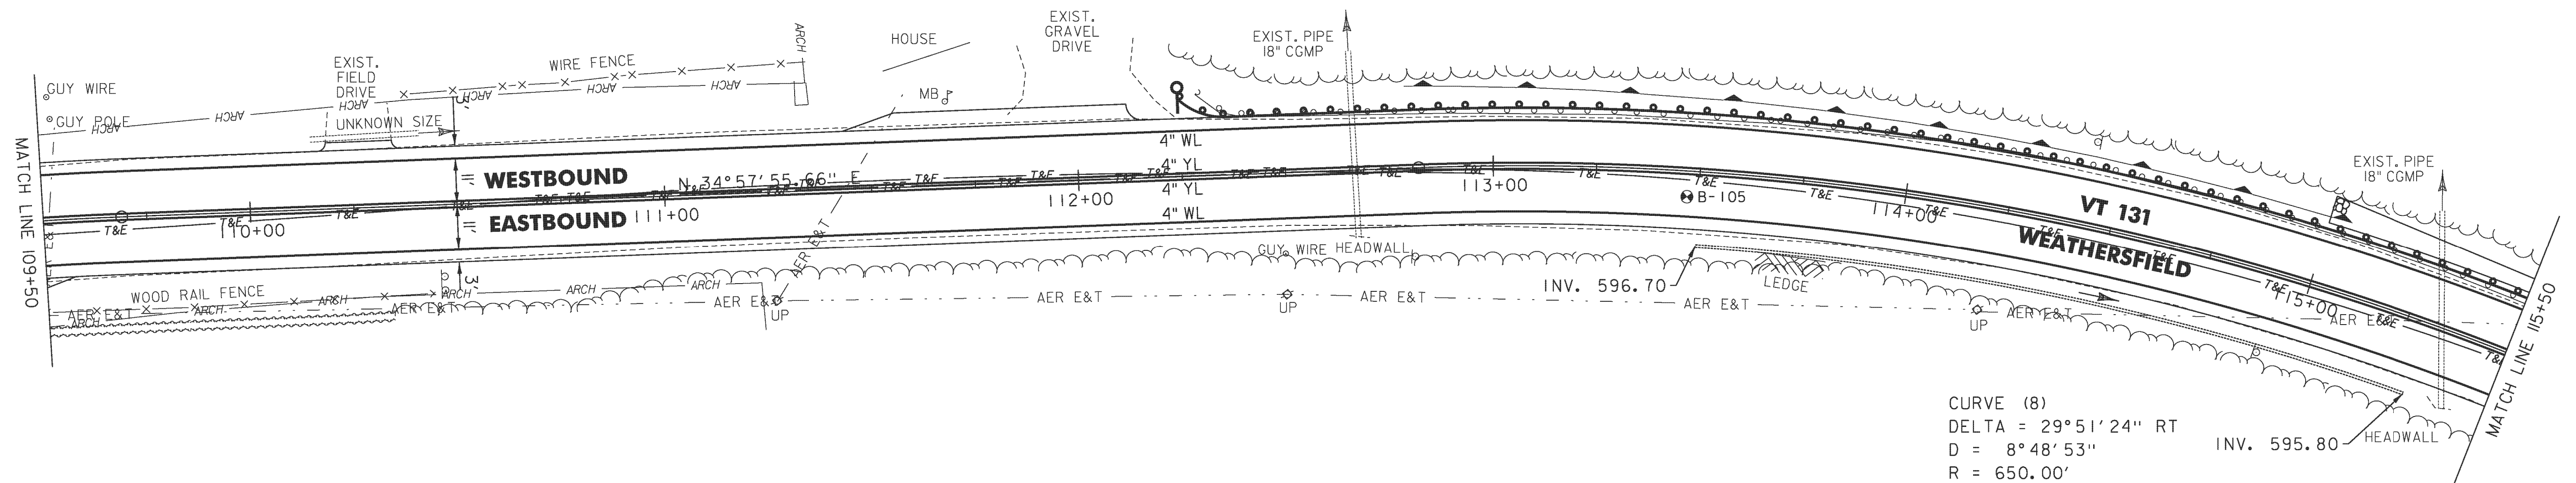

CURVE (9)
DELTA = 11°49'32" RT
D = 2°36'16"
R = 2200.00'
T = 227.84'
L = 454.06'
E = 11.77'
BANK = 0.027

LEGEND

R = REMOVE EXISTING
S = SALVAGE
R&S = REMOVE AND SALVAGE
N = NEW
RET = RETAIN
B-B = BACK TO BACK
= EXISTING GUARDRAIL
= PROPOSED GUARDRAIL
YL = YELLOW LINE
WL = WHITE LINE
= DELINEATOR
= UNDERDRAIN
= BORING

ROADWAY LAYOUT SHEET 6

PROJECT NAME: WEATHERSFIELD

PROJECT NUMBER: STP 2913(1)

FILE NAME: 10c228.dgn

PROJECT LEADER: PTS

DESIGNED BY: NLL

IPARM FILE NAME: p10c228_39

PLOT DATE: 3/7/2013

DRAWN BY: WWG

CHECKED BY: PTS

SHEET 39 OF 234

NOT TO SCALE