

TEMPORARY 4" WHITE LINE, PAINT
DURABLE 4" WHITE LINE (OPTION BID ITEM)
203+50 TO 211+15 SOLID LT
203+50 TO 215+50 SOLID RT
211+15 TO 211+49 SOLID LT (TH 7)
211+65 TO 211+89 SOLID LT (TH 7)
211+89 TO 215+50 SOLID LT

TEMPORARY 4" YELLOW LINE, PAINT
DURABLE 4" YELLOW LINE (OPTION BID ITEM)
203+50 TO 211+32 SOLID LT & RT
211+52 TO 211+57 DOUBLE SOLID LT (TH 7)
211+72 TO 215+50 SOLID LT & RT

TEMPORARY 24" STOP BAR, PAINT
DURABLE 24" STOP BAR (OPTION BID ITEM)
211+33 TO 211+51 LT (TH 7)

TEMPORARY LETTER OR SYMBOL, PAINT
DURABLE LETTER OR SYMBOL (OPTION BID ITEM)
211+44 LT - "STOP" (TH 7)

6 INCH UNDERDRAIN PIPE
203+50 TO 206+00 RT

STEEL BEAM GUARDRAIL, GALVANIZED
211+88 TO 215+50 LT
212+25 TO 213+00 RT
214+87.5 TO 215+50 RT



STEEL BEAM GUARDRAIL, GALVANIZED
W/8 FEET POSTS
213+00 TO 214+87.5 RT

ANCHOR FOR STEEL BEAM RAIL
211+88 LT
212+25 RT

REMOVAL AND DISPOSAL OF GUARDRAIL
211+88 TO 215+50 LT
212+25 TO 215+50 RT

DELINEATOR WITH STEEL POST
211+88 LT
212+25 RT

RELOCATE MAILBOX, SINGLE SUPPORT
206+60 LT
207+89 LT

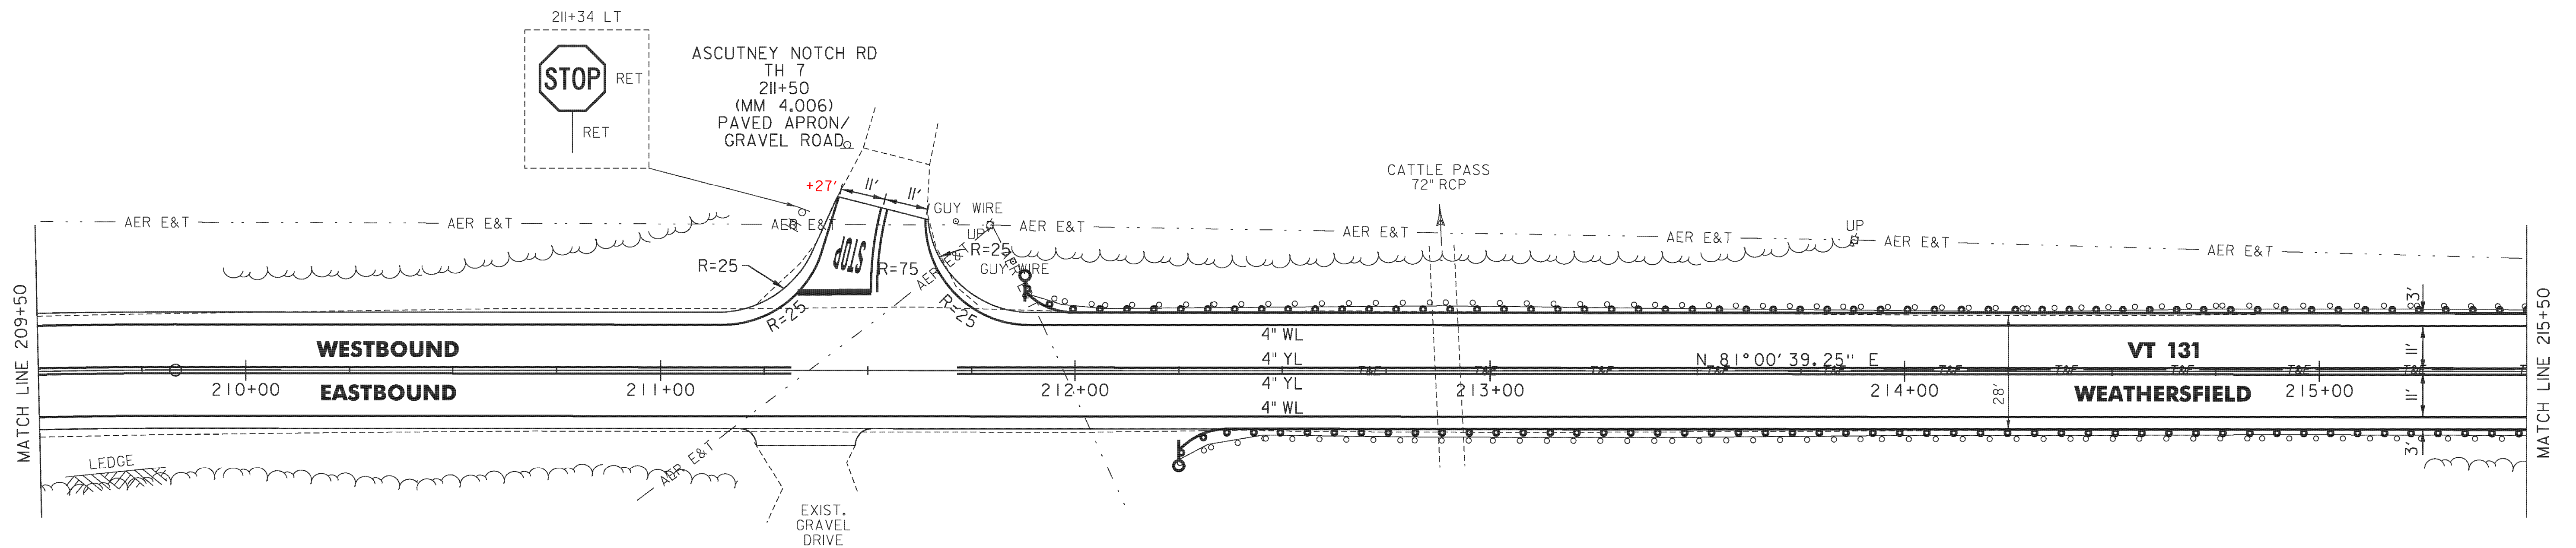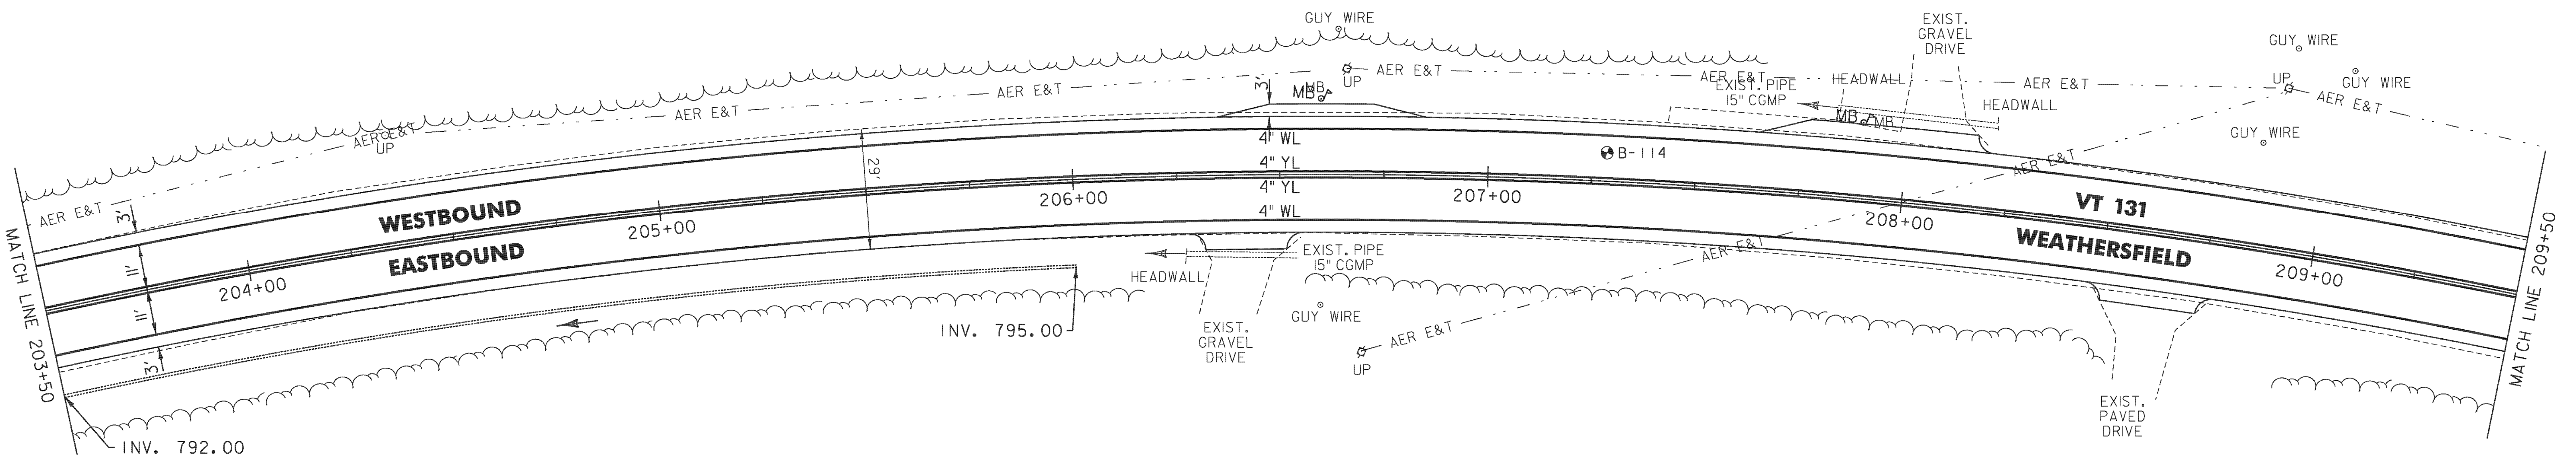

- LEGEND
- R = REMOVE EXISTING
 - S = SALVAGE
 - R&S = REMOVE AND SALVAGE
 - N = NEW
 - RET = RETAIN
 - B-B = BACK TO BACK
 - = EXISTING GUARDRAIL
 - = PROPOSED GUARDRAIL
 - YL = YELLOW LINE
 - WL = WHITE LINE
 - = DELINEATOR
 - = UNDERDRAIN
 - = BORING

ROADWAY LAYOUT SHEET 14

PROJECT NAME:	WEATHERSFIELD
PROJECT NUMBER:	STP 2913(1)
FILE NAME:	I0c228.dgn
DESIGNED BY:	NLL
IPARM FILE NAME:	pi0c228_47
PLOT DATE:	3/7/2013
DRAWN BY:	WWG
CHECKED BY:	PTS
SHEET	47 OF 234

NOT TO SCALE