

TEMPORARY 4" WHITE LINE, PAINT
DURABLE 4" WHITE LINE (OPTION BID ITEM)
298+50 TO 310+50 SOLID LT
298+50 TO 301+24 SOLID RT
302+04 TO 308+57 SOLID RT
309+19 TO 310+50 SOLID RT

TEMPORARY 4" YELLOW LINE, PAINT
DURABLE 4" YELLOW LINE (OPTION BID ITEM)
298+50 TO 301+44 SOLID LT & RT
301+84 TO 308+61 SOLID LT & RT
309+01 TO 310+50 SOLID LT & RT

6 INCH UNDERDRAIN PIPE
302+50 TO 306+00 LT

STONE FILL, TYPE I
GEOTEXTILE UNDER STONE FILL
298+75 TO 299+50 LT

STEEL BEAM GUARDRAIL, GALVANIZED
306+53 TO 310+50 LT


STEEL BEAM GUARDRAIL, GALVANIZED
W/8 FEET POSTS
306+20 TO 308+57.5 RT

ANCHOR FOR STEEL BEAM RAIL
306+20 RT
306+53 LT
308+57.5 RT

REMOVAL AND DISPOSAL OF GUARDRAIL
306+19 TO 308+57 RT
306+53 TO 310+50 LT

DELINEATOR WITH STEEL POST
306+20 RT
306+53 LT
308+57.5 RT

CURVE (24)
DELTA = 17°52'02" LT
D = 3°34'52"
R = 1600.00'
T = 251.51'
L = 498.94'
E = 19.65'
BANK = 0.059

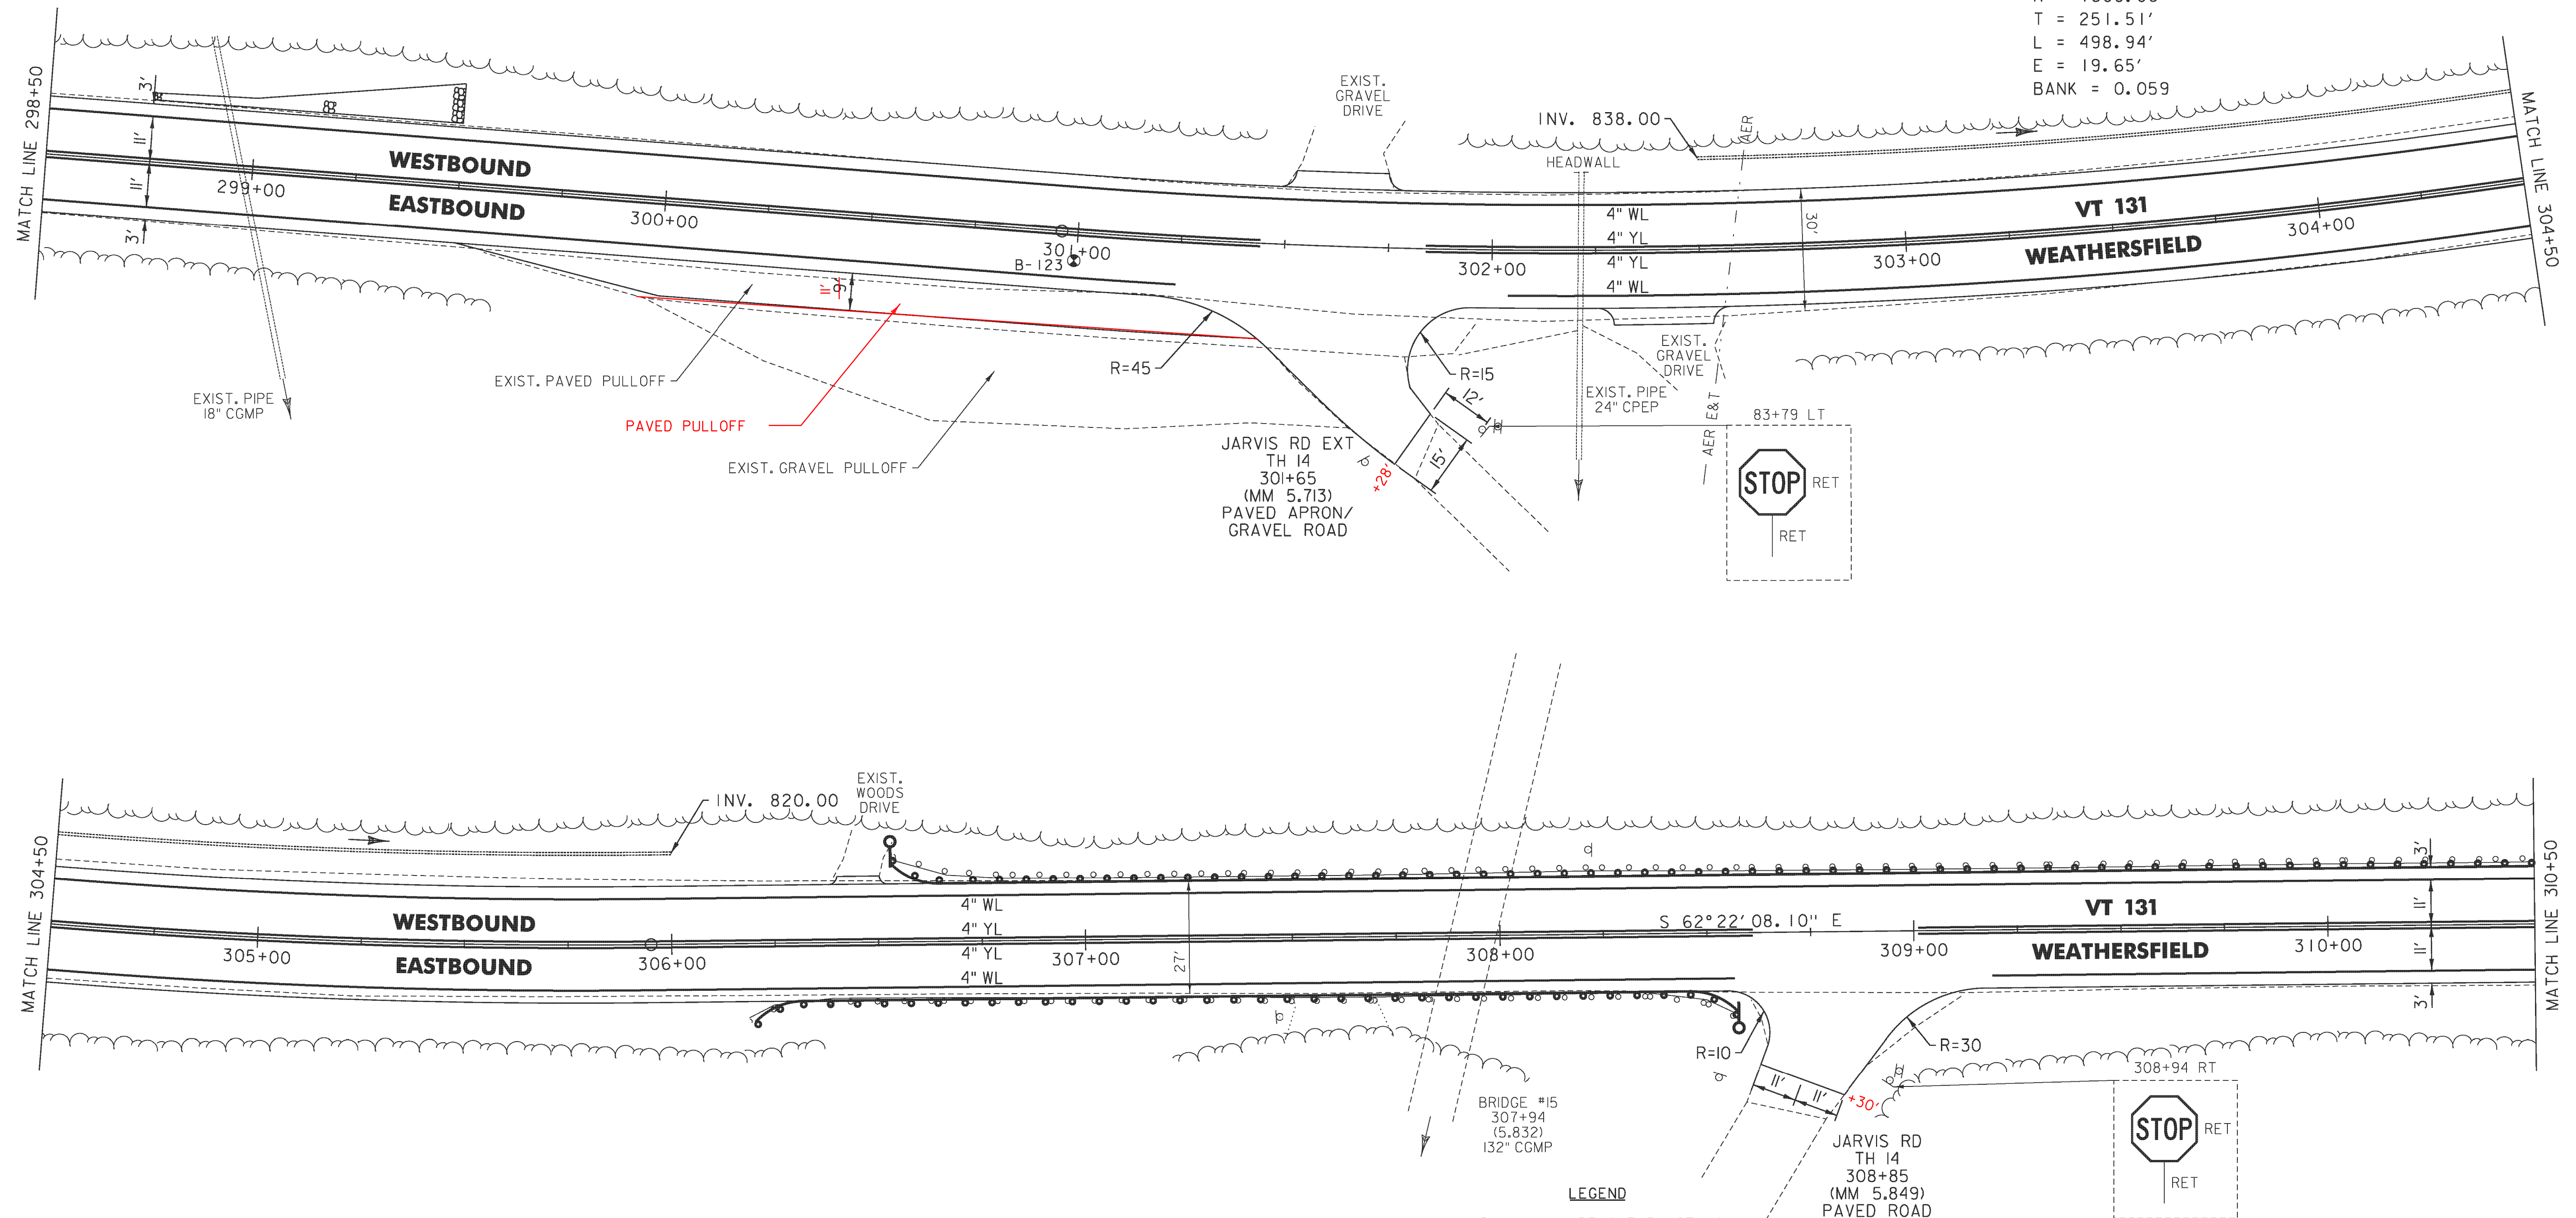

LEGEND
R = REMOVE EXISTING
S = SALVAGE
R&S = REMOVE AND SALVAGE
N = NEW
RET = RETAIN
B-B = BACK TO BACK
G = EXISTING GUARDRAIL
K = PROPOSED GUARDRAIL
YL = YELLOW LINE
WL = WHITE LINE
D = DELINEATOR
U = UNDERDRAIN
B = BORING

ROADWAY LAYOUT SHEET 22

PROJECT NAME: WEATHERSFIELD

PROJECT NUMBER: STP 2913(1)

FILE NAME: I0c228.dgn
PROJECT LEADER: PTS
DESIGNED BY: NLL
IPARM FILE NAME: pI0C228.55

PLOT DATE: 3/7/2013
DRAWN BY: WWG
CHECKED BY: PTS
SHEET 55 OF 234