
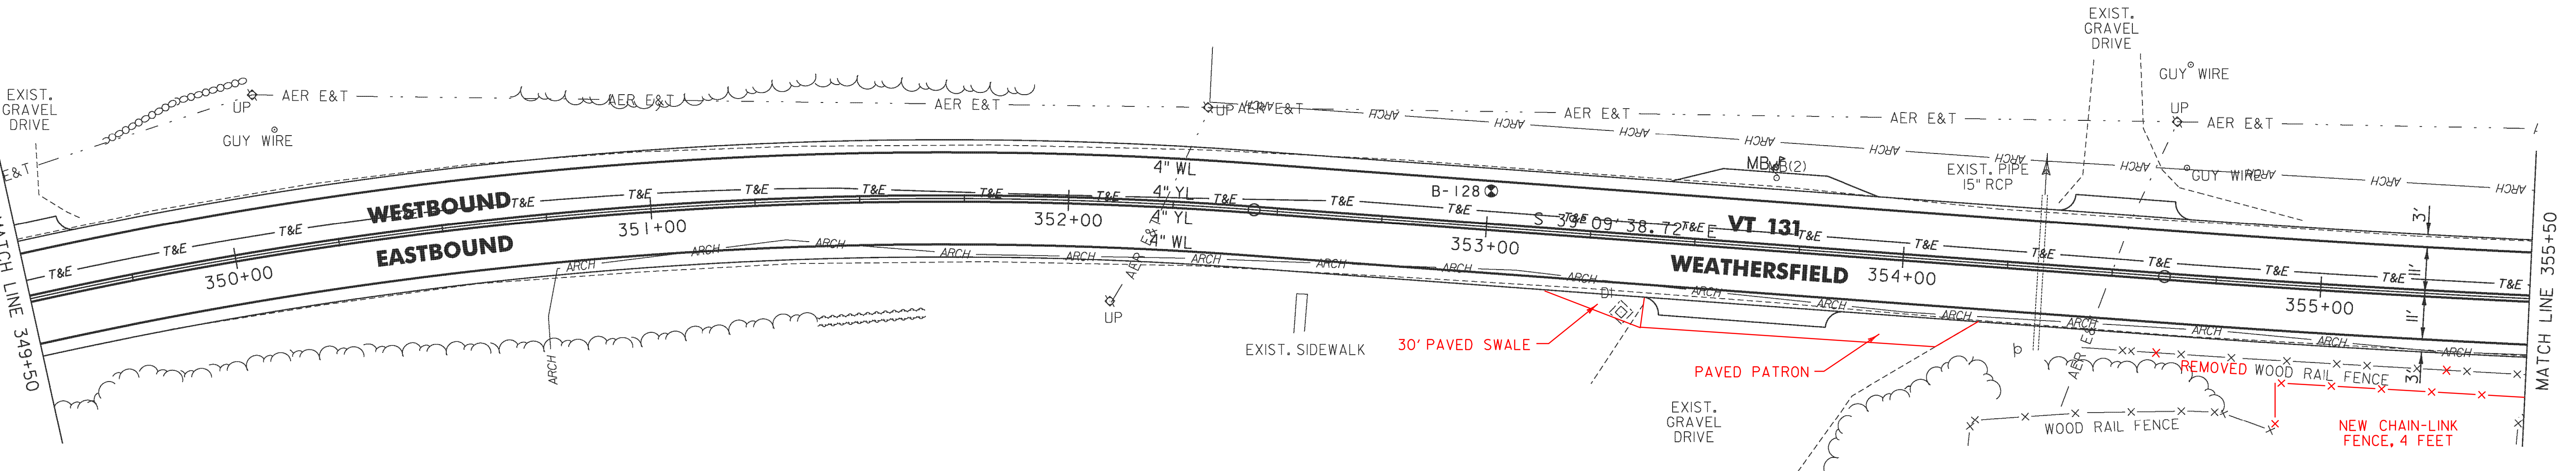


TEMPORARY 4" WHITE LINE, PAINT  
DURABLE 4" WHITE LINE (OPTION BID ITEM)  
343+50 TO 343+78 SOLID LT  
343+50 TO 355+50 SOLID RT  
343+78 TO 344+11 SOLID LT (TH 37)  
344+13 TO 344+18 SOLID LT (TH 37)  
344+18 TO 355+50 SOLID LT  
  
TEMPORARY 4" YELLOW LINE, PAINT  
DURABLE 4" YELLOW LINE (OPTION BID ITEM)  
343+50 TO 343+80 SOLID LT & RT  
343+99 TO 344+17 DOUBLE SOLID LT (TH 37)  
344+20 TO 355+50 SOLID LT & RT

TEMPORARY 24" STOP BAR, PAINT  
DURABLE 24" STOP BAR (OPTION BID ITEM)  
343+88 TO 343+99 LT (TH 37)  
  
TEMPORARY LETTER OR SYMBOL, PAINT  
DURABLE LETTER OR SYMBOL (OPTION BID ITEM)  
344+00 LT - "STOP" (TH 37)

REMOVAL OF EXISTING FENCE  
354+44 TO 355+50 RT

RELOCATE MAILBOX, SINGLE SUPPORT  
353+68 LT

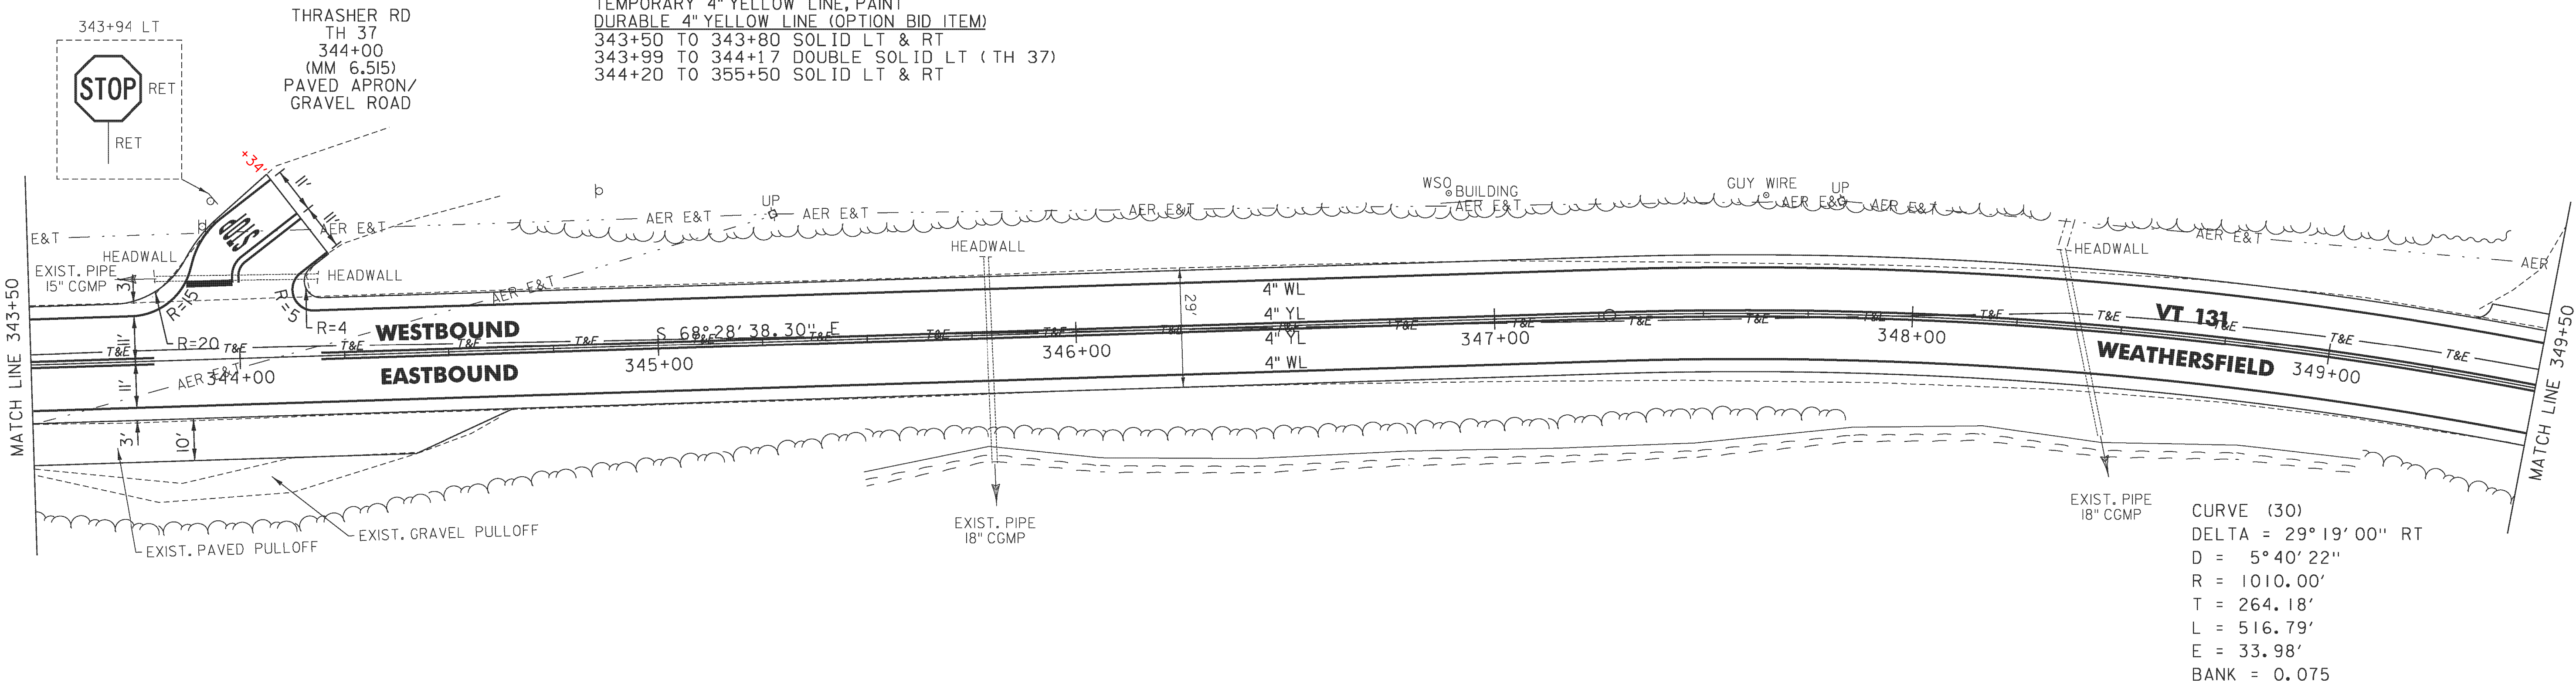

| LEGEND |                      |
|--------|----------------------|
| R      | = REMOVE EXISTING    |
| S      | = SALVAGE            |
| R&S    | = REMOVE AND SALVAGE |
| N      | = NEW                |
| RET    | = RETAIN             |
| B-B    | = BACK TO BACK       |
| ○      | = EXISTING GUARDRAIL |
| ○      | = PROPOSED GUARDRAIL |
| YL     | = YELLOW LINE        |
| WL     | = WHITE LINE         |
| ○      | = DELINEATOR         |
| ----   | = UNDERDRAIN         |
| ●      | = BORING             |

ROADWAY LAYOUT SHEET 26

|                  |               |
|------------------|---------------|
| PROJECT NAME:    | WEATHERSFIELD |
| PROJECT NUMBER:  | STP 2913(1)   |
| FILE NAME:       | I0c228.dgn    |
| PROJECT LEADER:  | PTS           |
| DESIGNED BY:     | NLL           |
| IPARM FILE NAME: | pI0C228.59    |
| PLOT DATE:       | 3/7/2013      |
| DRAWN BY:        | WWG           |
| CHECKED BY:      | PTS           |
| SHEET            | 59 OF 234     |

NOT TO SCALE