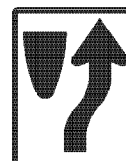
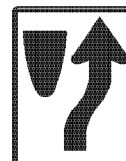


MILEMARKER, STATION, OR SIGN NUMBER	SIGN LEGEND	SIGN DIMENSIONS			NEW & SALVAGED SIGNS				EXIST POST		NO. OF POSTS	NEW SIGN POSTS					TUBULAR STEEL Ø (in)				TUBULAR STEEL Ø (in)				W-SHAPE STEEL				RE QUI RED FR AME D S IG NE	REMARKS	SIGN DETAIL		
		E A	WIDTH (in)	HEIGHT (in)	“A”	“B”	SALV SIGN	SALV TIS	RE TAIN	S A L V A G E		SQUARE STEEL (in)			TUBULAR ALUMINUM Ø (in)			FOUND- ATION	TUBULAR STEEL Ø (in)			FTG. SIZE		WEIGHT	POST SIZE	SHSM	DETAIL ON SHEET NUMBER	STD. SHEET NUMBER					
												1.75	2.0	2.5	ANCHOR	SLEEVE	3.0		4.0	4.0 MOD	3.0	3.5	4.0								5.0	24"	30"
WEATHERSFIELD VT 131																																	
429+32 LT	 	I I	30 30	30 30	6.25✓ 6.25✓						I		X	14.75	X													RI-I R5-I	BACK TO BACK	X X			
	 	I I	36 36	12 12	3.00✓ 3.00✓																							R6-IR R6-IL	BACK TO BACK	X X			
455+04 LT (MEDIAN)							I ✓				I		X	12.5	X																		
	 						I ✓ I ✓																						BACK TO BACK				
WEATHERSFIELD US 5																																	
272+24 LT (MEDIAN)							I ✓				I		X	12.5	X																		
	 						I ✓ I ✓																						BACK TO BACK				
WEATHERSFIELD VT 12																																	
0+99 RT	 	I	30	36	7.50✓						I	15.5	X		X													R2-I		X			
1+01 LT	 	I	24	30	5.00✓						I	14.25	X		X													R2-I		X			
2+50 RT		I	60	48	20.00✓						2						2	168	11' 12.5'									VD-42IM		234			
3+25 LT	 	I	24	12	2.00✓						I	15	X		X													M4-6	GREEN ON WHITE	X			
	 	I	24	24	4.00✓																							MI-5			E-136B		
FINAL POST LENGTHS ARE TO BE DETERMINED IN THE FIELD. POST SIZES ARE COMPUTED BASED ON INFORMATION FURNISHED ON THE STANDARD SHEETS AND VTRANS "SIGN POST DESIGN GUIDELINE."												FT	FT 90	FT		EA	LB	LB	LB		LB 168	LB	LB	LB	LB								
												FT				LB																	
												84.5 ✓																					