

INDEX OF SHEETS

1. TITLE SHEET
2. COMPOSITE NOTES SHEET
- 3.-4. TYPICAL SECTION SHEETS
- 5.-6. QUANTITY SHEETS
7. BRIDGE DETAIL SHEET
8. RAILROAD CROSSING DETAIL SHEET
- 9.-10. PAVEMENT MARKING DETAIL SHEETS
- 11.-17. INTERCHANGE PAVEMENT MARKING DETAIL SHEETS
- 18.-21. ROUGHNESS/RUT DATA INFORMATION SHEETS
- 22.-23. INTERCHANGE TRAFFIC CONTROL SHEETS
24. TRAFFIC CONTROL NOTES SHEET

BRIDGE JOINT, ASPHALTIC PLUG (STRUCTURES DETAIL SD-516.10)

VAOT STANDARDS

E-100	CONSTRUCTION APPROACH SIGNS	01/02/04
E-101	CONSTRUCTION SIGN DETAILS	05/30/03
E-102	CONSTRUCTION SIGN DETAILS	06/30/03
E-102A	CONSTRUCTION SIGN DETAILS	05/01/04
E-103	MAINLINE TRAFFIC CONTROL DIVIDED HIGHWAY ONE LANE CLOSED	03/01/04
E-105	TRAFFIC CONTROL FOR CONSTRUCTION VEHICLE U-TURNS ON DIVIDED HIGHWAY	05/01/04
E-106	TRAFFIC CONTROL - MISCELLANEOUS DETAILS	03/01/04
E-107A	BREAKAWAY BARRICADE DETAILS	06/08/09
E-190	RAILROAD CROSSING PAVEMENT MARKINGS	06/30/03
E-191	PAVEMENT MARKING DETAILS	02/01/99
E-192	PAVEMENT MARKING DETAILS	10/12/00
E-193	PAVEMENT MARKING DETAILS	08/18/95

RECORD PLANS

CONTRACTOR: ALL STATE ASPHALT, INC. - SUNDERLAND, MA
 RESIDENT ENGINEER: SANDRA SCHMITT
 CONSTRUCTION BEGAN: MAY 21, 2012
 CONSTRUCTION COMPLETE: SEPTEMBER 21, 2012
 RECORD PLANS BY: SANDRA SCHMITT & STEPHEN KENT

I HEREBY CERTIFY THAT ALL THE CONSTRUCTION REQUIRED BY THIS SET OF DRAWINGS HAS BEEN ACCOMPLISHED AS INDICATED HEREIN.

BY Sandra E. Schmitt RESIDENT ENGINEER
 DATE 05-20-13

NOTE: Any further information concerning final quantities, amounts or other details relative to this project may be found at Central Files in the electronic archives.

QUALITY ASSURANCE PROGRAM: LEVEL 1

CONVENTIONAL SYMBOLS

COUNTY LINE	
TOWN LINE	
LIMITS OF ACCESS	
POINT OF ACCESS	
FENCE LINE	
STONE WALL	
TRAVELED WAY	
GUARD RAIL	
RAILROAD	
SURVEY LINE	
CULVERT	
POWER POLE	
TELEPHONE POLE	
TREES	
CONTROL OF ACCESS	
PROPERTY LINE	
R.O.W. TAKING LINE	
SLOPE RIGHTS	
TOP OF CUT	
TOE OF SLOPE	

SURVEYED BY : N/A
 SURVEYED DATE : N/A

DATUM
 VERTICAL N/A
 HORIZONTAL N/A

STATE OF VERMONT AGENCY OF TRANSPORTATION




PROPOSED IMPROVEMENT TOWNS OF FAIR HAVEN CASTLETON IRA WEST RUTLAND & RUTLAND COUNTY OF RUTLAND U.S. ROUTE 4 EB & WB

THIS PROJECT INCLUDES BOTH EASTBOUND AND WESTBOUND BARRELS. EB: MM 0.195 ~ MM 18.610; WB: MM 0.594 ~ MM 18.805
 INCLUDED ARE THE RAMPS AT INTERCHANGES 2, 3, 4, 5, AND 6.


EB LENGTH OF ROADWAY = 97,231.2 FT = (18.415 MILES) = 98,287.20 FT = (18.615 MILES)
 WB LENGTH OF ROADWAY = 96,154.08 FT = (18.211 MILES) = 96,238.56 FT = (18.227 MILES)
 PROJECT LENGTH 97,231.20 FT = (18.415 MILES) 98,287.20 FT = (18.615 MILES)

WORK TO BE PERFORMED UNDER THIS PROJECT INCLUDES SURFACE PREPARATION INVOLVING PATCHING, POT HOLE REPAIR, CRACK SEALING AND OVERLAYING WITH A THIN BITUMINOUS SURFACE TREATMENT, TRAFFIC MARKINGS AND OTHER HIGHWAY RELATED ITEMS.

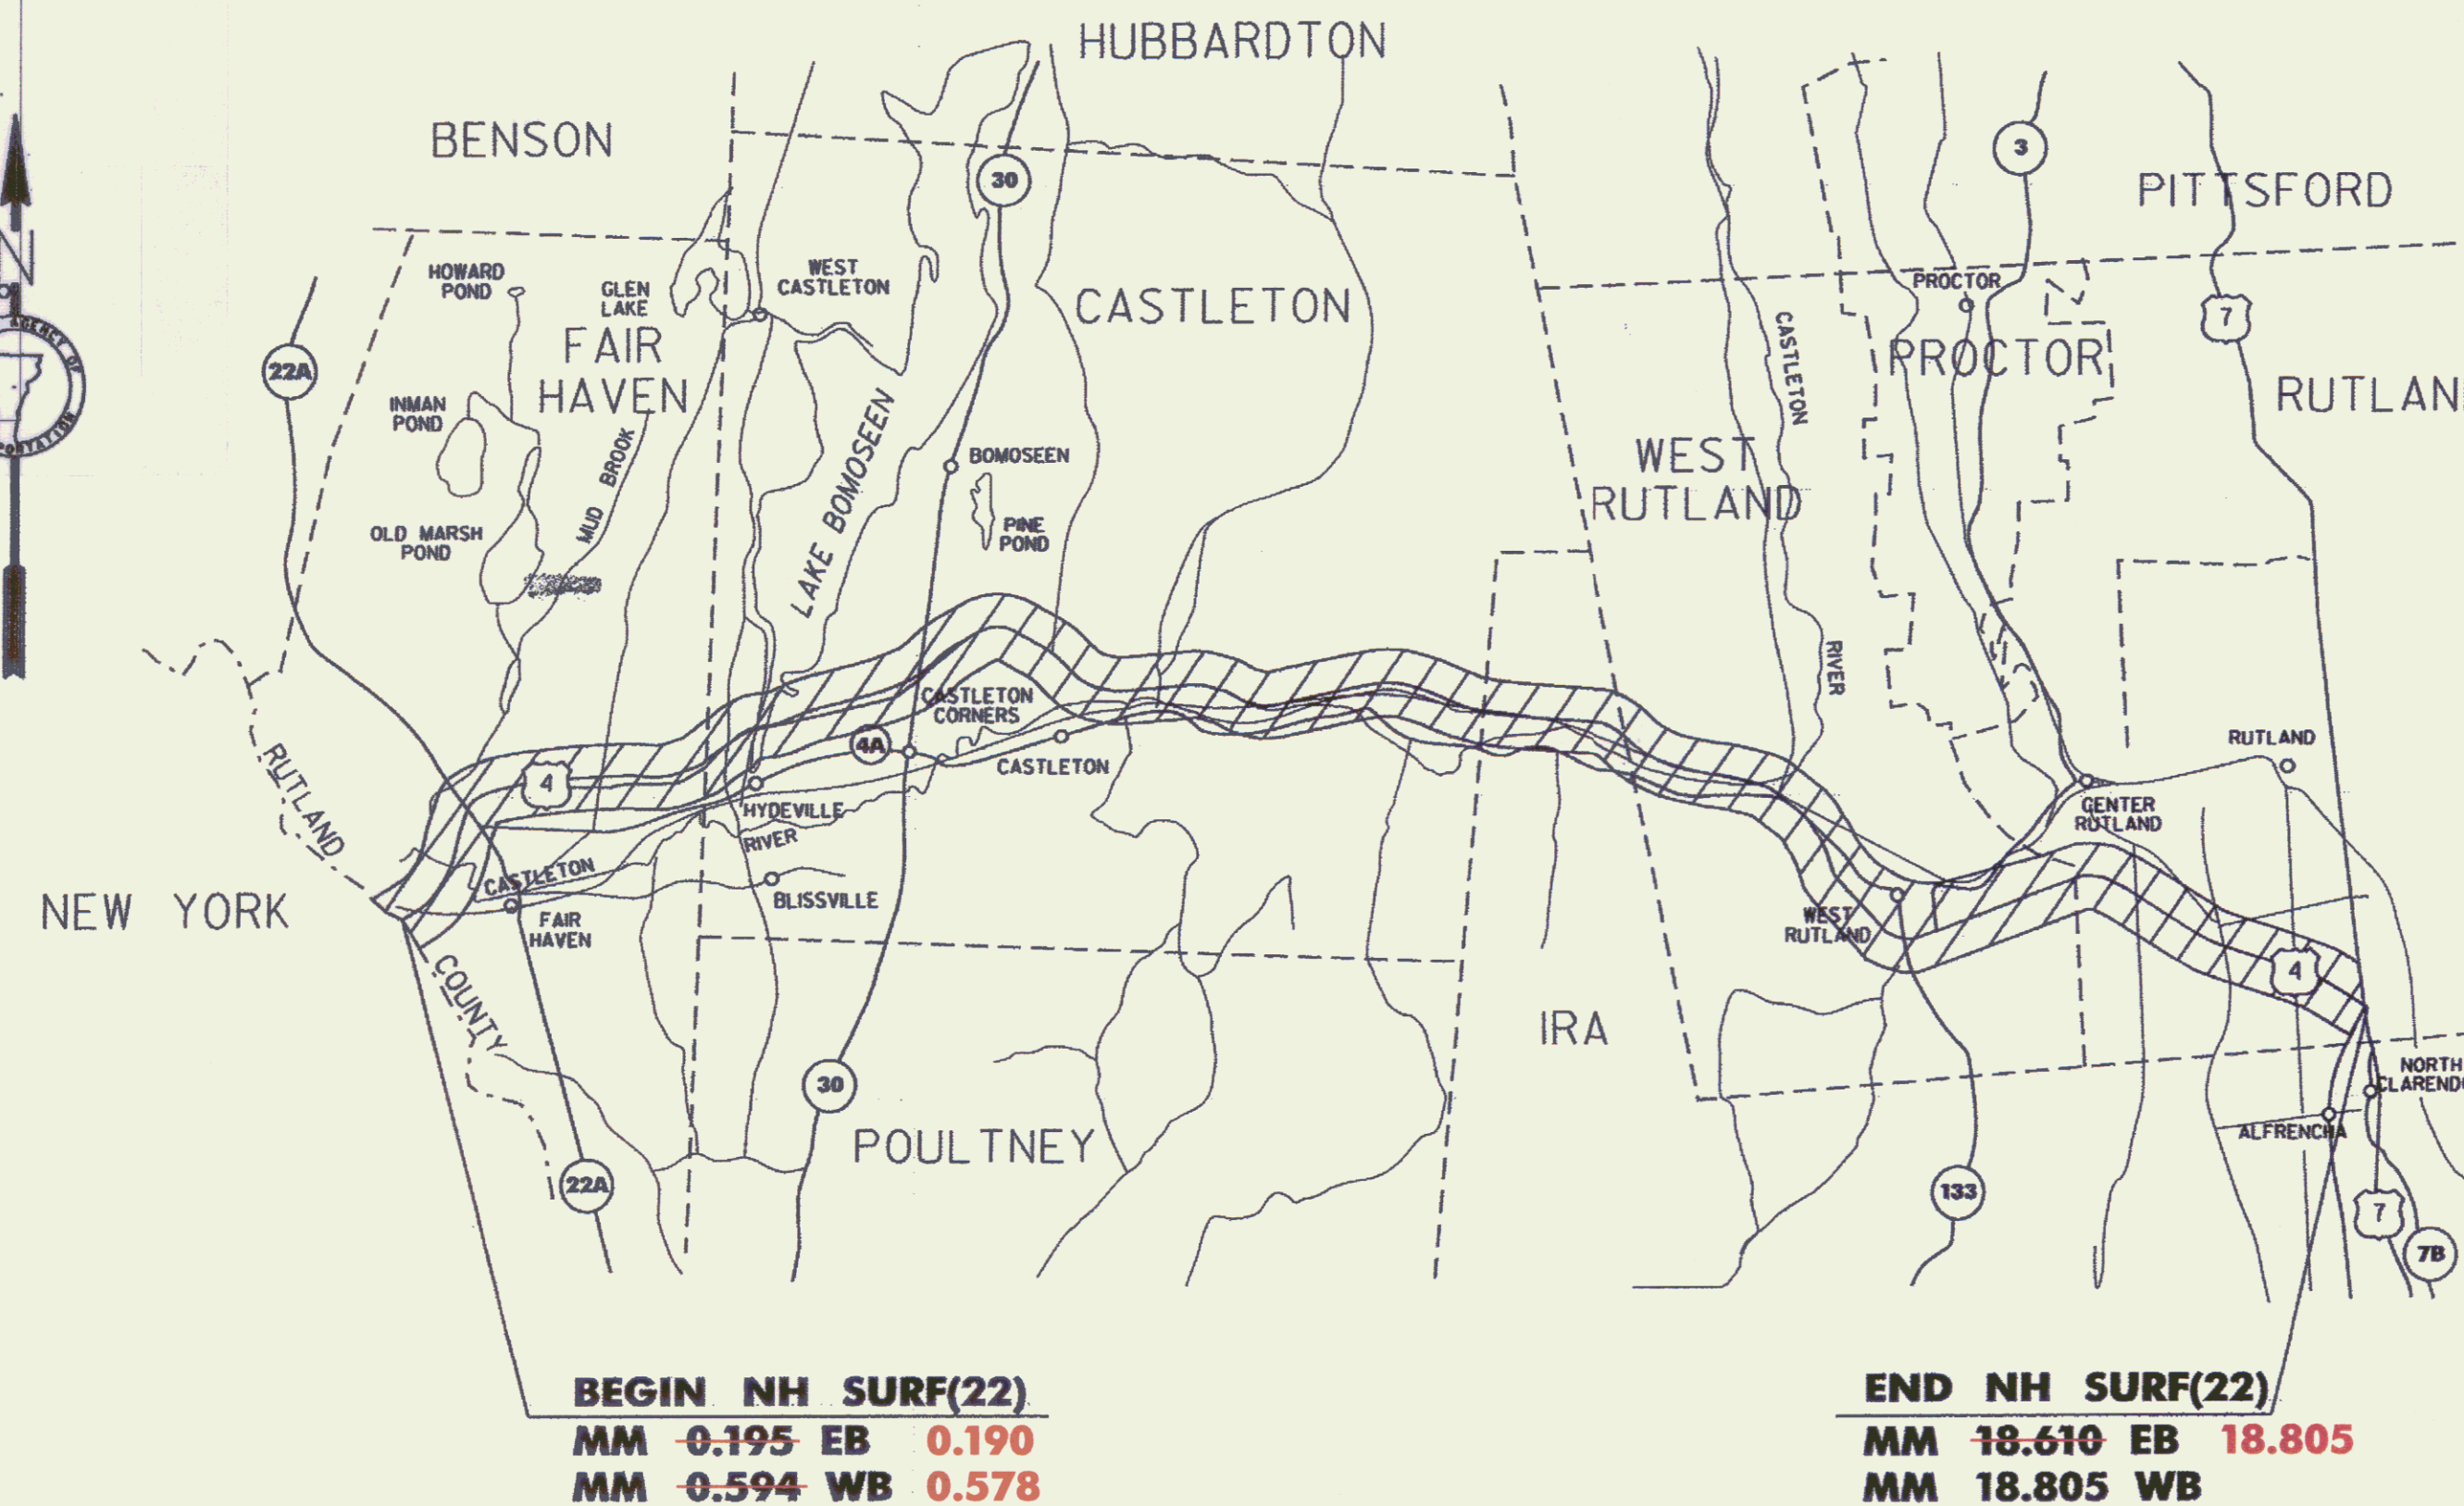

BEGIN NH SURF(22)
 MM 0.195 EB 0.190
 MM 0.594 WB 0.578

END NH SURF(22)
 MM 18.610 EB 18.805
 MM 18.805 WB

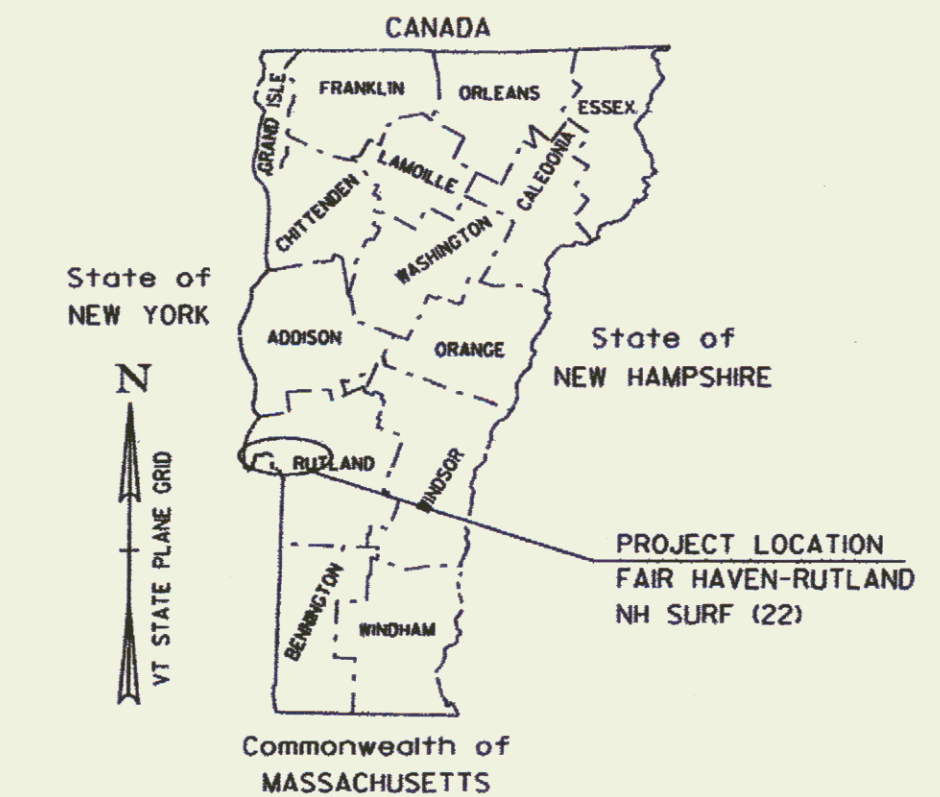

TRAFFIC DATA

EASTBOUND	WESTBOUND
NY S/L - VT. RTE. 4A 2011 ADT = 3900 2011 DHV = 500 2021 ADT = 4300 2021 DHV = 550 2011 - 2021 CUM. ESALS = 2,973,000 2011 - 2031 CUM. ESALS = 7,081,000	NY S/L - VT. RTE. 4A 2011 ADT = 3900 2011 DHV = 540 2021 ADT = 4300 2021 DHV = 600 2010 - 2020 CUM. ESALS = 2,779,000 2011 - 2031 CUM. ESALS = 6,597,000
VT. RTE. 4A - VT. 22A 2011 ADT = 3500 2011 DHV = 450 2021 ADT = 3800 2021 DHV = 490 2011 - 2021 CUM. ESALS = 2,291,000 2011 - 2031 CUM. ESALS = 5,130,000	VT. RTE. 4A - VT. 22A 2011 ADT = 3550 2011 DHV = 490 2021 ADT = 3800 2021 DHV = 530 2010 - 2020 CUM. ESALS = 2,325,000 2011 - 2031 CUM. ESALS = 5,213,000
VT. RTE. 22A - FSH 2011 ADT = 3100 2011 DHV = 400 2021 ADT = 3300 2021 DHV = 430 2011 - 2021 CUM. ESALS = 1,334,000 2011 - 2031 CUM. ESALS = 3,152,000	VT. RTE. 22A - FSH 2011 ADT = 3100 2011 DHV = 430 2021 ADT = 3300 2021 DHV = 460 2010 - 2020 CUM. ESALS = 4,132,000 2011 - 2031 CUM. ESALS = 13,802,000
FSH - VT. RTE. 30 2011 ADT = 4000 2011 DHV = 520 2021 ADT = 4300 2021 DHV = 550 2011 - 2021 CUM. ESALS = 1,690,000 2011 - 2031 CUM. ESALS = 3,648,000	FSH - VT. RTE. 30 2011 ADT = 4000 2011 DHV = 560 2021 ADT = 4300 2021 DHV = 600 2011 - 2021 CUM. ESALS = 2,292,000 2011 - 2031 CUM. ESALS = 4,799,000
VT. RTE. 30 - CSH 2011 ADT = 5700 2011 DHV = 740 2021 ADT = 6000 2021 DHV = 770 2011 - 2021 CUM. ESALS = 2,014,000 2011 - 2031 CUM. ESALS = 4,851,000	VT. RTE. 30 - CSH 2011 ADT = 5700 2011 DHV = 790 2021 ADT = 6000 2021 DHV = 830 2011 - 2021 CUM. ESALS = 1,466,000 2011 - 2031 CUM. ESALS = 3,500,000
CSH - BR US 4 2011 ADT = 6800 2011 DHV = 730 2021 ADT = 7400 2021 DHV = 800 2011 - 2021 CUM. ESALS = 1,759,000 2011 - 2031 CUM. ESALS = 4,261,000	CSH - BR US 4 2011 ADT = 6800 2011 DHV = 830 2021 ADT = 7400 2021 DHV = 900 2011 - 2021 CUM. ESALS = 2,423,000 2011 - 2031 CUM. ESALS = 5,951,000
BR US 4 - US 7 2011 ADT = 5100 2011 DHV = 550 2021 ADT = 5600 2021 DHV = 600 2011 - 2021 CUM. ESALS = 1,583,000 2011 - 2031 CUM. ESALS = 3,848,000	BR US 4 - US 7 2011 ADT = 5100 2011 DHV = 620 2021 ADT = 5600 2021 DHV = 680 2011 - 2021 CUM. ESALS = 1,928,000 2011 - 2031 CUM. ESALS = 4,687,000

THESE PLANS ARE SUBJECT TO SUCH ENGINEERING CHANGES AS MAY BE REQUIRED BY THE FEDERAL HIGHWAY ADMINISTRATION OR THE DIRECTOR OF PROGRAM DEVELOPMENT.

CONSTRUCTION IS TO BE CARRIED ON IN ACCORDANCE WITH THESE PLANS AND THE STANDARD SPECIFICATIONS FOR CONSTRUCTION DATED 2006, AS APPROVED BY THE FEDERAL HIGHWAY ADMINISTRATION ON JUNE 15, 2006 FOR USE ON THIS PROJECT, INCLUDING ALL SUBSEQUENT REVISIONS AND SUCH REVISED SPECIFICATIONS AND SPECIAL PROVISIONS AS ARE INCORPORATED IN THESE PLANS.

DIRECTOR OF PROGRAM DEVELOPMENT	APPROVED <u>Michael Fowler</u> DATE <u>5/1/11</u>
PROJECT MANAGER : MICHAEL FOWLER, P.E.	
PROJECT NAME : FAIR HAVEN - RUTLAND	
PROJECT NUMBER : NH SURF (22)	
SHEET 1 OF 24 SHEETS	

NOTES:

1. IF IT IS DETERMINED IN AREAS ALONG THE BASE OF THE GUARDRAIL THAT WINTER SAND AND OTHER DEBRIS HAS ACCUMULATED SUFFICIENTLY TO AFFECT PROPER CRACK-SEALING AND RELATED PATCHING AND POTHOLE REPAIR TREATMENTS, THIS MATERIAL SHALL BE REMOVED PRIOR TO CRACK-SEALING, PATCHING, AND POTHOLE REPAIR AS DIRECTED BY THE RESIDENT ENGINEER. AN ESTIMATED QUANTITY FOR ITEM 203.40 SHOULDER BERM REMOVAL HAS BEEN INCLUDED TO COVER THE COSTS ASSOCIATED WITH THIS WORK.

2. ALL EXISTING PAVEMENT MARKINGS SHALL BE REMOVED PRIOR TO APPLYING THE THIN BITUMINOUS SURFACE TREATMENT. PAVEMENT MARKINGS SHALL BE REMOVED PRIOR TO ANY CRACK SEALING BEING PERFORMED. ALL LANE DELINEATION IS TO BE MAINTAINED DURING CONSTRUCTION BY THE USE OF LINE STRIPING TARGETS OR TEMPORARY PAINT.

3. TWO (2) APPLICATIONS OF FINAL PAVEMENT MARKINGS WILL BE REQUIRED FOR THIS TREATMENT. THE FIRST APPLICATION WILL BE IMMEDIATELY FOLLOWING PLACEMENT OF THE SURFACE TREATMENT, AS DIRECTED BY THE RESIDENT ENGINEER. THE SECOND AND FINAL APPLICATION WILL BE APPLIED NO SOONER THAN 15 SEPTEMBER 2012, AND NO LATER THAN 12 OCTOBER 2012.

4. THERE ARE WEIGH-IN-MOTION SENSORS IN THE PAVEMENT AT MM 1.00 EASTBOUND AND WESTBOUND THAT MAY BE IMPACTED BY CONSTRUCTION ACTIVITIES. INSTALLATION OF NEW SENSORS WILL BE PERFORMED BY OTHERS FOLLOWING COMPLETION OF THE PROJECT. THE RESIDENT ENGINEER IS TO CONTACT DAVE GOSSELIN @ 802.828.2694 PRIOR TO PLACEMENT OF THE SURFACE TREATMENT.

5. THERE IS AN RWIS INSTALLATION AT MM 0.25 WITH SURFACE SENSORS LOCATED IN THE EASTBOUND BARREL OF THE PROJECT. THE CONTRACTOR IS TO AVOID DAMAGING THE SENSORS. THE SENSORS ARE TO BE REMOVED BY THE CONTRACTOR PRIOR TO CONSTRUCTION ACTIVITIES AT THIS LOCATION. PAYMENT WILL NOT BE MADE DIRECTLY, BUT WILL BE CONSIDERED INCIDENTAL TO THE SURFACE TREATMENT ITEM. REINSTALLATION IS TO BE DONE BY OTHERS. THE RESIDENT ENGINEER IS TO CONTACT MARK GERRISH @ 802.828.2834.

5. OUT OF PROJECT LIMITS
AT ~ MM 0.025

6. ALL NECESSARY SURFACE PREPARATION INVOLVING PATCHING, POTHOLE REPAIR, AND CRACK SEALING SHALL BE PERFORMED PRIOR TO PAVING. ALL CRACKS GREATER THAN 0.20" AND UP TO 1.0" IN WIDTH SHALL BE SEALED USING THE "BLOW AND GO" METHOD. ALL COSTS ASSOCIATED WITH THIS WORK SHALL BE PAID UNDER ITEM 417.20 BITUMINOUS CRACK SEALING, "BLOW AND GO" METHOD. STRIKE OFF OF EXCESS MATERIAL MAY BE ACCOMPLISHED WITH A SQUEEGEE. THE PATCHING OF ALL CRACKS GREATER THAN 1.0" AND ALL OTHER PATCHING AND POTHOLE REPAIR SHALL BE COMPLETED WITH BITUMINOUS CONCRETE PAVEMENT TYPE IV OR TYPE V, OR SUPERPAVE BITUMINOUS CONCRETE PAVEMENT TYPE IVS OR TYPE VS AS DIRECTED BY THE RESIDENT ENGINEER. AN ESTIMATED QUANTITY OF ITEM 900.680 SPECIAL PROVISION (BITUMINOUS CONCRETE PAVEMENT SURFACE PREPARATION, TYPE I) HAS BEEN INCLUDED TO COVER ALL COSTS ASSOCIATED WITH THIS WORK.

7. A 50' COLD PLANED WEDGE SHALL BE CONSTRUCTED AT THE PROJECT BEGIN AND END, RAMPS, BRIDGE APPROACHES, AND RAILROAD CROSSING. THE LONGITUDINAL EDGES OF THE SURFACE TREATMENT SHALL BE TAPERED AS SHOWN ON THE TYPICAL SECTION, OR AS DIRECTED BY THE RESIDENT ENGINEER. ANY SAW CUTTING AT BUTT JOINTS WILL NOT BE MADE DIRECTLY, BUT WILL BE CONSIDERED INCIDENTAL TO ITEM 210.10, COLD PLANING, BITUMINOUS PAVEMENT.

8. FOLLOWING COMPLETION OF COLD PLANING, THE MILLED SURFACE FOR ALL BRIDGES SHALL ALSO RECEIVE CRACK-SEALING AND RELATED PATCHING AND POTHOLE REPAIR TREATMENTS, AS DIRECTED BY THE RESIDENT ENGINEER.

9. THE GYRATION SPECIFICATION FOR THE SPECIAL PROVISION (6.3 MM POLYMER-MODIFIED BITUMINOUS CONCRETE PAVEMENT) SHALL BE 65.

10. EXISTING SHOULDER PAVEMENT SURFACES BEYOND THE LIMITS OF THE THIN BITUMINOUS SURFACE TREATMENT SHALL ALSO RECEIVE CRACK-SEALING AND RELATED PATCHING AND POTHOLE REPAIR TREATMENTS.

BRIDGE TREATMENT EASTBOUND BARREL

BR. NO. 3-E, MM 0.721 PL. GIRD. (COLD PLANE 1.0" THEN PAVE WITH THIN BITUMINOUS SURFACE TREATMENT).
BR. NO. 8-E, MM 4.148 PL. GIRD. (COLD PLANE 1.0" THEN PAVE WITH THIN BITUMINOUS SURFACE TREATMENT).
BR. NO. 10-E, MM 5.449 PL. GIRD. (COLD PLANE 1.0" THEN PAVE WITH THIN BITUMINOUS SURFACE TREATMENT).
BR. NO. 13-E, MM 12.952 WF BEAM (COLD PLANE 1.0" THEN PAVE WITH THIN BITUMINOUS SURFACE TREATMENT).
BR. NO. 14-E, MM 13.067 WF BEAM (COLD PLANE 1.0" THEN PAVE WITH THIN BITUMINOUS SURFACE TREATMENT).
BR. NO. 15-E, MM 14.522 W BEAM (COLD PLANE 1.0" THEN PAVE WITH THIN BITUMINOUS SURFACE TREATMENT).
BR. NO. 16-E, MM 14.899 COMP. GIRD. (COLD PLANE 1.0" THEN PAVE WITH THIN BITUMINOUS SURFACE TREATMENT).
BR. NO. 19-E, MM 17.578 PL. GIRD. (COLD PLANE 1.0" THEN PAVE WITH THIN BITUMINOUS SURFACE TREATMENT).
BR. NO. 20-E, MM 17.839 PL. GIRD. (COLD PLANE 1.0" THEN PAVE WITH THIN BITUMINOUS SURFACE TREATMENT).

BRIDGE TREATMENT WESTBOUND BARREL

BR. NO. 3-W, MM 0.721 PL. GIRD. (COLD PLANE 1.0" THEN PAVE WITH THIN BITUMINOUS SURFACE TREATMENT).
BR. NO. 8-W, MM 4.148 PL. GIRD. (COLD PLANE 1.0" THEN PAVE WITH THIN BITUMINOUS SURFACE TREATMENT).
BR. NO. 10-W, MM 5.449 PL. GIRD. (COLD PLANE 1.0" THEN PAVE WITH THIN BITUMINOUS SURFACE TREATMENT).
BR. NO. 13-W, MM 12.952 WF BEAM (COLD PLANE 1.0" THEN PAVE WITH THIN BITUMINOUS SURFACE TREATMENT).
BR. NO. 14-W, MM 13.067 WF BEAM (COLD PLANE 1.0" THEN PAVE WITH THIN BITUMINOUS SURFACE TREATMENT).
BR. NO. 15-W, MM 14.522 W BEAM (COLD PLANE 1.0" THEN PAVE WITH THIN BITUMINOUS SURFACE TREATMENT).
BR. NO. 16-W, MM 14.899 COMP. GIRD. (COLD PLANE 1.0" THEN PAVE WITH THIN BITUMINOUS SURFACE TREATMENT).
BR. NO. 19-W, MM 17.578 PL. GIRD. (COLD PLANE 1.0" THEN PAVE WITH THIN BITUMINOUS SURFACE TREATMENT).
BR. NO. 20-W, MM 17.839 PL. GIRD. (COLD PLANE 1.0" THEN PAVE WITH THIN BITUMINOUS SURFACE TREATMENT).

BRIDGE TREATMENT WESTBOUND

20 W: NO TREATMENT
19 W: 1" MILL, 1" FILL THEN TAPER TO ¾"
16 W: 1" MILL, 1" FILL THEN TAPER TO ¾"
15 W: 1" MILL, 1" FILL THEN TAPER TO ¾"
14 W: NO TREATMENT
13 W: NO TREATMENT
10 W: NO TREATMENT
8 W: 1" MILL, 1" FILL THEN TAPER TO ¾"
5 W: 1" MILL, 1" FILL THEN TAPER TO ¾"
3 W: NO TREATMENT


BRIDGE TREATMENT EAST BOUND

20 E: NO TREATMENT
19 E: NO TREATMENT
16 E: NO TREATMENT
15 E: 1" MILL, 1" FILL THEN TAPER TO ¾"
14 E: 1" MILL, 1" FILL THEN TAPER TO ¾"
13 E: 1" MILL, 1" FILL THEN TAPER TO ¾"
10 E: 1" MILL, 1" FILL THEN TAPER TO ¾"
8 E: 1" MILL, 1" FILL THEN TAPER TO ¾"
5 E: 1" MILL, 1" FILL THEN TAPER TO ¾"
3 E: NO TREATMENT


PROJECT
NOTES
SHEET

PROJECT NAME: FAIR HAVEN-RUTLAND TOWN
PROJECT NUMBER: NH SURF (22)

FILE NAME: 10b106\10b106.dgn
PROJECT LEADER: M. FOWLER
DESIGNED BY: PVT. MGT.
IPARM FILE NAME: 10B106#2.1
PLOT DATE: 31-MAY-2013 11:55
DRAWN BY: PVT. MGT.
CHECKED BY: PVMT MGMT
SHEET 2 OF 24

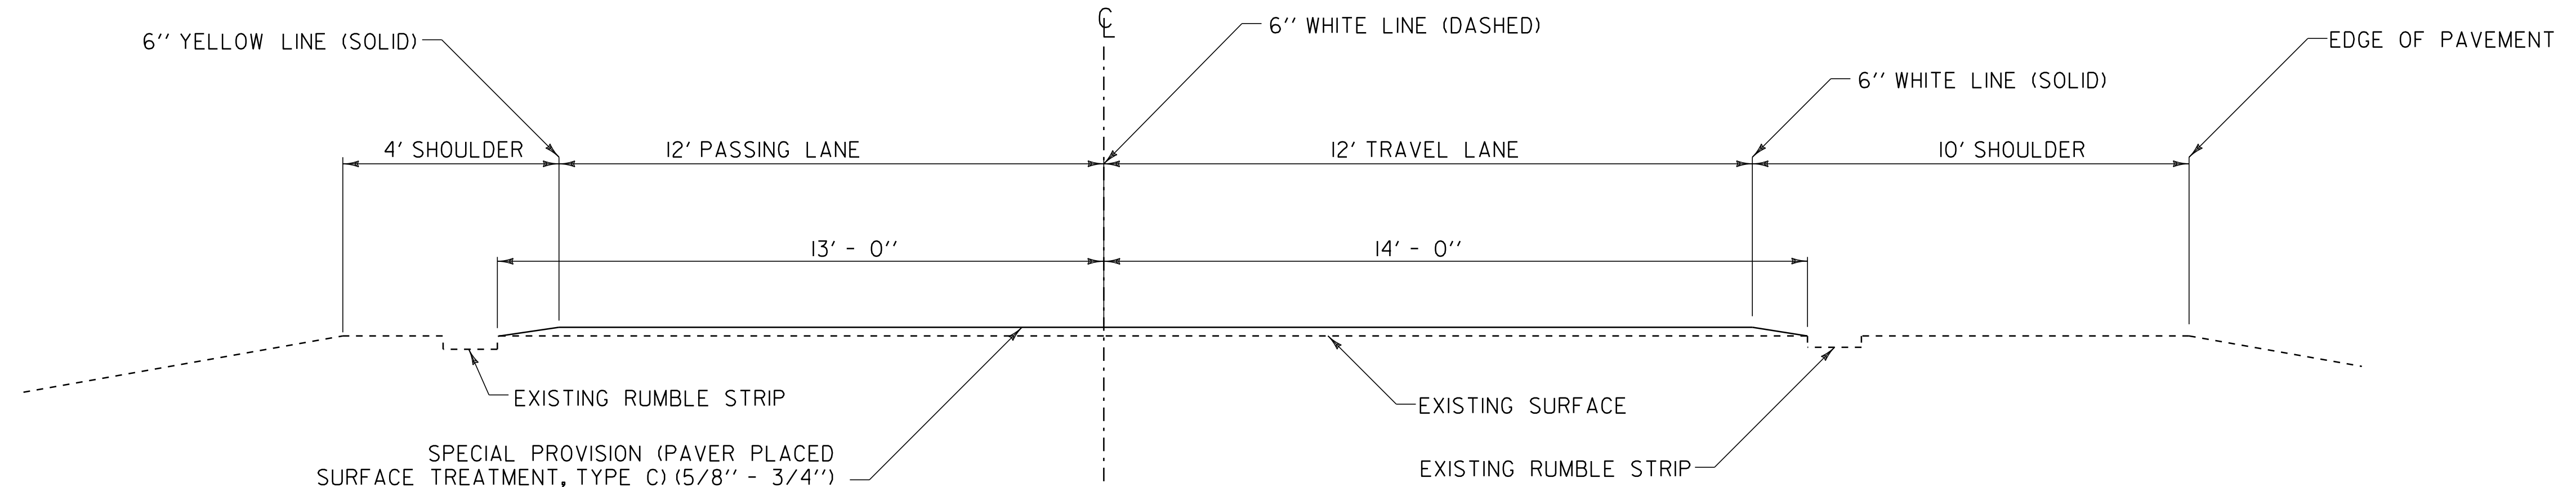


TYPICAL SECTION - ALTERNATE A
PAVER PLACED SURFACE TREATMENT TYPE C
US RTE. 4 EASTBOUND MM ~~0.195~~ ^{0.190} - MM 18.805
US RTE. 4 WESTBOUND MM ~~0.594~~ ^{0.578} - MM 18.805


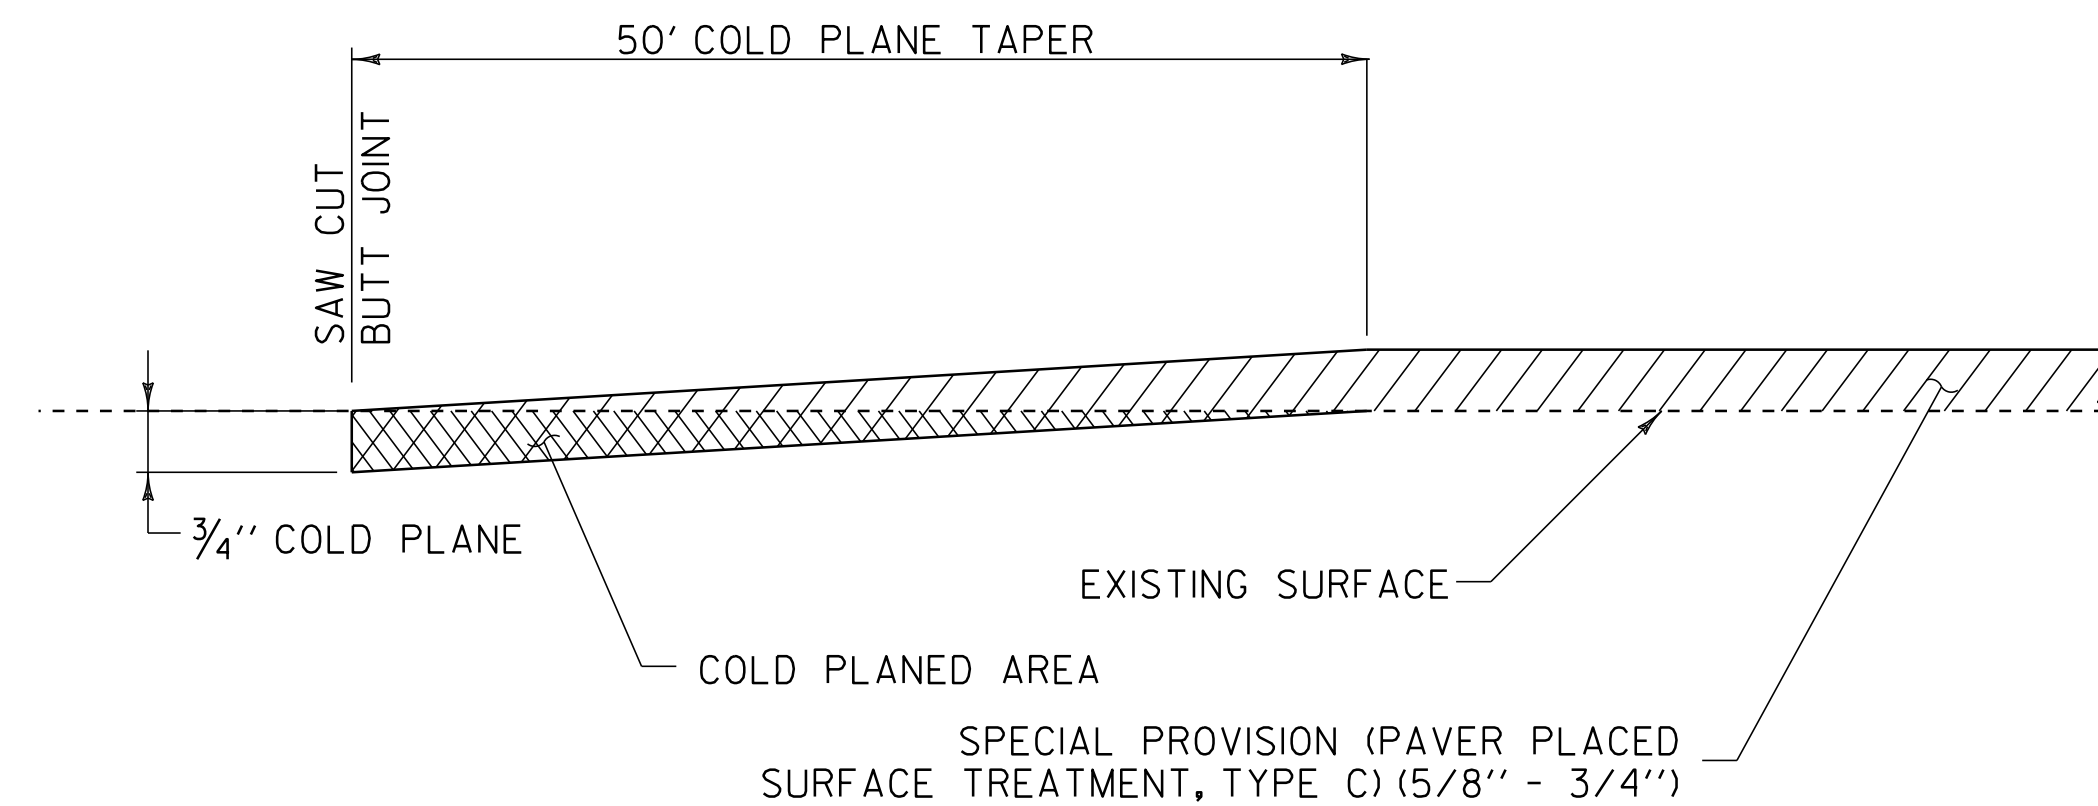


COLD PLANE DETAIL AT BEGIN/END PROJECT & RAMPS

NOTES:
1. SURFACE PREPARATION IS REQUIRED ON ALL RAMPS.

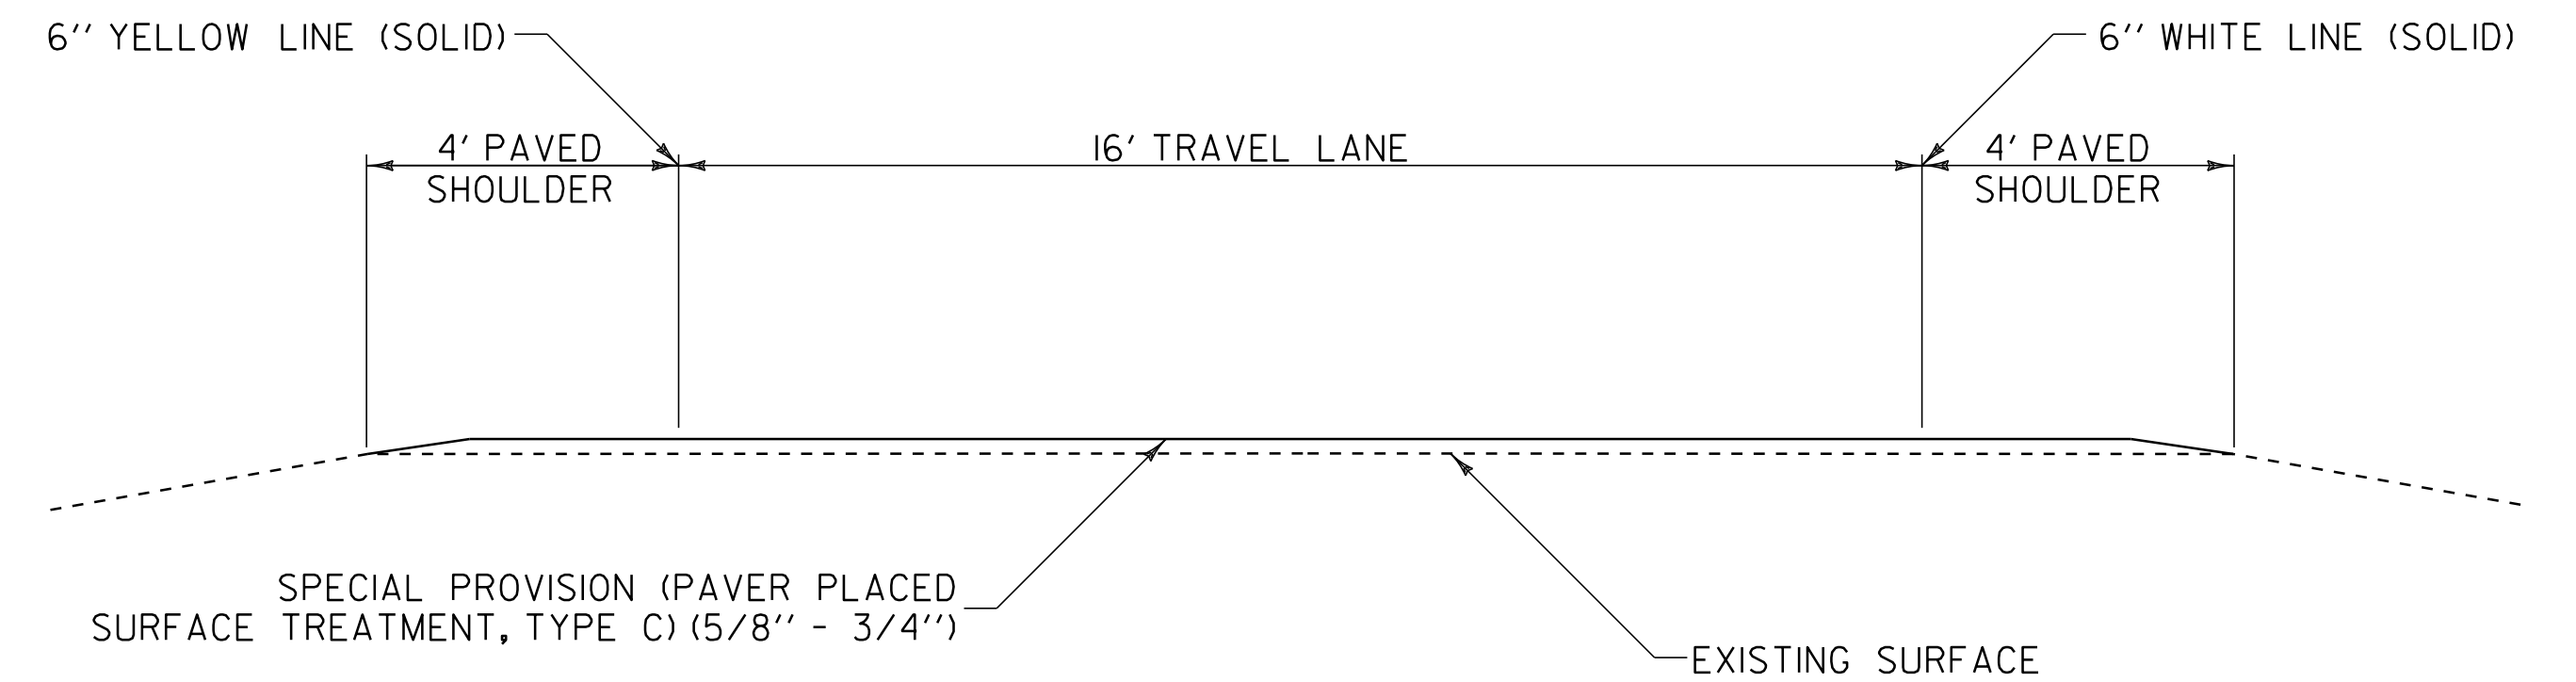

TYPICAL RAMP SECTION

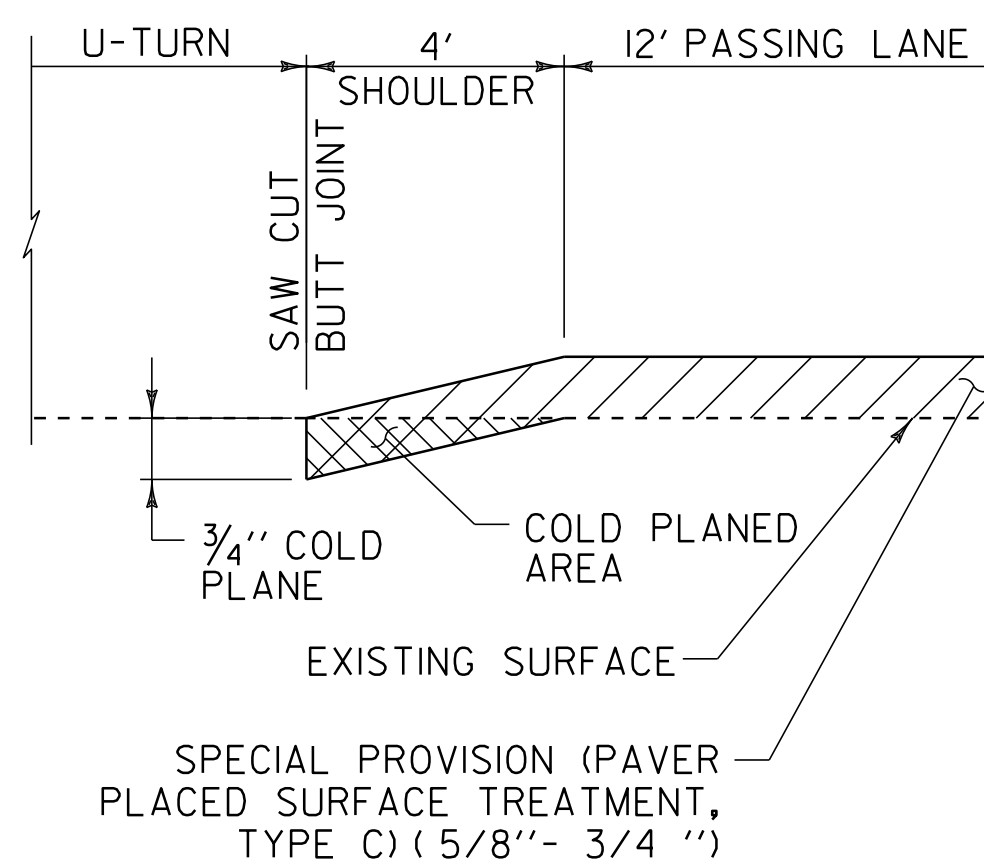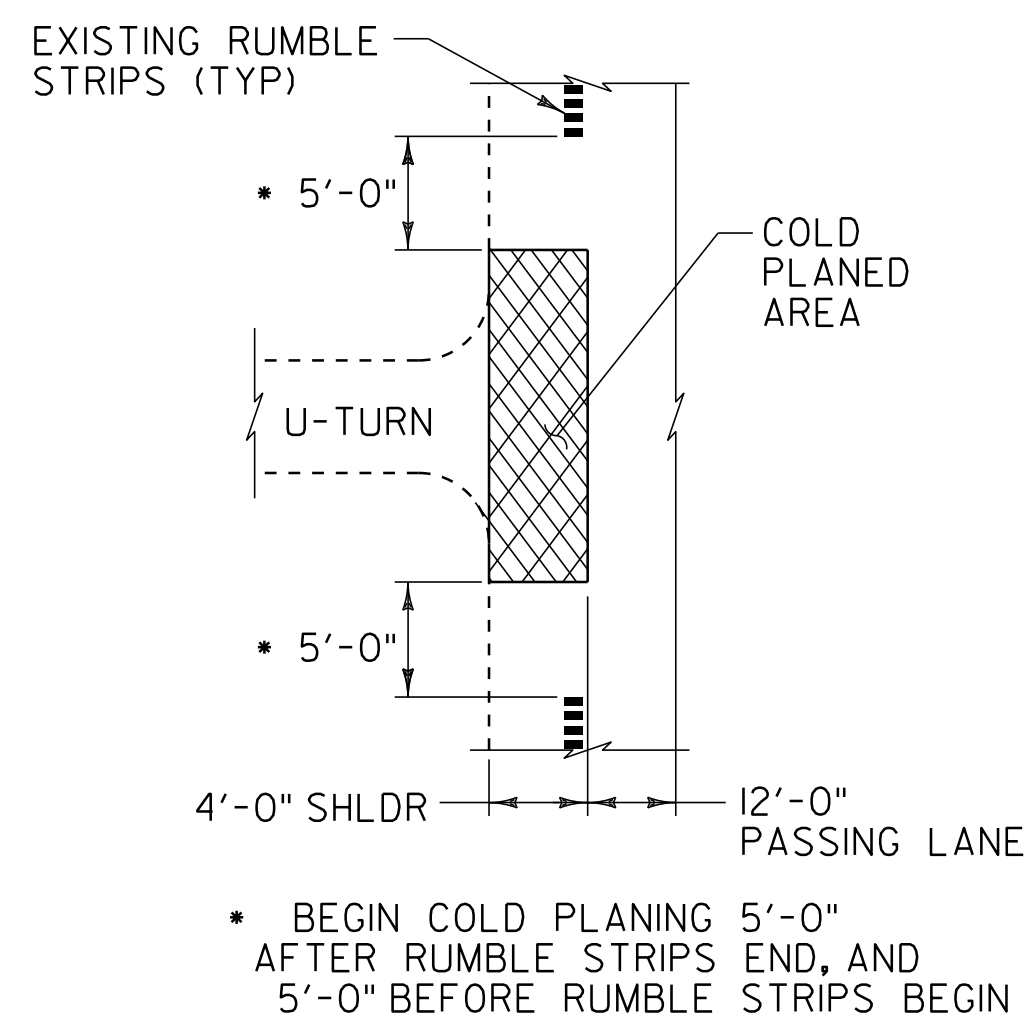

COLD PLANE DETAIL AT U-TURNS

NOT TO SCALE


**ALTERNATE A
TYPICAL
SECTIONS**

PROJECT NAME: FAIR HAVEN-RUTLAND TOWN
PROJECT NUMBER: NH SURF (22)


FILE NAME: 10b106/10b106.dgn
PROJECT LEADER: M. FOWLER
DESIGNED BY: PVT. MGT.
IPARM FILE NAME: 10B106#3.1

PLOT DATE: 31-MAY-2013 11:55
DRAWN BY: PVT. MGT.
CHECKED BY: PVT. MGT.
SHEET 3 OF 24

TYPICAL SECTION

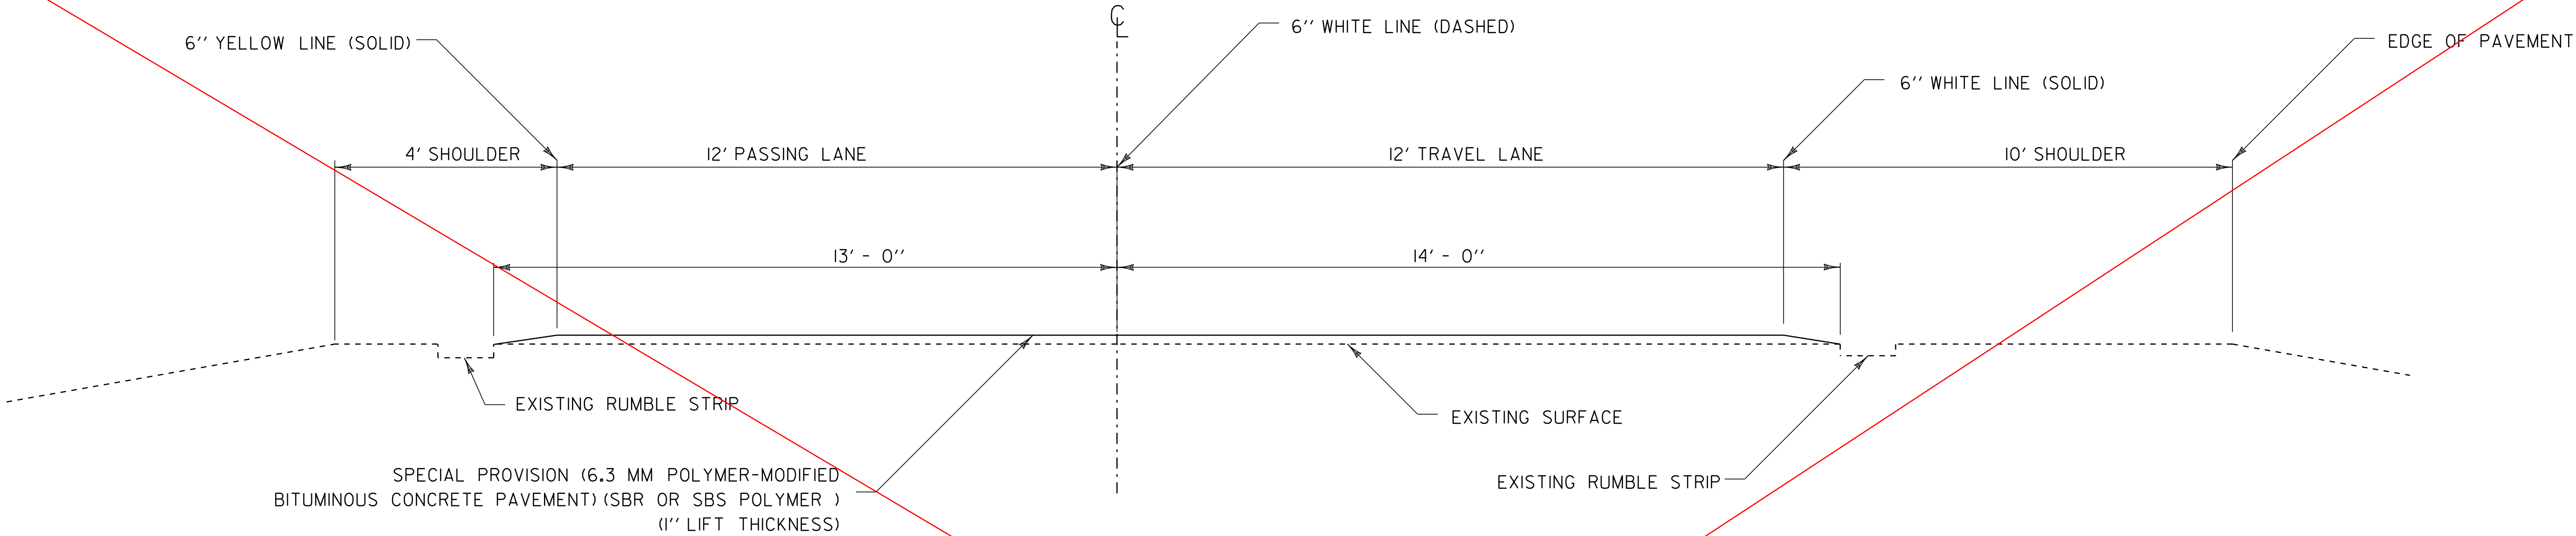


PROJECT TYPICAL SECTION - ALTERNATE B
6.3 MM POLYMER-MODIFIED BITUMINOUS CONCRETE PAVEMENT
US RTE. 4 EASTBOUND MM 0.195 - MM 18.805
US RTE. 4 WESTBOUND MM 0.594 - MM 18.805

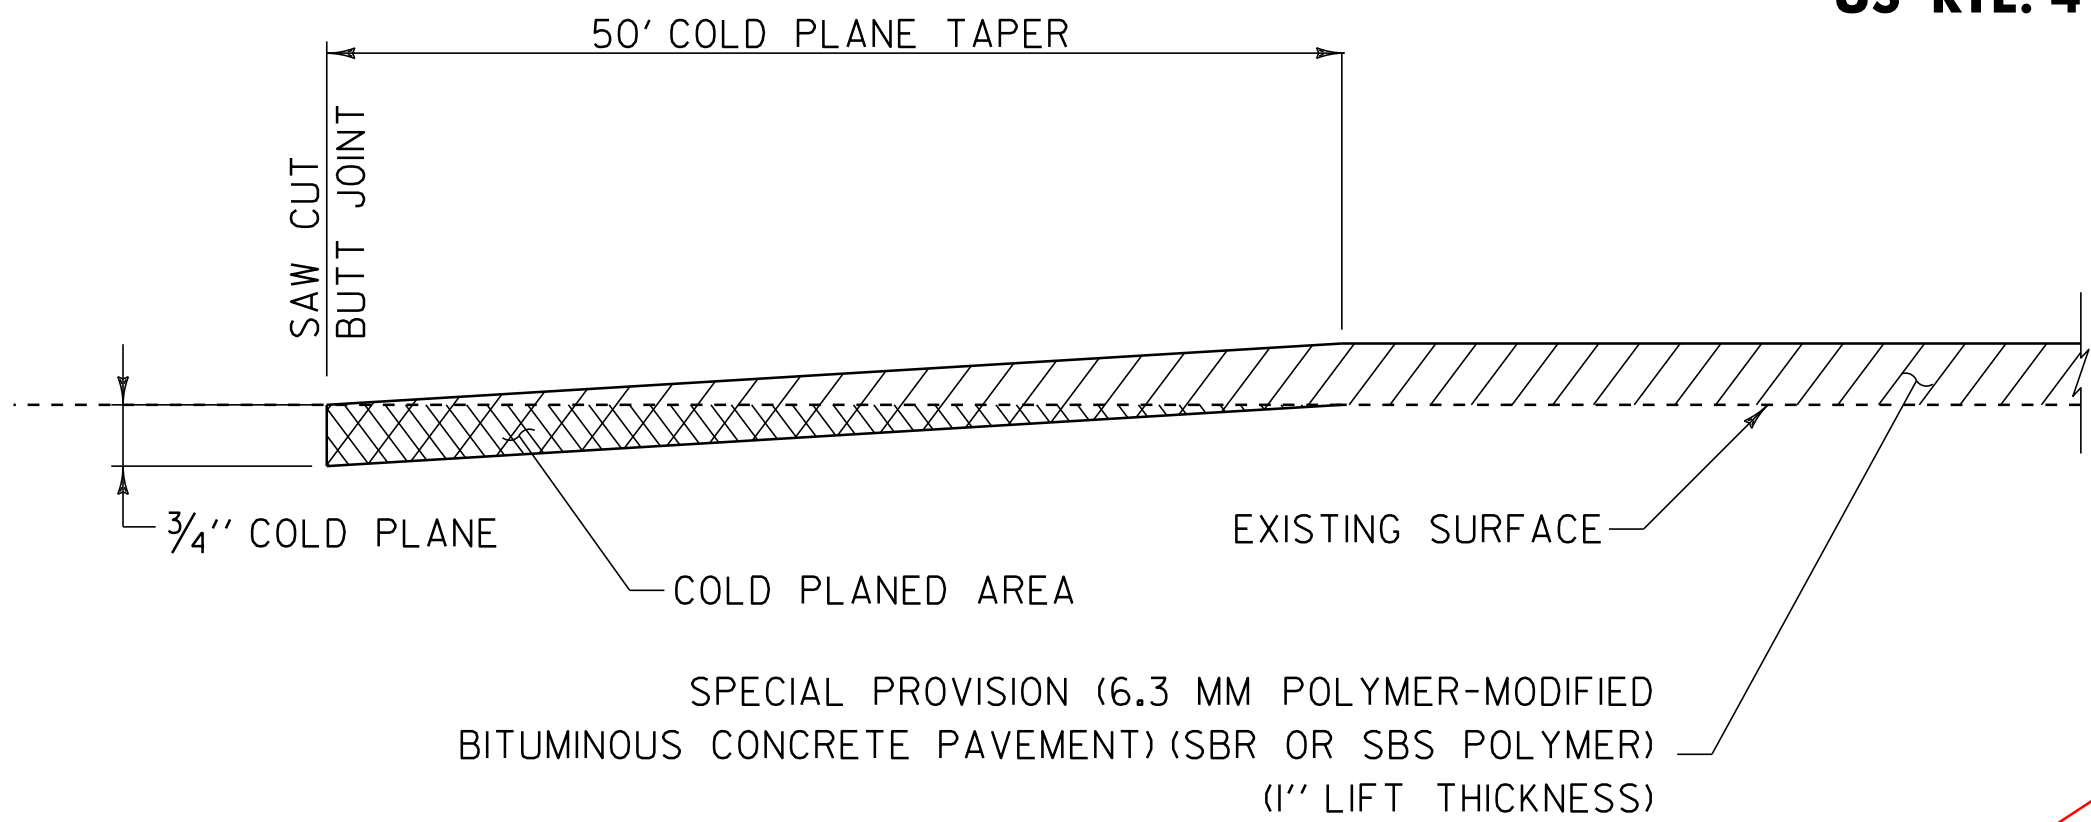


COLD PLANE DETAIL AT BEGIN/END PROJECT & RAMPS

NOTES:
1. SURFACE PREPARATION IS REQUIRED ON ALL RAMPS.

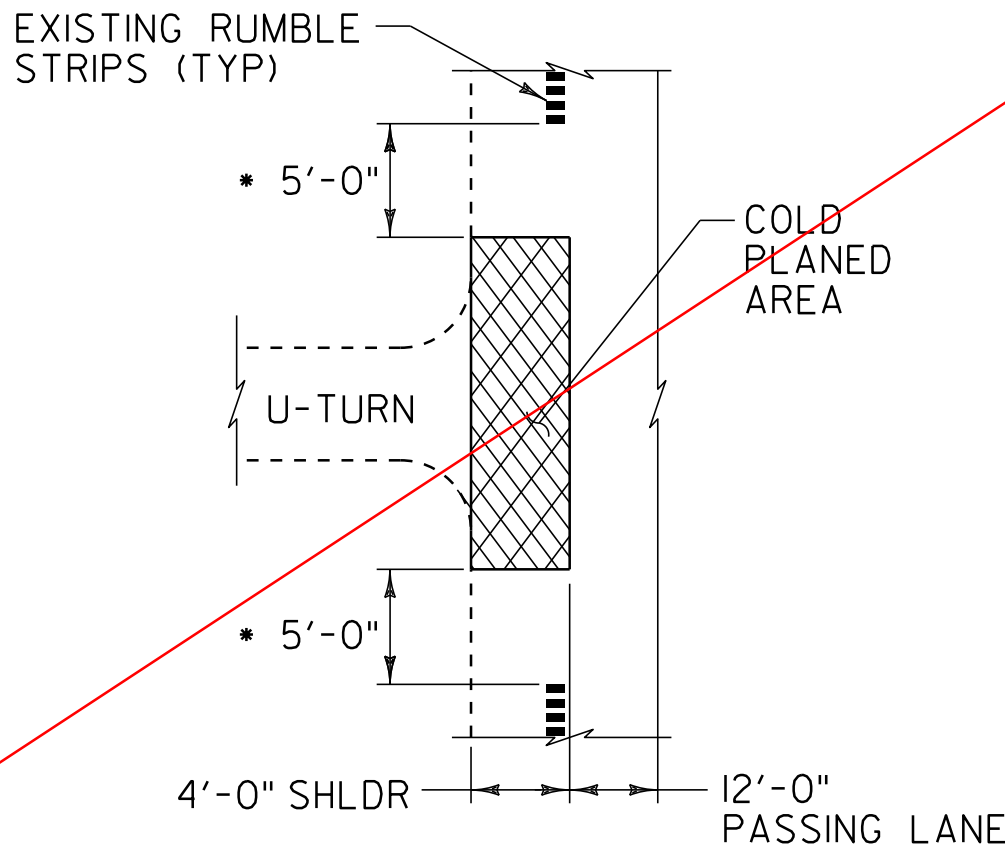


* BEGIN COLD PLANING 5'-0" AFTER RUMBLE STRIPS END, AND 5'-0" BEFORE RUMBLE STRIPS BEGIN

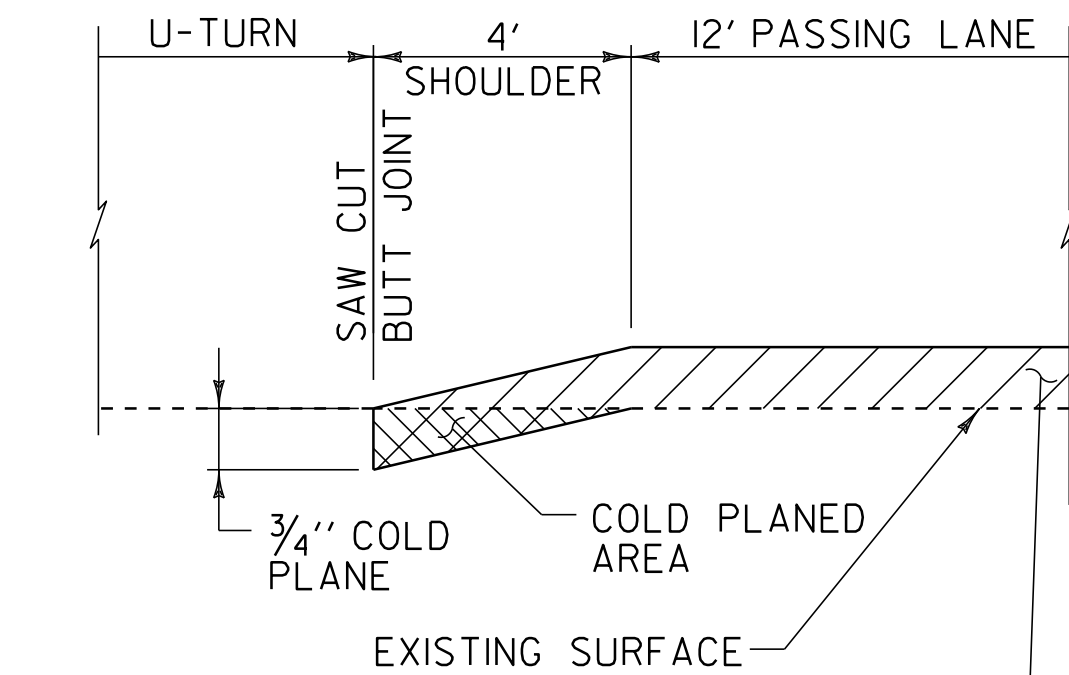

SPECIAL PROVISION (6.3 MM POLYMER-MODIFIED BITUMINOUS CONCRETE PAVEMENT) (SBR OR SBS POLYMER) (1" LIFT THICKNESS)

COLD PLANE DETAIL AT U-TURNS

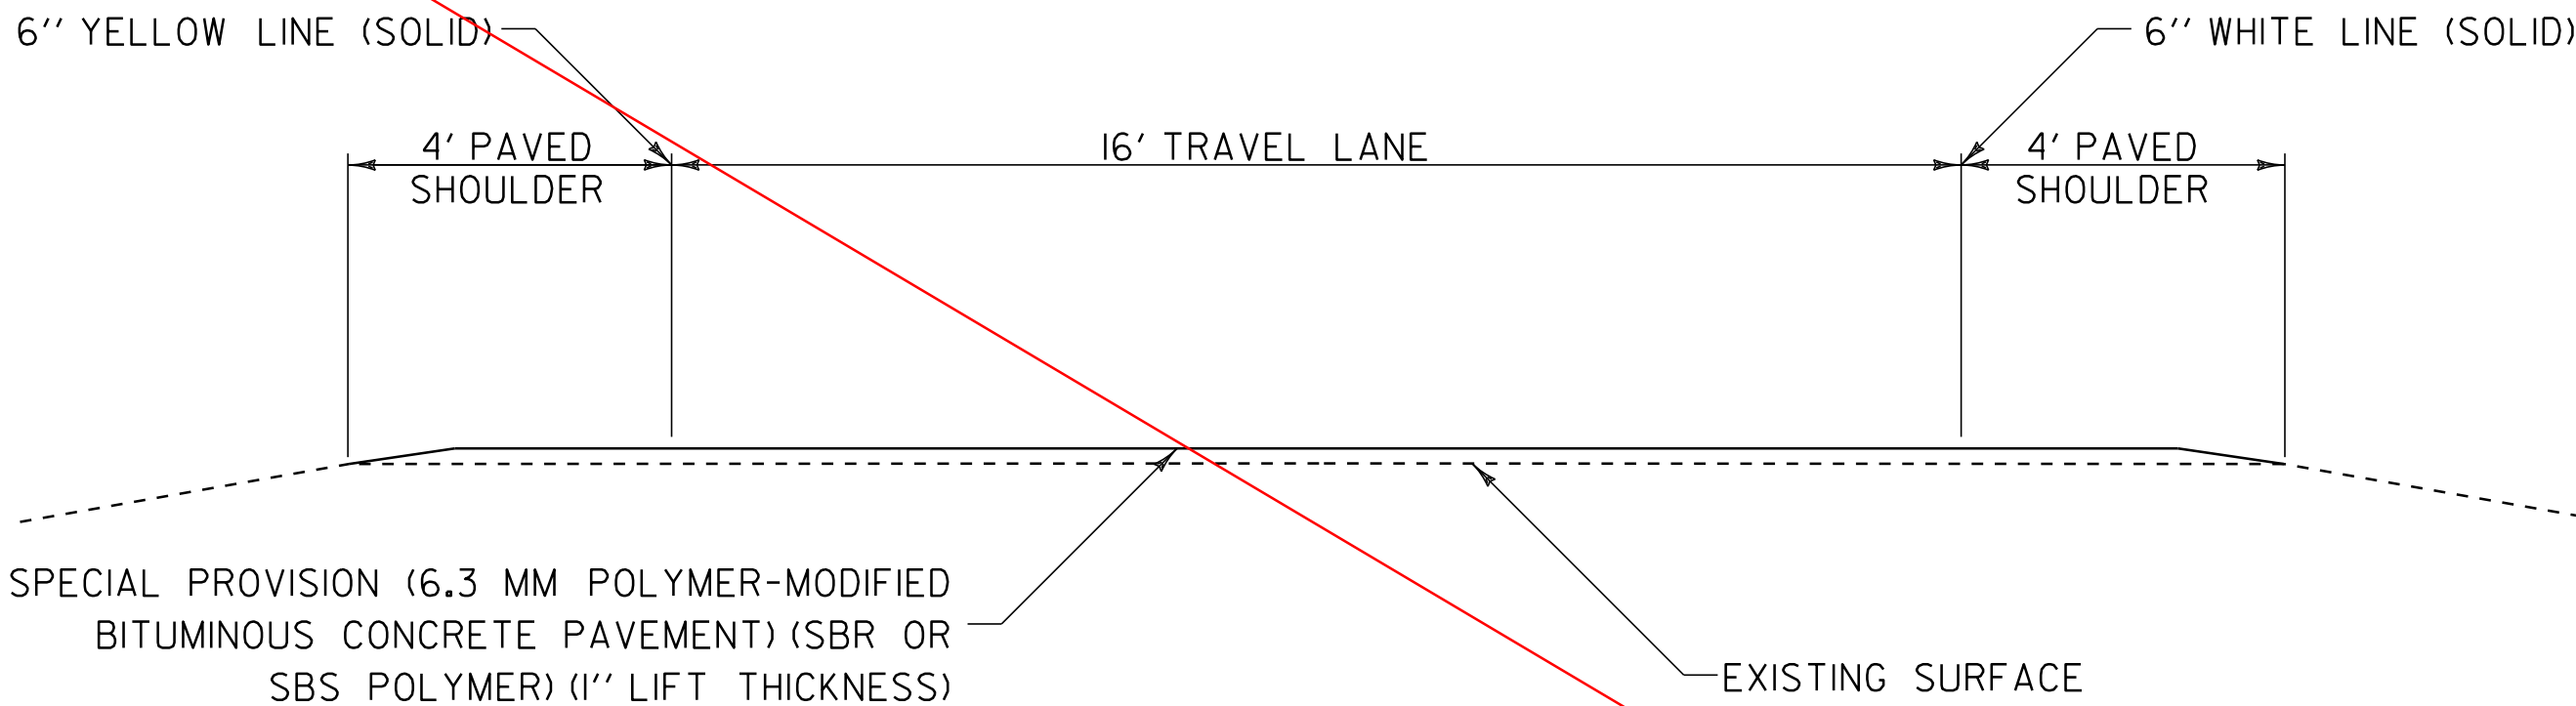

TYPICAL RAMP SECTION

NOTE:
1. PRIOR TO THE PLACEMENT OF THE POLYMER MODIFIED SURFACE TREATMENT, EMULSIFIED ASPHALT SHALL BE APPLIED TO ALL EXISTING PAVEMENT SURFACES AND ON ALL COLD PLANED SURFACES AT A RATE OF 0.080 GAL/SY (+/- 0.01 GAL/SY) OR AS DIRECTED BY THE RESIDENT ENGINEER. EMULSIFIED ASPHALT SHALL BE RS-1H OR CRS-1H PER THE MANUFACTURER'S RECOMMENDATION. THIS SHALL BE PAID UNDER ITEM 900.683 SPECIAL PROVISION (EMULSIFIED ASPHALT) (RS-1H OR CRS-1H).

USED ALTERNATE A

ALTERNATE B
TYPICAL
SECTIONS

NOT TO SCALE

PROJECT NAME: FAIR HAVEN-RUTLAND TOWN	
PROJECT NUMBER: NH SURF(22)	
FILE NAME: I0BI06\I0BI06.dgn	PLOT DATE: 31-MAY-2013 11:55
PROJECT LEADER: M. FOWLER	DRAWN BY: PVT. MGT.
DESIGNED BY: PVT. MGT.	CHECKED BY: PVT. MGT.
I0AI06*4.1	SHEET 4 OF 24

QUANTITY SHEET 1

STATE OF VERMONT
AGENCY OF TRANSPORTATION


SUMMARY OF ESTIMATED QUANTITIES									
	EMPLOYEE TRAINEESHIP	BRIDGE	ROADWAY	FULL C.E.	QUANTITIES GRAND TOTAL	UNIT	ITEMS	ITEM NO.	ROUNDING
							BEGIN ITEMS COMMON TO ALL ALTERNATES		
			110 500		110 500	LF	SHOULDER BERM REMOVAL	203.40	230
			I		I	CY	TRENCH EXCAVATION OF EARTH, EXPLORATORY (N.A.B.I.)	204.22	EST
			26 000		26 000	SY	COLD PLANING, BITUMINOUS PAVEMENT	210.10	396
			I		I	LU	PRICE ADJUSTMENT, ASPHALT CEMENT (N.A.B.I.)	406.50	-
			80 000		80 000	LB	BITUMINOUS CRACK SEALING, "BLOW AND GO" METHOD (AASHTO M 324 (ASTM D 6690)TYPE II)	417.20	395
		1400			1400	LF	BRIDGE EXPANSION JOINT, ASPHALTIC PLUG	516.10	4
		100			100	CF	RAPID SETTING CONCRETE REPAIR MATERIAL WITH COURSE AGGREGATE	580.20	EST
			300		300	HR	POWER BROOM RENTAL, TYPE I	608.30	EST
			2 000		2 000	HR	UNIFORMED TRAFFIC OFFICERS	630.10	EST
			1200		1200	HR	FLAGGERS	630.15	EST
				I	I	LS	FIELD OFFICE, ENGINEERS	631.10	
				I	I	LS	TESTING EQUIPMENT, BITUMINOUS	631.17	-
				3 000	3 000	DL	FIELD OFFICE, TELEPHONE (N.A.B.I.)	631.26	-
	520				520	HR	EMPLOYEE TRAINEESHIP	634.10	-
			I		I	LS	MOBILIZATION/DEMOBILIZATION	635.11	
			I		I	LS	TRAFFIC CONTROL	641.10	
			4		4	EA	PORTABLE CHANGEABLE MESSAGE SIGN	641.15	-
			530 000		530 000	LF	6 INCH WHITE LINE	646.214	2846
			435 000		435 000	LF	6 INCH YELLOW LINE	646.215	4582
			6 000		6 000	LF	12 INCH WHITE LINE	646.24	EST
			350		350	LF	24 INCH STOP BAR	646.26	20
			195		195	EA	LETTER OR SYMBOL	646.30	EST
			4		4	EA	RAILROAD CROSSING SYMBOL	646.32	-
			265 000		265 000	LF	TEMPORARY 6 INCH WHITE LINE	646.620	1423
			220 000		220 000	LF	TEMPORARY 6 INCH YELLOW LINE	646.630	4791
			6 000		6 000	LF	TEMPORARY 12 INCH WHITE LINE	646.660	EST.
			350		350	LF	TEMPORARY 24 INCH STOP BAR	646.680	20
			108		108	EA	TEMPORARY LETTER OR SYMBOL	646.690	EST.
			4		4	EA	TEMPORARY RAILROAD CROSSING SYMBOL	646.710	
			10 250		10 250	EA	LINE STRIPING TARGETS	646.76	33
			241 000		241 000	SF	REMOVAL OF EXISTING PAVEMENT MARKINGS	646.85	550
			I		I	LU	PRICE ADJUSTMENT, FUEL (N.A.B.I.)	690.50	-
			I		I	LU	SPECIAL PROVISION (MAINTENANCE OF RAILROAD TRAFFIC)(N.A.B.I.)	900.650	-
			30		30	TON	SPECIAL PROVISION (BITUMINOUS CONCRETE PAVEMENT SURFACE PREPARATION, TYPE I)	900.680	EST.
							END ITEMS COMMON TO ALL ALTERNATES		

[illegible][illegible]


QUANTITY SHEET 2

STATE OF VERMONT
AGENCY OF TRANSPORTATION

[illegible][illegible][illegible]

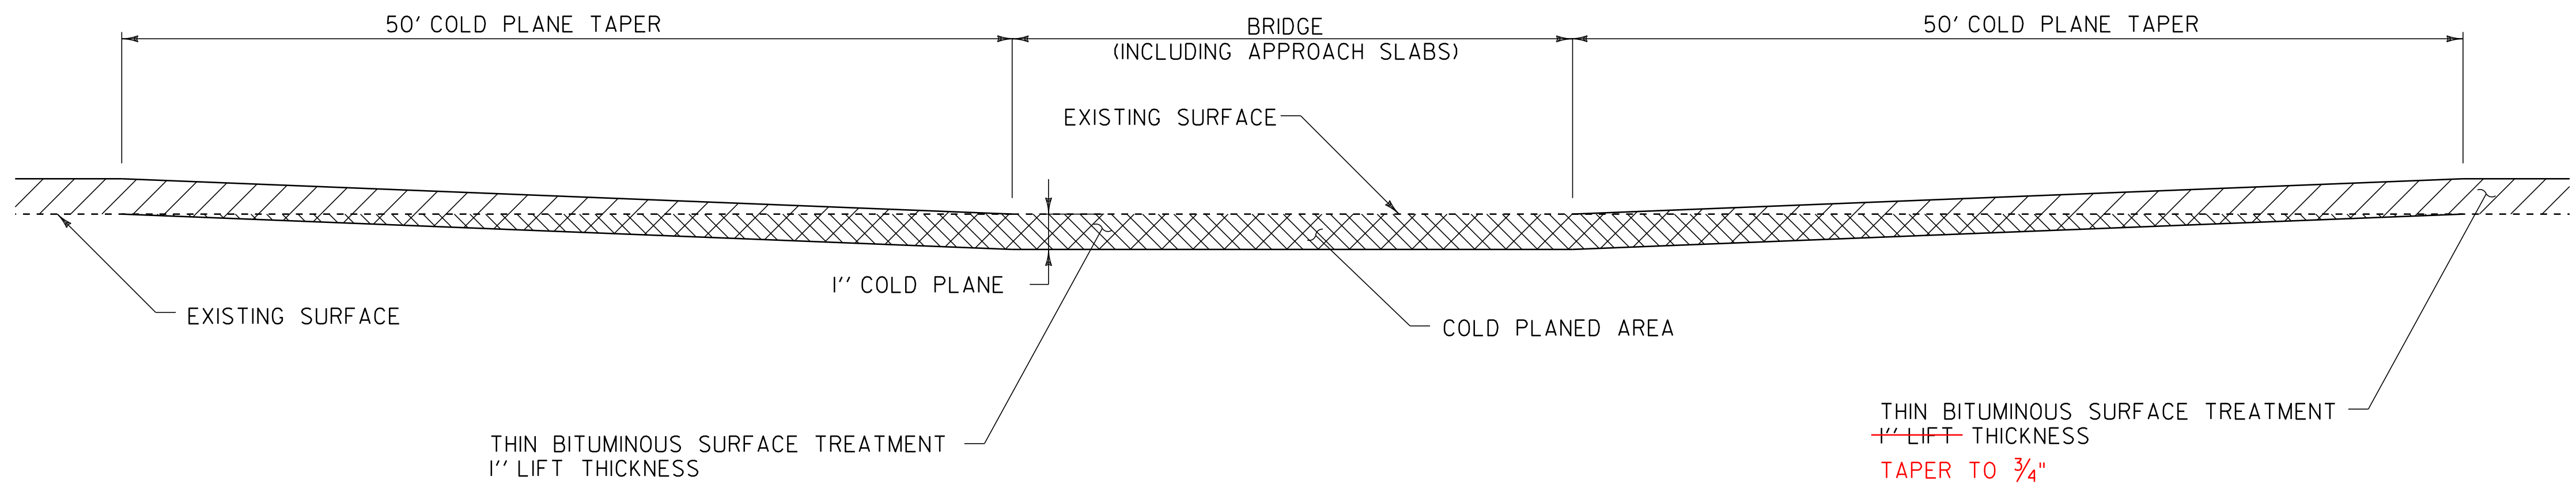

BRIDGE COLD PLANE TYPICAL SECTION A-A

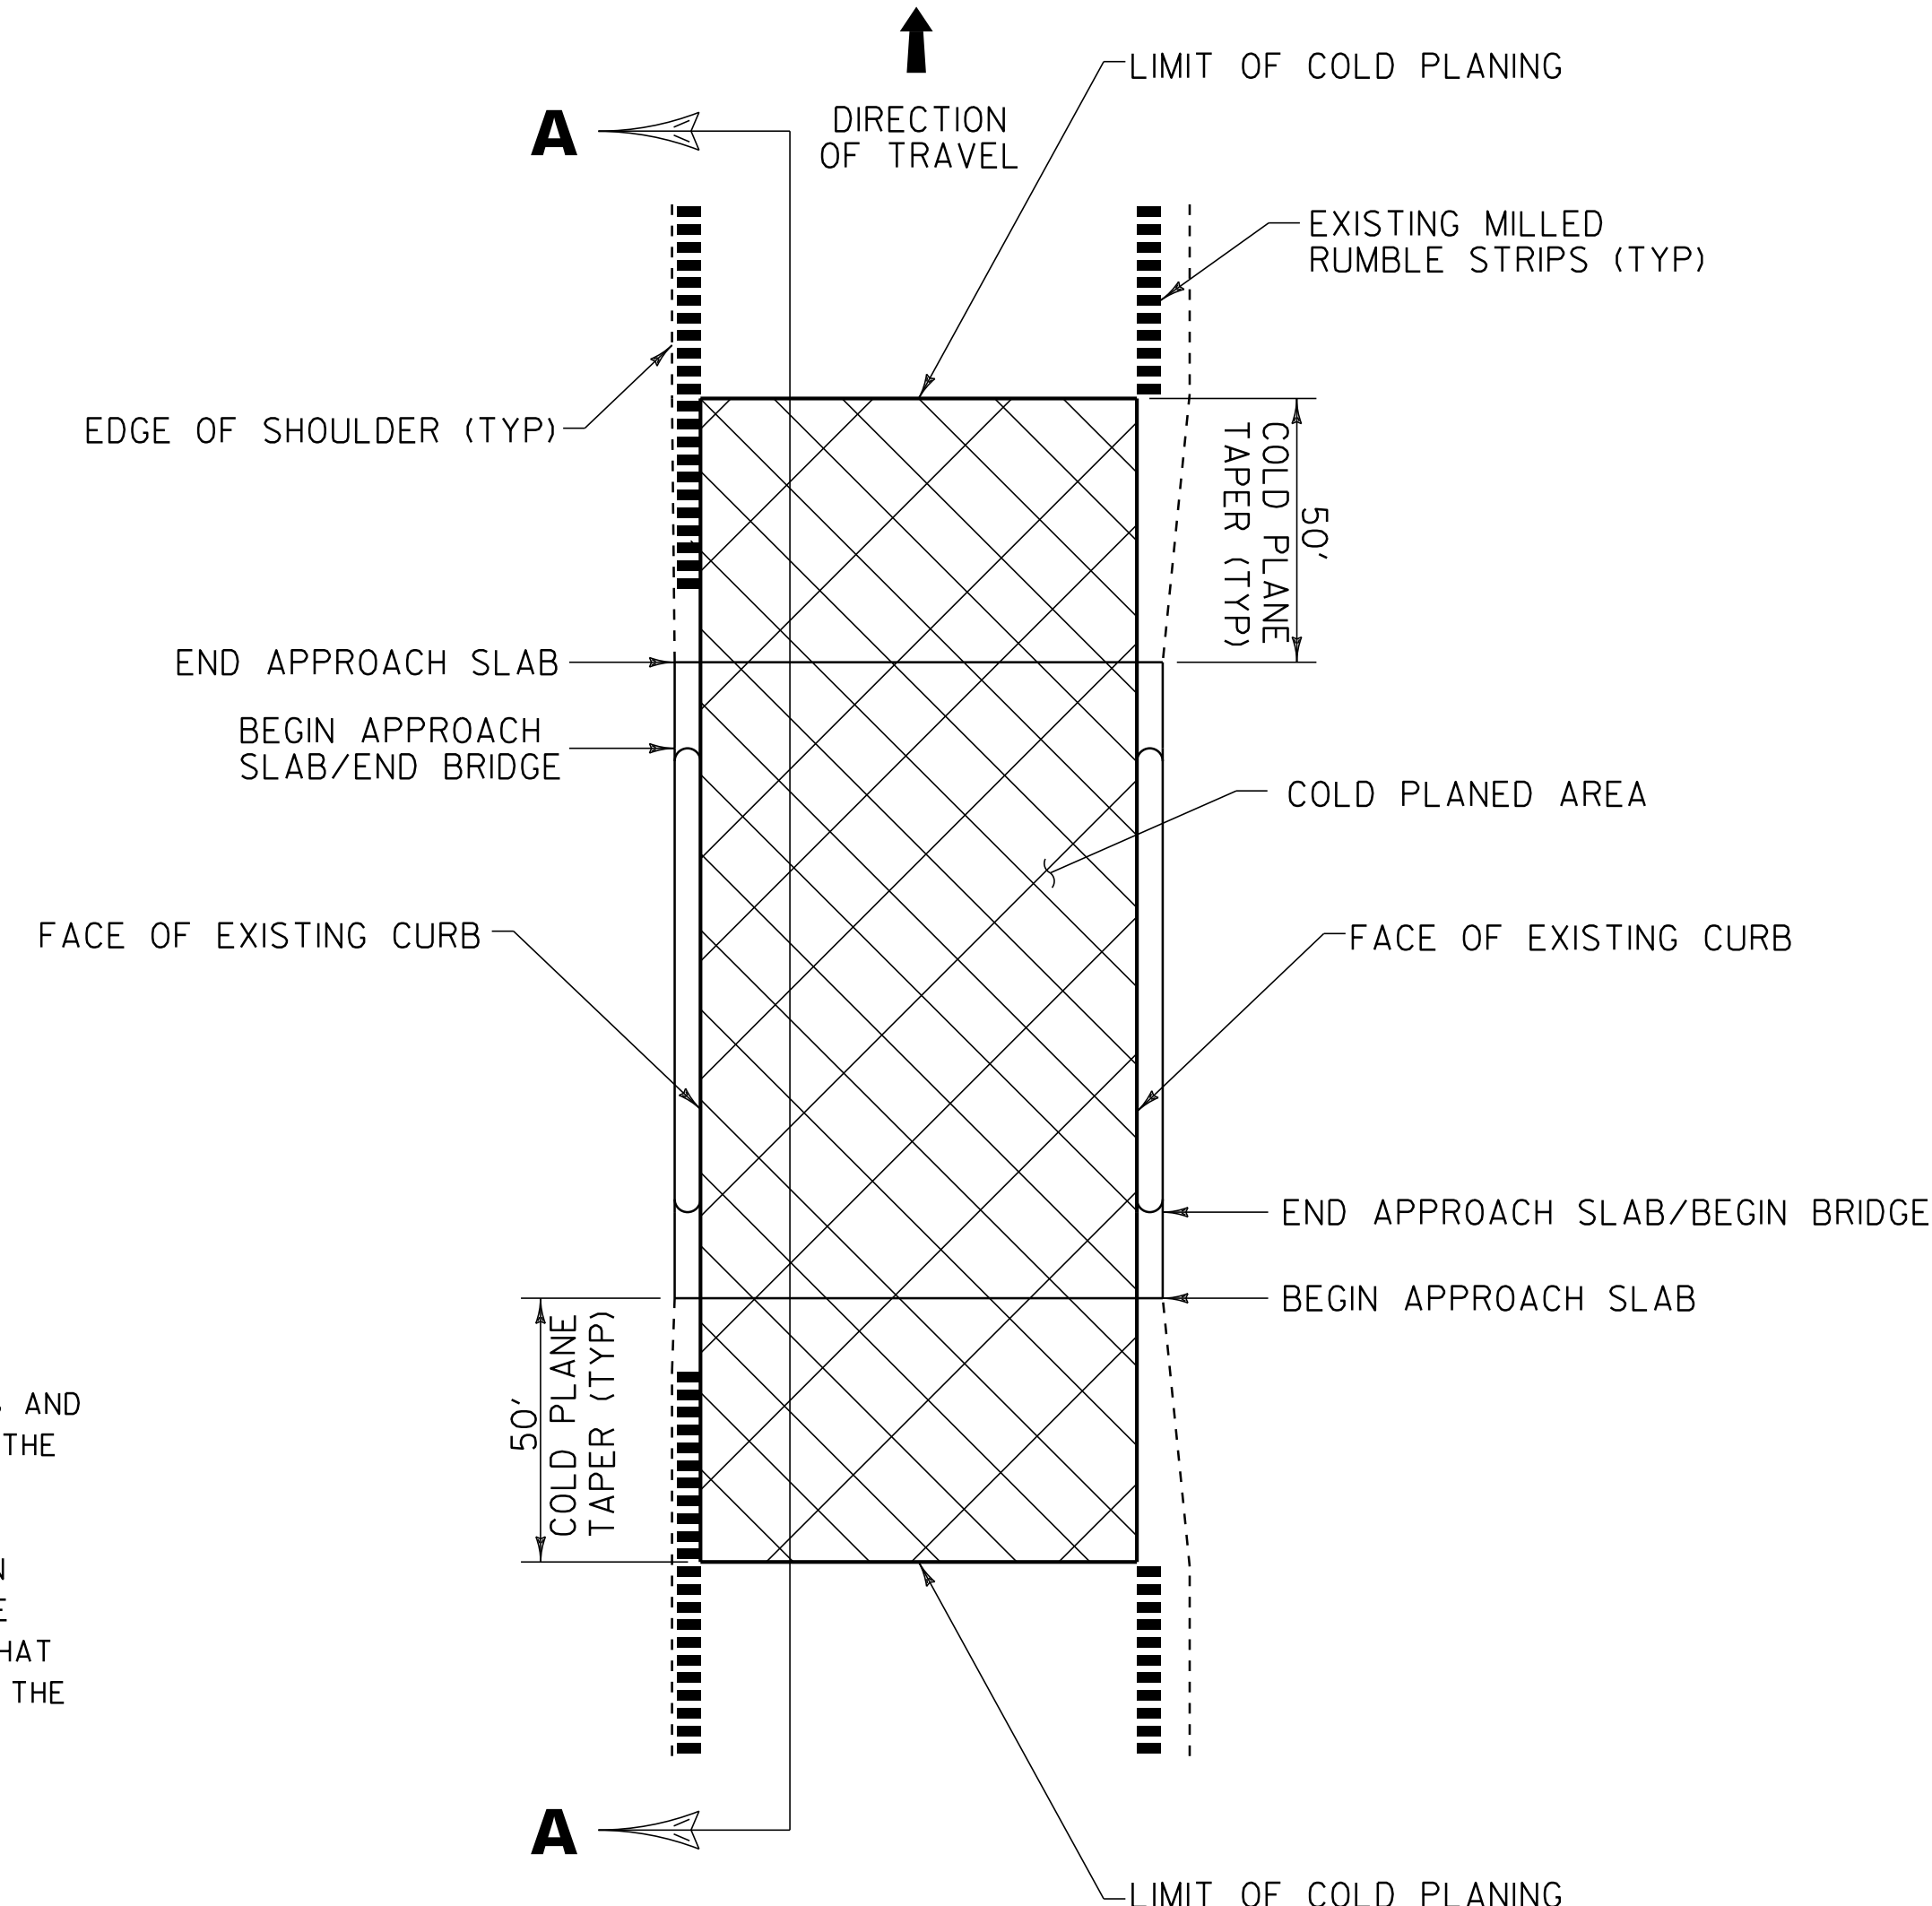


BRIDGE COLD PLANE TYPICAL PLAN

NOTES:

1. REFER TO STRUCTURES DETAIL SD-516.10. ALL NEW JOINTS TO BE PAID FOR UNDER ITEM 516.10, "BRIDGE EXPANSION JOINT, ASPHALTIC PLUG".
2. THE CONTRACTOR SHALL TAKE PRECAUTIONS TO AVOID DAMAGING DRAINAGE STRUCTURES AND EXPANSION JOINTS. ANY DAMAGE CAUSED BY THE CONTRACTOR SHALL BE REPAIRED BY THE CONTRACTOR AT THE EXPENSE OF THE CONTRACTOR.
3. THE CONTRACTOR SHALL TAKE PRECAUTIONS TO AVOID THE ACCUMULATION OF DEBRIS IN THE DRAINAGE STRUCTURES LOCATED AT CURB LINE AND IN THE EXPANSION JOINTS. THE CONTRACTOR SHALL EXAMINE THESE BRIDGE FEATURES ON A DAILY BASIS TO ENSURE THAT DEBRIS HAS NOT ACCUMULATED. ANY DEBRIS WHICH IS PRESENT SHALL BE REMOVED BY THE CONTRACTOR AT NO COST TO THE STATE.

LEGEND

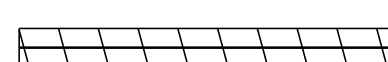 EXISTING BRIDGE JOINTS TO BE REPAIRED WITH ASPHALTIC PLUG JOINT

ASPHALTIC PLUG-TYPE JOINT LOCATIONS

BRIDGE #	JOINT #	MM	LENGTH
3-E	1	0.715	43
3-E	3	0.760	43
5-E			36.6
8-E	2	4.136	37
10-E	1	5.440	48 47.0
10-E	2	5.446	48
10-E	4	5.485	48 47.5
13-E	1	12.925	30 30.33
13-E	2	12.94	30
13-E	3	12.966	30
13-E	4	12.970	30
13-E	5	12.985	30 30.33
14-E	1	13.035	47 44.0
15-E	1	14.600	38 40.5
15-E	2	14.620	38 41.5
16-E	1	14.880	37 44.0
16-E	2	14.9100	37 30.0
19-E	2	17.590	36 41.6
TOTAL		650	433.36 LF

BRIDGE #	MM	JOINT #	LENGTH
3-W	0.675	1	43
3-W	0.720	2	43
5-W			37.4
8-W	4.080	1	37
8-W	4.180	2	37
10-W	5.426	1	48
10-W	5.435	2	48
10-W	5.460	3	48
10-W	5.470	4	48
13-W	12.930	1	30 30.3
13-W	12.940	2	30
13-W	12.976	3	30
13-W	12.980	4	30
13-W	12.990	5	30
14-W	13.046	1	47
14-W	13.110	2	47
15-W	14.580	1	38 39.0
15-W	14.600	2	38 36.0
16-W	14.865	1	37 36.0
16-W	14.895	2	37
19-W			43.0
TOTAL			258.7 LF



TOTAL EB AND WB = 433.36 LF + 258.7 LF + 0.04 (PROJECT ROUNDING) = 692.1 LF

BRIDGE
DETAIL
SHEET

PROJECT NAME: FAIR HAVEN-RUTLAND TOWN
PROJECT NUMBER: NH SURF (22)

FILE NAME: 10b106/10b106.dgn
PROJECT LEADER: M. FOWLER
DESIGNED BY: PVT. MGT.
IPARM FILE NAME: 10B106#7.1
PLOT DATE: 31-MAY-2013 11:55
DRAWN BY: PVT. MGT.
CHECKED BY: PVT. MGT.
SHEET 7 OF 24


NOT TO SCALE

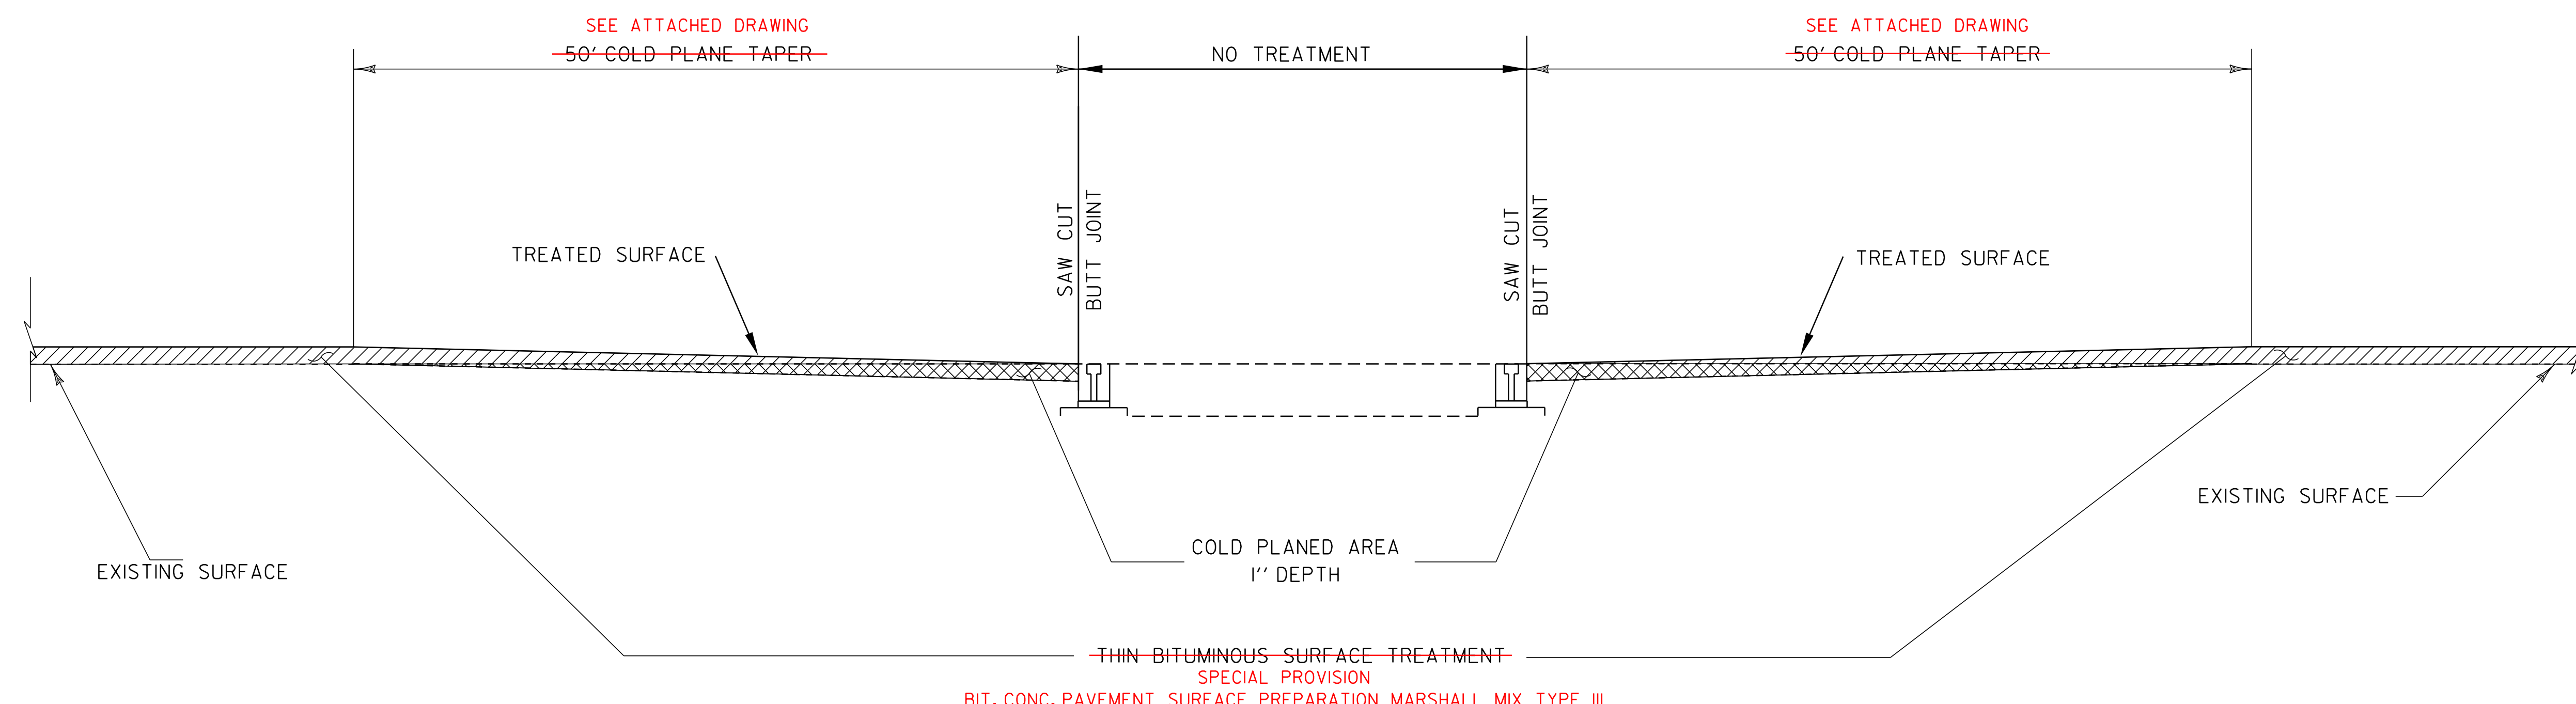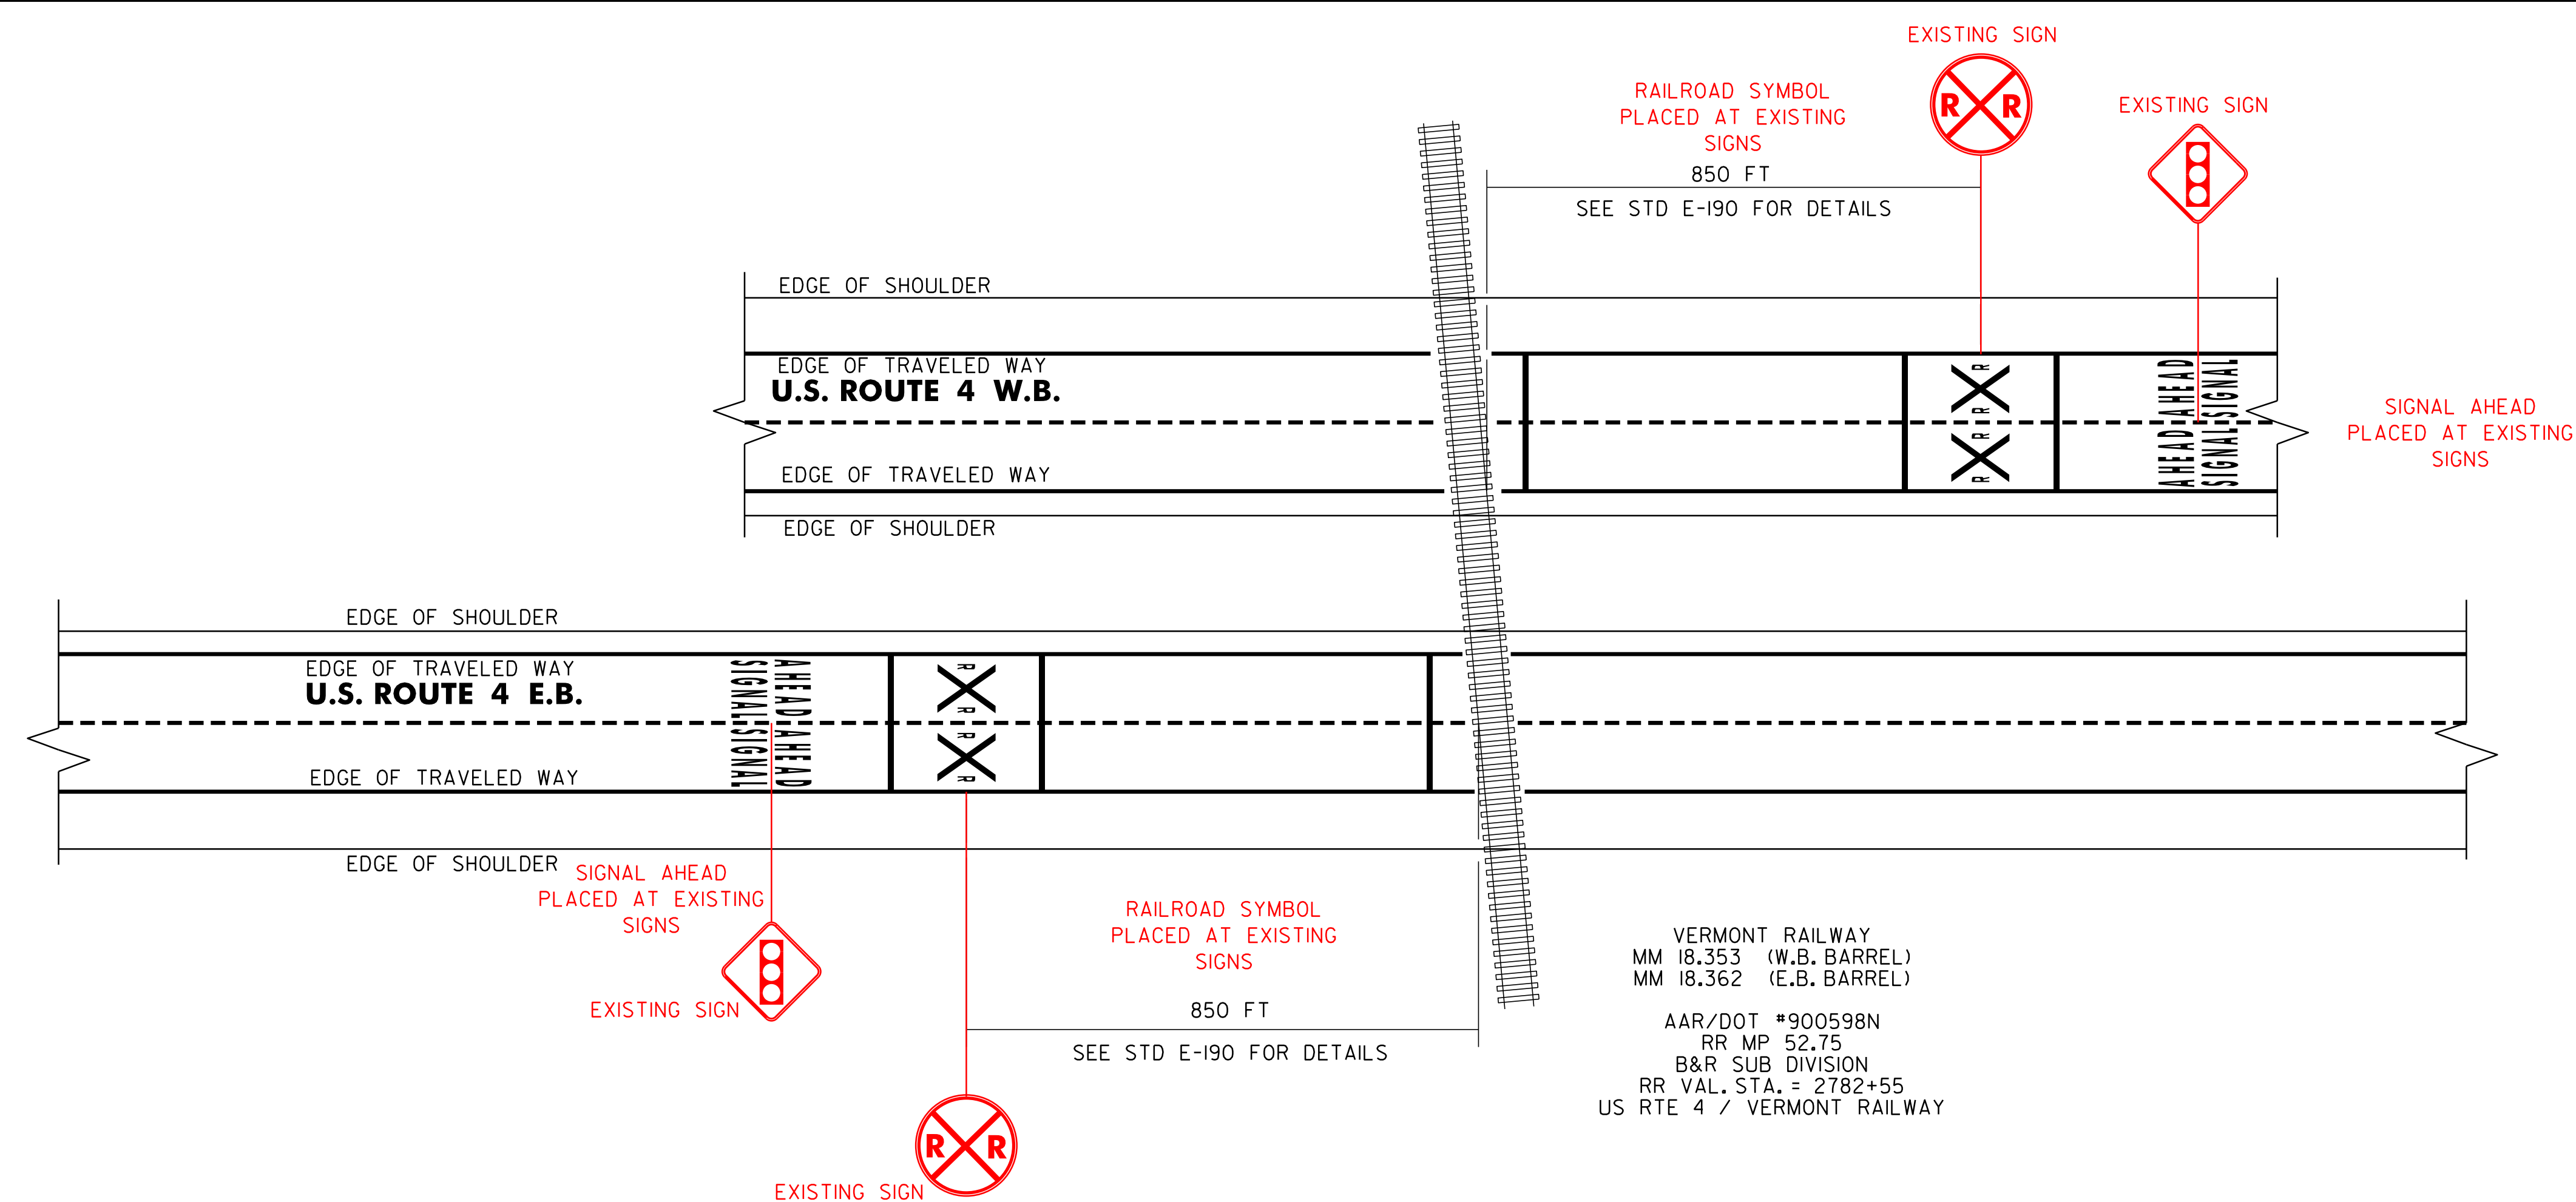

RAIL – HIGHWAY CROSSING TREATMENT DETAIL


NOT TO SCALE

RAILROAD CROSSING DETAIL SHEET	PROJECT NAME: FAIR HAVEN-RUTLAND TOWN	
	PROJECT NUMBER: NH SURF(22)	
	FILE NAME: IOBI06/IOBI06.dgn	PLOT DATE: 31-MAY-2013 11:55
	PROJECT LEADER: M. FOWLER DESIGNED BY: PVT. MGT. IOBI06*8.1	DRAWN BY: PVT. MGT. CHECKED BY: PVT. MGT. SHEET 8 OF 24

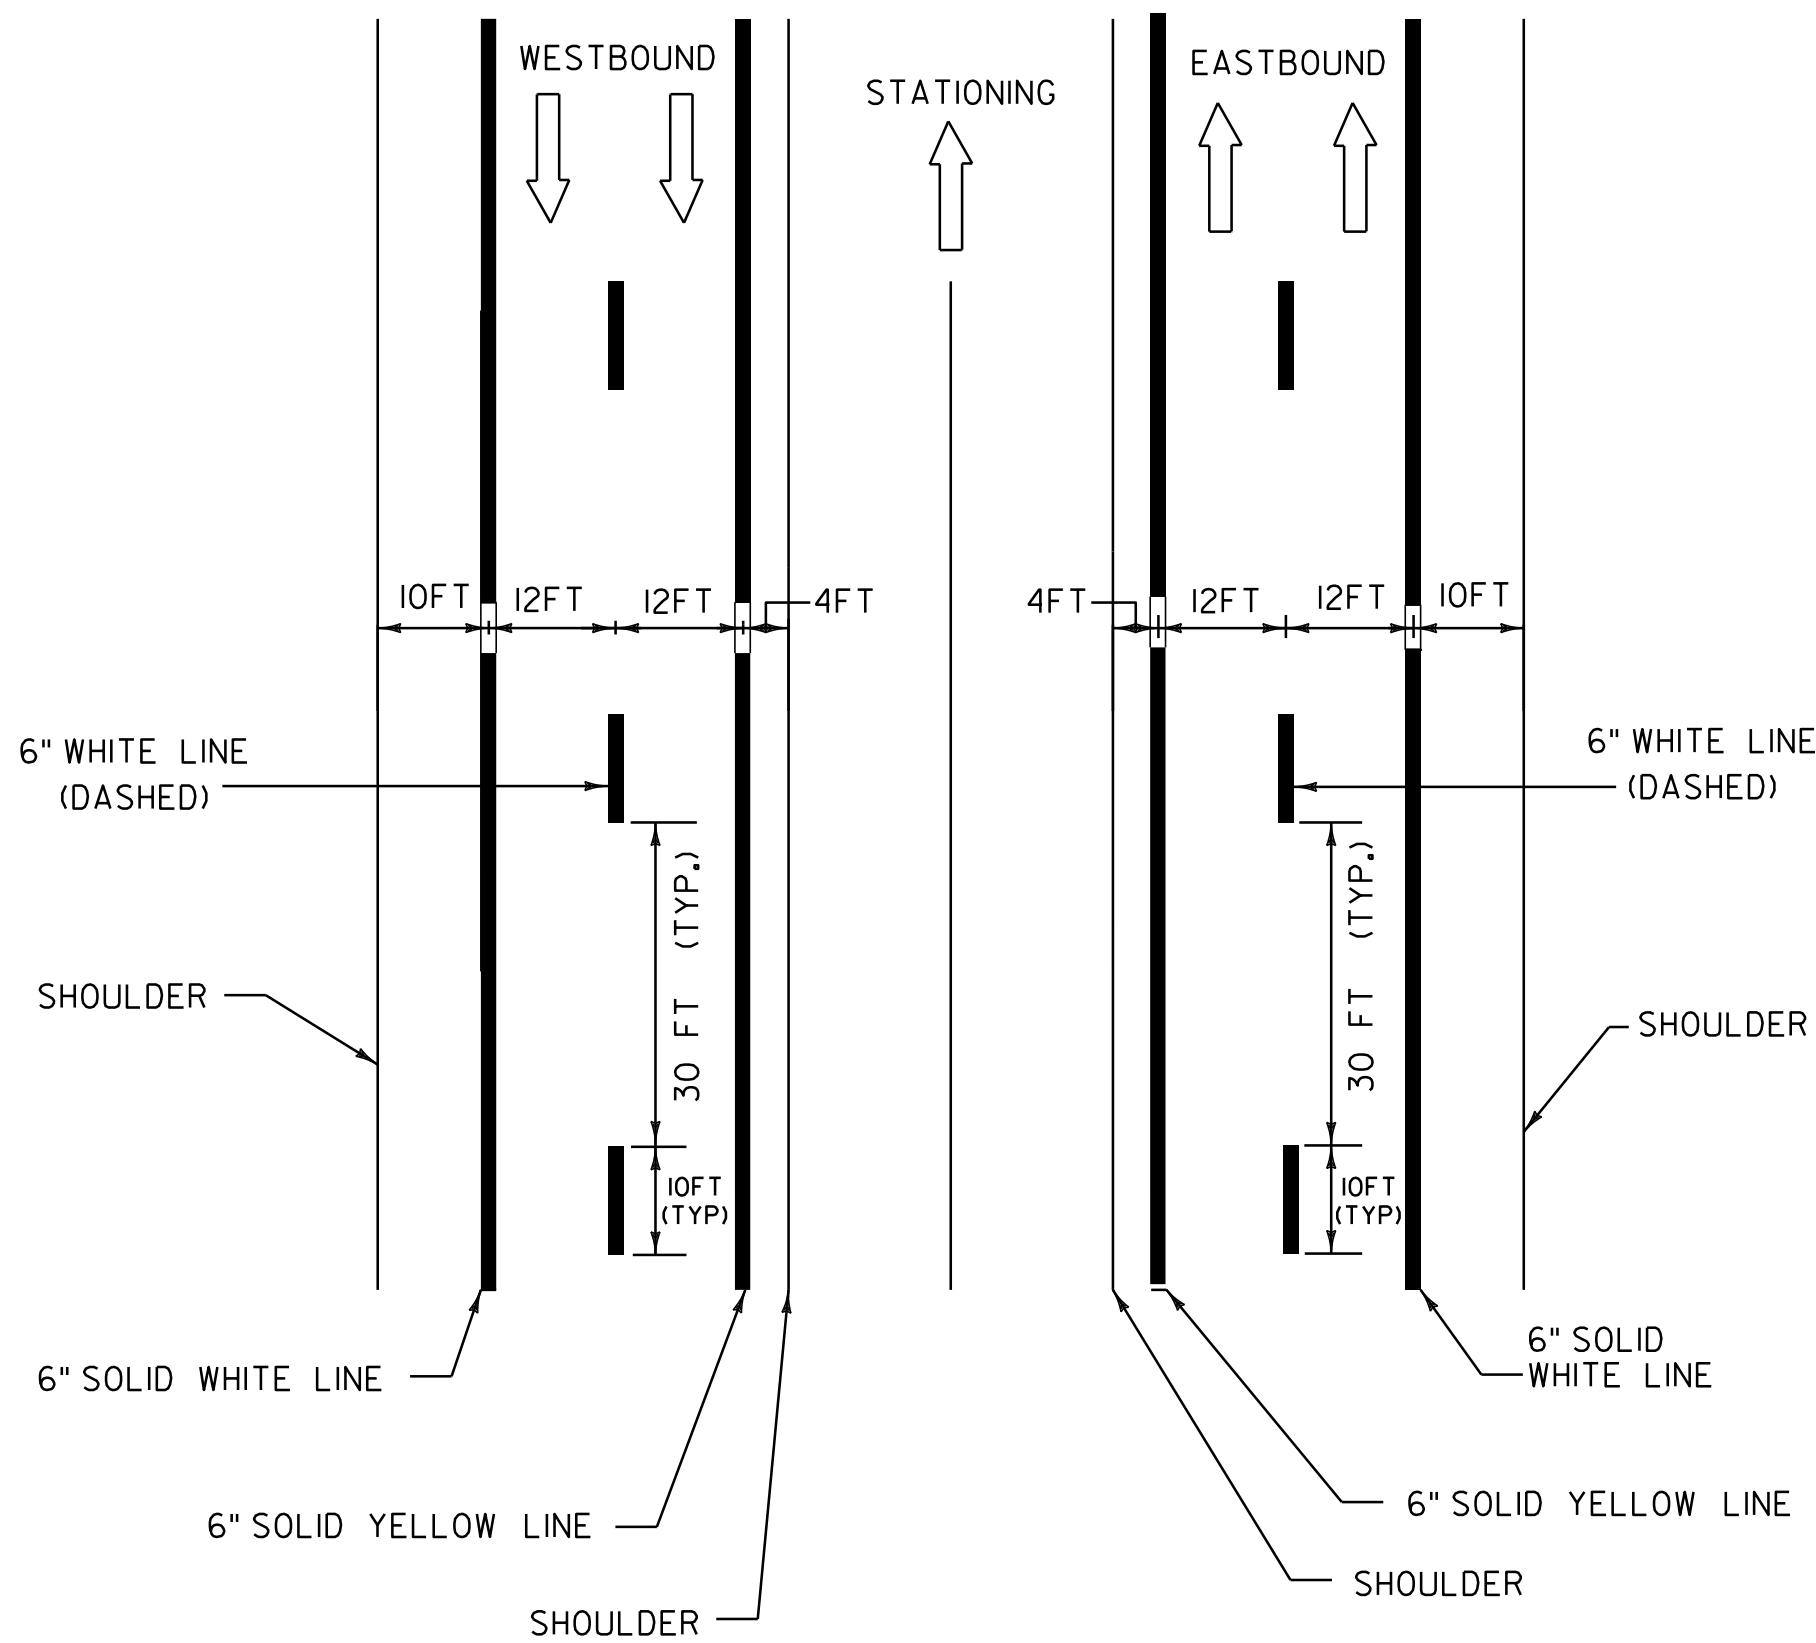


PAVEMENT MARKING LINE DETAILS

SEE MAINLINE AND INTERCHANGE LAYOUT SHEETS FOR LOCATIONS AND MATERIALS

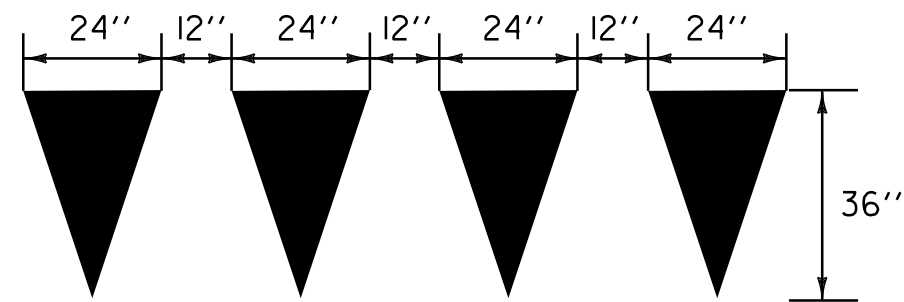

YIELD LINE DETAIL

EACH TRIANGLE SHALL BE PAID AS ONE EACH LETTER OR SYMBOL.

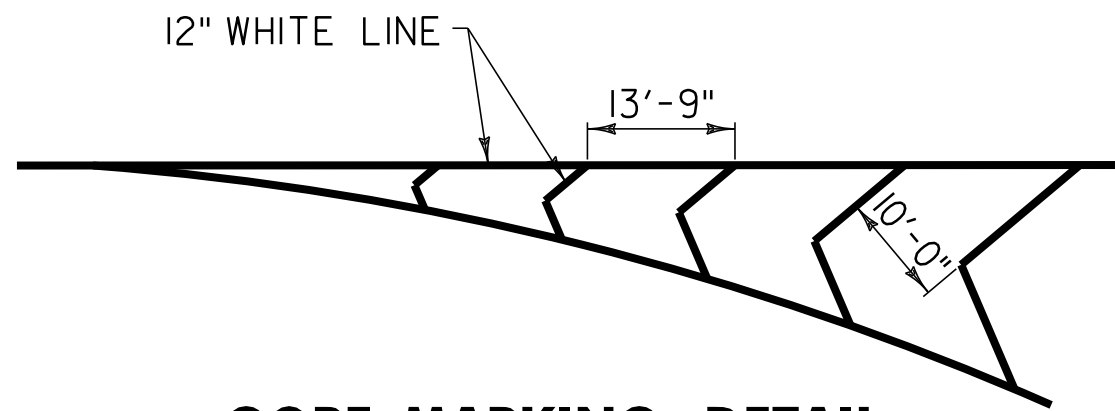


GORE MARKING DETAIL



LEGEND



NOTES:
1. TWO (2) APPLICATIONS OF FINAL PAVEMENT MARKINGS WILL BE REQUIRED ON ALL ALTERNATIVE TREATMENTS.
THE FIRST APPLICATION WILL BE IMMEDIATELY FOLLOWING PLACEMENT OF THE WEARING COURSE. THE SECOND
AND FINAL APPLICATION WILL BE APPLIED NO SOONER THAN 15 SEPTEMBER 2012, AND NO LATER THAN 12 OCTOBER 2012.

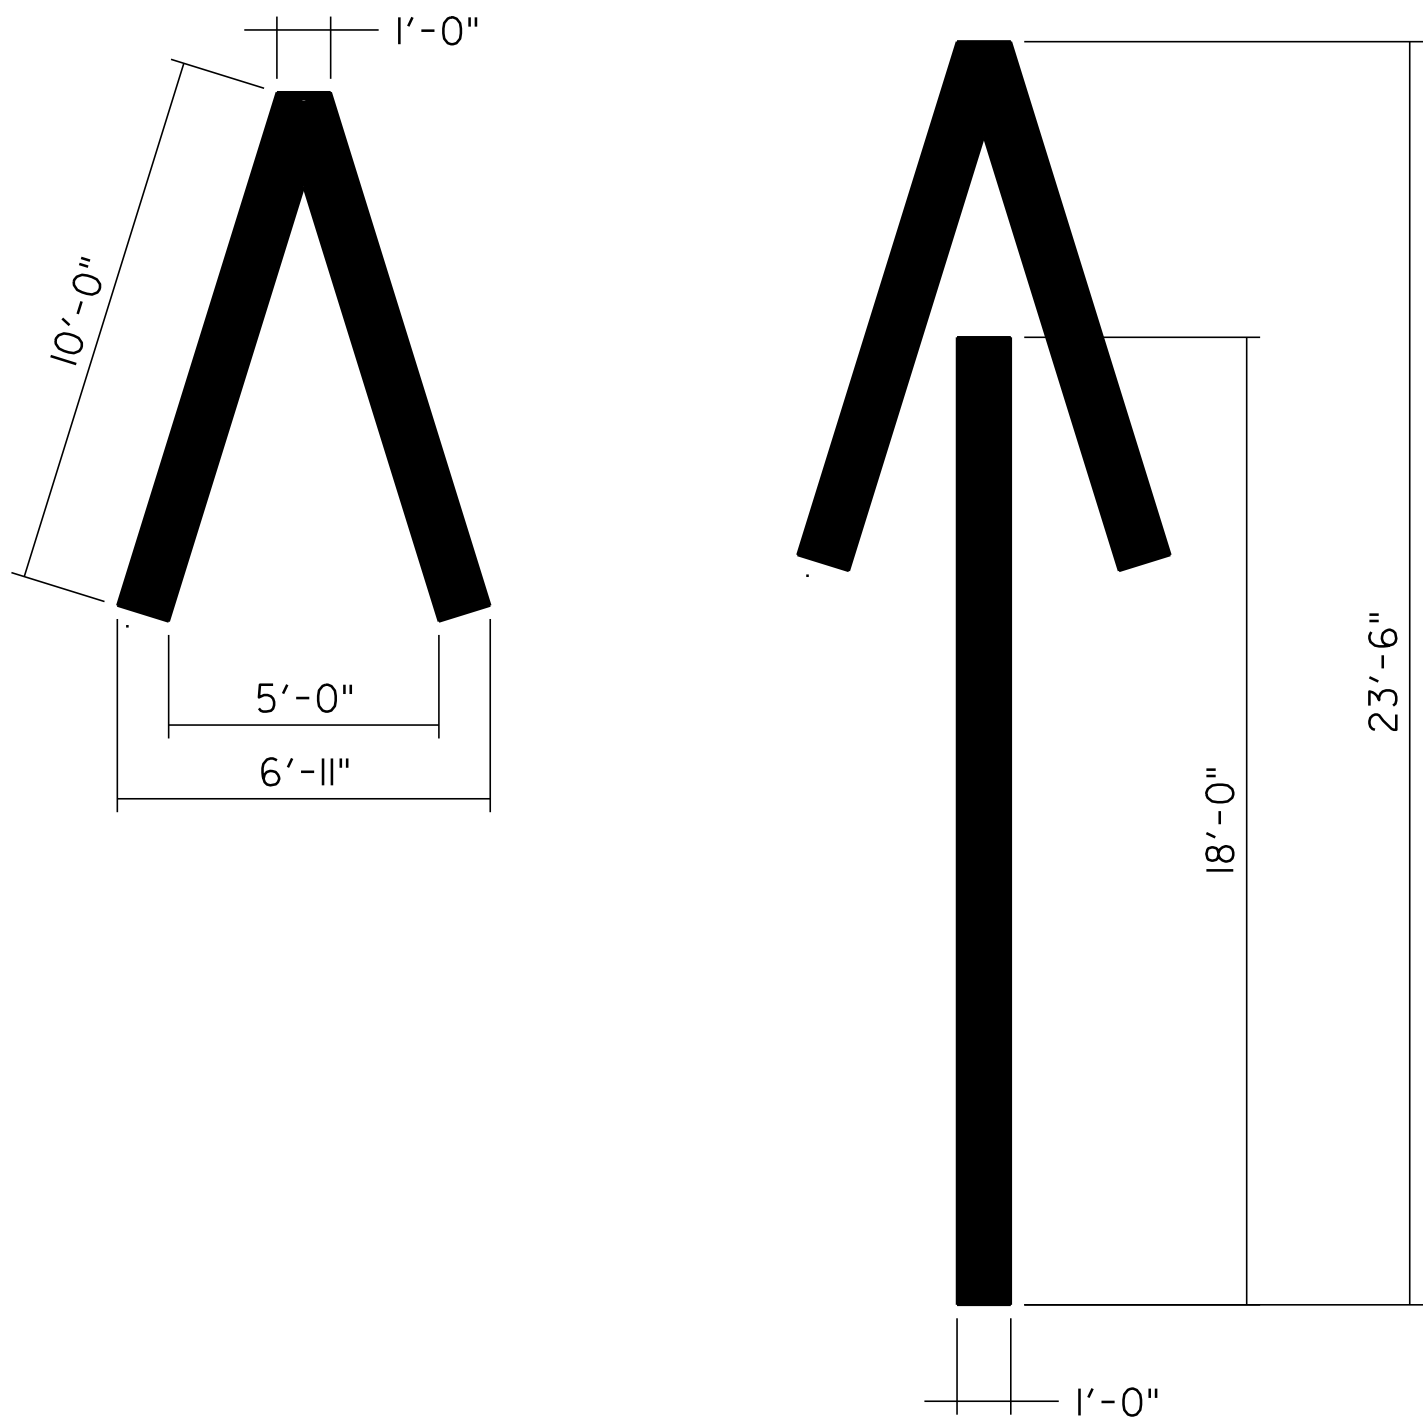

WRONG WAY ARROW DETAILS

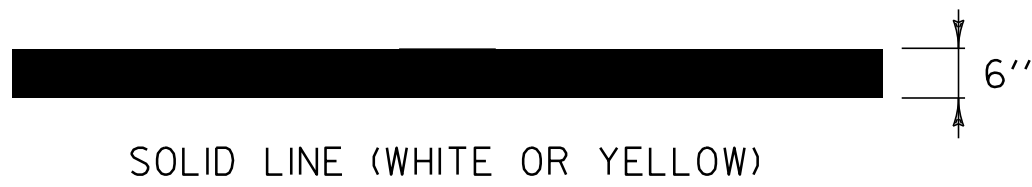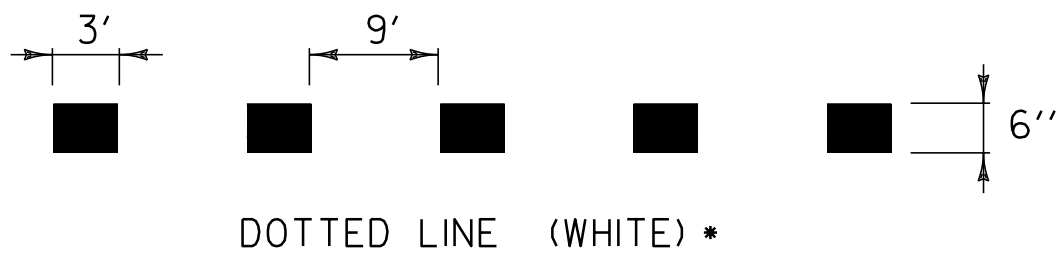

PAVEMENT MARKING LINE DETAILS

• TO BE INSTALLED AT THE DIRECTION OF THE RESIDENT ENGINEER

TURN ARROWS SHALL BE PLACED AT THE BEGIN AND END OF THE LEFT OR RIGHT TURN LANE.

IF LANE LENGTH IS LESS THAN 100', TURN ARROWS SHOULD BE PLACED AT THE BEGINNING AND END OF THE LEFT OR RIGHT TURN LANE.

THE "ONLY" WORD MARKINGS SHALL BE USED TO SUPPLEMENT LANE-USE ARROW MARKINGS FOR TURN LANES 100' OR LONGER.


THE LONGITUDINAL SPACE BETWEEN WORD OR SYMBOL MESSAGE MARKINGS, SHOULD BE AT LEAST FOUR TIMES THE HEIGHT OF THE CHARACTERS FOR LOW SPEED ROADS, BUT NOT MORE THAN TEN TIMES THE HEIGHT OF THE CHARACTERS UNDER ANY CONDITIONS.

STOP BARS ARE INSTALLED ONLY WHERE A STOP SIGN OR TRAFFIC SIGNAL ARE LOCATED.

MORE ARROWS AND ONLYS ARE OPTIONAL WHEN SPACE PERMITS. ARROW MARKINGS START AT THE BEGINNING OF THE SOLID LANE LINE.

EXCLUSIVE TURN LANES (LEFT OR RIGHT) LANE LINES SHALL BE SOLID AND EXTEND BACK FROM THE STOP LINE TO THE POINT OF FULL LANE WIDTH OF THE TURN LANE. 3' DOTS WITH A 9' SPACE SHOULD BE EXTENDED THE FULL LENGTH OF THE LANE TAPER.








TYPICAL MARKINGS FOR TURN LANES

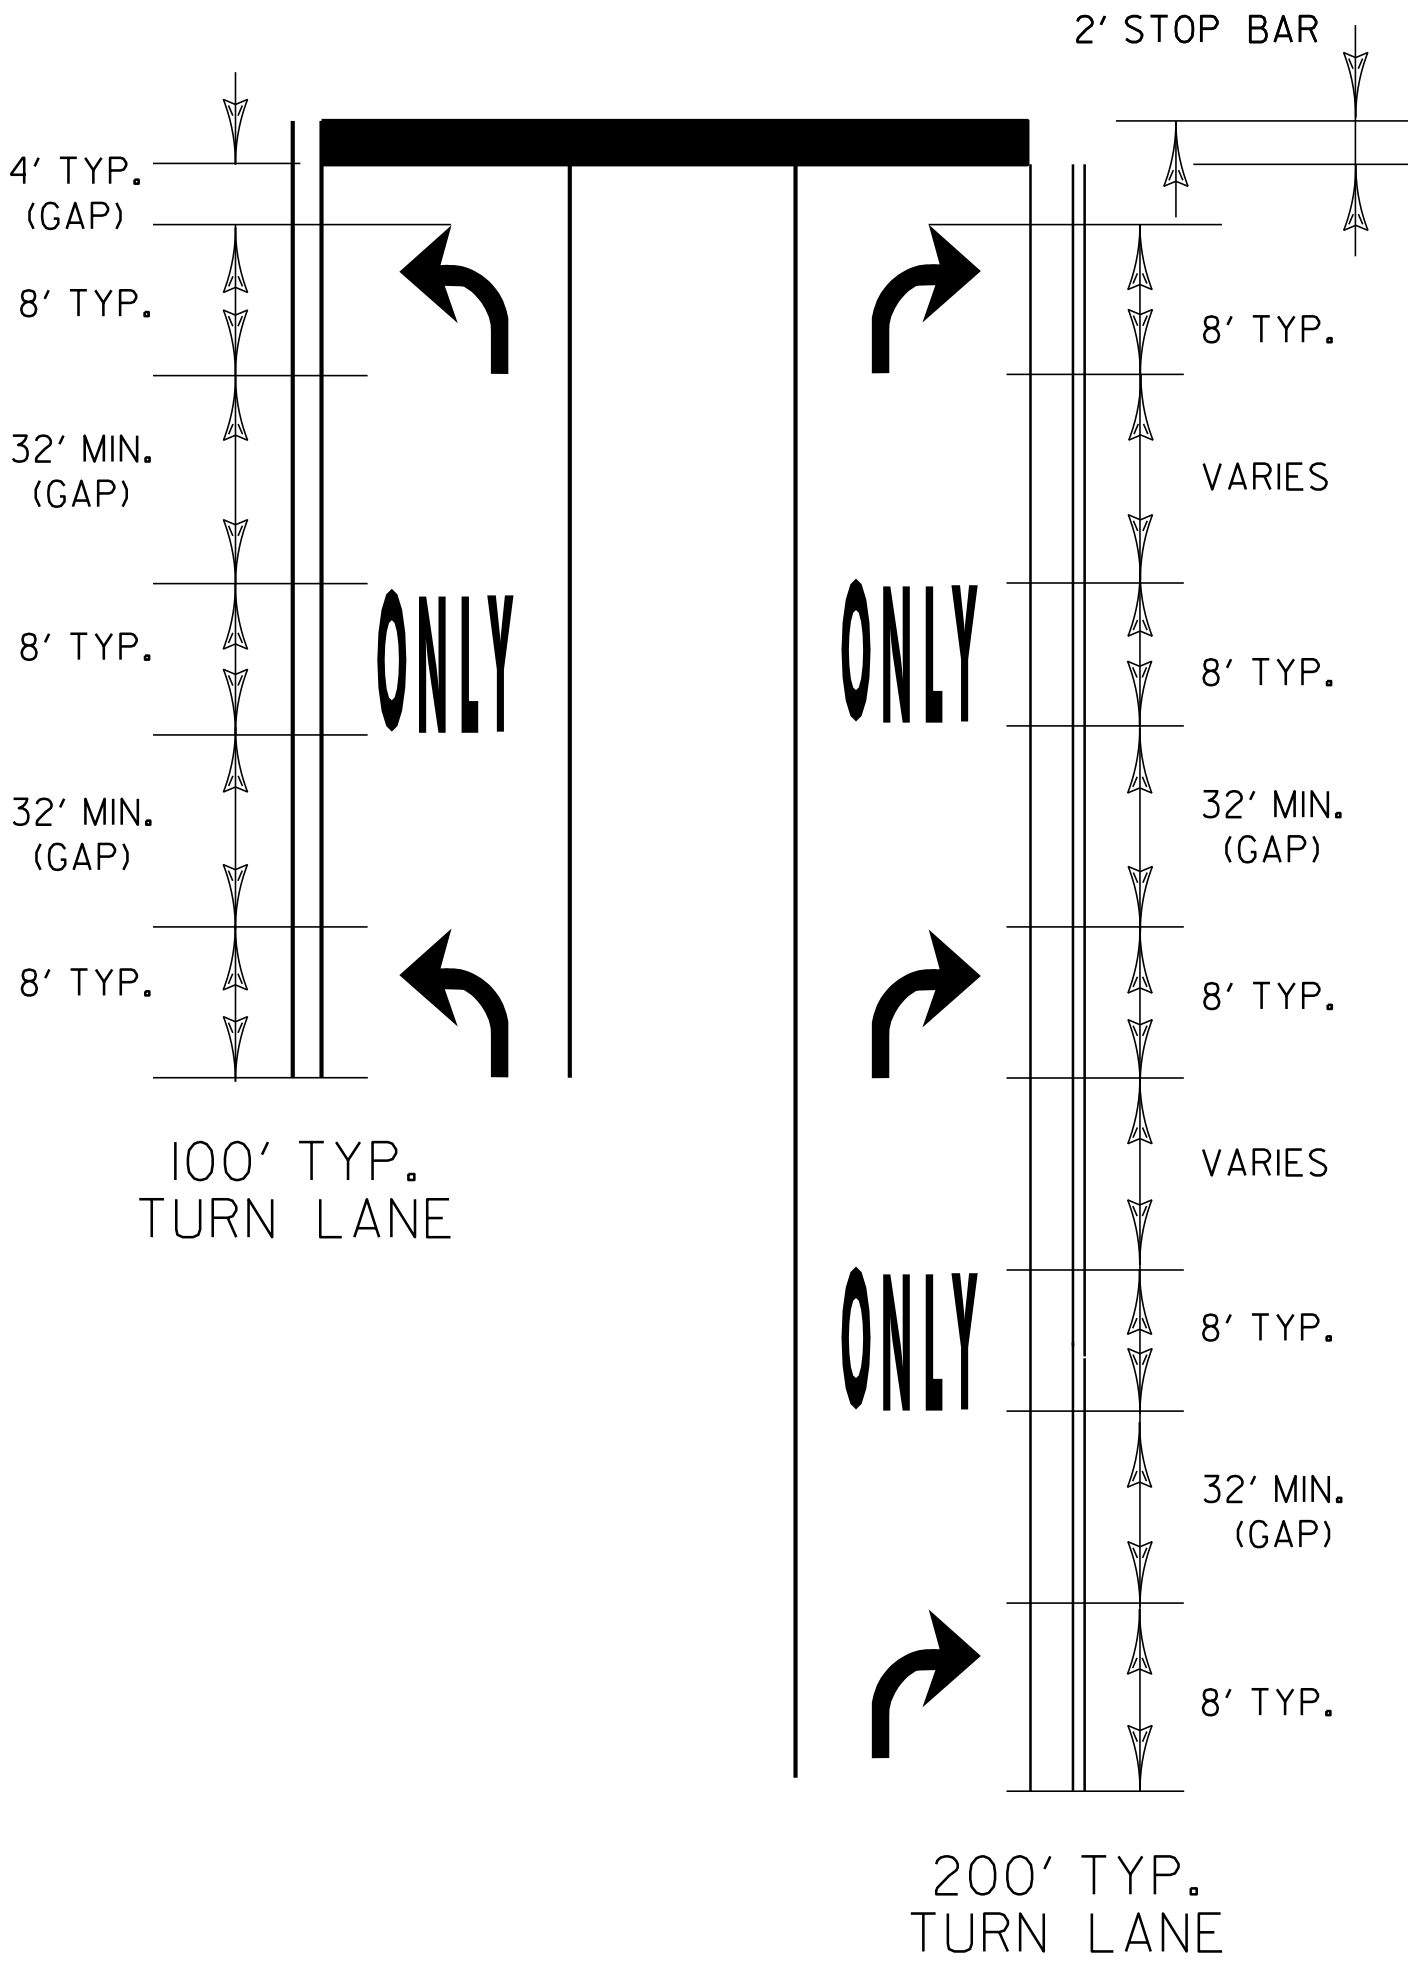

NOT TO SCALE

PAVEMENT MARKING DETAIL SHEET 1

PROJECT NAME:	FAIR HAVEN-RUTLAND TOWN		
PROJECT NUMBER:	NH SURF (22)		
FILE NAME:	10b106/10b106.dgn	PLOT DATE:	31-MAY-2013 11:55
PROJECT LEADER:	M. FOWLER	DRAWN BY:	PVT. MGT.
DESIGNED BY:	PVT. MGT.	CHECKED BY:	PVT. MGT.
IPARM FILE NAME:	10B106*9.i	SHEET	9 OF 24

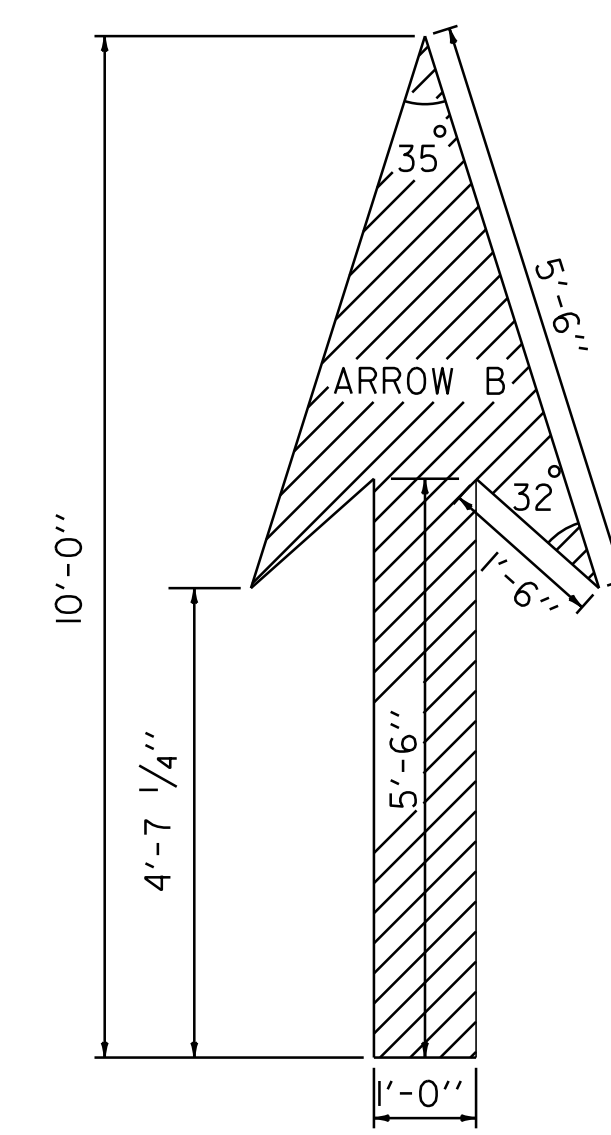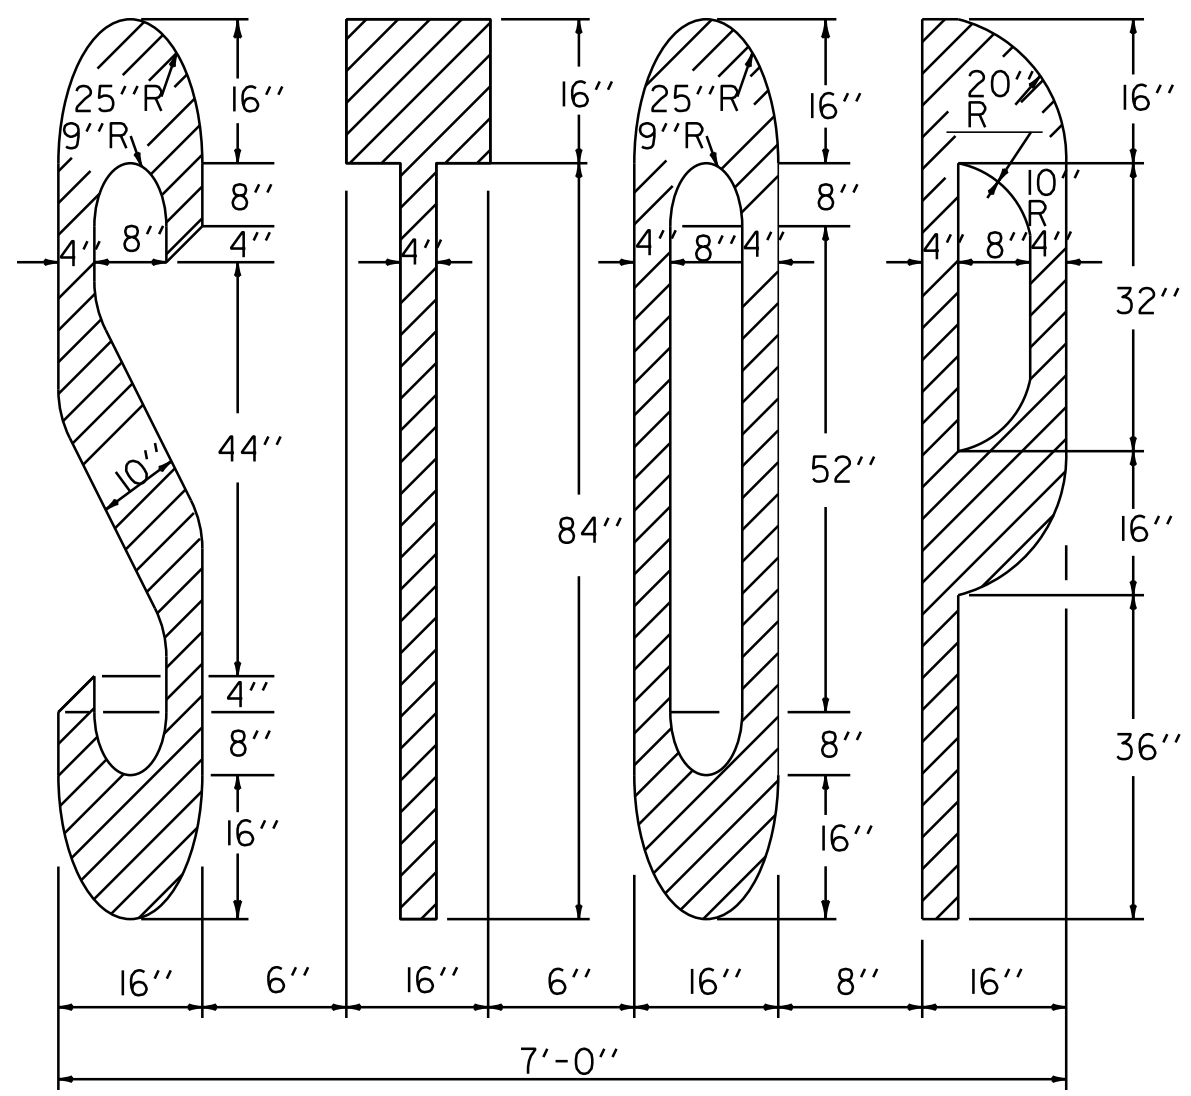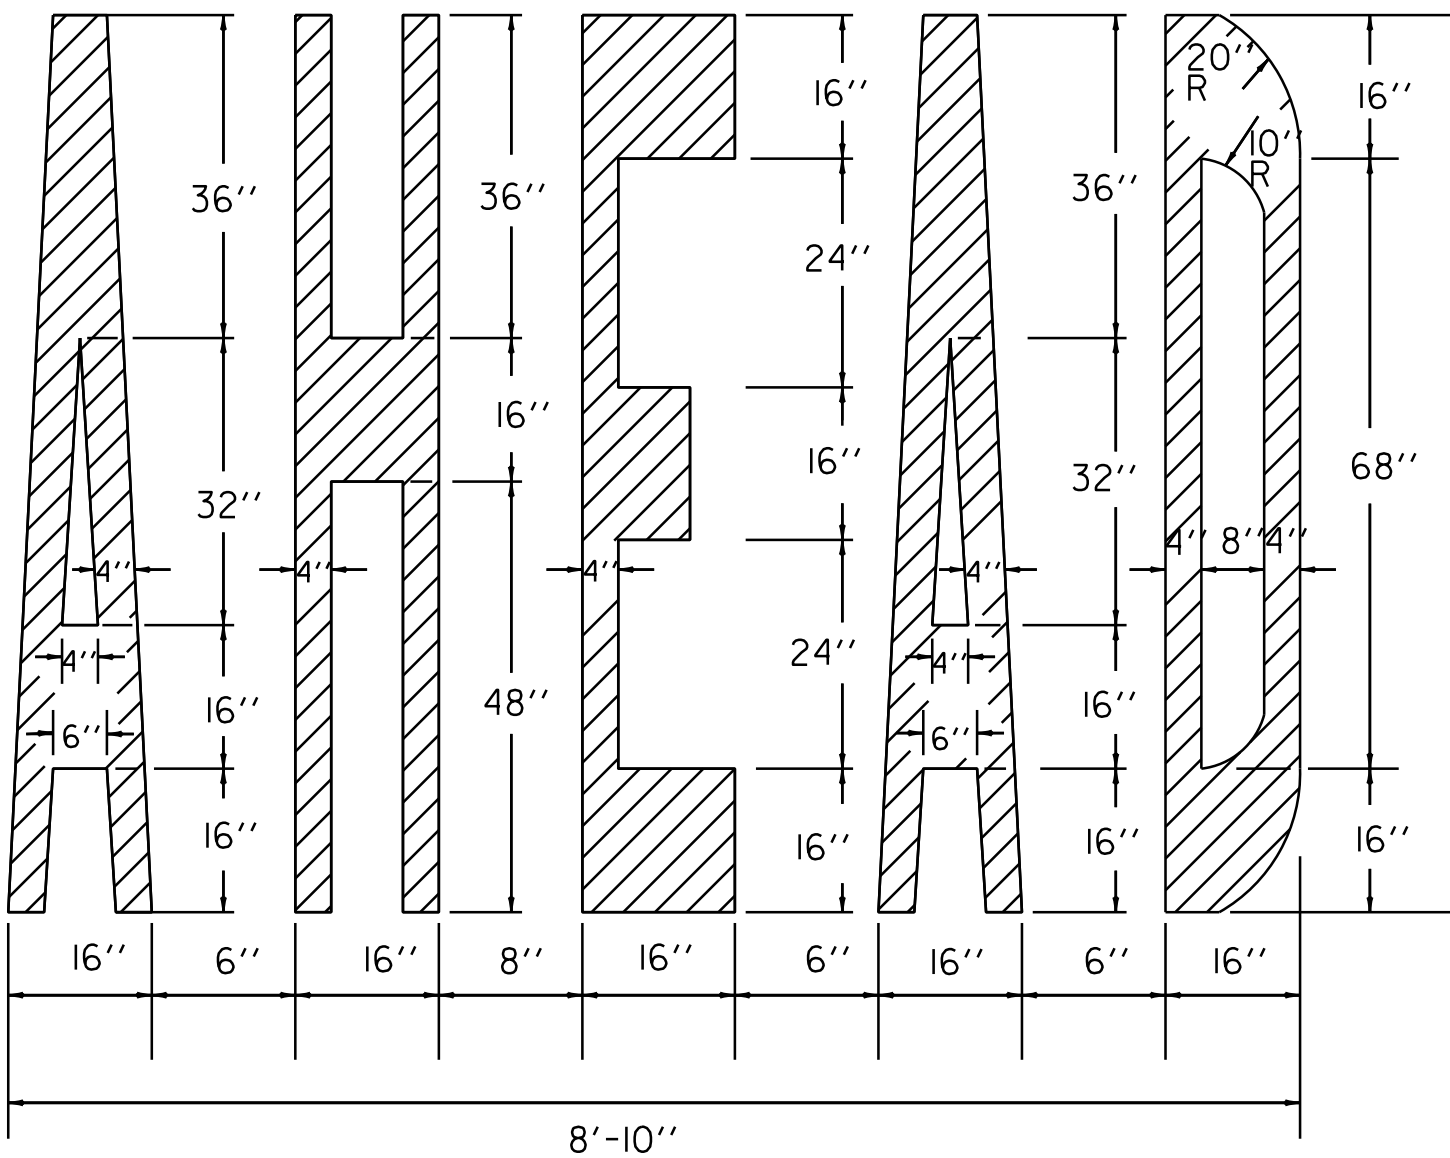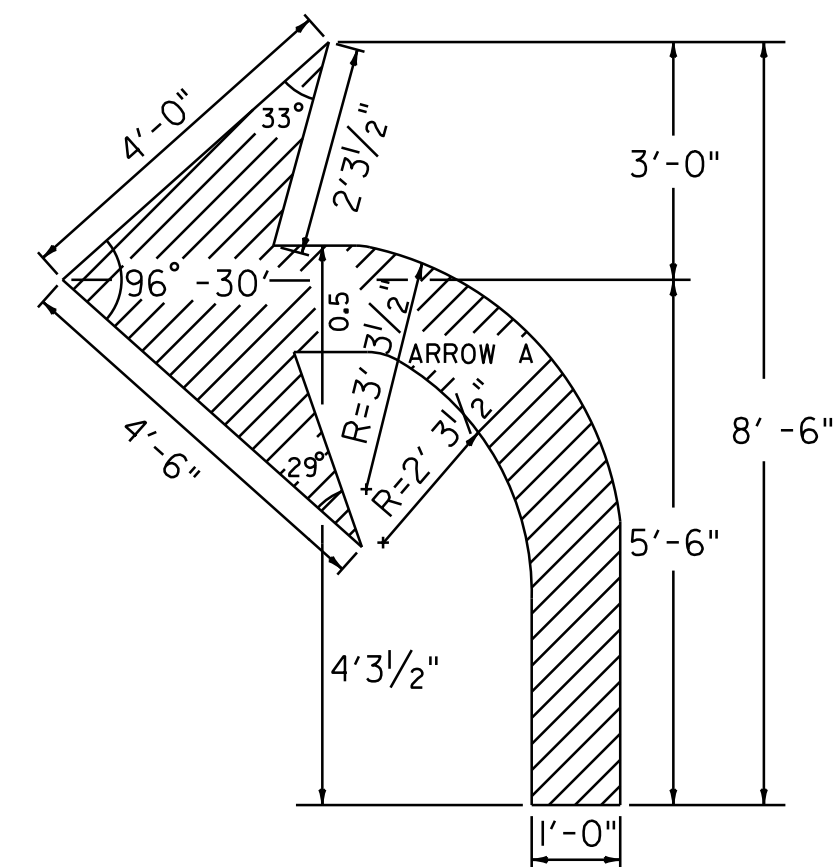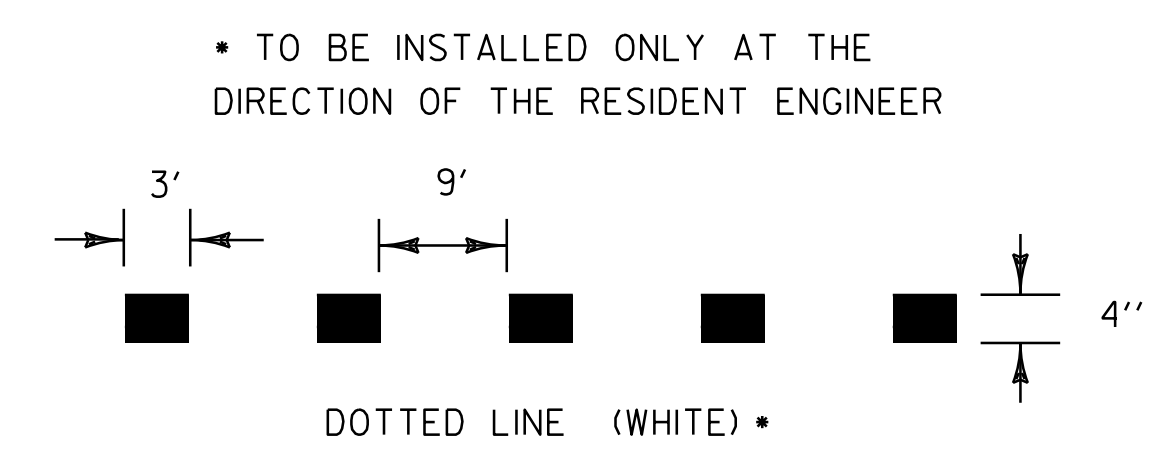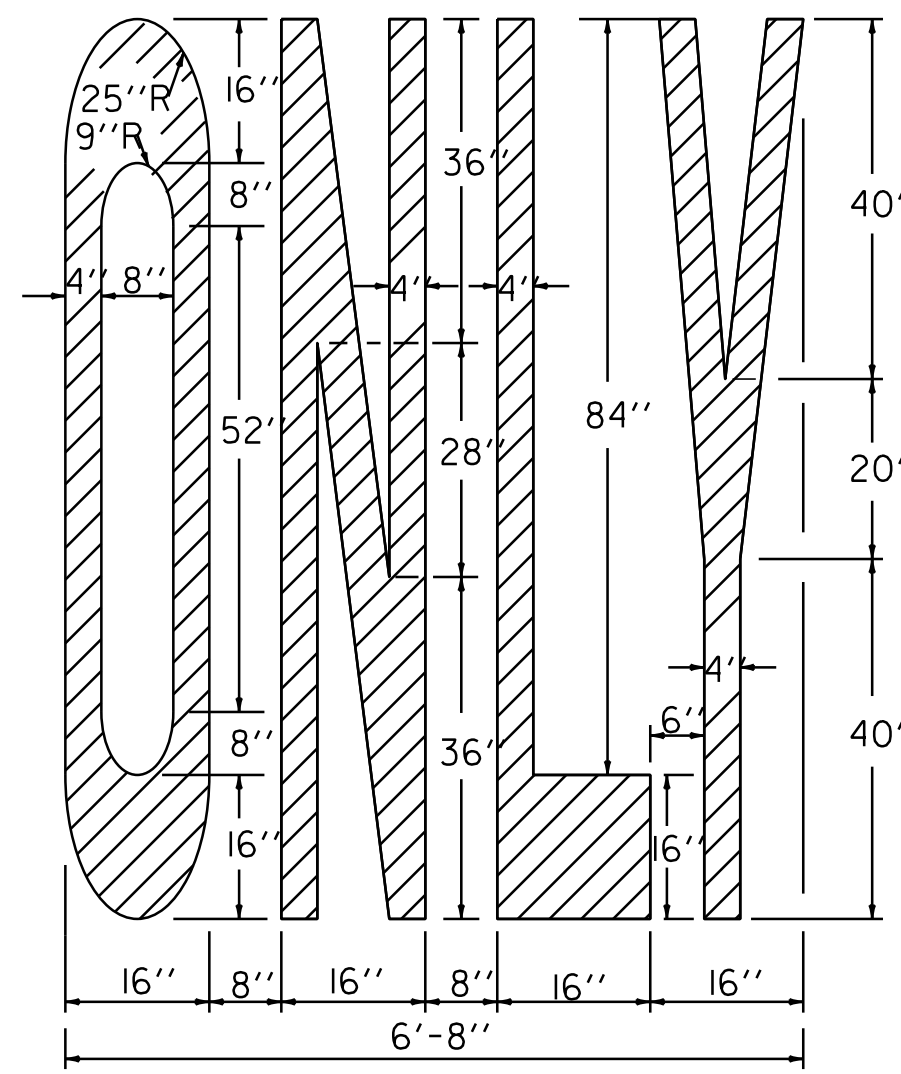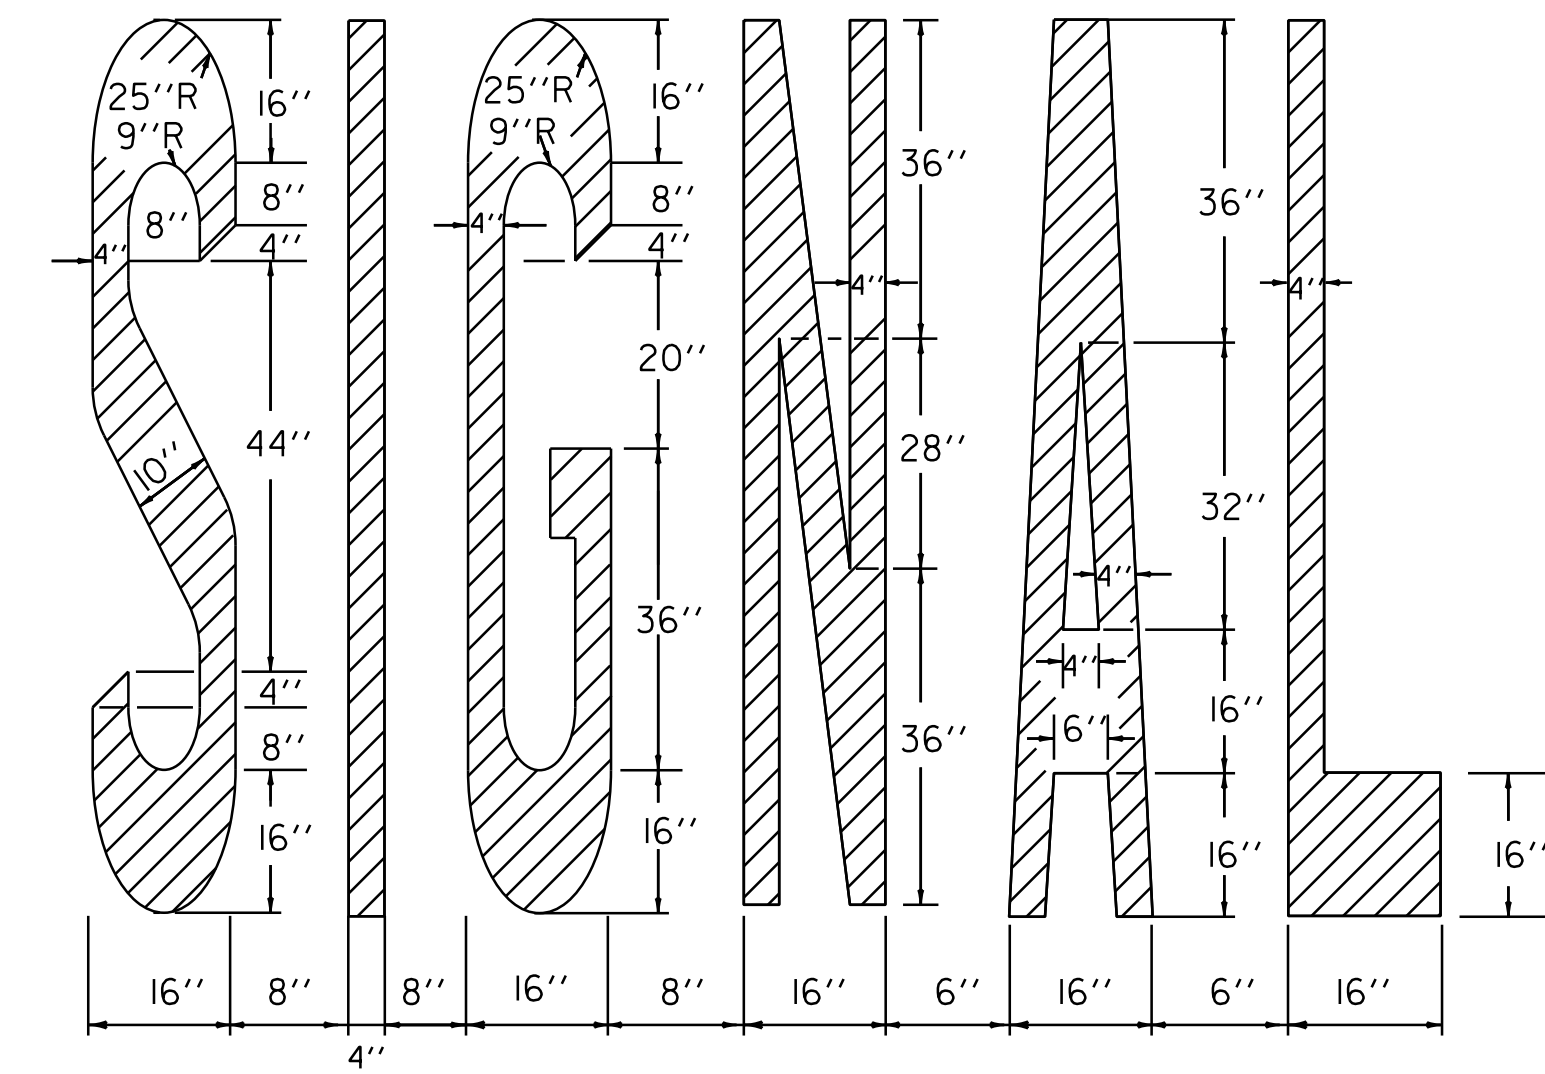

PAVEMENT MARKING DETAILS

ARROW DETAILS

NOT TO SCALE

PAVEMENT MARKING DETAIL SHEET 2	PROJECT NAME: FAIR HAVEN-RUTLAND TOWN	
	PROJECT NUMBER: NH SURF(22)	
	FILE NAME: I0bI06/I0bI06.dgn	PLOT DATE: 31-MAY-2013 11:55
	PROJECT LEADER: M. FOWLER	DRAWN BY: PVT. MGT.
	DESIGNED BY: PVT. MGT.	CHECKED BY:
	I0bI06*10.i.	SHEET 10 OF 24

STA. E13+04
STA G15+73


STA. E13+04
STA G15+73

STA E9+00	WRONG WAY ARROW	(1 EA.)
STA E12+95	STOP	(4 EA.)
STA G11+19	WRONG WAY ARROW	(1 EA.)
STA G15+68	STOP	(4 EA.)
STA G	STOP AHEAD	(9 EA.)
STA E	STOP AHEAD	(9 EA.)

646.690 TEMPORARY LETTER OR SYMBOL			
STA E9+00	WRONG WAY	ARROW	(1 EA.)
STA E12+95	STOP		(4 EA.)
STA G11+19	WRONG WAY	ARROW	(1 EA.)
STA G15+68	STOP		(4 EA.)
STA G	STOP AHEAD		(9 EA.)
STA E	STOP AHEAD		(9 EA.)

GORE LOCATIONS: TO BE INSTALLED PER
THE LATEST EDITION OF THE MUTCD

GORE LOCATIONS: TO BE INSTALLED PER
THE LATEST EDITION OF THE MUTCD

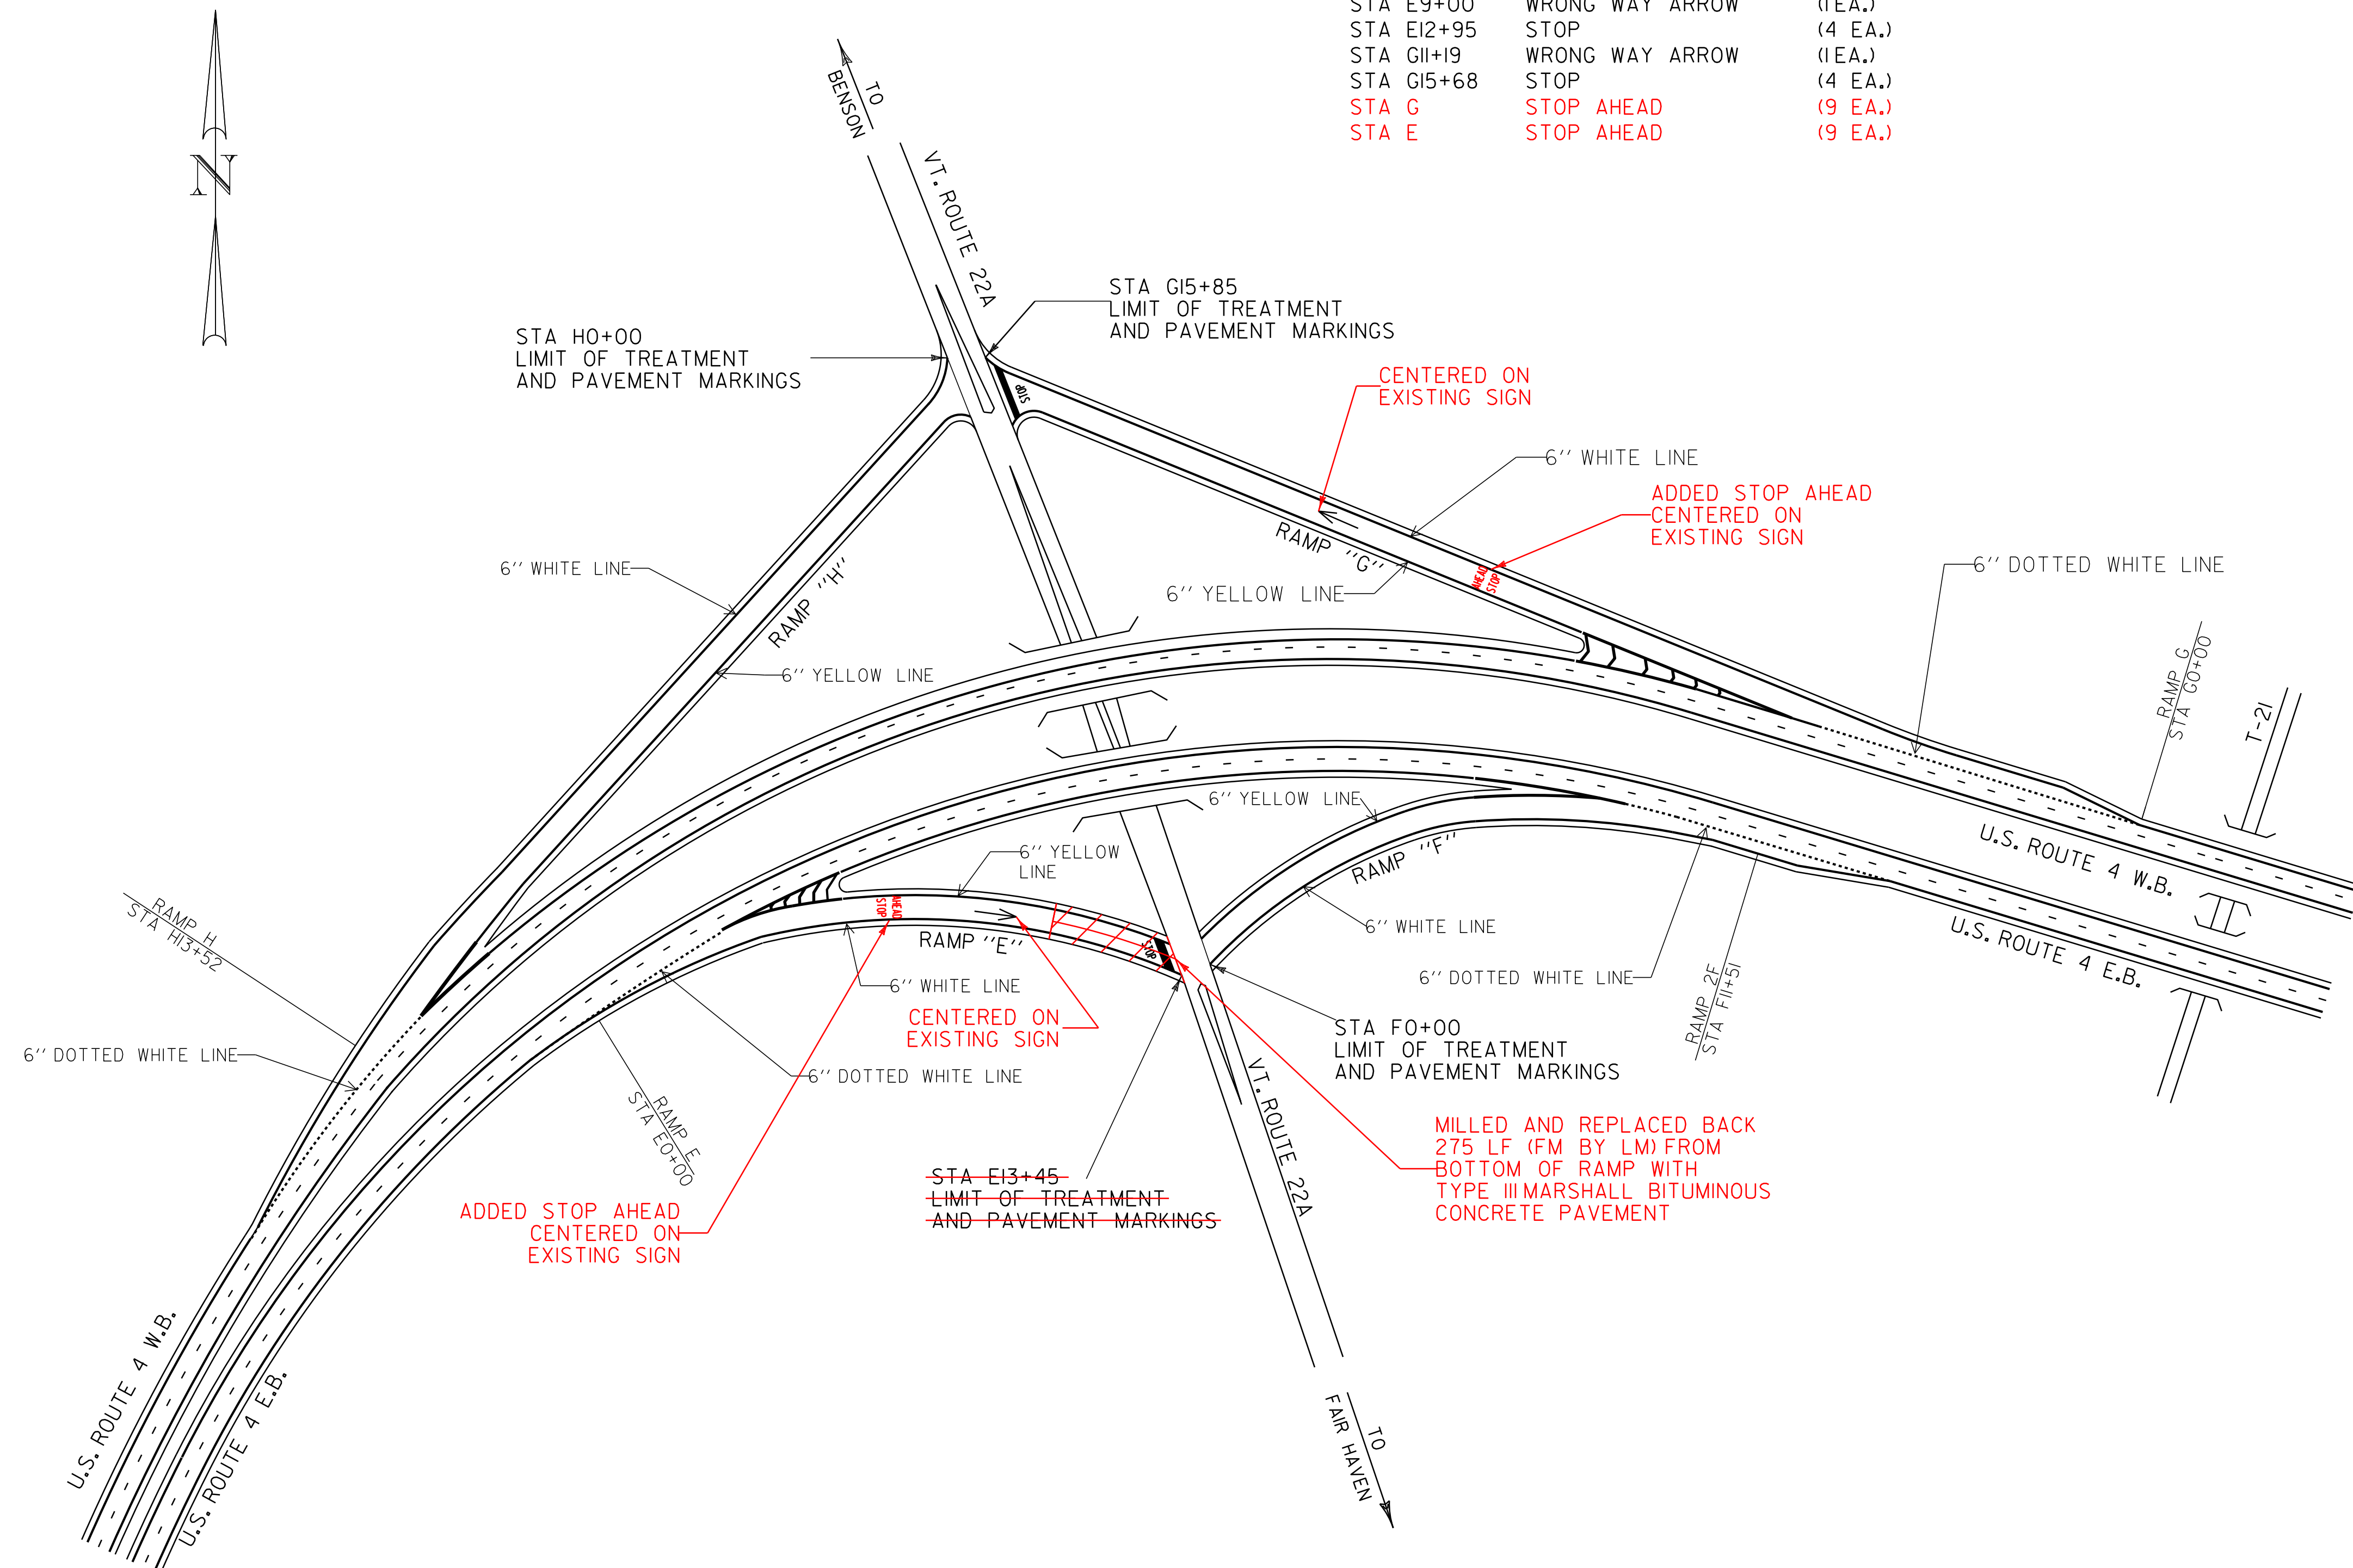

**INTERCHANGE
NO. 2
PAVEMENT
MARKING
DETAIL SHEET**

FILE NAME: IOBIO6\IOBIO6.dgn
PROJECT LEADER: M. FOWLER
DESIGNED BY: PVT. MGT.
IOBIO6*II.I

PLOT DATE: 31-MAY-2013 11:55
DRAWN BY: PVT.MGT.
CHECKED BY: PVT.MGT.
SHEET 11 OF 24

646.26 24 INCH STOP BAR
STA. LI2+24


646.680 TEMPORARY 24 INCH STOP BAR
STA. LI2+24

646.24 12 INCH WHITE LINE
GORE LOCATIONS: TO BE INSTALLED PER
THE LATEST EDITION OF THE MUTCD

646.660 TEMPORARY 12 INCH WHITE LINE
GORE LOCATIONS: TO BE INSTALLED PER
THE LATEST EDITION OF THE MUTCD

646.30 LETTER OR SYMBOL
STA LI0+40 WRONG WAY ARROW (1EA.)
STA LI2+15 STOP (4 EA.)
STA L STOP AHEAD (9 EA.)

646.690 TEMPORARY LETTER OR SYMBOL
STA LI0+40 WRONG WAY ARROW (1EA.)
STA LI2+15 STOP (4 EA.)
STA L STOP AHEAD (9 EA.)

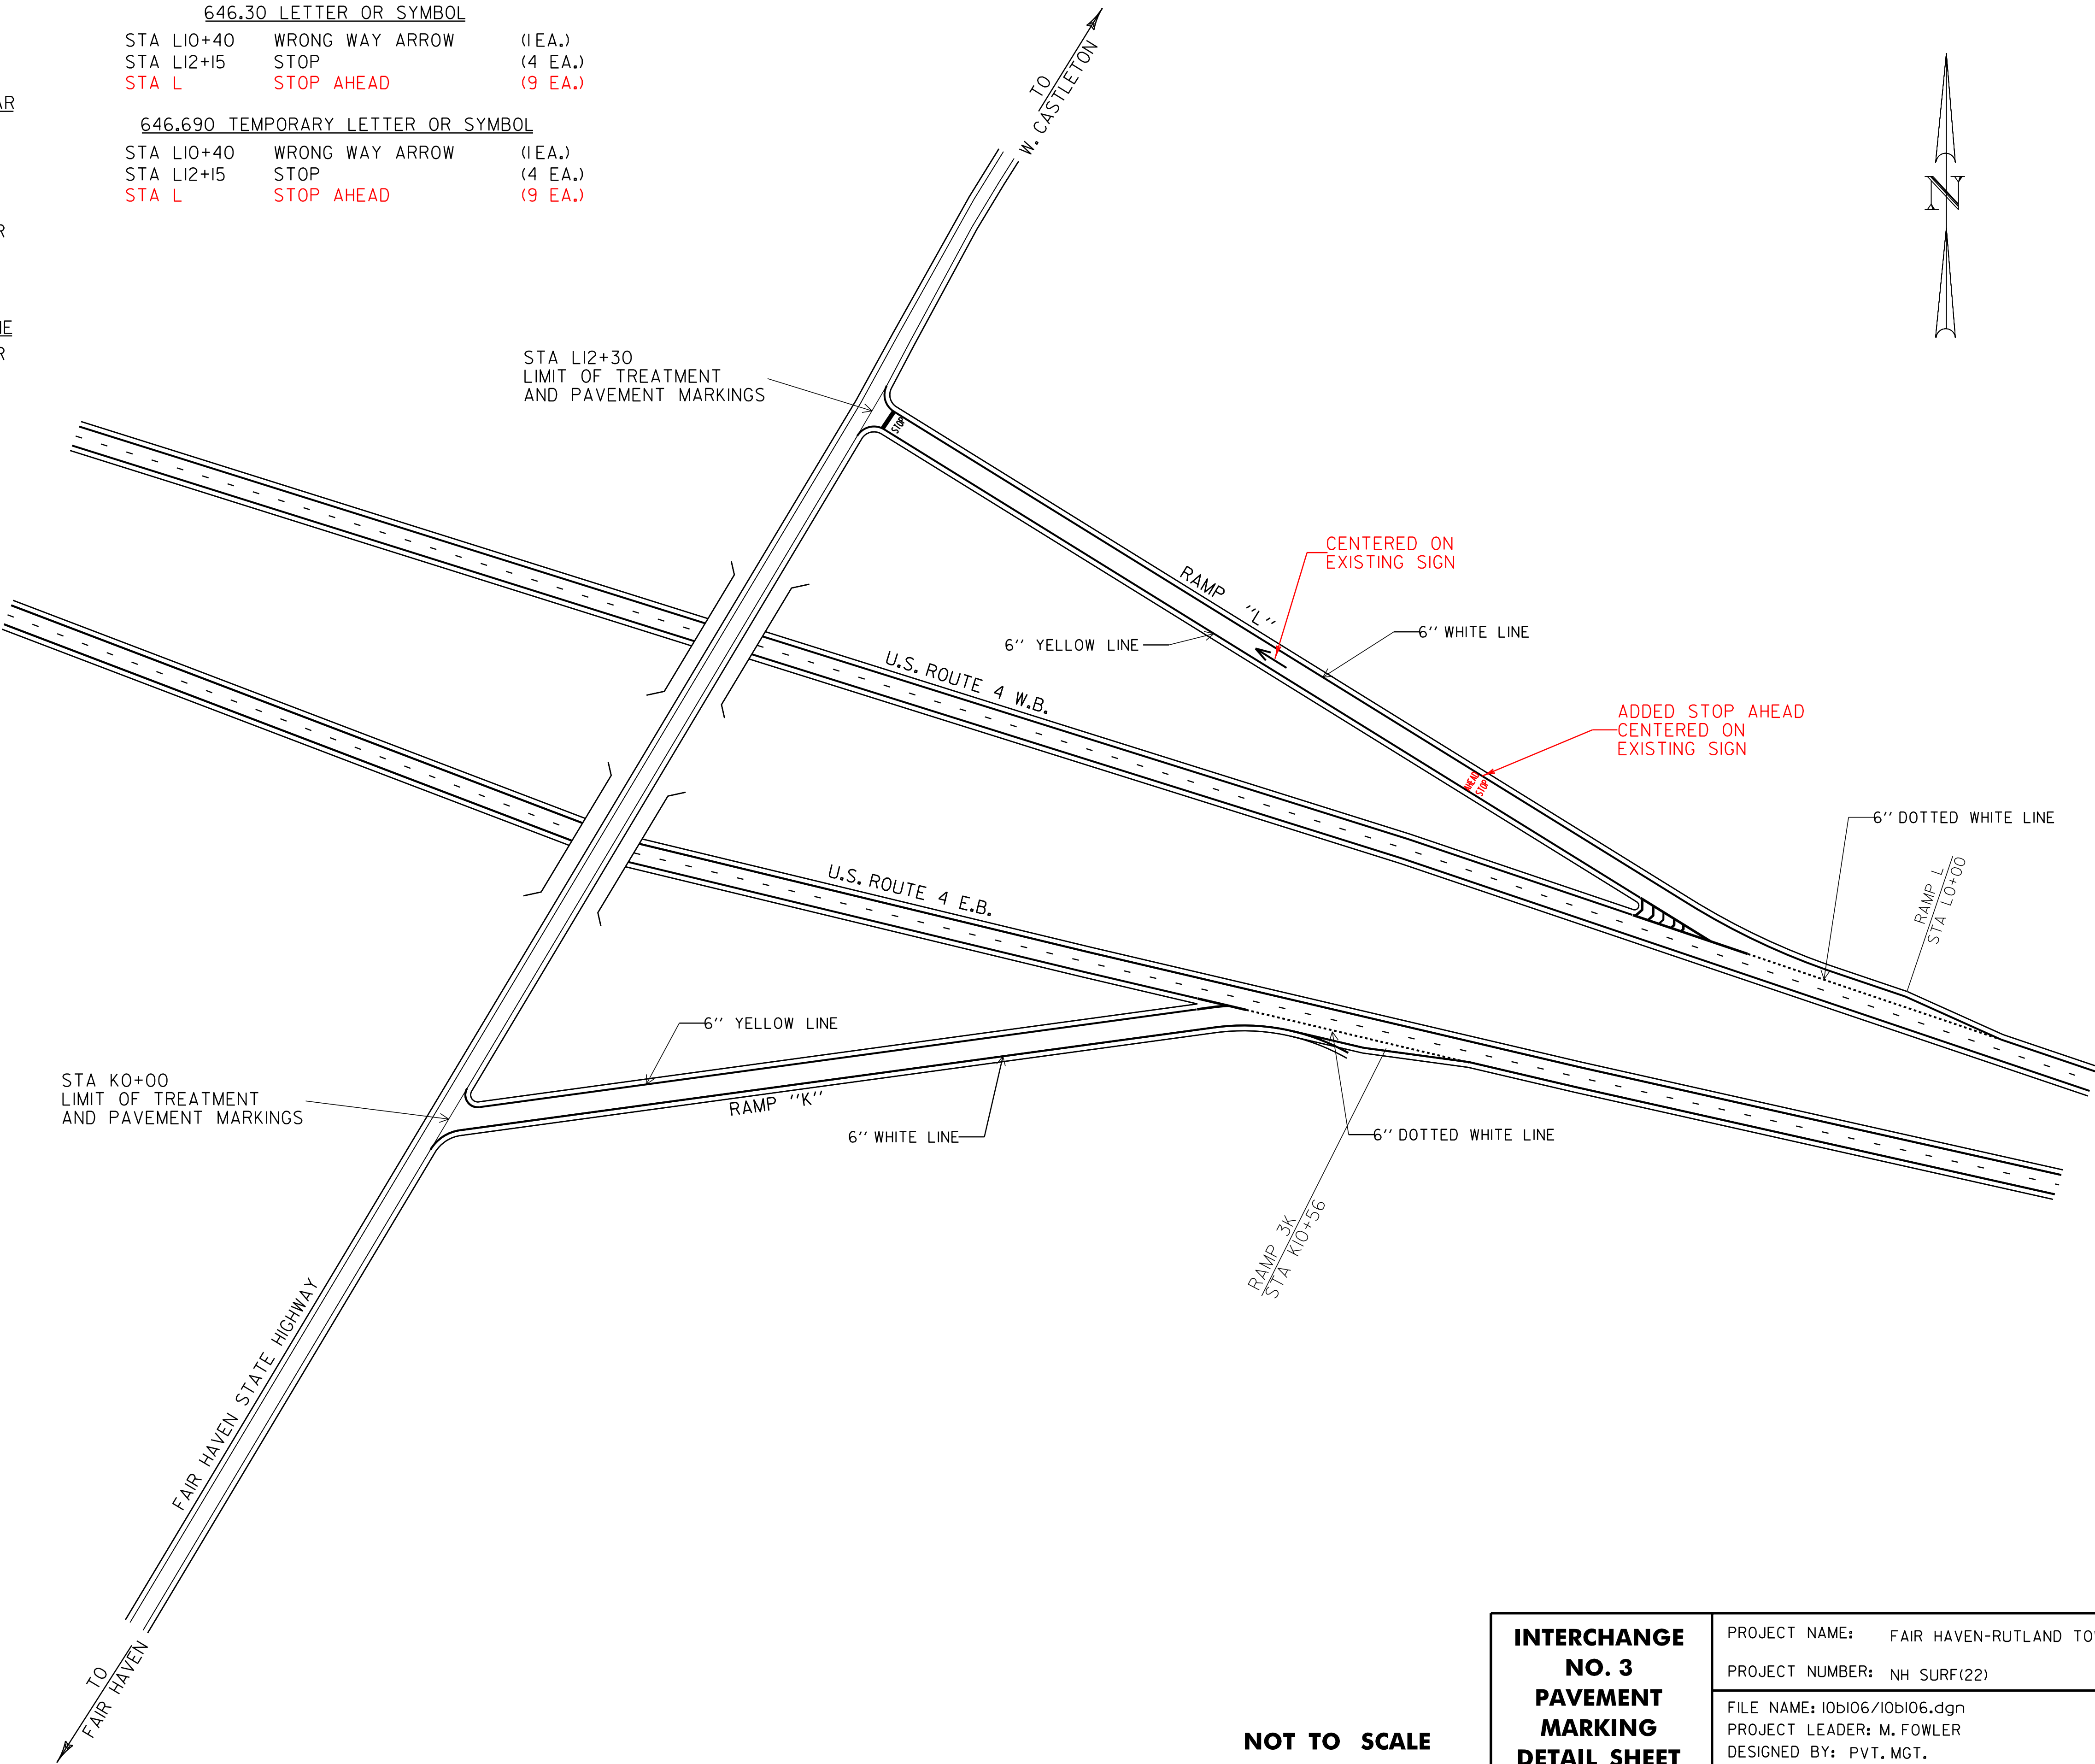

NOT TO SCALE

**INTERCHANGE
NO. 3
PAVEMENT
MARKING
DETAIL SHEET**

PROJECT NAME: FAIR HAVEN-RUTLAND TOWN

PROJECT NUMBER: NH SURF(22)

FILE NAME: IOBI06/IOBI06.dgn

PROJECT LEADER: M. FOWLER

DESIGNED BY: PVT. MGT.


IOBI06*12.1

PLOT DATE: 31-MAY-2013 11:55

DRAWN BY: PVT. MGT.

CHECKED BY: PVT. MGT.

SHEET 12 OF 24

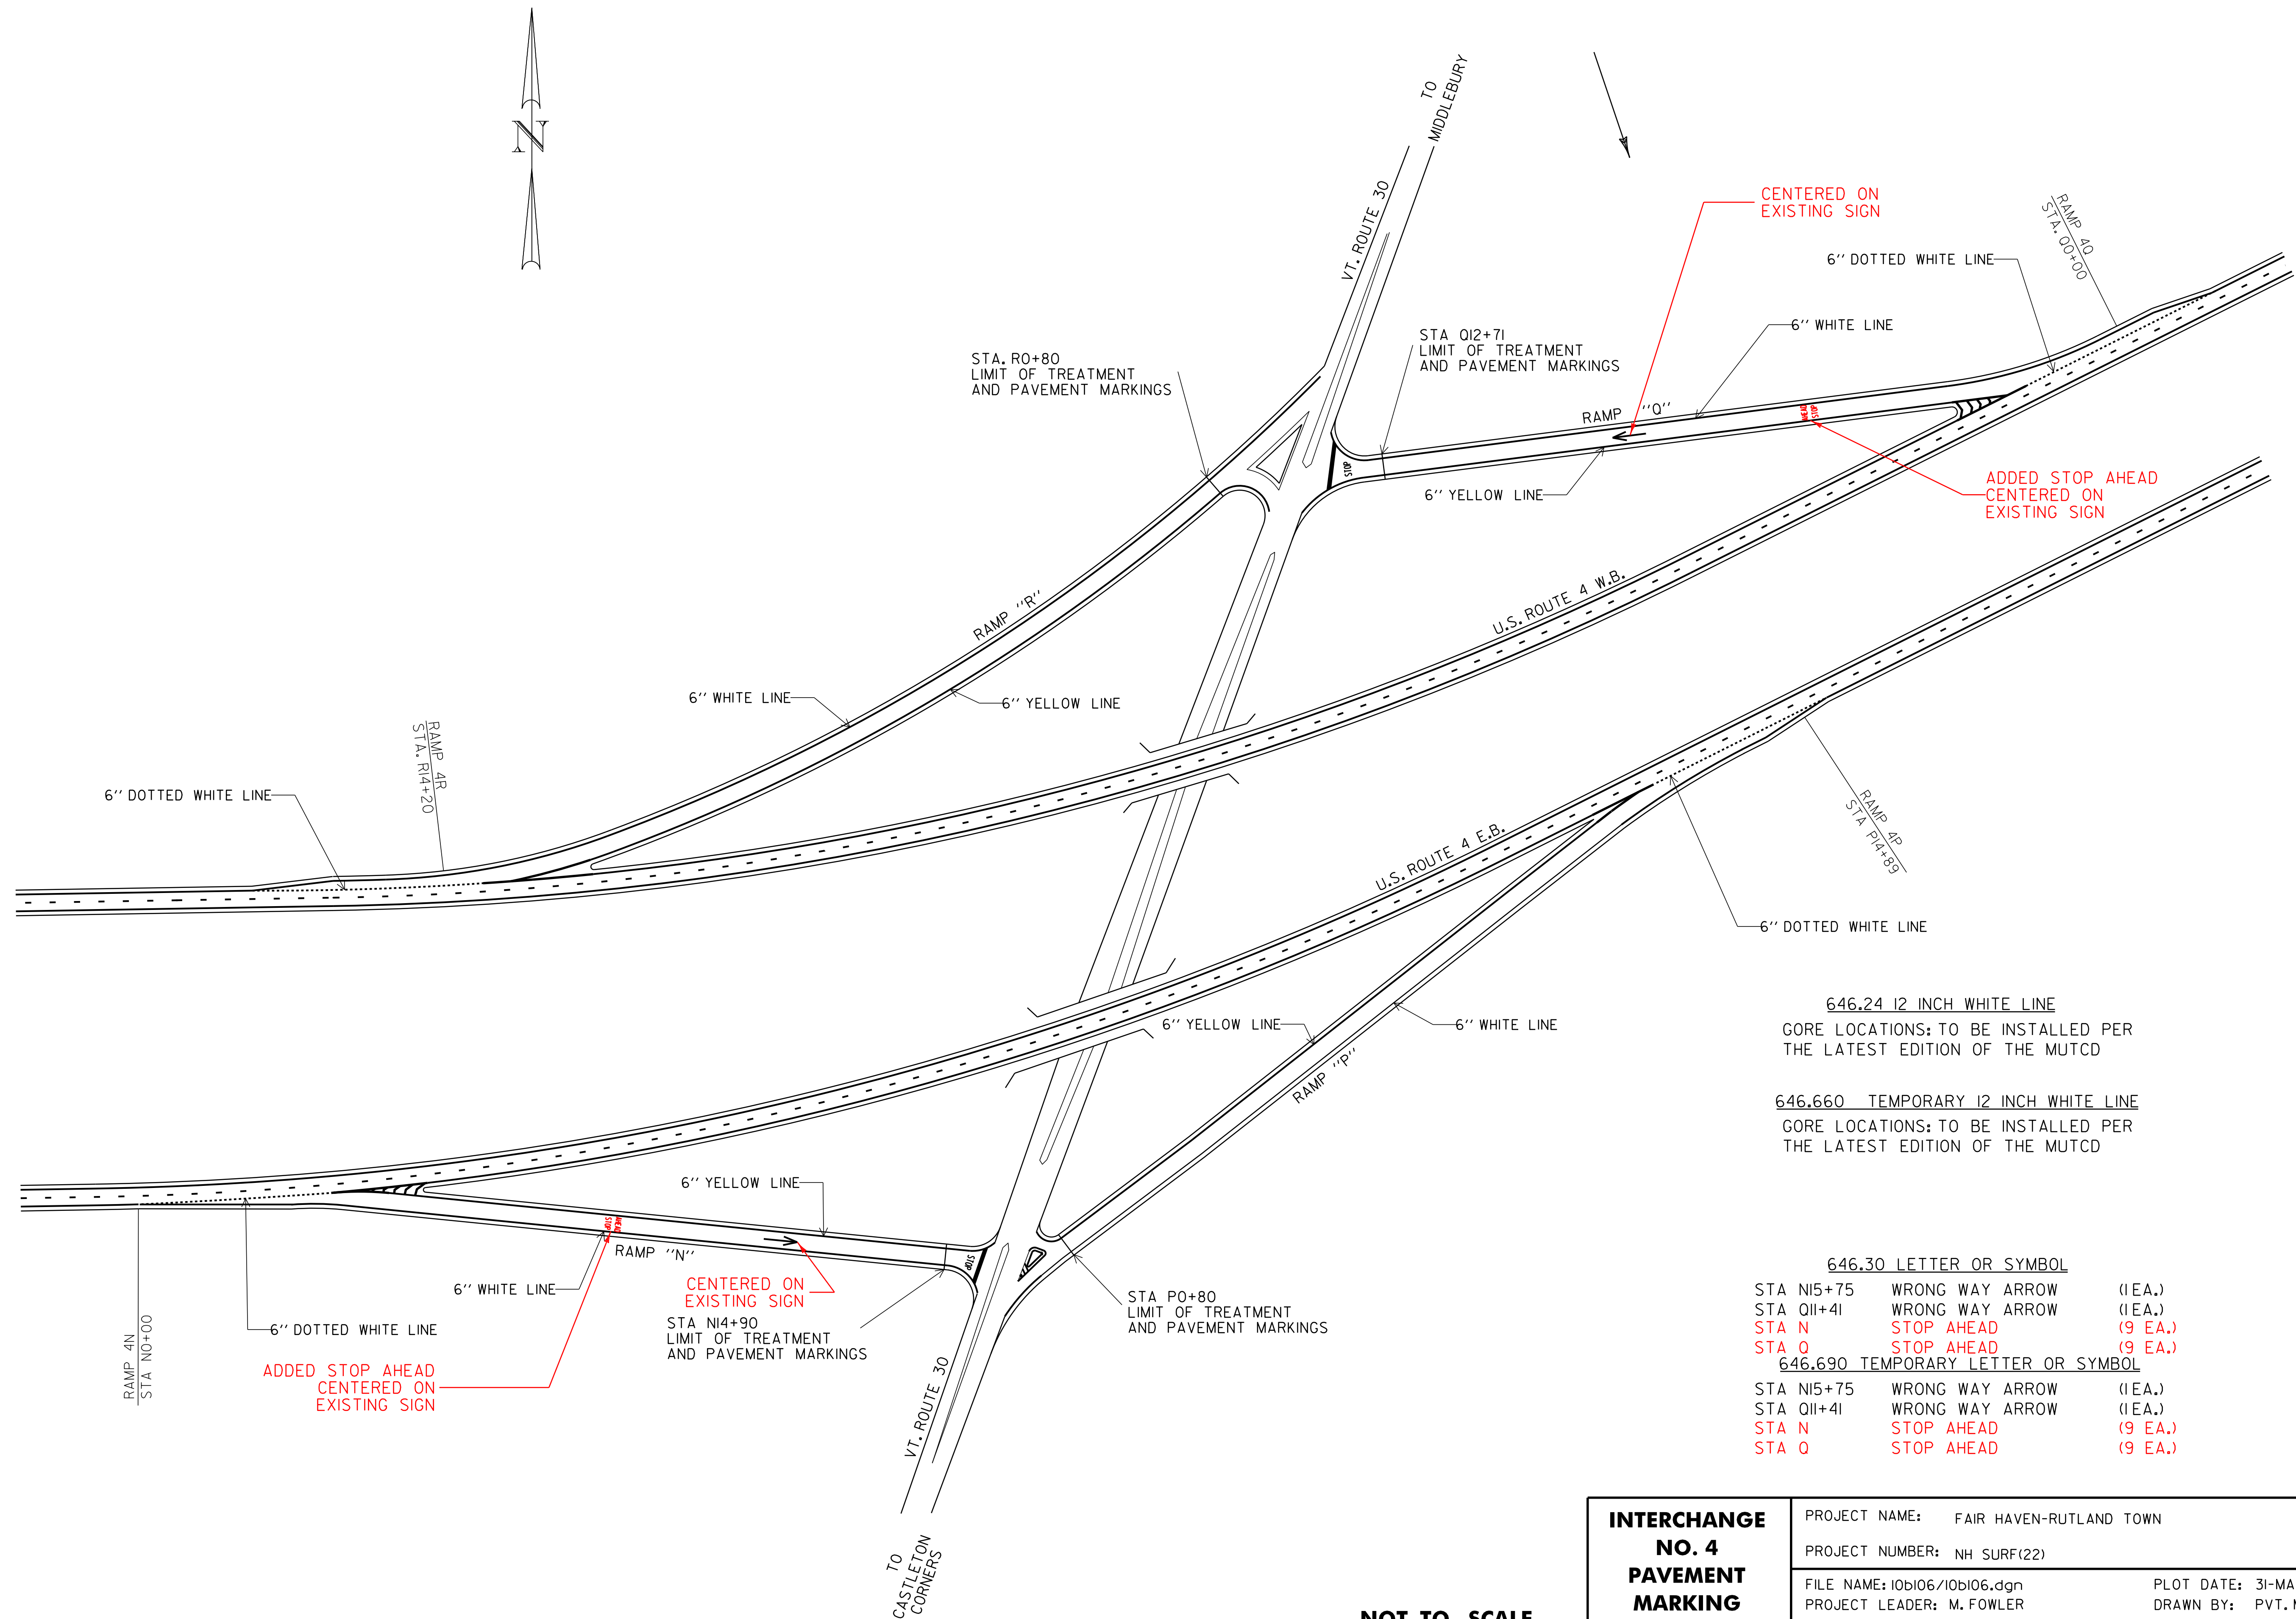


NOT TO SCALE

**INTERCHANGE
NO. 4
PAVEMENT
MARKING
DETAIL SHEET**

PROJECT NAME:	FAIR HAVEN-RUTLAND TOWN	
PROJECT NUMBER:	NH SURF(22)	
FILE NAME:	I0b106/I0b106.dgn	PLOT DATE: 31-MAY-2013 11:55
PROJECT LEADER:	M. FOWLER	DRAWN BY: PVT. MGT.
DESIGNED BY:	PVT. MGT.	CHECKED BY: PVT. MGT.
I0A106*13.1		SHEET 13 OF 24

* CHANGED LIMIT OF TREATMENT AND PAVEMENT MARKINGS DUE TO CONFLICT WITH ANOTHER PROJECT:
CASTLETON, CASTLETON, CASTLETON-WEST RUTLAND AC STP 2908, AC STP 2909, AC STP 2705

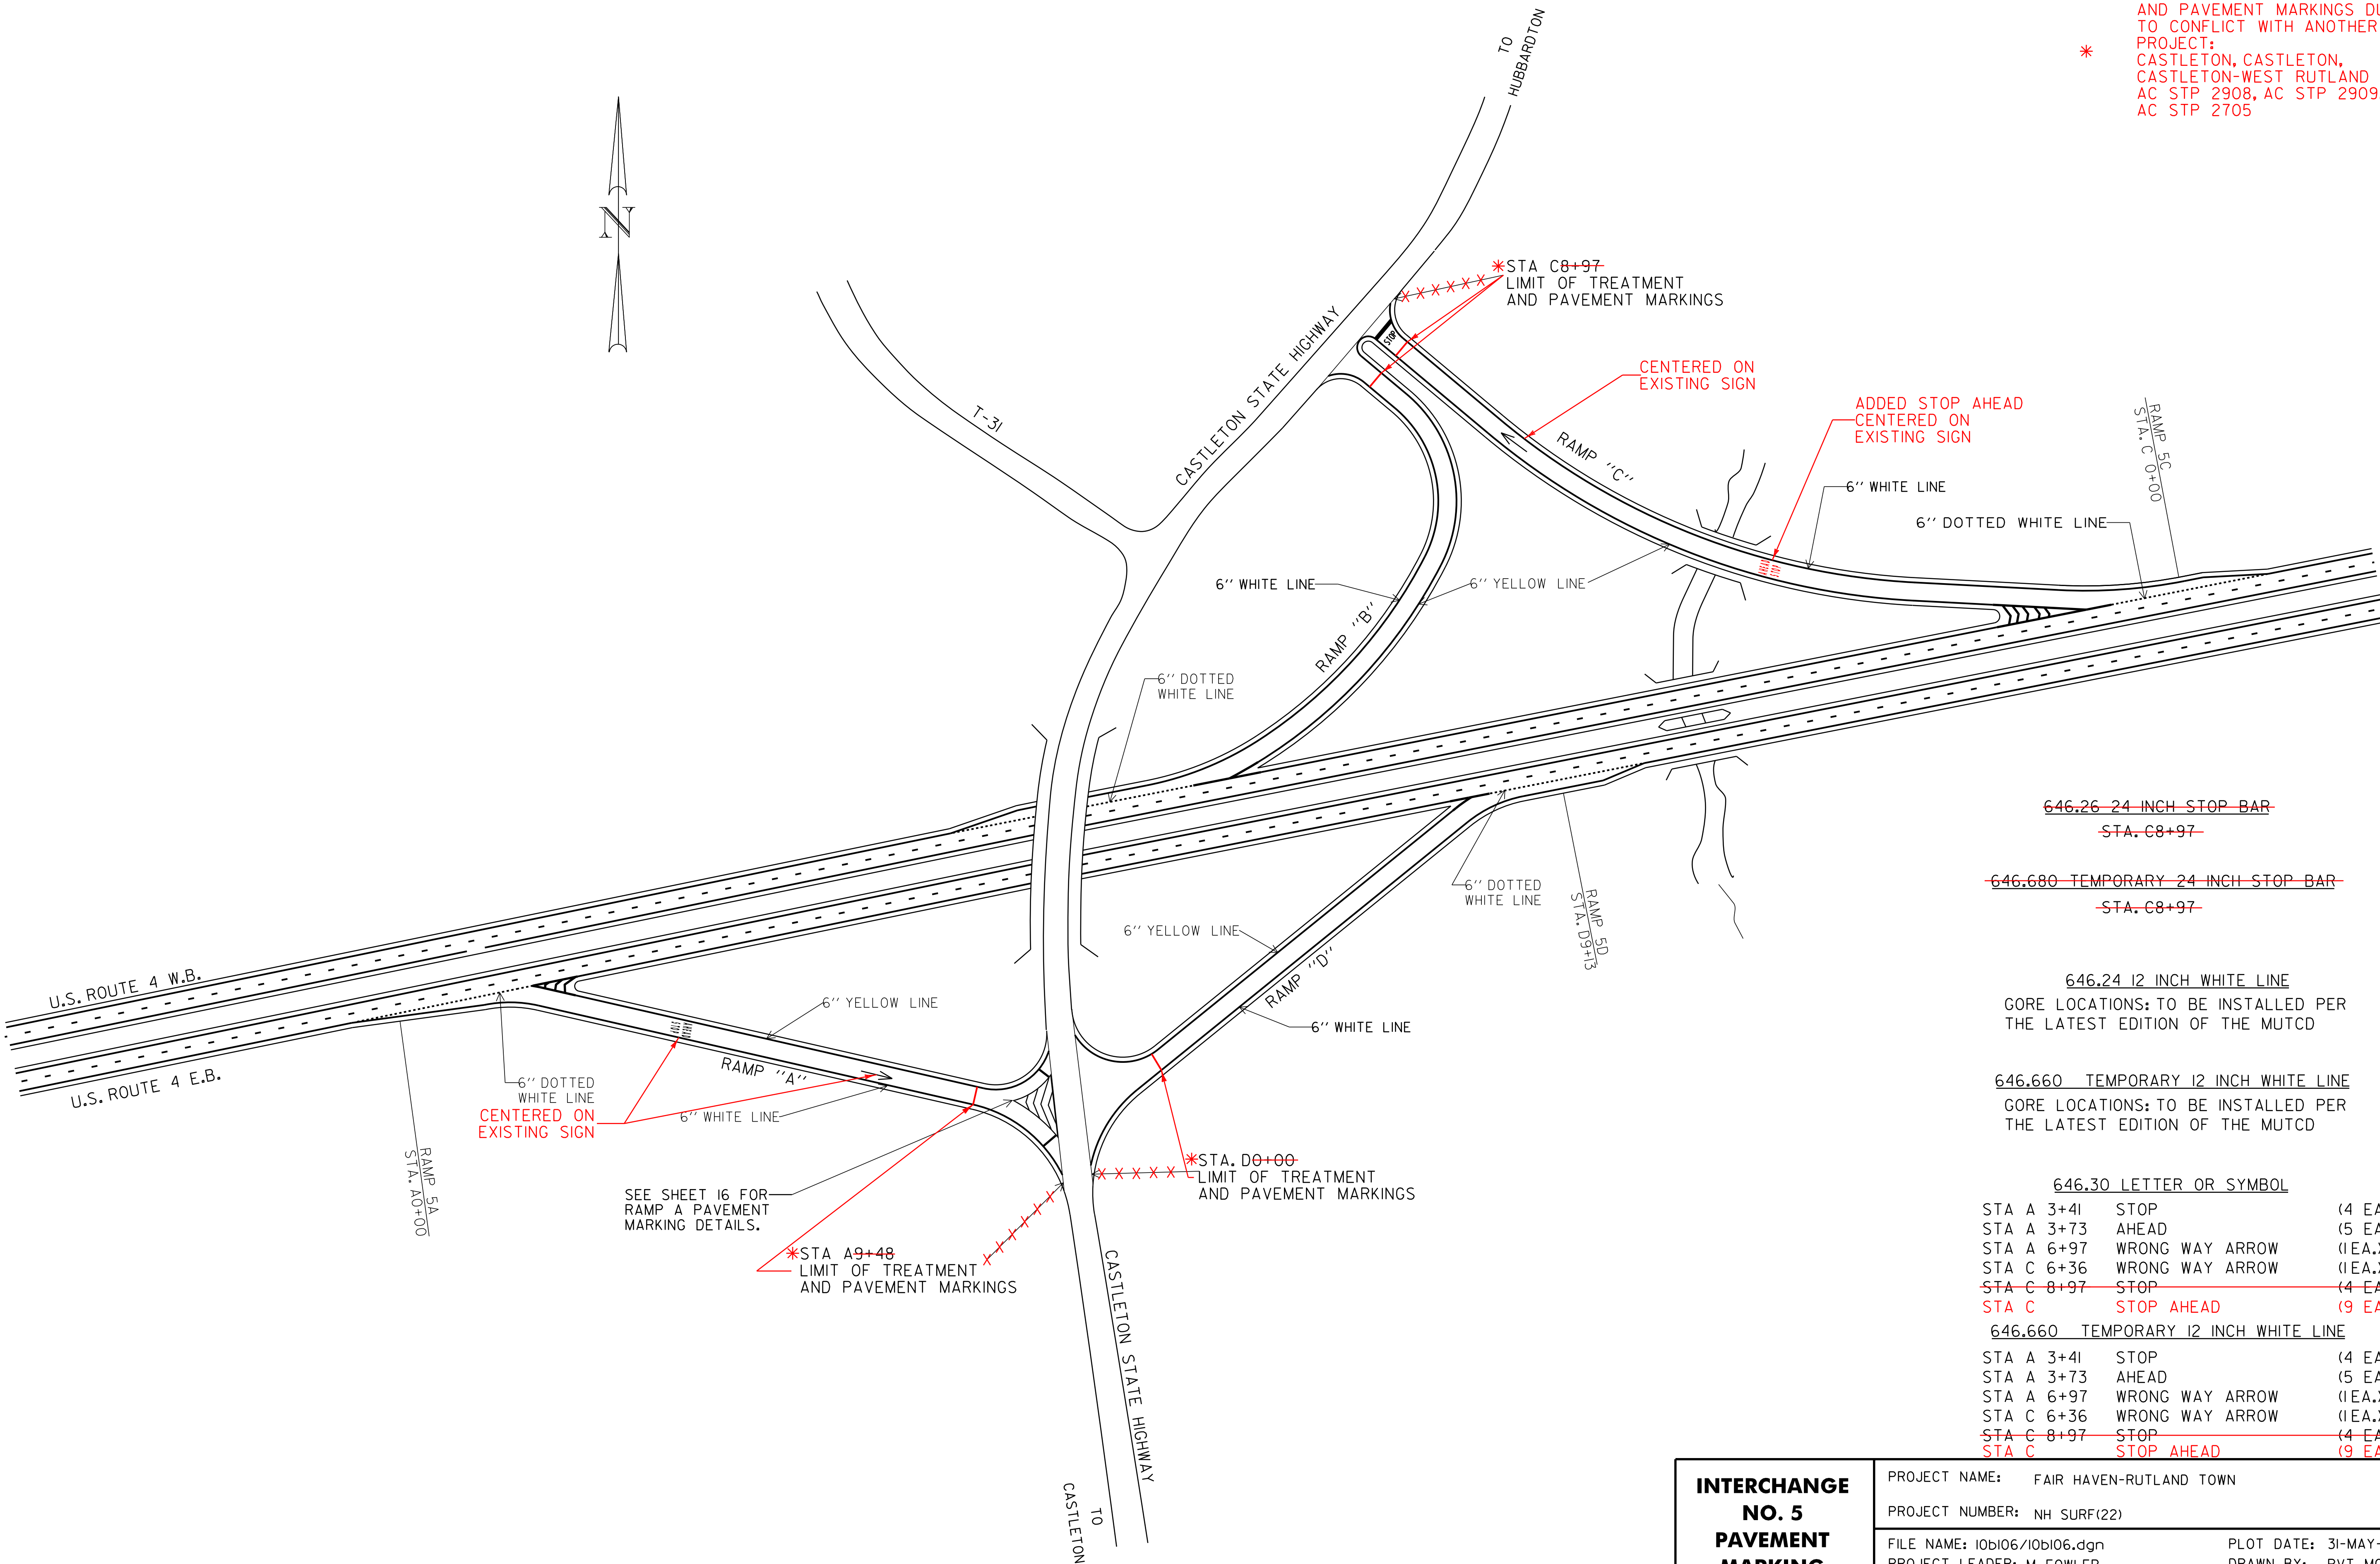

~~646.26 24 INCH STOP BAR~~
~~STA. C8+97~~



~~646.680 TEMPORARY 24 INCH STOP BAR~~
~~STA. C8+97~~

646.24 12 INCH WHITE LINE
GORE LOCATIONS: TO BE INSTALLED PER THE LATEST EDITION OF THE MUTCD

646.660 TEMPORARY 12 INCH WHITE LINE
GORE LOCATIONS: TO BE INSTALLED PER THE LATEST EDITION OF THE MUTCD

646.30 LETTER OR SYMBOL			
STA A 3+41	STOP	(4 EA.)	
STA A 3+73	AHEAD	(5 EA.)	
STA A 6+97	WRONG WAY ARROW	(1 EA.)	
STA C 6+36	WRONG WAY ARROW	(1 EA.)	
STA C 8+97	STOP	(4 EA.)	
STA C	STOP AHEAD	(9 EA.)	
646.660 TEMPORARY 12 INCH WHITE LINE			
STA A 3+41	STOP	(4 EA.)	
STA A 3+73	AHEAD	(5 EA.)	
STA A 6+97	WRONG WAY ARROW	(1 EA.)	
STA C 6+36	WRONG WAY ARROW	(1 EA.)	
STA C 8+97	STOP	(4 EA.)	
STA C	STOP AHEAD	(9 EA.)	

INTERCHANGE NO. 5 PAVEMENT MARKING DETAIL SHEET	PROJECT NAME: FAIR HAVEN-RUTLAND TOWN	
	PROJECT NUMBER: NH SURF(22)	
	FILE NAME: 10b106/10b106.dgn	PLOT DATE: 31-MAY-2013 11:55
	PROJECT LEADER: M. FOWLER	DRAWN BY: PVT. MGT.
	DESIGNED BY: PVT. MGT.	CHECKED BY: PVT. MGT.
	10A106*14.1	SHEET 14 OF 24

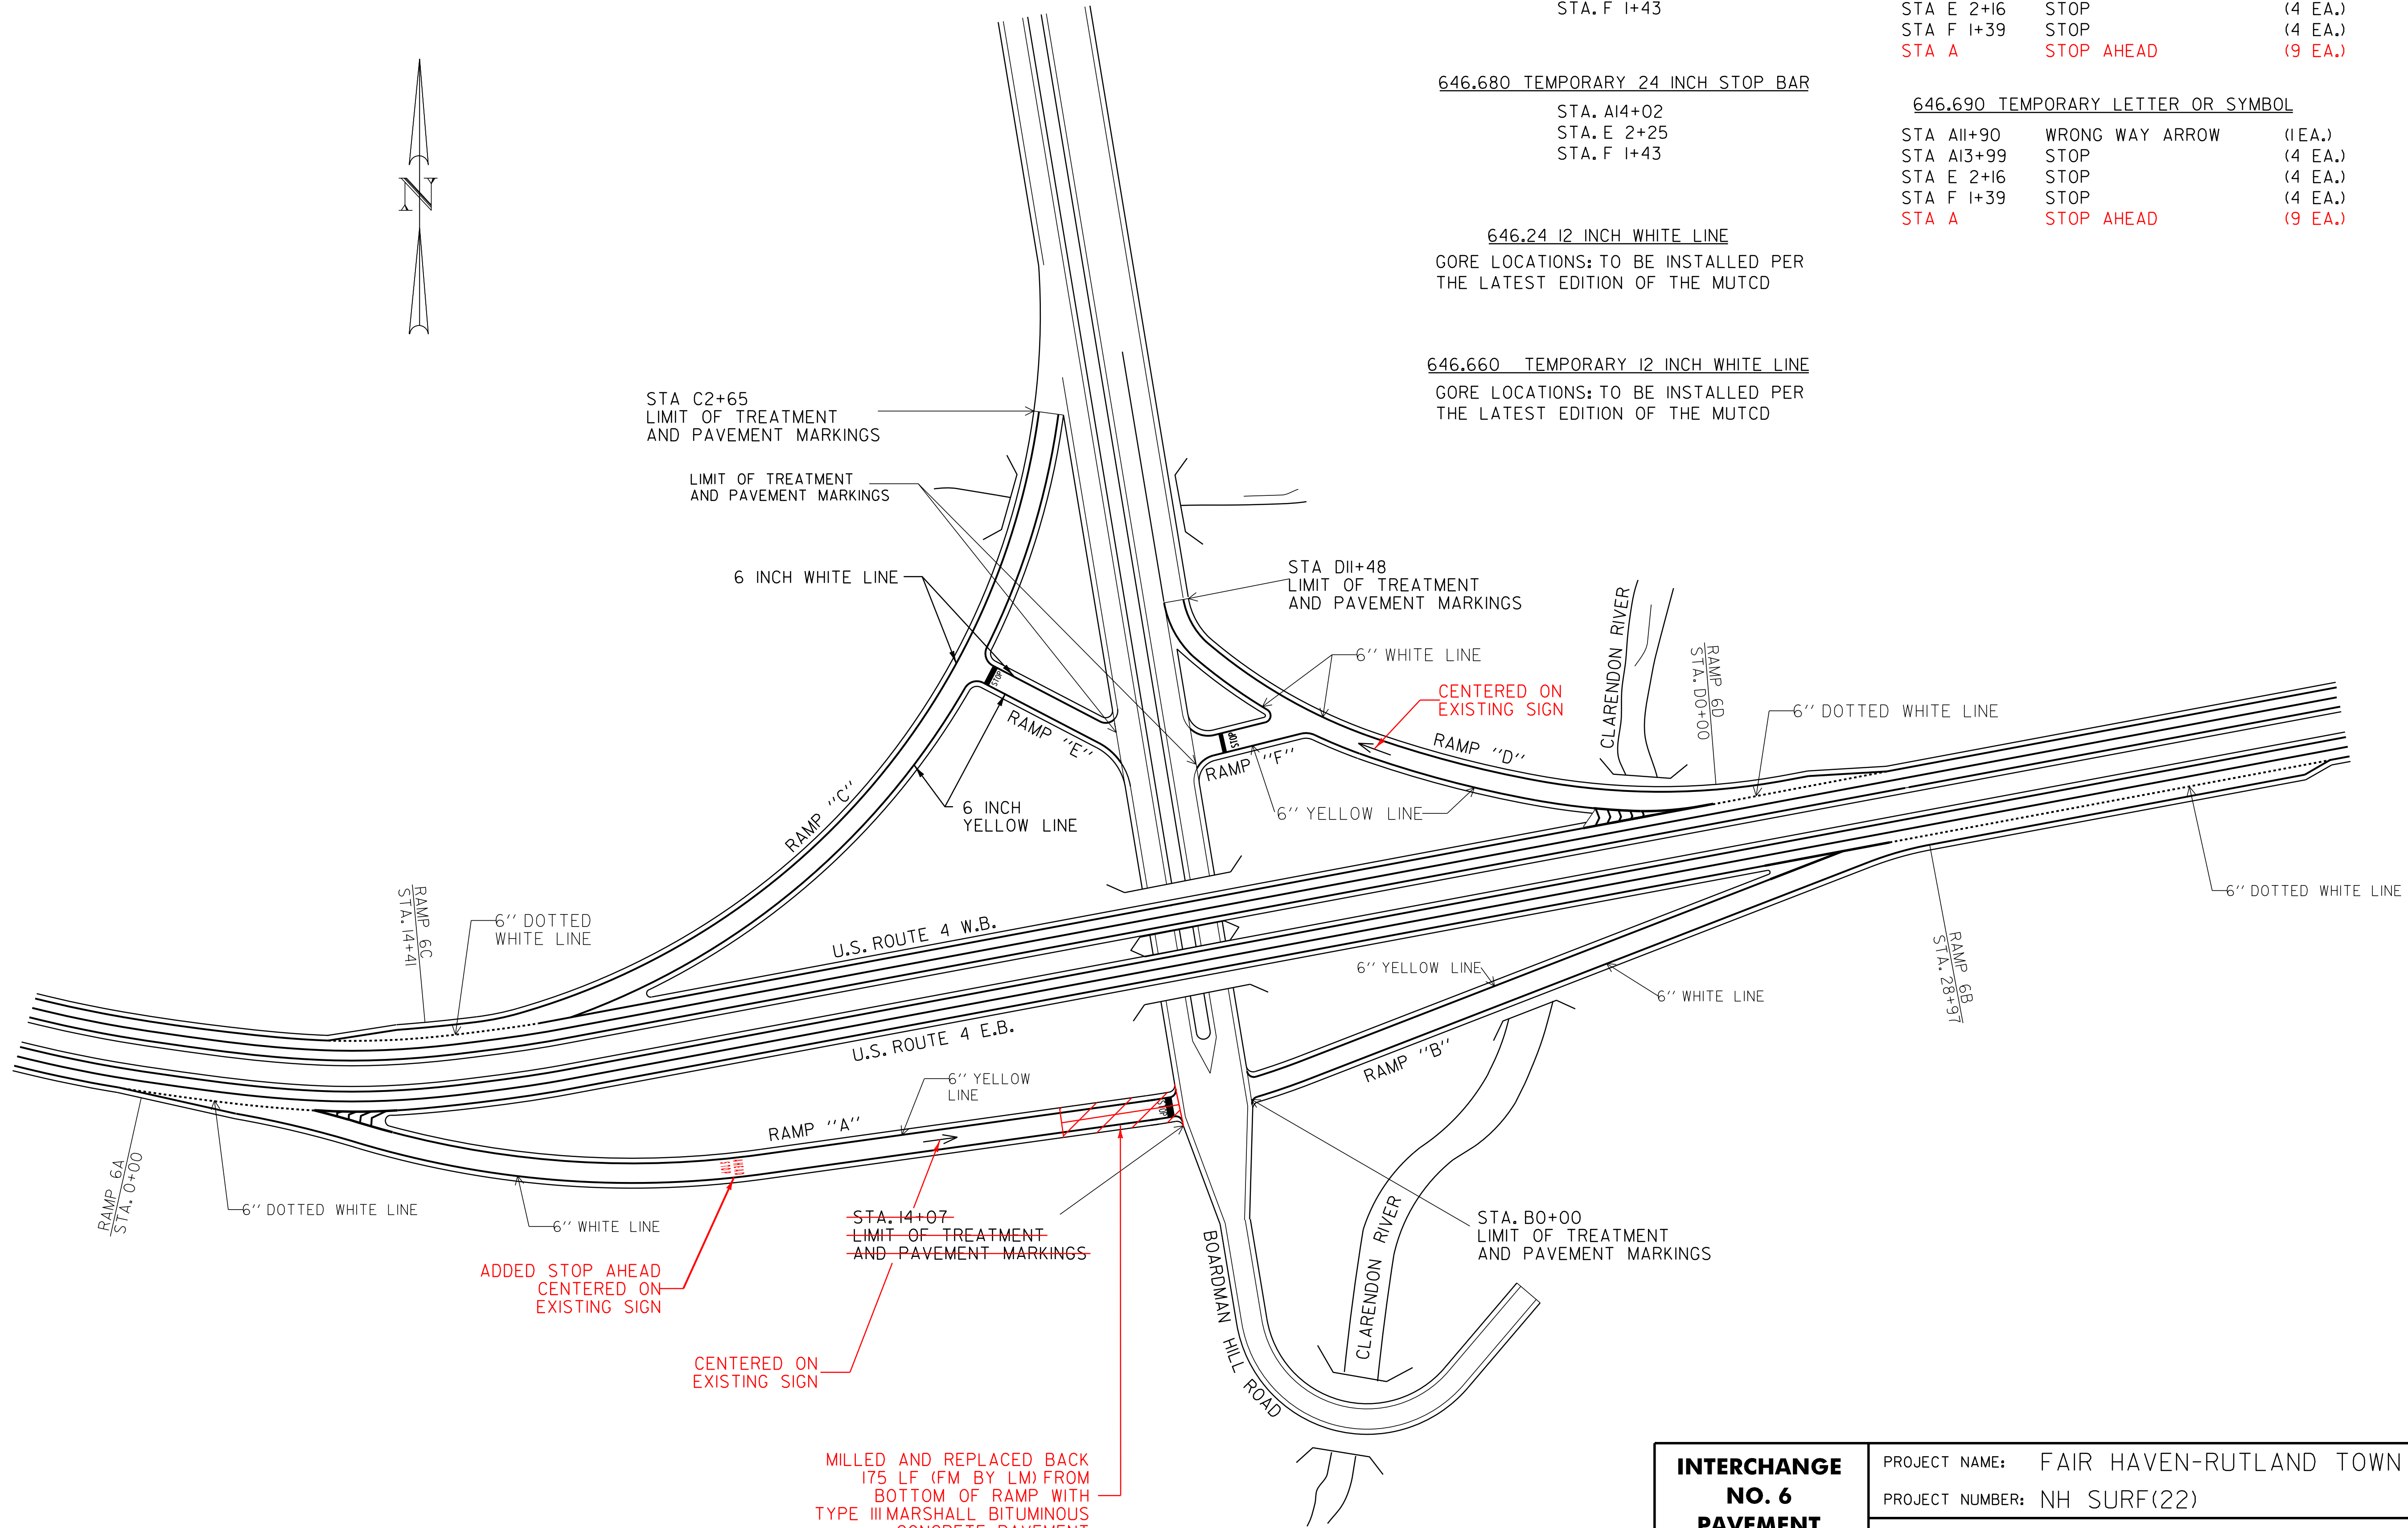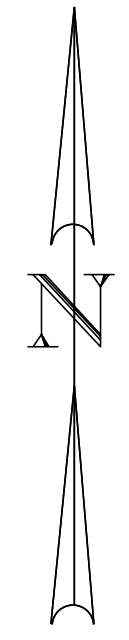

646.26 24 INCH STOP BAR

STA. A14+02
STA. E 2+25
STA. F 1+43

646.30 LETTER OR SYMBOL

STA A11+90 WRONG WAY ARROW (1EA.)
STA A13+99 STOP (4 EA.)
STA E 2+16 STOP (4 EA.)
STA F 1+39 STOP (4 EA.)
STA A STOP AHEAD (9 EA.)

646.680 TEMPORARY 24 INCH STOP BAR

STA. A14+02
STA. E 2+25
STA. F 1+43

646.690 TEMPORARY LETTER OR SYMBOL

STA A11+90 WRONG WAY ARROW (1EA.)
STA A13+99 STOP (4 EA.)
STA E 2+16 STOP (4 EA.)
STA F 1+39 STOP (4 EA.)
STA A STOP AHEAD (9 EA.)

646.24 12 INCH WHITE LINE

GORE LOCATIONS: TO BE INSTALLED PER
THE LATEST EDITION OF THE MUTCD

646.660 TEMPORARY 12 INCH WHITE LINE

GORE LOCATIONS: TO BE INSTALLED PER
THE LATEST EDITION OF THE MUTCD

NOT TO SCALE

INTERCHANGE
NO. 6
PAVEMENT
MARKING
DETAIL SHEET

PROJECT NAME: FAIR HAVEN-RUTLAND TOWN	
PROJECT NUMBER: NH SURF(22)	
FILE NAME: 10B106/10B106.DGN	PLOT DATE: 31-MAY-2013 11:55
PROJECT LEADER: M. FOWLER	DRAWN BY: PVT. MGT.
DESIGNED BY: PVT. MGT.	CHECKED BY: PVT. MGT.
10B106*15.1	SHEET 15 OF 24


ADDED STOP AHEAD
CENTERED ON
EXISTING SIGN

CENTERED ON
EXISTING SIGN

MILLED AND REPLACED BACK
175 LF (FM BY LM) FROM
BOTTOM OF RAMP WITH
TYPE III MARSHALL BITUMINOUS
CONCRETE PAVEMENT

~~STA. 14+07
LIMIT OF TREATMENT
AND PAVEMENT MARKINGS~~

CENTERED ON
EXISTING SIGN

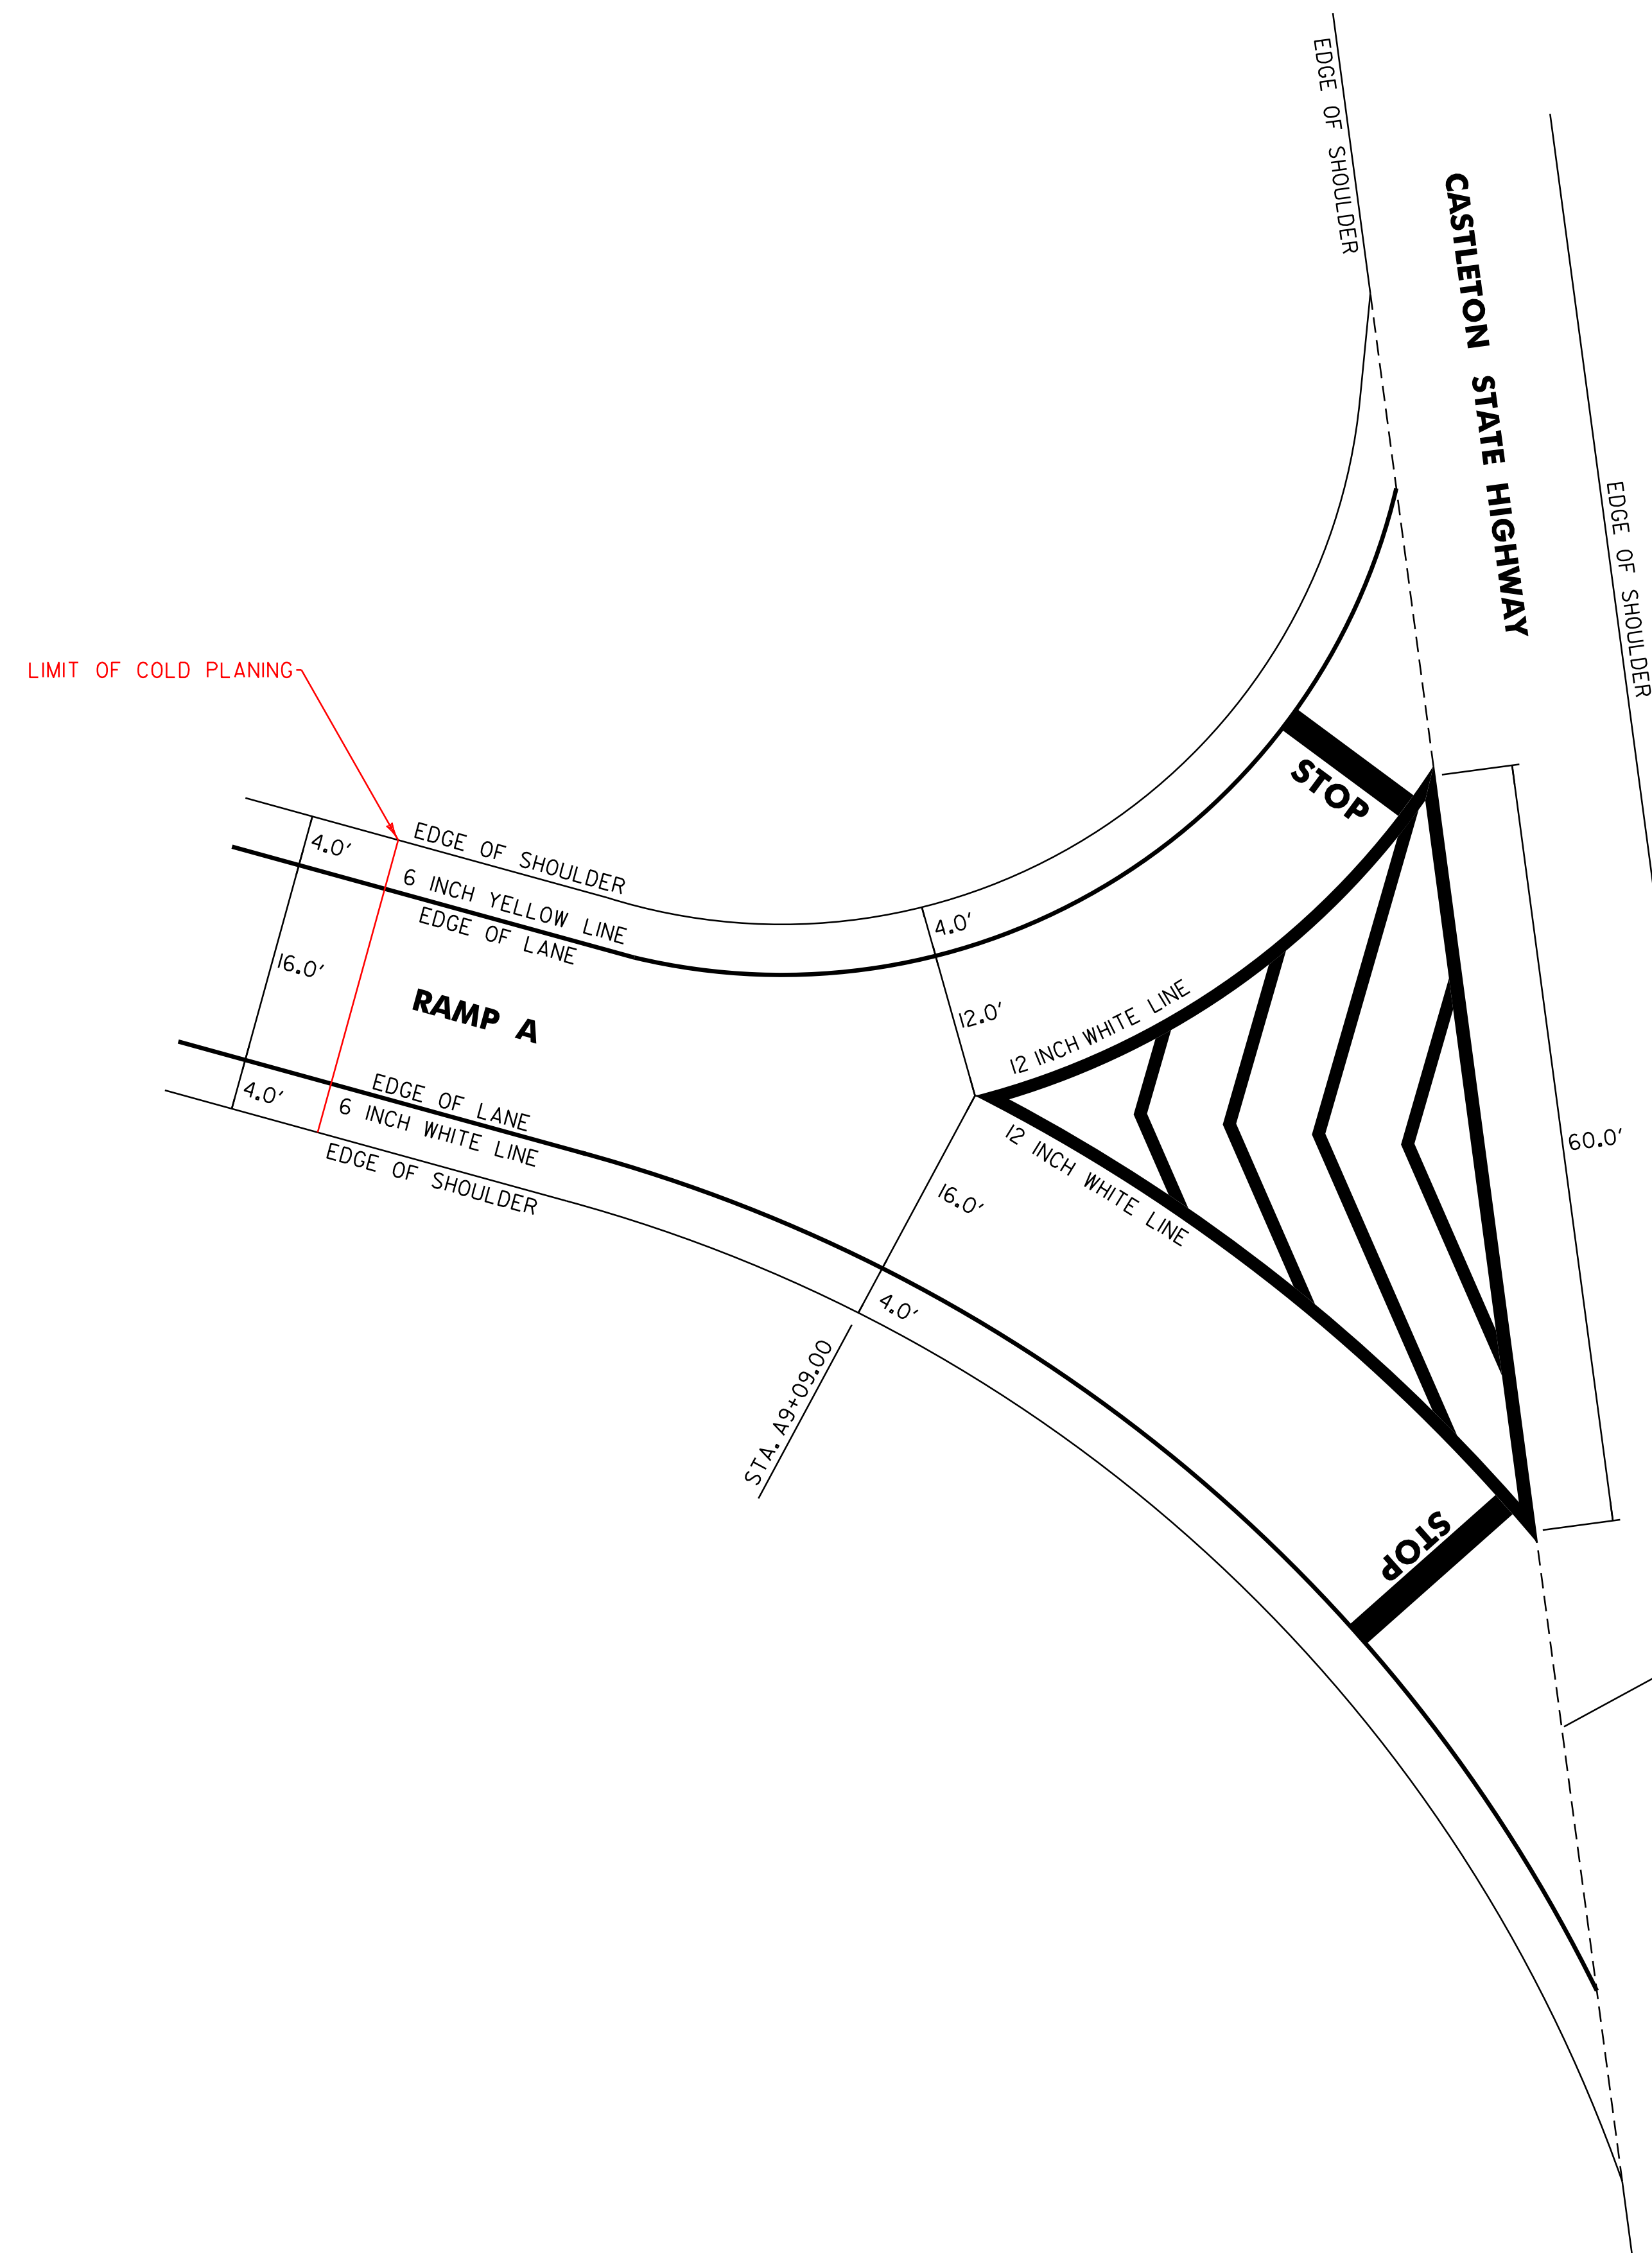

646.215 6 INCH YELLOW LINE
STA. A8+53.00 - STA. A9+48.00 SOLID LINE LT

646.630 TEMPORARY 6 INCH YELLOW LINE
STA. A8+53.00 - STA. A9+48.00 SOLID LINE LT

646.214 6 INCH WHITE LINE
STA. A8+53.00 - STA. A9+48.00 SOLID LINE LT

646.620 TEMPORARY 6 INCH WHITE LINE
STA. A8+53.00 - STA. A9+48.00 SOLID LINE RT

* 646.24 12 INCH WHITE LINE
~~STA. A9+09.00 - STA. A9+48.00 GORE LINES/HATCHING LT & RT~~

646.660 TEMPORARY 12 INCH WHITE LINE
~~STA. A9+09.00 - STA. A9+48.00 GORE LINES/HATCHING LT & RT~~

* 646.26 24 INCH STOP BAR
~~STA. A9+43.00 LT~~
~~STA. A9+43.00 RT~~

646.680 TEMPORARY 24 INCH STOP BAR
~~STA. A9+43.00 LT~~
~~STA. A9+43.00 RT~~

* 646.30 LETTER OR SYMBOL
~~STA. A9+34.00 LT, "S,T,O,P" (4 EA)~~
~~STA. A9+34.00 RT, "S,T,O,P" (4 EA)~~


646.690 TEMPORARY LETTER OR SYMBOL
~~STA. A9+34.00 LT, "S,T,O,P" (4 EA)~~
~~STA. A9+34.00 RT, "S,T,O,P" (4 EA)~~

* COMPLETED UNDER ANOTHER CONTRACT:
CASTLETON, CASTLETON, CASTLETON-WEST
RUTLAND: AC STP 2908, AC STP 2909, AC STP 2705

~~LIMIT OF COLD PLANING,
PAVING AND PAVEMENT
MARKINGS
STA. A9+48.00~~

NOT TO SCALE

INTERCHANGE NO. 5 RAMP A PAVEMENT MARKING DETAIL SHEET	PROJECT NAME: FAIR HAVEN-RUTLAND TOWN	
	PROJECT NUMBER: NH SURF(22)	
	FILE NAME: IOBIO6/IOBIO6.DGN PROJECT LEADER: M. FOWLER DESIGNED BY: PVT. MGT. IOBIO6*16.I	PLOT DATE: 31-MAY-2013 11:55 DRAWN BY: PVT. MGT. CHECKED BY: PVT. MGT. SHEET 16 OF 24

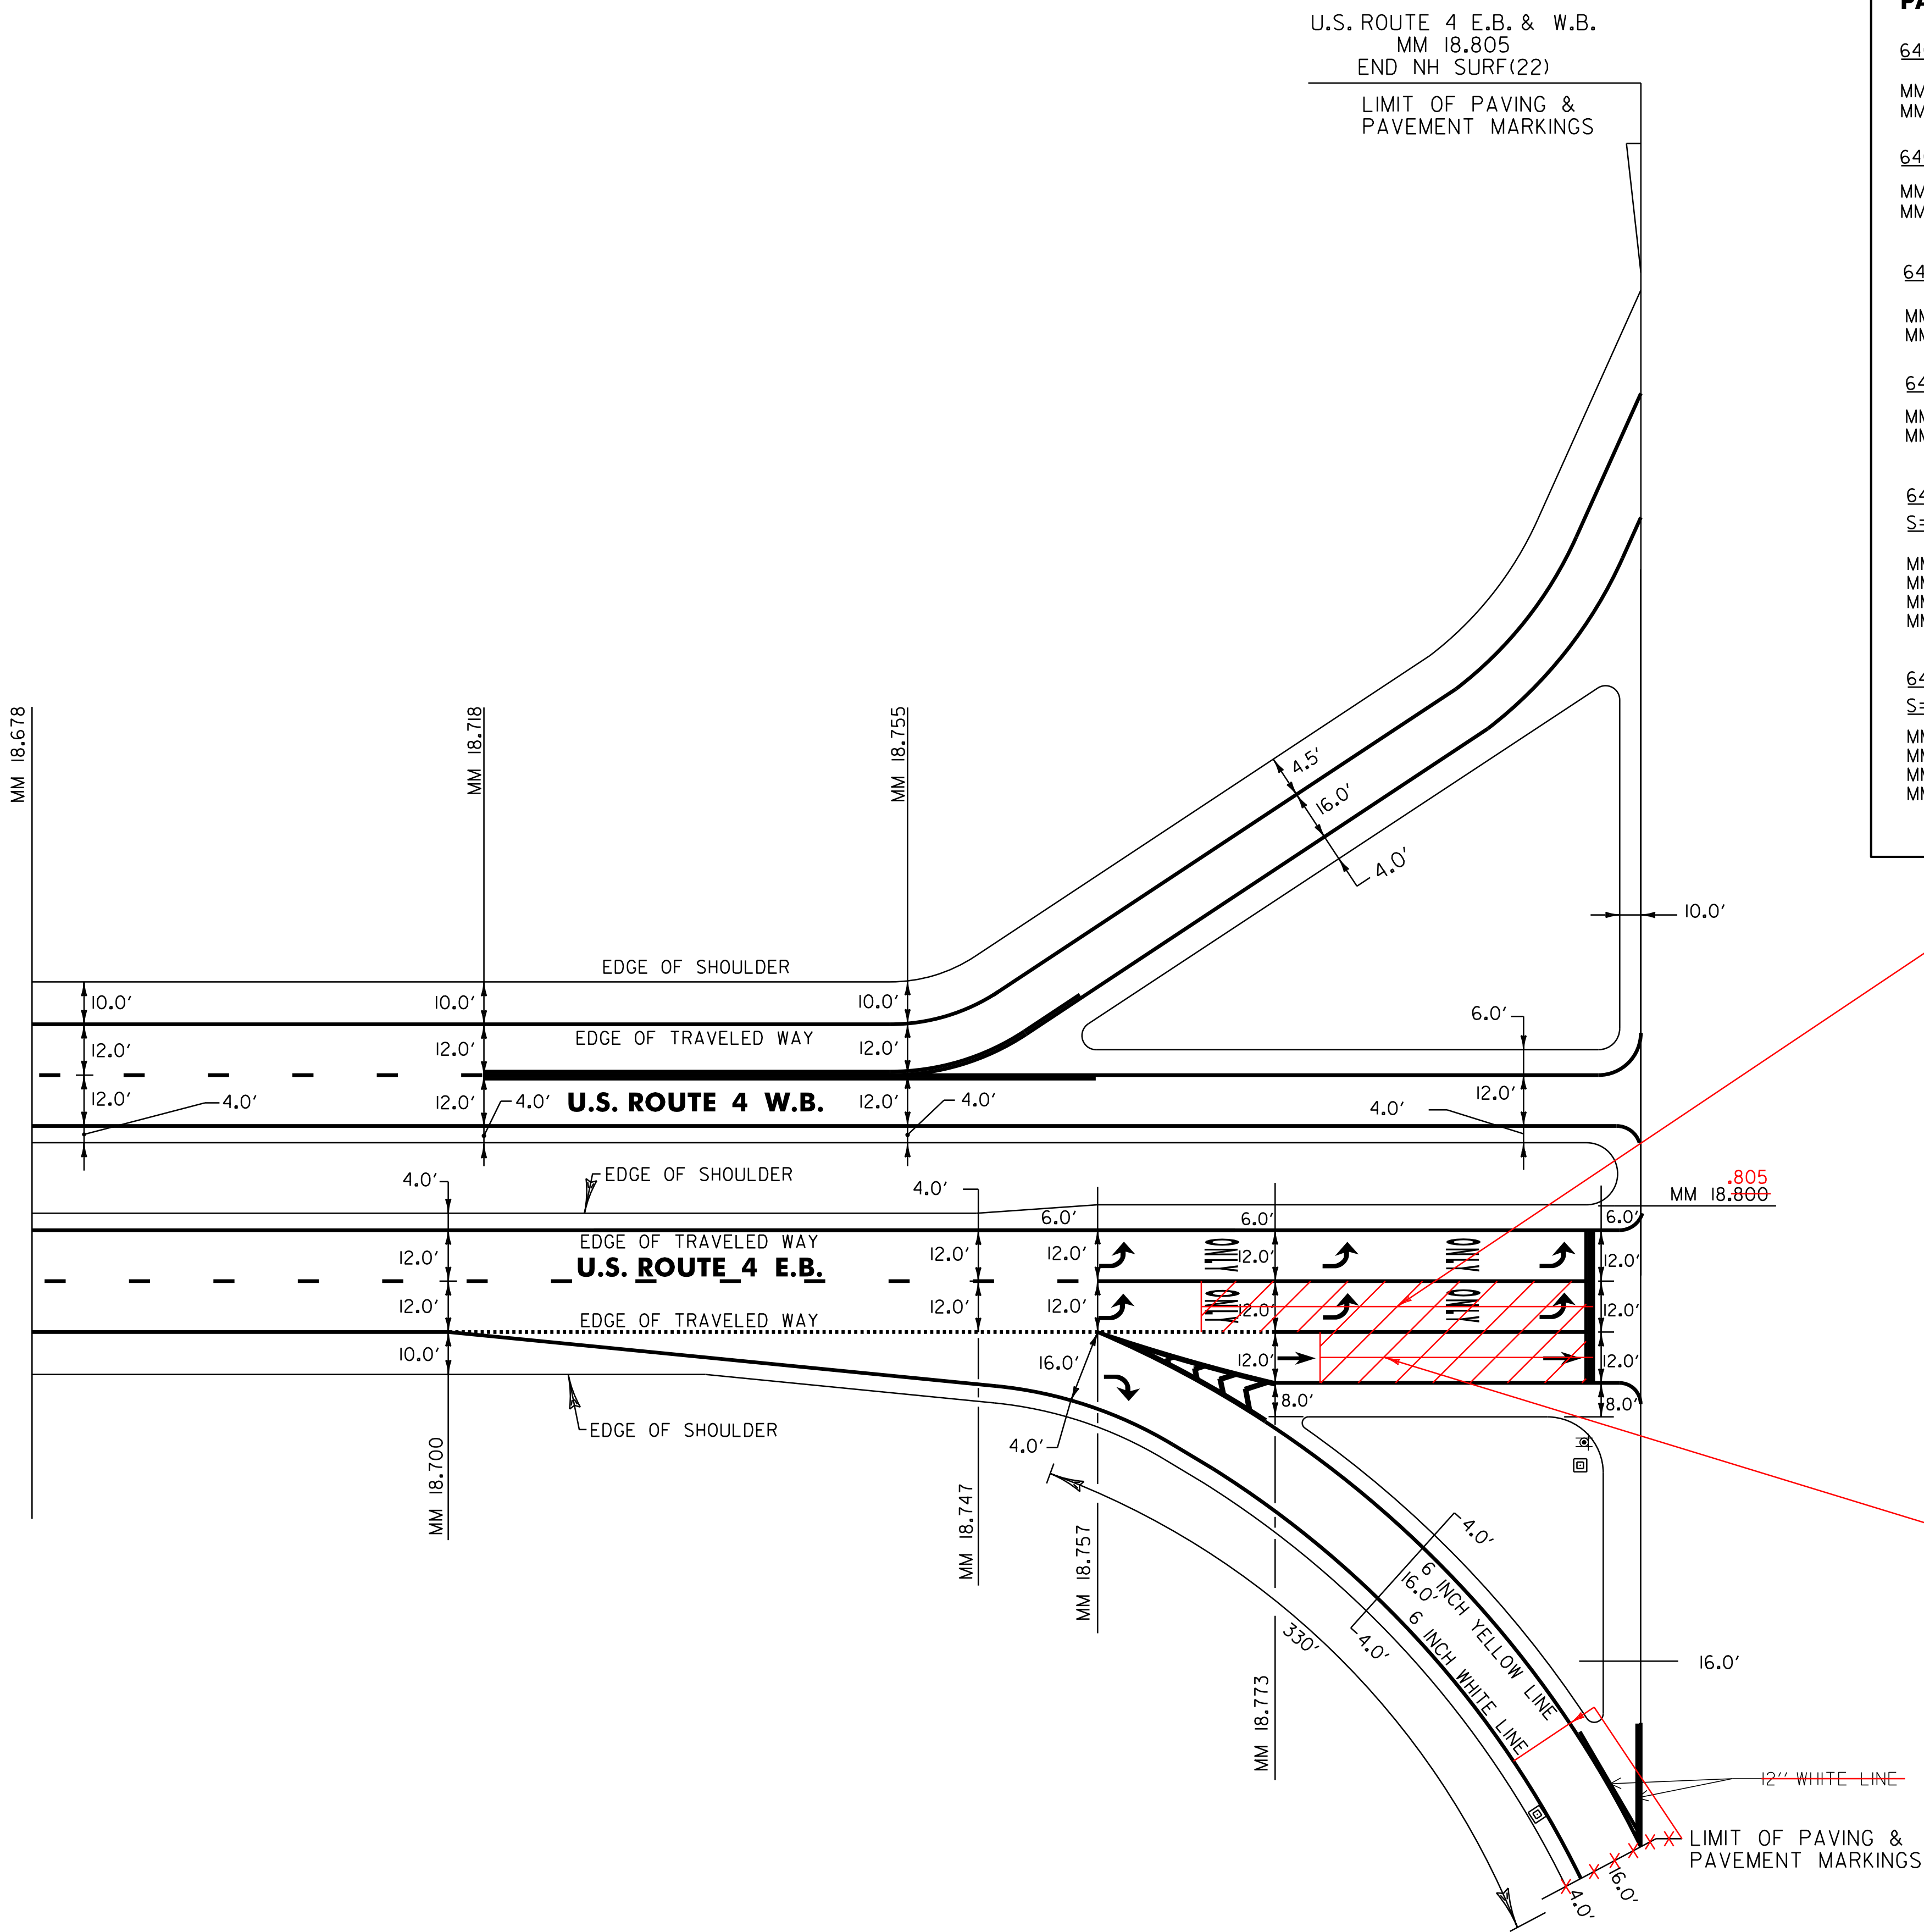

PAVEMENT MARKINGS—WEST BOUND

646.215 6 INCH YELLOW LINE

MM 18.678 - MM 18.805 SOLID LINE 12.0' RT
MM 18.718 - MM 18.805 SOLID LINE (ON-RAMP)

646.630 TEMPORARY 6 INCH YELLOW LINE

MM 18.678 - MM 18.805 SOLID LINE 12.0' RT
MM 18.718 - MM 18.805 SOLID LINE (ON-RAMP)

646.24 12 INCH WHITE LINE

MM 18.718 - MM 18.755 C (GORE STRIPING)
MM 18.755 - MM 18.805 C & LT (GORE STRIPING)

646.660 TEMPORARY 12 INCH WHITE LINE

MM 18.718 - MM 18.755 C (GORE STRIPING)
MM 18.755 - MM 18.805 C & LT (GORE STRIPING)

646.214 6 INCH WHITE LINE

S=SOLID, D=DASHED

	LT	C	RT
MM 18.678 - MM 18.718	S	D	:
MM 18.678 - MM 18.755	S	D	:
MM 18.755 - MM 18.805	SOLID LINE		(ON-RAMP)
MM 18.765 - MM 18.805	:	S	:

646.620 TEMPORARY 6 INCH WHITE LINE

S=SOLID, D=DASHED

	LT	C	RT
MM 18.678 - MM 18.718	S	D	:
MM 18.678 - MM 18.755	S	D	:
MM 18.755 - MM 18.805	SOLID LINE		(ON-RAMP)
MM 18.765 - MM 18.805	:	S	:

MILLED CENTER LANE BACK 140 LF (FM)
AND REPLACED WITH TYPE III MARSHALL
BITUMINOUS CONCRETE PAVEMENT

MILLED RIGHT LANE BACK 70 LF (FM)
AND REPLACED WITH TYPE III MARSHALL
BITUMINOUS CONCRETE PAVEMENT

PAVEMENT MARKINGS—EAST BOUND

646.215 6 INCH YELLOW LINE

MM 18.678 - MM 18.805 SOLID LINE LT
MM 18.773 - MM 18.805 SOLID LINE (OFF-RAMP)

646.630 TEMPORARY 6 INCH YELLOW LINE

MM 18.678 - MM 18.805 SOLID LINE LT
MM 18.773 - MM 18.805 SOLID LINE (OFF-RAMP)

646.26 24 INCH STOP BAR

MM 18.800

646.680 TEMPORARY 24 INCH STOP BAR

MM 18.800

646.30 LETTER OR SYMBOL

MM 18.758	LT, ARROW	(1EA)
MM 18.758	RT, ARROW	(2 EA)
MM 18.773	RT, ARROW	(1EA)
MM 18.775	LT, "O,N,L,Y"	(4 EA)
MM 18.775	RT, "O,N,L,Y"	(4 EA)
MM 18.783	LT, ARROW	(1EA)
MM 18.783	RT, ARROW	(1EA)
MM 18.791	LT, "O,N,L,Y"	(4 EA)
MM 18.791	RT, "O,N,L,Y"	(4 EA)
MM 18.799	RT, ARROW	(1EA)
MM 18.799	LT, ARROW	(1EA)
MM 18.799	RT, ARROW	(1EA)

646.690 TEMPORARY LETTER OR SYMBOL

MM 18.758	LT, ARROW	(1EA)
MM 18.758	RT, ARROW	(2 EA)
MM 18.773	RT, ARROW	(1EA)
MM 18.783	LT, ARROW	(1EA)
MM 18.783	RT, ARROW	(1EA)
MM 18.798	RT, ARROW	(1EA)
MM 18.799	LT, ARROW	(1EA)
MM 18.799	RT, ARROW	(1EA)

646.214 6 INCH WHITE LINE

MM 18.678 - MM 18.757 DASHED C
MM 18.768 - MM 18.700 SOLID LINE 3.6 m RT
MM 18.700 - MM 18.773 DOTTED LINE 3.6 m RT
MM 18.700 - MM 18.805 SOLID LINE (OFF-RAMP)
MM 18.757 - MM 18.801 SOLID C
MM 18.773 - MM 18.801 SOLID LINE 3.6 m RT
MM 18.773 - MM 18.804 SOLID LINE 7.2 m RT

646.620 TEMPORARY 6 INCH WHITE LINE

MM 18.678 - MM 18.757 DASHED C
MM 18.678 - MM 18.700 SOLID LINE 3.6 m RT
MM 18.700 - MM 18.773 DOTTED LINE 3.6 m RT
MM 18.700 - MM 18.805 SOLID LINE (OFF-RAMP)
MM 18.757 - MM 18.801 SOLID C
MM 18.773 - MM 18.801 SOLID LINE 3.6 m RT
MM 18.773 - MM 18.804 SOLID LINE 7.2 m RT

646.24 12 INCH WHITE LINE

MM 18.757 - MM 18.773 GORE LINES RT
MM 18.757 - MM 18.773 GORE HATCHING
~~MM 18.800 - MM 18.804 GORE LINES RT~~

646.660 TEMPORARY 12 INCH WHITE LINE

MM 18.757 - MM 18.773 GORE LINES RT
MM 18.757 - MM 18.773 GORE HATCHING
~~MM 18.800 - MM 18.804 GORE LINES RT~~

NOT TO SCALE

US 7
INTERCHANGE
PAVEMENT
MARKING
DETAIL SHEET

PROJECT NAME: FAIR HAVEN-RUTLAND TOWN

PROJECT NUMBER: NH SURF(22)

FILE NAME: IOBIO6/IOBIO6.DGN

PROJECT LEADER: M. FOWLER

DESIGNED BY: PVT. MGT.

IOBIO6*17.1

PLOT DATE: 31-MAY-2013 11:55

DRAWN BY: PVT. MGT.


CHECKED BY: PVT. MGT.

SHEET 17 OF 24

US 4 Fair Haven-Rutland Town NH Surf (22)Westbound Ride

Profiled 7-12-11

Travel Lane Avg. IRI = 78.4, Passing Lane Avg. IRI = 84.6

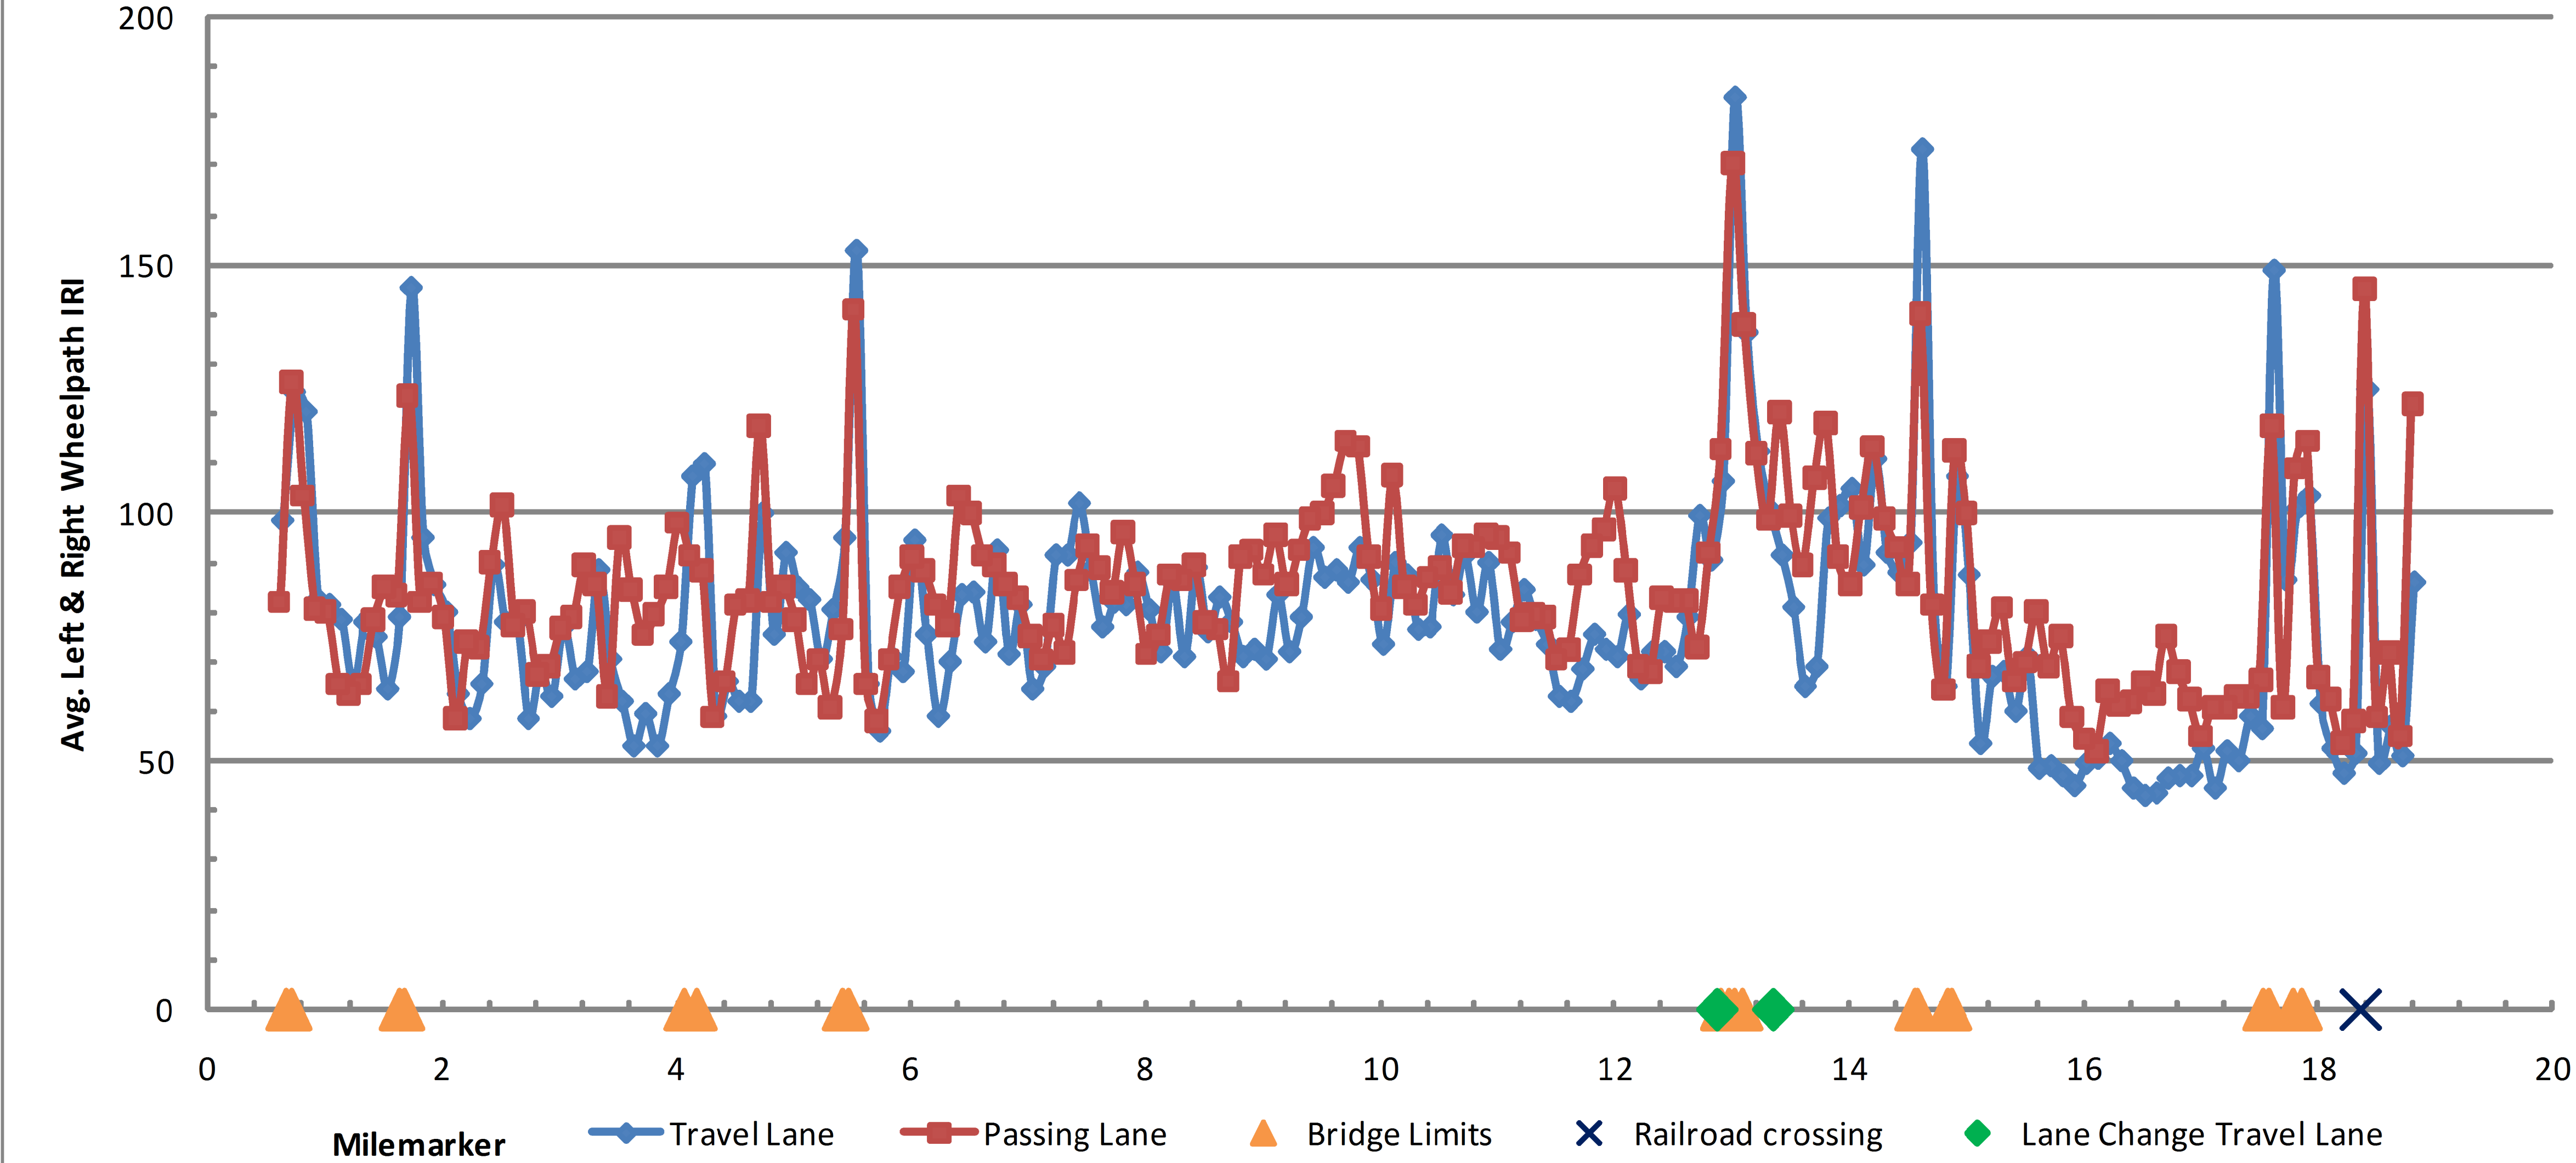

**WESTBOUND
ROUGHNESS
DATA
INFORMATION
SHEET**

PROJECT NAME: FAIR HAVEN-RUTLAND TOWN

PROJECT NUMBER: NH SURF(22)


FILE NAME: IOBIO6/IOBIO6.DGN
PROJECT LEADER: M. FOWLER
DESIGNED BY: PVT. MGT.
IOBIO6*18.1

PLOT DATE: 31-MAY-2013 11:55
DRAWN BY: PVT. MGT.
CHECKED BY: PVT. MGT.
SHEET 18 OF 24

US 4 Fair Haven-Rutland Town NH Surf (22)Westbound Rut

Profiled 7-12-11

Travel Lane Avg. Rut = 0.242", Passing Lane Avg. Rut = 0.065"

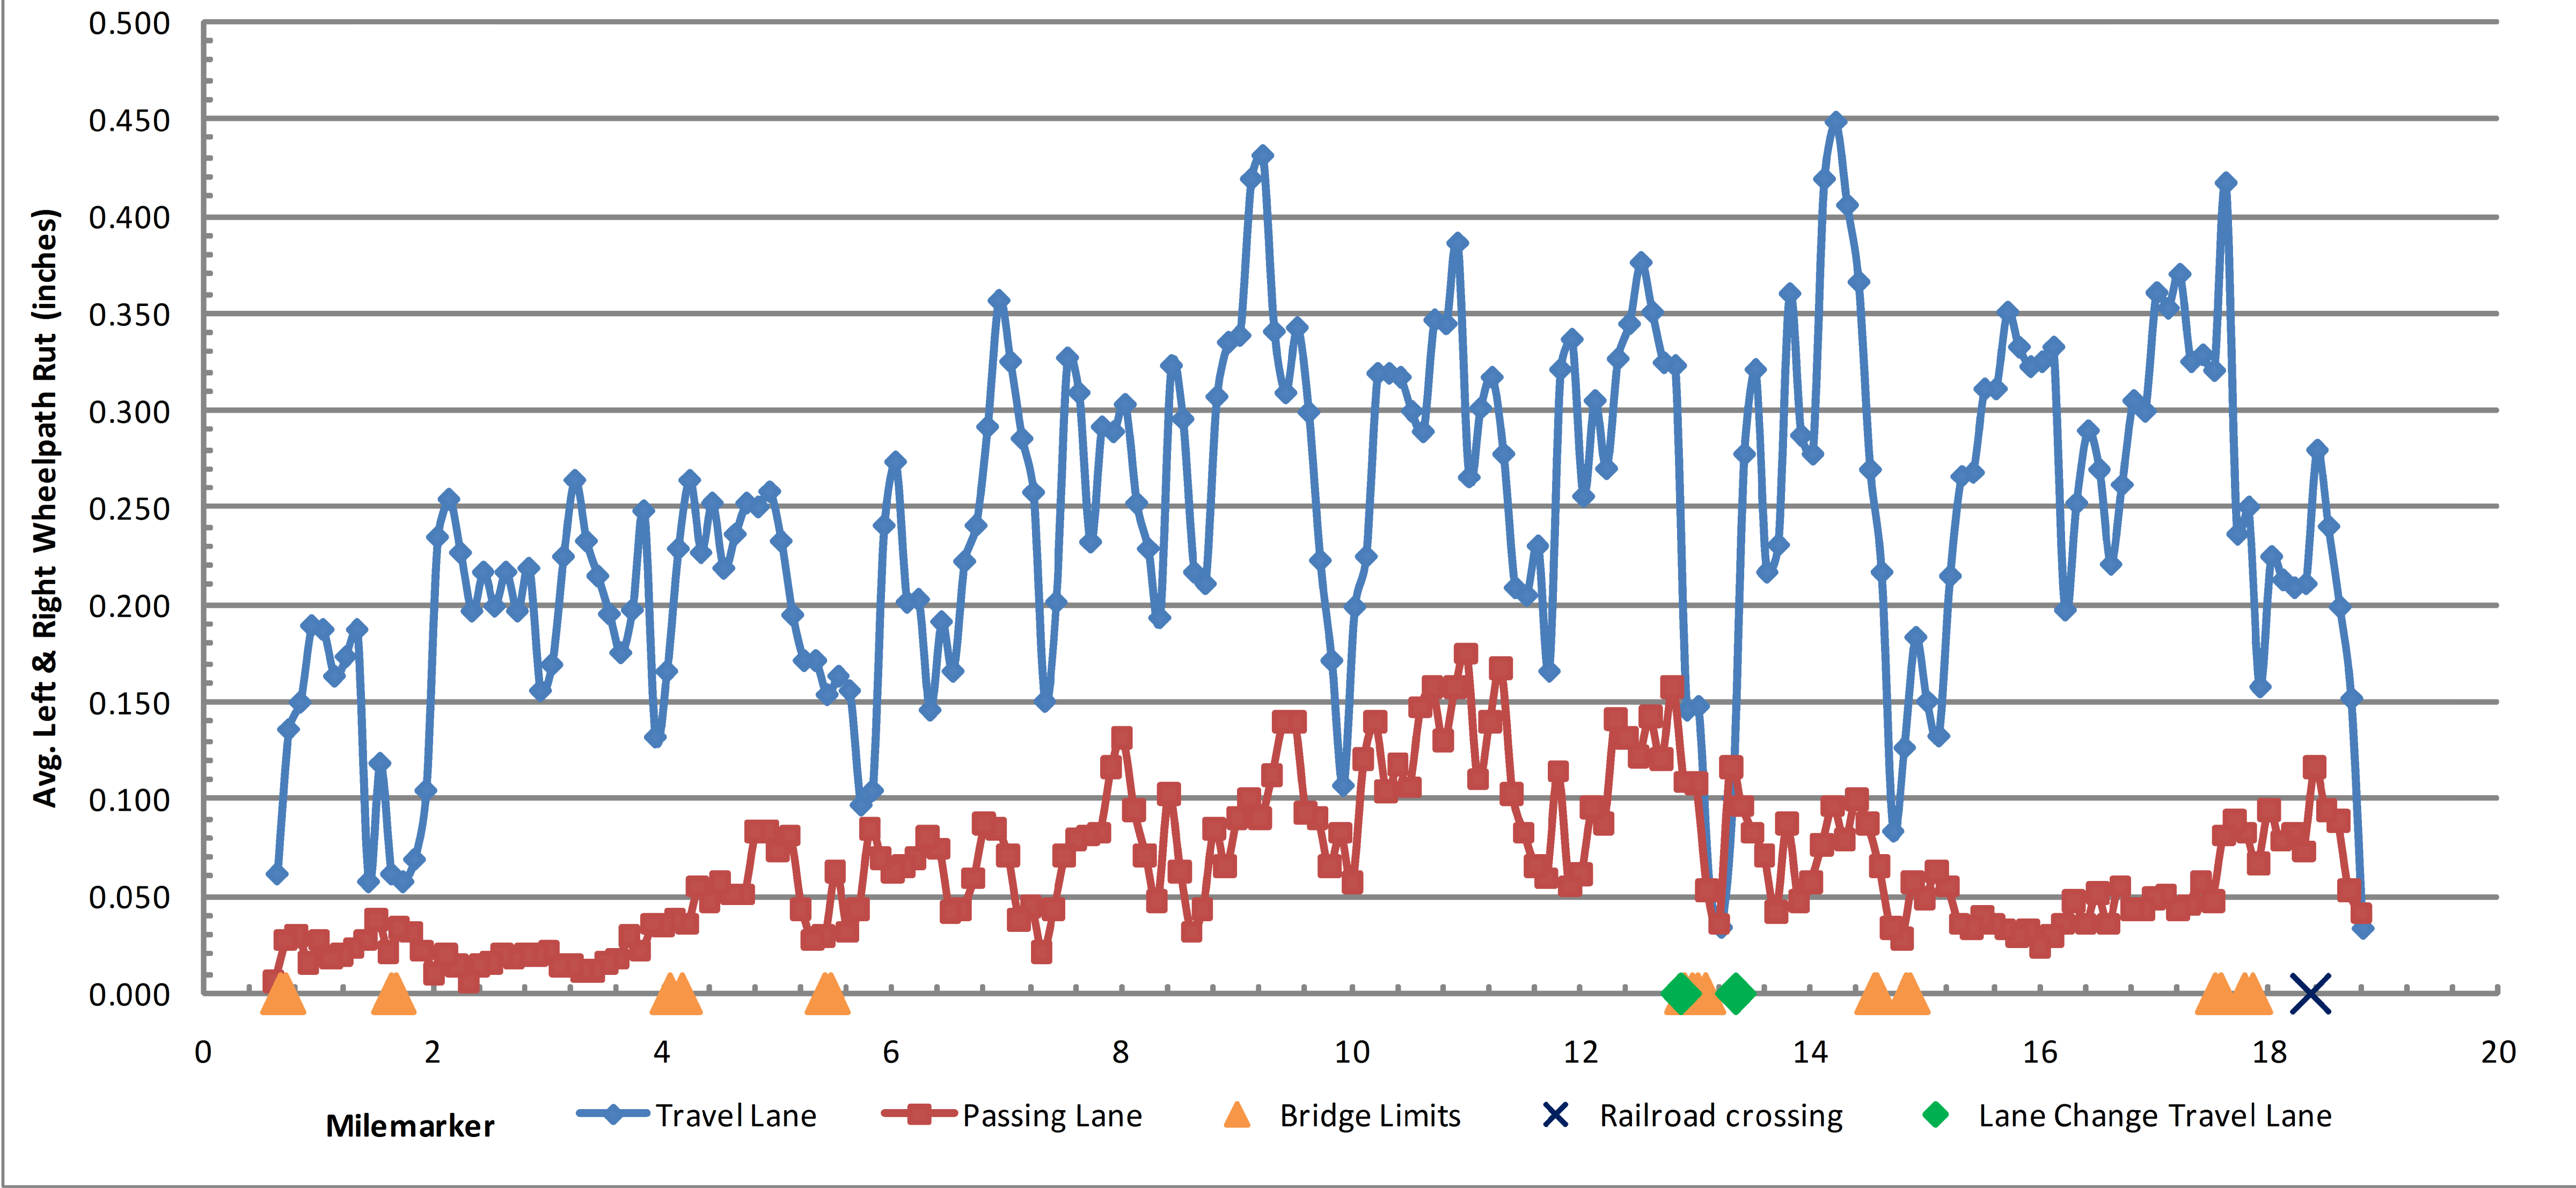

**WESTBOUND
RUT
DATA
INFORMATION
SHEET**

PROJECT NAME: FAIR HAVEN-RUTLAND TOWN

PROJECT NUMBER: NH SURF(22)


FILE NAME: IOBIO6/IOBIO6.DGN
PROJECT LEADER: M. FOWLER
DESIGNED BY: PVT. MGT.
IOBIO6*19.1

PLOT DATE: 31-MAY-2013 11:55
DRAWN BY: PVT. MGT.
CHECKED BY: PVT. MGT.
SHEET 19 OF 24

US 4 Fair Haven-Rutland Town NH Surf (22) Eastbound Ride

Profiled 7-12-11

Travel Lane Avg. IRI = 75.4, Passing Lane Avg. IRI = 81.9

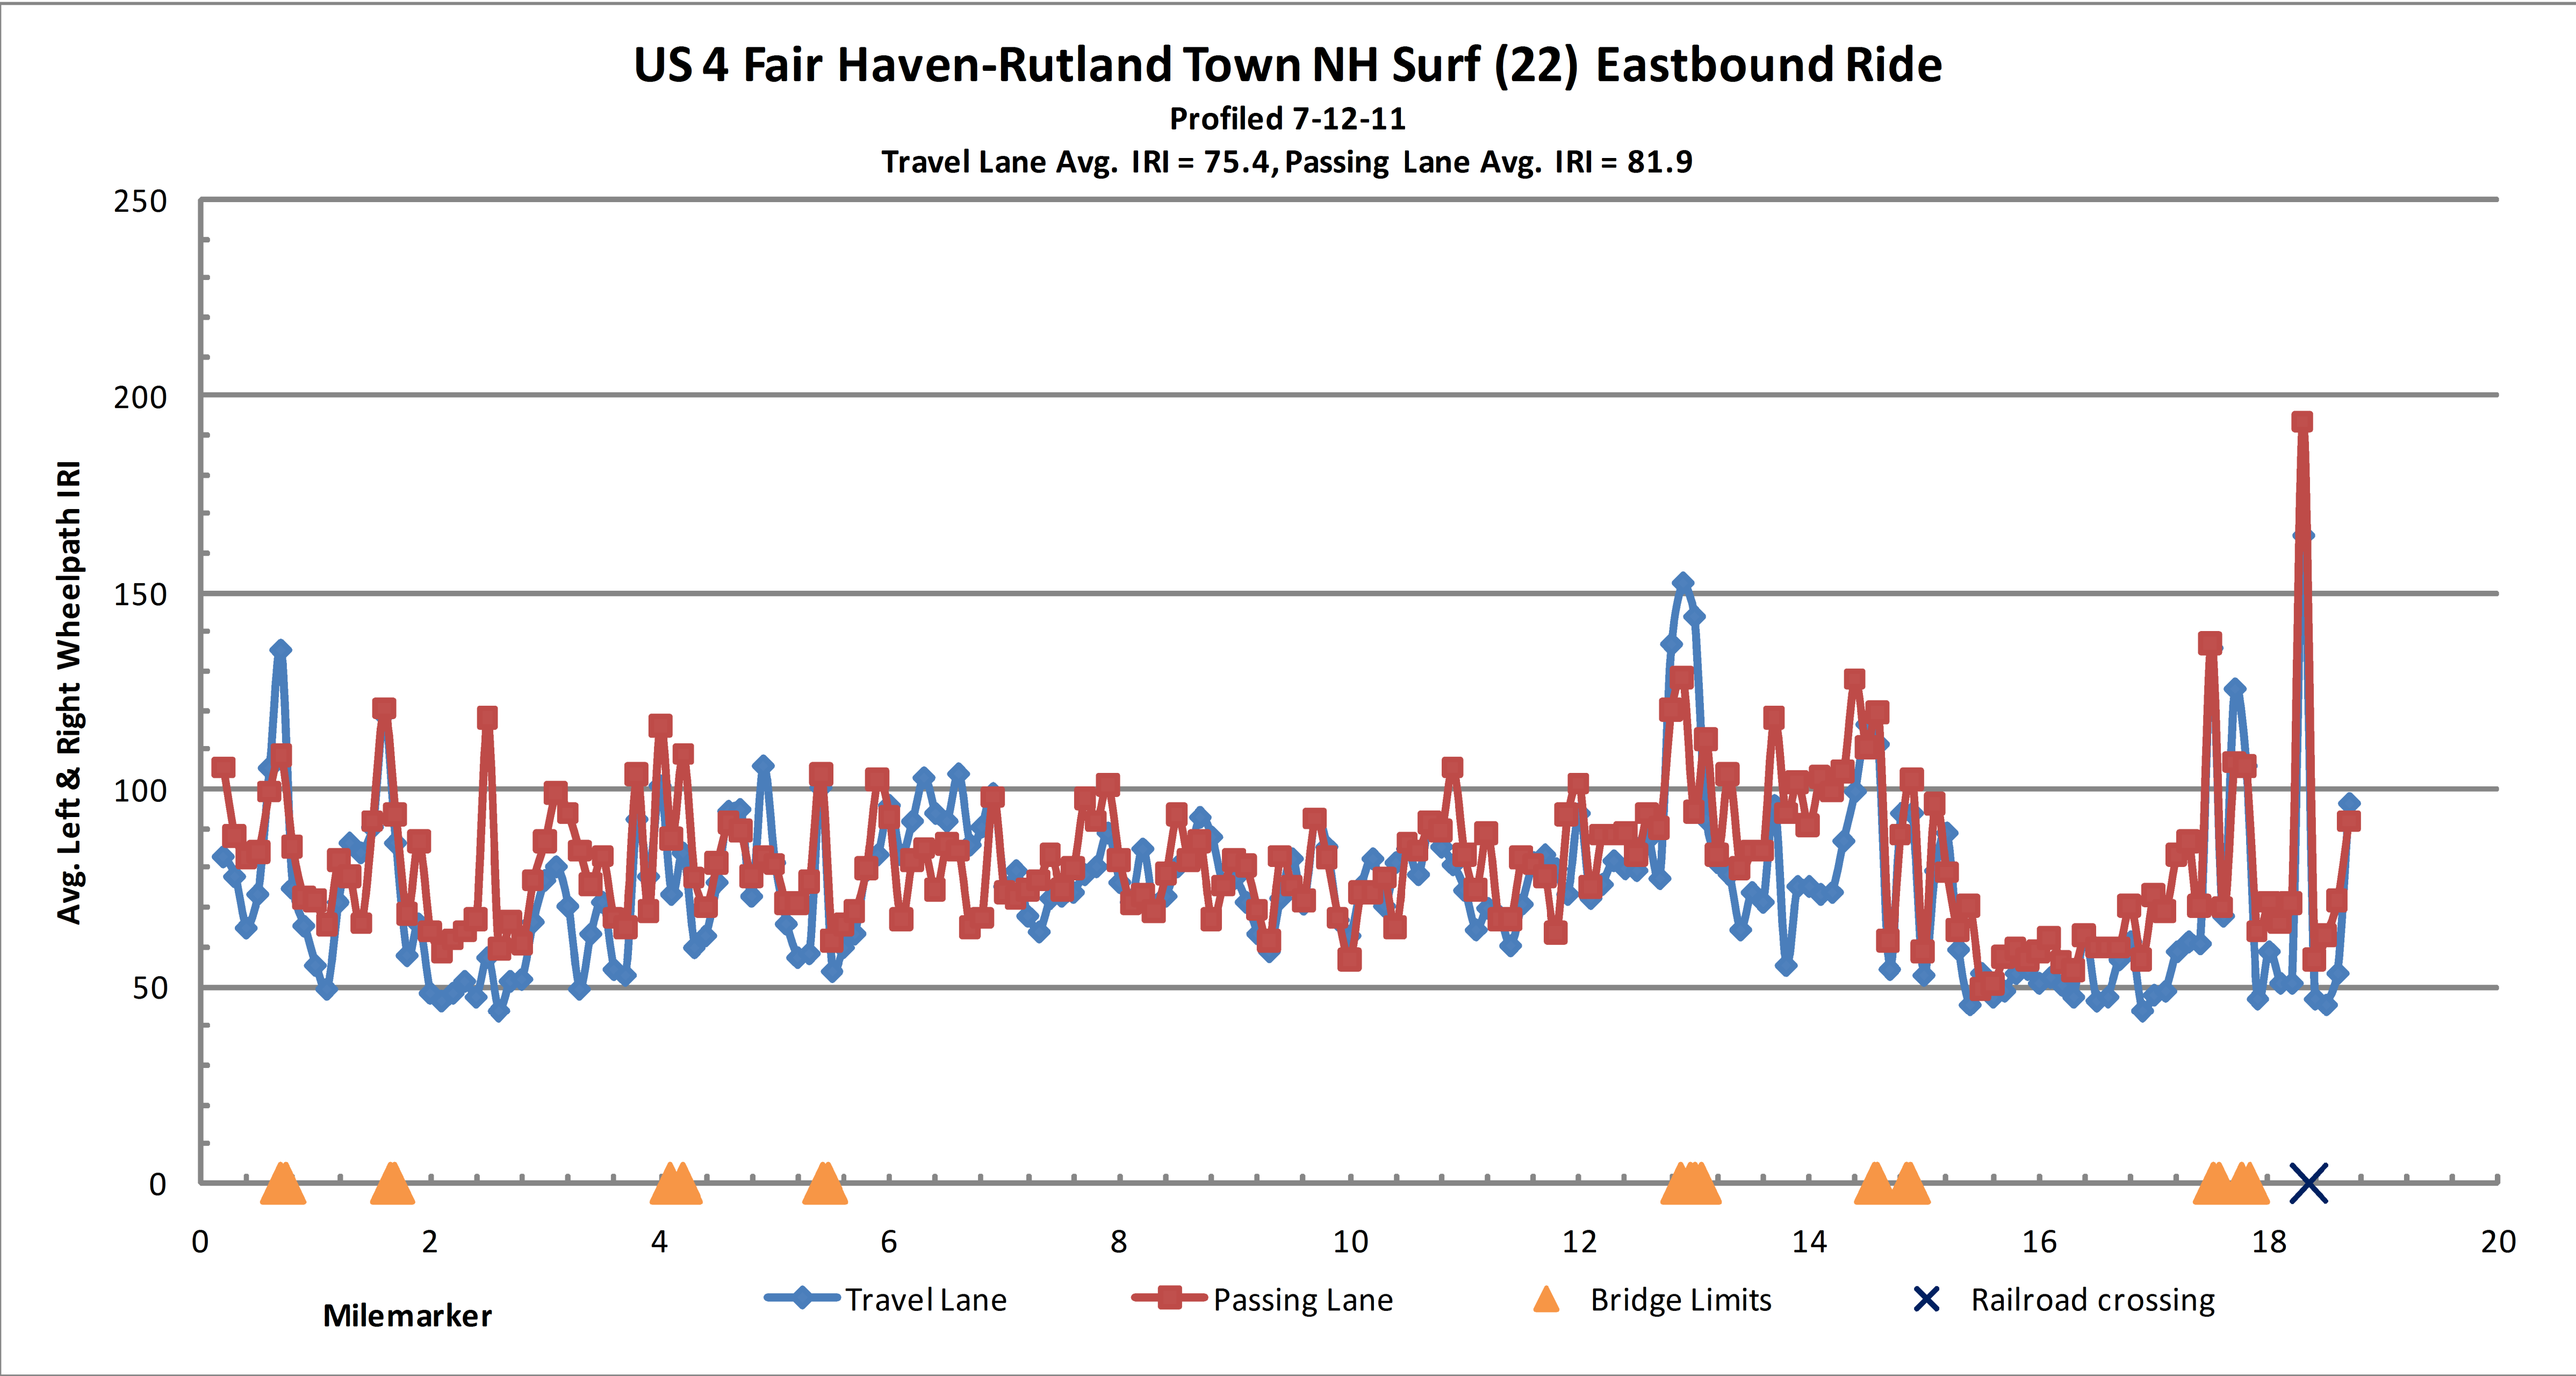


EASTBOUND ROUGHNESS DATA INFORMATION SHEET	PROJECT NAME: FAIR HAVEN-RUTLAND TOWN	
	PROJECT NUMBER: NH SURF(22)	
	FILE NAME: IOBIO6/IOBIO6.DGN	PLOT DATE: 31-MAY-2013 11:56
	PROJECT LEADER: M. FOWLER	DRAWN BY: PVT. MGT.
	DESIGNED BY: PVT. MGT.	CHECKED BY: PVT. MGT.
	IOBIO6*20.I	SHEET 20 OF 24

US 4 Fair Haven-Rutland Town NH Surf (22) Eastbound Rut

Profiled 7-12-11

Travel Lane Avg. Rut = 0.183", Passing Lane Avg. Rut = 0.050"

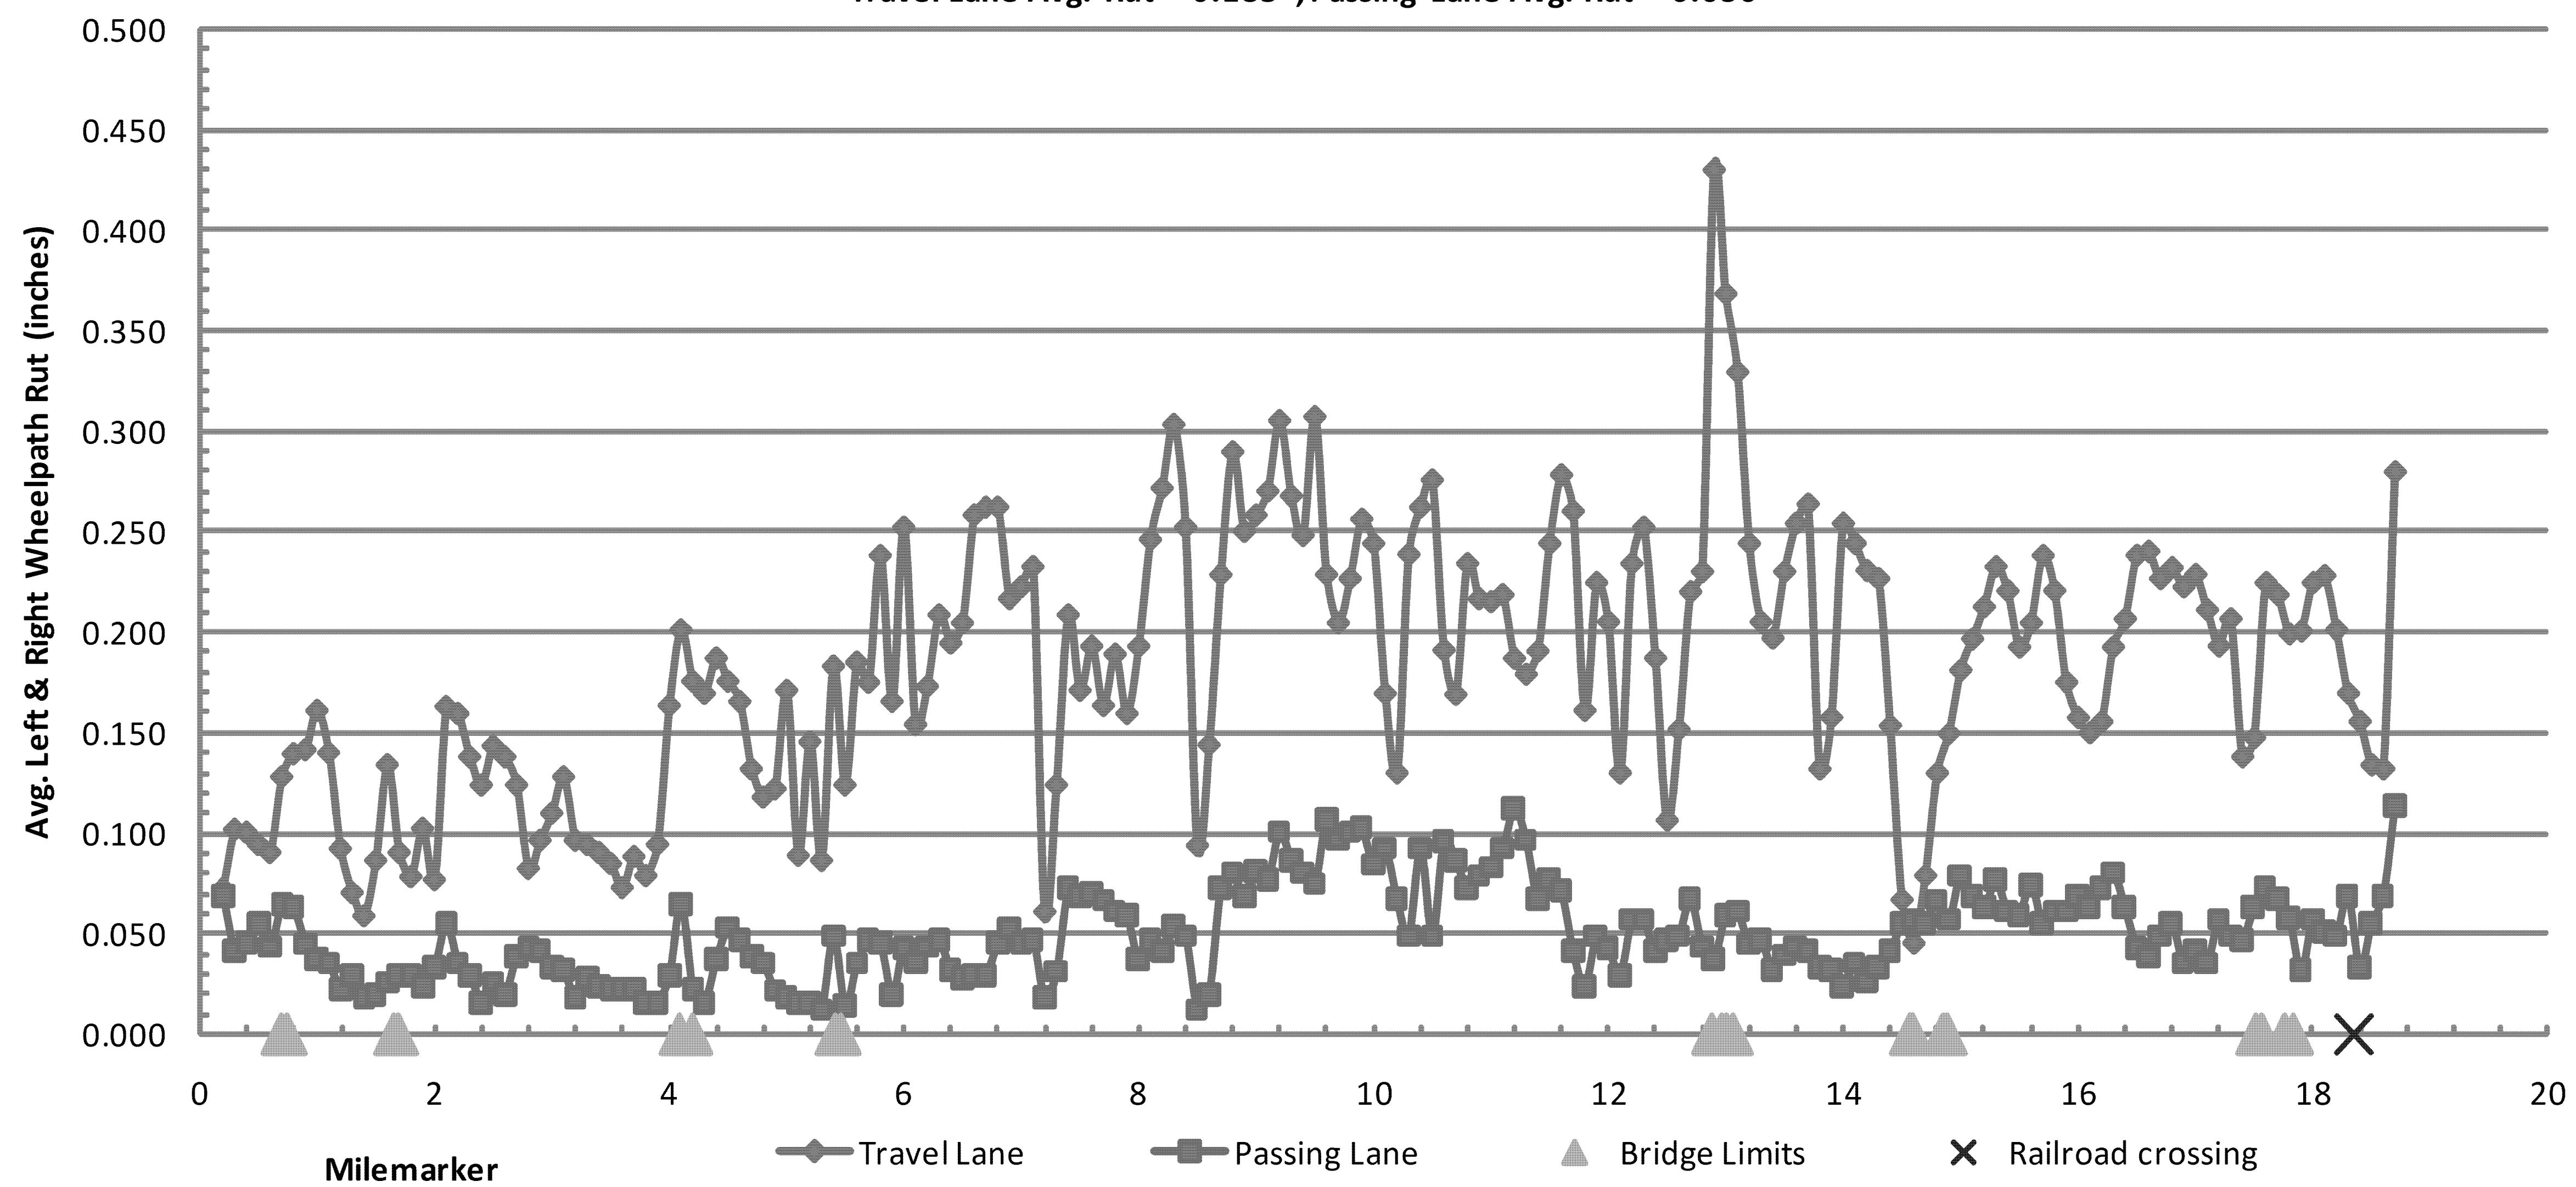

EASTBOUND RUT DATA INFORMATION SHEET

PROJECT NAME: FAIR HAVEN-RUTLAND TOWN

PROJECT NUMBER: NH SURF(22)

FILE NAME: IOBIO6/IOBIO6.DGN
PROJECT LEADER: M. FOWLER
DESIGNED BY: PVT. MGT.
IOBIO6*21.I

PLOT DATE: 12-AUG-2011
DRAWN BY: PVT. MGT.
CHECKED BY: PVT. MGT.
SHEET 21 OF 24

INTERCHANGE NO. 1

The diagram illustrates the layout of Interchange No. 1, showing the intersection of U.S. Route 4 and the New York / Vermont State Line. Key features include:

- Signage:**
 - Road Work Ahead:** Two diamond-shaped signs are shown, one at the start of the work zone and another further ahead.
 - End Road Work:** Two rectangular signs are shown, one at the end of the work zone and another further ahead.
 - Road Work 1000 FT:** A rectangular sign indicating the duration of the work zone.
 - Road Work Next 19 Miles:** A rectangular sign indicating the duration of the work zone.
 - Vermont 4A:** A rectangular sign indicating the route number and state.
- Distances:**
 - 1000 FT (twice)
 - 150 m
- Geographic Features:**
 - New York / Vermont State Line:** A vertical line marking the boundary between the two states.
 - U.S. Route 4 WB (Westbound):** The top horizontal road.
 - U.S. Route 4 EB (Eastbound):** The bottom horizontal road.
 - Interchange:** The intersection of the two roads.

INTERCHANGE NO. 2

The diagram illustrates the layout of Interchange No. 2, showing the intersection of Vermont Route 22A and Route 4. Key features include:

- Route 22A:** Indicated by a shield sign at the top and bottom. A "ROAD WORK AHEAD" sign is placed on the northbound side.
- Route 4:** Indicated by a shield sign on the right side. A "ROAD WORK NEXT 17 MILES" sign is placed on the southbound side.
- Ramps:** Labeled as RAMP "H", RAMP "E", RAMP "F", and RAMP "G".
- Road Work Areas:** Four rectangular areas are marked with "ROAD WORK" signs, indicating the locations of construction projects.
- Distances:** Various segments are marked with "500 FT" to indicate the extent of the work areas.
- Signage:** Includes "ROAD WORK AHEAD" diamond signs and "END ROAD WORK" rectangular signs to guide traffic through the construction zones.

The diagram illustrates a road construction project on Highway 4. The main road is labeled "4" and runs horizontally. Two ramps, "RAMP 'K'" and "RAMP 'L'", branch off from the main road. "RAMP 'K'" branches off to the left, and "RAMP 'L'" branches off to the right. The construction area is marked with "ROAD WORK AHEAD" signs at the beginning of each ramp and "END ROAD WORK" signs at the end of each ramp. The distance from the start of the construction area to the end of the construction area is marked as 500 FT. The diagram also shows the intersection of "FAIR HAVEN ST. HWY." with the main road. A north arrow is located in the upper right corner.

[illegible]


INTERCHANGE TRAFFIC CONTROL SHEET 1

FILE NAME: IOBI06/IOBI06.DGN
PROJECT LEADER: M. FOWLER
DESIGNED BY: PVT. MGT.
IOBI06*22.I


PLOT DATE: 31-MAY-2013 11:56
DRAWN BY: PVT.MGT.
CHECKED BY: PVT.MGT.
SHEET 22 OF 24

NOTE:
SEE STANDARD E-100 FOR ADDITIONAL SIGN PLACEMENT DETAILS


INTERCHANGE NO. 5

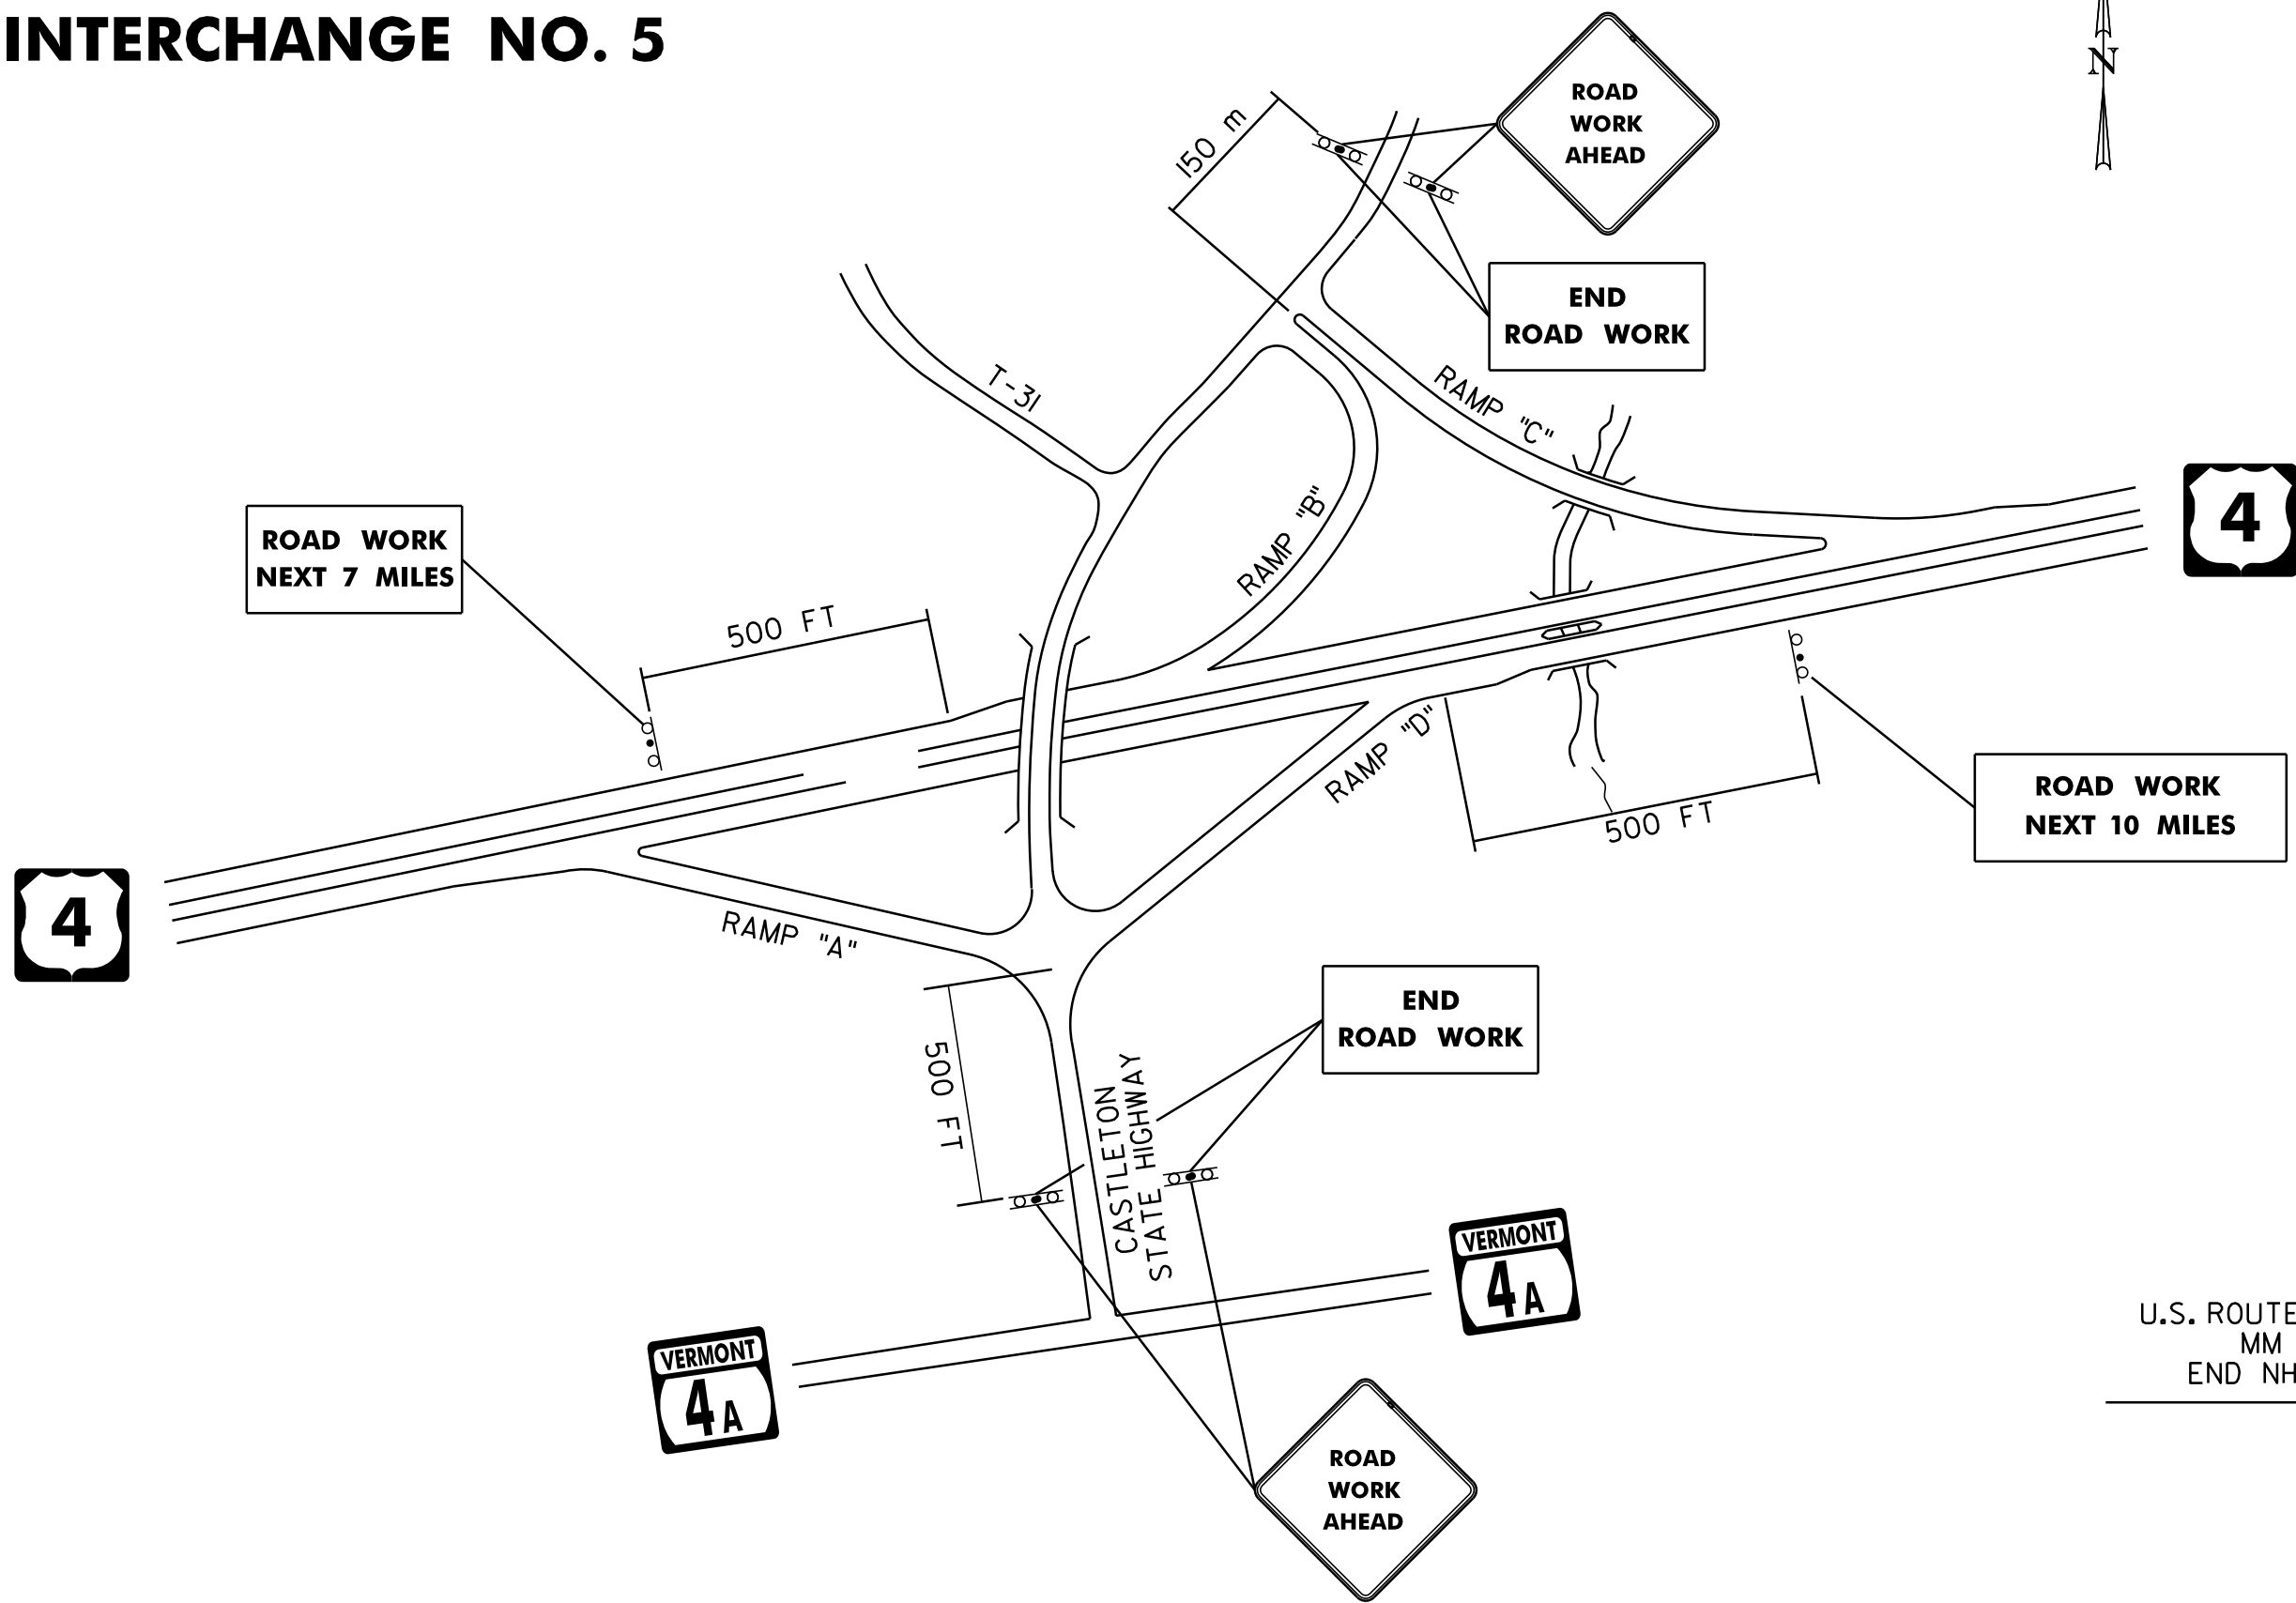

INTERCHANGE NO. 6

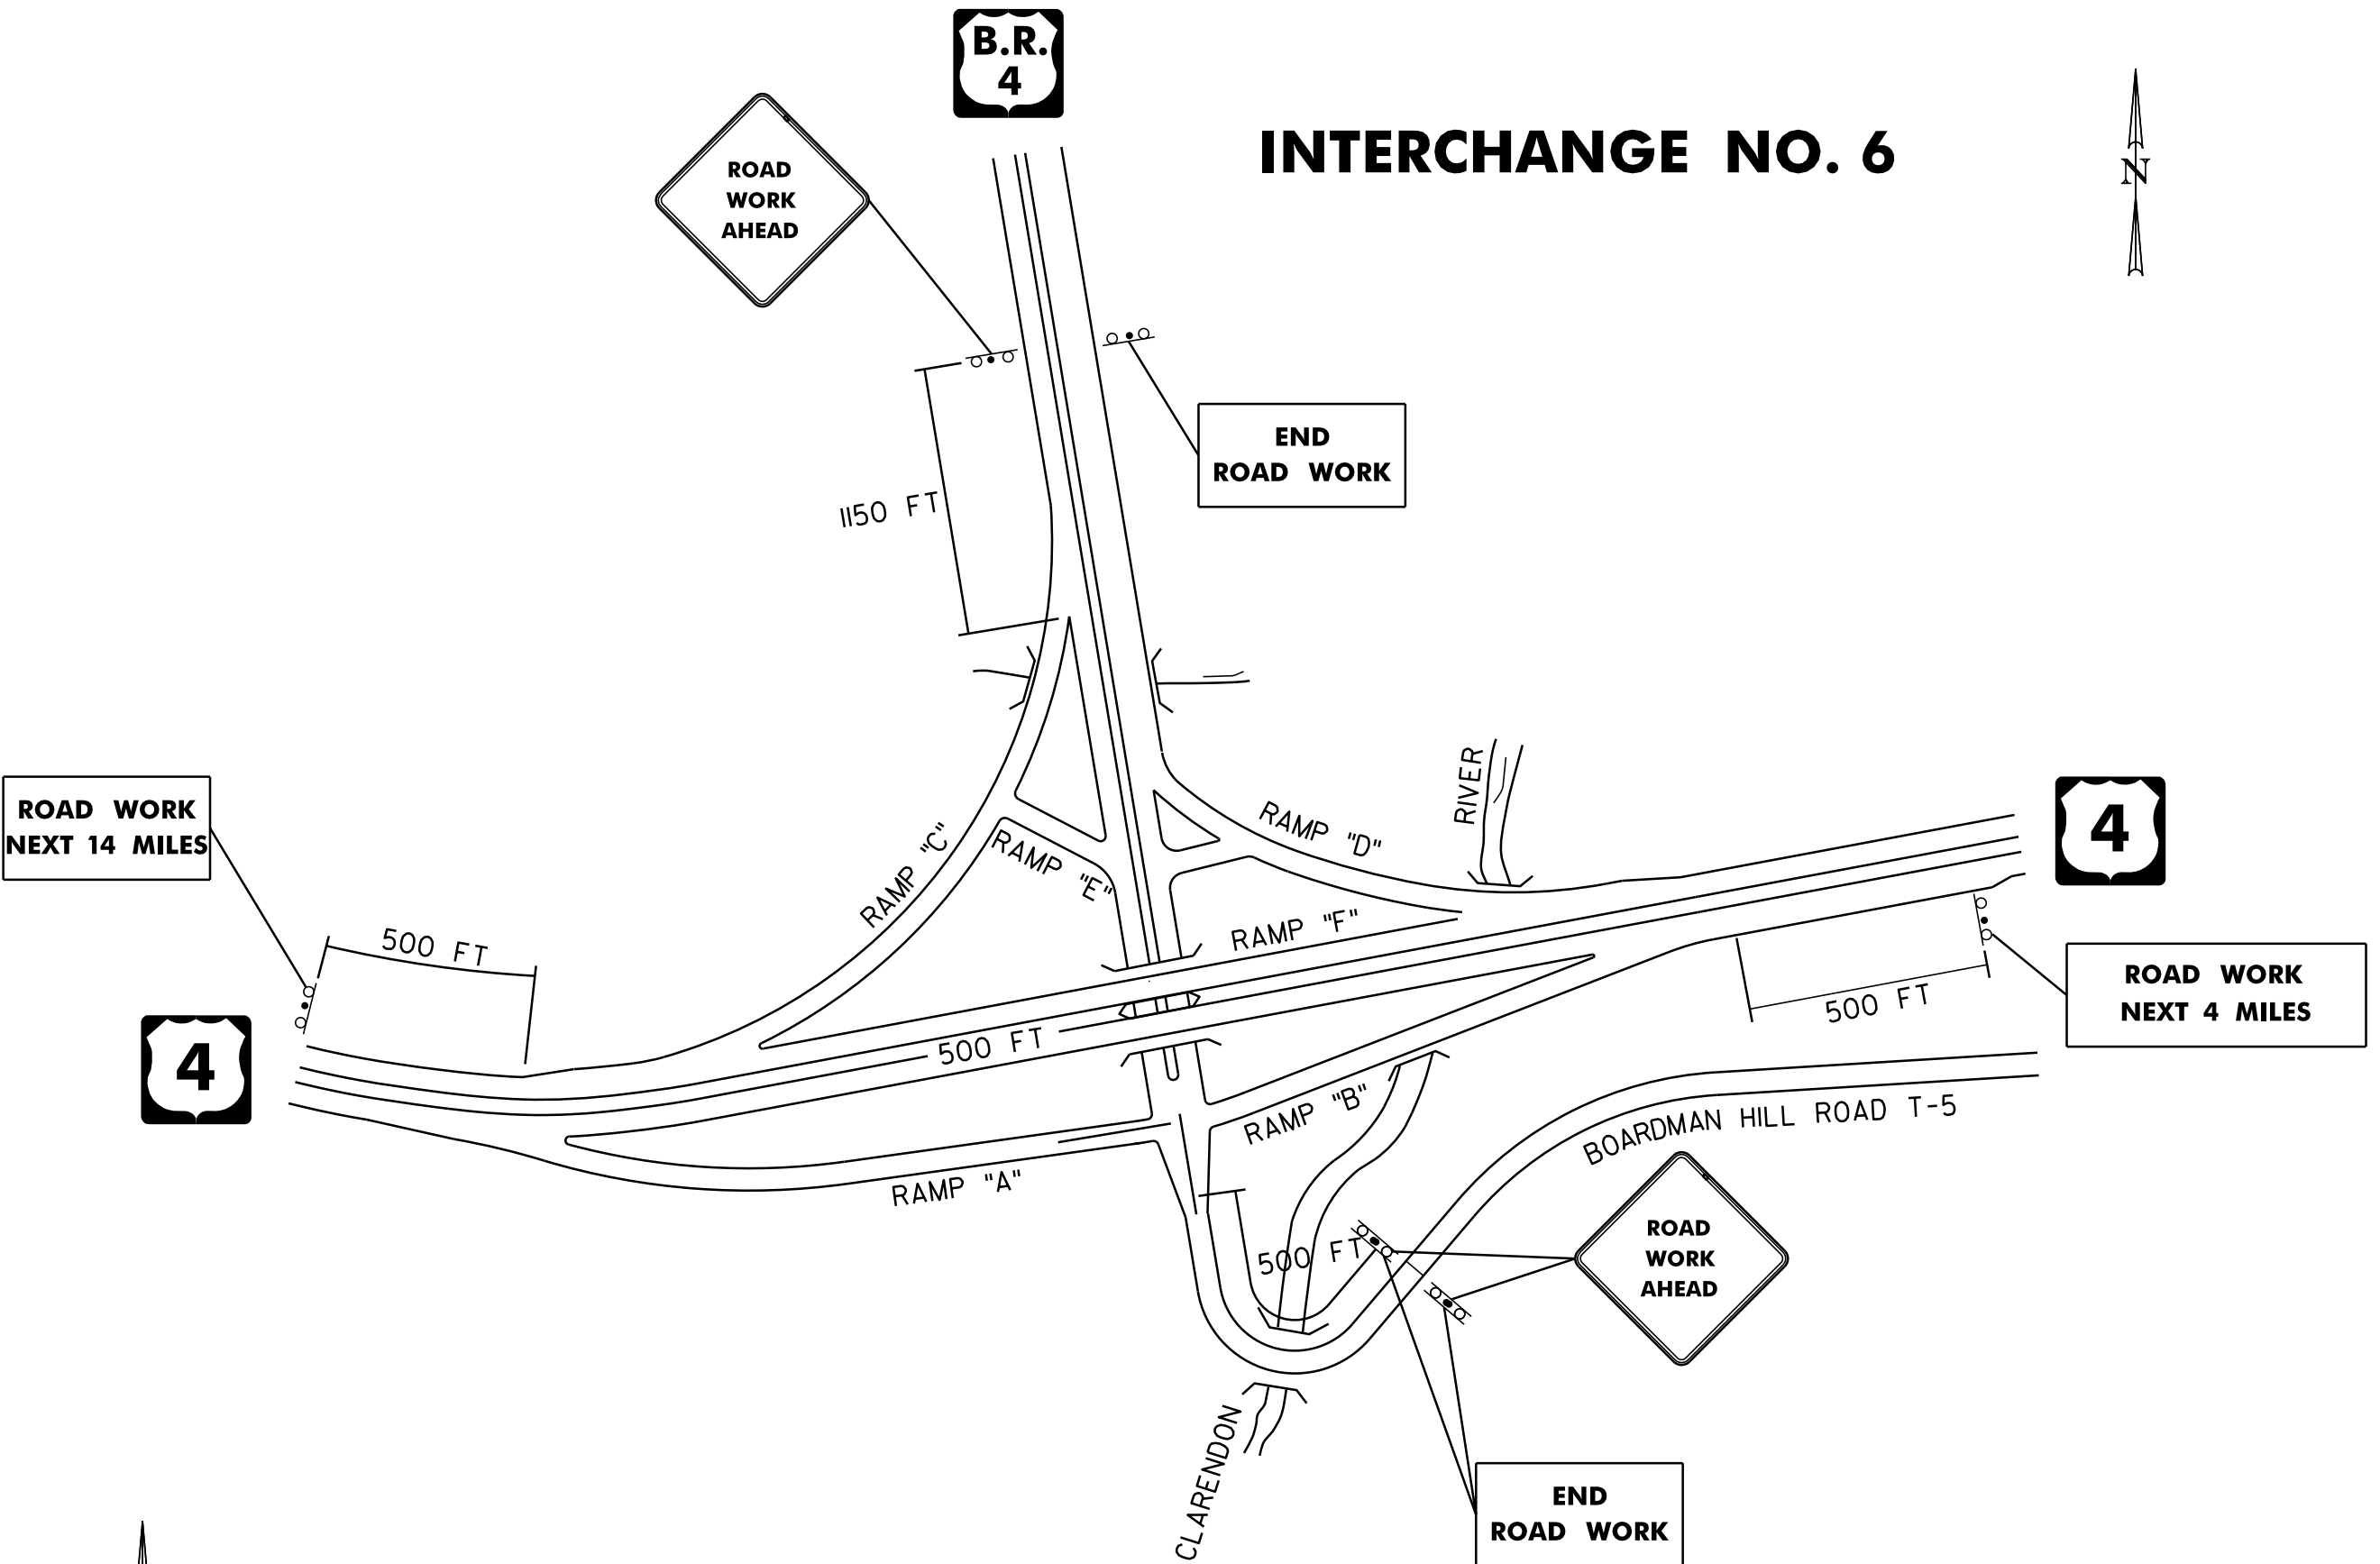

INTERSECTION WITH U.S. ROUTE 7

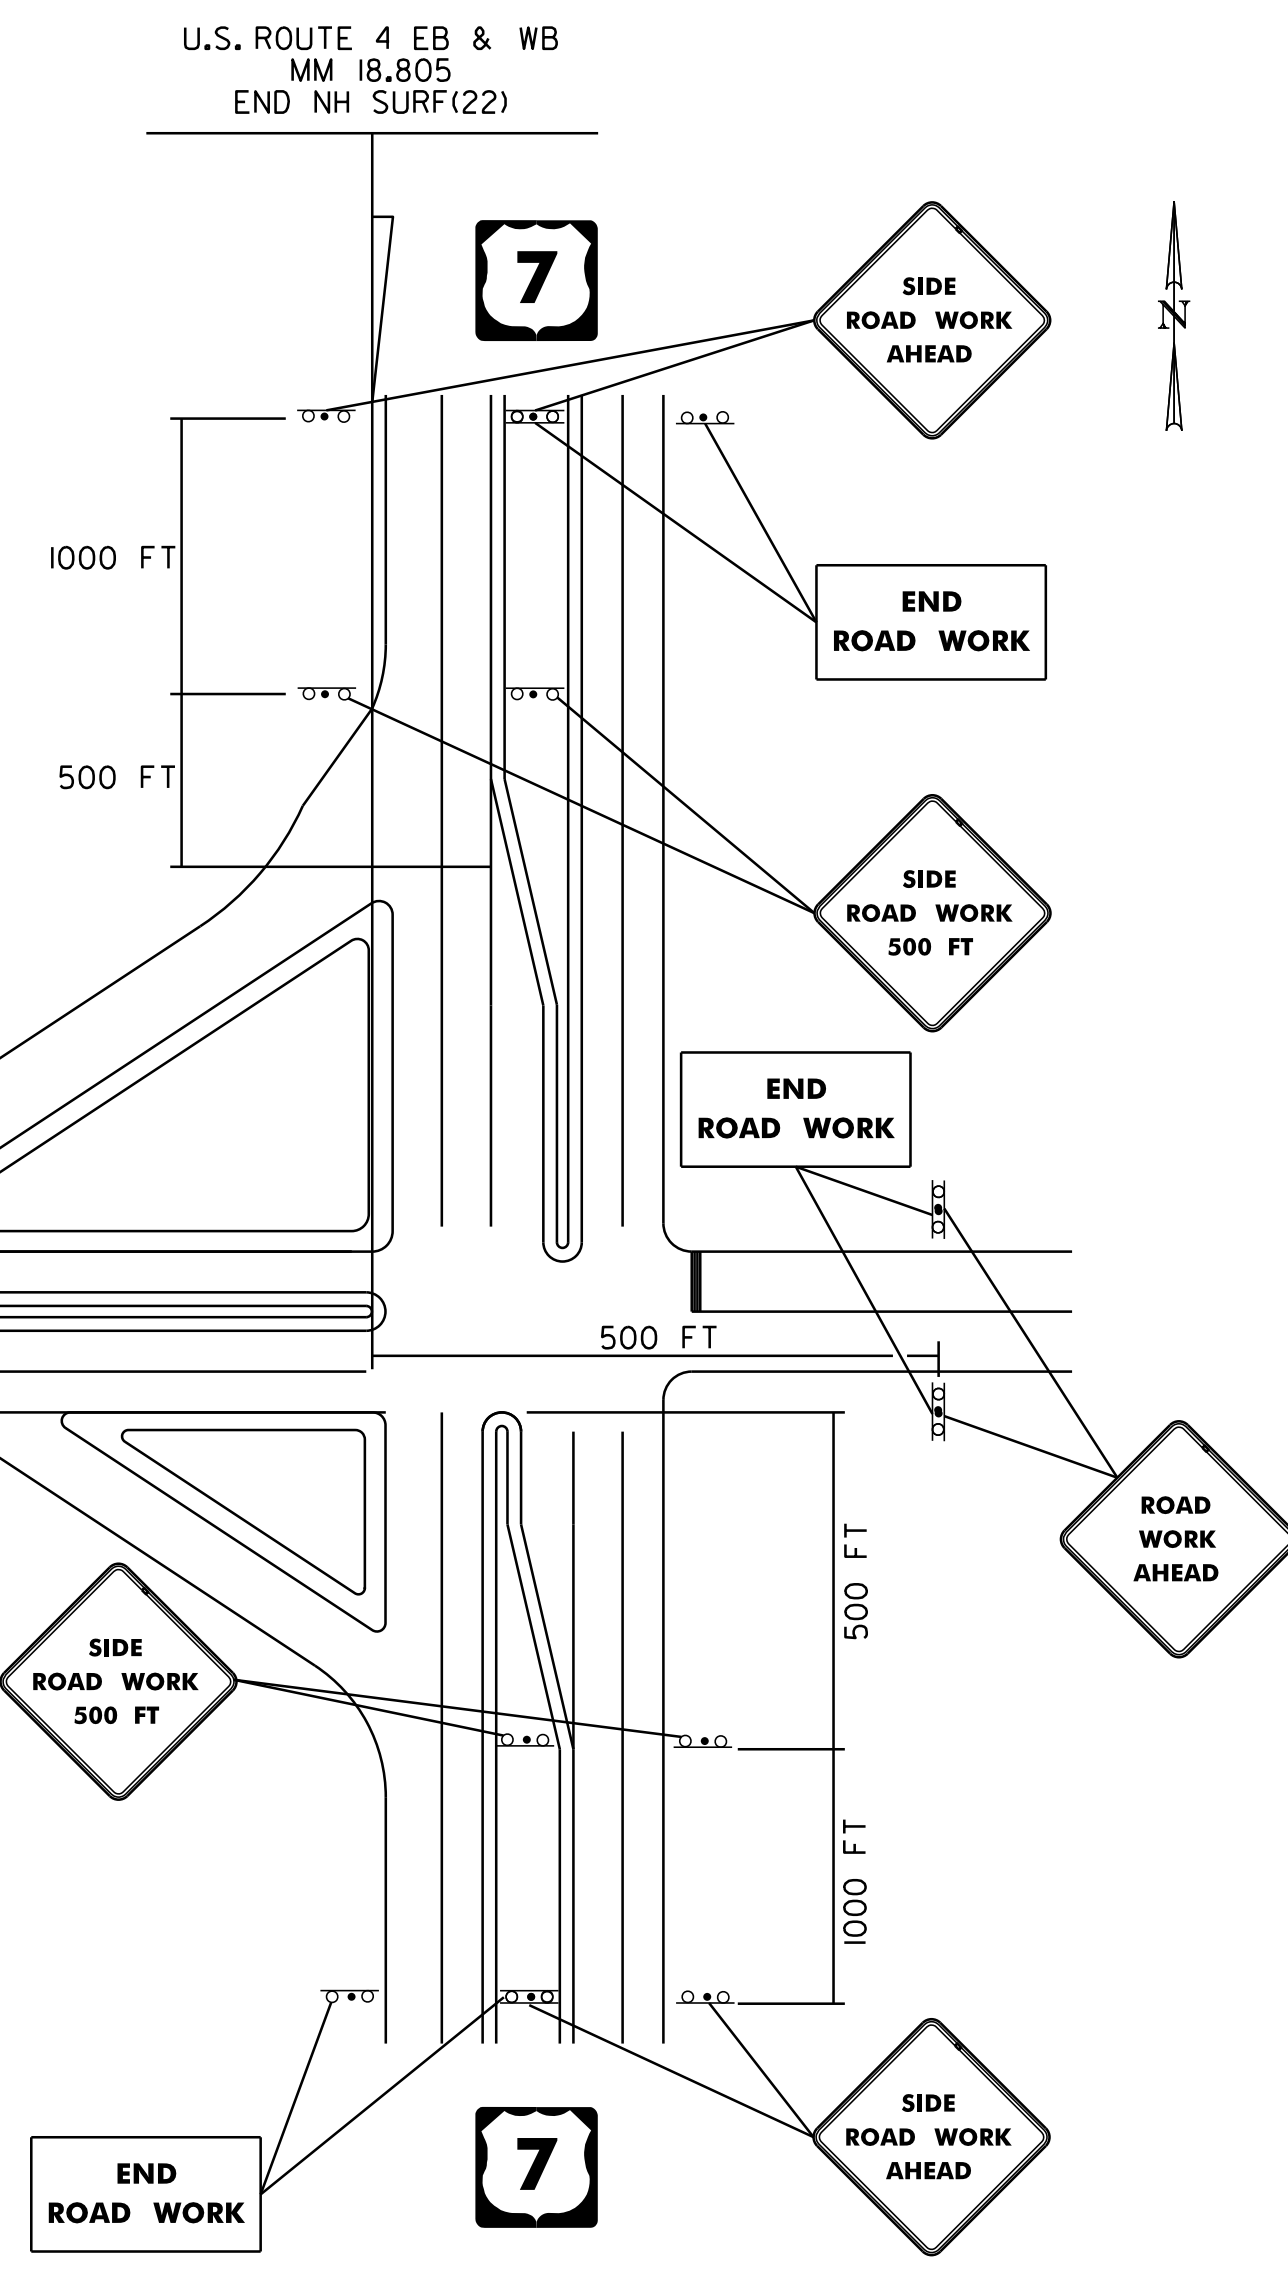

NOT TO SCALE

INTERCHANGE
TRAFFIC
CONTROL
SHEET 2

PROJECT NAME: FAIR HAVEN-RUTLAND TOWN	
PROJECT NUMBER: NH SURF(22)	
FILE NAME: 10B106/10B106.DGN	PLOT DATE: 31-MAY-2013 11:56
PROJECT LEADER: M. FOWLER	DRAWN BY: PVT. MGT.
DESIGNED BY: PVT. MGT.	CHECKED BY: PVT. MGT.
10B106*23.1	SHEET 23 OF 24

1. THE CONTRACTOR SHALL SUBMIT A TRAFFIC CONTROL PLAN TO THE RESIDENT ENGINEER FOR APPROVAL PRIOR TO THE START OF CONSTRUCTION. THE CONTRACTOR SHALL INCLUDE A CONSTRUCTION SIGN PACKAGE FOR EXPECTED LANE CLOSURES AND WORK ZONE SPEED REDUCTIONS IN COMPLIANCE WITH STANDARD E-103. THE COST OF PREPARING THIS PLAN (AND MAKING CHANGES IF NECESSARY) SHALL BE INCLUDED IN THE UNIT PRICE BID FOR ITEM 641.10, TRAFFIC CONTROL.

2. THE CONTRACTOR SHALL POSITION PORTABLE CHANGEABLE MESSAGE SIGNS (PCMS) WARNING MOTORISTS OF THE EXPECTED ROADWAY CONDITIONS AHEAD. THE MESSAGE TO BE DISPLAYED, AND THEIR PROPOSED LOCATIONS SHALL BE SUBMITTED TO THE RESIDENT ENGINEER IN ADVANCE FOR APPROVAL. THE COST OF PROVIDING THESE MESSAGE SIGNS SHALL BE PAID UNDER ITEM 641.15, PORTABLE CHANGEABLE MESSAGE SIGN.

3. THE BID PRICE FOR TRAFFIC CONTROL, ITEM 641.10, SHALL INCLUDE ALL OF THE FOLLOWING, AS NEEDED: APPROACH AND ON-PROJECT CONSTRUCTION SIGNING, PORTABLE FLASHING ARROW BOARDS, BARRIERS, BARRELS, CONES, BARRICADES, TEMPORARY REGULATORY AND WARNING SIGNS, AND POSTS AS DETAILED IN VTRANS STANDARDS. ALL ADJUSTING, RELOCATING AND REMOVING OF THESE DEVICES AS DIRECTED BY THE RESIDENT ENGINEER SHALL ALSO BE INCLUDED.

4. THE 2009 EDITION OF THE MANUAL ON UNIFORM TRAFFIC CONTROL DEVICES (MUTCD) SHALL BE THE STANDARD FOR ALL TRAFFIC CONTROL DEVICES. EXISTING SIGNS AND MARKING SHALL BE VALID UNTIL SUCH TIME AS THEY ARE REPLACED OR RECONSTRUCTED. WHEN NEW TRAFFIC DEVICES ARE ERECTED OR PLACED, OR EXISTING TRAFFIC CONTROL DEVICES ARE REPLACED OR REPAIRED, THE EQUIPMENT, DESIGN, METHOD OF INSTALLATION, PLACEMENT OR REPAIR SHALL CONFORM WITH SUCH STANDARDS.

5. NO CONSTRUCTION SIGNS SHALL BE INSTALLED AS TO INTERFERE OR OBSTRUCT THE VIEW OF EXISTING TRAFFIC CONTROL DEVICES, STOPPING SIGHT DISTANCE, AND CORNER SIGHT DISTANCE FROM DRIVES AND TOWN HIGHWAYS.

6. ON VTRANS STANDARD E-103, SIGN W4-2 MAY BE REPLACED WITH W9-2.

7. SEE VAOT STANDARD E-100 FOR ADDITIONAL SIGN PLACEMENT DETAILS.

8. CONSTRUCTION ZONE SIGN LAYOUT SHALL BE IN ACCORDANCE WITH SECTION 6 OF THE LATEST EDITION OF THE MANUAL ON UNIFORM TRAFFIC CONTROL DEVICES (MUTCD).

9. CONSTRUCTION SIGNS SHALL BE IN NEW OR LIKE NEW CONDITION PER VAOT STANDARDS AND SPECIAL PROVISIONS.

10. DIAMOND SHAPED SIGNS SHALL BE 4' X 4' WITH BLACK TEXT AND BORDER ON A RETROREFLECTIVE FLUORESCENT ORANGE BACKGROUND.

11. RETROREFLECTIVE SHEETING SHALL BE TYPE III MINIMUM AS NOTED ON VAOT STANDARD E-100 AND IN THE SPECIAL PROVISIONS.

12. CONSTRUCTION ZONE SIGNS SHALL BE INSTALLED AS OUTLINED IN THE SPECIAL PROVISIONS.

13. WHERE TEMPORARY SIGNS ARE PLACED BEHIND GUARDRAIL, THEY SHALL BE ADJUSTED SUCH THAT THE BOTTOMS OF THE SIGNS ARE ONE FOOT ABOVE THE TOP OF GUARDRAIL.

14. AS THE PAVING OPERATION MOVES, FLAGGER SIGNS SHALL BE MOVED ACCORDINGLY. AT NO TIME SHOULD THE FLAGGER SYMBOL SIGN BE MORE THAN 1000 FEET FROM THE FLAGGER STATION. FLAGGER SIGNS SHALL BE COVERED OR TURNED AWAY FROM TRAFFIC WHEN FLAGGING OPERATIONS CEASE FOR LONGER THAN 10 MINUTES.

15. BARRELS AND CONES SHALL BE USED TO CLEARLY DEFINE THE TRAVEL SPACE AND PROVIDE SEPARATION FROM THE WORK SPACE ALONG ITS ENTIRE LENGTH.

16. FOR LANE CLOSURES GREATER THAN 1/2 MILE LONG, PLACE ONE TYPE III BARRICADE ACROSS THE CLOSED LANE AT 1500 FOOT INTERVALS.

17. TEMPORARY SPEED LIMIT SIGN ASSEMBLIES SHALL INCLUDE G20-5aP "WORK ZONE" PLAQUE.
- NOT TO SCALE
- TRAFFIC
CONTROL
NOTES
SHEET
- | | |
|----------------------------------|------------------------------|
| PROJECT NAME: FAIR HAVEN-RUTLAND | |
| PROJECT NUMBER: NH SURF(22) | |
| FILE NAME: 10B106/10B106.DGN | PLOT DATE: 31-MAY-2013 11:56 |
| PROJECT LEADER: M. FOWLER | DRAWN BY: PVT. MGT. |
| DESIGNED BY: PVT. MGT. | CHECKED BY: PVT. MGT. |
| 10B106*24.1 | SHEET 24 OF 24 |