


SOCCER FIELD

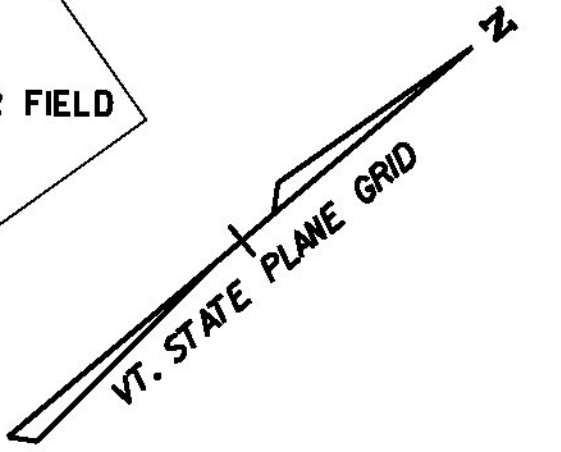

SOCCER FIELD

GRASS

GRASS

MATCHLINE STA 7+760

PROPOSED VT 100

LEGEND

→ EXISTING DRAINAGE PATTERNS

CLASS III
WETLAND

TOWN OF MORRISTOWN
VILLAGE OF MORRISVILLE

0 10 20 30
SCALE 1:500

PROJECT NAME: MORRISTOWN
PROJECT NUMBER: STP F 029-1(2)C/1

FILE NAME: z10b194ec03.dgn
PROJECT LEADER: DMB
DESIGNED BY: BRC
EXISTING CONDITIONS SITE PLAN - 1

PLOT DATE: 29-MAR-2012
DRAWN BY: MAL
CHECKED BY: DMB
SHEET 40 OF 123