


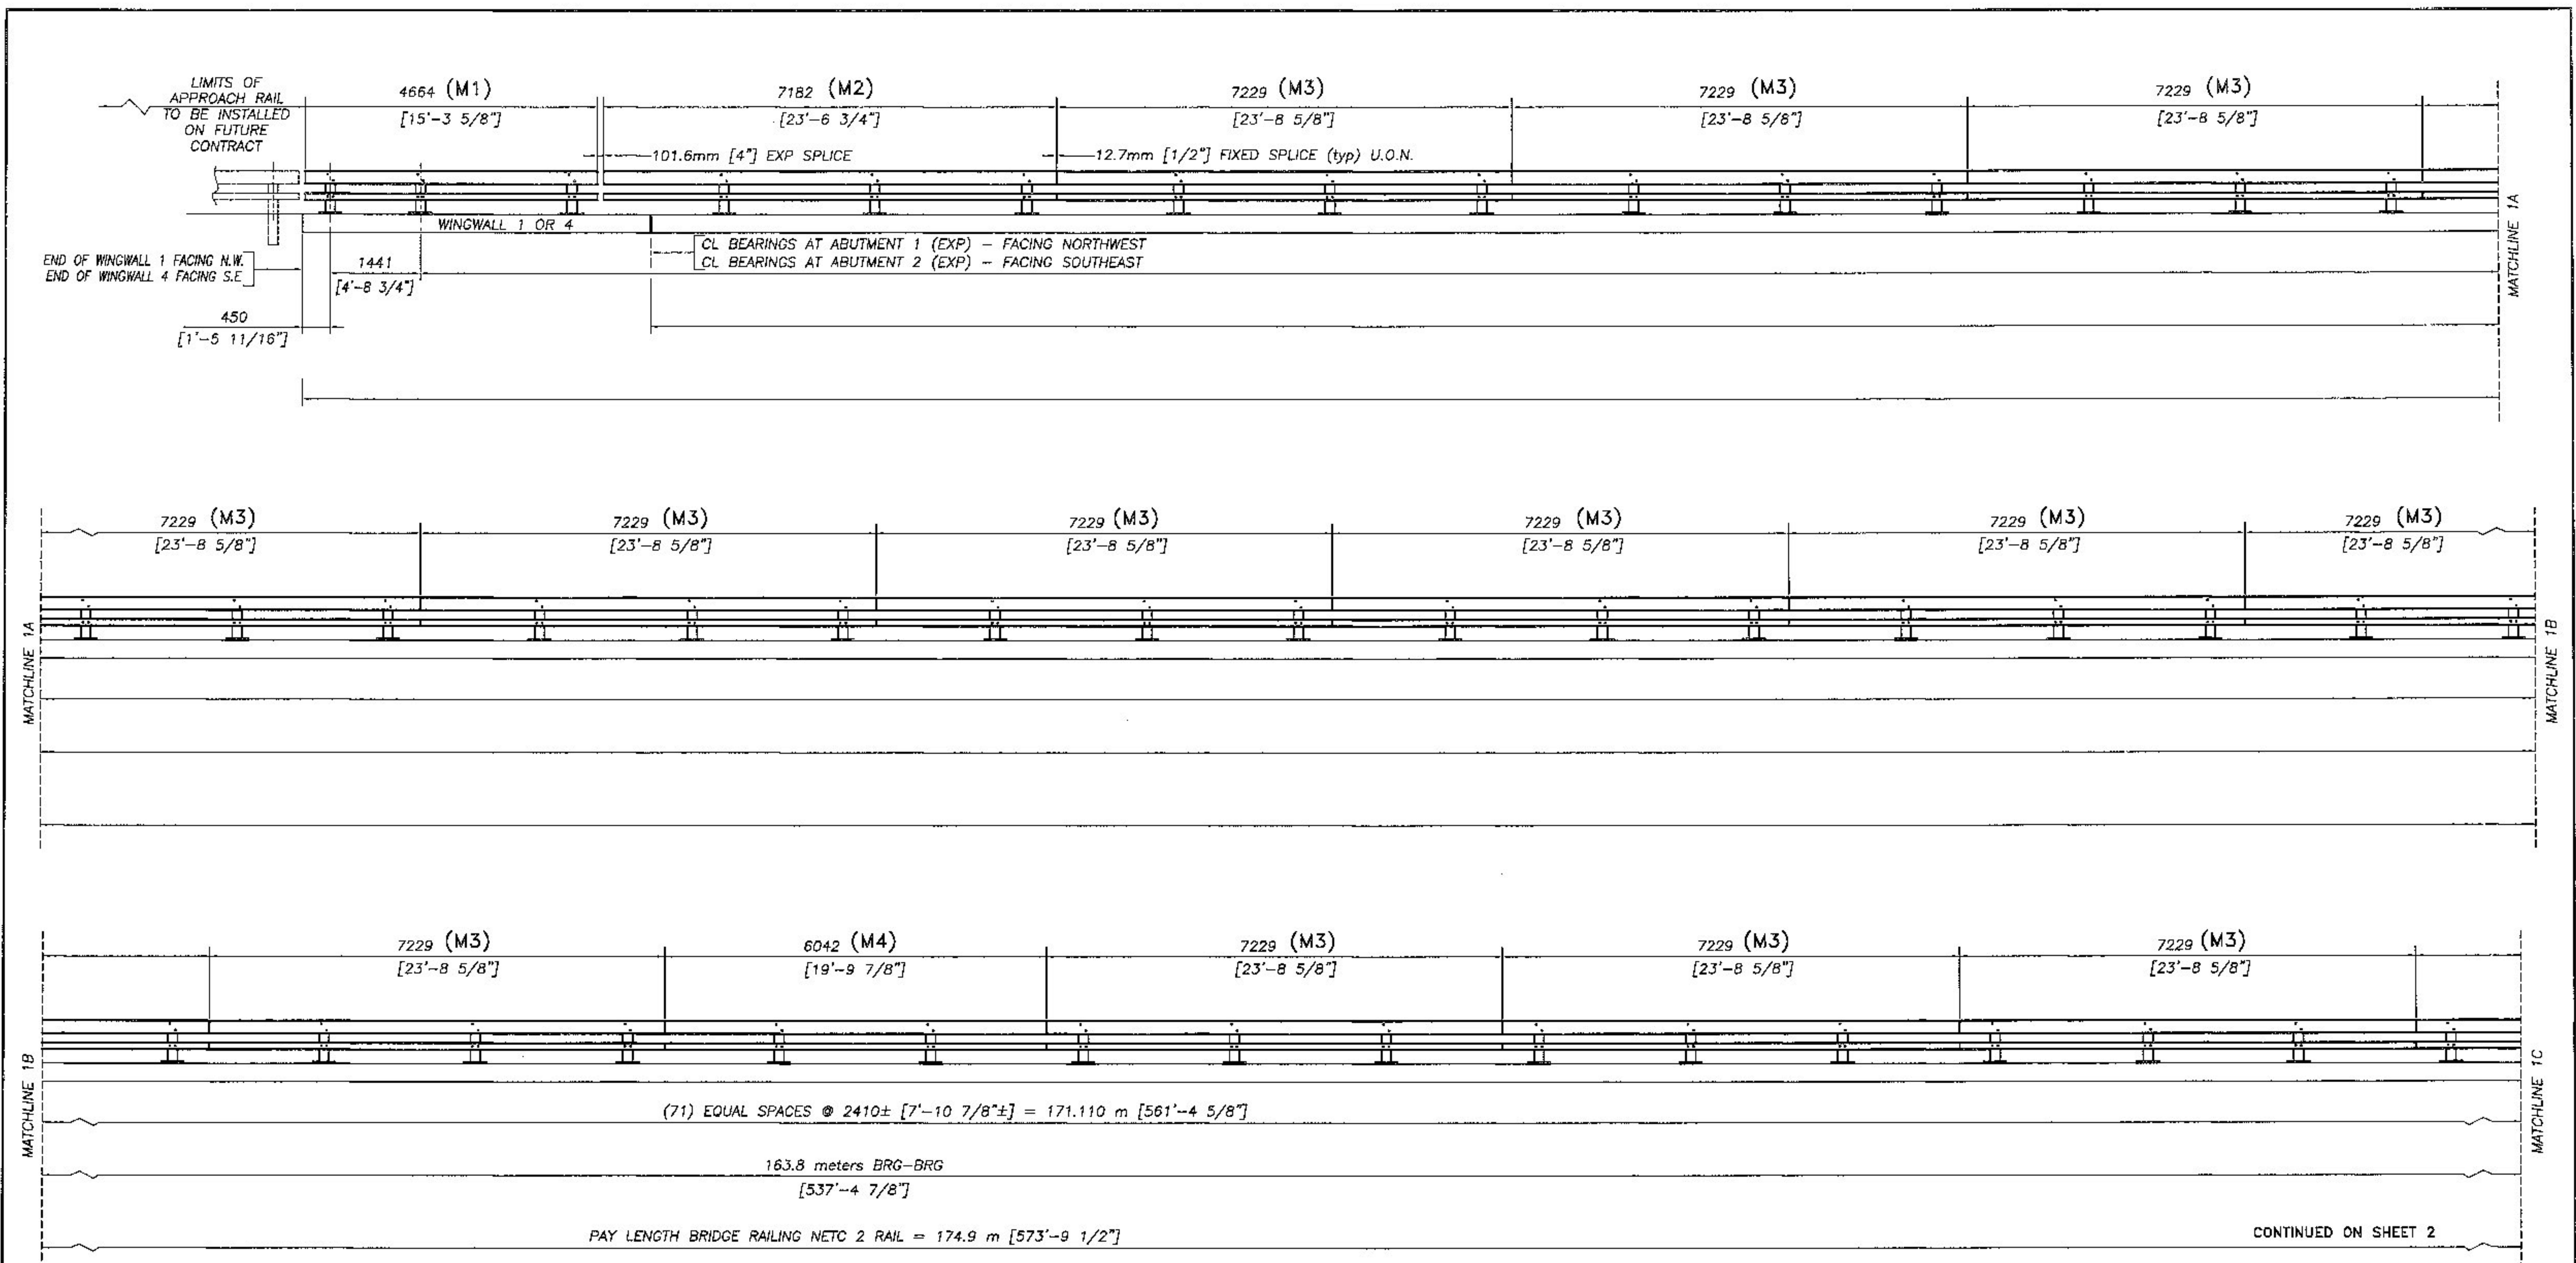

NORTHWEST (OR SOUTHEAST) RAILING ELEVATION
 LOOKING AT FACE OF RAILING FROM CENTERLINE OF ROAD
 FACING NORTHWEST (OR SOUTHEAST)

Vermont Agency of Transportation
RECEIVED
 CK'D BY OK'D BY D. Bonneau
 January 4, 2013
 RESUBMIT No Approved
 BY Douglas Bonneau DATE 01/08/13

ALL LINEAR DIMENSIONS ARE IN millimeters (mm) UNLESS OTHERWISE NOTED
 ENGLISH STANDARD DIMENSIONS ARE SHOWN IN [] FOR REFERENCE

No.	Remarks	Date
0	Initial submittal	1/28/12
REVISIONS - APPLIES TO SET		

☐ Reviewed
☐ Rejected
☒ Furnish As Corrected
☐ Revise and Resubmit

This review is only for general conformance with the design concept and the information given in the Construction Documents. Corrections or comments made on the shop drawings during the review do not relieve the Contractor from compliance with the requirements of the Plans and Specifications. Review of a specific item shall not include review of an assembly of which an item is a component. The Contractor is responsible for dimensions to be confirmed and corrected at the job site; information that pertains solely to the fabrication process or to the means, methods, techniques, sequences and procedures of construction; coordination of the Work with that of other trades and performing all Work in a safe and satisfactory manner.

Date: January 3, 2012
 By: D. Kull

McFarland Johnson

ITEM 525.33 NETC 2 RAIL BRIDGE RAIL = 350 meters (BOTH SIDES COMBINED)

HIGHWAY SAFETY CORP
 GLASTONBURY, CT
 860-633-9445

ITEM 525.33 NETC 2 RAIL BRIDGE RAILING (S-360A)

TOWN OF MORRISTOWN, VERMONT
 LAMOILLE COUNTY
 VT100 MINOR ARTERIAL STP F 029-1(2) C/1

GENERAL CONTRACTOR
 SUB CONTRACTOR
 LAFAYETTE

DATE 11-28-12 SCALE NONE SIZE D

CERTIFIED FABRICATOR
 1909
 1 of 3