



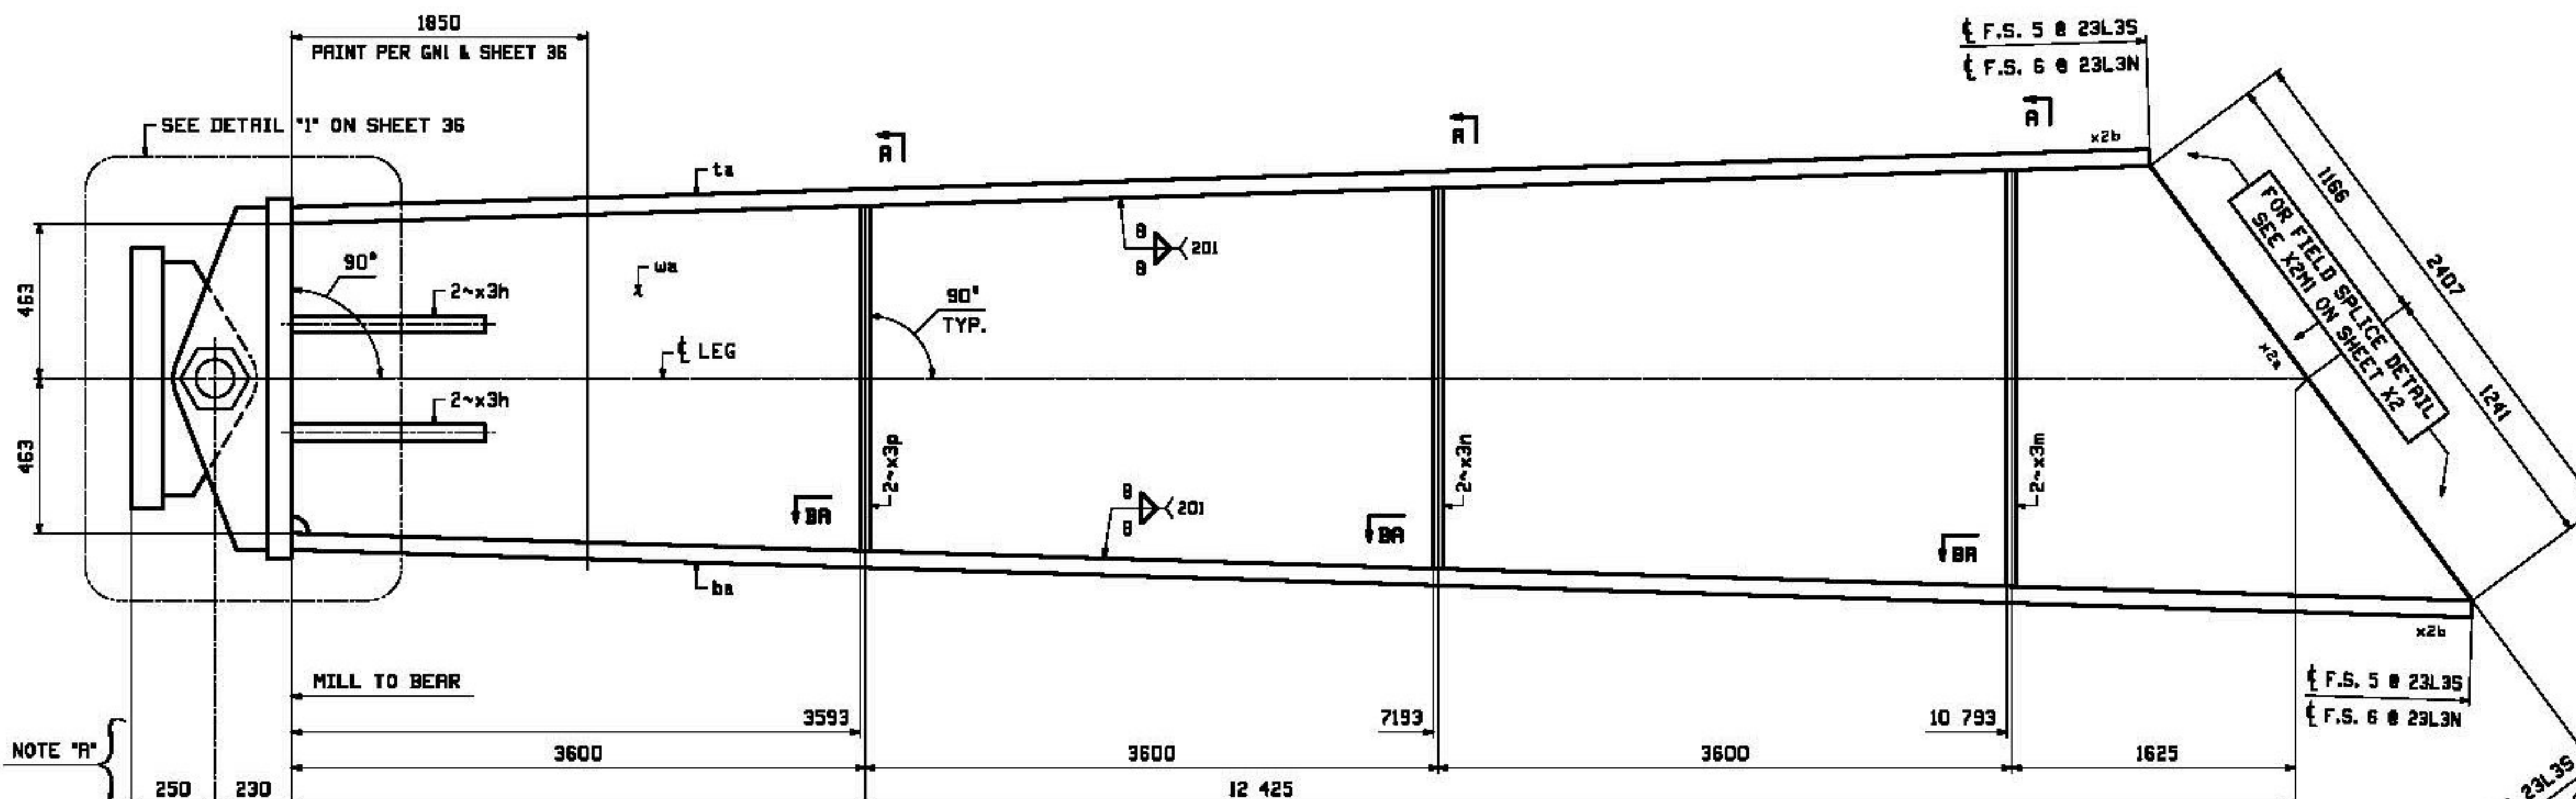


NOTE "A"
DIM'S ARE PARALLEL TO LEG.

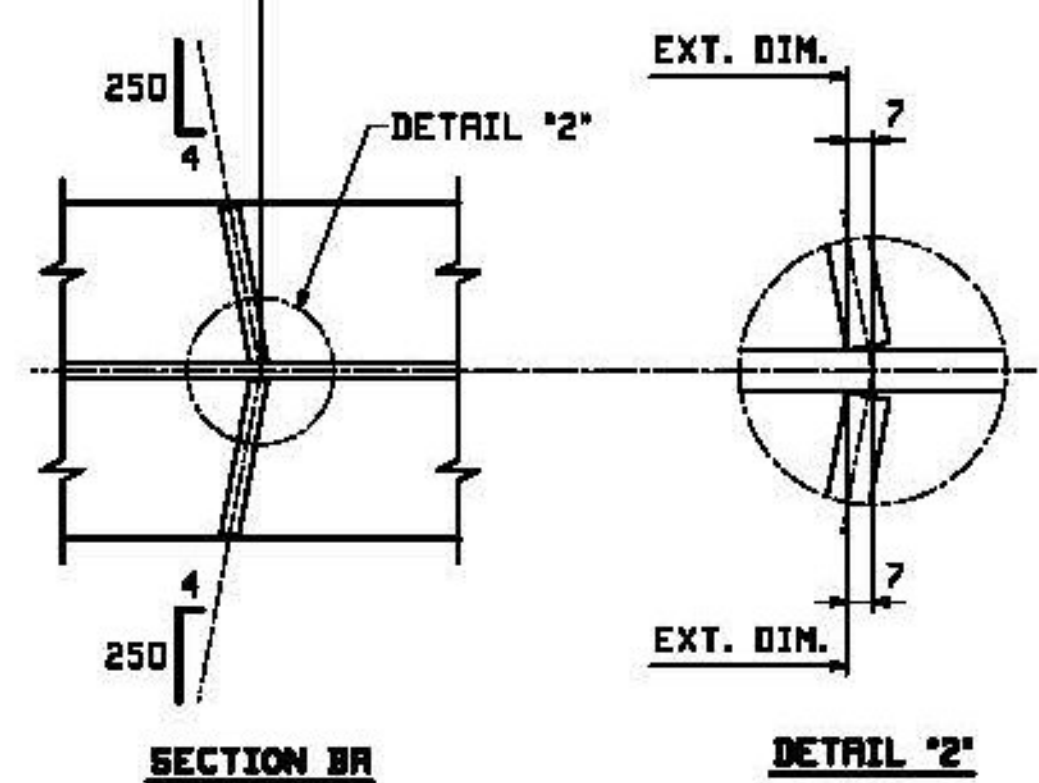

ONE - DELTA LEG - 23L35
ONE - DELTA LEG - 23L3N } ALIKE EXCEPT AS NOTED

FOR FIELD SPICE DETAILS SEE DRAWING X2.
FOR GIRDER STANDARD DETAILS SEE DRAWING X3 & X5.
FOR CAMBER & FLANGE DIAGRAMS SEE DRAWING CS.
FOR GENERAL NOTES SEE DRAWING GNL.
T2 DENOTES MATERIAL SUBJECT TO CHARPY V-NOTCH TESTING.

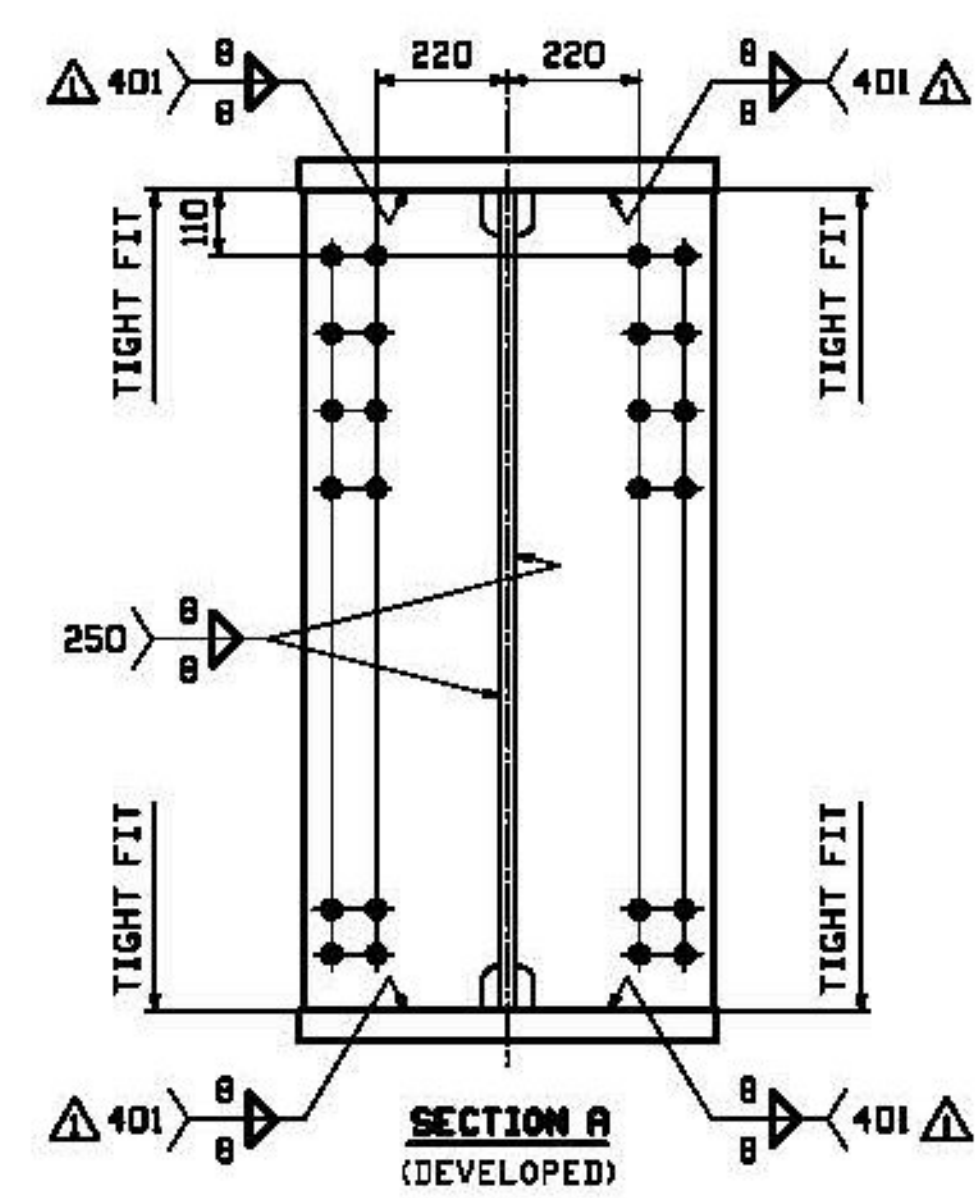

JOB NO.	DRAWING NO.	REV.	BILL OF MATERIAL							
			FORM INFO	SHOP						
PAGE	LINE	MARK	QTY	MARK	MATERIAL	LENGTH		REMARKS	MT	PROCUREMENT NOTES
						m	mm			
		23L35	1		DELTA LEG				4010 kg 20001 JV	
		23L3N	1		DELTA LEG				4010 kg 20001 JV	
A	1	U	2	wa	PL 25x1646	19	340	MIE 9270N-245K072	4500 kg 20001 JV	
	2	G	2	ta	PL 50x700	11	605	MIE 9270N-245K072	3100 kg 20001 JV	
	2	E	2	bw	PL 50x700	19	311	MIE 9270N-245K072	3027 kg 20001 JV	
	5	R	8	x3h	PL 50x340	0	800	MIE	107 kg 20001 JV	
	5	H	4	x3m	PL 13x330	1	598		54 kg 102 JV	
									45 kg 102 JV	
									28 kg 02 JV	

Vermont Agency of Transportation
RECEIVED
CK'D BY D.E.B. OK'D BY D.E.B.
March 19, 2013
RESUBMIT No Approved
BY T. Bohl DATE 03/28/2013


X Reviewed
Rejected

Furnish As Corrected
Revise and Resubmit

This review is only for general conformance with the design concept and the information given in the Construction Documents. Corrections or comments made on the shop drawings during the review do not relieve the Contractor from compliance with the requirements of the Plans and Specifications. Review of a specific item shall not include review of an assembly of which an item is a component. The Contractor is responsible for dimensions to be confirmed and corrected at the job site; information that pertains solely to the fabrication process or to the means, methods, techniques, sequences and procedures of construction; coordination of the Work with that of other trades and performing all Work in a safe and satisfactory manner.

By D. Kull Date March 19, 2013

McFarland Johnson

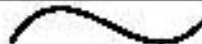WORK THIS SHEET WITH SHEET 35									
	3/15	F.S. DESIGN REV	CRK	PCP					
	12/18	APPROVAL COMMENTS	EEO	PCP					
									
REV.	DATE	REMARKS			DWN	CHK	APVL	SHOP	
MATERIAL:			SURFACE PREP. & PAINT:		HOLES:		SHOP BOLTS:		
M270M-345W U.N.			AS NOTED		5/16"		NONE		
DESCRIPTION: GIRDER DETAIL - 23L35 & 23L3N									
CASCO BAY STEEL STRUCTURES, INC.									
1 WALLACE AVE.			PHONE (207) 780-6722						
SOUTH PORTLAND, ME 04106			FAX. (207) 780-6726						
									
STRUCTURE:					DRAWN:		DATE:		
VT 100 OVER LAHOILLE RIVER					EEO		08/31		
MORRISTOWN, VT					CHKD:		DATE:		
STP F 029-1 (2) C/1					PCP		08/17		
LOCATION:					JOB NO.		DWG NO.		
MORRISTOWN, VT					521		23		
PROJ NO.					STP F 029-1(2)C/1		REV.		
CUSTOMER:					MINTERSET, INC.				