

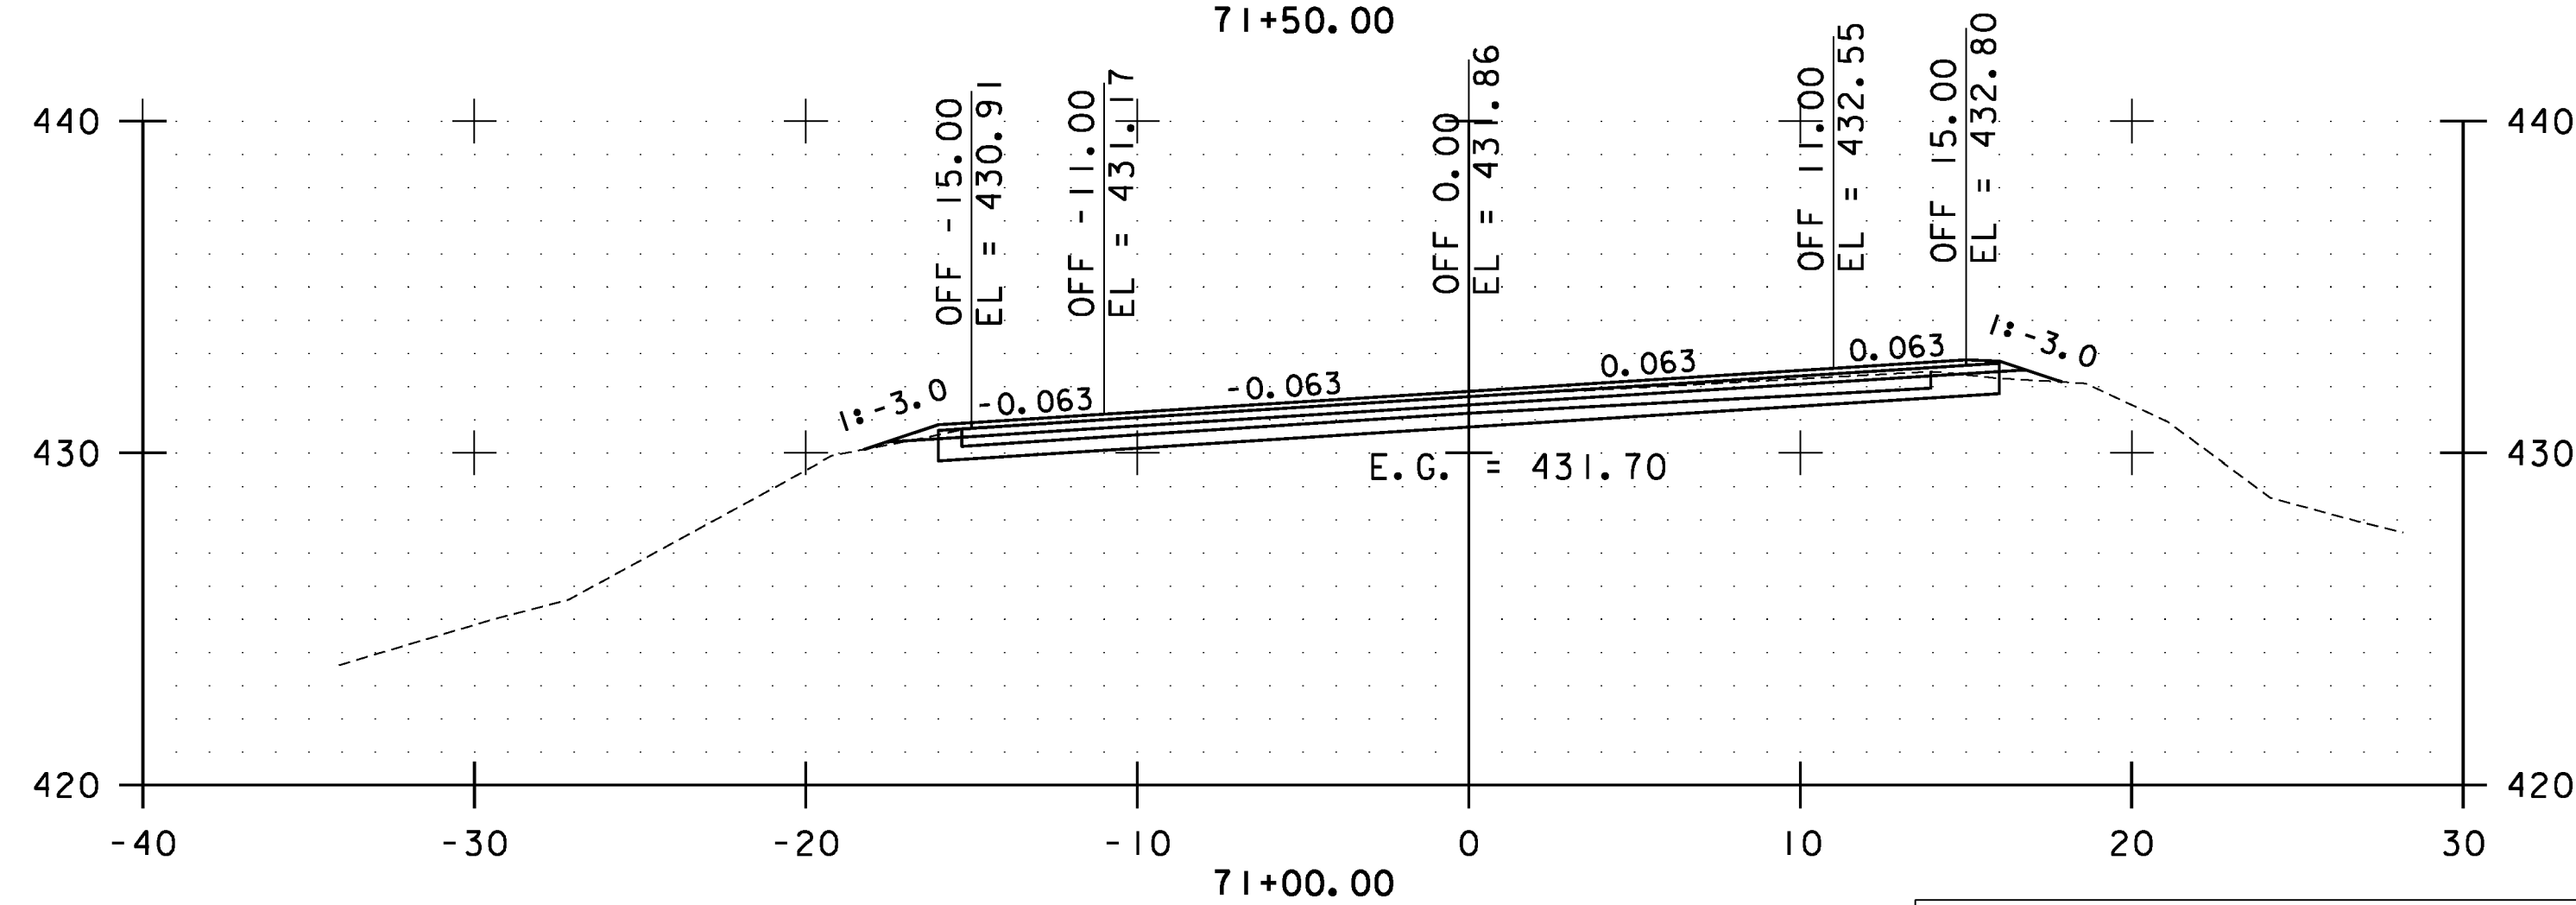
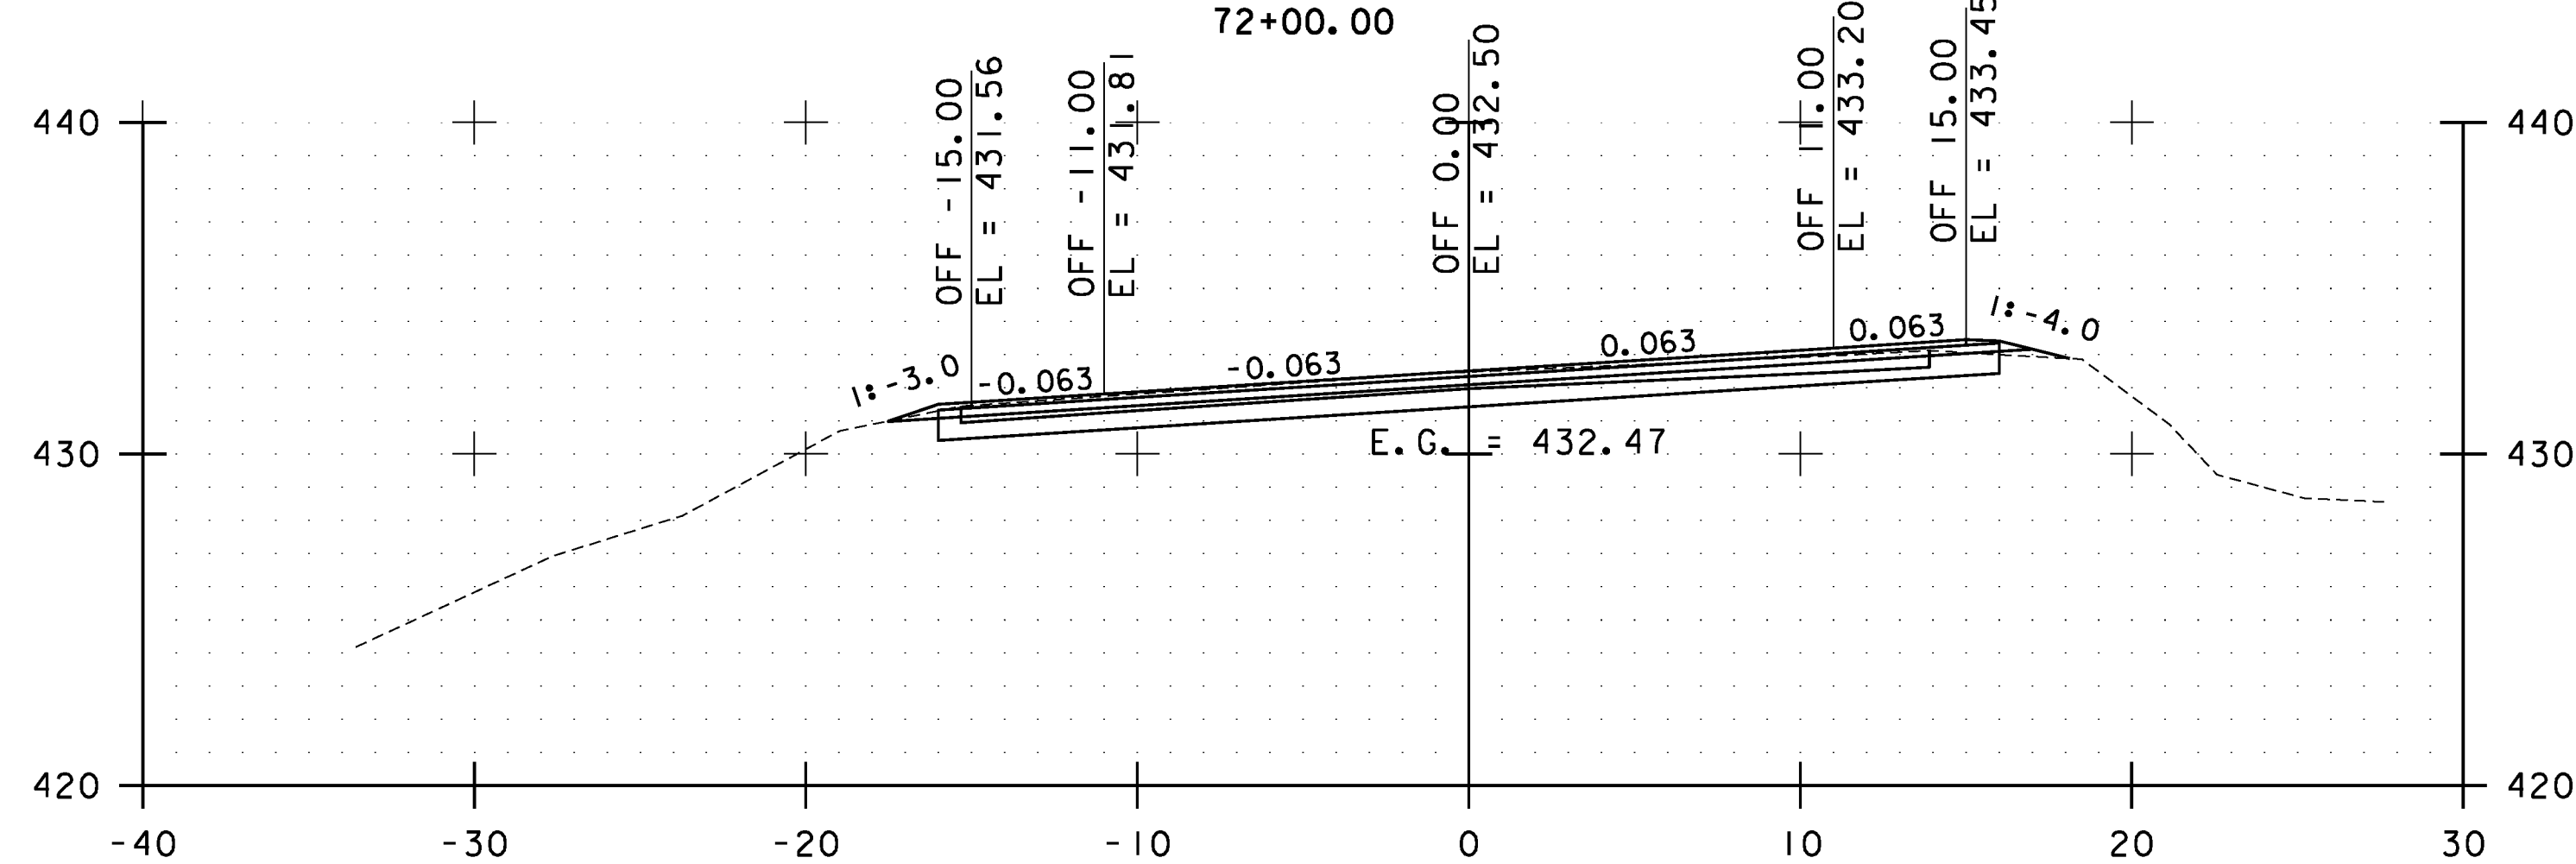
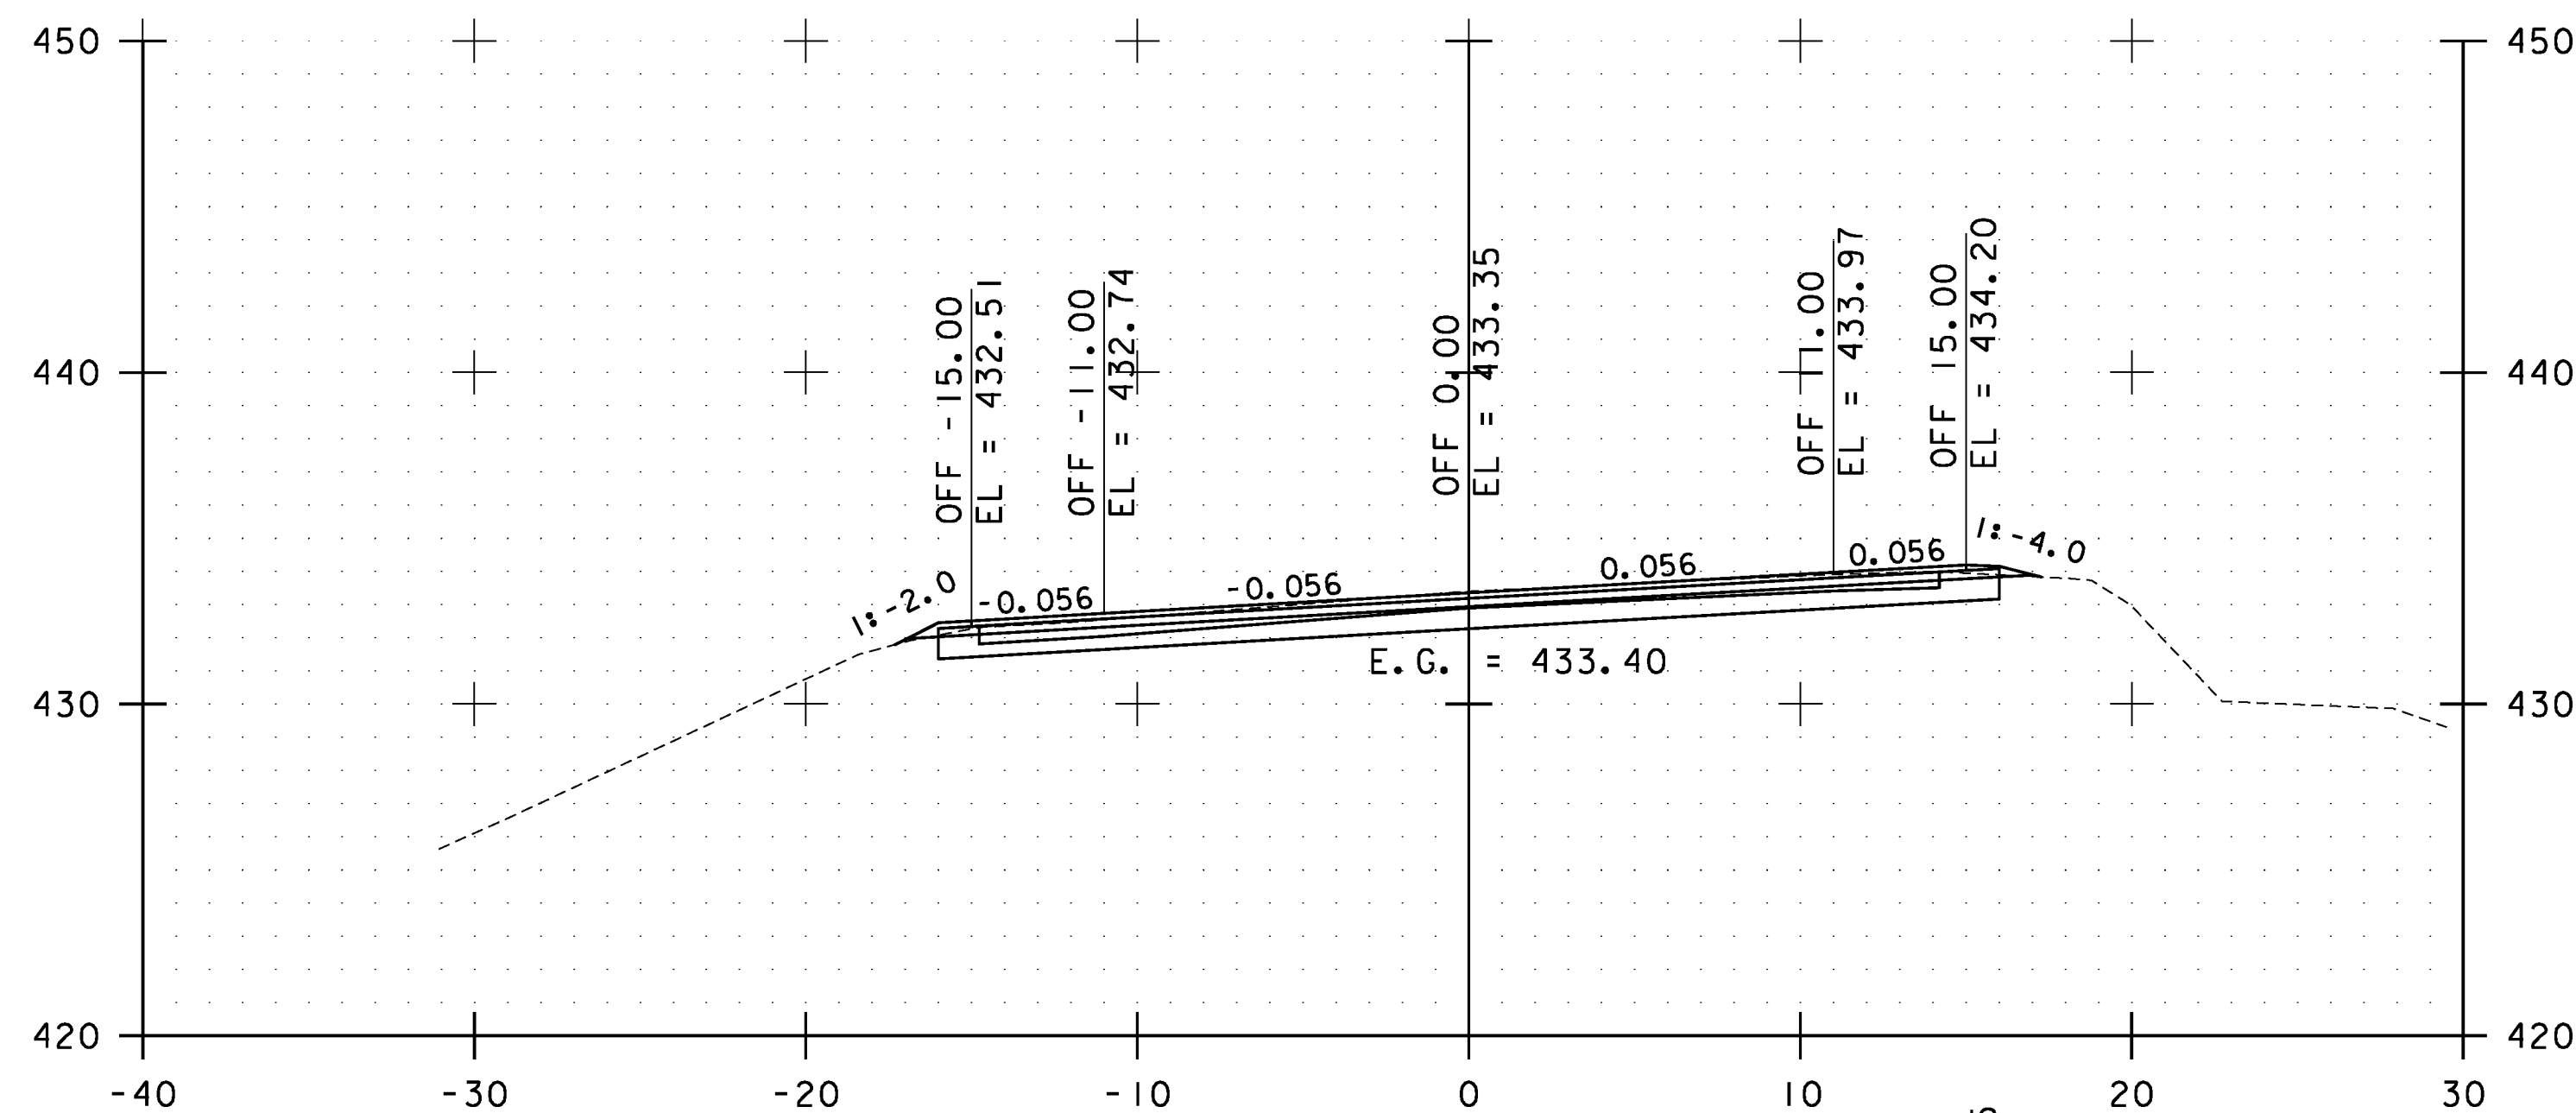
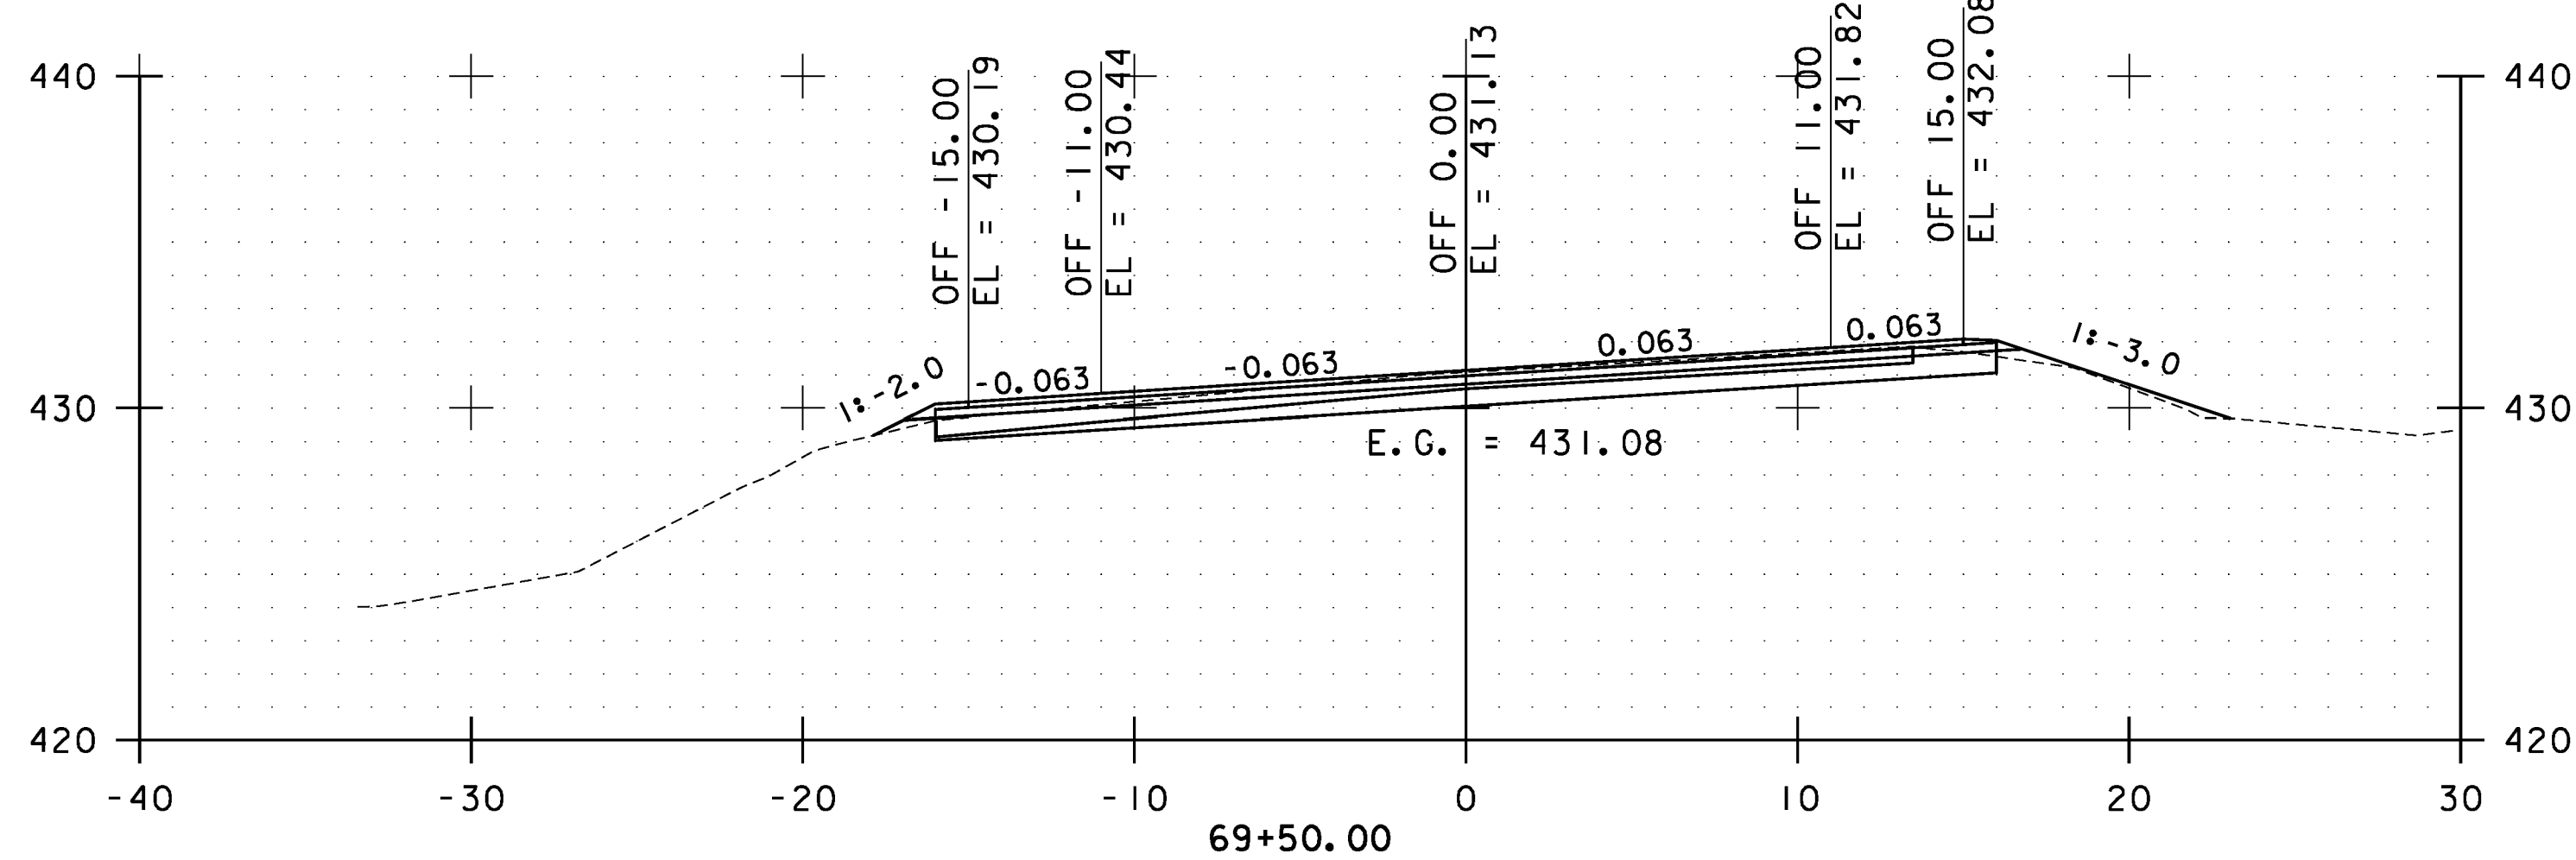
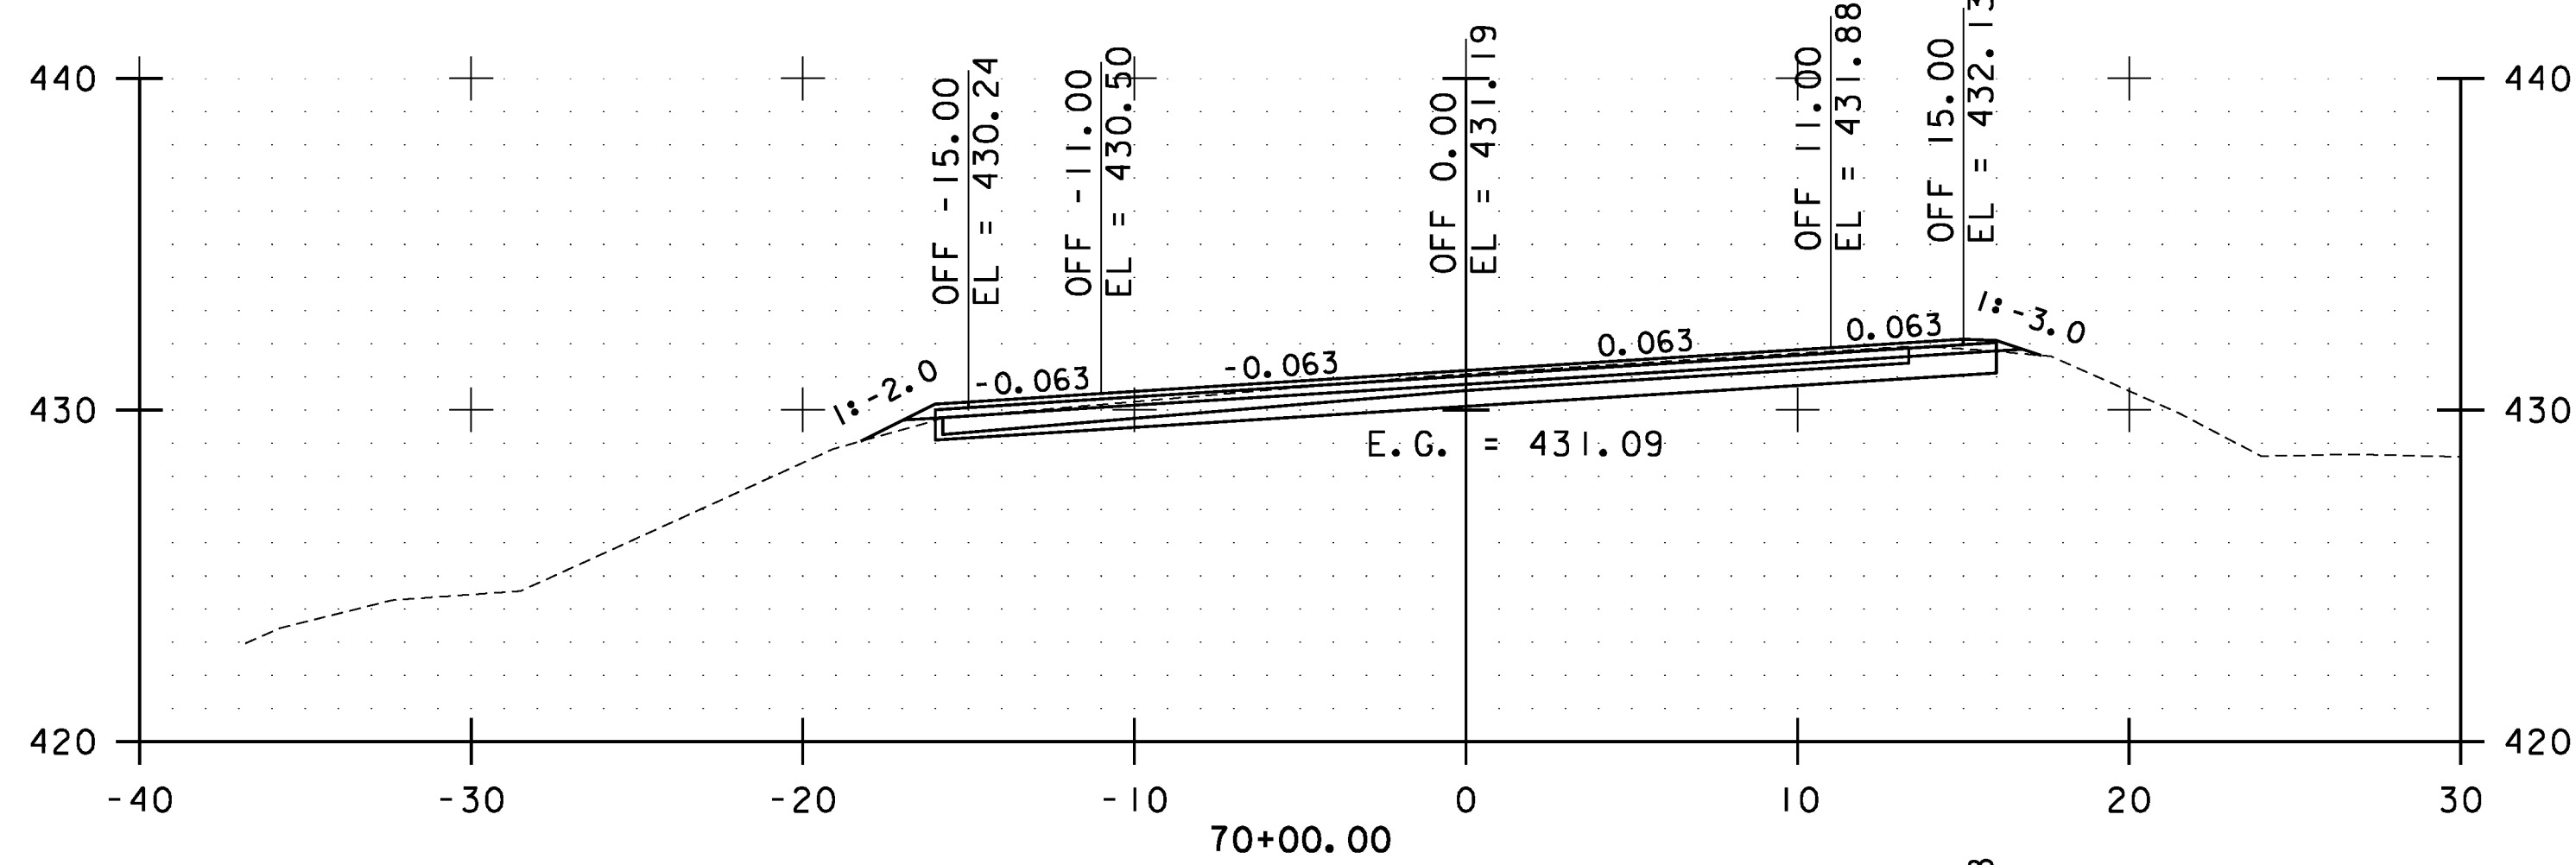


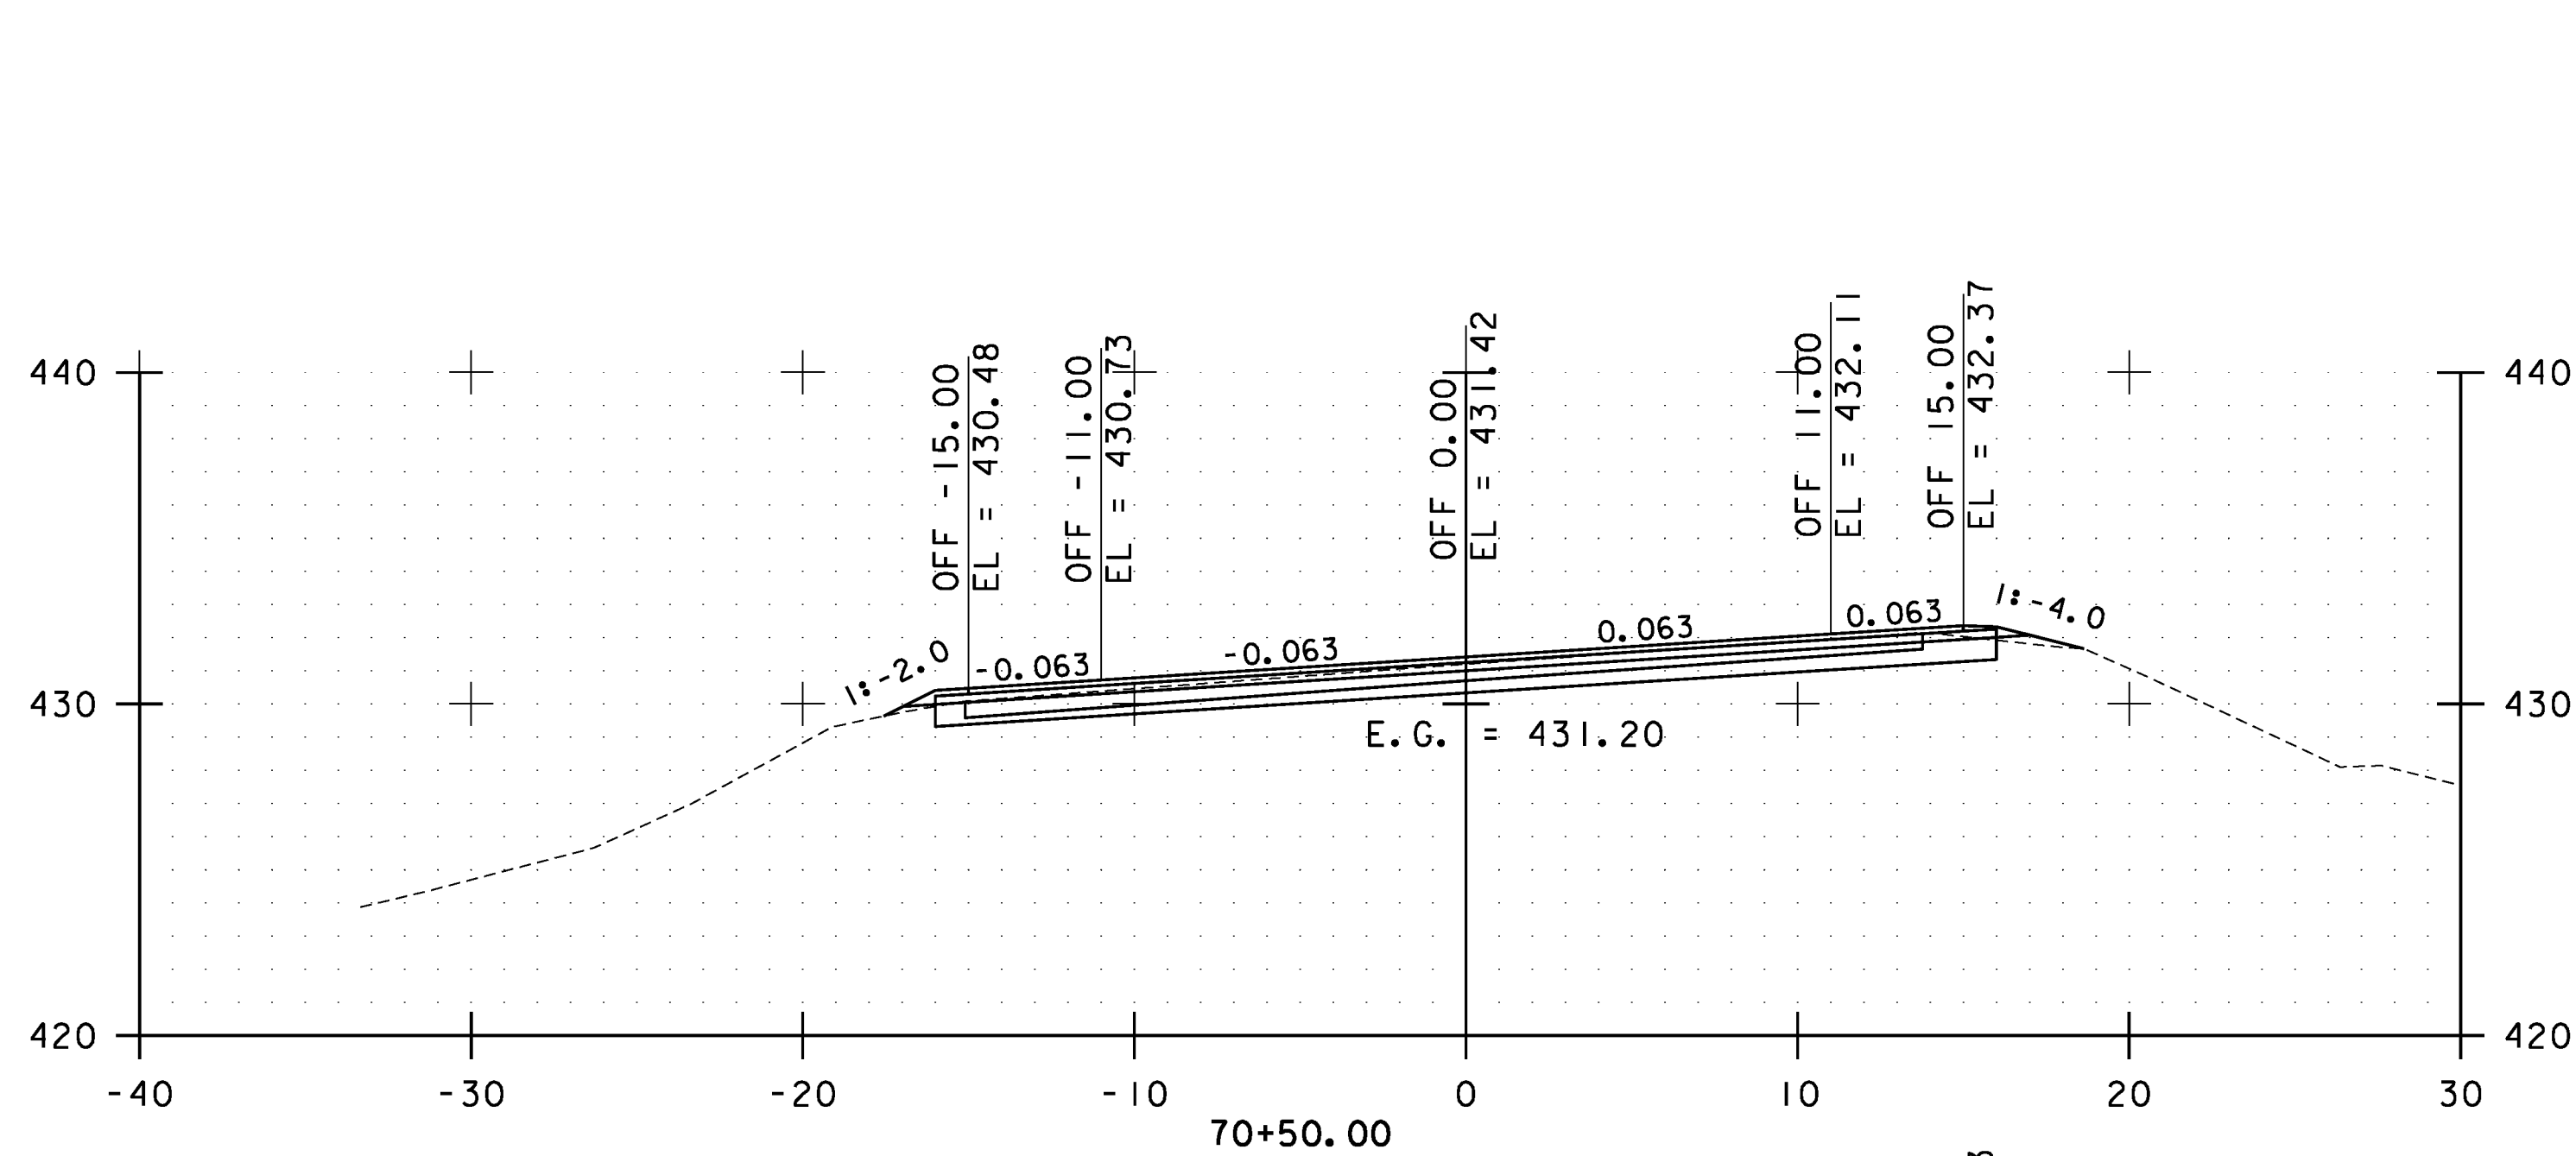

STA. 69+50.00 TO STA. 72+00.00

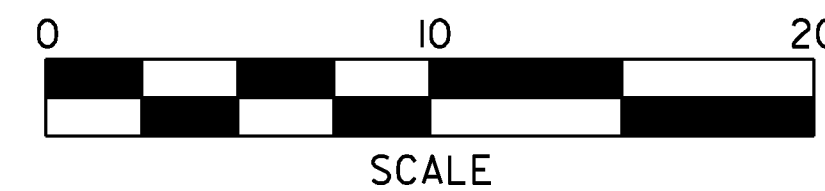

FLETCHER CROSS SECTIONS SHEET #28

PROJECT NAME:	CAMBRIDGE-BAKERSFIELD
PROJECT NUMBER:	STP 2926(1)
FILE NAME:	p10b258.dgn
PROJECT LEADER:	JLL
DESIGNED BY:	STANTEC
IPARM FILE:	p10b258xs28.i
PLOT DATE:	11/15/2012
DRAWN BY:	STANTEC
CHECKED BY:	STANTEC
SHEET	250 OF 387