

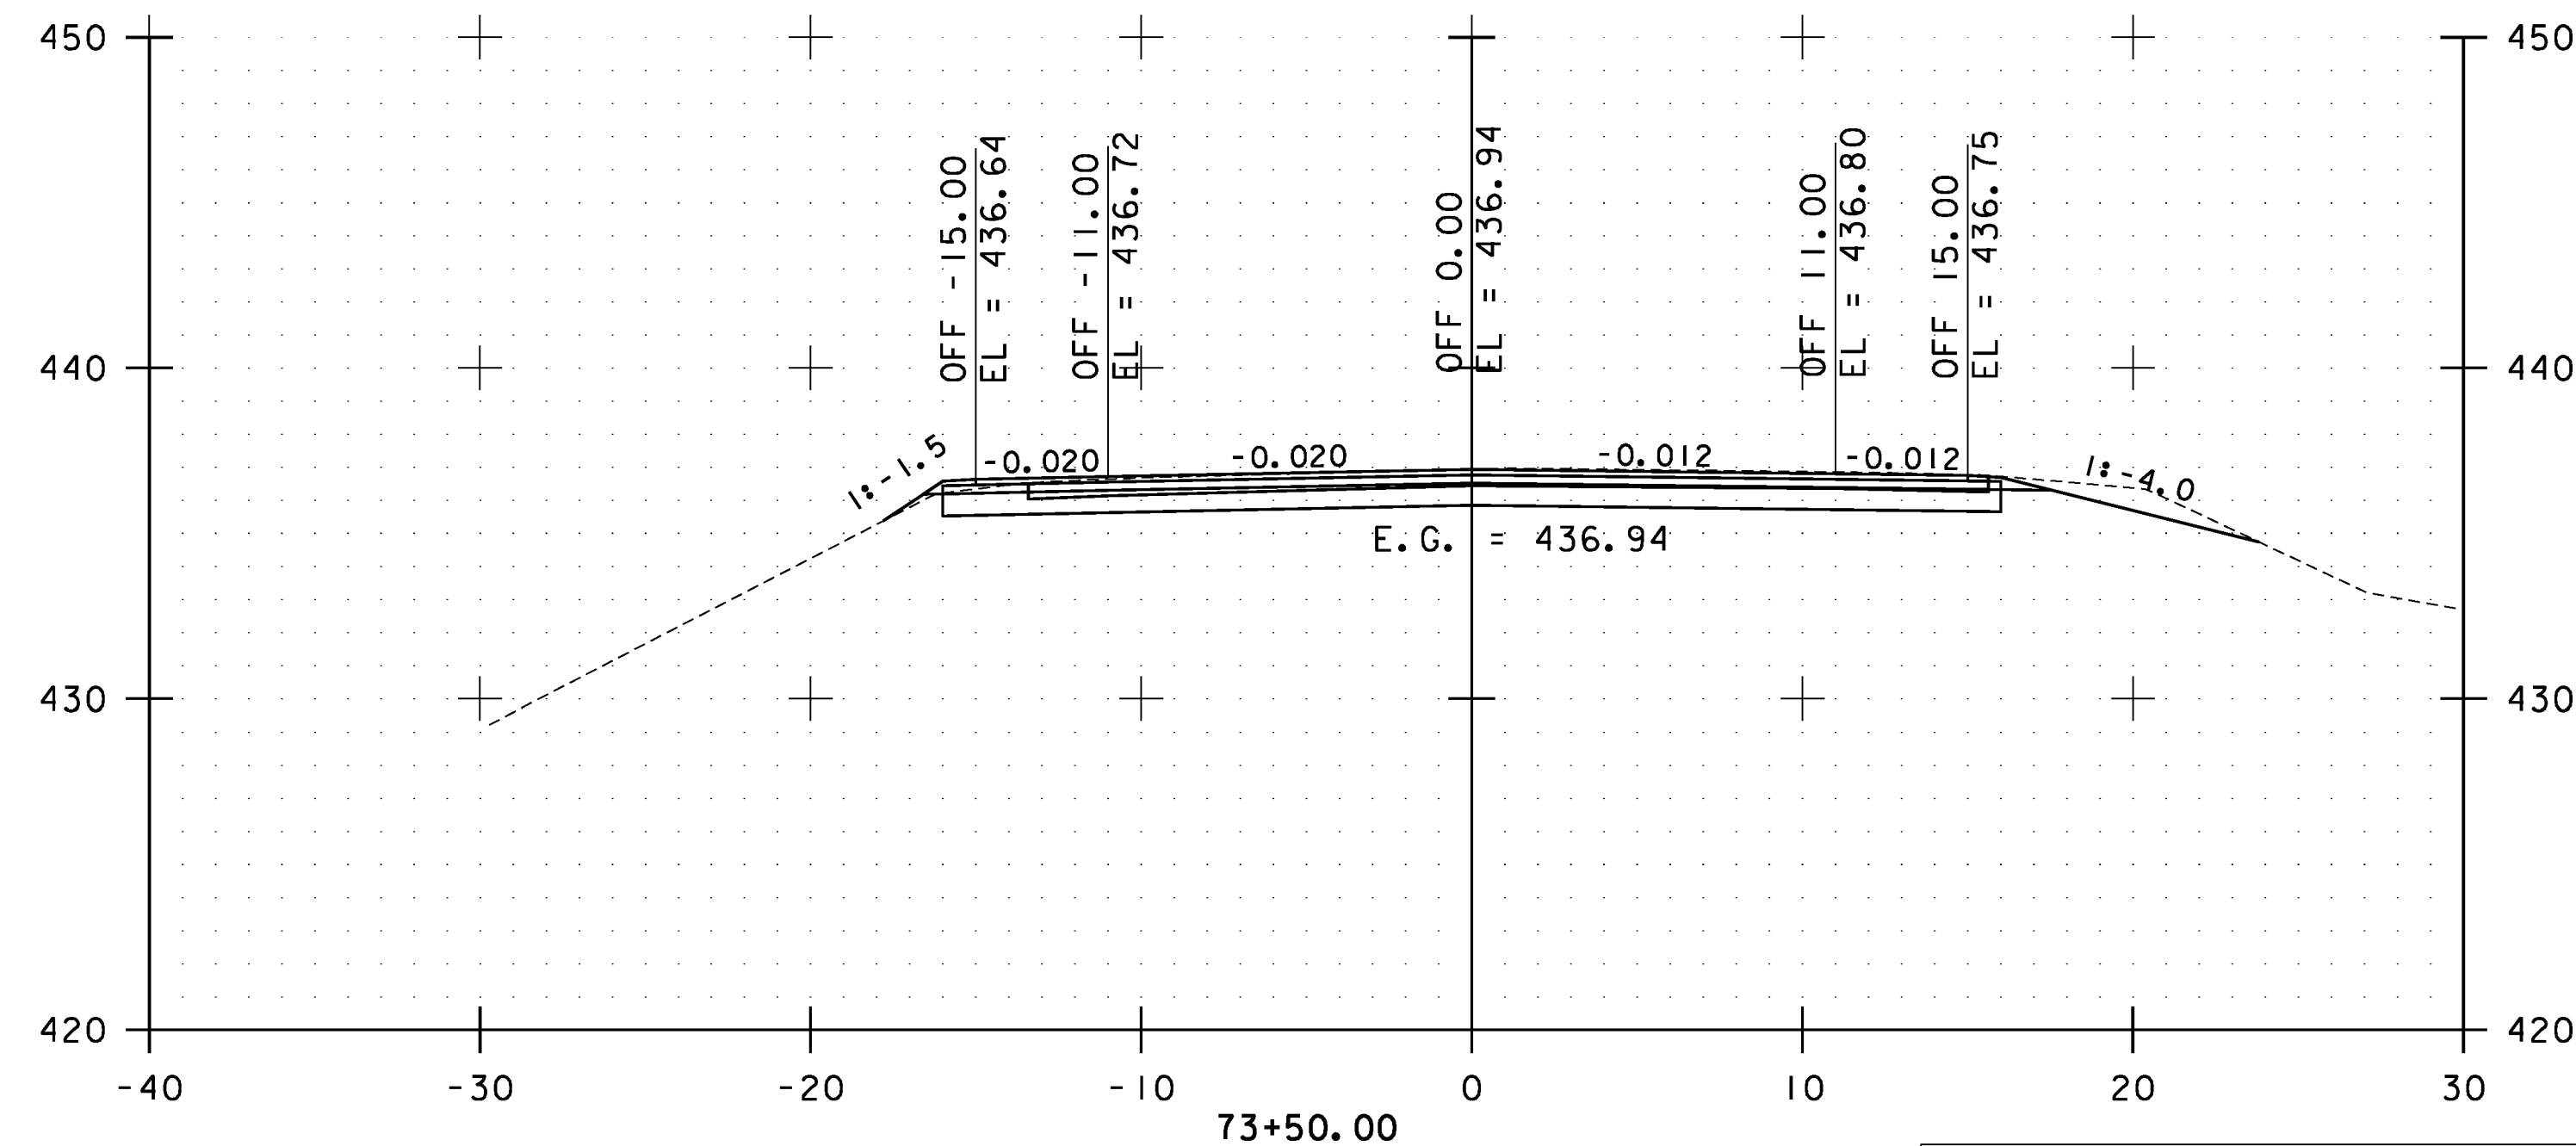
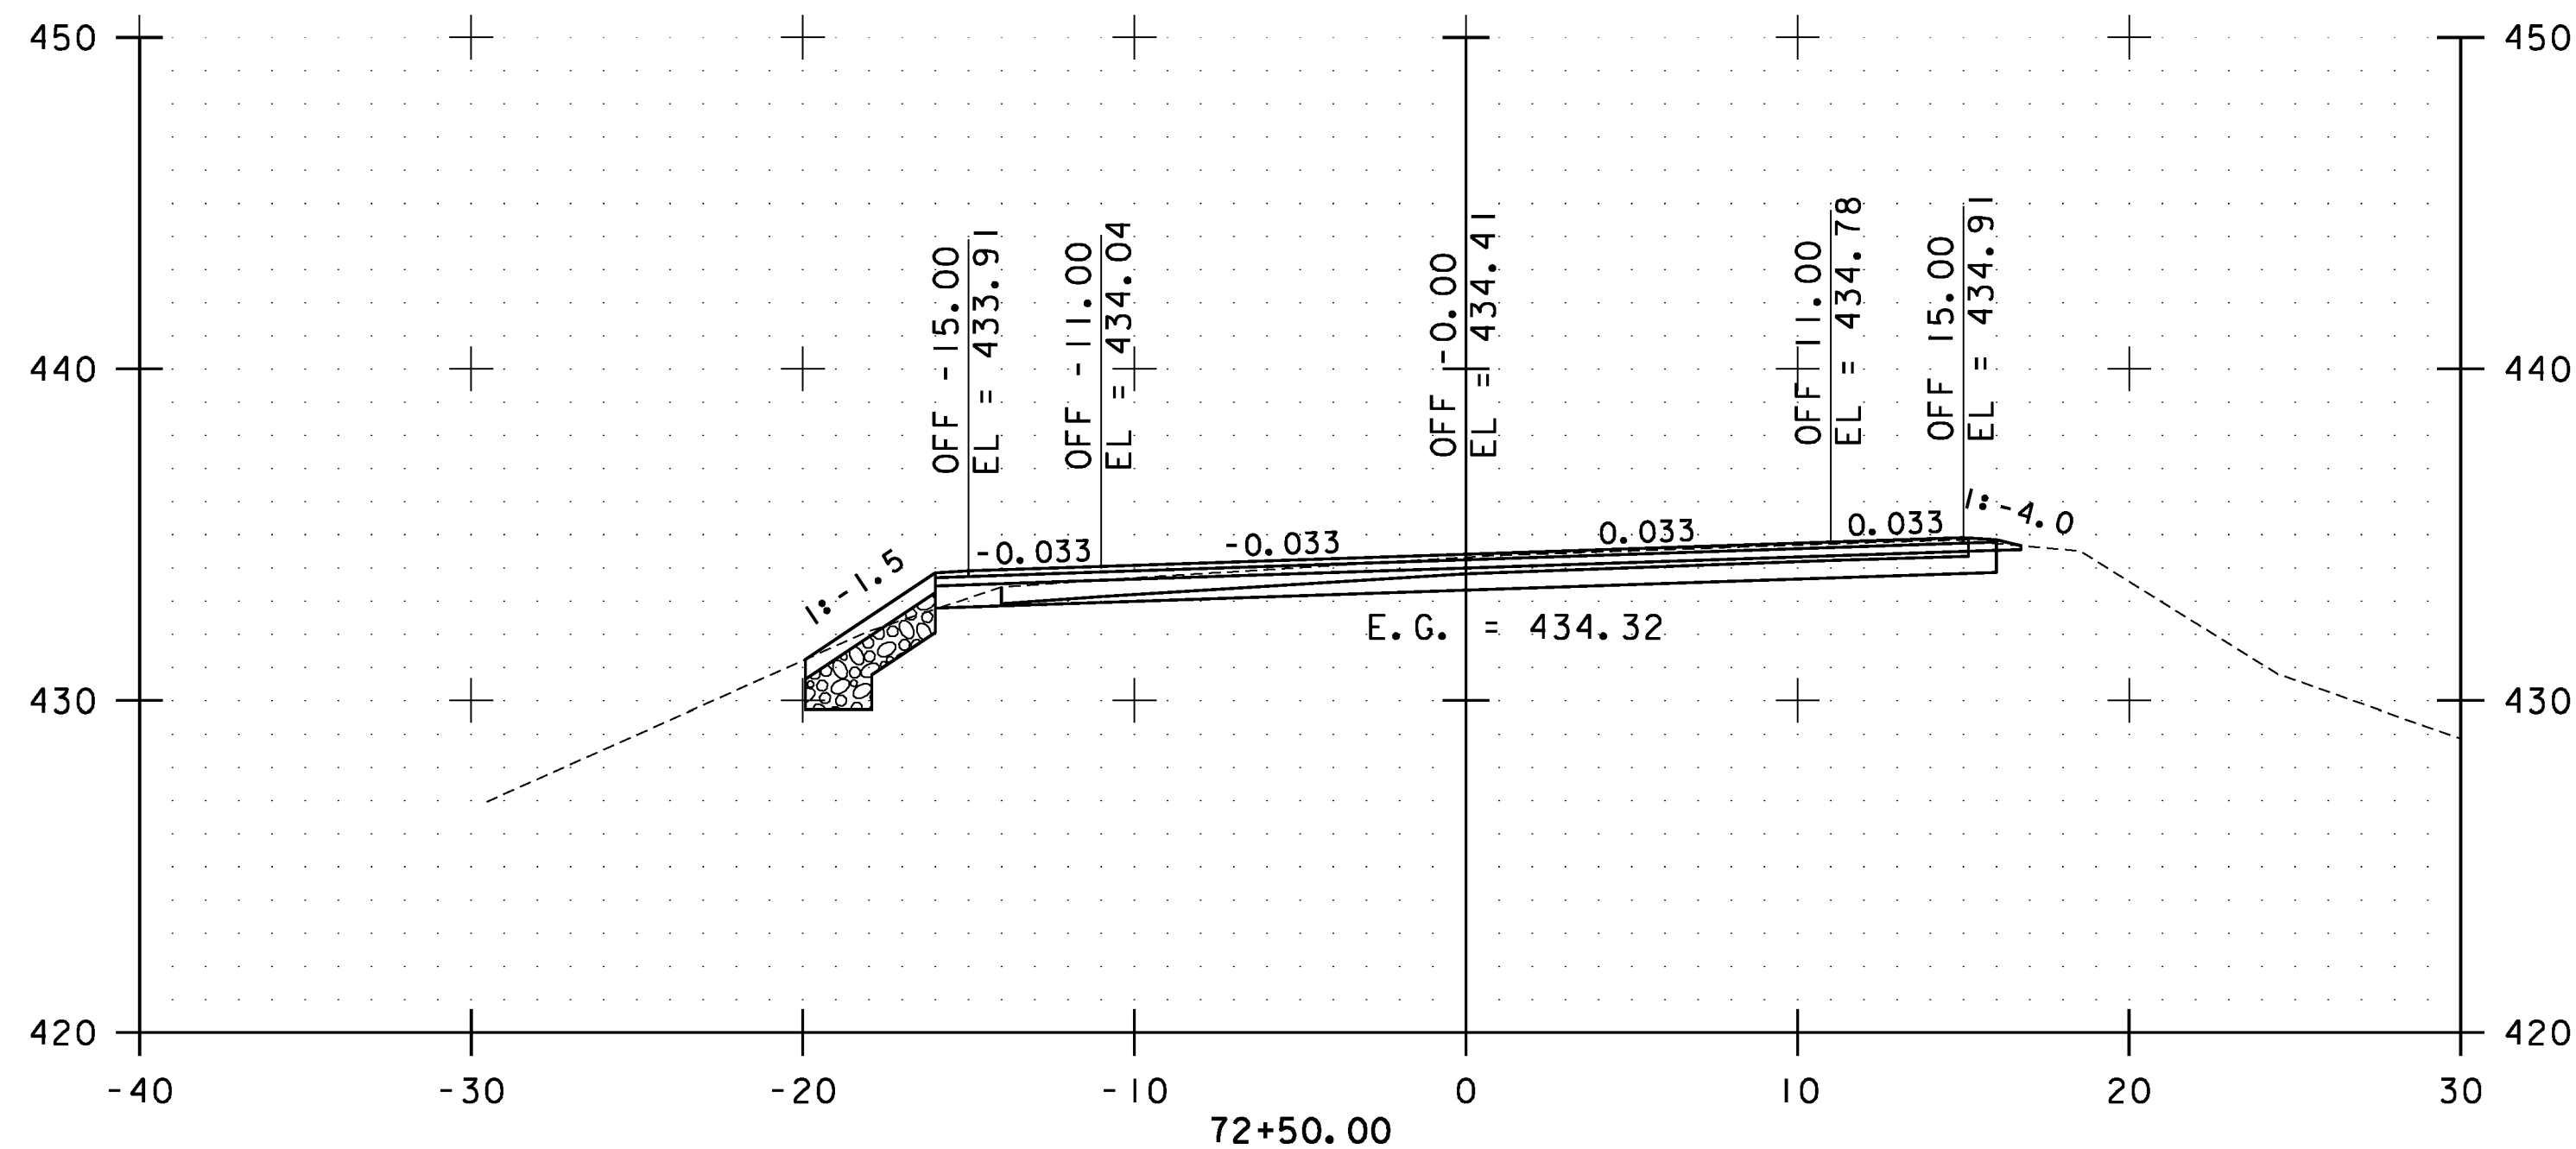
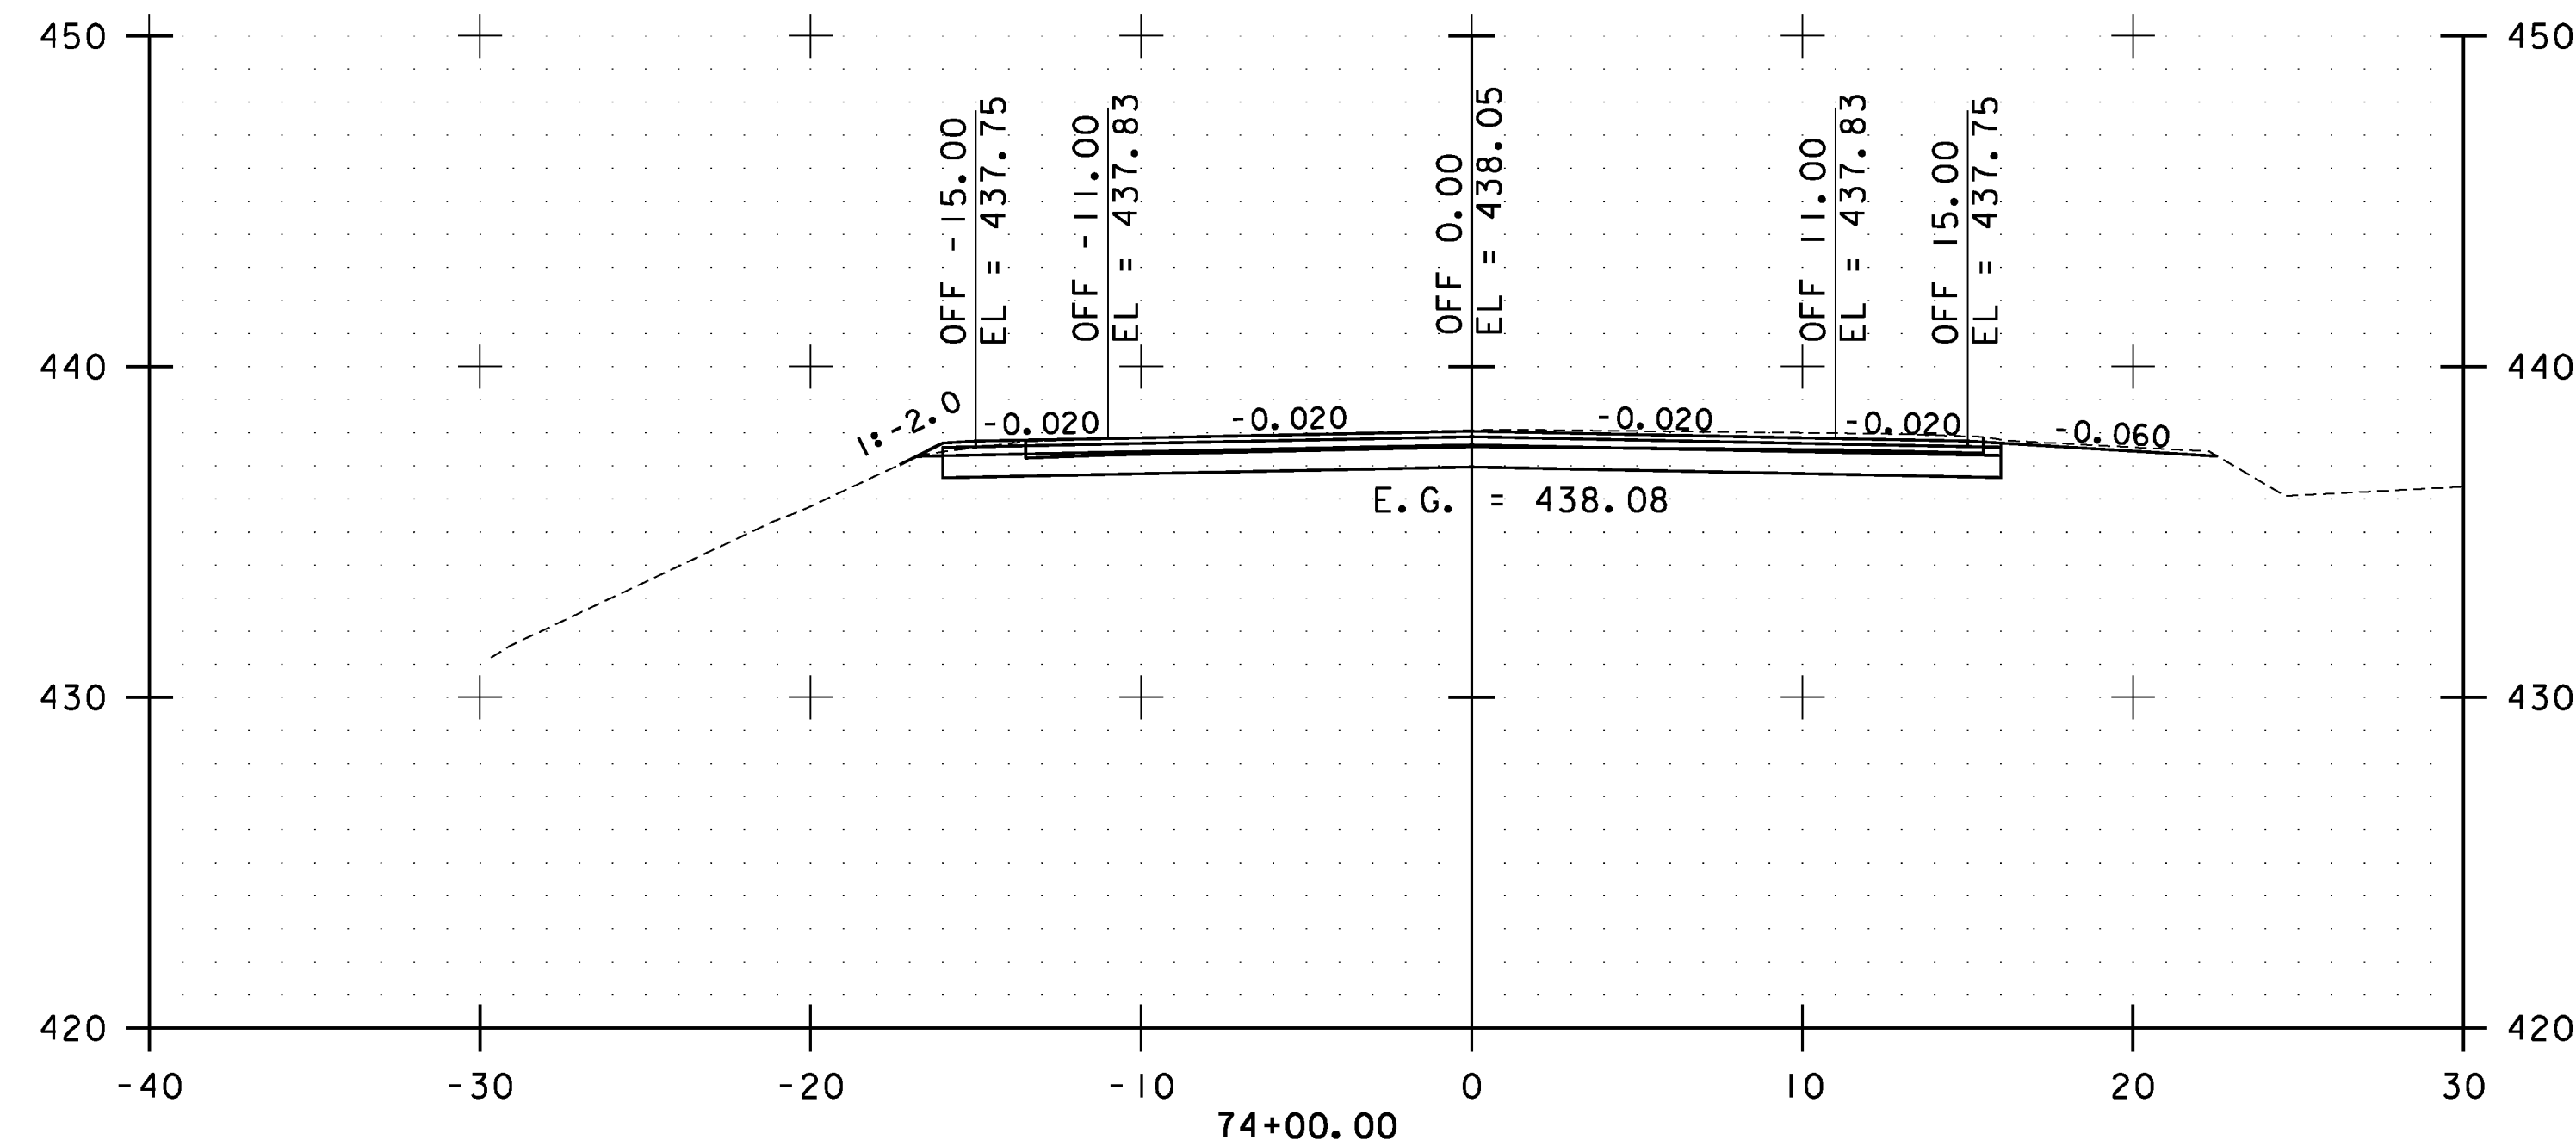


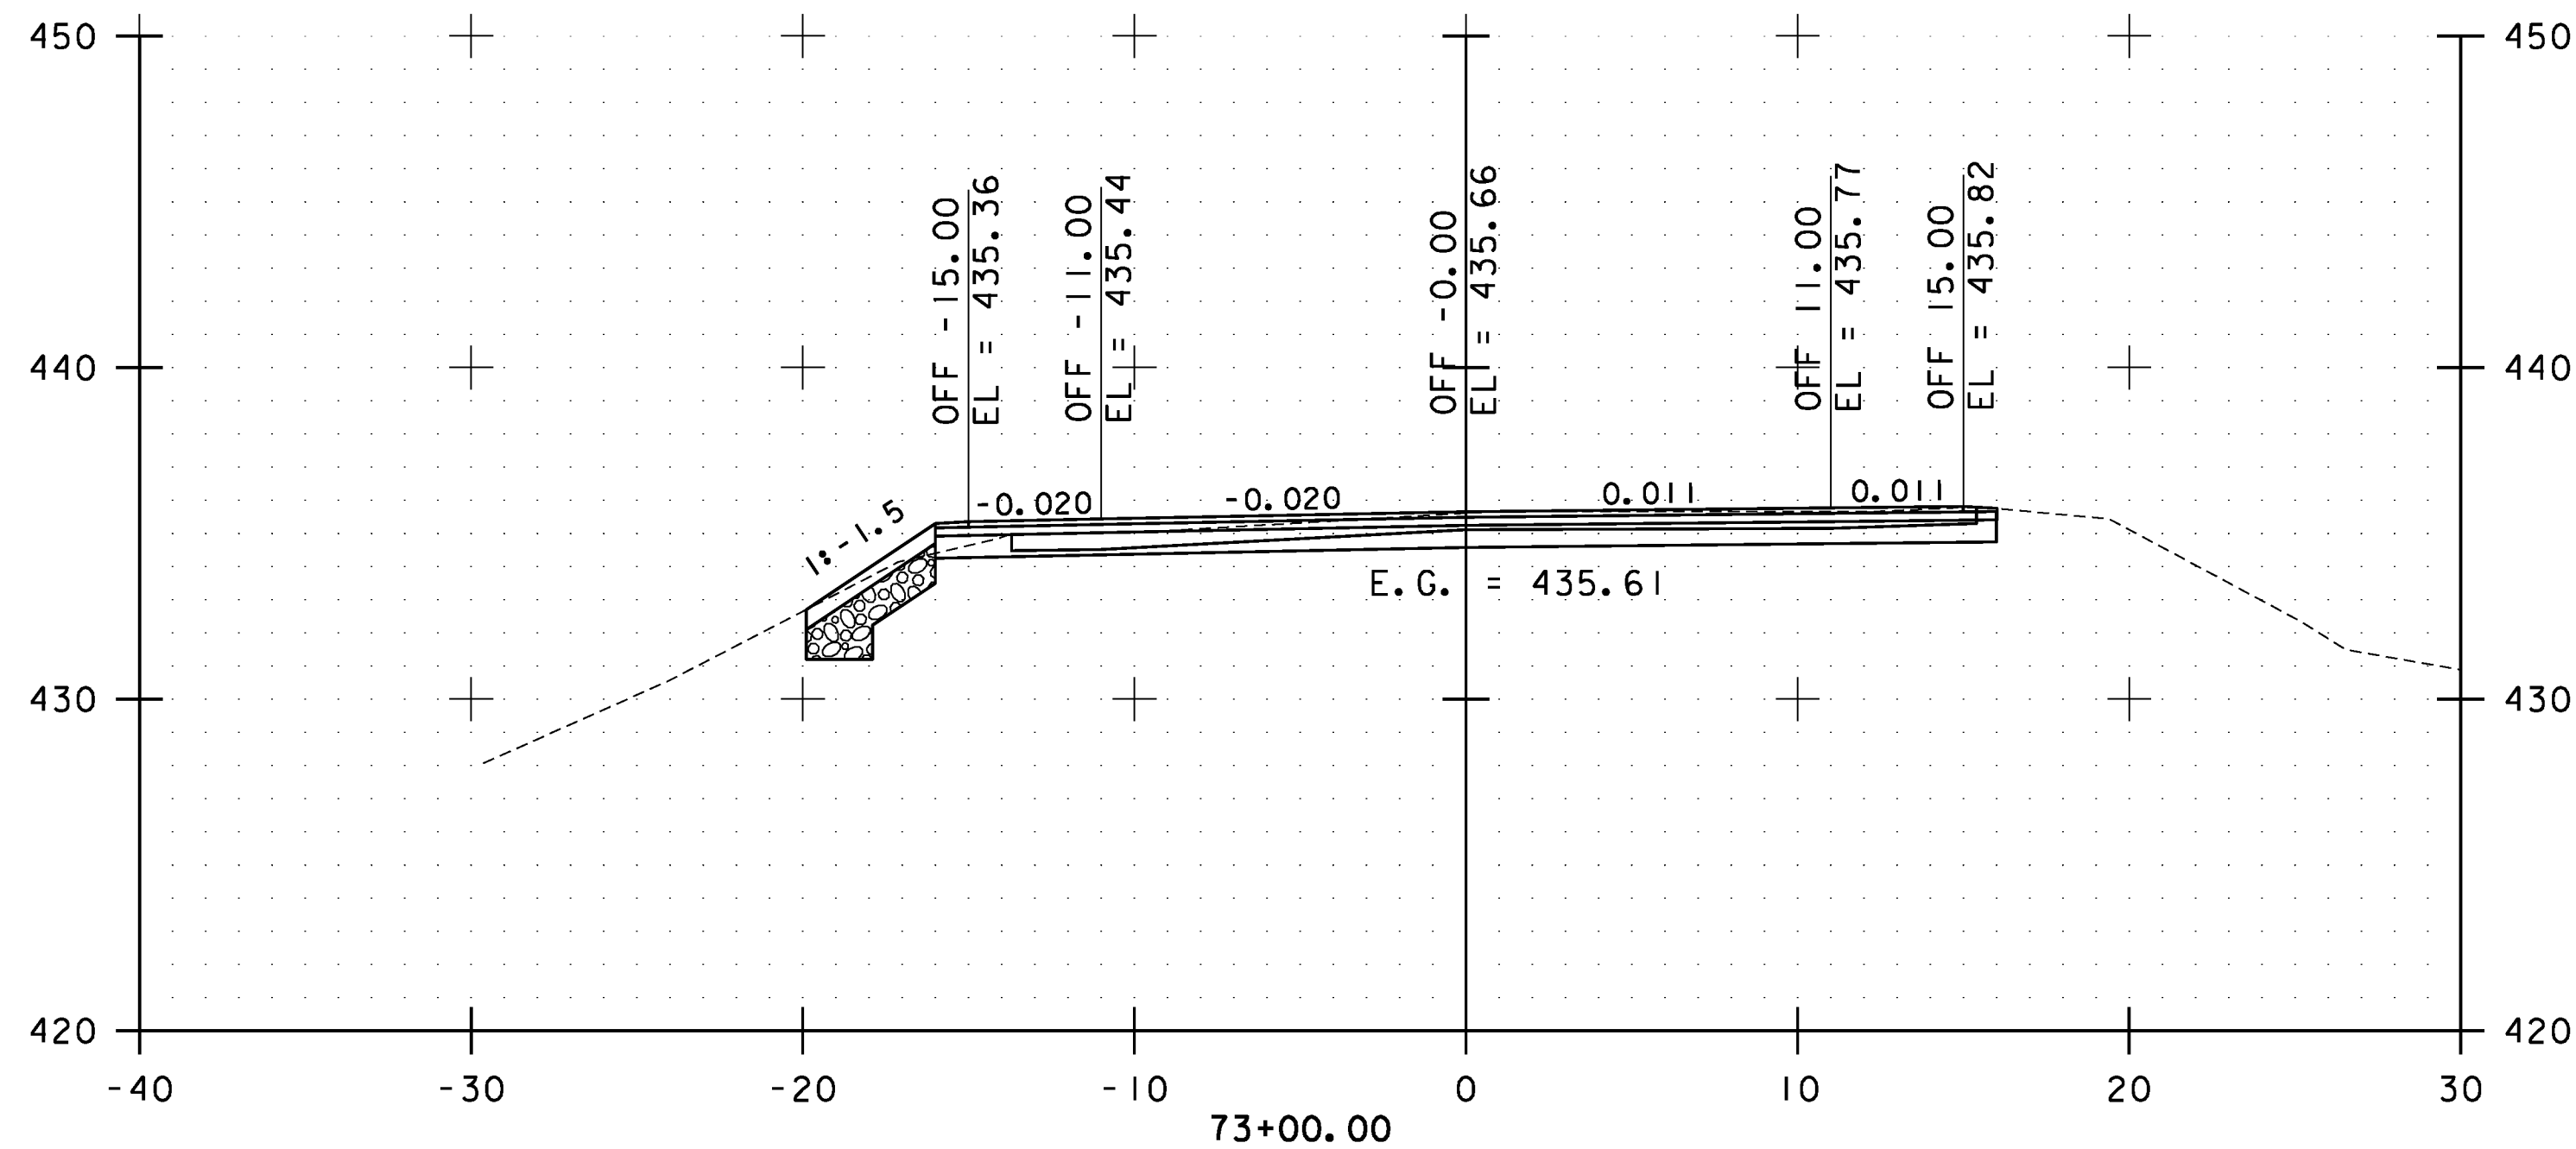

STA. 72+50.00 TO STA. 74+00.00

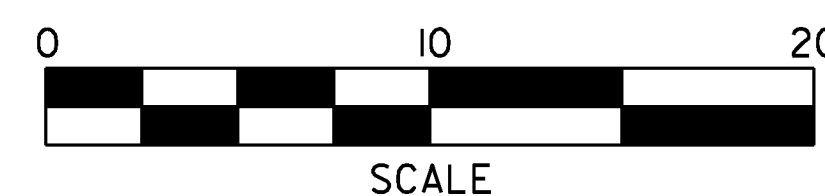

**FLETCHER  
CROSS  
SECTIONS  
SHEET #29**

|                 |                       |
|-----------------|-----------------------|
| PROJECT NAME:   | CAMBRIDGE-BAKERSFIELD |
| PROJECT NUMBER: | STP 2926(1)           |
| FILE NAME:      | p10b258.dgn           |
| PROJECT LEADER: | JLL                   |
| DESIGNED BY:    | STANTEC               |
| IPARM FILE:     | p10b258xs29.i         |
| PLOT DATE:      | 11/15/2012            |
| DRAWN BY:       | STANTEC               |
| CHECKED BY:     | STANTEC               |
| SHEET           | 251 OF 387            |