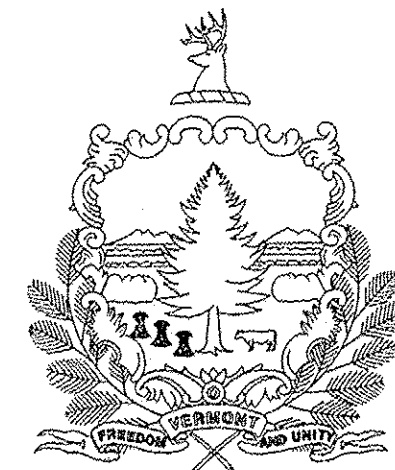


STATE OF VERMONT
AGENCY OF TRANSPORTATION

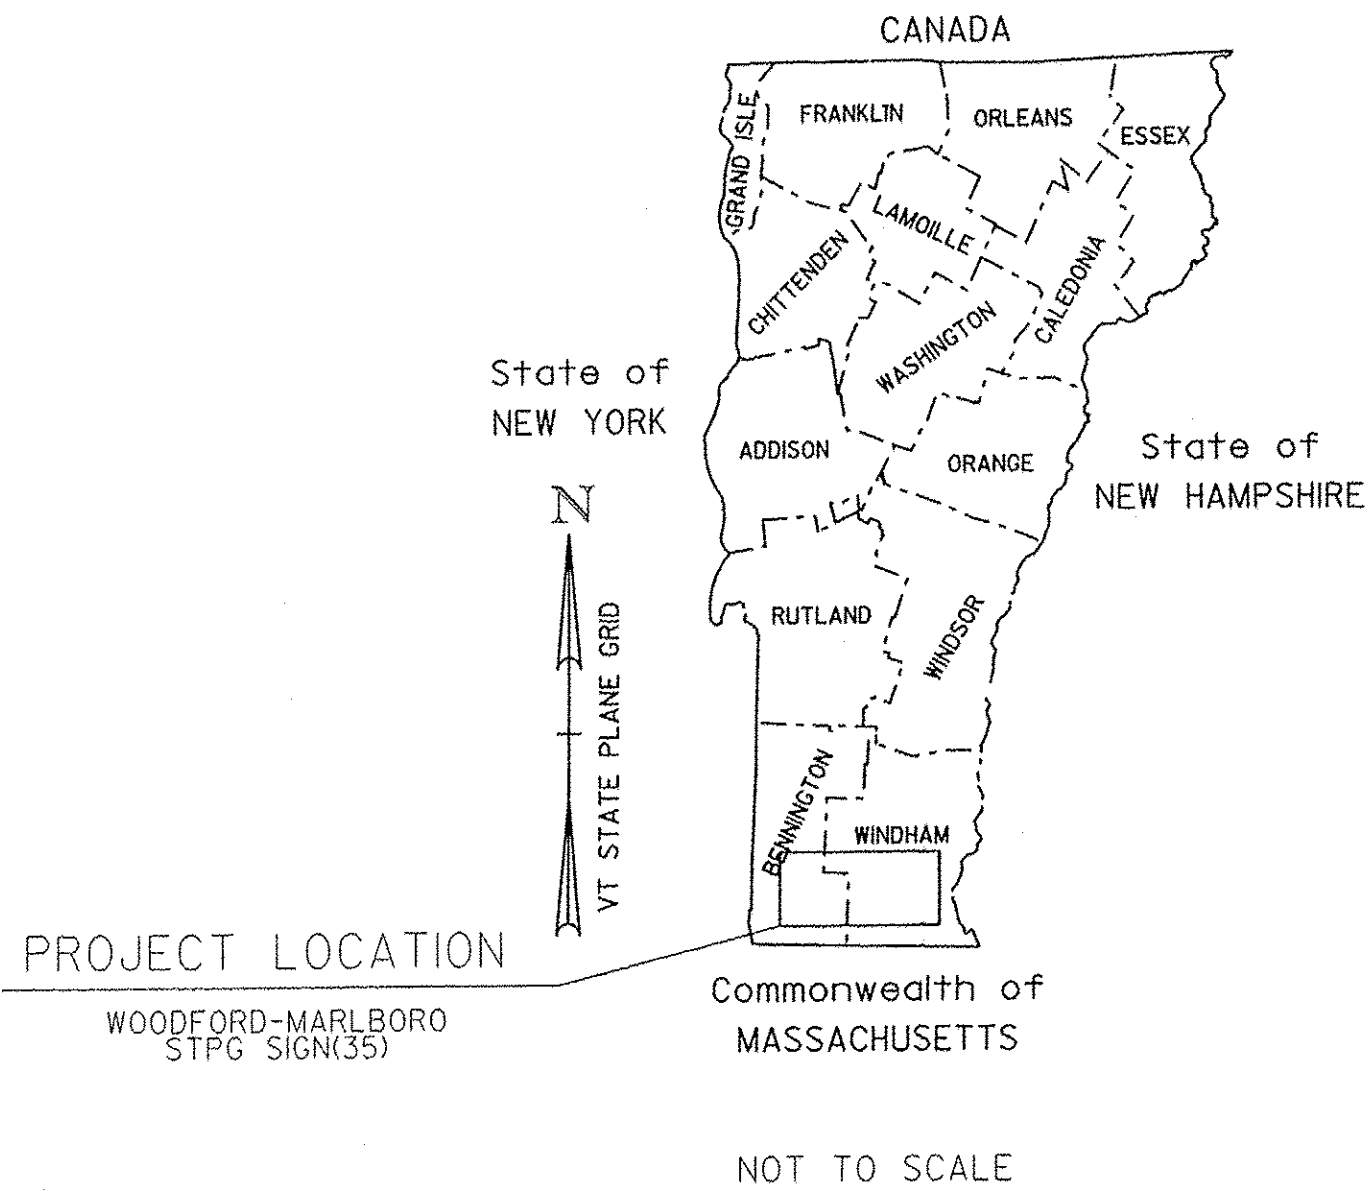


PROPOSED IMPROVEMENT
TOWNS OF WOODFORD, SEARSBURG,
WILMINGTON AND MARLBORO
COUNTIES OF BENNINGTON AND WINDHAM
VERMONT ROUTE 9 (PRINCIPAL ARTERIAL - NHS)

SOUTHERN REGION SIGN REPLACEMENT - 30.577 MILES:
WOODFORD MP 0.000-9.575, SEARSBURG MP 0.000-5.538,
WILMINGTON MP 0.000-7.160, MARLBORO MP 0.000-8.304

LENGTH OF ROADWAY = 30.577 MILES
LENGTH OF PROJECT = 30.577 MILES

WORK TO BE PERFORMED UNDER THIS PROJECT INCLUDES THE REMOVAL OF EXISTING SIGNS AND POSTS
AND THE INSTALLATION OF NEW SIGNS, SIGN POSTS AND OTHER RELATED HIGHWAY ITEMS.



RECORD PLANS

CONTRACTOR: EMI GUIDE RAUL, LLC - SCHENECTADY, NY

RESIDENT ENGINEER: FRED ROSS

CONSTRUCTION BEGAN: AUGUST 13, 2012

CONSTRUCTION COMPLETE: OCTOBER 12, 2012

RECORD PLANS BY: FRED ROSS & JENNA HYDE

I HEREBY CERTIFY THAT ALL THE CONSTRUCTION REQUIRED BY THIS SET OF DRAWINGS HAS BEEN ACCOMPLISHED AS INDICATED HEREIN.

BY *[Signature]* RESIDENT ENGINEER

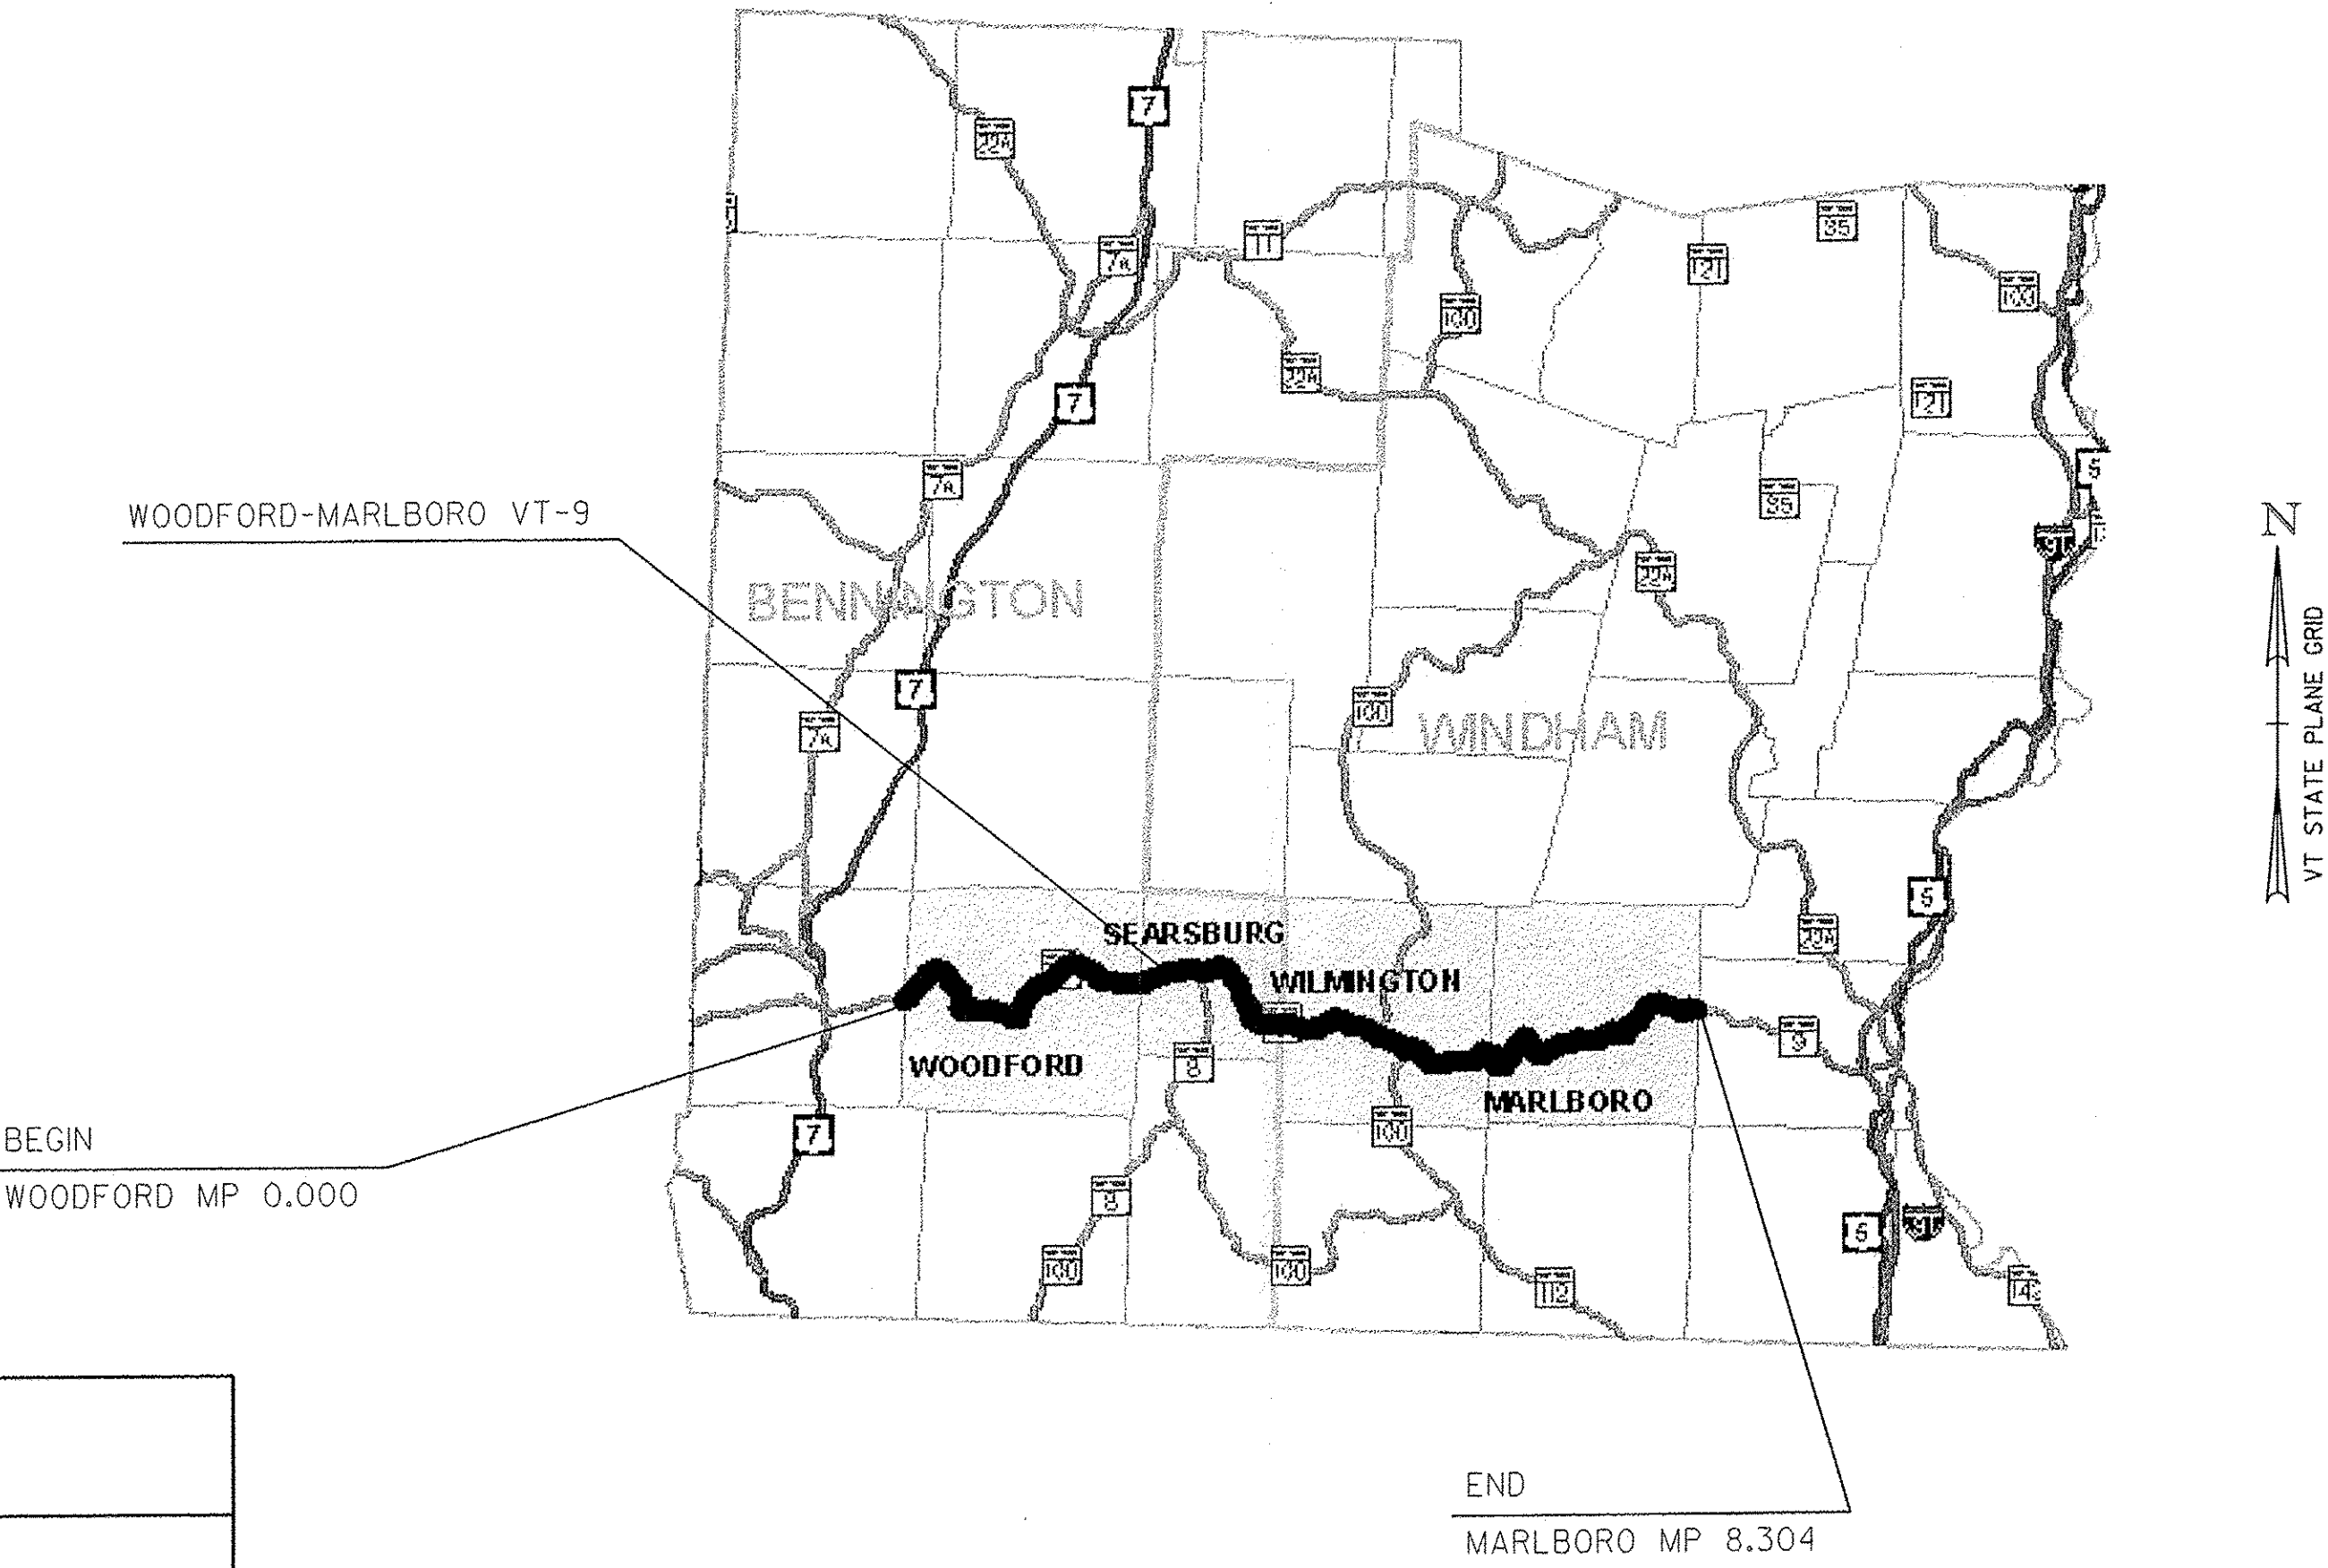
DATE 1-4-13

NOTE: Any further information concerning final quantities, amounts or other details relative to this project may be found at Central Files in the electronic archives.

QUALITY ASSURANCE PROGRAM: LEVEL 3

CONVENTIONAL SYMBOLS

COUNTY LINE	
TOWN LINE	
LIMITS OF ACCESS	
POINT OF ACCESS	
FENCE LINE	
STONE WALL	
TRAVELED WAY	
GUARD RAIL	
RAILROAD	
SURVEY LINE	
CULVERT	
POWER POLE	
TELEPHONE POLE	
TREES	
CONTROL OF ACCESS	
PROPERTY LINE	
R.O.W. TAKING LINE	
SLOPE RIGHTS	
TOP OF CUT	
TOE OF SLOPE	



SURVEYED BY : N/A

SURVEYED DATE : N/A

DATUM

VERTICAL N/A

HORIZONTAL N/A

THESE PLANS ARE SUBJECT TO SUCH ENGINEERING CHANGES AS MAY BE REQUIRED BY THE FEDERAL HIGHWAY ADMINISTRATION OR THE DIRECTOR OF PROGRAM DEVELOPMENT.

CONSTRUCTION IS TO BE CARRIED ON IN ACCORDANCE WITH THESE PLANS AND THE STANDARD SPECIFICATIONS FOR CONSTRUCTION DATED 2011, AS APPROVED BY THE FEDERAL HIGHWAY ADMINISTRATION ON JULY 20, 2011 FOR USE ON THIS PROJECT, INCLUDING ALL SUBSEQUENT REVISIONS AND SUCH REVISED SPECIFICATIONS AND SPECIAL PROVISIONS AS ARE INCORPORATED IN THESE PLANS.

DIRECTOR OF PROGRAM DEVELOPMENT

APPROVED *[Signature]* DATE 4/12/12

PROJECT MANAGER : AMY GAMBLE

PROJECT NAME : WOODFORD-MARLBORO

PROJECT NUMBER : STPG SIGN (35)

SHEET 1 OF 80 SHEETS

INDEX SHEETS

1	TITLE SHEET
2	GENERAL NOTES
3	QUANTITY SHEET I
4	TOWN/COUNTY LINE SIGN DETAILS
5-9	SIGN DETAILS I-5
10-20	WOODFORD EB VT-9 TRAFFIC SIGN SUMMARY SHEETS I-II
21-29	WOODFORD WB VT-9 TRAFFIC SIGN SUMMARY SHEETS I-9
30-36	SEARSBURG EB VT-9 TRAFFIC SIGN SUMMARY SHEETS I-7
37-41	SEARSBURG WB VT-9 TRAFFIC SIGN SUMMARY SHEETS I-5
42-43	WILMINGTON EB VT-9 TRAFFIC SIGN SUMMARY SHEETS I-2
44-45	WILMINGTON WB VT-9 TRAFFIC SIGN SUMMARY SHEETS I-2
46-63	MARLBORO EB VT-9 TRAFFIC SIGN SUMMARY SHEETS I-18
64-79	MARLBORO WB VT-9 TRAFFIC SIGN SUMMARY SHEETS I-16
80	TOWN TOTAL SIGN SUMMARY SHEET

STANDARDS

E-121	STANDARD SIGN PLACEMENT CONVENTIONAL ROAD	08/08/1995
E-136B	STATE ROUTE MARKER SIGN DETAILS	08/08/1995
E-138	MILE MARKER DETAILS STATE AND TOWN HIGHWAYS	05/30/2003
E-164	SQUARE STEEL SIGN POST	06/08/2009

2-1/2" SOIL BEARING SLIP BASE LOCATIONS:

TOWN:	DIRECTION:	MILE POINT:	NO. REQ:	SHEETS:
SEARSBURG	EB	1.743	2	31
SEARSBURG	EB	1.812	2	31
SEARSBURG	EB	1.918	2	32
SEARSBURG	WB	1.874	2	39
SEARSBURG	WB	1.837	2	39
MARLBORO	EB	0.477	2	47
MARLBORO	EB	7.636	2	61
MARLBORO	WB	7.945	2	64
MARLBORO	WB	0.716	2	78

1.

THE LOCATIONS SHOWN IN THE TABLE ABOVE WILL REQUIRE THAT EACH 2-1/2" SQUARE STEEL SIGN POST, AS SPECIFIED ON THE APPLICABLE SIGN SUMMARY SHEET, BE INSTALLED USING A SOIL BEARING SLIP BASE WITH ANCHOR SLEEVE. AT THESE SPECIFIED LOCATIONS THE 2-1/2" POSTS ARE NOT PROTECTED BY GUARD RAIL OR CURBING, THUS REQUIRING THE USE OF SOIL BEARING SLIP BASES FOR THIS SIZE POST.
- 2.)

PAYMENT FOR SOIL BEARING SLIP BASE (EACH) WILL BE MADE UNDER CONTRACT ITEM 900.620, SPECIAL PROVISION, SOIL BEARING SLIP BASE, 2-1/2".

GENERAL NOTES

SIGN DESIGN AND FABRICATION

1.

THE MUTCD SIGN CODES PROVIDED IN THESE PLANS REFER TO THE 2009 MUTCD. DESIGN DETAILS FOR SIGNS INDICATED ON THE PLANS AS FOUND IN THE STANDARD HIGHWAY SIGNS AND MARKINGS BOOK (SHSM), SHALL BE PER 2009 SHSM, WHICH AT THIS TIME HAS NOT YET BEEN RELEASED. TO ADVANCE THE AVAILABILITY OF NEW INFORMATION FOR FIELD INSTALLATIONS AS SOON AS POSSIBLE, INTERIM RELEASES ARE PLANNED FOR ITEMS THAT ARE NEW OR SIGNIFICANTLY REVISED BY THE 2009 MUTCD; THEY CAN BE FOUND AT: http://mutcd.fhwa.dot.gov/shsm_interim/index.htm. THE CONTRACTOR SHALL CONTACT THE ENGINEER FOR SIGN DETAILS IF NONE ARE AVAILABLE FROM THESE SOURCES.
2.

SIGN SHEETING FOR FLUORESCENT YELLOW (FY) AND FLUORESCENT YELLOW-GREEN (FYG) SHALL BE ASTM D4956 TYPE VII, VIII OR IX. ALL OTHER SIGN SHEETING SHALL BE TYPE III OR IV.
3.

SHEETING TYPES AND SHEETING FABRICATED BY DIFFERENT MANUFACTURERS SHALL NOT BE MIXED ON A SINGLE SIGN ASSEMBLY. SHEETING COLOR/TYPE SHOULD BE BY THE SAME MANUFACTURER AND SHOULD BE CONSISTENT THROUGHOUT THE PROJECT.
4.

SIGN BASE MATERIAL FOR DELINEATORS AND MILE MARKER PLAQUES (VD-700) SHALL BE 0.063" THICK FLAT SHEET ALUMINUM. UNLESS OTHERWISE NOTED ON THE PLANS, ALL OTHER SIGNS SHALL BE FLAT SHEET ALUMINUM WITH THE FOLLOWING MINIMUM THICKNESSES:

SIGN SIZE	9" X 12"		
	12" X 12"		
	18" X 18"		
	21" X 15"		
	24" X 10"		48" X 18"
	24" X 12"	36" X 12"	48" X 24"
	24" X 18"	36" X 15"	48" X 30"
	24" X 24"	36" X 18"	48" X 42"
	24" X 30"	36" X 24"	48" X 48"
	30" X 15"	30" X 42"	48" X 60"
	30" X 18"	36" X 36"	72" X 10"
	30" X 30"	36" X 48"	72" X 12"
	30" X 42"	36" X 54"	72" X 20"
THICKNESS	0.080"	0.100"	0.125"

SIGN POSTS

1.

ALL SQUARE STEEL SIGN POSTS SHALL BE INSTALLED IN A NEW ANCHOR. ALL SIGNS INSTALLED IN PAVED OR CONCRETE ISLANDS OR SIDEWALKS SHALL ALSO BE INSTALLED WITH AN 18" SLEEVE. PAYMENT FOR SLEEVE SHALL BE INCIDENTAL TO THE SIGN POST CONTRACT ITEM.
2.

1.75" SQUARE STEEL POSTS SHALL BE 14 GAUGE STEEL. 2" AND 2.5" SQUARE STEEL POSTS SHALL BE 12 GAUGE STEEL.

SIGN INSTALLATION

1.

THE CONTRACTOR SHALL BE RESPONSIBLE FOR REPAIRING ANY DAMAGE TO PRIVATE OR PUBLIC PROPERTY CAUSED BY THE CONTRACTOR, AT CONTRACTOR'S EXPENSE.
2.

SIGN LOCATIONS AS SHOWN ON THE PLANS ARE APPROXIMATE. EXACT LOCATIONS TO BE DETERMINED IN THE FIELD AND APPROVED BY THE ENGINEER.
3.

ALL SIGN PLACEMENT SHALL BE IN CONFORMANCE WITH VAOT STANDARD E-121 STANDARD SIGN PLACEMENT CONVENTIONAL ROAD, UNLESS OTHERWISE NOTED.
4.

ALL SIGNS, FRAMES, MOUNTING HARDWARE, POSTS, AND ANCHORS FOR ANY SIGN ASSEMBLY SHALL BE REPLACED AT THE SAME TIME. MIXING OF OLD AND NEW SIGNS ON THE SAME ASSEMBLY WILL NOT BE ALLOWED. ALL NEW OR SALVAGED SIGNS SHALL BE INSTALLED WITH NEW ASSEMBLY HARDWARE MEETING SUBSECTION 750.12 ASSEMBLY HARDWARE.
5.

NEW SIGNS WITH THEIR GREATER NIGHTTIME RETROREFLECTIVITY CAN OBSCURE OLDER SIGNS MOUNTED IN CLOSE PROXIMITY TO THEM. TO AVOID CONFUSION OF ROAD USERS, WORK SHALL BE COORDINATED SUCH THAT ALL SIGNS ASSOCIATED WITH A CURVE, INTERSECTION, OR SPEED CHANGES, SHALL BE REPLACED ON THE SAME DAY AND NOT LEFT INCOMPLETE NOR WITH A MIXTURE OF OLD AND NEW SIGNS WITHIN A GROUP OF ASSOCIATED SIGNS. AT NO TIME SHALL A SIGN ASSEMBLY BE REMOVED WITHOUT IMMEDIATELY INSTALLING THE REPLACEMENT SIGN ASSEMBLY UNLESS OTHERWISE SHOWN ON THE PLANS.
6.

ALL NEW SIGN INSTALLATIONS SHALL BE NO CLOSER THAN 10 FEET FROM UTILITY POLES.

TEMPORARY TRAFFIC CONTROL NOTES

1.

THE CONTRACTOR SHALL SUBMIT SITE SPECIFIC TRAFFIC CONTROL PLANS CONFORMING TO THE MANUAL ON UNIFORM TRAFFIC CONTROL DEVICES (MUTCD), DATED 2009, AND ITS LATEST REVISIONS, AT THE PRE-CONSTRUCTION MEETING FOR REVIEW AND APPROVAL BY THE ENGINEER.
2.

WHEN WORKING IN THE VICINITY OF EXISTING PEDESTRIAN FACILITIES, ADA ACCESSIBLE PEDESTRIAN ACCOMMODATIONS SHALL BE MAINTAINED AT ALL TIMES. PAYMENT SHALL BE INCLUDED IN THE UNIT BID PRICE FOR CONTRACT ITEM 641.10 TRAFFIC CONTROL.
3.

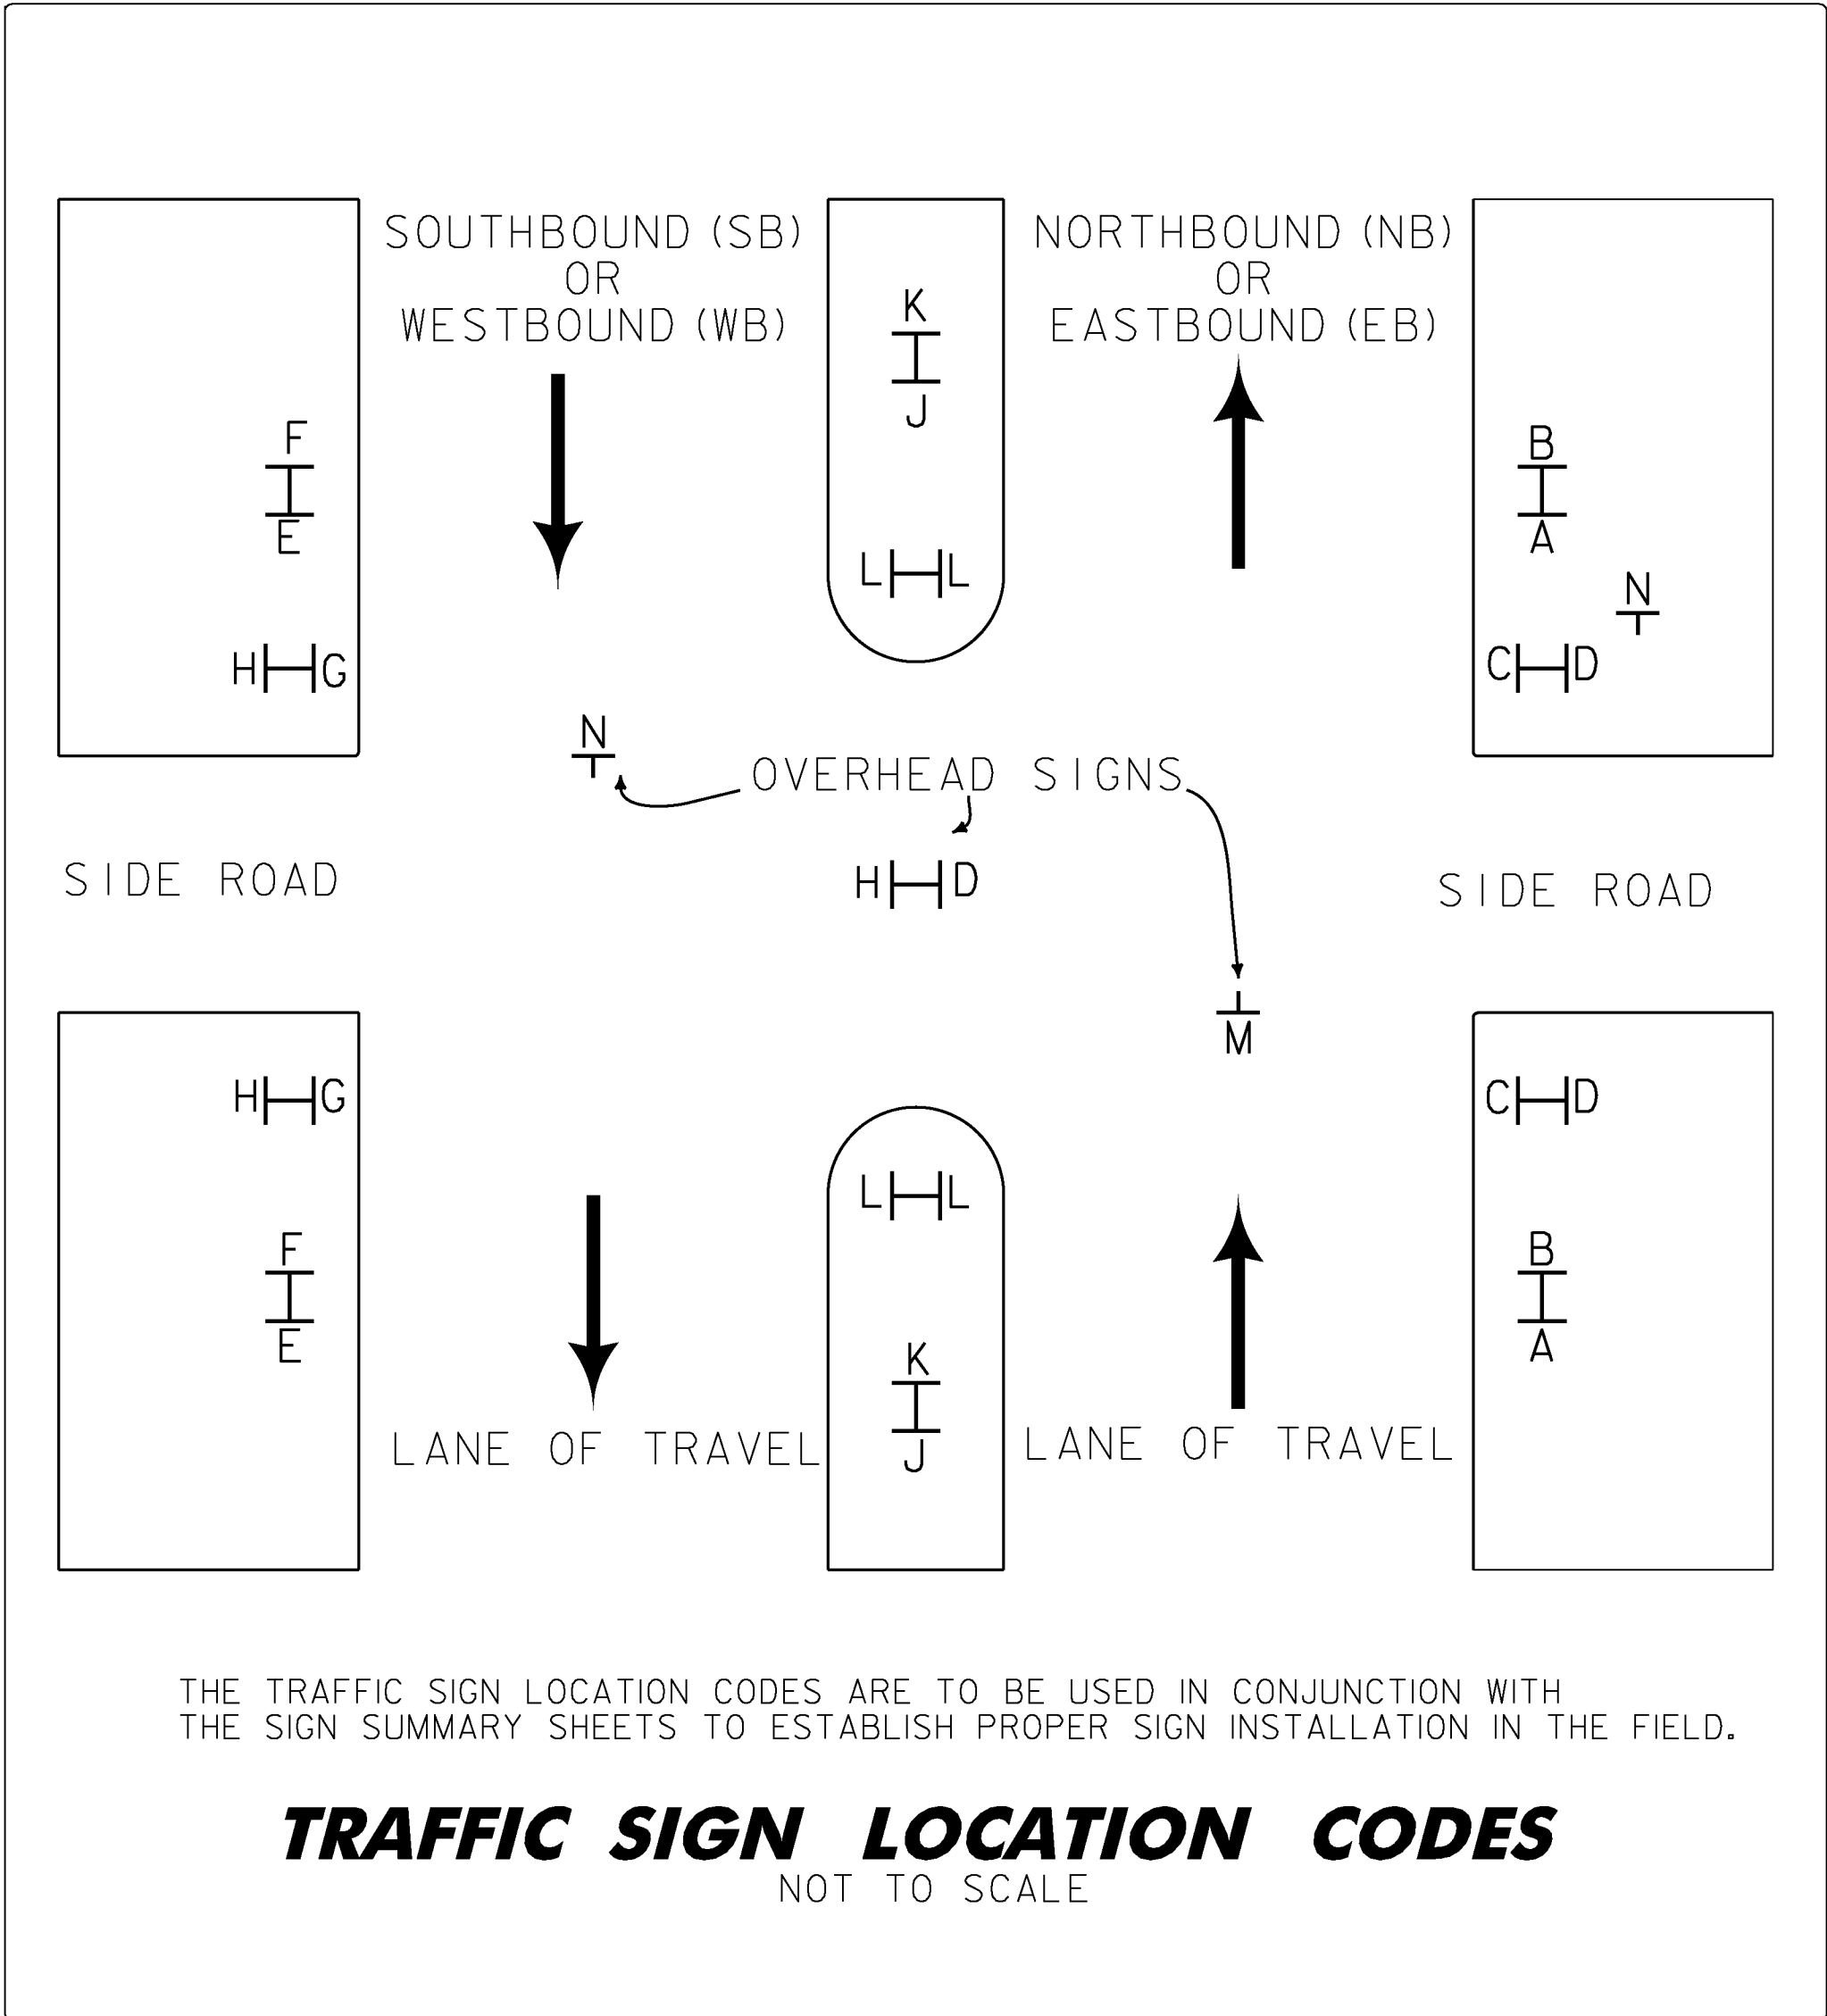
THE CONTRACTOR SHALL PROVIDE ACCESS THROUGH THE WORK ZONE FOR EMERGENCY VEHICLES AT ALL TIMES.
4.

THE CONTRACTOR SHALL CONDUCT THE WORK AT ALL TIMES IN SUCH A MANNER AND IN SUCH SEQUENCE SO AS TO ENSURE THE LEAST INTERFERENCE WITH TRAFFIC OCCURS.
5.

SIGNS SHALL ONLY BE VISIBLE TO MOTORISTS AT THE TIMES WHEN THE MESSAGE IS PERTINENT. I.E. A "FLAGGER AHEAD" SIGN SHALL ONLY BE VISIBLE TO MOTORISTS WHEN THE FLAGGER IS ACTUALLY PRESENT PERFORMING THEIR DUTIES.
6.

PAYMENT FOR CONSTRUCTION SIGNING WILL BE MADE UNDER CONTRACT ITEM 641.10.
7.

SIGNS SHALL BE MOVED AS WORK AREA MOVES. AT NO TIME SHALL THE FLAGGER SIGN BE GREATER THAN 750 FEET IN ADVANCE OF THE FLAGGER STATION.



GENERAL NOTES

1.

EXISTING STAND ALONE MILE MARKERS OR MILE MARKERS ATTACHED TO A RETAINED SIGN POST ASSEMBLY SHALL BE RETAINED.
2.

EXISTING MILE MARKERS ON SIGN POSTS BEING REPLACED SHALL BE REMOVED AND SALVAGED ONTO THE NEW SIGN POST.
3.

EXISTING MILE MARKERS ATTACHED TO A SIGN ASSEMBLY THAT IS TO BE RELOCATED SHALL BE REMOVED, SALVAGED AND REINSTALLED ONTO A NEW DELINEATOR POST (1.75" SQUARE STEEL) UNLESS OTHERWISE DIRECTED BY THE ENGINEER.
4.

EXISTING STREET NAME SIGNS ATTACHED TO SIGN POSTS THAT ARE TO BE REPLACED SHALL BE REMOVED, SALVAGED AND INSTALLED AT THE TOP OF THE NEW POST.
5.

ALL EXISTING STREET NAME SIGNS INSTALLED ON STAND ALONE SIGN POSTS SHALL BE RETAINED UNLESS OTHERWISE NOTED.
6.

AN ESTIMATED QUANTITY FOR CONTRACT ITEMS 675.50 REMOVING SIGNS AND 675.60 ERECTING SALVAGED SIGNS HAS BEEN INCLUDED FOR MILE MARKERS AND STREET NAME SIGNS.
7.

SELECTIVE CUTTING OF BRUSH OR TREE BRANCHES IN THE IMMEDIATE VICINITY OF THE SIGN MAY BE NECESSARY TO PROVIDE FULL VISIBILITY FOR ANY EXISTING (RETAINED) OR NEW SIGN LOCATIONS. SIGNS SHALL BE COMPLETELY VISIBLE FOR 200 FEET BY APPROACHING MOTORISTS. THIS WORK WILL BE PERFORMED AT THE DIRECTION OF THE ENGINEER AND PAID FOR UNDER CONTRACT ITEM 201.31 THINNING AND TRIMMING FOR SIGNS. THIS WORK SHALL BE DONE AT THE SAME TIME THAT THE SIGNS ARE INSTALLED.

PROJECT NAME: WOODFORD - MARLBORO

PROJECT NUMBER: STPG SIGN (35)

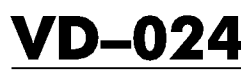
FILE NAME: 10B336_TS.DGN
PROJECT LEADER: A. GAMBLE
DESIGNED BY: J. KELLY
GENERAL NOTES

PLOT DATE: 10-APR-2012
DRAWN BY: J. KELLY
CHECKED BY: A. GAMBLE
SHEET 2 OF 80

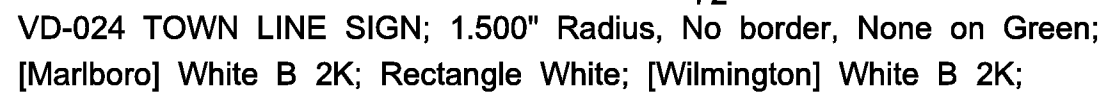
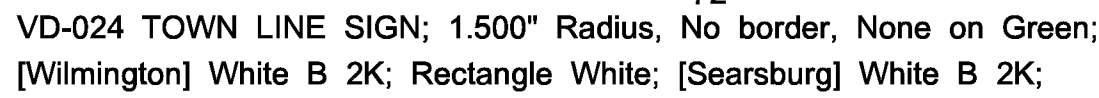
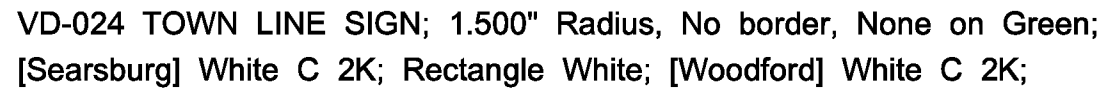
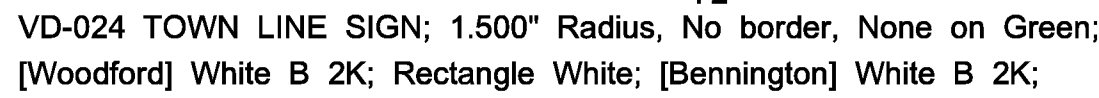
**STATE OF VERMONT
AGENCY OF TRANSPORTATION**

QUANTITY SHEET 1

[illegible]

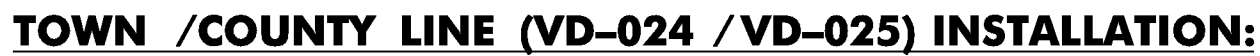


1. THE SIGN BASE MATERIAL SHALL BE SHEET ALUMINUM WITH A 0.125" MINIMUM THICKNESS.
2. THE RETROREFLECTIVE MATERIAL SHALL BE SHEETING APPLIED TO THE ENTIRE BACKGROUND OF THE SIGN. THE LEGEND SHALL BE CUT-OUT RETROREFLECTIVE LEGEND. ALL RETROREFLECTIVE MATERIAL SHALL BE EQUAL TO OR EXCEEDING THE "THE AMERICAN SOCIETY OF TESTING AND MATERIALS" (ASTM) TYPE III.
3. SIGNS SHALL HAVE A WHITE LEGEND ON A GREEN BACKGROUND.
4. LEGEND SHALL CONFORM WITH THE STANDARD ALPHABETS FOR HIGHWAY SIGNS APPROVED BY THE NATIONAL COMMITTEE ON UNIFORM TRAFFIC CONTROL DEVICES.
5. SIGNS SHALL BE FABRICATED IN UPPER/LOWER CASE TEXT AS SHOWN IN SIGN DETAIL. ALL TEXT ON AN INDIVIDUAL SIGN SHALL BE OF THE SAME SIZE AND FONT.
6. ALL DIMENSIONS IN INCHES UNLESS OTHERWISE NOTED.
7. WORD TO WORD SPACING FOR MULTIPLE TEXT TOWN/COUNTY NAMES IS ADJUSTABLE TO ACCOMMODATE DIMENSION REQUIREMENT.
8. DIMENSIONS SHOWN ARE APPROXIMATE AND MAY BE ADJUSTED SLIGHTLY TO ACCOMMODATE VARIOUS MANUFACTURER'S LETTER WIDTHS.



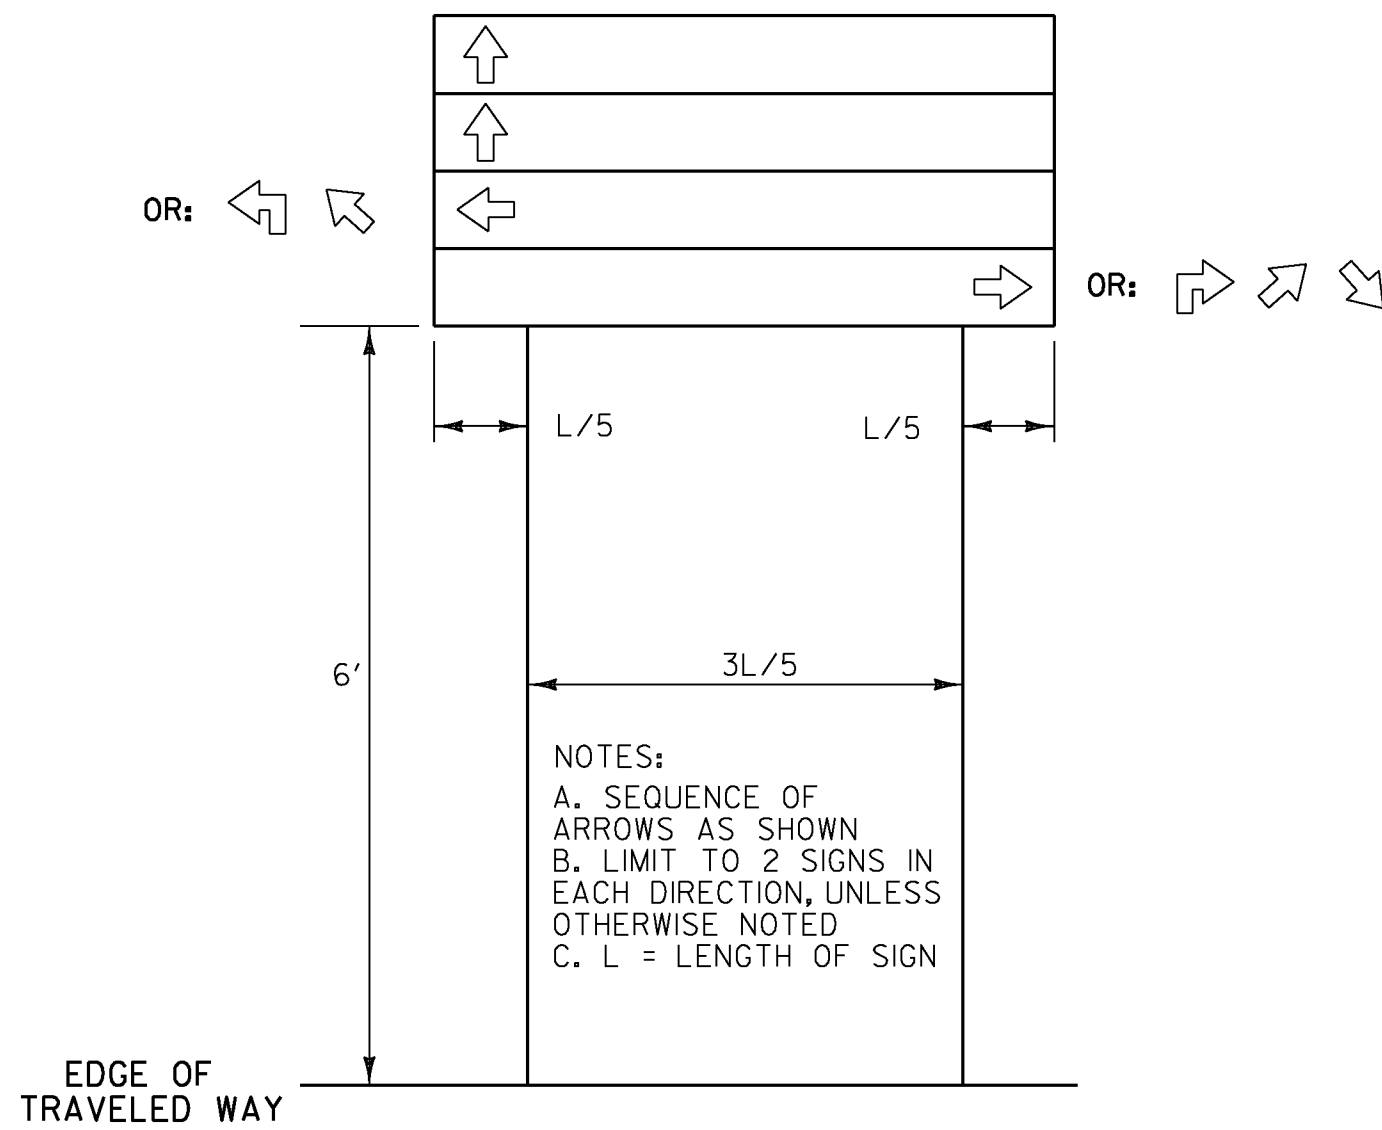
VD-025 COUNTY LINE SIGN; 1.500" Radius, No border, None on Green;
[Windham Co] White B 2K; Rectangle White; [Bennington Co] White B 2K;

WHEN CROSSING COUNTY BOUNDARIES, AN ADDITIONAL COUNTY LINE SIGN (VD-025) SHALL BE MOUNTED BELOW THE TOWN LINE SIGN (VD-024), MAINTAINING A SEVEN FOOT CLEARANCE.



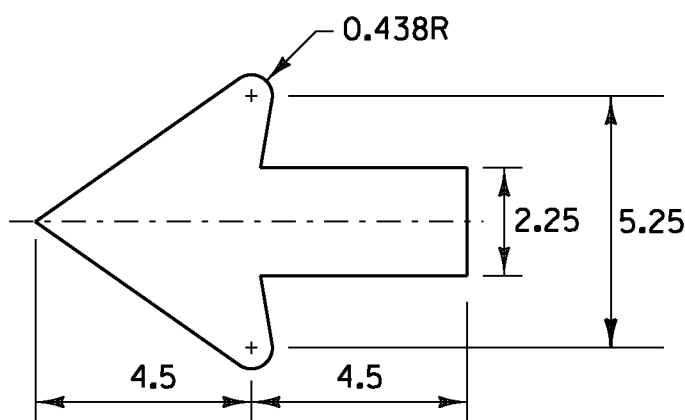
- NOT TO SCALE

PROJECT NAME: WOODFORD - MARLBORO	
PROJECT NUMBER: STPG SIGN (35)	
FILE NAME: IOB336_TS.DGN	PLOT DATE: 10-APR-2012
PROJECT LEADER: A. GAMBLE	DRAWN BY: J. KELLY
DESIGNED BY: J. KELLY	CHECKED BY: A. GAMBLE
TOWN/COUNTY LINE SIGN DETAILS	SHEET 4 OF 80

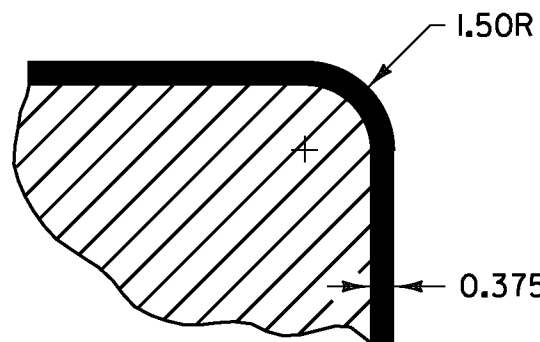


DESTINATION SIGN (VD1-1, VD1-1A, VD1-2, VD2-1) ASSEMBLY:

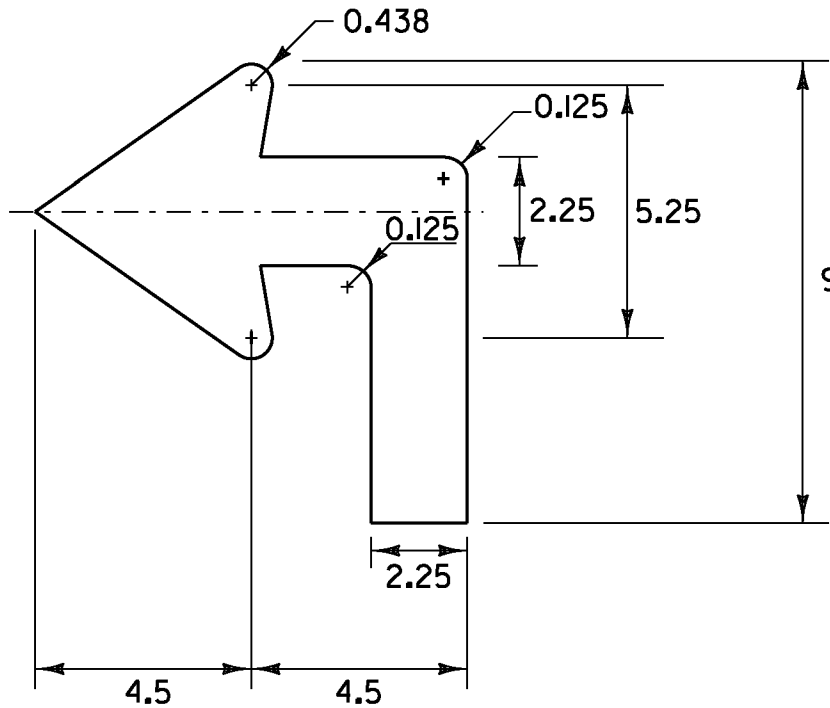
1. THE DESTINATION SIGN DETAILS SHOWN ON SHEETS 6 AND 7 SHALL HAVE WHITE RETROREFLECTIVE ASTM TYPE III OR IV TEXT, ARROWS AND BORDERS ON A GREEN RETROREFLECTIVE ASTM TYPE III OR IV BACKGROUND.
2. FONT SPACING SHOWN ON AN INDIVIDUAL SIGN DETAIL MAY BE ADJUSTED SLIGHTLY TO MEET DIMENSION REQUIREMENT(S).
3. DIMENSIONS SHOWN ON THE INDIVIDUAL SIGN DETAILS MAY BE ADJUSTED SLIGHTLY TO ACCOMMODATE VARIOUS MANUFACTURER'S LETTER WIDTHS.



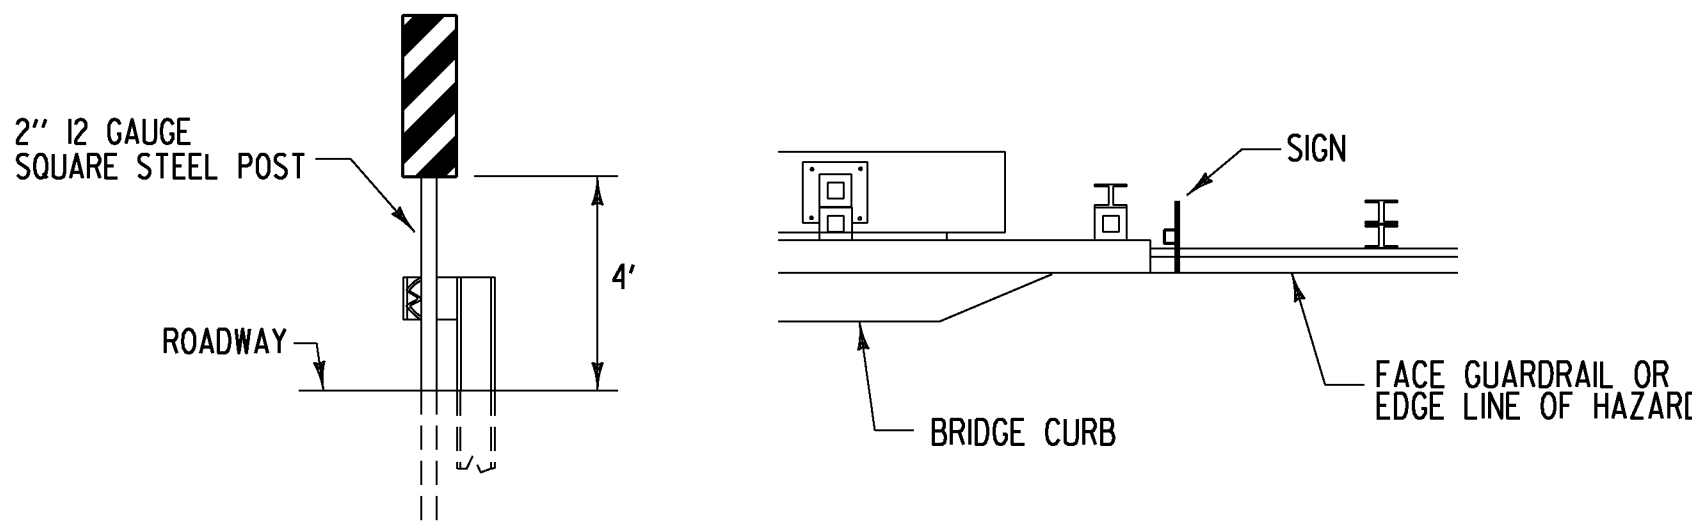
STANDARD SHS 2.25" ARROW



BORDER DETAIL



ADVANCE 2.25" ARROW

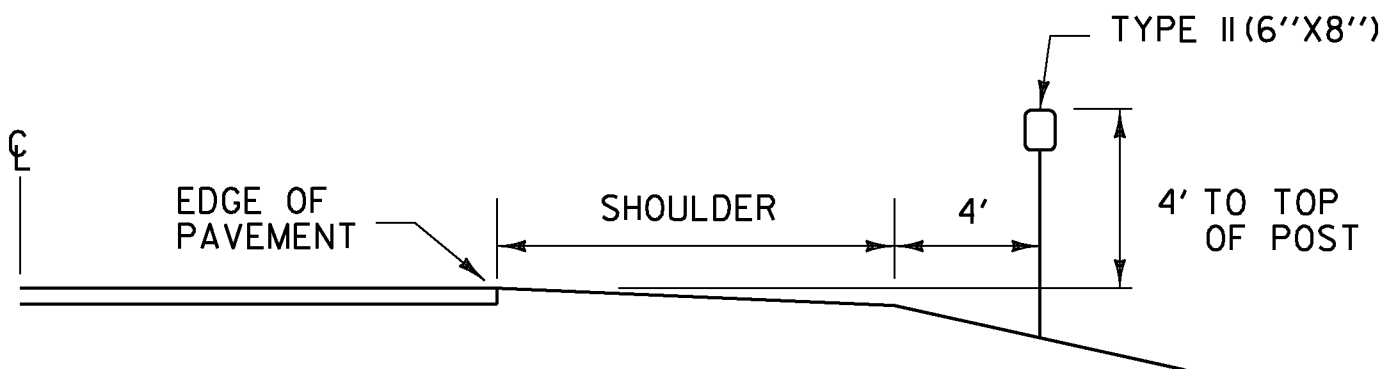


ELEVATION

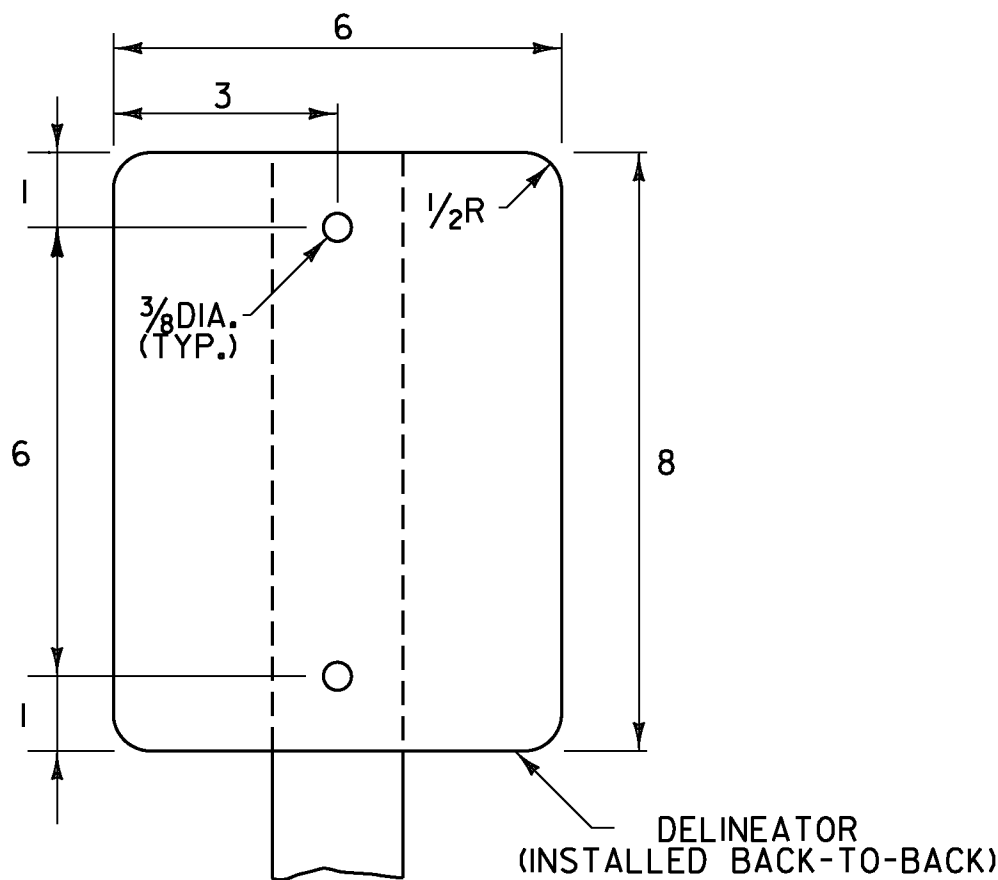
PLAN VIEW

OBJECT MARKER (OM3-L or OM3-R) INSTALLATION:

1. OBJECT MARKER SHOULD BE INSTALLED SO THAT THE INSIDE EDGE OF THE SIGN IS AS CLOSE AS POSSIBLE TO THE FACE OF GUARDRAIL OR INSIDE EDGE OF THE HAZARD.
2. THE SIGN SHALL BE MOUNTED SO THE DIAGONAL STRIPES SLOPE DOWNWARDS TOWARD THE ROAD CENTERLINE.
3. ASSEMBLY HARDWARE SHALL CONFORM TO SUBSECTION 750.12 (a). RIVETS SHALL NOT BE USED.
4. SIGN BASE MATERIAL SHALL BE 0.100" FLAT SHEET ALUMINUM.
5. MOUNTING HARDWARE FOR SIGNS ATTACHED TO ABUTMENTS OR HAZARDS SHALL BE APPROVED BY THE ENGINEER.
6. PAYMENT FOR ALL MATERIALS AND LABOR NECESSARY TO ATTACH AN OM3(L/R) SIGN TO ANYTHING OTHER THAN A SIGN POST WILL BE PAID FOR AS ONE 2" SQUARE STEEL SIGN POST 15 FEET LONG.



DELINEATOR PLACEMENT



TYPE II (6"x8") DELINEATOR

DELINEATOR LOCATIONS:

TOWN:	DIRECTION:	MILE POINT:	NO. OF NEW TYPE II (POSTS):	NO. OF REMOVALS:	POST SPACING:	SHEET:
WOODFORD	EB	4.856-4.996	30 (15)		50 FT	14

DELINEATORS WITH RETROREFLECTIVE SHEETING:

1. MATERIAL FOR A TYPE II (6"x8") DELINEATOR SHALL BE A 0.063" ALUMINUM BACKING WITH WHITE ASTM TYPE III OR IV RETROREFLECTIVE SHEETING APPLIED TO ONE SIDE.
2. ALL TYPE II (6"x8") DELINEATOR POSTS SHALL BE 1.75" SQUARE STEEL, 1.88 LB/FT (14 GAUGE) WITH A 12 GAUGE ANCHOR. ANCHOR REVEAL OF 2" MAXIMUM.
3. DELINEATOR POSTS SHALL HAVE A MINIMUM EMBEDMENT OF 2'-6" IN THE GROUND.
4. ALL WORK ASSOCIATED WITH INSTALLING NEW TYPE II (6"x8") DELINEATORS SHALL BE PAID FOR UNDER ITEM 676.10 DELINEATOR WITH STEEL POST.

ALL DIMENSIONS SHOWN IN INCHES, EXCEPT WHERE NOTED.

PROJECT NAME: WOODFORD - MARLBORO

PROJECT NUMBER: STPG SIGN (35)

FILE NAME: IOC332.SD-1

PROJECT LEADER: A. GAMBLE

DESIGNED BY: J. KELLY

SIGN DETAILS I

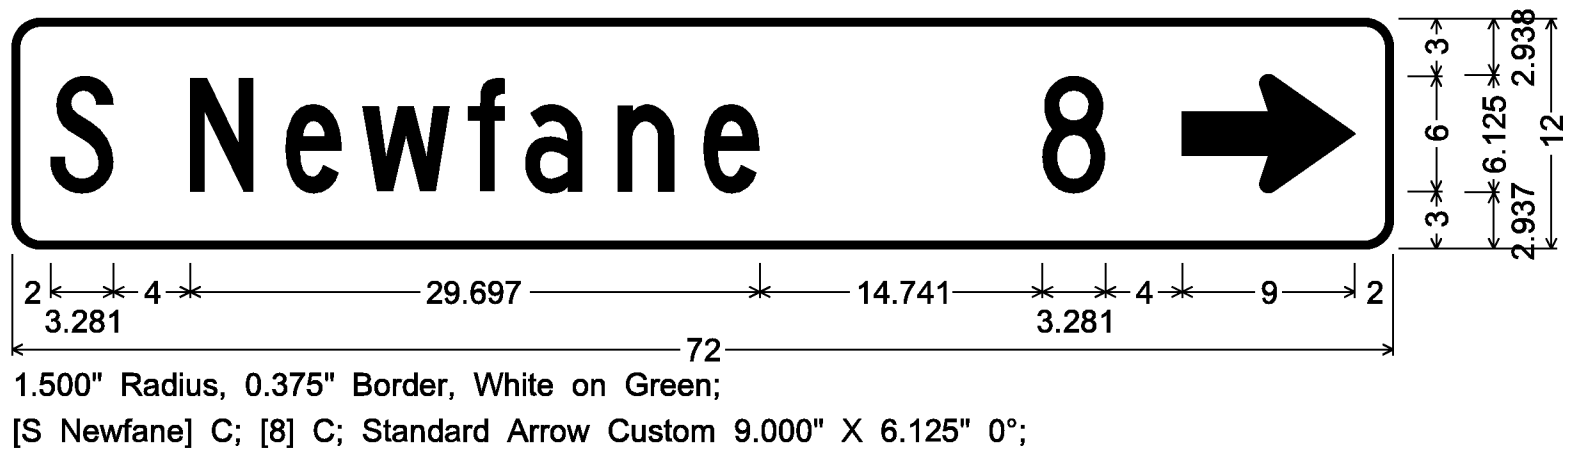
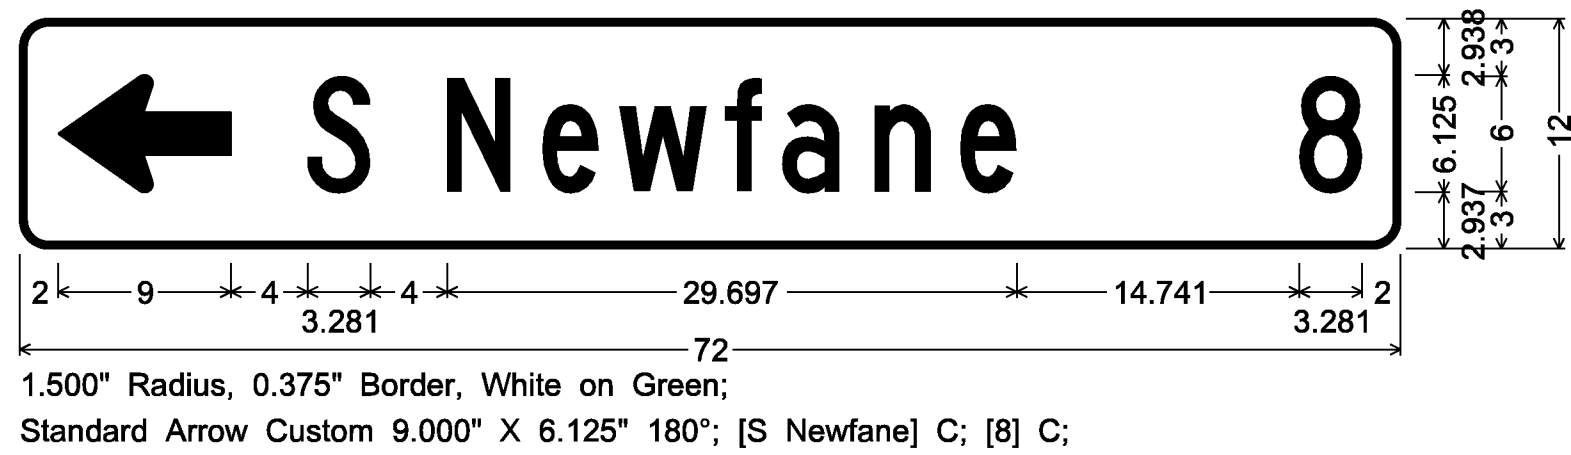
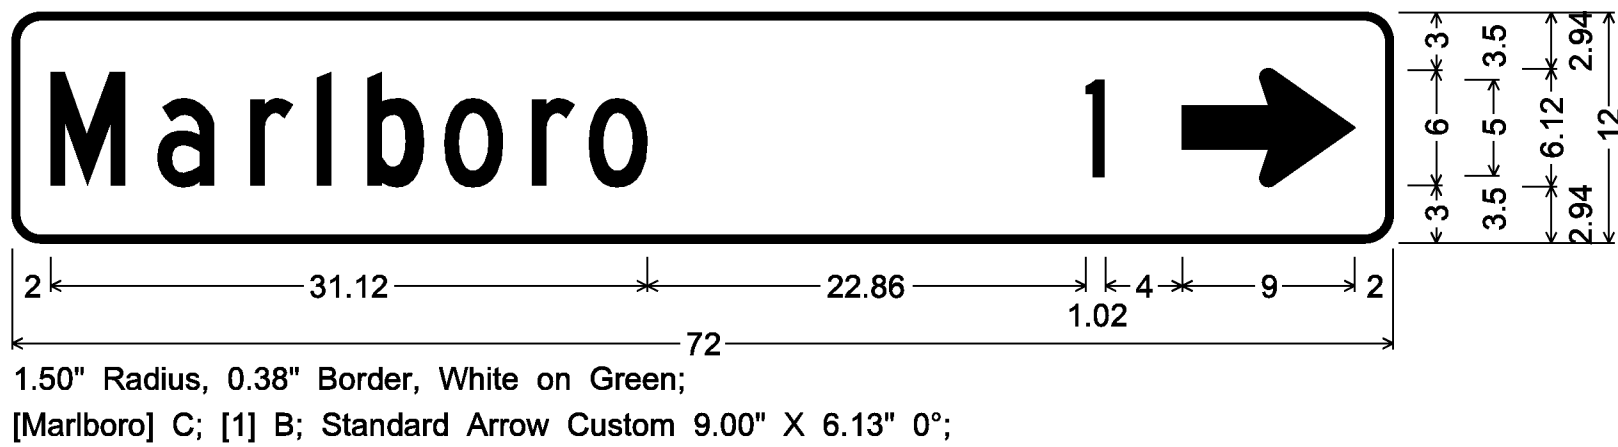
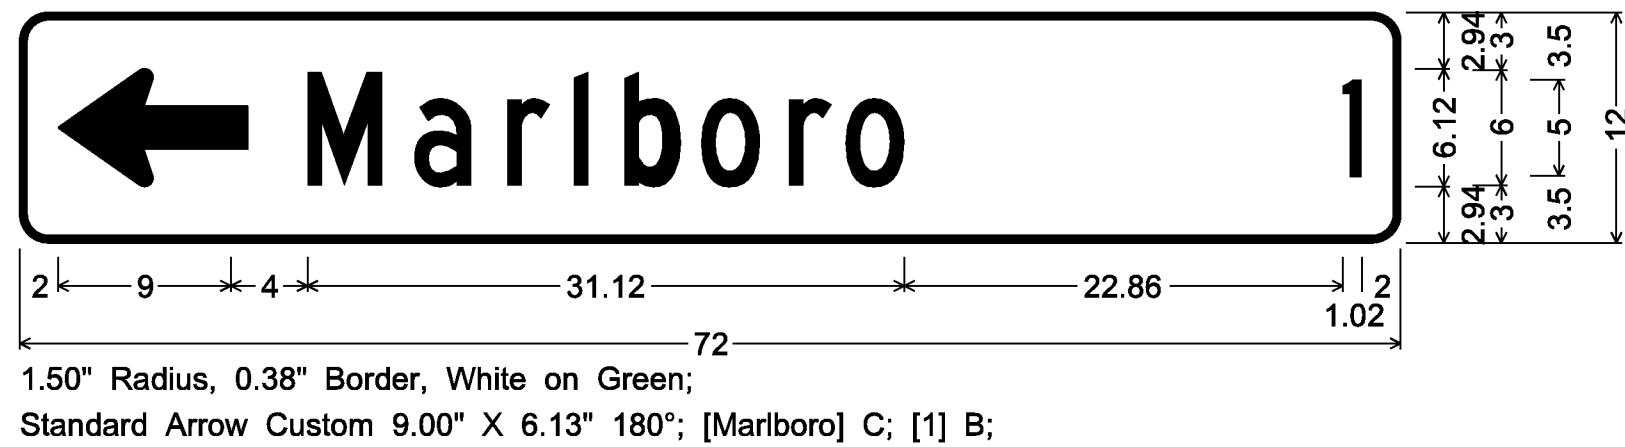
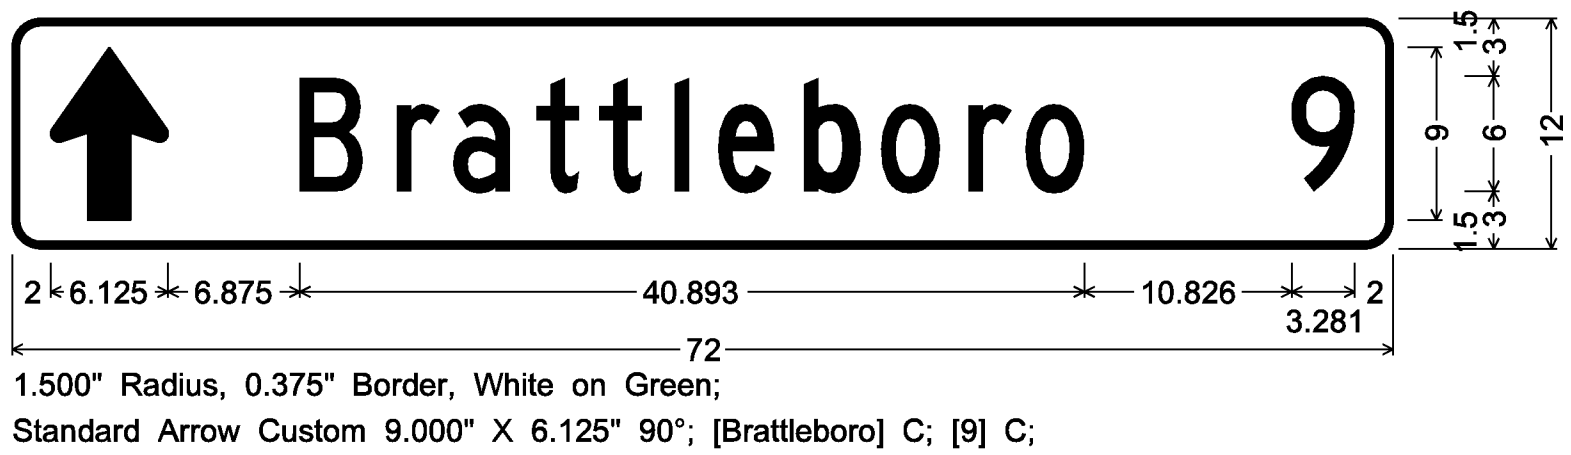
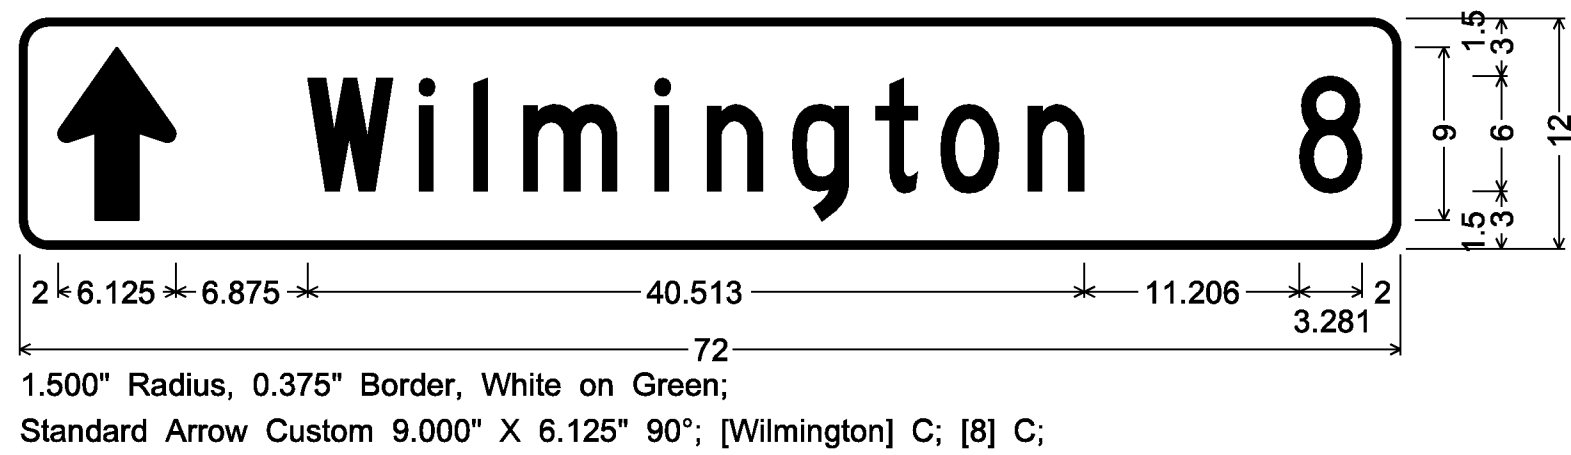
PLOT DATE: 10-APR-2012

DRAWN BY: J. KELLY

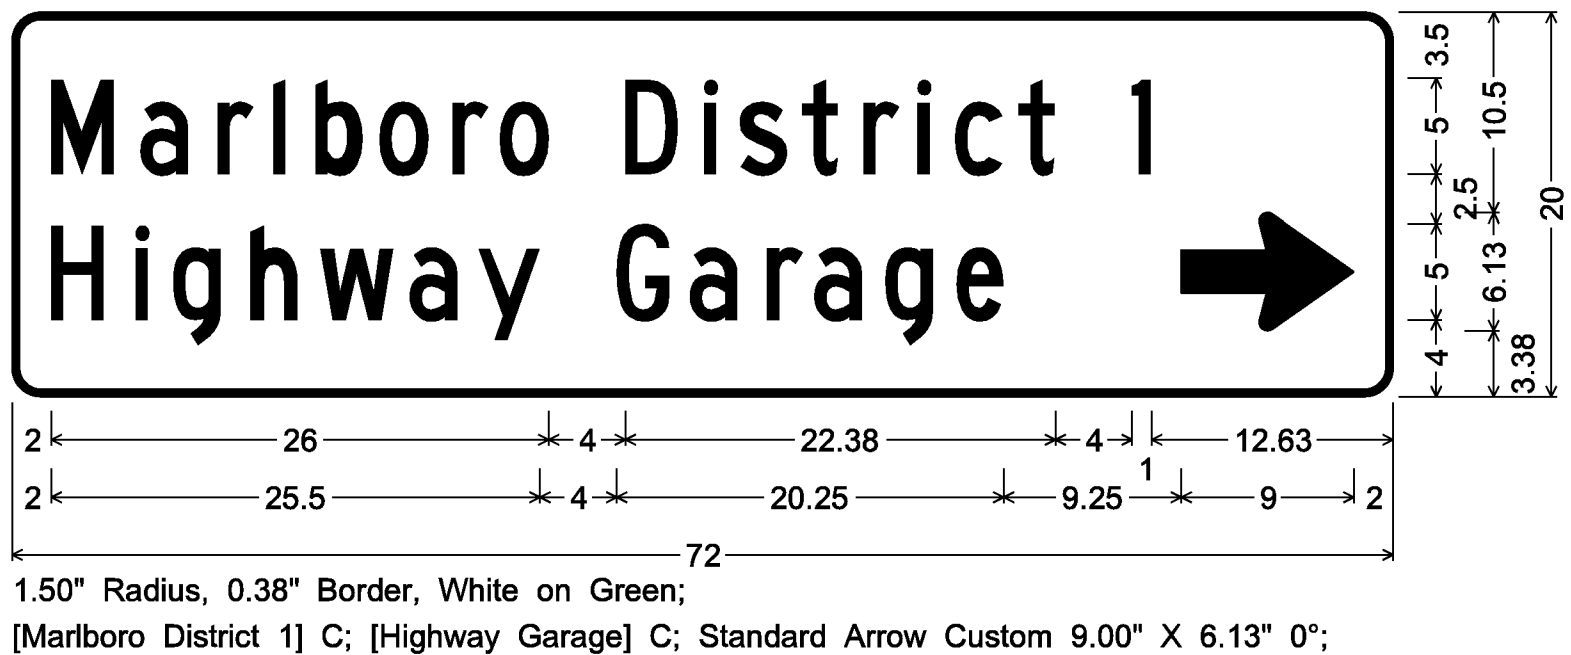
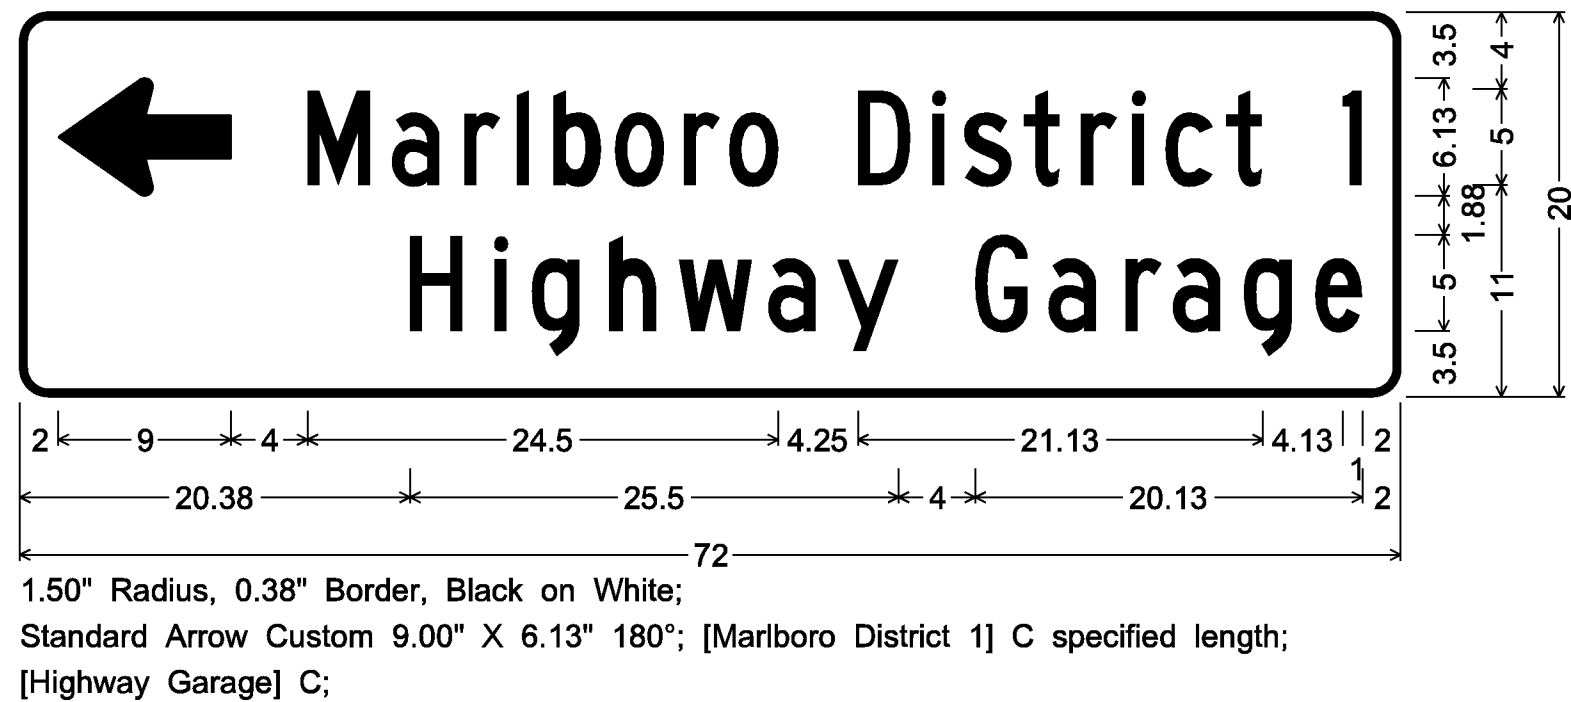
CHECKED BY: A. GAMBLE

SHEET 5 OF 80

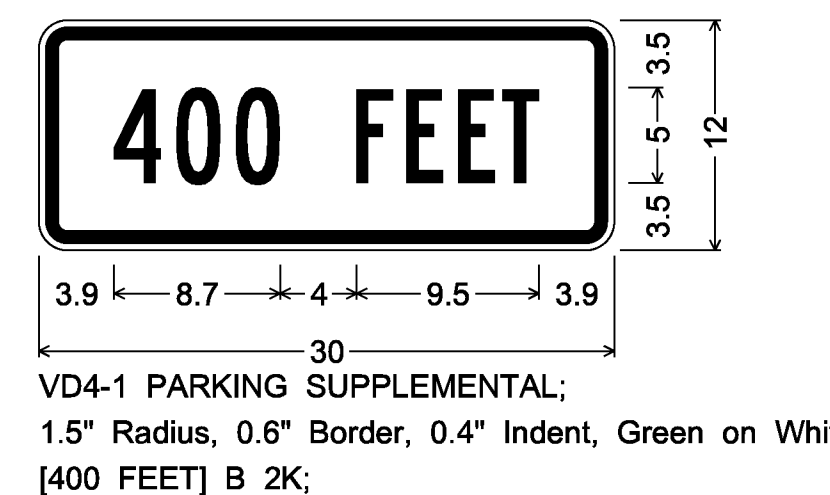
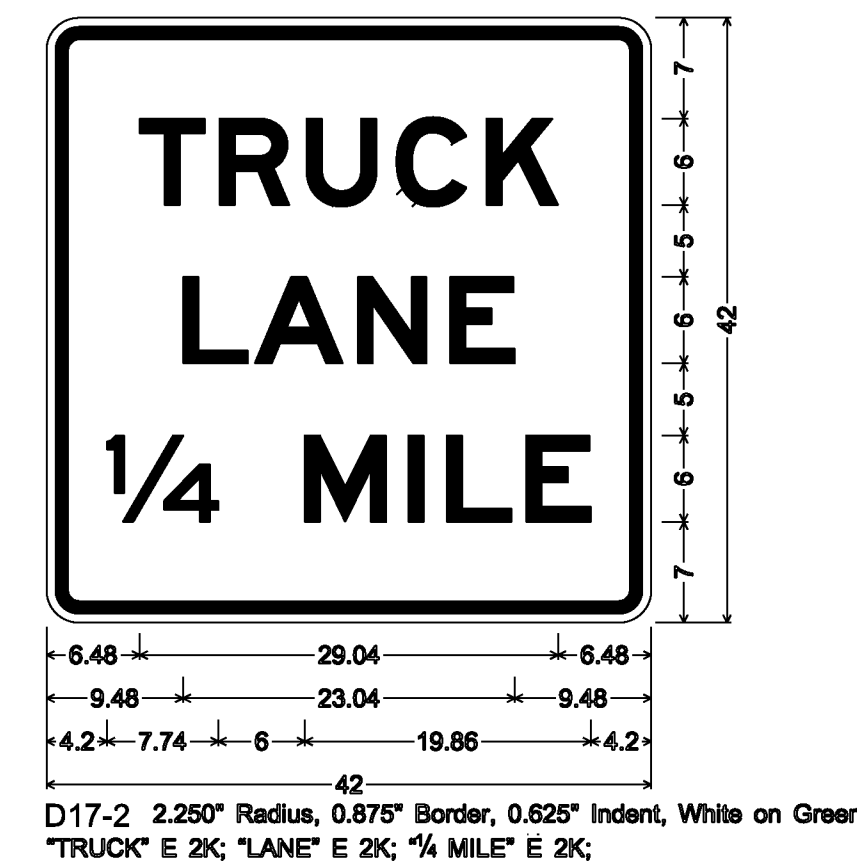
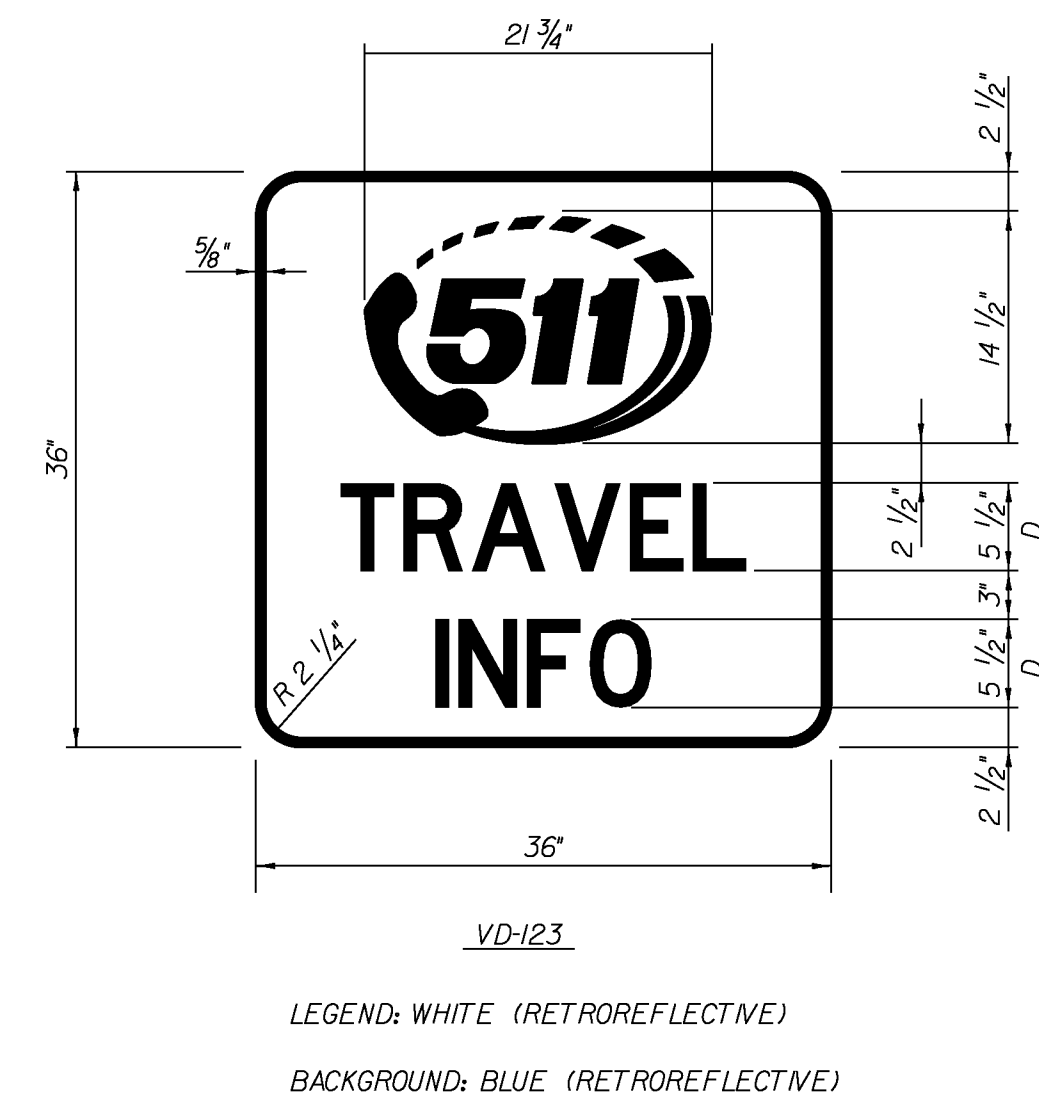
NOT TO SCALE



VD1-1A SIGN DETAILS



VD1-1 SIGN DETAILS



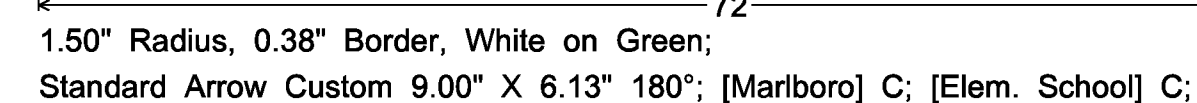
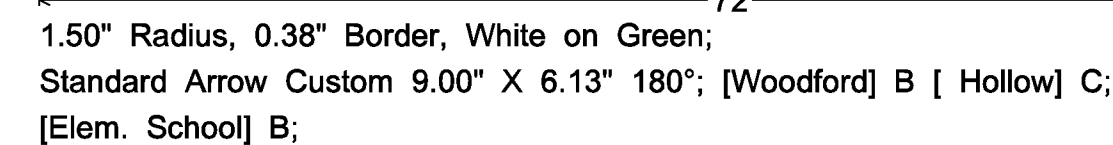
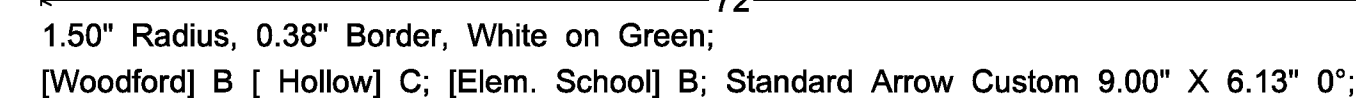
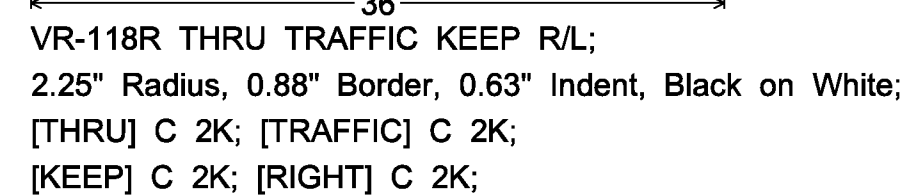
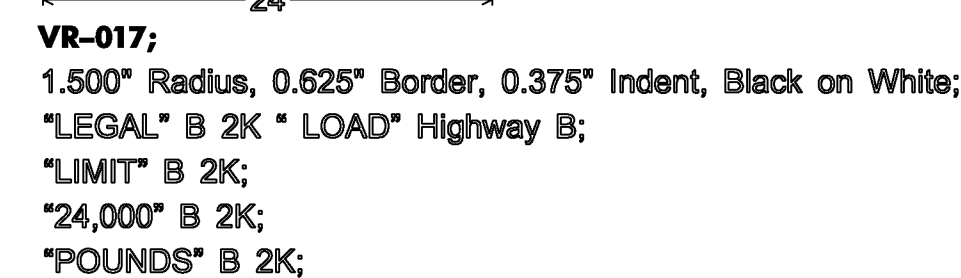
PROJECT NAME: WOODFORD - MARLBORO

PROJECT NUMBER: STPG SIGN (35)

FILE NAME: IOB336_TS.DGN
PROJECT LEADER: A. GAMBLE
DESIGNED BY: J. KELLY
SIGN DETAILS 2

PLOT DATE: IO-APR-2012
DRAWN BY: J. KELLY
CHECKED BY: A. GAMBLE
SHEET 6 OF 80

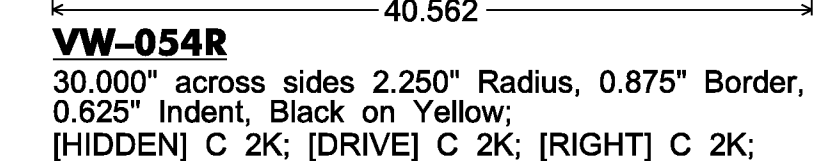
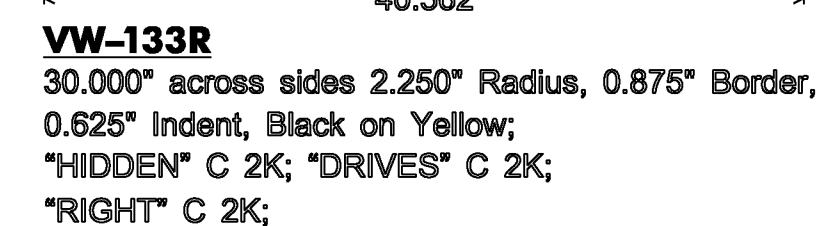
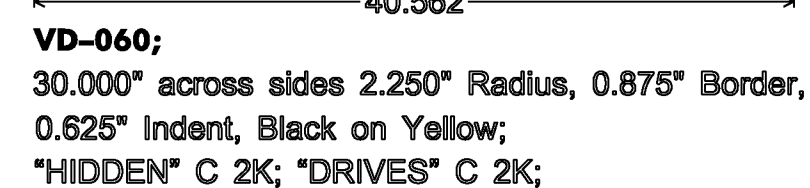
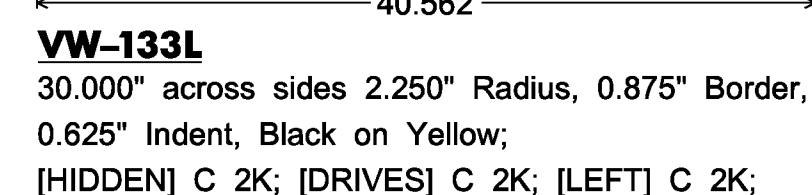
NOT TO SCALE



ALL DIMENSIONS SHOWN IN INCHES UNLESS OTHERWISE NOTED.

PROJECT NAME: WOODFORD - MARLBORO	
PROJECT NUMBER: STPG SIGN (35)	
FILE NAME: IOB336_TS.DGN	PLOT DATE: 10-APR-2012
PROJECT LEADER: A. GAMBLE	DRAWN BY: J. KELLY
DESIGNED BY: J. KELLY	CHECKED BY: A. GAMBLE
SIGN DETAILS 3	SHEET 7 OF 80

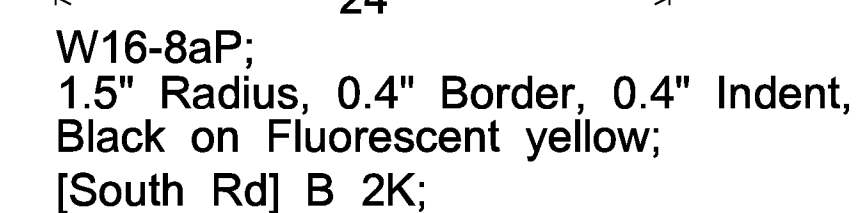
NOT TO SCALE



SIGN	DIMENSIONS (INCHES)											
	A	B	C	D	E	F	G	H	J	K	L	M
MIN.	30	1/2	3/4	1 7/8	9 5/8	9 3/4	4B	2	5B	2	9/4	10 1/2
STD.	36	5/8	7/8	2 1/4	11 3/4	12	4C	2 1/2	5C	2	11/2	12 3/4
EXPWY.	48	3/4	1 1/4	3	14 3/4	15 3/8	5C	3 3/8	8B	2 5/8	4 1/4	16 1/2



SYMBOL AND BORDER - BLACK (NON-REFL.)
BACKGROUND - YELLOW (REFL.)



ALL DIMENSIONS SHOWN IN INCHES UNLESS OTHERWISE NOTED.

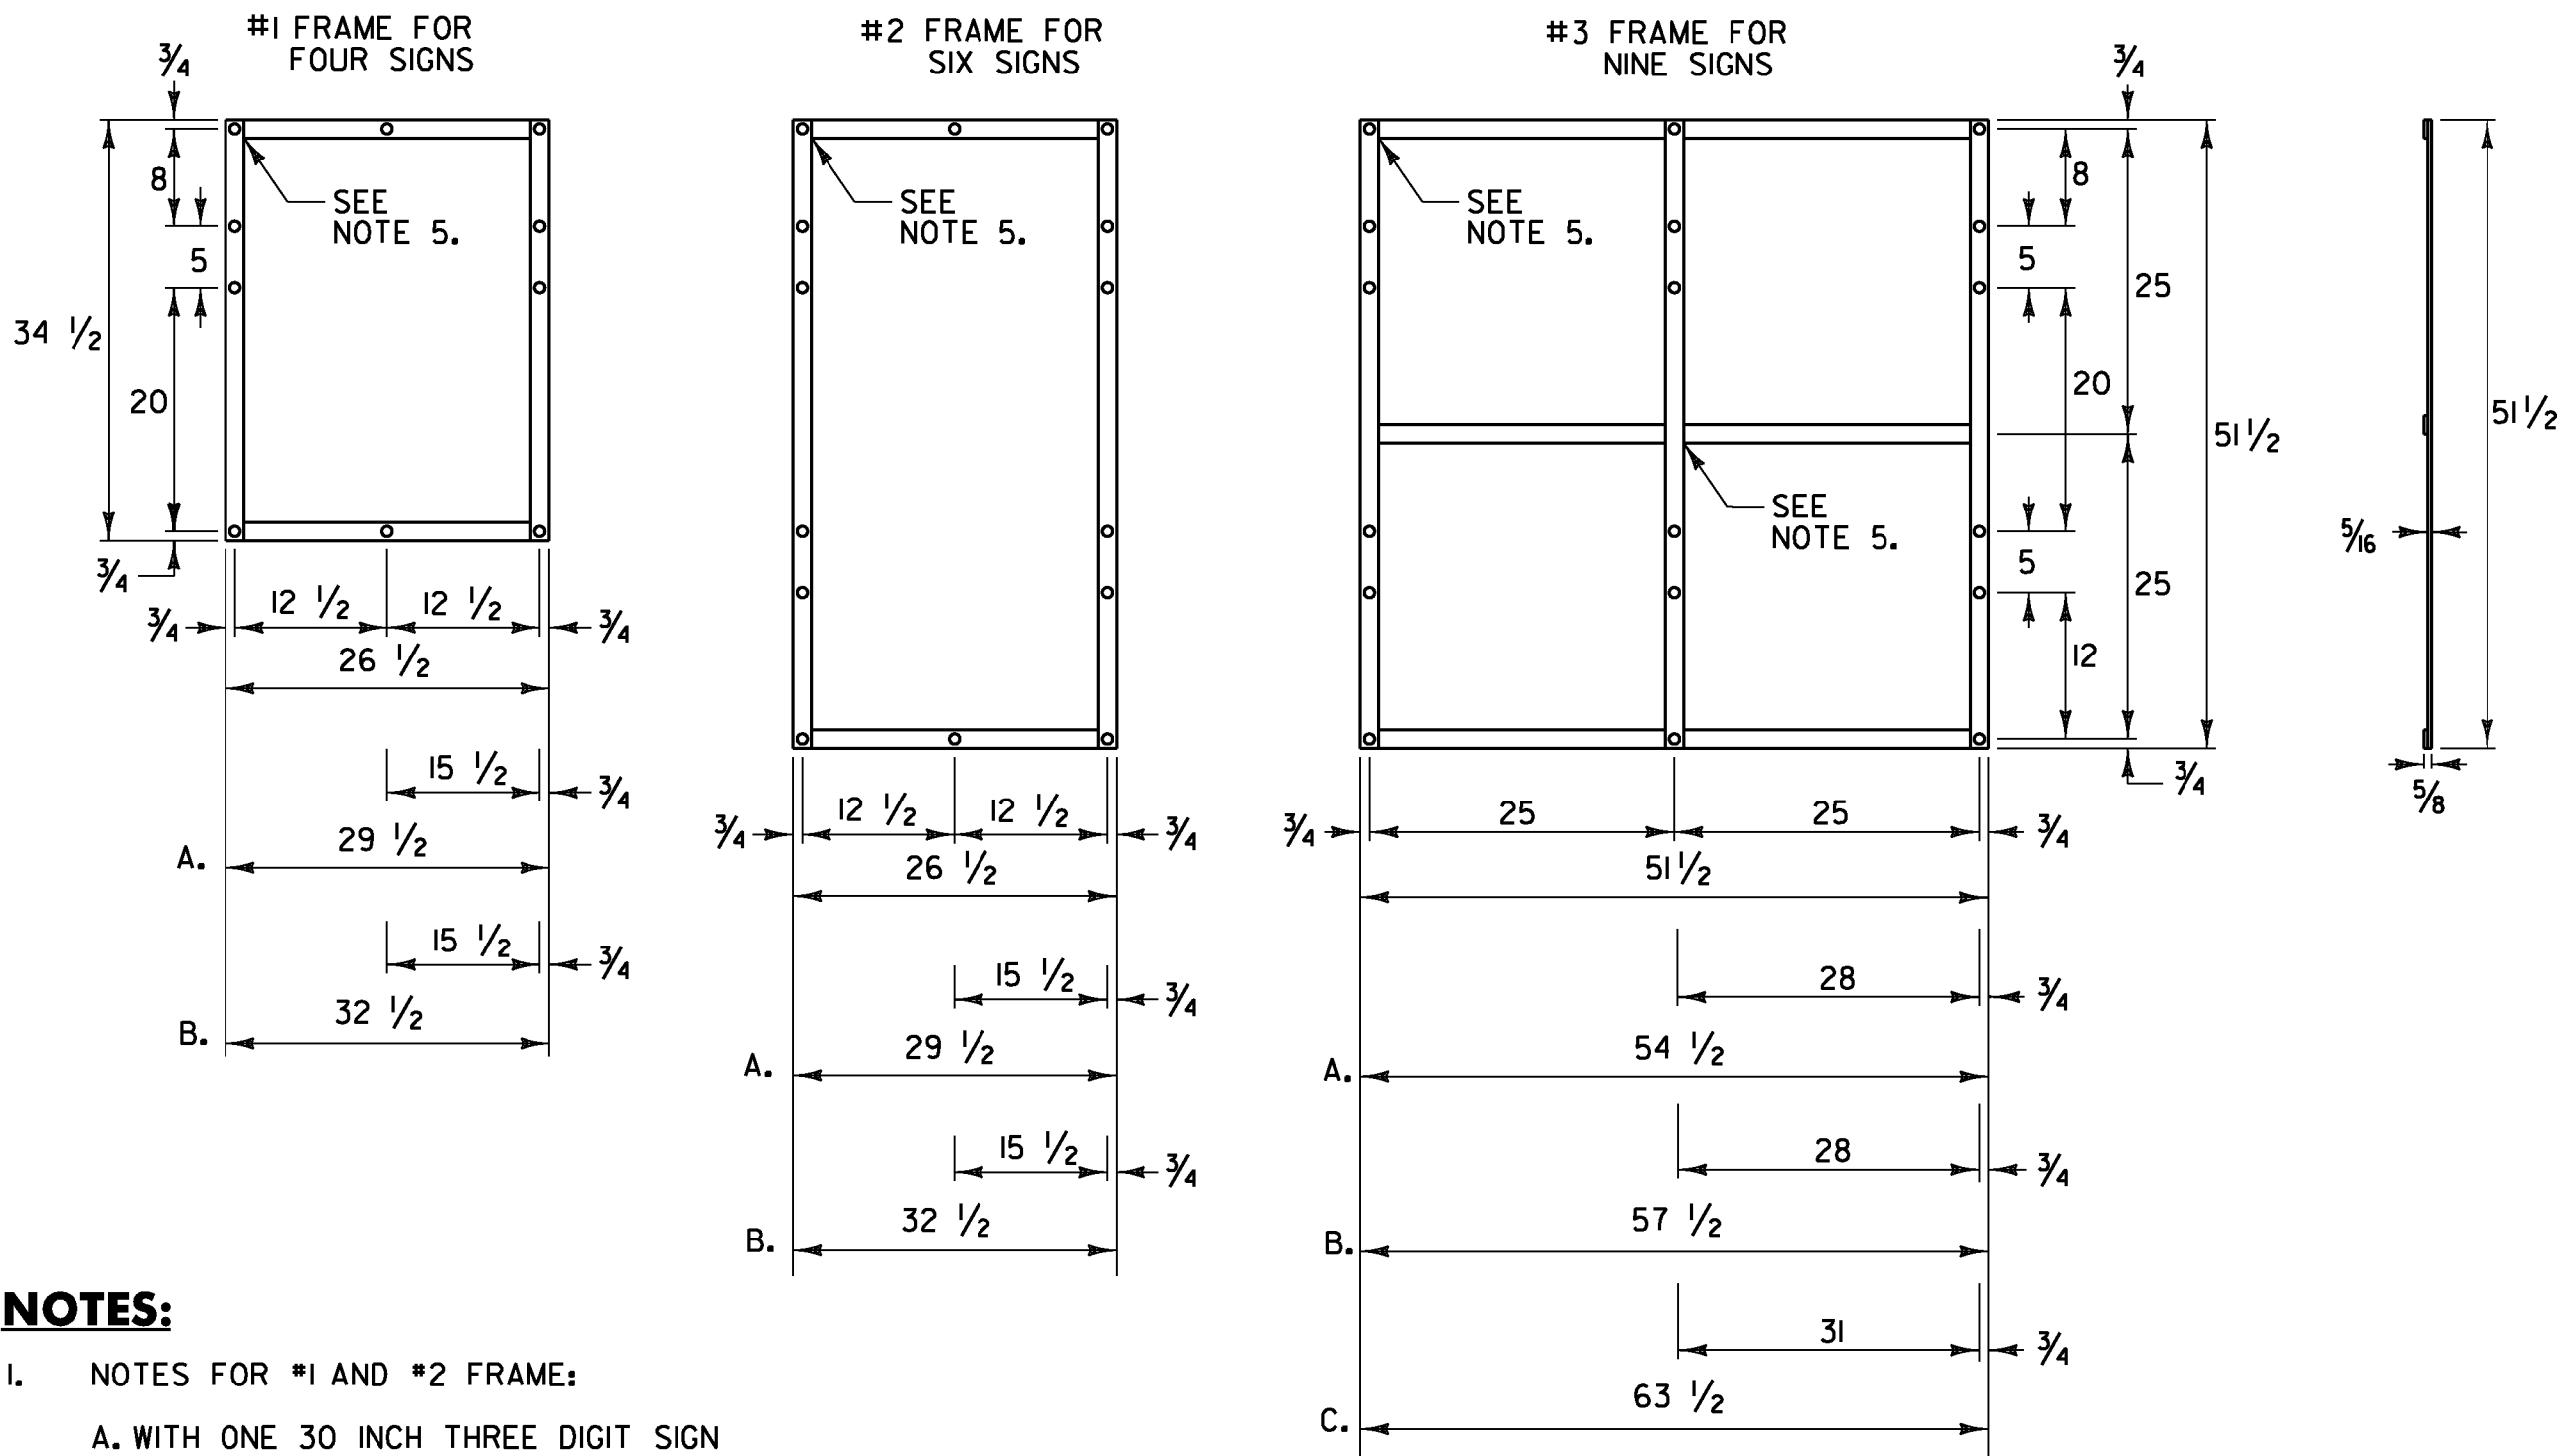
PROJECT NAME: WOODFORD - MARLBORO

PROJECT NUMBER: STPG SIGN (35)

FILE NAME: IOB336_TS.DGN
PROJECT LEADER: A. GAMBLE
DESIGNED BY: J. KELLY
SIGN DETAILS 4

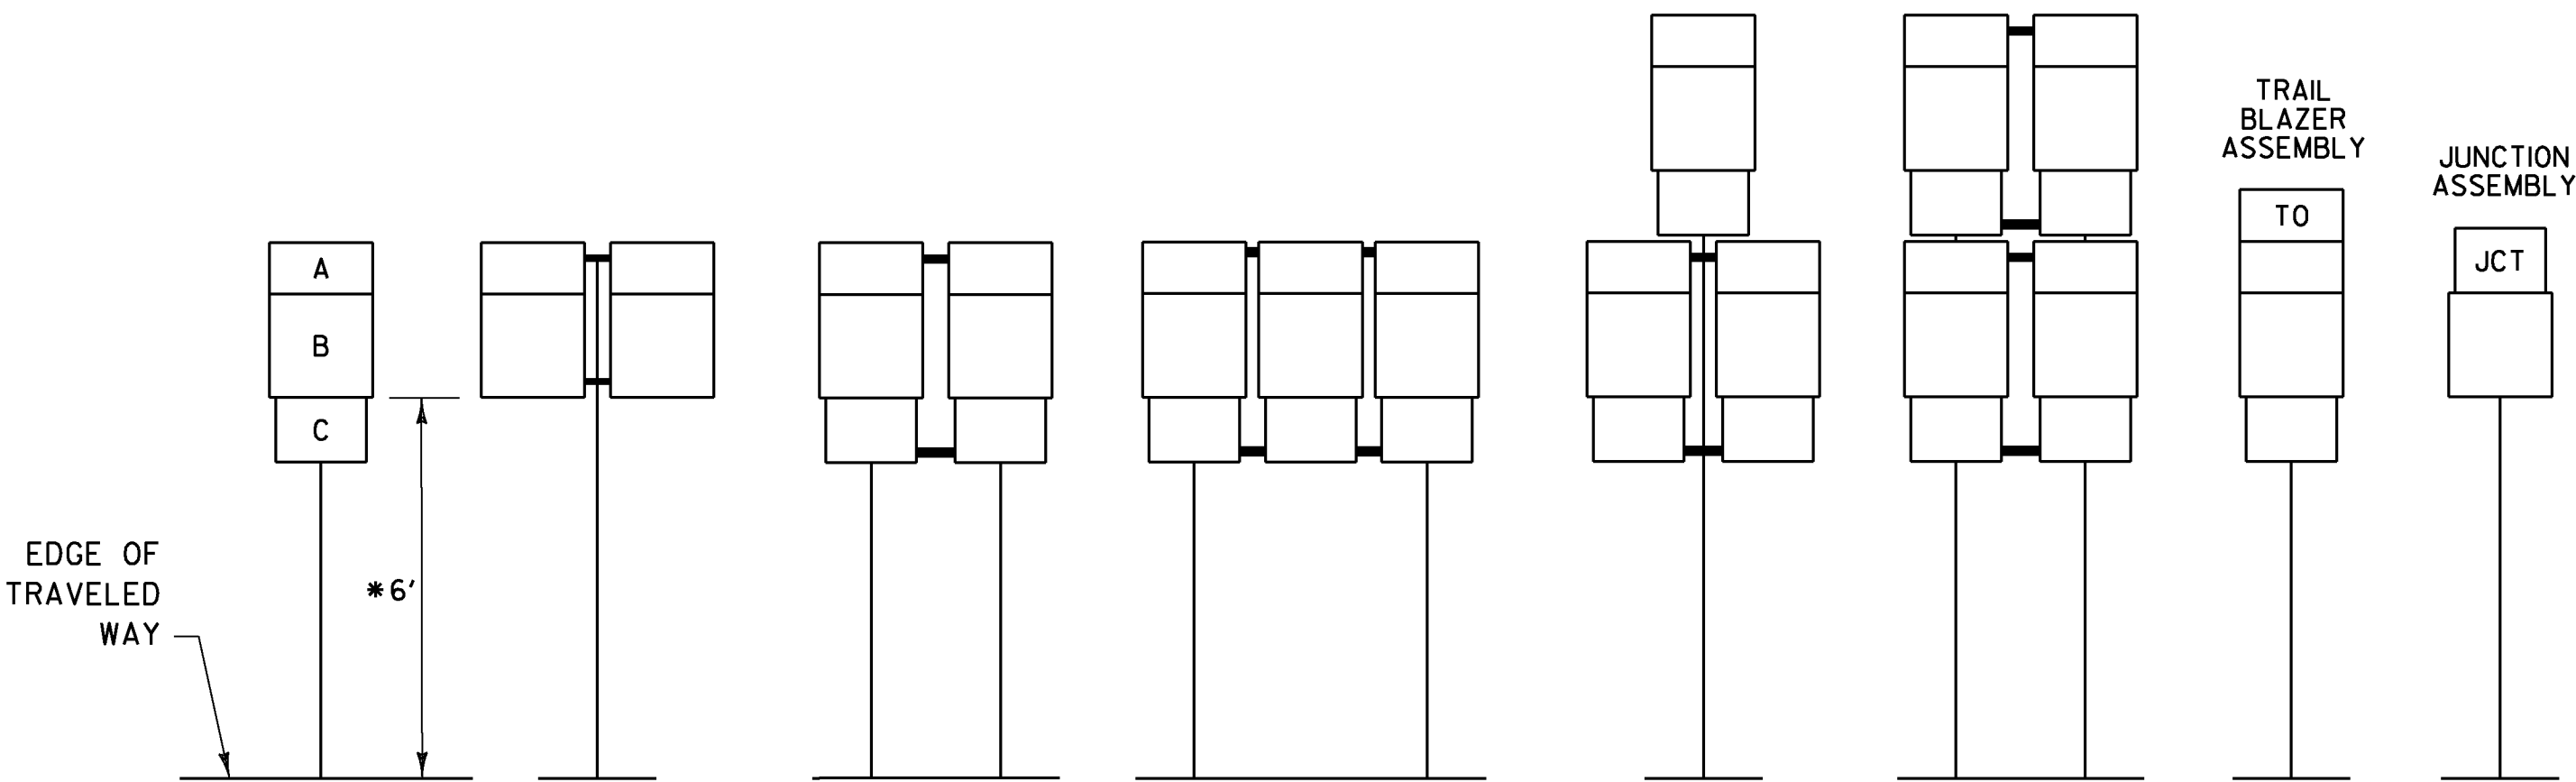
PLOT DATE: 10-APR-2012
DRAWN BY: J. KELLY
CHECKED BY: A. GAMBLE
SHEET 8 OF 80

ROUTE MARKER ASSEMBLY FRAMES



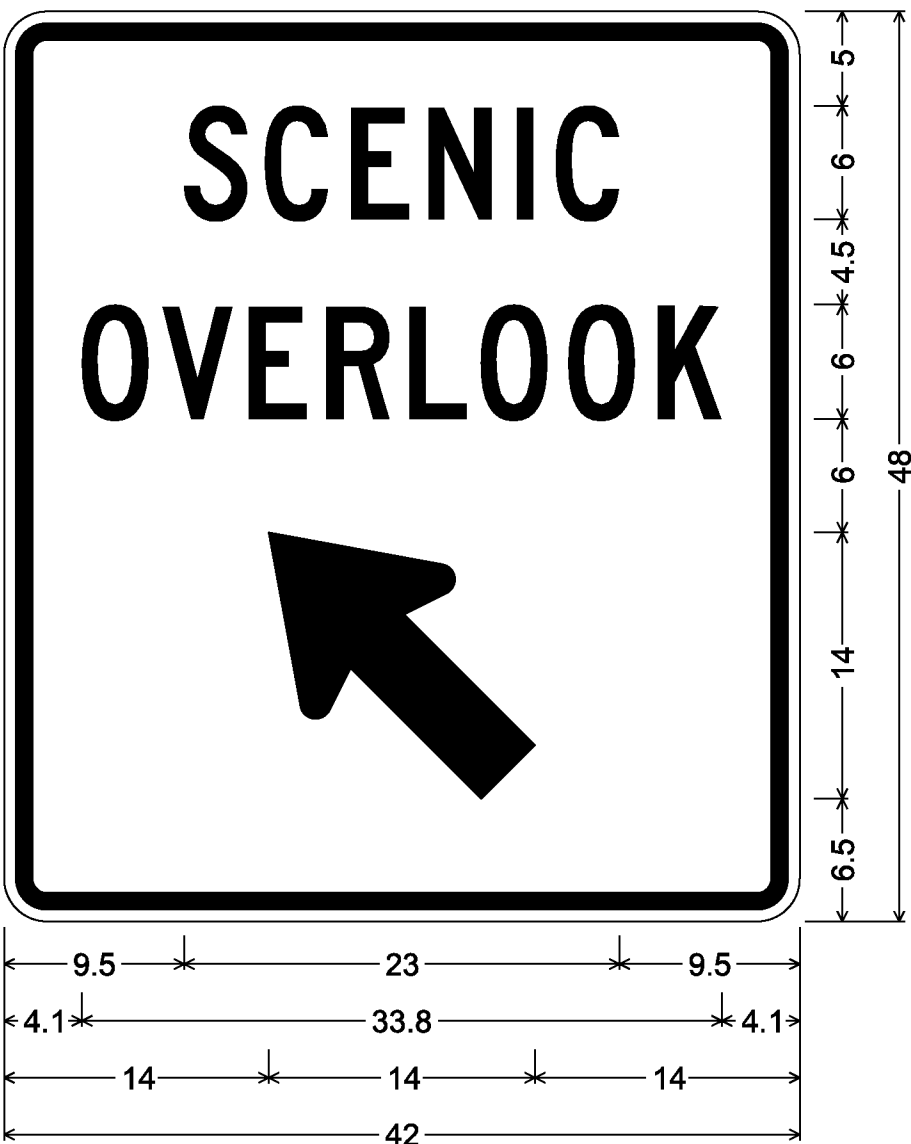
- NOTES:**
- NOTES FOR #1 AND #2 FRAME:
A. WITH ONE 30 INCH THREE DIGIT SIGN
B. WITH TWO 30 INCH THREE DIGIT SIGNS
 - NOTES FOR #3 FRAME:
A. WITH ONE 30 INCH THREE DIGIT SIGN IN AN OUTSIDE POSITION.
B. WITH ONE 30 INCH THREE DIGIT SIGN IN THE CENTER POSITION OR TWO SUCH SIGNS IN THE OUTSIDE POSITIONS.
C. WITH THREE 30 INCH THREE DIGIT SIGNS.
 - ALL HOLES SHALL BE 3/16 INCH DIAMETER. FOR OTHER SIGN COMBINATIONS THAN ABOVE, THE FRAME DIMENSIONS AND HOLE SPACING SHALL BE MODIFIED AS NECESSARY. THE FRAME SHALL BE PAINTED WITH ONE COAT OF PRIMER AND A SECOND COAT OF BLACK PAINT. THE PAINT SHALL BE OF THE TYPE USED ON EXTERIOR METAL SURFACES TO PREVENT METAL CORROSION.
 - FRAMES SHALL BE CONSTRUCTED OF 5/16 INCH x 1 1/2 INCH A-36 STEEL.
 - ALL OVERLAPPED CONNECTIONS SHALL BE WELDED WITH TWO 1/4 INCH WIDE FILLET WELDS, 1 1/2 INCHES LONG.

STANDARD MOUNTING OF ROUTE MARKER ASSEMBLIES

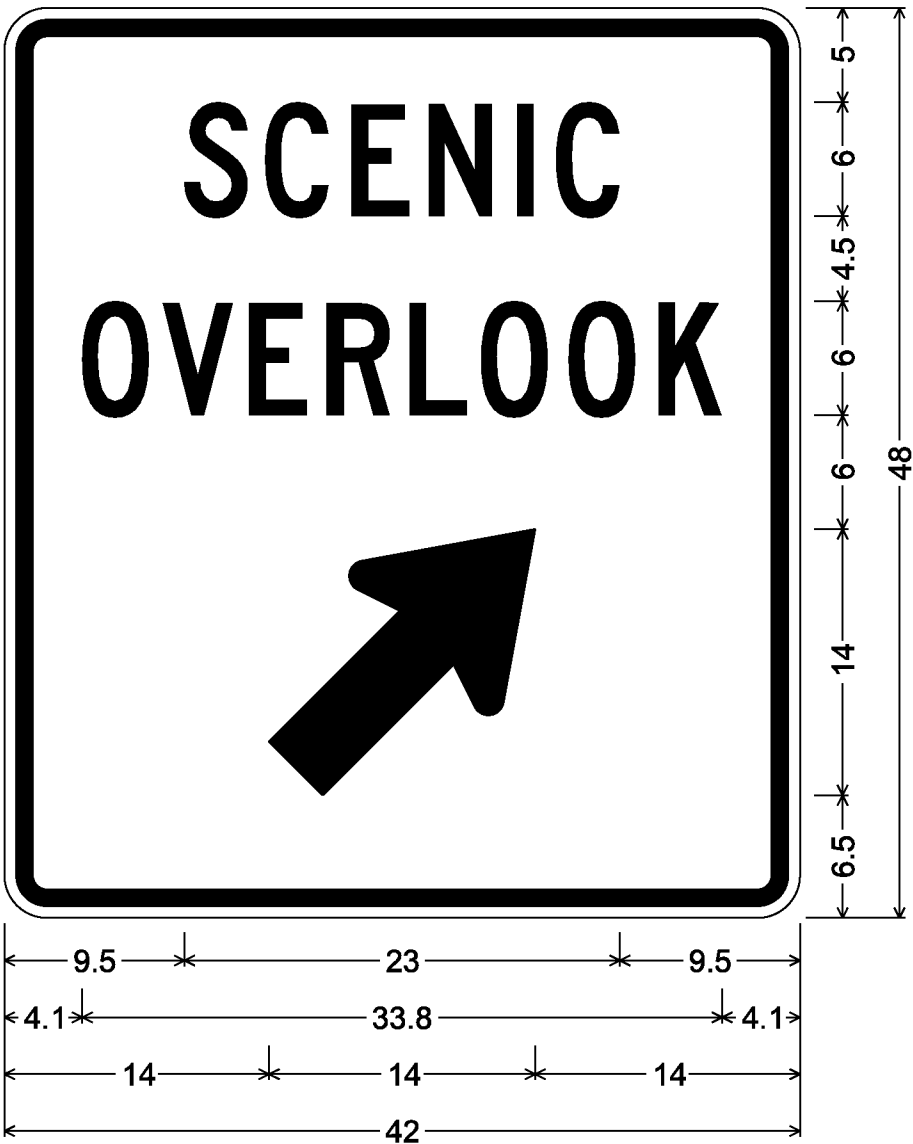


- A - CARDINAL DIRECTION MARKER
B - ROUTE NUMBER
C - ADVANCE TURN ARROW OR DIRECTIONAL ARROW
- * WHERE PARKING OR PEDESTRIAN TRAFFIC WILL OCCUR IN THE IMMEDIATE VICINITY OF THESE SIGNS MINIMUM VERTICAL CLEARANCE SHALL BE INCREASED TO SEVEN FEET
- INSTALLATION SEQUENCE:
IN MULTIPLE HORIZONTAL MOUNTINGS PLACE A ROUTE MARKER ASSEMBLY INDICATING A LEFT TURN ON THE LEFT SIDE OF THE ASSEMBLY; RIGHT TURN ON THE RIGHT SIDE. FOR VERTICALLY STACKED MOUNTINGS PLACE THE STRAIGHT THROUGH MOVE INDICATION ON TOP, THE LEFT OR RIGHT TURNS AS APPROPRIATE BENEATH.

- NOTES:**
- ALL DIMENSIONS SHOWN IN INCHES UNLESS OTHERWISE NOTED.
 - VERTICAL FRAME MEMBERS SHALL LINE UP WITH SIGN POST ON WHICH THEY ARE MOUNTED.



D5-21
2.3" Radius, 0.9" Border, 0.6" Indent, White on Blue;
[SCENIC] C 2K; [OVERLOOK] C 2K;



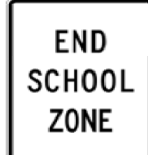
D5-2R
2.3" Radius, 0.9" Border, 0.6" Indent, White on Blue;
[SCENIC] C 2K; [OVERLOOK] C 2K;

ALL DIMENSIONS SHOWN IN INCHES UNLESS OTHERWISE NOTED.

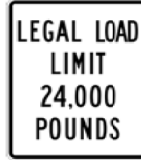
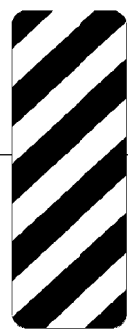
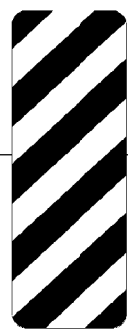
PROJECT NAME:	WOODFORD - MARLBORO
PROJECT NUMBER:	STPG SIGN (35)
FILE NAME:	I0B336_TS.DGN
PROJECT LEADER:	A. GAMBLE
DESIGNED BY:	J. KELLY
SIGN DETAILS 5	
PLOT DATE:	17-APR-2012
DRAWN BY:	J. KELLY
CHECKED BY:	A. GAMBLE
SHEET 9	OF 80

NOT TO SCALE

DIRECTION	MILEPOINT	LOCATION CODE (SHEET 2)	SIGN CODE	WIDTH (IN)	HEIGHT (IN)	SHEETING REMARKS	SIGN LEGEND	NEW SIGNS		EXISTING SIGNS				EXIST POST		NUMBER OF NEW POSTS	SQUARE STEEL (IN)			TUBULAR STEEL Ø (IN)				SIGN FRAME REQUIRED	REMARKS	SIGN DETAIL LOCATION				
								"A"	"B"	RETAIN	SALVAGE FROM	SALVAGE TO	REMOVE	RETAIN	REMOVE		1.75	2.00	2.50	FOUNDATION	3.0	3.50	4.00			5.00	SHSM	PROJECT SHEET #	STANDARD SHEET #	
																	(LB / FT)				(LB / FT)									
																	1.88	2.42	3.35		7.6	9.00	10.80			14.60				
WOODFORD EB							FY-FLUORESCENT YELLOW FYG-FLUORESCENT YELLOW GREEN															"SHSM"-STANDARD HIGHWAY SIGNS AND MARKINGS								
EB	0.000	C	VD-024	60	7.5		Woodford Bennington 0090 0217 0000 0090 0202 0687	5.00					1		X	2		X												
		C	VD-024	72	10			0.42																	INSTALL ON LEFT POST BELOW WOODFORD.	REMOVE OLD MM		E-138		
		C	VD-700	6	10			0.42																	INSTALL ON RIGHT POST BELOW BENNINGTON.	REMOVE OLD MM		E-138		
EB	0.385	A	R2-5A	24	30			REDUCED SPEED AHEAD						1		X	2		X									TRIM BRUSH		
		A	W3-5	36	36		SPEED LIMIT 40	9.00										X									X			
EB	0.520	A	R2-1	24	30		SPEED LIMIT 40	7.50					1		X	1		X								INSTALL DIRECTLY ACROSS FROM WEST BOUND SL50 SIGN.	X			
		A	R2-1	30	36																									
EB	0.761	A	R2-1	24	30		SPEED LIMIT 40	5.00					1		X	1		X										X		
		A	R2-1	24	30																									
EB	0.828	A	S1-1	30	30		SCHOOL	9.00					1		X	2		X								INSTALL NEXT TO SCHOOL PAVEMENT MARKING.	X			
		A	S1-1	36	36	FYG																								
		A	S4-3P	24	8	FYG		1.33																			X			
EB	0.873	A	S4-3P	24	8								1	X																
		A	R2-1	24	30								1																	
SIGN SUMMARY SHEET							SHEET TOTALS	37.67	0.00	0	0	0	97	0	0	8	120			0	0.0	0.0	0.0	0.0	PROJECT NAME: WOODFORD-MARLBORO			PLOT DATE: 4/10/2012		
							SF	SF	EA	EA	EA	EA	EA	EA	EA		FT		EA	LB	LB	LB	LB	PROJECT NUMBER: STPG SIGN(35)						
VERMONT AGENCY OF TRANSPORTATION																								FILE NAME: 10B336			DRAWN BY: J. KELLY			
							TOWN DIRECTIONAL TOTALS	310.4	0.0	28.0	0.0	0.0	61	0.0	0.0	52	780.0			0	0.0				DESIGNED BY: J. KELLY			CHECKED BY: A. GAMBLE		
																								WOODFORD EB SHEET 1			SHEET 10 OF 80			

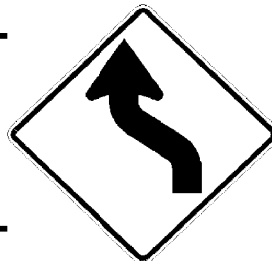
DIRECTION	MILEPOINT	LOCATION CODE (SHEET 2)	SIGN CODE	WIDTH (IN)	HEIGHT (IN)	SHEETING REMARKS	SIGN LEGEND	NEW SIGNS		EXISTING SIGNS				EXIST POST		NUMBER OF NEW POSTS	SQUARE STEEL (IN)			TUBULAR STEEL Ø (IN)				SIGN FRAME REQUIRED	REMARKS	SIGN DETAIL LOCATION			
								"A"	"B"	RETAIN	SALVAGE FROM	SALVAGE TO	REMOVE	RETAIN	REMOVE		1.75	2.00	2.50	FOUNDATION	3.0	3.50	4.00			5.00	SHSM	PROJECT SHEET #	STANDARD SHEET #
																	(LB / FT)				(LB / FT)								
																	1.88	2.42	3.35		7.6	9.00	10.80			14.60			
WOODFORD EB							FY-FLUORESCENT YELLOW FYG-FLUORESCENT YELLOW GREEN															"SHSM"-STANDARD HIGHWAY SIGNS AND MARKINGS							
		A	S4-4P	24	10								1																
		A	S4-3P	24	8	FYG		1.33															REPLACE SIGNS. RETAIN POST, FLASHING BEACON AND WIRING.	X					
		A	R2-1	24	30			5.00																X					
		A	S4-4P	24	10			1.67																X					
EB	0.949	A	D1-1E	72	20								1		X														
		A	VD1-1	72	20			10.00								2		X								7			
EB	1.136	A	S5-2	30	24		END SCHOOL ZONE						1		X														
		A	R2-1	24	30			5.00								1		X						X		TRIM BRUSH			
		A	S5-2	24	30			5.00																X					
EB	1.291	A	W2-2L	30	30		LEFT SIDE ROAD			1				X															
EB	1.397	A	S3-1	30	30		SCHOOL BUS STOP AHEAD						1		X														
EB	1.454	A	S3-1	36	36			9.00								2		X						INSTALL 300 FEET EAST OF EXISTING AND 10 FEET WEST OF POLE WITH CONDUIT.	X				
EB	1.495	A	R2-1	24	30								1		X														
		A	R2-1	24	30			5.00								1		X							X		TRIM BRUSH		
EB	2.228	A	W1-2R	30	30		RIGHT CURVE						1		X														
SIGN SUMMARY SHEET							SHEET TOTALS	42.00	0.00	1	0	0	6	0	0	6	90			0	0.0	0.0	0.0	0.0	PROJECT NAME: WOODFORD-MARLBORO				
								SF	SF	EA	EA	EA	EA	EA	EA	EA		FT		EA	LB	LB	LB	LB	PROJECT NUMBER: STPG SIGN(35)				
							VERMONT AGENCY OF TRANSPORTATION															FILE NAME: 10B336			PROJECT MANAGER: A. GAMBLE			PLOT DATE: 4/10/2012	
TOWN DIRECTIONAL TOTALS																								DRAWN BY: J. KELLY					
																											CHECKED BY: A. GAMBLE		
																						DESIGNED BY: J. KELLY							
																							WOODFORD EB SHEET 2						
																							SHEET 11 OF 80						

DIRECTION	MILEPOINT	LOCATION CODE (SHEET 2)	SIGN CODE	WIDTH (IN)	HEIGHT (IN)	SHEETING REMARKS	SIGN LEGEND	NEW SIGNS		EXISTING SIGNS				EXIST POST		NUMBER OF NEW POSTS	SQUARE STEEL (IN)			TUBULAR STEEL Ø (IN)				SIGN FRAME REQUIRED	REMARKS	SIGN DETAIL LOCATION			
								"A"	"B"	RETAIN	SALVAGE FROM	SALVAGE TO	REMOVE	RETAIN	REMOVE		1.75	2.00	2.50	FOUNDATION	3.0	3.50	4.00			5.00	SHSM	PROJECT SHEET #	STANDARD SHEET #
																	(LB / FT)				(LB / FT)								
																	1.88	2.42	3.35		7.6	9.00	10.80			14.60			
WOODFORD EB							FY-FLUORESCENT YELLOW FYG-FLUORESCENT YELLOW GREEN															"SHSM"-STANDARD HIGHWAY SIGNS AND MARKINGS							
		A	D17-2	42	42		TRUCK LANE 1/4 MILE	12.25							2		X									6			
EB	2.299	A	W1-2R	30	30			6.25							1		X							INSTALL 375 FEET EAST OF EXISTING RIGHT CURVE ASSEMBLY.	X				
EB	2.362	A	R4-6	24	30		TRUCK LANE 500 FEET						1		X														
EB	2.382	A	W11-2	30	30	FYG		6.25							1		X							INSTALL 150 FEET WEST OF EXISTING PEDESTRIAN ASSEMBLY.	X				
		A	W16-9P	24	12	FYG		2.00																	X				
EB	2.411	A	W11-2	30	30		PEDESTRIAN						1		X														
		A	W16-9P	24	10		AHEAD						1																
EB	2.420	A	VR-072	24	30		ENCARE - THINK			1				X										BACK TO BACK ASSEMBLY.					
		B	VR-072	24	30		ENCARE - THINK			1																			
EB	2.457	A	R4-3	24	30								1		X														
		A	R4-3	24	30		SLOWER TRAFFIC KEEP RIGHT 0090 0217 0245	5.00			I	I	I			1		X							REINSTALL 2.45 MILE MARKER	X	R/S MM		
EB	2.483	A	D4-1	30	24								1		X														
		A	D4-1L	30	24			5.00							1		X								X				
EB	2.525	A	W11-2	30	30								1		X														
		A	W16-7	24	12		DOWNWARD LEFT ARROW						1																
SIGN SUMMARY SHEET							SHEET TOTALS	36.75	0.00	2	0	0	87	0	0	6	90			0	0.0	0.0	0.0	0.0	PROJECT NAME: WOODFORD-MARLBORO				
								SF	SF	EA	EA	EA	EA	EA	EA	EA		FT		EA	LB	LB	LB	LB	PROJECT NUMBER: STPG SIGN(35)				
							VERMONT AGENCY OF TRANSPORTATION																			FILE NAME: 10B336			
TOWN DIRECTIONAL TOTALS								310.4	0.0	28.0	0.0	0.0	61	0.0	0.0	52	780.0			0	0.0				PROJECT MANAGER: A. GAMBLE				
																									DRAWN BY: J. KELLY				
																									CHECKED BY: A. GAMBLE				
																							DESIGNED BY: J. KELLY						
																							WOODFORD EB SHEET 3						
																								SHEET 12 OF 80					

DIRECTION	MILEPOINT	LOCATION CODE (SHEET 2)	SIGN CODE	WIDTH (IN)	HEIGHT (IN)	SHEETING REMARKS	SIGN LEGEND	NEW SIGNS		EXISTING SIGNS				EXIST POST		NUMBER OF NEW POSTS	SQUARE STEEL (IN)			TUBULAR STEEL Ø (IN)				SIGN FRAME REQUIRED	REMARKS	SIGN DETAIL LOCATION			
								"A"	"B"	RETAIN	SALVAGE FROM	SALVAGE TO	REMOVE	RETAIN	REMOVE		1.75	2.00	2.50	FOUNDATION	3.0	3.50	4.00			5.00	SHSM	PROJECT SHEET #	STANDARD SHEET #
																	(LB / FT)				(LB / FT)								
																	1.88	2.42	3.35		7.6	9.00	10.80			14.60			
WOODFORD EB							FY-FLUORESCENT YELLOW FYG-FLUORESCENT YELLOW GREEN															"SHSM"-STANDARD HIGHWAY SIGNS AND MARKINGS							
		A	W11-2	30	30	FYG		6.25							1		X							X					
		A	W16-4P	30	24	FYG		5.00																X					
EB	2.590	A	R2-1	24	30								1		X											PLACED SIGN ON 8-30, COUNTED ON 8-29			
		A	R2-1	24	30			5.00							1		X							X					
EB	2.735	A	VW-285	30	30		FALLING ROCK SYMBOL						1		X														
EB	2.792	C	VR-017	24	30								1	X	X											RETAIN POST			
		C	VR-017	24	30			5.00							+		X									7			
EB	2.792	D	R1-1	30	30								1		X											NOTCH RD (TH-4)			
		D	R1-1	30	30			6.25							1		X							X		STREET SIGN R/S			
EB	2.801	A	OM3-R	12	36		 						1		X														
		A	OM3-R	12	36			3.00							1		X							X		RETAIN ANCHOR			
EB	2.853	B	OM3-L	12	36								1	X	X											R/S TWO PLAQUES			
		B	OM3-L	12	36			3.00							+		X							X		RETAIN POST			
EB	2.866	A	VW-285	30	30			6.25							1		X									INSTALL 50 FEET WEST OF LARGE ARROW.			
EB	2.883	B	W1-6	48	24		RIGHT LARGE ARROW			1				X															
SIGN SUMMARY SHEET							SHEET TOTALS	39.75	0.00	1	3	3	6	0	0	7	105			0	0.0	0.0	0.0	0.0	PROJECT NAME: WOODFORD-MARLBORO				
								SF	SF	EA	EA	EA	EA	EA	EA	EA		FT		EA	LB	LB	LB	LB	PROJECT NUMBER: STPG SIGN(35)				
							TOWN DIRECTIONAL TOTALS							310.4	0.0	28.0	0.0	0.0	61	0.0	0.0	52	780.0			0	0.0		
VERMONT AGENCY OF TRANSPORTATION																								PLOT DATE: 4/10/2012 DRAWN BY: J. KELLY CHECKED BY: A. GAMBLE SHEET 13 OF 80					

DIRECTION	MILEPOINT	LOCATION CODE (SHEET 2)	SIGN CODE	WIDTH (IN)	HEIGHT (IN)	SHEETING REMARKS	SIGN LEGEND	NEW SIGNS		EXISTING SIGNS				EXIST POST		NUMBER OF NEW POSTS	SQUARE STEEL (IN)			TUBULAR STEEL Ø (IN)				SIGN FRAME REQUIRED	REMARKS	SIGN DETAIL LOCATION			
								"A"	"B"	RETAIN	SALVAGE FROM	SALVAGE TO	REMOVE	RETAIN	REMOVE		1.75	2.00	2.50	FOUNDATION	3.0	3.50	4.00			5.00	SHSM	PROJECT SHEET #	STANDARD SHEET #
																	(LB / FT)				(LB / FT)								
																	1.88	2.42	3.35		7.6	9.00	10.80			14.60			
WOODFORD EB							FY-FLUORESCENT YELLOW FYG-FLUORESCENT YELLOW GREEN															"SHSM"-STANDARD HIGHWAY SIGNS AND MARKINGS							
EB	2.918	B	W1-6	48	24		RIGHT LARGE ARROW			1				X															
EB	2.968	B	W1-6	48	24		RIGHT LARGE ARROW			1				X															
EB	3.018	B	W1-6	48	24		RIGHT LARGE ARROW			1				X															
EB	3.048	B	W1-6	48	24		RIGHT LARGE ARROW			1				X															
EB	3.060	A	R4-3	24	30							1		X															
		A	R4-3	24	30		SLOWER TRAFFIC KEEP RIGHT	5.00								1	X						INSTALL ON WEST SIDE OF UTILITY POLE.	X					
EB	3.069	B	W1-6	48	24		RIGHT LARGE ARROW			1				X															
EB	3.336	B	W1-1R	48	48		RIGHT TURN			1				X															
		B	VW-527	30	24		TRUCKS 25 MPH			1																			
		B	W16-2	30	24		1000 FEET			1																			
EB	3.660	B	W1-6	48	24		RIGHT LARGE ARROW			1				X															
EB	3.708	B	W1-6	48	24		RIGHT LARGE ARROW			1				X															
EB	3.755	B	W1-6	48	24		RIGHT LARGE ARROW			1				X															
EB	3.986	A	M3-2	24	12							1	X																
		A	M1-5	24	24							1																	
SIGN SUMMARY SHEET							SHEET TOTALS	5.00	0.00	11	0	0	3	0	0	1	15		0	0.0	0.0	0.0	0.0	PROJECT NAME: WOODFORD-MARLBORO					
								SF	SF	EA	EA	EA	EA	EA	EA	EA		FT		EA	LB	LB	LB	LB	PROJECT NUMBER: STPG SIGN(35)				
																									FILE NAME: 10B336				
							VERMONT AGENCY OF TRANSPORTATION																			PROJECT MANAGER: A. GAMBLE			
TOWN DIRECTIONAL TOTALS																						DESIGNED BY: J. KELLY							
							310.4	0.0	28.0	0.0	0.0	61	0.0	0.0	52	780.0		0	0.0		WOODFORD EB SHEET 5								
																						PLOT DATE: 4/10/2012							
																						DRAWN BY: J. KELLY							
																						CHECKED BY: A. GAMBLE							
																						SHEET 14 OF 80							

DIRECTION	MILEPOINT	LOCATION CODE (SHEET 2)	SIGN CODE	WIDTH (IN)	HEIGHT (IN)	SHEETING REMARKS	SIGN LEGEND	NEW SIGNS		EXISTING SIGNS				EXIST POST		NUMBER OF NEW POSTS	SQUARE STEEL (IN)			TUBULAR STEEL Ø (IN)				SIGN FRAME REQUIRED	REMARKS	SIGN DETAIL LOCATION					
								"A"	"B"	RETAIN	SALVAGE FROM	SALVAGE TO	REMOVE	RETAIN	REMOVE		1.75	2.00	2.50	FOUNDATION	3.0	3.50	4.00			5.00	SHSM	PROJECT SHEET #	STANDARD SHEET #		
																	(LB / FT)				(LB / FT)										
																	1.88	2.42	3.35		7.6	9.00	10.80			14.60					
WOODFORD EB						FY-FLUORESCENT YELLOW FYG-FLUORESCENT YELLOW GREEN																"SHSM"-STANDARD HIGHWAY SIGNS AND MARKINGS									
		A	M3-2	24	12			2.00						X						RETAIN POST					RETAIN POST		E-136B				
		A	M1-5	24	24			4.00																		E-136B					
		A	VM-120	18	24		MOLLY STARK BYWAY 			I 1																					
EB	4.139	B	W1-13	48	48		ROLLING TRUCK CURVE			1				X																	
		B	VW-224P	66	18		1 MILE AHEAD			1																					
EB	4.208	A	VD-062B	72	16		BUSINESS SIGN			1				X																	
EB	4.295	A	VD-062BC	74.75	16		BUSINESS SIGN			1				X																	
		A	VD-062C	74.75	16		BUSINESS SIGN			1																					
EB	4.584	A	W1-2L	30	30		LEFT CURVE						1		X																
		A	W13-1	18	18		40 MPH ADVISORY						1																		
EB	4.616	A	R4-3	24	30		SLOWER TRAFFIC KEEP RIGHT (SIGN MISSING)						1		X																
EB	4.691	A	W9-1	36	36		RIGHT LANE ENDS			1				X																	
EB	4.748	A	W4-2R	36	36		RIGHT LANE MERGE SYMBOL			1				X																	
EB	4.856 - 4.996	A/B		6	8		DELINEATORS - SEE TABLE ON SHEET 5									I4				PAID EACH				INSTALL BACK TO BACK WHITE DELINEATORS FROM EAST END OF RAIL TO SKI AREA DRIVE.		ITEM 676.0					
EB	5.234	A	R2-1	24	30								1		X																
SIGN SUMMARY SHEET							SHEET TOTALS		6.00	0.00	8	0	0	4	0	0	0	0			0	0.0	0.0	0.0	PROJECT NAME: WOODFORD-MARLBORO						
									SF	SF	EA	EA	EA	EA	EA	EA	EA		FT		EA	LB	LB	LB	LB	PROJECT NUMBER: STPG SIGN(35)					
																										FILE NAME: 10B336			PLOT DATE: 4/10/2012		
							VERMONT AGENCY OF TRANSPORTATION																				PROJECT MANAGER: A. GAMBLE			DRAWN BY: J. KELLY	
							TOWN DIRECTIONAL TOTALS		310.4	0.0	28.0	0.0	0.0	61	0.0	0.0	52	780.0			0	0.0				DESIGNED BY: J. KELLY			CHECKED BY: A. GAMBLE		
																								WOODFORD EB SHEET 6			SHEET 15 OF 80				

DIRECTION	MILEPOINT	LOCATION CODE (SHEET 2)	SIGN CODE	WIDTH (IN)	HEIGHT (IN)	SHEETING REMARKS	SIGN LEGEND	NEW SIGNS		EXISTING SIGNS				EXIST POST		NUMBER OF NEW POSTS	SQUARE STEEL (IN)			TUBULAR STEEL Ø (IN)				SIGN FRAME REQUIRED	REMARKS	SIGN DETAIL LOCATION			
								"A"	"B"	RETAIN	SALVAGE FROM	SALVAGE TO	REMOVE	RETAIN	REMOVE		1.75	2.00	2.50	FOUNDATION	3.0	3.50	4.00			5.00	SHSM	PROJECT SHEET #	STANDARD SHEET #
																	(LB / FT)				(LB / FT)								
																	1.88	2.42	3.35		7.6	9.00	10.80			14.60			
WOODFORD EB							FY-FLUORESCENT YELLOW FYG-FLUORESCENT YELLOW GREEN															"SHSM"-STANDARD HIGHWAY SIGNS AND MARKINGS							
		A	R2-1	24	30		 	5.00			I	I	I			1		X							X	R/S MM			
EB	5.512	A	VW-060	30	30		HIDDEN DRIVES						1		X														
EB	5.526	A	VW-060	30	30			6.25								1		X						INSTALL 75 FEET EAST OF EXISTING HIDDEN DRIVES SIGN.		8			
EB	5.802	A	M3-2	24	12			2.00								1		X						INSTALL ASSEMBLY ⁵⁰ 30 FEET WEST OF CURRENT LOCATION.			E-136B		
		A	M1-5	24	24			4.00																		E-136B			
EB	5.808	A	M3-2	24	12		EAST						1		X														
		A	M1-5	24	24		VERMONT ROUTE 9						1																
EB	5.911	A	VW-205	36	36								1		X														
		A	VW-205	36	36	FY		9.00								2		X							8				
EB	5.994	A	S3-1	30	30		SCHOOL BUS STOP AHEAD 						1		X														
		A	S3-1	36	36	FYG		9.00			I	I	I			2		X							X				
EB	6.371	A	W1-4L	30	30		LEFT REVERSE CURVE						1		X														
EB	6.447	A	W1-4L	30	30			6.25								1		X						INSTALL ³⁷⁵ 400 FEET EAST OF EXISTING LEFT REVERSE CURVE SIGN.	X				
EB	6.540	A	VW-054R	30	30		HIDDEN DRIVE RIGHT						1		X														
EB	6.785	A	VW-054R	30	30								1		X														
SIGN SUMMARY SHEET							SHEET TOTALS	41.50	0.00	0	² 0	² 0	¹⁰ 8	0	0	8	120			0	0.0	0.0	0.0	0.0	PROJECT NAME: WOODFORD-MARLBORO				
								SF	SF	EA	EA	EA	EA	EA	EA	EA		FT		EA	LB	LB	LB	LB	PROJECT NUMBER: STPG SIGN(35)				
																									FILE NAME: 10B336				
							VERMONT AGENCY OF TRANSPORTATION																					PROJECT MANAGER: A. GAMBLE	
																							DESIGNED BY: J. KELLY						
																							WOODFORD EB SHEET 7						
																							PLOT DATE: 4/10/2012						
																							DRAWN BY: J. KELLY						
																							CHECKED BY: A. GAMBLE						
																							SHEET 16 OF 80						

DIRECTION	MILEPOINT	LOCATION CODE (SHEET 2)	SIGN CODE	WIDTH (IN)	HEIGHT (IN)	SHEETING REMARKS	SIGN LEGEND	NEW SIGNS		EXISTING SIGNS				EXIST POST		NUMBER OF NEW POSTS	SQUARE STEEL (IN)			TUBULAR STEEL Ø (IN)				SIGN FRAME REQUIRED	REMARKS	SIGN DETAIL LOCATION			
								"A"	"B"	RETAIN	SALVAGE FROM	SALVAGE TO	REMOVE	RETAIN	REMOVE		1.75	2.00	2.50	FOUNDATION	3.0	3.50	4.00			5.00	SHSM	PROJECT SHEET #	STANDARD SHEET #
																	(LB / FT)				(LB / FT)								
																	1.88	2.42	3.35		7.6	9.00	10.80			14.60			
WOODFORD EB							FY-FLUORESCENT YELLOW FYG-FLUORESCENT YELLOW GREEN															"SHSM"-STANDARD HIGHWAY SIGNS AND MARKINGS							
		A	VW-054R	30	30			6.25							1		X								8				
EB	7.000	A	VW-000	30	30			6.25							1		X						INSTALL NEW AT POLE #2/199/20T		8				
		A	W7-3A	24	18			3.00																X					
EB	7.174	A	VW-054									1		X															
		A	VW-054R	30	30			6.25							1		X								8				
EB	7.360	A	VW-054R	30	30		HIDDEN DRIVES RIGHT (SIGN IS MISSING)						+		X										NOTHING THERE				
EB	7.375	A	VW-054R	30	30			6.25							1		X						INSTALL 80 FEET EAST OF EXISTING HIDDEN DRIVE RIGHT SIGN.		8				
EB	8.100	A	R3-9CP	30	12			2.50							1		X						INSTALL 160 FEET WEST OF EXISTING BEGIN NO PARKING ASSEMBLY.	X					
		A	R8-3A	24	24			4.00																X					
EB	8.131	A	R3-9CP	24	12		BEGIN						1		X														
		A	R8-3A	24	24		NO PARKING SYMBOL						1																
EB	8.147	A	W11-2	30	30								1		X														
		A	W11-2	30	30	FYG		6.25							1		X							X					
		A	W16-4P	30	24	FYG		5.00																X					
EB	8.192	A	R8-3A	24	24		NO PARKING ASSEMBLY IS MISSING						+		X										NOTHING THERE				
SIGN SUMMARY SHEET							SHEET TOTALS	45.75	0.00	0	0	0	+	0	0	6	90			0	0.0	0.0	0.0	0.0	PROJECT NAME: WOODFORD-MARLBORO				
								SF	SF	EA	EA	EA	EA	EA	EA	EA		FT		EA	LB	LB	LB	LB	PROJECT NUMBER: STPG SIGN(35)				
																									FILE NAME: 10B336				
							VERMONT AGENCY OF TRANSPORTATION																					PROJECT MANAGER: A. GAMBLE	
TOWN DIRECTIONAL TOTALS																							DESIGNED BY: J. KELLY						
																									WOODFORD EB SHEET 8				
																						PLOT DATE: 4/10/2012							
																							DRAWN BY: J. KELLY						
																							CHECKED BY: A. GAMBLE						
																							SHEET 17 OF 80						

DIRECTION	MILEPOINT	LOCATION CODE (SHEET 2)	SIGN CODE	WIDTH (IN)	HEIGHT (IN)	SHEETING REMARKS	SIGN LEGEND	NEW SIGNS		EXISTING SIGNS				EXIST POST		NUMBER OF NEW POSTS	SQUARE STEEL (IN)			TUBULAR STEEL Ø (IN)				SIGN FRAME REQUIRED	REMARKS	SIGN DETAIL LOCATION			
								"A"	"B"	RETAIN	SALVAGE FROM	SALVAGE TO	REMOVE	RETAIN	REMOVE		1.75	2.00	2.50	FOUNDATION	3.0	3.50	4.00			5.00	SHSM	PROJECT SHEET #	STANDARD SHEET #
																	(LB / FT)				(LB / FT)								
																	1.88	2.42	3.35		7.6	9.00	10.80			14.60			
WOODFORD EB							FY-FLUORESCENT YELLOW FYG-FLUORESCENT YELLOW GREEN															"SHSM"-STANDARD HIGHWAY SIGNS AND MARKINGS							
		A	R8-3A	24	24			4.00							1		X							X					
EB	8.246	A	R8-3A	24	24						I	I	I		X														
		A	R8-3A	24	24			4.00							1		X							X					
		A	W11A-2	30	30		PEDESTRIAN WITH CROSSWALK						1		X														
EB	8.260	C	VR-017	24	30								I		X														
		C	VR-020	24	30								I																
		C	VR-017	24	30			5.00							1		X			RETAIN POST					RETAIN POSTS				
		C	VR-020	24	30			5.00																	7				
EB	8.264	D	R1-1	30	30								1		X														
		D	R1-1	30	30			6.25							1		X							X					
EB	8.283	A	R8-3A	24	24		NO PARKING SIGN ASSEMBLY IS MISSING.								X										NOTHING THERE				
		A	R8-3A	24	24			4.00							1		X							X					
EB	8.323	A	VD-537	30	18		RECREATION PARKING (UP)						1		X														
EB	8.351	A	VW-054L	30	30		HIDDEN DRIVE LEFT						1		X														
EB	8.365	A	D4-1L	30	24			5.00							1		X							INSTALL 75 FEET EAST OF EXISTING HIDDEN DRIVE LEFT SIGN.	X				
SIGN SUMMARY SHEET							SHEET TOTALS	33.25	0.00	2				0	0	6	90			0	0.0	0.0	0.0	0.0	PROJECT NAME: WOODFORD-MARLBORO				
								SF	SF	EA	EA	EA	EA	EA	EA	EA		FT		EA	LB	LB	LB	LB	PROJECT NUMBER: STPG SIGN(35)				
																											FILE NAME: 10B336		
							VERMONT AGENCY OF TRANSPORTATION																					PROJECT MANAGER: A. GAMBLE	
																							PLOT DATE: 4/10/2012						
																							DRAWN BY: J. KELLY						
																							CHECKED BY: A. GAMBLE						
							TOWN DIRECTIONAL TOTALS	310.4	0.0	28.0	0.0	0.0	61	0.0	0.0	52	780.0			0	0.0				DESIGNED BY: J. KELLY				
																							WOODFORD EB SHEET 9						
																							SHEET 18 OF 80						

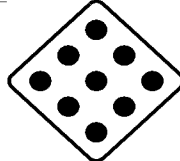
DIRECTION	MILEPOINT	LOCATION CODE (SHEET 2)	SIGN CODE	WIDTH (IN)	HEIGHT (IN)	SHEETING REMARKS	SIGN LEGEND	NEW SIGNS		EXISTING SIGNS				EXIST POST		NUMBER OF NEW POSTS	SQUARE STEEL (IN)			TUBULAR STEEL Ø (IN)				SIGN FRAME REQUIRED	REMARKS	SIGN DETAIL LOCATION			
								"A"	"B"	RETAIN	SALVAGE FROM	SALVAGE TO	REMOVE	RETAIN	REMOVE		1.75	2.00	2.50	FOUNDATION	3.0	3.50	4.00			5.00	SHSM	PROJECT SHEET #	STANDARD SHEET #
																	(LB / FT)				(LB / FT)								
																	1.88	2.42	3.35		7.6	9.00	10.80			14.60			
WOODFORD EB						FY-FLUORESCENT YELLOW FYG-FLUORESCENT YELLOW GREEN																"SHSM"-STANDARD HIGHWAY SIGNS AND MARKINGS							
EB	8.375	A	VD-537	30	18		RECREATION PARKING (LEFT)						1		X														
		B	VD-537	30	18		RECREATION PARKING (RIGHT)						1																
EB	8.400	A	R3-9DP	30	12		END	2.50							1		X							INSTALL AT END OF GUARDRAIL AND WEST OF MAILBOXES (60 FEET WEST OF EXISTING).	X				
		A	R8-3A	24	24			4.00																	X				
EB	8.412	A	R8-3A	24	24		END						1		X														
		A	M4-6P	24	12		NO PARKING SYMBOL						1																
EB	8.436	A	VW-205	30	30		WATCH FOR TURNING VEHICLES						1		X														
EB	8.477	A	VD-062BRN	72	16		BUSINESS SIGN			1				X															
EB	9.118	C	VR-017	24	30		POST PRESENT BUT NO SIGN.						1		X														
		C	VR-017	24	30			5.00								1		X						GEORGE D AIKEN WILDERNESS RD		7			
EB	9.122	D	R1-1	30	30								1		X									GEORGE D AIKEN WILDERNESS RD					
		D	R1-1	30	30			6.25								1		X							X				
EB	9.213	A	VW-000	30	30		MOOSE CROSSING			1				X															
		A	W7-3aP	24	18		NEXT 2 MILES			1																			
EB	9.304	A	R2-1	24	30			5.00								1		X						INSTALL AT BEGINNING OF EAST BOUND MARKED PASSING ZONE.	X				
SIGN SUMMARY SHEET							SHEET TOTALS		22.75	0.00	3	0	0	87	0	0	4	60		0	0.0	0.0	0.0	0.0	PROJECT NAME: WOODFORD-MARLBORO				
									SF	SF	EA	EA	EA	EA	EA	EA	EA		FT		EA	LB	LB	LB	LB	PROJECT NUMBER: STPG SIGN(35)			
																											FILE NAME: 10B336		
																											DRAWN BY: J. KELLY		
VERMONT AGENCY OF TRANSPORTATION							TOWN DIRECTIONAL TOTALS		310.4	0.0	28.0	0.0	0.0	61	0.0	0.0	52	780.0		0	0.0				DESIGNED BY: J. KELLY				
																							WOODFORD EB SHEET 10						
																							PLOT DATE: 4/10/2012						
																							CHECKED BY: A. GAMBLE						
																							SHEET 19 OF 80						

DIRECTION	MILEPOINT	LOCATION CODE (SHEET 2)	SIGN CODE	WIDTH (IN)	HEIGHT (IN)	SHEETING REMARKS	SIGN LEGEND	NEW SIGNS		EXISTING SIGNS				EXIST POST		NUMBER OF NEW POSTS	SQUARE STEEL (IN)			TUBULAR STEEL Ø (IN)				SIGN FRAME REQUIRED	REMARKS	SIGN DETAIL LOCATION			
								"A"	"B"	RETAIN	SALVAGE FROM	SALVAGE TO	REMOVE	RETAIN	REMOVE		1.75	2.00	2.50	FOUNDATION	3.0	3.50	4.00			5.00	SHSM	PROJECT SHEET #	STANDARD SHEET #
																	(LB / FT)				(LB / FT)								
																	1.88	2.42	3.35		7.6	9.00	10.80			14.60			
WOODFORD EB							FY-FLUORESCENT YELLOW FYG-FLUORESCENT YELLOW GREEN															"SHSM"-'STANDARD HIGHWAY SIGNS AND MARKINGS							
EB	9.561	A	R2-1	24	30		SPEED LIMIT 50						1		X														
SIGN SUMMARY SHEET							SHEET TOTALS	0.00	0.00	0	0	0	1	0	0	0	0		0	0.0	0.0	0.0	0.0	PROJECT NAME: WOODFORD-MARLBORO					
								SF	SF	EA	EA	EA	EA	EA	EA	EA	FT		EA	LB	LB	LB	LB	PROJECT NUMBER: STPG SIGN(35)					
																								FILE NAME: 10B336			PLOT DATE: 4/10/2012		
							VERMONT AGENCY OF TRANSPORTATION	TOWN DIRECTIONAL TOTALS	310.4	0.0	28.0	0.0	0.0	61	0.0	0.0	52	780.0		0	0.0				PROJECT MANAGER: A. GAMBLE			DRAWN BY: J. KELLY	
																						DESIGNED BY: J. KELLY			CHECKED BY: A. GAMBLE				
																						WOODFORD EB SHEET 11			SHEET 20 OF 80				

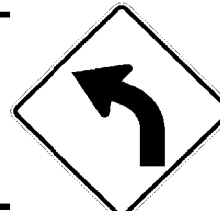
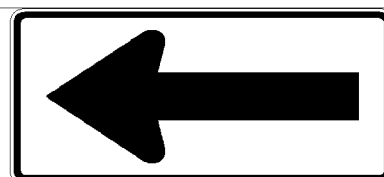
DIRECTION	MILEPOINT	LOCATION CODE (SHEET 2)	SIGN CODE	WIDTH (IN)	HEIGHT (IN)	SHEETING REMARKS	SIGN LEGEND	NEW SIGNS		EXISTING SIGNS				EXIST POST		NUMBER OF NEW POSTS	SQUARE STEEL (IN)			TUBULAR STEEL Ø (IN)				SIGN FRAME REQUIRED	REMARKS	SIGN DETAIL LOCATION			
								"A"	"B"	RETAIN	SALVAGE FROM	SALVAGE TO	REMOVE	RETAIN	REMOVE		1.75	2.00	2.50	FOUNDATION	3.0	3.50	4.00			5.00	SHSM	PROJECT SHEET #	STANDARD SHEET #
																	(LB / FT)				(LB / FT)								
																	1.88	2.42	3.35		7.6	9.00	10.80			14.60			
WOODFORD WB							FY-FLUORESCENT YELLOW FYG-FLUORESCENT YELLOW GREEN															"SHSM"-STANDARD HIGHWAY SIGNS AND MARKINGS							
WB	9.561	F	R2-1	24	30		SPEED LIMIT 50			1				X															
WB	9.221	F	W11-6H	30	30		SNOWMOBILE CROSSING SIGN						+		X								REMOVE SIGNAGE DUE TO ADEQUATE SSD.		NO SIGN OR POST				
		F	W16-4P	30	24		NEXT 500 FEET						1		X														
WB	9.092	F					EMPTY POST						1		X								REMOVE EMPTY POST.						
WB	8.882	F	VD-062BRN	72	16		BUSINESS SIGN			1				X															
WB	8.544 8.629	F	VW-205	36	36		WATCH FOR TURNING VEHICLES	9.00								2		X						MOVED 450' EAST INSTALL ACROSS FROM DRY HYDRANT PIPE.		8			
WB	8.497	F	VD-537	30	18		RECREATION PARKING						1		X														
		F	VD-411	12	18		STATE PARK AHEAD						1																
		F	W11-2	30	30	FYG	WATCH FOR TURNING VEHICLES AHEAD	6.25								1		X							X				
		F	W16-9P	24	12	FYG		2.00																X					
WB	8.441	F	VW-205	36	36		WATCH FOR TURNING VEHICLES (MISSING SIGN) 0090 0217 0840						1		X										REINSTALL MM				
		F	D4-1R	30	24		PARKING 400 FEET	5.00								1		X							X				
		F	VD4-1	30	12			2.50																	6				
WB	8.413	F	R8-3A	24	24		NO PARKING SYMBOL						1		X														
		F	VR-644P	24	12		BEGIN						1																
SIGN SUMMARY SHEET							SHEET TOTALS	24.75	0.00	2	2	2	7	0	0	4	60			0	0.0	0.0	0.0	0.0	PROJECT NAME: WOODFORD-MARLBORO PROJECT NUMBER: STPG SIGN(35) FILE NAME: 10B336 PROJECT MANAGER: A. GAMBLE DESIGNED BY: J. KELLY WOODFORD WB SHEET 1 PLOT DATE: 4/10/2012 DRAWN BY: J. KELLY CHECKED BY: A. GAMBLE SHEET 21 OF 80				
								SF	SF	EA	EA	EA	EA	EA	EA	EA		FT		EA	LB	LB	LB	LB					
VERMONT AGENCY OF TRANSPORTATION							TOWN DIRECTIONAL TOTALS	260.8	0.0	9.0	4.0	4.0	60	0.0	0.0	48	720.0			0	0.0								

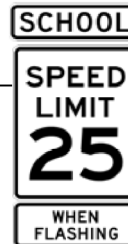
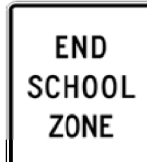
DIRECTION	MILEPOINT	LOCATION CODE (SHEET 2)	SIGN CODE	WIDTH (IN)	HEIGHT (IN)	SHEETING REMARKS	SIGN LEGEND	NEW SIGNS		EXISTING SIGNS				EXIST POST		NUMBER OF NEW POSTS	SQUARE STEEL (IN)			TUBULAR STEEL Ø (IN)					SIGN FRAME REQUIRED	REMARKS	SIGN DETAIL LOCATION			
								"A"	"B"	RETAIN	SALVAGE FROM	SALVAGE TO	REMOVE	RETAIN	REMOVE		1.75	2.00	2.50	FOUNDATION	3.0	3.50	4.00	5.00			SHSM	PROJECT SHEET #	STANDARD SHEET #	
																	(LB / FT)				(LB / FT)									
																	1.88	2.42	3.35		7.6	9.00	10.80	14.60						
WOODFORD WB							FY-FLUORESCENT YELLOW FYG-FLUORESCENT YELLOW GREEN															"SHSM"-STANDARD HIGHWAY SIGNS AND MARKINGS								
		F	W11-2	30	30		PEDESTRIAN						1																	
WB	8.413 8.400	F	R3-9cP	30	12			2.50							1		X							INSTALL 70 FEET WEST OF EXISTING NO PARKING ASSEMBLY AND AT EDGE OF DRIVEWAY.	X		INTALLED IN EXISTING LOCATION			
		F	R8-3	24	24			4.00									USE OLD ANCHOR								X					
WB	8.367	F	D4-1	30	24			5.00							1		X							INSTALL ON WESTERLY SIDE OF DRIVE FOR PARKING AREA.	X		MOVED EAST OF SIDE DRIVE			
WB	8.322	F	R8-3A	24	24							1		X																
		F	R8-3	24	24			4.00							1		X								X					
WB	8.189	F	R8-3A	24	24							1		X																
		F	R8-3	24	24			4.00							1		X								X					
WB	8.120	F	R8-3A	24	24		NO PARKING SYMBOL						1		X															
		F	M4-6P	24	12		END						1																	
EB	8.100	A	R3-9dP	30	12			2.50							1		X							INSTALL 100+/- FEET WEST OF EXISTING END NO PARKING ASSEMBLY. SHOULD BE DIRECTLY ACROSS FROM NEW BEGIN NO PARKING ASSEMBLY.	X					
		A	R8-3	24	24			4.00																	X					
WB	7.655	G	VR-023B	24	30		\$500 FINE FOR THROWING TRASH			1				X																
WB	6.915	F	W1-4L	30	30		LEFT REVERSE CURVE						1		X															
		F	W13-1	18	18		40 MPH ADVISORY						1																	
SIGN SUMMARY SHEET							SHEET TOTALS	26.00	0.00	1	0	0	7	0	0	5	75			0	0.0	0.0	0.0	0.0	PROJECT NAME: WOODFORD-MARLBORO PROJECT NUMBER: STPG SIGN(35)					
								SF	SF	EA	EA	EA	EA	EA	EA	EA		FT		EA	LB	LB	LB	LB						
							VERMONT AGENCY OF TRANSPORTATION							TOWN DIRECTIONAL TOTALS	260.8	0.0	9.0	4.0	4.0	60	0.0	0.0	48	720.0			0	0.0		

DIRECTION	MILEPOINT	LOCATION CODE (SHEET 2)	SIGN CODE	WIDTH (IN)	HEIGHT (IN)	SHEETING REMARKS	SIGN LEGEND	NEW SIGNS		EXISTING SIGNS				EXIST POST		NUMBER OF NEW POSTS	SQUARE STEEL (IN)			TUBULAR STEEL Ø (IN)				SIGN FRAME REQUIRED	REMARKS	SIGN DETAIL LOCATION			
								"A"	"B"	RETAIN	SALVAGE FROM	SALVAGE TO	REMOVE	RETAIN	REMOVE		1.75	2.00	2.50	FOUNDATION	3.0	3.50	4.00			5.00	SHSM	PROJECT SHEET #	STANDARD SHEET #
																	(LB / FT)				(LB / FT)								
																	1.88	2.42	3.35		7.6	9.00	10.80			14.60			
WOODFORD WB							FY-FLUORESCENT YELLOW FYG-FLUORESCENT YELLOW GREEN															"SHSM"-STANDARD HIGHWAY SIGNS AND MARKINGS							
WB	6.868	F	W1-4L	30	30			6.25							1		X						INSTALL 250 FEET WEST OF EXISTING LEFT REVERSE CURVE ASSEMBLY.	X					
		F	W13-1	18	18			2.25																X	INSTALLED 40 MPH				
WB	6.825	F	S3-1	36	36	FYG		9.00							2		X						INSTALL 200 FEET IN ADVANCE OF EXISTING HIDDEN DRIVE RIGHT ASSEMBLY.	X					
WB	6.799	F	S3-1	30	30		SCHOOL BUS STOP AHEAD						1		X														
WB	6.787	F	VW-054R	30	30		HIDDEN DRIVE RIGHT						1		X														
		F	VW-054R	30	30		 	6.25			I	I	I			1		X							R/S MM 8				
WB	6.329	F	VW-133R	30	30		HIDDEN DRIVES RIGHT			1				X															
WB	6.200	F	S3-1	30	30								1		X														
		F	S3-1	36	36	FYG	 	9.00			I	I	I			2		X							X	R/S MM			
WB	5.825	F	S3-1	30	30								1		X														
		F	S3-1	36	36	FYG		9.00							2		X							X					
WB	5.573	F	VD-062B	72	16		BUSINESS SIGN			1				X															
WB	5.403	F	VD-062C	74.75	16		BUSINESS SIGN				1	1	1		X	2		X					REMOVE 4 LB/FT FLANGED CHANNEL POSTS. REINSTALL SIGNS ON NEW POSTS.						
		F	VD-062BC	74.75	16						1	1	1																
WB	5.360	F	VW-054R	30	30		HIDDEN DRIVE RIGHT				I	I	I		X									R/S MM					
SIGN SUMMARY SHEET							SHEET TOTALS	41.75	0.00	2	5 2	5 2	10 7	0	0	10	150			0	0.0	0.0	0.0	0.0	PROJECT NAME: WOODFORD-MARLBORO				
								SF	SF	EA	EA	EA	EA	EA	EA	EA		FT		EA	LB	LB	LB	LB	PROJECT NUMBER: STPG SIGN(35)				
																									FILE NAME: 10B336				
							VERMONT AGENCY OF TRANSPORTATION																					PROJECT MANAGER: A. GAMBLE	
TOWN DIRECTIONAL TOTALS																							DESIGNED BY: J. KELLY						
																									WOODFORD WB SHEET 3				
																						PLOT DATE: 4/10/2012							
																							DRAWN BY: J. KELLY						
																							CHECKED BY: A. GAMBLE						
																							SHEET 23 OF 80						

DIRECTION	MILEPOINT	LOCATION CODE (SHEET 2)	SIGN CODE	WIDTH (IN)	HEIGHT (IN)	SHEETING REMARKS	SIGN LEGEND	NEW SIGNS		EXISTING SIGNS				EXIST POST		NUMBER OF NEW POSTS	SQUARE STEEL (IN)			TUBULAR STEEL Ø (IN)				SIGN FRAME REQUIRED	REMARKS	SIGN DETAIL LOCATION			
								"A"	"B"	RETAIN	SALVAGE FROM	SALVAGE TO	REMOVE	RETAIN	REMOVE		1.75	2.00	2.50	FOUNDATION	3.0	3.50	4.00			5.00	SHSM	PROJECT SHEET #	STANDARD SHEET #
																	(LB / FT)				(LB / FT)								
																	1.88	2.42	3.35		7.6	9.00	10.80			14.60			
WOODFORD WB						FY-FLUORESCENT YELLOW FYG-FLUORESCENT YELLOW GREEN																"SHSM"-STANDARD HIGHWAY SIGNS AND MARKINGS							
		F	VW-133R	30	30			6.25							1	X									8				
						SKIP TO TRUCK RAMP DUE TO RECENT SIGN REPLACEMENTS																							
WB	3.300	F	R3-9cP	30	12		 	2.50							1	X							INSTALL 100 FEET EAST OF EXISTING BEGIN NO PARKING SIGN ASSEMBLY.	X					
		F	R8-3	24	24			4.00															X						
WB	3.280	F	VR-644P	24	12		BEGIN						1		X														
		F	R8-3A	24	24		NO PARKING						1																
WB	3.254	F	OM1-1	18	18								1		X														
		F	OM1-1	18	18			2.25							1	X							X						
WB	3.251	F	W7-4B	78	60		RUNAWAY TRUCK RAMP(UP 45 RIGHT ARROW)			1				X															
WB	3.239	F	M4-6P	24	12								1		X														
		F	R8-3A	24	24								1																
		F	R3-9dP	30	12		 	2.50							1	X							X						
		F	R8-3	24	24			4.00															X						
WB	3.162	F	W1-1R	48	48		RIGHT TURN			1				X															
		F	VW-527	30	24		TRUCKS 25 MPH			1																			
SIGN SUMMARY SHEET							SHEET TOTALS		21.50	0.00	3	0	0	5	0	0	4	60		0	0.0	0.0	0.0	0.0	PROJECT NAME: WOODFORD-MARLBORO				
									SF	SF	EA	EA	EA	EA	EA	EA	EA	FT	EA	LB	LB	LB	LB	PROJECT NUMBER: STPG SIGN(35)					
																									FILE NAME: 10B336				
VERMONT AGENCY OF TRANSPORTATION							TOWN DIRECTIONAL TOTALS		260.8	0.0	9.0	4.0	4.0	60	0.0	0.0	48	720.0	0			0.0		PLOT DATE: 4/10/2012					
																									DRAWN BY: J. KELLY				
																						CHECKED BY: A. GAMBLE							
																						WOODFORD WB SHEET 4							
																						SHEET 24 OF 80							

DIRECTION	MILEPOINT	LOCATION CODE (SHEET 2)	SIGN CODE	WIDTH (IN)	HEIGHT (IN)	SHEETING REMARKS	SIGN LEGEND	NEW SIGNS		EXISTING SIGNS				EXIST POST		NUMBER OF NEW POSTS	SQUARE STEEL (IN)			TUBULAR STEEL Ø (IN)				SIGN FRAME REQUIRED	REMARKS	SIGN DETAIL LOCATION			
								"A"	"B"	RETAIN	SALVAGE FROM	SALVAGE TO	REMOVE	RETAIN	REMOVE		1.75	2.00	2.50	FOUNDATION	3.0	3.50	4.00			5.00	SHSM	PROJECT SHEET #	STANDARD SHEET #
																	(LB / FT)				(LB / FT)								
																	1.88	2.42	3.35		7.6	9.00	10.80			14.60			
WOODFORD WB							FY-FLUORESCENT YELLOW FYG-FLUORESCENT YELLOW GREEN															"SHSM"-STANDARD HIGHWAY SIGNS AND MARKINGS							
WB	3.100	F	VW-285	30	30		FALLING ROCK			1				X															
WB	2.843	F	OM-3R	12	36								1	X	X														
		F	OM3-R	12	36			3.00								1	X			RETAIN POST					X	RETAIN POST			
WB	2.793	E	OM-3L	12	36								1		X														
		E	OM3-L	12	36			3.00								1	RETAIN ANCHOR X								X	RETAIN ANCHOR			
WB	2.680	F	W11-2	30	30										1		X												
		F	W16-9	24	10																								
		F	W11-2	30	30	FYG		6.25									1	X								X			
		F	W16-9P	24	12 10	FYG		2.00 1.67																		X			
WB	2.570	F	W11-2	30	30										1		X												
		F	W16-7	24	12																								
		F	W11-2	30	30	FYG		6.25									1	X								X			
		A	W16-4P	30	24	FYG		5.00																		X			
WB	2.534	F	D4-1R	30	24			5.00								1	X								INSTALL IN LINE WITH NATIONAL FOREST WOODEN SIGN.	X			
WB	2.519	F	D4-1	30	24		PARKING RIGHT ARROW								1	X													
SIGN SUMMARY SHEET							SHEET TOTALS	30.50 30.17	0.00	1	0	0	7	0	0	5	75			0	0.0	0.0	0.0	0.0	PROJECT NAME: WOODFORD-MARLBORO				
								SF	SF	EA	EA	EA	EA	EA	EA	EA		FT		EA	LB	LB	LB	LB	PROJECT NUMBER: STPG SIGN(35)				
																									FILE NAME: 10B336				
VERMONT AGENCY OF TRANSPORTATION							TOWN DIRECTIONAL TOTALS	260.8	0.0	9.0	4.0	4.0	60	0.0	0.0	48	720.0			0	0.0				PLOT DATE: 4/10/2012				
																									DRAWN BY: J. KELLY				
																									DESIGNED BY: J. KELLY				
																						CHECKED BY: A. GAMBLE							
																							WOODFORD WB SHEET 5						
																							SHEET 25 OF 80						

DIRECTION	MILEPOINT	LOCATION CODE (SHEET 2)	SIGN CODE	WIDTH (IN)	HEIGHT (IN)	SHEETING REMARKS	SIGN LEGEND	NEW SIGNS		EXISTING SIGNS				EXIST POST		NUMBER OF NEW POSTS	SQUARE STEEL (IN)			TUBULAR STEEL Ø (IN)				SIGN FRAME REQUIRED	REMARKS	SIGN DETAIL LOCATION			
								"A"	"B"	RETAIN	SALVAGE FROM	SALVAGE TO	REMOVE	RETAIN	REMOVE		1.75	2.00	2.50	FOUNDATION	3.0	3.50	4.00			5.00	SHSM	PROJECT SHEET #	STANDARD SHEET #
																	(LB / FT)				(LB / FT)								
																	1.88	2.42	3.35		7.6	9.00	10.80			14.60			
WOODFORD WB							FY-FLUORESCENT YELLOW FYG-FLUORESCENT YELLOW GREEN															"SHSM"-STANDARD HIGHWAY SIGNS AND MARKINGS							
WB	2.500	F	W1-2L	30	30		CURVE LEFT						1		X														
		F	W13-1	18	18		45 MPH ADVISORY						1																
WB	2.438	F	W1-2L	30	30	FY		6.25								1		X						INSTALL 325 FEET WEST OF EXISTING LEFT CURVE WARNING SIGN ASSEMBLY.	X				
WB	2.395	F	W1-8L	18	24		CHEVRON						1		X														
WB	2.377	F	W1-8L	18	24		CHEVRON																						
		F	W1-6L	48	24	FY		8.00								2		X								X			
WB	2.355	F	W1-8L	18	24		CHEVRON						1		X														
WB	2.278	F	M3-4	24	12		 	2.00								1		X											E-136B
		F	M1-5	24	24			4.00																					E-136B
		F	M3-4	24	12																								
		F	M1-5	24	24																								
		F	VM-120	18	24		MOLLY STARK BYWAY				1	1	1											REINSTALL ON THE NEW POST BELOW ROUTE MARKER.					
WB	2.165	F	VW-619	30	30								1		X														
		F	VW-619	30	30			6.25									1		X								8		
WB	1.640	F	R2-5A	24	30		REDUCED SPEED AHEAD						1		X														
SIGN SUMMARY SHEET							SHEET TOTALS	26.50	0.00	0	1	1	10 9	0	0	5	75			0	0.0	0.0	0.0	0.0	PROJECT NAME: WOODFORD-MARLBORO				
								SF	SF	EA	EA	EA	EA	EA	EA	EA		FT		EA	LB	LB	LB	LB	PROJECT NUMBER: STPG SIGN(35)				
							VERMONT AGENCY OF TRANSPORTATION																			FILE NAME: 10B336			
							TOWN DIRECTIONAL TOTALS	260.8	0.0	9.0	4.0	4.0	60	0.0	0.0	48	720.0			0	0.0				PROJECT MANAGER: A. GAMBLE				
																								PLOT DATE: 4/10/2012					
																								DRAWN BY: J. KELLY					
																								DESIGNED BY: J. KELLY					
																								CHECKED BY: A. GAMBLE					
																								WOODFORD WB SHEET 6					
																								SHEET 26 OF 80					

DIRECTION	MILEPOINT	LOCATION CODE (SHEET 2)	SIGN CODE	WIDTH (IN)	HEIGHT (IN)	SHEETING REMARKS	SIGN LEGEND	NEW SIGNS		EXISTING SIGNS				EXIST POST		NUMBER OF NEW POSTS	SQUARE STEEL (IN)			TUBULAR STEEL Ø (IN)				SIGN FRAME REQUIRED	REMARKS	SIGN DETAIL LOCATION				
								"A"	"B"	RETAIN	SALVAGE FROM	SALVAGE TO	REMOVE	RETAIN	REMOVE		1.75	2.00	2.50	FOUNDATION	3.0	3.50	4.00			5.00	SHSM	PROJECT SHEET #	STANDARD SHEET #	
																	(LB / FT)				(LB / FT)									
																	1.88	2.42	3.35		7.6	9.00	10.80			14.60				
WOODFORD WB							FY-FLUORESCENT YELLOW FYG-FLUORESCENT YELLOW GREEN															"SHSM"-STANDARD HIGHWAY SIGNS AND MARKINGS								
WB	1.170	F	S1-1	36	36		 T. BUCK WILL INSTALL AT A LATER DATE							X												T. BUCK REMOVED				
		F	S1-1	36	36	FYG		9.00	*							2		X								* T. BUCK WILL INSTALL ONCE BRIDGE IS DONE, GIVEN TO LEE ABLE				
		F	S4-3P	24	8	FYG		1.33	*																	X				
WB	1.126	F	S4-3P	24	8									1	X						RETAIN POST									
		F	R2-1	24	30									1																
		F	S4-4P	24	10									1																
		F	S4-3P	24	8	FYG		1.33																		X				
		F	R2-1	24	30			5.00																		X				
		F	S4-4P	24	10			1.67																		X				
WB	1.053	F	D1-1E	72	20		WOODFORD HOLLOW ELEM SCHOOL (RIGHT)							1	X															
WB	1.025	F	VD1-1	72	20			10.00								2		X							INSTALL 150 FEET WEST OF EXISTING SCHOOL DESTINATION SIGN.		7			
WB	0.869	F	S5-2	30	24		END SCHOOL ZONE							1	X															
		F	R2-1	24	30			5.00								1		X							INSTALL DIRECTLY ACROSS FROM EB SCHOOL FLASHING BEACON ASSEMBLY.	X				
		F	S5-2	24	30			5.00																	X					
WB	0.779	F	R2-1	24	30		SPEED LIMIT 40							1	X															
SIGN SUMMARY SHEET							SHEET TOTALS	38.33	0.00	0	0	0	6 7	0	0	5	75			0	0.0	0.0	0.0	0.0	PROJECT NAME: WOODFORD-MARLBORO					
								SF	SF	EA	EA	EA	EA	EA	EA	EA		FT		EA	LB	LB	LB	LB	PROJECT NUMBER: STPG SIGN(35)					
							VERMONT AGENCY OF TRANSPORTATION																		FILE NAME: 10B336			PLOT DATE: 4/10/2012		
							TOWN DIRECTIONAL TOTALS						260.8	0.0	9.0	4.0	4.0	60	0.0	0.0	48	720.0			0	0.0				DRAWN BY: J. KELLY
																							DESIGNED BY: J. KELLY			CHECKED BY: A. GAMBLE				
																							WOODFORD WB SHEET 8			SHEET 28 OF 80				

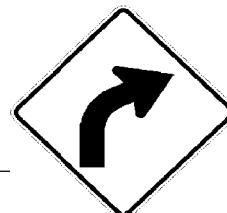
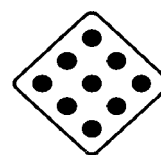
DIRECTION	MILEPOINT	LOCATION CODE (SHEET 2)	SIGN CODE	WIDTH (IN)	HEIGHT (IN)	SHEETING REMARKS	SIGN LEGEND	NEW SIGNS		EXISTING SIGNS				EXIST POST		NUMBER OF NEW POSTS	SQUARE STEEL (IN)			TUBULAR STEEL Ø (IN)				SIGN FRAME REQUIRED	REMARKS	SIGN DETAIL LOCATION			
								"A"	"B"	RETAIN	SALVAGE FROM	SALVAGE TO	REMOVE	RETAIN	REMOVE		1.75	2.00	2.50	FOUNDATION	3.0	3.50	4.00			5.00	SHSM	PROJECT SHEET #	STANDARD SHEET #
																	(LB / FT)				(LB / FT)								
																	1.88	2.42	3.35		7.6	9.00	10.80			14.60			
WOODFORD WB							FY-FLUORESCENT YELLOW FYG-FLUORESCENT YELLOW GREEN															"SHSM"-STANDARD HIGHWAY SIGNS AND MARKINGS							
WB	0.732	F	R2-1	24	30		SPEED LIMIT 40	5.00								1		X						INSTALL NEW SIGN 250 FEET WEST OF EXISTING SPEED LIMIT 40 SIGN, ACROSS FROM POLE #2/57/858.	X	TRIM	BRUSH		
WB	0.520	F	R2-1	24	30							1		X															
		F	R2-1	24	30		SPEED LIMIT 50	5.00								1		X						INSTALL DIRECTLY ACROSS FROM EB SL 40 SIGN.	X	TRIM	BRUSH		
SIGN SUMMARY SHEET							SHEET TOTALS	10.00	0.00	0	0	0	1	0	0	2	30			0	0.0	0.0	0.0	0.0	PROJECT NAME: WOODFORD-MARLBORO				
								SF	SF	EA	EA	EA	EA	EA	EA	EA		FT		EA	LB	LB	LB	LB	PROJECT NUMBER: STPG SIGN(35)				
																								FILE NAME: 10B336					
VERMONT AGENCY OF TRANSPORTATION																								PROJECT MANAGER: A. GAMBLE					
																								DESIGNED BY: J. KELLY					
							TOWN DIRECTIONAL TOTALS	260.8	0.0	9.0	4.0	4.0	60	0.0	0.0	48	720.0			0	0.0				PLOT DATE: 4/10/2012				
																								DRAWN BY: J. KELLY					
																								CHECKED BY: A. GAMBLE					
																								WOODFORD WB SHEET 9					
																								SHEET 29 OF 80					

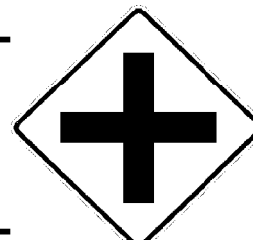
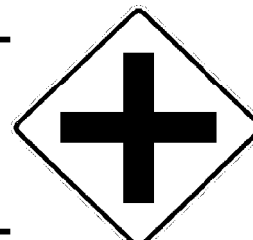
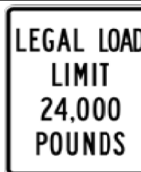
DIRECTION	MILEPOINT	LOCATION CODE (SHEET 2)	SIGN CODE	WIDTH (IN)	HEIGHT (IN)	SHEETING REMARKS	SIGN LEGEND	NEW SIGNS		EXISTING SIGNS				EXIST POST		NUMBER OF NEW POSTS	SQUARE STEEL (IN)			TUBULAR STEEL Ø (IN)					SIGN FRAME REQUIRED	REMARKS	SIGN DETAIL LOCATION		
								"A"	"B"	RETAIN	SALVAGE FROM	SALVAGE TO	REMOVE	RETAIN	REMOVE		1.75	2.00	2.50	FOUNDATION	3.0	3.50	4.00	5.00			SHSM	PROJECT SHEET #	STANDARD SHEET #
																	(LB / FT)				(LB / FT)								
																	1.88	2.42	3.35		7.6	9.00	10.80	14.60					
SEARSBURG EB						FY-FLUORESCENT YELLOW FYG-FLUORESCENT YELLOW GREEN																"SHSM"-STANDARD HIGHWAY SIGNS AND MARKINGS							
EB	0.000	C	VD-024	60	7.5	Searsburg Woodford 0090 0212 0000 0090 0217 0958	5.00					1		X															
		C	VD-024	72	10		0.42									2		X											
		C	VD-700	6	10		0.42																		INSTALL ON LEFT POST BELOW SEARSBURG	R MM		E-138	
		C	VD-700	6	10		0.42																		INSTALL ON RIGHT POST BELOW WOODFORD	R MM		E-138	
EB	0.485	C	VR-017	24	30	LEGAL LOAD LIMIT 24,000 POUNDS						1		X												OLD ROUTE 9 (TH-6)			
		C	VR-017	24	30		5.00									1		X									7		
EB	0.495	D	R1-1	30	30	STOP 0090 0212 0049						1		X												OLD ROUTE 9 (TH-6) R/S	REMOVED SIGN FROM NEW POST AND PUT ON SAME POST AS STOP SIGN AT SEARSBURG ROAD SUPT REQUEST.		
		D	R1-1	30	30		6.25									1		X									X		
EB	0.761	C	VR-017	24	24	LEGAL LOAD LIMIT 24,000 POUNDS						1	X	X												OLD ROUTE 9 (TH-6)			
		C	VR-017	24	30		5.00									1		X			RETAIN POST						7		
EB	0.770	D	R1-1	30	30	STOP 0090 0212 0075						1	X	X												OLD ROUTE 9 (TH-6)			
		D	R1-1	30	30		6.25									1		X			RETAIN POST						X		
EB	0.795	A	M3-2	24	12	EAST						1																	
		A	M1-5	24	24								1		X														
		A	M3-2	24	12		2.00									1		X										E-136B	
SIGN SUMMARY SHEET						SHEET TOTALS		30.34	0.00	0	3 0	3 0	12 7	0	0	7	105			0	0.0	0.0	0.0	0.0	PROJECT NAME: WOODFORD-MARLBORO				
								SF	SF	EA	EA	EA	EA	EA	EA	EA		FT		EA	LB	LB	LB	LB	PROJECT NUMBER: STPG SIGN(35)				
																										FILE NAME: 10B336			
						VERMONT AGENCY OF TRANSPORTATION																				PROJECT MANAGER: A. GAMBLE			
						TOWN DIRECTIONAL TOTALS		130.8	0.0	29.0	18.0	18.0	41	0.0	0.0	28	420.0			0	0.0				DESIGNED BY: J. KELLY				
																								PLOT DATE: 4/10/2012					
																								DRAWN BY: J. KELLY					
																								CHECKED BY: A. GAMBLE					
																								SHEET 30 OF 80					

DIRECTION	MILEPOINT	LOCATION CODE (SHEET 2)	SIGN CODE	WIDTH (IN)	HEIGHT (IN)	SHEETING REMARKS	SIGN LEGEND	NEW SIGNS		EXISTING SIGNS				EXIST POST		NUMBER OF NEW POSTS	SQUARE STEEL (IN)			TUBULAR STEEL Ø (IN)				SIGN FRAME REQUIRED	REMARKS	SIGN DETAIL LOCATION			
								"A"	"B"	RETAIN	SALVAGE FROM	SALVAGE TO	REMOVE	RETAIN	REMOVE		1.75	2.00	2.50	FOUNDATION	3.0	3.50	4.00			5.00	SHSM	PROJECT SHEET #	STANDARD SHEET #
																	(LB / FT)				(LB / FT)								
																	1.88	2.42	3.35		7.6	9.00	10.80			14.60			
SEARSBURG EB						FY-FLUORESCENT YELLOW FYG-FLUORESCENT YELLOW GREEN																"SHSM"-STANDARD HIGHWAY SIGNS AND MARKINGS							
		A	M1-5	24	24			4.00																		E-136B			
EB	1.353	A	W7-4	78	40		RUNAWAY TRUCK RAMP 1 MILE			1				X															
EB	1.462	A	VW-092	30	30		UNSAFE TO PASS			1				X															
EB	1.580	A	W7-1	30	30		HILL SYMBOL (8%)			1				X															
		A	W7-3A	24	18		NEXT 2 MILES			1																			
EB	1.670	A	W2-2R	30	30		RIGHT SIDE ROAD			1				X															
EB	1.698	A	M2-1	21	15		JCT			1				X															
		A	M1-5	24	24		VERMONT ROUTE 8			1																			
EB	1.743	A	D1-1A	72	12		↑ WILMINGTON 7				1	1	1		X	2	SLIP BASES	X						REINSTALL SIGNS ON NEW POSTS AND SLIP-BASES. SEE SHEET 2.		SLIP BASES			
		A	D1-1S	72	12		↑ SKI AREAS				1	1	1																
		A	D1-1A	72	12		↑ BRATTLEBORO 24				1	1	1																
		A	D1-1A	72	12		HEARTWELLVILLE 6 ---->						1																
		A	D1-1A	72	12		READSBORO 11 ---->				1	1	1											MOVE SIGN UP					
		A	D1-1A	72	12		STAMFORD 12 ---->				1	1	1											MOVE SIGN UP					
EB	1.812	A	M3-2	24	12		ROUTE MARKER ASSEMBLY				1	1	1		X	2		X						REINSTALL SIGNS AND FRAME ON NEW POSTS WITH SLIP-BASES. SEE SHEET 2.					
SIGN SUMMARY SHEET						SHEET TOTALS	4.00	0.00	7	6	6	7	0	0	4	60			0	0.0	0.0	0.0	0.0	PROJECT NAME: WOODFORD-MARLBORO					
							SF	SF	EA	EA	EA	EA	EA	EA	EA		FT		EA	LB	LB	LB	LB	PROJECT NUMBER: STPG SIGN(35)					
						VERMONT AGENCY OF TRANSPORTATION						TOWN DIRECTIONAL TOTALS															FILE NAME: 10B336		
													130.8	0.0	29.0	18.0	18.0	41	0.0	0.0	28	420.0			0	0.0			
																						PROJECT MANAGER: A. GAMBLE			DRAWN BY: J. KELLY				
																						DESIGNED BY: J. KELLY			CHECKED BY: A. GAMBLE				
																						SEARSBURG EB SHEET 2			SHEET 31 OF 80				

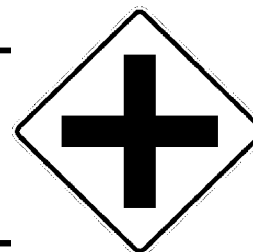
DIRECTION	MILEPOINT	LOCATION CODE (SHEET 2)	SIGN CODE	WIDTH (IN)	HEIGHT (IN)	SHEETING REMARKS	SIGN LEGEND	NEW SIGNS		EXISTING SIGNS				EXIST POST		NUMBER OF NEW POSTS	SQUARE STEEL (IN)			TUBULAR STEEL Ø (IN)				SIGN FRAME REQUIRED	REMARKS	SIGN DETAIL LOCATION			
								"A"	"B"	RETAIN	SALVAGE FROM	SALVAGE TO	REMOVE	RETAIN	REMOVE		1.75	2.00	2.50	FOUNDATION	3.0	3.50	4.00			5.00	SHSM	PROJECT SHEET #	STANDARD SHEET #
																	(LB / FT)				(LB / FT)								
																	1.88	2.42	3.35		7.6	9.00	10.80			14.60			
SEARSBURG EB						FY-FLUORESCENT YELLOW FYG-FLUORESCENT YELLOW GREEN																"SHSM"-STANDARD HIGHWAY SIGNS AND MARKINGS							
		A	M1-5	24	24					1	1	1																	
		A	M6-3	21	15					1	1	1																	
		A	M3-3	24	12					1	1	1																	
		A	M1-5	24	24					1	1	1			SLIP BASES											SLIP BASES			
		A	M6-1	21	15					1	1	1																	
		A	M4-5	24	12					1	1	1																	
		A	M3-3	24	12					1	1	1																	
		A	M1-5	30	24					1	1	1																	
		A	M6-1	21	15					1	1	1																	
EB	1.850	A	W7-1	30	30		HILL SYMBOL (8%)			1				X															
		A	W7-3A	24	18		NEXT 2 MILES			1																			
EB	1.884	A	W7-4	78	40		RUNAWAY TRUCK RAMP 1/2 MILE			1				X															
EB	1.905	A	D2-1	72	10		WILMINGTON 7						1		X														
		A	D2-1	72	10		ACTUAL SIGN SKI AREAS						1																
EB	1.918	A	VD2-1	72	12		Wilmington 7	6.00							2	SLIP BASES							INSTALL 70 FEET EAST OF EXISTING DESTINATION BOARD ASSEMBLY.		SLIP BASES	7			
SIGN SUMMARY SHEET						SHEET TOTALS		6.00	0.00	3	9	9	11	0	0	2	30		0	0.0	0.0	0.0	0.0	PROJECT NAME: WOODFORD-MARLBORO					
								SF	SF	EA	EA	EA	EA	EA	EA	EA		FT		EA	LB	LB	LB	LB	PROJECT NUMBER: STPG SIGN(35)				
																										FILE NAME: 10B336			
VERMONT AGENCY OF TRANSPORTATION																						PROJECT MANAGER: A. GAMBLE			PLOT DATE: 4/10/2012				
						TOWN DIRECTIONAL TOTALS		130.8	0.0	29.0	18.0	18.0	41	0.0	0.0	28	420.0		0	0.0				DESIGNED BY: J. KELLY			DRAWN BY: J. KELLY		
																						CHECKED BY: A. GAMBLE			SHEET 32 OF 80				
																						SEARSBURG EB SHEET 3							

DIRECTION	MILEPOINT	LOCATION CODE (SHEET 2)	SIGN CODE	WIDTH (IN)	HEIGHT (IN)	SHEETING REMARKS	SIGN LEGEND	NEW SIGNS		EXISTING SIGNS				EXIST POST		NUMBER OF NEW POSTS	SQUARE STEEL (IN)			TUBULAR STEEL Ø (IN)				SIGN FRAME REQUIRED	REMARKS	SIGN DETAIL LOCATION					
								"A"	"B"	RETAIN	SALVAGE FROM	SALVAGE TO	REMOVE	RETAIN	REMOVE		1.75	2.00	2.50	FOUNDATION	3.0	3.50	4.00			5.00	SHSM	PROJECT SHEET #	STANDARD SHEET #		
																	(LB / FT)				(LB / FT)										
																	1.88	2.42	3.35		7.6	9.00	10.80			14.60					
SEARSBURG EB						FY-FLUORESCENT YELLOW FYG-FLUORESCENT YELLOW GREEN															"SHSM"-STANDARD HIGHWAY SIGNS AND MARKINGS										
		A	VD2-1	72	12		Ski Areas	6.00															SEE SHEET 2.		7						
		A	VD2-1	72	12		Brattleboro24	6.00																7							
		A	M3-2	24	12		EAST VERMONT 9	2.00															INSTALL ON LEFT POST			E-136B					
		A	M1-5	24	24			4.00														INSTALL ON LEFT POST			E-136B						
EB	1.952	A	VW-092	36	36		UNSAFE TO PASS				1		1		X																
EB	1.978	A	VW-092	36	36		UNSAFE TO PASS					1				2		X		USED OLD SIGN POSTS		INSTALL 135 FEET EAST OF EXISTING UNSAFE TO PASS ASSEMBLY.		USED OLD SIGN POSTS							
EB	2.068	A	VW-000	30	30		MOOSE CROSSING			1				X																	
		A	W7-3A	24	18		NEXT 4 MILES			1																					
							SCHOOL BUS STOP AHEAD	9.00								2									JOE KELLY ADDED						
EB	2.342	A	VW-092	36	36		UNSAFE TO PASS			1				X																	
EB	2.375	A	VR-644P	24	12		BEGIN			1				X																	
		A	R8-3	24	24		NO PARKING			1																					
EB	2.408	A	OM1-1	18	18		OBJECT MARKER			1				X																	
EB	2.413	A	W7-3B	60	60		RUNAWAY TRUCK RAMP			1				X								RETAIN SIGN ASSEMBLY AND FLASHING BEACONS.									
EB	2.425	A	M4-6P	24	12		END			1				X																	
		A	R8-3	24	24		NO PARKING			1																					
SIGN SUMMARY SHEET						SHEET TOTALS	27.00 48.00	0.00	9	1	1	1	0	0	2	30			0	0.0	0.0	0.0	0.0	PROJECT NAME: WOODFORD-MARLBORO							
							SF	SF	EA	EA	EA	EA	EA	EA	EA		FT		EA	LB	LB	LB	LB	PROJECT NUMBER: STPG SIGN(35)							
						VERMONT AGENCY OF TRANSPORTATION						TOWN DIRECTIONAL TOTALS	130.8	0.0	29.0	18.0	18.0	41	0.0	0.0	28	420.0			0	0.0			FILE NAME: 10B336		
																												DESIGNED BY: J. KELLY			PLOT DATE: 4/10/2012
																							PROJECT MANAGER: A. GAMBLE			DRAWN BY: J. KELLY					
																							SHEET 33 OF 80			CHECKED BY: A. GAMBLE					

DIRECTION	MILEPOINT	LOCATION CODE (SHEET 2)	SIGN CODE	WIDTH (IN)	HEIGHT (IN)	SHEETING REMARKS	SIGN LEGEND	NEW SIGNS		EXISTING SIGNS				EXIST POST		NUMBER OF NEW POSTS	SQUARE STEEL (IN)			TUBULAR STEEL Ø (IN)				SIGN FRAME REQUIRED	REMARKS	SIGN DETAIL LOCATION						
								"A"	"B"	RETAIN	SALVAGE FROM	SALVAGE TO	REMOVE	RETAIN	REMOVE		1.75	2.00	2.50	FOUNDATION	3.0	3.50	4.00			5.00	SHSM	PROJECT SHEET #	STANDARD SHEET #			
																	(LB / FT)				(LB / FT)											
																	1.88	2.42	3.35		7.6	9.00	10.80			14.60						
SEARSBURG EB						FY-FLUORESCENT YELLOW FYG-FLUORESCENT YELLOW GREEN																"SHSM"-STANDARD HIGHWAY SIGNS AND MARKINGS										
EB	2.442	A	W1-1R	36	36		RIGHT CURVE						1		X																	
		A	W13-1	24	24		40 MPH ADVISORY (MISSING)						1													NOTHING THERE						
EB	2.468	A	W7-4	96	48		RUNAWAY TRUCK RAMP 1/2 MILE			1				X																		
EB	2.542	A	W1-2R	36	36	FY		9.00								2		X						INSTALL 10 FEET WEST OF UTILITY POLE #604/11 1/2.	X							
		A	W13-1	24	24	FY		4.00																INSTALL ON LEFT POST	X							
EB	2.986	A	VR-644P	30	12		BEGIN			1				X																		
		A	R8-3	24	24		NO PARKING			1															X							
EB	3.025	A	OM1-1	18	18		OBJECT MARKER (MISSING)						1		X											NOTHING THERE						
		A	OM1-1	18	18			2.25								1		X						INSTALL AT POINT OF GORE FOR TRUCK RAMP.	X							
EB	3.036	A	W7-4B	60	60		RUNAWAY TRUCK RAMP			1				X																		
EB	3.067	C	R5-1	30	30		DO NOT ENTER			1				X																		
		C	R8-3A	24	24		NO PARKING			1																						
EB	3.106	A	M4-6P	24	12		END			1				X																		
		A	R8-3	24	24		NO PARKING			1																						
EB	3.170	A	W2-1M	36	36		MODIFIED CROSSROAD						1		X																	
SIGN SUMMARY SHEET						SHEET TOTALS	15.25	0.00	8	0	0	2 4	0	0	3	45			0	0.0	0.0	0.0	0.0	PROJECT NAME: WOODFORD-MARLBORO								
							SF	SF	EA	EA	EA	EA	EA	EA	EA		FT		EA	LB	LB	LB	LB	PROJECT NUMBER: STPG SIGN(35)								
						VERMONT AGENCY OF TRANSPORTATION						TOWN DIRECTIONAL TOTALS	130.8	0.0	29.0	18.0	18.0	41	0.0	0.0	28	420.0			0	0.0				FILE NAME: 10B336 PROJECT MANAGER: A. GAMBLE DESIGNED BY: J. KELLY SEARSBURG EB SHEET 5		
													PLOT DATE: 4/10/2012 DRAWN BY: J. KELLY CHECKED BY: A. GAMBLE SHEET 34 OF 80																			

DIRECTION	MILEPOINT	LOCATION CODE (SHEET 2)	SIGN CODE	WIDTH (IN)	HEIGHT (IN)	SHEETING REMARKS	SIGN LEGEND	NEW SIGNS		EXISTING SIGNS				EXIST POST		NUMBER OF NEW POSTS	SQUARE STEEL (IN)			TUBULAR STEEL Ø (IN)				SIGN FRAME REQUIRED	REMARKS	SIGN DETAIL LOCATION			
								"A"	"B"	RETAIN	SALVAGE FROM	SALVAGE TO	REMOVE	RETAIN	REMOVE		1.75	2.00	2.50	FOUNDATION	3.0	3.50	4.00			5.00	SHSM	PROJECT SHEET #	STANDARD SHEET #
																	(LB / FT)				(LB / FT)								
																	1.88	2.42	3.35		7.6	9.00	10.80			14.60			
SEARSBURG EB						FY-FLUORESCENT YELLOW FYG-FLUORESCENT YELLOW GREEN																"SHSM"-STANDARD HIGHWAY SIGNS AND MARKINGS							
EB	3.198	A	VW-092	36	36			9.00							2		X						INSTALL 150 EAST OF EXISTING CROSSROAD SIGN ASSEMBLY.		8				
EB	3.270	A	W2-1	36	36			9.00							2		X						INSTALL 50 FEET EAST OF BREAK IN GUARDRAIL	X					
EB	3.357	C	VR-017	24	30							1		X									SLEEPY HOLLOW RD. (TH-3)						
		C	VR-017	24	30			5.00							1		X			USED NEW POST REMOVED FROM EB 0.485 AND PAID THERE						7			
		C		30	30		DEAD END (TOWN-OWNED) NOW "NO OUTLET"				+	+	+		+		X						REINSTALL TOWN'S DEAD END SIGN 50 FEET FURTHER UP TOWN HIGHWAY ON A SEPARATE POST.	TOWN HAS PUT IN "NO OUTLET" SIGN					
EB	3.361	D	R1-1	30	30							1	X	X									SLEEPY HOLLOW RD. (TH-3)						
		D	R1-1	30	30			6.25							+		X		RETAIN POST						X	RETAINED POST			
		D	D3-1				STREET NAME SIGN (TOWN-OWNED)				+	+	+										REINSTALL ABOVE NEW STOP SIGN USING 90 DEG. BRACKET.		RETAIN POST				
EB	3.402	A	M3-2	24	12							1	X	X					RETAIN POST					RETAIN FLANGED CHANNEL POST					
		A	M1-5	24	24							1																	
		A	M3-2	24	12			2.00																			E-136B		
		A	M1-5	24	24			4.00																			E-136B		
		A	VM-120	18	24		MOLLY STARK BYWAY			1														RETAIN BYWAY SIGN.					
EB	3.510	A	R2-1	24	30							1	X	X										RETAIN FLANGED CHANNEL POST.	OLD POST DAMAGED				
		A	R2-1	24	30			5.00																	X				
SIGN SUMMARY SHEET						SHEET TOTALS		40.25	0.00	1	0 2	0 2	5 7	0	0	7	105			0	0.0	0.0	0.0	0.0	PROJECT NAME: WOODFORD-MARLBORO				
								SF	SF	EA	EA	EA	EA	EA	EA	EA		FT		EA	LB	LB	LB	LB	PROJECT NUMBER: STPG SIGN(35)				
																										FILE NAME: 10B336			
VERMONT AGENCY OF TRANSPORTATION																								PROJECT MANAGER: A. GAMBLE					
																									PLOT DATE: 4/10/2012				
																									DRAWN BY: J. KELLY				
TOWN DIRECTIONAL TOTALS																							DESIGNED BY: J. KELLY						
																									CHECKED BY: A. GAMBLE				
								130.8	0.0	29.0	18.0	18.0	41	0.0	0.0	28	420.0			0	0.0				SEARSBURG EB SHEET 6				
																							SHEET 35 OF 80						

DIRECTION	MILEPOINT	LOCATION CODE (SHEET 2)	SIGN CODE	WIDTH (IN)	HEIGHT (IN)	SHEETING REMARKS	SIGN LEGEND	NEW SIGNS		EXISTING SIGNS				EXIST POST		NUMBER OF NEW POSTS	SQUARE STEEL (IN)			TUBULAR STEEL Ø (IN)				SIGN FRAME REQUIRED	REMARKS	SIGN DETAIL LOCATION			
								"A"	"B"	RETAIN	SALVAGE FROM	SALVAGE TO	REMOVE	RETAIN	REMOVE		1.75	2.00	2.50	FOUNDATION	3.0	3.50	4.00			5.00	SHSM	PROJECT SHEET #	STANDARD SHEET #
																	(LB / FT)				(LB / FT)								
																	1.88	2.42	3.35		7.6	9.00	10.80			14.60			
SEARSBURG EB						FY-FLUORESCENT YELLOW FYG-FLUORESCENT YELLOW GREEN																"SHSM"-STANDARD HIGHWAY SIGNS AND MARKINGS							
EB	3.857	A	VW-005	30	30		BRIDGES FREEZE BEFORE ROAD						1		X								REMOVE FLAGS.						
		A	W8-13	36	36			9.00								2		X						X					
		A	W7-3aP	24	18			3.00																X					
EB	4.039	A	M3-2	24	12		EAST						1		X														
		A	M1-5	24	24		VERMONT ROUTE 9						1																
EB	5.473	A	VD-062AS	72	16		BUSINESS SIGN			1				X															
EB	5.519	A	R2-1	24	30								1		X														
		A	R2-1	24	30			5.00								1		X						X					
SIGN SUMMARY SHEET							SHEET TOTALS	17.00	0.00	1	0	0	4	0	0	3	45			0	0.0	0.0	0.0	0.0	PROJECT NAME: WOODFORD-MARLBORO				
								SF	SF	EA	EA	EA	EA	EA	EA	EA	FT			EA	LB	LB	LB	LB	PROJECT NUMBER: STPG SIGN(35)				
							VERMONT AGENCY OF TRANSPORTATION																			FILE NAME: 10B336			
							TOWN DIRECTIONAL TOTALS						130.8	0.0	29.0	18.0	18.0	41	0.0	0.0	28	420.0			0	0.0			
																							PROJECT MANAGER: A. GAMBLE			DRAWN BY: J. KELLY			
																							DESIGNED BY: J. KELLY			CHECKED BY: A. GAMBLE			
																							SEARSBURG EB SHEET 7			SHEET 36 OF 80			

DIRECTION	MILEPOINT	LOCATION CODE (SHEET 2)	SIGN CODE	WIDTH (IN)	HEIGHT (IN)	SHEETING REMARKS	SIGN LEGEND	NEW SIGNS		EXISTING SIGNS				EXIST POST		NUMBER OF NEW POSTS	SQUARE STEEL (IN)			TUBULAR STEEL Ø (IN)				SIGN FRAME REQUIRED	REMARKS	SIGN DETAIL LOCATION			
								"A"	"B"	RETAIN	SALVAGE FROM	SALVAGE TO	REMOVE	RETAIN	REMOVE		1.75	2.00	2.50	FOUNDATION	3.0	3.50	4.00			5.00	SHSM	PROJECT SHEET #	STANDARD SHEET #
																	(LB / FT)				(LB / FT)								
																	1.88	2.42	3.35		7.6	9.00	10.80			14.60			
SEARSBURG WB							FY-FLUORESCENT YELLOW FYG-FLUORESCENT YELLOW GREEN															"SHSM"-STANDARD HIGHWAY SIGNS AND MARKINGS							
WB	5.518	F	R2-1	24	30								1	X						RETAIN POST		RETAIN FLANGED CHANNEL POST.							
		F	R2-1	24	30			5.00															X						
WB	4.590	F	VW-005	30	30		BRIDGES FREEZE BEFORE ROAD						1		X										REMOVE FLAGS.				
		F	W8-13	36	36			9.00								2		X							X				
		F	W7-3aP	24	18			3.00																X					
WB	4.490	G	VR-017	24	30								1	X						RETAIN POST		LIND LANE (TH-8)							
		G	VR-017	24	30			5.00																	7				
WB	4.484	H	R1-1	30	30					I	I	I	1	X						RETAIN POST		LIND LANE (TH-8)		STREET SIGN ON TOP OF STOP SIGN INSTALLED 9-II					
		H	R1-1	30	30			6.25															X						
WB	3.488	F	W2-1M	36	36		MODIFIED CROSSROADS						I	1		X								REMOVE OLD POSTS FOR ONE MISSING SIGN					
																													
WB	3.446	F	W2-1	36	36			9.00								2		X					X	INSTALL 100 FEET WEST OF EXISTING CROSSROADS SIGN.	PER JOE KELLY				
WB	3.390	F	D17-2	42	42			12.25								2		X						INSTALL 600 FEET WEST OF NEW CROSSROADS SIGN.	PER JOE KELLY	6			
WB	3.362	G	VR-017	24	30		LEGAL LOAD 24K			1				X										SOMERSET RD (TH-4)					
WB	3.356	H	R1-1	30	30		STOP			1				X										SOMERSET RD (TH-4)					
WB	3.321	F	R2-1	24	30		SPEED LIMIT 50			1				X															
SIGN SUMMARY SHEET							SHEET TOTALS	49.50	0.00	3	0	0	75	0	0	6	90			0	0.0	0.0	0.0	0.0	PROJECT NAME: WOODFORD-MARLBORO				
								SF	SF	EA	EA	EA	EA	EA	EA	EA		FT		EA	LB	LB	LB	LB	PROJECT NUMBER: STPG SIGN(35)				
							VERMONT AGENCY OF TRANSPORTATION																			FILE NAME: 10B336			
TOWN DIRECTIONAL TOTALS								86.0	0.0	21.0	17.0	17.0	34	0.0	0.0	18	270.0			0	0.0				PROJECT MANAGER: A. GAMBLE				
																									DESIGNED BY: J. KELLY				
																									SEARSBURG WB SHEET 1				
																							PLOT DATE: 4/10/2012						
																								DRAWN BY: J. KELLY					
																								CHECKED BY: A. GAMBLE					
																								SHEET 37 OF 80					

DIRECTION	MILEPOINT	LOCATION CODE (SHEET 2)	SIGN CODE	WIDTH (IN)	HEIGHT (IN)	SHEETING REMARKS	SIGN LEGEND	NEW SIGNS		EXISTING SIGNS				EXIST POST		NUMBER OF NEW POSTS	SQUARE STEEL (IN)			TUBULAR STEEL Ø (IN)				SIGN FRAME REQUIRED	REMARKS	SIGN DETAIL LOCATION			
								"A"	"B"	RETAIN	SALVAGE FROM	SALVAGE TO	REMOVE	RETAIN	REMOVE		1.75	2.00	2.50	FOUNDATION	3.0	3.50	4.00			5.00	SHSM	PROJECT SHEET #	STANDARD SHEET #
																	(LB / FT)				(LB / FT)								
																	1.88	2.42	3.35		7.6	9.00	10.80			14.60			
SEARSBURG WB							FY-FLUORESCENT YELLOW FYG-FLUORESCENT YELLOW GREEN															"SHSM"-STANDARD HIGHWAY SIGNS AND MARKINGS							
WB	3.273	F	R4-6	24	30		TRUCK LANE 500 FEET							1		X													
WB	3.178	F	R4-3	24	30		SLOWER TRAFFIC KEEP RIGHT			1					X														
WB	2.744	F	R4-3	24	30		SLOWER TRAFFIC KEEP RIGHT			1					X														
WB	2.709	E	W1-8R	18	24		CHEVRON			1					X														
WB	2.694	E	W1-8R	18	24		CHEVRON			1					X														
WB	2.677	E	W1-8R	18	24		CHEVRON			+		I			X			POST	ON								MISSING, INSTALL SALVAGED ONE		
WB	2.666	E	W1-8R	18	24		CHEVRON			1					X														
WB	2.643	E	W1-8R	18	24		CHEVRON			1					X														
WB	2.627	E	W1-8R	18	24		CHEVRON			1					X														
WB	2.612	E	W1-8R	18	24		CHEVRON			1					X														
	2.394						SCHOOL BUS STOP AHEAD	9.00									2										JOE KELLY ADDED		
WB	2.394	F	VW-133R	30	30		HIDDEN DRIVES RIGHT (SIGN IS MISSING)							1		X													
WB	2.343	F	VW-054R	30	30			6.25									1		X						INSTALL 50 FEET EAST OF #1358 MAILBOX.		8		
WB	2.070	F	R4-3	24	30		SLOWER TRAFFIC KEEP RIGHT							1		X													
		F	VW-054R	30	30			6.25									1		X								8		
	2.034						SCHOOL BUS STOP AHEAD	9.00									2								INSTALL ASSEMBLY 100 FEET EAST OF CURRENT LOCATION.			JOE KELLY ADDED	
WB	1.991	F	W2-2L	30	30		LEFT SIDE ROAD					1					1		X										
SIGN SUMMARY SHEET							SHEET TOTALS	30.50 12.50	0.00	9	0	2 4	3	0	0	3	45			0	0.0	0.0	0.0	0.0	PROJECT NAME: WOODFORD-MARLBORO				
								SF	SF	EA	EA	EA	EA	EA	EA	EA		FT		EA	LB	LB	LB	LB	PROJECT NUMBER: STPG SIGN(35)				
																										FILE NAME: 10B336			
							VERMONT AGENCY OF TRANSPORTATION																					PROJECT MANAGER: A. GAMBLE	
							TOWN DIRECTIONAL TOTALS	86.0	0.0	21.0	17.0	17.0	34	0.0	0.0	18	270.0			0	0.0				DESIGNED BY: J. KELLY				
																							PLOT DATE: 4/10/2012						
																							DRAWN BY: J. KELLY						
																							CHECKED BY: A. GAMBLE						
																							SHEET 38 OF 80						

DIRECTION	MILEPOINT	LOCATION CODE (SHEET 2)	SIGN CODE	WIDTH (IN)	HEIGHT (IN)	SHEETING REMARKS	SIGN LEGEND	NEW SIGNS		EXISTING SIGNS				EXIST POST		NUMBER OF NEW POSTS	SQUARE STEEL (IN)			TUBULAR STEEL Ø (IN)				SIGN FRAME REQUIRED	REMARKS	SIGN DETAIL LOCATION			
								"A"	"B"	RETAIN	SALVAGE FROM	SALVAGE TO	REMOVE	RETAIN	REMOVE		1.75	2.00	2.50	FOUNDATION	3.0	3.50	4.00			5.00	SHSM	PROJECT SHEET #	STANDARD SHEET #
																	(LB / FT)				(LB / FT)								
																	1.88	2.42	3.35		7.6	9.00	10.80			14.60			
SEARSBURG WB							FY-FLUORESCENT YELLOW FYG-FLUORESCENT YELLOW GREEN															"SHSM"-STANDARD HIGHWAY SIGNS AND MARKINGS							
WB	1.972	F	W2-2L	30	30		LEFT SIDE ROAD				1		1		X								RELOCATE ASSEMBLY 100 FEET EAST OF CURRENT LOCATION.						
WB	1.953	F	M2-1	21	15		JCT					1				1		X					INSTALL ASSEMBLY 150 FEET EAST OF CURRENT LOCATION.						
		F	M1-5	24	24		VERMONT ROUTE 8					1																	
WB	1.924	F	M2-1	21	15		JCT				1		1		X								RELOCATE ASSEMBLY 150 FEET EAST OF CURRENT LOCATION.						
		F	M1-5	24	24		VERMONT ROUTE 8				1		1																
WB	1.915	F	VR-731	36	48		THRU TRAFFIC KEEP RIGHT	12.00								2		X						INSTALL 200 FEET EAST OF DESTINATION SIGNS.		7			
WB	1.901	F	VR-731	24	30		THRU TRAFFIC USE RIGHT LANE						1		X														
WB	1.874	F	VD1-1A	72	10		↑ BENNINGTON 14				1	1	1		X	2			X				REINSTALL SIGNS ON NEW POSTS AND SLIP-BASES. SEE SHEET 2.						
		F	VD1-1A	72	10		<---- HEARTWELLVILLE 6						1										REMOVE SIGN FROM ASSEMBLY.						
		F	VD1-1A	72	10		<---- READSBORO 11				1	1	1				SLIP BASES						MOVE SIGN UP		SLIP BASES				
		F	VD1-1A	72	10		<---- STAMFORD 12				1	1	1										MOVE SIGN UP						
WB	1.837	F	M3-3	24	12		ROUTE MARKER ASSEMBLY				1	1	1		X	2			X				REINSTALL SIGNS AND FRAME ON NEW POSTS AND SLIP-BASES. SEE SHEET 2.						
		F	M1-5	24	24						1	1	1				SLIP BASES												
		F	M6-1	21	15						1	1	1				SLIP BASES												
		F	M4-5	24	12						1	1	1				SLIP BASES												
SIGN SUMMARY SHEET							SHEET TOTALS		12.00	0.00	0	10	9	12	0	0	7	105			0	0.0	0.0	0.0	0.0	PROJECT NAME: WOODFORD-MARLBORO			
									SF	SF	EA	EA	EA	EA	EA	EA		FT		EA	LB	LB	LB	LB	PROJECT NUMBER: STPG SIGN(35)				
																									FILE NAME: 10B336				
																										PROJECT MANAGER: A. GAMBLE			
VERMONT AGENCY OF TRANSPORTATION							TOWN DIRECTIONAL TOTALS		86.0	0.0	21.0	17.0	17.0	34	0.0	0.0	18	270.0			0	0.0				DESIGNED BY: J. KELLY			
																							PLOT DATE: 4/10/2012						
																							DRAWN BY: J. KELLY						
																							CHECKED BY: A. GAMBLE						
																							SEARSBURG WB SHEET 3						
																							SHEET 39 OF 80						

DIRECTION	MILEPOINT	LOCATION CODE (SHEET 2)	SIGN CODE	WIDTH (IN)	HEIGHT (IN)	SHEETING REMARKS	SIGN LEGEND	NEW SIGNS		EXISTING SIGNS				EXIST POST		NUMBER OF NEW POSTS	SQUARE STEEL (IN)			TUBULAR STEEL Ø (IN)				SIGN FRAME REQUIRED	REMARKS	SIGN DETAIL LOCATION				
								"A"	"B"	RETAIN	SALVAGE FROM	SALVAGE TO	REMOVE	RETAIN	REMOVE		1.75	2.00	2.50	FOUNDATION	3.0	3.50	4.00			5.00	SHSM	PROJECT SHEET #	STANDARD SHEET #	
																	(LB / FT)				(LB / FT)									
																	1.88	2.42	3.35		7.6	9.00	10.80			14.60				
SEARSBURG WB							FY-FLUORESCENT YELLOW FYG-FLUORESCENT YELLOW GREEN															"SHSM"-STANDARD HIGHWAY SIGNS AND MARKINGS								
		F	M3-3	24	12						1	1	1																	
		F	M1-5	30	24						1	1	1																	
		F	M6-1	21	15						1	1	1																	
		F	M3-4	24	12						1	1	1																	
		F	M1-5	24	24						1	1	1																	
		F	M6-3	21	15						1	1	1																	
WB	1.824	F	W9-1R	30	30		RIGHT LANE ENDS						1		X															
WB	1.823	G	W1-7	48	24		DOUBLE HEADED ARROW			1				X																
WB	1.792	F	VD2-1	72	10		Bennington14 WEST VERMONT 9					1		X																
		F	VD2-1	72	12	6.00								2		X									7					
		F	M3-4	24	12	2.00																		INSTALL ON LEFT POST.			E-136B			
		F	M1-5	24	24	4.00																		INSTALL ON LEFT POST.			E-136B			
		F	VM-120	18	24		MOLLY STARK BYWAY					1												RELOCATE SIGN FROM MP 1.760+/-. INSTALL ON LEFT POST.						
WB	1.760	F	M3-4	24	12		WEST					1		X																
		F	M1-5	24	24		VERMONT ROUTE 9 (MISSING)					1																		
SIGN SUMMARY SHEET							SHEET TOTALS		12.00	0.00	1	6	7	10	0	0	2	30			0	0.0	0.0	0.0	0.0	PROJECT NAME: WOODFORD-MARLBORO PROJECT NUMBER: STPG SIGN(35)				
							SF	SF	EA	EA	EA	EA	EA	EA	EA	EA	FT			EA	LB	LB	LB	LB	FILE NAME: 10B336 PROJECT MANAGER: A. GAMBLE DESIGNED BY: J. KELLY SEARSBURG WB SHEET 4			PLOT DATE: 4/10/2012 DRAWN BY: J. KELLY CHECKED BY: A. GAMBLE SHEET 40 OF 80		
							TOWN DIRECTIONAL TOTALS		86.0	0.0	21.0	17.0	17.0	34	0.0	0.0	18	270.0			0	0.0								
VERMONT AGENCY OF TRANSPORTATION																														

DIRECTION	MILEPOINT	LOCATION CODE (SHEET 2)	SIGN CODE	WIDTH (IN)	HEIGHT (IN)	SHEETING REMARKS	SIGN LEGEND	NEW SIGNS		EXISTING SIGNS				EXIST POST		NUMBER OF NEW POSTS	SQUARE STEEL (IN)			TUBULAR STEEL Ø (IN)				SIGN FRAME REQUIRED	REMARKS	SIGN DETAIL LOCATION			
								"A"	"B"	RETAIN	SALVAGE FROM	SALVAGE TO	REMOVE	RETAIN	REMOVE		1.75	2.00	2.50	FOUNDATION	3.0	3.50	4.00			5.00	SHSM	PROJECT SHEET #	STANDARD SHEET #
																	(LB / FT)				(LB / FT)								
																	1.88	2.42	3.35		7.6	9.00	10.80			14.60			
SEARSBURG WB							FY-FLUORESCENT YELLOW FYG-FLUORESCENT YELLOW GREEN															"SHSM"-STANDARD HIGHWAY SIGNS AND MARKINGS							
		F	VM-120	18	24		MOLLY STARK BYWAY				1		1										RELOCATE SIGN TO D-BOARD ASSEMBLY AT MP 1.792+/-						
WB	1.752	G	VR-017	24	30		LEGAL LOAD 24K			1				X									TOWN GARAGE RD (TH-7)						
WB	1.745	H	R1-1	30	30		STOP			1				X									TOWN GARAGE RD (TH-7)						
WB	1.714	F	W4-2R	36	36		RIGHT LANE REDUCTION			1				X															
WB	1.679	F	VW-054R	30	30		HIDDEN DRIVE RIGHT			1				X															
WB	1.642	F	VW-000	30	30		MOOSE CROSSING			1				X															
		F	W7-3A	24	18		NEXT 2 MILES			1																			
WB	1.060	F					(EMPTY POST) 0090 0212 0106 REMOVE						1		X								REMOVE EMPTY POST.						
WB	0.925	F	VW-139	30	30		LIVESTOCK CROSSING (MISSING)						1		X								SIGN IS NO LONGER WARRANTED.						
WB	0.556	F	W11-6H	30	30		SNOWMOBILE						1		X								SIGN IS NOT WARRANTED DUE TO ADEQUATE SSD.						
WB	0.458	F	M3-4	24	12		WEST			1				X															
		F	M1-5	24	24		VERMONT ROUTE 9			1																			
SIGN SUMMARY SHEET							SHEET TOTALS		0.00	0.00	8	1	0	4	0	0	0	0			0	0.0	0.0	0.0	PROJECT NAME: WOODFORD-MARLBORO				
									SF	SF	EA	EA	EA	EA	EA	EA	EA		FT		EA	LB	LB	LB	LB	PROJECT NUMBER: STPG SIGN(35)			
																										FILE NAME: 10B336			
							VERMONT AGENCY OF TRANSPORTATION																				PROJECT MANAGER: A. GAMBLE		
							TOWN DIRECTIONAL TOTALS		86.0	0.0	21.0	17.0	17.0	34	0.0	0.0	18	270.0			0	0.0				PLOT DATE: 4/10/2012			
																								DRAWN BY: J. KELLY					
																								CHECKED BY: A. GAMBLE					
																								DESIGNED BY: J. KELLY					
																								SEARSBURG WB SHEET 5					
																								SHEET 41 OF 80					

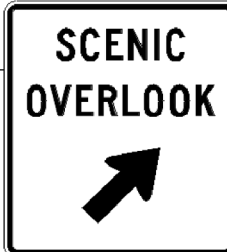
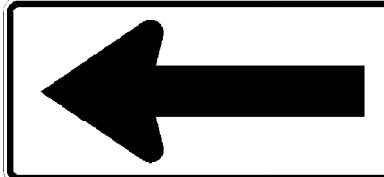
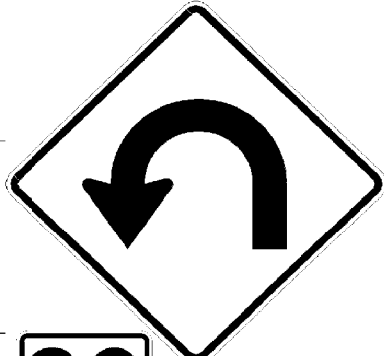
DIRECTION	MILEPOINT	LOCATION CODE (SHEET 2)	SIGN CODE	WIDTH (IN)	HEIGHT (IN)	SHEETING REMARKS	SIGN LEGEND	NEW SIGNS		EXISTING SIGNS				EXIST POST		NUMBER OF NEW POSTS	SQUARE STEEL (IN)			TUBULAR STEEL Ø (IN)				SIGN FRAME REQUIRED	REMARKS	SIGN DETAIL LOCATION			
								"A"	"B"	RETAIN	SALVAGE FROM	SALVAGE TO	REMOVE	RETAIN	REMOVE		1.75	2.00	2.50	FOUNDATION	3.0	3.50	4.00			5.00	SHSM	PROJECT SHEET #	STANDARD SHEET #
																	(LB / FT)				(LB / FT)								
																	1.88	2.42	3.35		7.6	9.00	10.80			14.60			
WILMINGTON EB							FY-FLUORESCENT YELLOW FYG-FLUORESCENT YELLOW GREEN															"SHSM"-STANDARD HIGHWAY SIGNS AND MARKINGS							
EB	0.000	C	VD-024	60	7.5		Wilmington Searsburg Windham Co Bennington Co 0090 1322 0000 0090 0212 0554						1		X														
		C	VD-025	60	7.5								1																
		C	VD-024	72	10			5.00								2		X									4		
		C	VD-025	72	10			5.00																			4		
		C	VD-700	6	10			0.42																INSTALL ON LH POST BELOW WILMINGTON				E-138	
		C	VD-700	6	10			0.42																INSTALL ON RH POST BELOW SEARSBURG				E-138	
EB	0.185	A	VD-123	36	36		511 TRAVEL INFO	9.00								2		X							INSTALL 200 FEET IN ADVANCE OF SIDE ROAD WARNING SIGN.			6	
EB	0.223	A	W2-2R	30	30		⊥						1		X														
		A	W2-2R	30	30			6.25								1		X								X			
EB	0.307	C	VR-017	24	30		LEGAL LOAD LIMIT 24,000 POUNDS							1	X										WOODS RD (TH-31)			RETAIN POST	
		C	VR-017	24	30			5.00																	RETAIN EXISTING POST.			7	
EB	0.313	D	R1-1	30	30		STOP							1	X										WOODS RD (TH-31)			RETAIN POST	
		D	R1-1	30	30			6.25																	RETAIN EXISTING POST.	X			
EB	0.766	A	VD-062DBR	24	24		MOLLY STARK OBLISK				1				X														
EB	0.805	A	VD-062D	24	24		TRAVEL INFO				1				X														
SIGN SUMMARY SHEET							SHEET TOTALS		37.34	0.00	2	0	0	5	0	0	5	75			0	0.0	0.0	0.0	0.0	PROJECT NAME: WOODFORD-MARLBORO			
									SF	SF	EA	EA	EA	EA	EA	EA	EA	FT			EA	LB	LB	LB	LB	PROJECT NUMBER: STPG SIGN(35)			
																									FILE NAME: 10B336				
							VERMONT AGENCY OF TRANSPORTATION																				PROJECT MANAGER: A. GAMBLE		
							TOWN DIRECTIONAL TOTALS		56.8	0.0	7.0	0.0	0.0	9	0.0	0.0	7	105.0			0	0.0				PLOT DATE: 4/10/2012			
																								DRAWN BY: J. KELLY					
																								CHECKED BY: A. GAMBLE					
																								DESIGNED BY: J. KELLY					
																								WILMINGTON EB SHEET 1					
																								SHEET 42 OF 80					

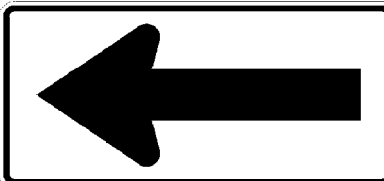
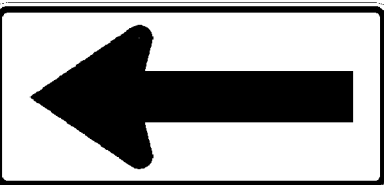
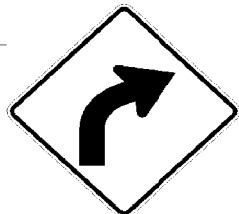
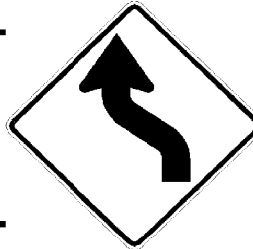
DIRECTION	MILEPOINT	LOCATION CODE (SHEET 2)	SIGN CODE	WIDTH (IN)	HEIGHT (IN)	SHEETING REMARKS	SIGN LEGEND	NEW SIGNS		EXISTING SIGNS				EXIST POST		NUMBER OF NEW POSTS	SQUARE STEEL (IN)			TUBULAR STEEL Ø (IN)				SIGN FRAME REQUIRED	REMARKS	SIGN DETAIL LOCATION			
								"A"	"B"	RETAIN	SALVAGE FROM	SALVAGE TO	REMOVE	RETAIN	REMOVE		1.75	2.00	2.50	FOUNDATION	3.0	3.50	4.00			5.00	SHSM	PROJECT SHEET #	STANDARD SHEET #
																	(LB / FT)				(LB / FT)								
																	1.88	2.42	3.35		7.6	9.00	10.80			14.60			
WILMINGTON EB							FY-FLUORESCENT YELLOW FYG-FLUORESCENT YELLOW GREEN															"SHSM"-'STANDARD HIGHWAY SIGNS AND MARKINGS							
EB	0.984	A					PICNIC AREA RIGHT			1				X															
EB	1.000	C	VR-017	24	30		LEGAL LOAD 24K			1				X															
EB	1.006	D	R1-1	30	30		STOP			1				X															
EB	1.041	A	W11-2	30	30							1		X															
		A	W16-2	24	12		500 FEET					1																	
		A	W11-2	30	30	FYG		6.25								1	X							X					
		A	W16-9P	24	12	FYG		2.00																X					
EB	1.131	C	VR-017	24	30		LEGAL LOAD 24K			1				X															
EB	1.137	D	R1-1	30	30		STOP			1				X															
EB	1.144	A	W11-2	30	30							1		X															
		A	W16-7	24	12		(DOWN ARROW)					1																	
		A	W11-2	30	30	FYG		6.25								1	X							X					
		A	W16-4P	30	24	FYG		5.00																X					
				SKIP FROM MP 1.50+/- TO MARLBORO TOWN LINE DUE TO RECENT SIGN REPLACEMENTS																									
SIGN SUMMARY SHEET							SHEET TOTALS	19.50	0.00	5	0	0	4	0	0	2	30			0	0.0	0.0	0.0	0.0	PROJECT NAME: WOODFORD-MARLBORO				
								SF	SF	EA	EA	EA	EA	EA	EA	EA		FT		EA	LB	LB	LB	LB	PROJECT NUMBER: STPG SIGN(35)				
							VERMONT AGENCY OF TRANSPORTATION																				FILE NAME: 10B336		
							TOWN DIRECTIONAL TOTALS							56.8	0.0	7.0	0.0	0.0	9	0.0	0.0	7	105.0			0	0.0		
																								PROJECT MANAGER: A. GAMBLE					
																								DRAWN BY: J. KELLY					
																								CHECKED BY: A. GAMBLE					
																								WILMINGTON EB SHEET 2					
																								SHEET 43 OF 80					

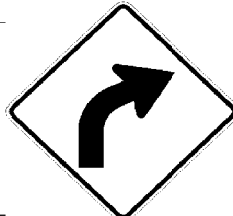
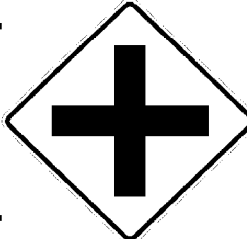
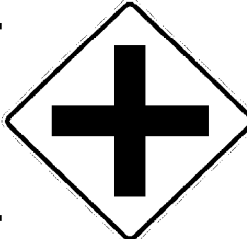
DIRECTION	MILEPOINT	LOCATION CODE (SHEET 2)	SIGN CODE	WIDTH (IN)	HEIGHT (IN)	SHEETING REMARKS	SIGN LEGEND	NEW SIGNS		EXISTING SIGNS				EXIST POST		NUMBER OF NEW POSTS	SQUARE STEEL (IN)			TUBULAR STEEL Ø (IN)				SIGN FRAME REQUIRED	REMARKS	SIGN DETAIL LOCATION			
								"A"	"B"	RETAIN	SALVAGE FROM	SALVAGE TO	REMOVE	RETAIN	REMOVE		1.75	2.00	2.50	FOUNDATION	3.0	3.50	4.00			5.00	SHSM	PROJECT SHEET #	STANDARD SHEET #
																	(LB / FT)				(LB / FT)								
																	1.88	2.42	3.35		7.6	9.00	10.80			14.60			
WILMINGTON WB							FY-FLUORESCENT YELLOW FYG-FLUORESCENT YELLOW GREEN															"SHSM"-STANDARD HIGHWAY SIGNS AND MARKINGS							
WB	7.145	G	VR-017	24	30								1		X								SUN & SKI RD (TH-68)						
		G	VR-017	24	30	5.00								1		X									TRIM BRUSH 7				
WB	7.143	H	R1-1	30	30								1		X								SUN & SKI RD (TH-68)						
		H	R1-1	30	30	6.25								1		X									X				
WB	7.113	F	M3-4	24	12								1		X														
		F	M1-5	24	24									1															
		F	M3-4	24	12	2.00									1		X										E-136B		
		F	M1-5	24	24	4.00																					E-136B		
WB	7.075	F	R2-1	24	30		OLD SIGN MISSING						+		X										NONE THERE				
		F	R2-1	24	30			5.00								1		X							X				
				SKIP FROM MP 7.00+/- to MP 1.40+/- DUE TO RECENT SIGN REPLACEMENTS																									
WB	1.399	F	M3-4	24	12								1		X														
		F	M1-5	24	24									1															
		F	M3-4	24	12	2.00										1		X									E-136B		
		F	M1-5	24	24	4.00																					E-136B		
SIGN SUMMARY SHEET							SHEET TOTALS		28.25	0.00	0	0	0	6 7	0	0	5	75		0	0.0	0.0	0.0	0.0	PROJECT NAME: WOODFORD-MARLBORO				
								SF	SF	EA	EA	EA	EA	EA	EA	EA	EA		FT		EA	LB	LB	LB	LB	PROJECT NUMBER: STPG SIGN(35)			
VERMONT AGENCY OF TRANSPORTATION							TOWN DIRECTIONAL TOTALS		47.8	0.0	3.0	0.0	0.0	11	0.0	0.0	7	105.0		0	0.0				FILE NAME: 10B336				
																									PLOT DATE: 4/10/2012				
																									DRAWN BY: J. KELLY				
																									DESIGNED BY: J. KELLY				
																									WILMINGTON WB SHEET 1				
																									CHECKED BY: A. GAMBLE				
																									SHEET 44 OF 80				

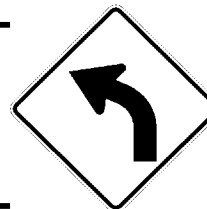
DIRECTION	MILEPOINT	LOCATION CODE (SHEET 2)	SIGN CODE	WIDTH (IN)	HEIGHT (IN)	SHEETING REMARKS	SIGN LEGEND	NEW SIGNS		EXISTING SIGNS				EXIST POST		NUMBER OF NEW POSTS	SQUARE STEEL (IN)			TUBULAR STEEL Ø (IN)				SIGN FRAME REQUIRED	REMARKS	SIGN DETAIL LOCATION			
								"A"	"B"	RETAIN	SALVAGE FROM	SALVAGE TO	REMOVE	RETAIN	REMOVE		1.75	2.00	2.50	FOUNDATION	3.0	3.50	4.00			5.00	SHSM	PROJECT SHEET #	STANDARD SHEET #
																	(LB / FT)				(LB / FT)								
																	1.88	2.42	3.35		7.6	9.00	10.80			14.60			
WILMINGTON WB							FY-FLUORESCENT YELLOW FYG-FLUORESCENT YELLOW GREEN															"SHSM"-STANDARD HIGHWAY SIGNS AND MARKINGS							
WB	1.360	F	VD-062BRN	72	16		BUSINESS SIGN			1				X															
WB	1.308	F	W11-2	30	30																								
		F	W16-2	24	12																								
		F	W11-2	30	30	FYG																							
		F	W16-9P	24	12	FYG																							
WB	1.201	F	W11-2	30	30																								
		F	W16-7	24	12																								
		F	W11-2	30	30	FYG																							
		F	W16-4P	30	24	FYG																							
WB	1.141	F					PICNIC AREA LEFT			1				X															
WB	0.985	F	VD-062AS	72	16		BUSINESS SIGN			1				X															
SIGN SUMMARY SHEET							SHEET TOTALS	19.50	0.00	3	0	0	4	0	0	2	30			0	0.0	0.0	0.0	0.0	PROJECT NAME: WOODFORD-MARLBORO				
								SF	SF	EA	EA	EA	EA	EA	EA	EA	FT			EA	LB	LB	LB	LB	PROJECT NUMBER: STPG SIGN(35)				
																									FILE NAME: 10B336				
VERMONT AGENCY OF TRANSPORTATION																									PLOT DATE: 4/10/2012				
																									DRAWN BY: J. KELLY				
																									CHECKED BY: A. GAMBLE				
							TOWN DIRECTIONAL TOTALS	47.8	0.0	3.0	0.0	0.0	11	0.0	0.0	7	105.0			0	0.0				WILMINGTON WB SHEET 2				
																									SHEET 45 OF 80				

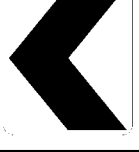
DIRECTION	MILEPOINT	LOCATION CODE (SHEET 2)	SIGN CODE	WIDTH (IN)	HEIGHT (IN)	SHEETING REMARKS	SIGN LEGEND	NEW SIGNS		EXISTING SIGNS				EXIST POST		NUMBER OF NEW POSTS	SQUARE STEEL (IN)			TUBULAR STEEL Ø (IN)				SIGN FRAME REQUIRED	REMARKS	SIGN DETAIL LOCATION			
								"A"	"B"	RETAIN	SALVAGE FROM	SALVAGE TO	REMOVE	RETAIN	REMOVE		1.75	2.00	2.50	FOUNDATION	3.0	3.50	4.00			5.00	SHSM	PROJECT SHEET #	STANDARD SHEET #
																	(LB / FT)				(LB / FT)								
																	1.88	2.42	3.35		7.6	9.00	10.80			14.60			
MARLBORO EB							FY-FLUORESCENT YELLOW FYG-FLUORESCENT YELLOW GREEN															"SHSM"-STANDARD HIGHWAY SIGNS AND MARKINGS							
EB	0.000	C	VD-024	60	7.5		Marlboro Wilmington 0090 1311 0000 0090 1322 0716 0090 1322 0723						1		X														
		C	VD-024	72	10			5.00								2		X								4			
		C	VD-700	6	10			0.42					I											INSTALL ON LEFT POST BELOW MARLBORO		R MM	E-138		
		C	VD-700	6	10			0.42					I											INSTALL ON RIGHT POST BELOW WILMINGTON		R MM	E-138		
EB	0.109	A	M3-2	24	12		EAST VERMONT 9						1	X							RETAIN POST						RETAIN POST		
		A	M1-5	24	24								1																
		A	M3-2	24	12			2.00																		E-136B			
		A	M1-5	24	24			4.00																		E-136B			
EB	0.147	A	R2-1	24	30		SPEED LIMIT 50						1	X							RETAIN POST						RETAIN POST		
		A	R2-1	24	30			5.00																	X				
EB	0.185	A	VD-062BRN	72	16		BUSINESS SIGN			1				X															
EB	0.247	A	VR-020	24	30		NO PARKING ON TRAVEL LANE						1		X														
EB	0.284	A	VW-205	36	36		WATCH FOR TURNING VEHICLES						1	X															
		A	VW-205	36	36			9.00													RETAIN POST				RETAIN POST 8				
EB	0.330	A	W11-2	48	48		PEDESTRIAN						1		X														
SIGN SUMMARY SHEET							SHEET TOTALS	25.84	0.00	1	0	0	9 7	0	0	2	30			0	0.0	0.0	0.0	0.0	PROJECT NAME: WOODFORD-MARLBORO				
								SF	SF	EA	EA	EA	EA	EA	EA	EA		FT		EA	LB	LB	LB	LB	PROJECT NUMBER: STPG SIGN(35)				
																									FILE NAME: 10B336				
																									PROJECT MANAGER: A. GAMBLE				
VERMONT AGENCY OF TRANSPORTATION							TOWN DIRECTIONAL TOTALS	634.4	0.0	28.0	1.0	1.0	127	0.0	0.0	88	1320.0			0	0.0				DESIGNED BY: J. KELLY				
																								DRAWN BY: J. KELLY					
																								CHECKED BY: A. GAMBLE					
																						MARLBORO EB SHEET 1							
																							SHEET 46 OF 80						

DIRECTION	MILEPOINT	LOCATION CODE (SHEET 2)	SIGN CODE	WIDTH (IN)	HEIGHT (IN)	SHEETING REMARKS	SIGN LEGEND	NEW SIGNS		EXISTING SIGNS				EXIST POST		NUMBER OF NEW POSTS	SQUARE STEEL (IN)			TUBULAR STEEL Ø (IN)				SIGN FRAME REQUIRED	REMARKS	SIGN DETAIL LOCATION				
								"A"	"B"	RETAIN	SALVAGE FROM	SALVAGE TO	REMOVE	RETAIN	REMOVE		1.75	2.00	2.50	FOUNDATION	3.0	3.50	4.00			5.00	SHSM	PROJECT SHEET #	STANDARD SHEET #	
																	(LB / FT)				(LB / FT)									
																	1.88	2.42	3.35		7.6	9.00	10.80			14.60				
MARLBORO EB							FY-FLUORESCENT YELLOW FYG-FLUORESCENT YELLOW GREEN															"SHSM"-STANDARD HIGHWAY SIGNS AND MARKINGS								
EB	0.362	A	D6-3M	30	30		SCENIC OVERLOOK AHEAD 						1		X															
		A	D5-2R	42	48			14.00								2		X									9			
EB	0.396	A	VR-020	24	30		NO PARKING ON TRAVEL LANE						1		X															
EB	0.412	A	W1-6L	48	24								1		X						RETAIN POST						RETAIN POST			
		A	W1-6L	48	24			8.00								2		X								X				
EB	0.446	A	W11A-2	48	48		PEDESTRIAN CROSSWALK						1	X							RETAIN POST						RETAIN POST			
		A	W16-4	24	18								1																	
		A	W11-2	48	48	FYG		16.00																	X					
		A	W16-4	30	24	FYG		5.00																		X				
EB	0.477	A	VW-537L	48	48								1		X															
		A	W13-1	24	24								1																	
		A	W1-11L	36	36	FY		9.00								2		SLIP BASES	X						X		SLIP BASES			
		A	W13-1	24	24	FY		4.00																		X				
EB	0.497	A		36	36		CENTERLINE RUMBLE STRIPS			1				X																
		A		24	18		NEXT 9 MILES			1																				
SIGN SUMMARY SHEET							SHEET TOTALS	56.00	0.00	2	0	0	7	0	0	6	90			0	0.0	0.0	0.0	0.0	PROJECT NAME: WOODFORD-MARLBORO					
								SF	SF	EA	EA	EA	EA	EA	EA	EA		FT		EA	LB	LB	LB	LB	PROJECT NUMBER: STPG SIGN(35)					
							TOWN DIRECTIONAL TOTALS															634.4	0.0	28.0	1.0	1.0	127	0.0	0.0	88
VERMONT AGENCY OF TRANSPORTATION																						FILE NAME: 10B336			PLOT DATE: 4/10/2012					
																						PROJECT MANAGER: A. GAMBLE			DRAWN BY: J. KELLY					
																						DESIGNED BY: J. KELLY			CHECKED BY: A. GAMBLE					
																						MARLBORO EB SHEET 2			SHEET 47 OF 80					

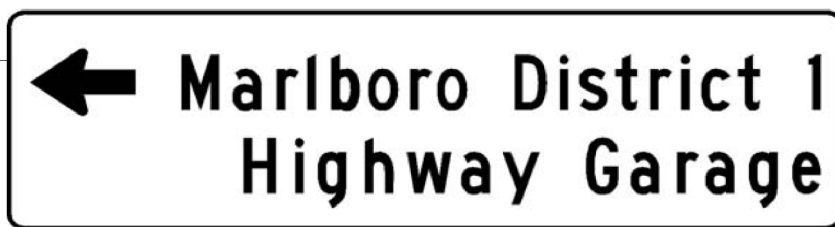
DIRECTION	MILEPOINT	LOCATION CODE (SHEET 2)	SIGN CODE	WIDTH (IN)	HEIGHT (IN)	SHEETING REMARKS	SIGN LEGEND	NEW SIGNS		EXISTING SIGNS				EXIST POST		NUMBER OF NEW POSTS	SQUARE STEEL (IN)			TUBULAR STEEL Ø (IN)				SIGN FRAME REQUIRED	REMARKS	SIGN DETAIL LOCATION					
								"A"	"B"	RETAIN	SALVAGE FROM	SALVAGE TO	REMOVE	RETAIN	REMOVE		1.75	2.00	2.50	FOUNDATION	3.0	3.50	4.00			5.00	SHSM	PROJECT SHEET #	STANDARD SHEET #		
																	(LB / FT)				(LB / FT)										
																	1.88	2.42	3.35		7.6	9.00	10.80			14.60					
MARLBORO EB							FY-FLUORESCENT YELLOW FYG-FLUORESCENT YELLOW GREEN															"SHSM"-STANDARD HIGHWAY SIGNS AND MARKINGS									
EB	0.585	A	W1-6L	48	24								1	X							RETAIN POST							RETAIN POST			
		A	W1-6L	48	24	FY		8.00																	X						
EB	0.612	A	W1-6L	48	24								1	X							RETAIN POST							RETAIN POST			
		A	W1-6L	48	24	FY		8.00																	X						
EB	0.708	A	W1-2R	30	30								1	X							RETAIN POST							RETAIN POST			
		A	W1-2R	30	30			6.25																	X						
EB	0.924	A	W1-4L	30	30		LEFT REVERSE CURVE						1		X																
EB	0.962	A	W1-4L	30	30											1		X							INSTALL 200 FEET EAST OF EXISTING REVERSE CURVE SIGN.	X	TRIM BRUSH				
EB	1.139	A	M3-2	24	12								1	X							RETAIN POST							RETAIN POST			
		A	M1-5	24	24							1																			
		A	M3-2	24	12											2.00											E-136B				
		A	M1-5	24	24			4.00																			E-136B				
EB	1.172	A	R2-1	24	30								1	X							RETAIN POST							RETAIN POST			
		A	R2-1	24	30			5.00																	X						
EB	1.238	A					2 EMPTY POSTS						1		X										REMOVE EMPTY POSTS.						
SIGN SUMMARY SHEET							SHEET TOTALS		39.50	0.00	0	0	0	8	0	0	1	15			0	0.0	0.0	0.0	0.0	PROJECT NAME: WOODFORD-MARLBORO					
									SF	SF	EA	EA	EA	EA	EA	EA	EA		FT		EA	LB	LB	LB	LB	PROJECT NUMBER: STPG SIGN(35)					
																											FILE NAME: 10B336			PLOT DATE: 4/10/2012	
VERMONT AGENCY OF TRANSPORTATION																											PROJECT MANAGER: A. GAMBLE		DRAWN BY: J. KELLY		
																													DESIGNED BY: J. KELLY		CHECKED BY: A. GAMBLE
							TOWN DIRECTIONAL TOTALS		634.4	0.0	28.0	1.0	1.0	127	0.0	0.0	88	1320.0			0	0.0				MARLBORO EB SHEET 3			SHEET 48 OF 80		

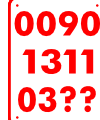
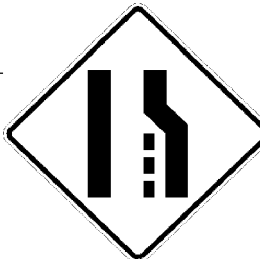
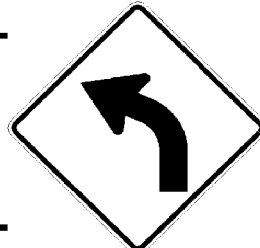
DIRECTION	MILEPOINT	LOCATION CODE (SHEET 2)	SIGN CODE	WIDTH (IN)	HEIGHT (IN)	SHEETING REMARKS	SIGN LEGEND	NEW SIGNS		EXISTING SIGNS				EXIST POST		NUMBER OF NEW POSTS	SQUARE STEEL (IN)			TUBULAR STEEL Ø (IN)				SIGN FRAME REQUIRED	REMARKS	SIGN DETAIL LOCATION			
								"A"	"B"	RETAIN	SALVAGE FROM	SALVAGE TO	REMOVE	RETAIN	REMOVE		1.75	2.00	2.50	FOUNDATION	3.0	3.50	4.00			5.00	SHSM	PROJECT SHEET #	STANDARD SHEET #
																	(LB / FT)				(LB / FT)								
																	1.88	2.42	3.35		7.6	9.00	10.80			14.60			
MARLBORO EB							FY-FLUORESCENT YELLOW FYG-FLUORESCENT YELLOW GREEN															"SHSM"-STANDARD HIGHWAY SIGNS AND MARKINGS							
EB	1.338	A	VW-092	36	36		UNSAFE TO PASS			1				X															
EB	1.653	A	W1-2R	36	36		 			+			I	X					RETAIN	POST								RETAIN POST	
		A	W13-1	24	24					+				I															
		A	W1-2R	36	36			9.00																		X			
		A	W13-1	24	24			4.00																		X			
EB	1.765	A	W1-10R	30	30		RIGHT CURVE / CROSSROAD						1		X														
		A	S3-1	30	30		SCHOOL BUS STOP AHEAD						1																
		A	S3-1	36	36	FYG	 	9.00								2		X								X	TRIM BRUSH		
EB	1.803	A	W2-1	30	30			 	6.25								1		X							INSTALL 200 FEET EAST OF NEW SCHOOL BUS STOP SIGN.	X		
EB	1.877	C	VR-017	24	30								1	X						RETAIN	POST				BUTTERFIELD RD (TH-5)		RETAIN POST		
		C	VR-017	24	30																						7		
		C	R2-1	24	30		SPEED LIMIT 35 (TOWN OWNED)			1															REINSTALL BELOW NEW LEGAL LOAD SIGN.				
EB	1.886	D	R1-1	30	30		 						1	X							RETAIN	POST				BUTTERFIELD RD (TH-5)		RETAIN POST	
		D	R1-1	30	30			6.25																		X			
EB	1.926	A	M3-2	24	12								1	X							RETAIN	POST					RETAIN POST		
SIGN SUMMARY SHEET							SHEET TOTALS		39.50	0.00	4	0	0	7 5	0	0	3	45			0	0.0	0.0	0.0	0.0	PROJECT NAME: WOODFORD-MARLBORO			
									SF	SF	EA	EA	EA	EA	EA	EA	EA		FT		EA	LB	LB	LB	LB	PROJECT NUMBER: STPG SIGN(35)			
																										FILE NAME: 10B336			
							VERMONT AGENCY OF TRANSPORTATION																				PROJECT MANAGER: A. GAMBLE		
																								DESIGNED BY: J. KELLY					
																								MARLBORO EB SHEET 4					
																								DRAWN BY: J. KELLY					
																								CHECKED BY: A. GAMBLE					
																								SHEET 49 OF 80					

DIRECTION	MILEPOINT	LOCATION CODE (SHEET 2)	SIGN CODE	WIDTH (IN)	HEIGHT (IN)	SHEETING REMARKS	SIGN LEGEND	NEW SIGNS		EXISTING SIGNS				EXIST POST		NUMBER OF NEW POSTS	SQUARE STEEL (IN)			TUBULAR STEEL Ø (IN)				SIGN FRAME REQUIRED	REMARKS	SIGN DETAIL LOCATION			
								"A"	"B"	RETAIN	SALVAGE FROM	SALVAGE TO	REMOVE	RETAIN	REMOVE		1.75	2.00	2.50	FOUNDATION	3.0	3.50	4.00			5.00	SHSM	PROJECT SHEET #	STANDARD SHEET #
																	(LB / FT)				(LB / FT)								
																	1.88	2.42	3.35		7.6	9.00	10.80			14.60			
MARLBORO EB							FY-FLUORESCENT YELLOW FYG-FLUORESCENT YELLOW GREEN															"SHSM"-STANDARD HIGHWAY SIGNS AND MARKINGS							
		A	M1-5	24	24							1																	
		A	M3-2	24	12																					E-136B			
		A	M1-5	24	24																					E-136B			
EB	1.966	A	R2-1	24	30							1	X																
		A	R2-1	24	30																					X			
EB	2.024	A	VD-062B	72	16		BUSINESS SIGN			1				X															
		A	VD-062AS	72	16		BUSINESS SIGN			1																			
EB	2.161	A	VR-023B	24	30		\$500 FINE						1		X														
EB	2.384	A	W1-2L	30	30		LEFT CURVE						1		X														
EB	2.442	A	W1-2L	30	30			6.25								1		X						INSTALL 300 FEET EAST OF EXISTING LEFT CURVE ASSEMBLY, WEST OF POLE #68B/7A/1.	X				
EB	2.479	A	W1-8L	18	24								1		X														
		A	W1-8L	18	24												1		X							X			
EB	2.479	B	W1-8R	18	24								1		X														
		B	W1-8R	18	24														X							X			
EB	2.513	A	W1-8L	18	24								1		X														
SIGN SUMMARY SHEET							SHEET TOTALS	23.25	0.00	2	0	0	7	0	0	3	45			0	0.0	0.0	0.0	0.0	PROJECT NAME: WOODFORD-MARLBORO				
								SF	SF	EA	EA	EA	EA	EA	EA	EA		FT		EA	LB	LB	LB	LB	PROJECT NUMBER: STPG SIGN(35)				
																									FILE NAME: 10B336				
							VERMONT AGENCY OF TRANSPORTATION																			PROJECT MANAGER: A. GAMBLE			
							TOWN DIRECTIONAL TOTALS	634.4	0.0	28.0	1.0	1.0	127	0.0	0.0	88	1320.0			0	0.0				PLOT DATE: 4/10/2012				
																								DRAWN BY: J. KELLY					
																							CHECKED BY: A. GAMBLE						
																							MARLBORO EB SHEET 5						
																							SHEET 50 OF 80						

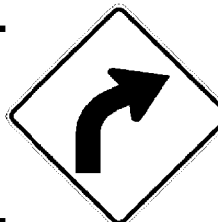
DIRECTION	MILEPOINT	LOCATION CODE (SHEET 2)	SIGN CODE	WIDTH (IN)	HEIGHT (IN)	SHEETING REMARKS	SIGN LEGEND	NEW SIGNS		EXISTING SIGNS				EXIST POST		NUMBER OF NEW POSTS	SQUARE STEEL (IN)			TUBULAR STEEL Ø (IN)				SIGN FRAME REQUIRED	REMARKS	SIGN DETAIL LOCATION			
								"A"	"B"	RETAIN	SALVAGE FROM	SALVAGE TO	REMOVE	RETAIN	REMOVE		1.75	2.00	2.50	FOUNDATION	3.0	3.50	4.00			5.00	SHSM	PROJECT SHEET #	STANDARD SHEET #
																	(LB / FT)				(LB / FT)								
																	1.88	2.42	3.35		7.6	9.00	10.80			14.60			
MARLBORO EB							FY-FLUORESCENT YELLOW FYG-FLUORESCENT YELLOW GREEN															"SHSM"-STANDARD HIGHWAY SIGNS AND MARKINGS							
		A	W1-8L	18	24			3.00							1		X							X					
EB	2.513	B	W1-8R	18	24							1		X															
		B	W1-8R	18	24			3.00							1		X							X					
EB	2.546	A	W1-8L	18	24							1		X															
		A	W1-8L	18	24			3.00							1		X							X					
EB	2.546	B	W1-8R	18	24							1		X															
		B	W1-8R	18	24			3.00							1		X							X					
EB	2.579	A	W1-8L	18	24							1		X															
		A	W1-8L	18	24			3.00							1		X							X					
EB	2.579	B	W1-8R	18	24							1		X															
		B	W1-8R	18	24			3.00							1		X							X					
EB	2.612	A	W1-8L	18	24							1		X															
		A	W1-8L	18	24			3.00							1		X							X					
EB	2.612	B	W1-8R	18	24							1		X															
		B	W1-8R	18	24			3.00							1		X							X					
SIGN SUMMARY SHEET							SHEET TOTALS	24.00	0.00	0	0	0	7	0	0	8	120			0	0.0	0.0	0.0	0.0	PROJECT NAME: WOODFORD-MARLBORO				
								SF	SF	EA	EA	EA	EA	EA	EA	EA		FT		EA	LB	LB	LB	LB	PROJECT NUMBER: STPG SIGN(35)				
																									FILE NAME: 10B336				
							VERMONT AGENCY OF TRANSPORTATION																			PROJECT MANAGER: A. GAMBLE			
TOWN DIRECTIONAL TOTALS																							DESIGNED BY: J. KELLY						
							634.4	0.0	28.0	1.0	1.0	127	0.0	0.0	88	1320.0			0	0.0				CHECKED BY: A. GAMBLE					
																						MARLBORO EB SHEET 6							
																							PLOT DATE: 4/10/2012						
																							DRAWN BY: J. KELLY						
																							SHEET 51 OF 80						

DIRECTION	MILEPOINT	LOCATION CODE (SHEET 2)	SIGN CODE	WIDTH (IN)	HEIGHT (IN)	SHEETING REMARKS	SIGN LEGEND	NEW SIGNS		EXISTING SIGNS				EXIST POST		NUMBER OF NEW POSTS	SQUARE STEEL (IN)			TUBULAR STEEL Ø (IN)				SIGN FRAME REQUIRED	REMARKS	SIGN DETAIL LOCATION			
								"A"	"B"	RETAIN	SALVAGE FROM	SALVAGE TO	REMOVE	RETAIN	REMOVE		1.75	2.00	2.50	FOUNDATION	3.0	3.50	4.00			5.00	SHSM	PROJECT SHEET #	STANDARD SHEET #
																	(LB / FT)				(LB / FT)								
																	1.88	2.42	3.35		7.6	9.00	10.80			14.60			
MARLBORO EB							FY-FLUORESCENT YELLOW FYG-FLUORESCENT YELLOW GREEN															"SHSM"-STANDARD HIGHWAY SIGNS AND MARKINGS							
EB	2.618	C	VR-017	24	30		ROAD CLOSED FOR SEASON			I			1	X						RETAIN	POST			ADAMS CROSSROAD (TH-34)	RETAIN ROAD CLOSED RETAIN POST				
		C	VR-017	24	30		LEGAL LOAD LIMIT 24,000 POUNDS	5.00																	7				
EB	2.628	D	R1-1	30	30		0090 1311 0263			I			1	X						RETAIN	POST			ADAMS CROSSROAD (TH-34)	TRIM BRUSH RETAIN MM				
		D	R1-1	30	30		STOP	6.25																X	RETAIN POST				
EB	2.653	A	W1-8L	18	24								1		X														
		A	W1-8L	18	24			3.00								1		X							X				
EB	2.653	B	W1-8R	18	24								1		X														
		B	W1-8R	18	24			3.00								1		X							X				
EB	2.665	A	M3-2	24	12		EAST						1		X														
		A	M1-5	24	24		VERMONT ROUTE 9						1																
EB	2.703	A	R2-1	24	30		SPEED LIMIT 50						1		X														
EB	2.756	A	S3-1	36	36	FYG		9.00								2		X						INSTALL 125 FEET WEST OF EXISTING HIDDEN DRIVES RIGHT AND SBSA ASSEMBLY.	X				
EB	2.780	A	VW-133R	30	30		HIDDEN DRIVES RIGHT				1		1		X														
		A	S3-1	30	30		SCHOOL BUS STOP AHEAD						1																
EB	2.794	A	VW-133R	30	30		HIDDEN DRIVES RIGHT					1				1		X						INSTALL 75+/- FEET EAST OF EXISTING HIDDEN DRIVES RIGHT LOCATION.					
SIGN SUMMARY SHEET							SHEET TOTALS		26.25	0.00	0	1	1	9	0	0	5	75			0	0.0	0.0	0.0	0.0	PROJECT NAME: WOODFORD-MARLBORO			
									SF	SF	EA	EA	EA	EA	EA	EA	EA		FT		EA	LB	LB	LB	LB	PROJECT NUMBER: STPG SIGN(35)			
																										FILE NAME: 10B336			
							VERMONT AGENCY OF TRANSPORTATION																			PROJECT MANAGER: A. GAMBLE			
							TOWN DIRECTIONAL TOTALS		634.4	0.0	28.0	1.0	1.0	127	0.0	0.0	88	1320.0			0	0.0				PLOT DATE: 4/10/2012			
																								DRAWN BY: J. KELLY					
																								DESIGNED BY: J. KELLY					
																								MARLBORO EB SHEET 7					
																								CHECKED BY: A. GAMBLE					
																								SHEET 52 OF 80					

DIRECTION	MILEPOINT	LOCATION CODE (SHEET 2)	SIGN CODE	WIDTH (IN)	HEIGHT (IN)	SHEETING REMARKS	SIGN LEGEND	NEW SIGNS		EXISTING SIGNS				EXIST POST		NUMBER OF NEW POSTS	SQUARE STEEL (IN)			TUBULAR STEEL Ø (IN)				SIGN FRAME REQUIRED	REMARKS	SIGN DETAIL LOCATION				
								"A"	"B"	RETAIN	SALVAGE FROM	SALVAGE TO	REMOVE	RETAIN	REMOVE		1.75	2.00	2.50	FOUNDATION	3.0	3.50	4.00			5.00	SHSM	PROJECT SHEET #	STANDARD SHEET #	
																	(LB / FT)				(LB / FT)									
																	1.88	2.42	3.35		7.6	9.00	10.80			14.60				
MARLBORO EB							FY-FLUORESCENT YELLOW FYG-FLUORESCENT YELLOW GREEN															"SHSM"-STANDARD HIGHWAY SIGNS AND MARKINGS								
EB	2.852	A	W7-1	48	48								1		X															
		A	W7-1a	36	36			9.00								2		X							TRIMS TREES.	X	TRIM BRUSH			
EB	2.978	A	S3-1	30	30		SCHOOL BUS STOP AHEAD						1		X															
EB	3.016	A	W1-2L	30	30		LEFT CURVE						1		X															
		A	S3-1	36	36	FYG	 	9.00								2		X								X				
EB	3.054	A	W1-2L	30	30			6.25								1		X								INSTALL 200 FEET EAST OF EXISTING LEFT CURVE SIGN.	X			
EB	3.117 3-212	A	D1-1M	72	20								1		X												RELOCATE TO 3.117 PER DISTRICT REQUEST			
		A	VD1-1	72	20			10.00								2		X									6			
EB	3.585	A	VD-062AS	72	16		BUSINESS SIGN			1					X															
EB	3.636	A	D1-1A	72	10								1	X													RETAIN POST			
		A	D1-1A	72	10								1																	
		A	VD1-1A	72	12			6.00																			6			
		A	VD1-1A	72	12			6.00																			6			
EB	3.678	A	D17-2	42	42			12.25								2		X								INSTALL 225 FEET EAST OF DESTINATION SIGN ASSEMBLY.		6		
EB	3.747	A	R4-6	24	30		TRUCK LANE 500 FEET						1	X													RETAIN POST			
SIGN SUMMARY SHEET							SHEET TOTALS	58.50	0.00	1	0	0	7	0	0	9	135			0	0.0	0.0	0.0	0.0	PROJECT NAME: WOODFORD-MARLBORO			PROJECT NUMBER: STPG SIGN(35)		
								SF	SF	EA	EA	EA	EA	EA	EA	EA		FT		EA	LB	LB	LB	LB	FILE NAME: 10B336			PLOT DATE: 4/10/2012		
																									PROJECT MANAGER: A. GAMBLE			DRAWN BY: J. KELLY		
							VERMONT AGENCY OF TRANSPORTATION																			DESIGNED BY: J. KELLY			CHECKED BY: A. GAMBLE	
TOWN DIRECTIONAL TOTALS							634.4	0.0	28.0	1.0	1.0	127	0.0	0.0	88	1320.0			0	0.0				MARLBORO EB SHEET 8			SHEET 53 OF 80			

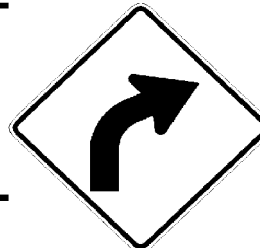
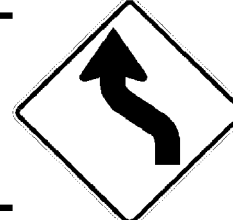
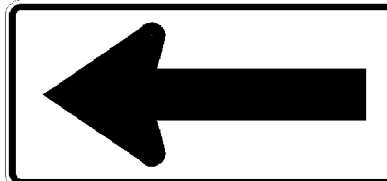
DIRECTION	MILEPOINT	LOCATION CODE (SHEET 2)	SIGN CODE	WIDTH (IN)	HEIGHT (IN)	SHEETING REMARKS	SIGN LEGEND	NEW SIGNS		EXISTING SIGNS				EXIST POST		NUMBER OF NEW POSTS	SQUARE STEEL (IN)			TUBULAR STEEL Ø (IN)				SIGN FRAME REQUIRED	REMARKS	SIGN DETAIL LOCATION			
								"A"	"B"	RETAIN	SALVAGE FROM	SALVAGE TO	REMOVE	RETAIN	REMOVE		1.75	2.00	2.50	FOUNDATION	3.0	3.50	4.00			5.00	SHSM	PROJECT SHEET #	STANDARD SHEET #
																	(LB / FT)				(LB / FT)								
																	1.88	2.42	3.35		7.6	9.00	10.80			14.60			
MARLBORO EB							FY-FLUORESCENT YELLOW FYG-FLUORESCENT YELLOW GREEN															"SHSM"-STANDARD HIGHWAY SIGNS AND MARKINGS							
		A	M3-2	24	12			2.00																		E-136B			
		A	M1-5	24	24			4.00																		E-136B			
EB	3.789	A	M3-2	24	12		EAST						1	X						RETAIN	POST					RETAIN	POST		
		A	M1-5	24	24		VERMONT ROUTE 9 						1																
		A	R2-1	24	30			5.00																		X			
EB	3.821	A	R2-1	24	30		SPEED LIMIT 50						1		X														
EB	3.854	A	R4-3	24	30								1	X	X														
		A	R4-3	24	30																					X			
EB	3.948	A	VW-133L	30	30		HIDDEN DRIVES LEFT						1		X														
EB	4.039	A	R4-3	24	30		SLOWER TRAFFIC KEEP RIGHT						1		X														
EB	4.086	A	W9-1R	36	36			9.00								2		X							INSTALL 300 FEET WEST OF LANE MERGE SYMBOL SIGN.	X			
EB	4.143	A	W4-2R	36	36								1		X														
		A	W4-2R	36	36			9.00								2		X								X			
EB	4.219	A	W1-2L	30	30	FY		6.25								1		X							INSTALL 400 FEET EAST OF RIGHT LANE REDUCTION SYMBOL SIGN.	X			
EB	4.288	A	W1-8L	24	30	FY		5.00								1		X							INSTALL 250 WEST OF EXISTING FIRST CHEVRON.	X			
SIGN SUMMARY SHEET							SHEET TOTALS	40.25	0.00	0	0	0	7	0	0	6	90			0	0.0	0.0	0.0	0.0	PROJECT NAME: WOODFORD-MARLBORO				
								SF	SF	EA	EA	EA	EA	EA	EA	EA		FT		EA	LB	LB	LB	LB	PROJECT NUMBER: STPG SIGN(35)				
																									FILE NAME: 10B336				
VERMONT AGENCY OF TRANSPORTATION																								PROJECT MANAGER: A. GAMBLE					
							TOWN DIRECTIONAL TOTALS	634.4	0.0	28.0	1.0	1.0	127	0.0	0.0	88	1320.0			0	0.0				DESIGNED BY: J. KELLY				
																							PLOT DATE: 4/10/2012						
																							DRAWN BY: J. KELLY						
																							CHECKED BY: A. GAMBLE						
																							MARLBORO EB SHEET 9						
																							SHEET 54 OF 80						

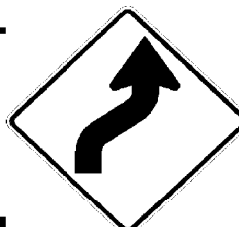
DIRECTION	MILEPOINT	LOCATION CODE (SHEET 2)	SIGN CODE	WIDTH (IN)	HEIGHT (IN)	SHEETING REMARKS	SIGN LEGEND	NEW SIGNS		EXISTING SIGNS				EXIST POST		NUMBER OF NEW POSTS	SQUARE STEEL (IN)			TUBULAR STEEL Ø (IN)				SIGN FRAME REQUIRED	REMARKS	SIGN DETAIL LOCATION			
								"A"	"B"	RETAIN	SALVAGE FROM	SALVAGE TO	REMOVE	RETAIN	REMOVE		1.75	2.00	2.50	FOUNDATION	3.0	3.50	4.00			5.00	SHSM	PROJECT SHEET #	STANDARD SHEET #
																	(LB / FT)				(LB / FT)								
																	1.88	2.42	3.35		7.6	9.00	10.80			14.60			
MARLBORO EB							FY-FLUORESCENT YELLOW FYG-FLUORESCENT YELLOW GREEN															"SHSM"-STANDARD HIGHWAY SIGNS AND MARKINGS							
EB	4.322	C	VR-017	24	30								1	X						RETAIN	POST			TOWN HILL RD (TH-4)		RETAIN	POST		
		C	VR-017	24	30			5.00																	7				
EB	4.330	D	R1-1	30	30								1	X						RETAIN	POST			TOWN HILL RD (TH-4)		RETAIN	POST		
		D	R1-1	30	30		 	6.25																	X				
EB	4.335	A	W1-8L	18	24								1		X														
		A	W1-8L	24	30	FY		5.00							1		X								X				
EB	4.360	A	W1-8L	18	24		CHEVRON						1		X														
EB	4.385	A	W1-8L	18	24								1		X														
		A	W1-8L	24	30	FY		5.00							1		X								X				
EB	4.409	A	W1-8L	18	24		CHEVRON						1		X														
EB	4.654	A	VW-619	36	36								1		X														
		A	VW-619	36	36			9.00							2		X									8			
EB	4.827	A	M3-2	24	12								1	X						RETAIN	POST					RETAIN	POST		
		A	M1-5	24	24								1																
		A	M3-2	24	12			2.00																		E-136B			
SIGN SUMMARY SHEET							SHEET TOTALS		32.25	0.00	0	0	0	9	0	0	4	60			0	0.0	0.0	0.0	0.0	PROJECT NAME: WOODFORD-MARLBORO			
									SF	SF	EA	EA	EA	EA	EA	EA	EA		FT		EA	LB	LB	LB	LB	PROJECT NUMBER: STPG SIGN(35)			
																										FILE NAME: 10B336			
							VERMONT AGENCY OF TRANSPORTATION																				PROJECT MANAGER: A. GAMBLE		
							TOWN DIRECTIONAL TOTALS		634.4	0.0	28.0	1.0	1.0	127	0.0	0.0	88	1320.0			0	0.0				DESIGNED BY: J. KELLY			
																								PLOT DATE: 4/10/2012					
																								DRAWN BY: J. KELLY					
																								CHECKED BY: A. GAMBLE					
																								MARLBORO EB SHEET 10					
																								SHEET 55 OF 80					

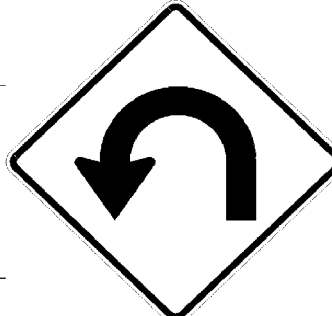
DIRECTION	MILEPOINT	LOCATION CODE (SHEET 2)	SIGN CODE	WIDTH (IN)	HEIGHT (IN)	SHEETING REMARKS	SIGN LEGEND	NEW SIGNS		EXISTING SIGNS				EXIST POST		NUMBER OF NEW POSTS	SQUARE STEEL (IN)			TUBULAR STEEL Ø (IN)				SIGN FRAME REQUIRED	REMARKS	SIGN DETAIL LOCATION			
								"A"	"B"	RETAIN	SALVAGE FROM	SALVAGE TO	REMOVE	RETAIN	REMOVE		1.75	2.00	2.50	FOUNDATION	3.0	3.50	4.00			5.00	SHSM	PROJECT SHEET #	STANDARD SHEET #
																	(LB / FT)				(LB / FT)								
																	1.88	2.42	3.35		7.6	9.00	10.80			14.60			
MARLBORO EB							FY-FLUORESCENT YELLOW FYG-FLUORESCENT YELLOW GREEN															"SHSM"-STANDARD HIGHWAY SIGNS AND MARKINGS							
		A	M1-5	24	24			4.00																		E-136B			
		A	VM-120	18	24		MOLLY STARK BYWAY			1																			
EB	4.856	A	R2-1	24	30		SPEED LIMIT 50						1		X														
EB	4.903	A	W1-2R	30	30	FY		6.25								1		X						INSTALL 250 FEET EAST OF EXISTING SPEED LIMIT 50 ASSEMBLY.	X				
EB	5.065	A	VW-133R	30	30		HIDDEN DRIVES RIGHT			1				X															
EB	5.090	A	S3-1	30	30								1		X														
		A	S3-1	36	36	FYG		9.00								2		X								X			
EB	5.241	A	W1-10L	30	30		LEFT CURVE WITH SIDE ROAD RIGHT			+			1	X	X														
		A	W13-1	18	18		35 MPH ADVISORY						1																
		A	W1-10L	36	36	FY		9.00																	X				
		A	W16-8P	24	8	FY		1.33																		8			
EB	5.255	A	VD-062B	72	16		BUSINESS SIGN			1				X															
EB	5.293	A	W1-6L	48	24		LARGE ARROW			1				X															
EB	5.293	B	W1-8R	24	30		CHEVRON			1				X															
EB	5.307	A	VW-205	30	30		WATCH FOR TURNING VEHICLES						1		X														
SIGN SUMMARY SHEET							SHEET TOTALS	29.58	0.00	6	0	0	54	0	0	3	45			0	0.0	0.0	0.0	0.0	PROJECT NAME: WOODFORD-MARLBORO				
								SF	SF	EA	EA	EA	EA	EA	EA	EA		FT		EA	LB	LB	LB	LB	PROJECT NUMBER: STPG SIGN(35)				
							VERMONT AGENCY OF TRANSPORTATION																			FILE NAME: 10B336			PLOT DATE: 4/10/2012
							TOWN DIRECTIONAL TOTALS	634.4	0.0	28.0	1.0	1.0	127	0.0	0.0	88	1320.0			0	0.0				PROJECT MANAGER: A. GAMBLE				
																								DRAWN BY: J. KELLY					
																							DESIGNED BY: J. KELLY						
																							CHECKED BY: A. GAMBLE						
																							MARLBORO EB SHEET 11						
																							SHEET 56 OF 80						

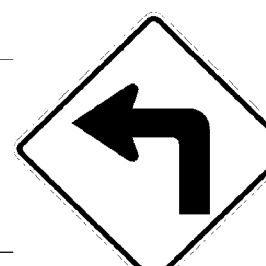
DIRECTION	MILEPOINT	LOCATION CODE (SHEET 2)	SIGN CODE	WIDTH (IN)	HEIGHT (IN)	SHEETING REMARKS	SIGN LEGEND	NEW SIGNS		EXISTING SIGNS				EXIST POST		NUMBER OF NEW POSTS	SQUARE STEEL (IN)			TUBULAR STEEL Ø (IN)				SIGN FRAME REQUIRED	REMARKS	SIGN DETAIL LOCATION			
								"A"	"B"	RETAIN	SALVAGE FROM	SALVAGE TO	REMOVE	RETAIN	REMOVE		1.75	2.00	2.50	FOUNDATION	3.0	3.50	4.00			5.00	SHSM	PROJECT SHEET #	STANDARD SHEET #
																	(LB / FT)				(LB / FT)								
																	1.88	2.42	3.35		7.6	9.00	10.80			14.60			
MARLBORO EB							FY-FLUORESCENT YELLOW FYG-FLUORESCENT YELLOW GREEN															"SHSM"-STANDARD HIGHWAY SIGNS AND MARKINGS							
EB	5.319	A	W1-8L	24	30		CHEVRON			1				X															
EB	5.319	B	W1-8R	24	30		CHEVRON			1				X															
EB	5.341	A	W1-8L	24	30		CHEVRON			1				X															
EB	5.341	B	W1-8R	24	30		CHEVRON			1				X															
EB	5.358	A	D1-1	72	10		Marlboro1➡					1		X															
		A	VD1-1A	72	12			6.00								2		X									6		
EB	5.377	A	W1-8L	24	30		CHEVRON			1				X															
EB	5.378	B	W1-8R	24	30		CHEVRON			1				X															
EB	5.398	C	VR-017	24	30		(ASSEMBLY IS MISSING)						+		X										SOUTH RD (TH-3)	ALL MISSING R/S SL 35			
		C	VR-017	24	30		LEGAL LOAD LIMIT 24,000 POUNDS SPEED LIMIT 35 INSTALL BELOW LLL ➡	5.00		I	I	I				1		X										7	
EB	5.409	D	R1-1	30	30		STOP						1	X						RETAIN POST						SOUTH RD (TH-3)	RETAIN POST		
		D	R1-1	30	30			6.25																		X			
EB	5.413	A	W1-8L	24	30		(ASSEMBLY IS MISSING)						1		X														
		A	W1-8L	24	30	FY	➡	5.00								1		X								X			
EB	5.414	B	W1-6R	48	24		LARGE ARROW			1				X															
SIGN SUMMARY SHEET							SHEET TOTALS		22.25	0.00	7	0	0	4	0	0	4	60			0	0.0	0.0	0.0	0.0	PROJECT NAME: WOODFORD-MARLBORO			
									SF	SF	EA	EA	EA	EA	EA	EA	EA		FT		EA	LB	LB	LB	LB	PROJECT NUMBER: STPG SIGN(35)			
																										FILE NAME: 10B336			
							VERMONT AGENCY OF TRANSPORTATION																			PROJECT MANAGER: A. GAMBLE			
							TOWN DIRECTIONAL TOTALS		634.4	0.0	28.0	1.0	1.0	127	0.0	0.0	88	1320.0			0	0.0				PLOT DATE: 4/10/2012			
																								DRAWN BY: J. KELLY					
																								CHECKED BY: A. GAMBLE					
																								DESIGNED BY: J. KELLY					
																								MARLBORO EB SHEET 12					
																								SHEET 57 OF 80					

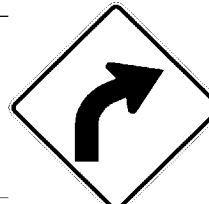
DIRECTION	MILEPOINT	LOCATION CODE (SHEET 2)	SIGN CODE	WIDTH (IN)	HEIGHT (IN)	SHEETING REMARKS	SIGN LEGEND	NEW SIGNS		EXISTING SIGNS				EXIST POST		NUMBER OF NEW POSTS	SQUARE STEEL (IN)			TUBULAR STEEL Ø (IN)				SIGN FRAME REQUIRED	REMARKS	SIGN DETAIL LOCATION			
								"A"	"B"	RETAIN	SALVAGE FROM	SALVAGE TO	REMOVE	RETAIN	REMOVE		1.75	2.00	2.50	FOUNDATION	3.0	3.50	4.00			5.00	SHSM	PROJECT SHEET #	STANDARD SHEET #
																	(LB / FT)				(LB / FT)								
																	1.88	2.42	3.35		7.6	9.00	10.80			14.60			
MARLBORO EB							FY-FLUORESCENT YELLOW FYG-FLUORESCENT YELLOW GREEN															"SHSM"-STANDARD HIGHWAY SIGNS AND MARKINGS							
EB	5.437	A	W1-8L	24	30		CHEVRON			1				X															
EB	5.454	A	S1-1	36	36		SCHOOL PENTAGON			1				X									RETAIN SIGN, POSTS AND FLASHING BEACONS.		RETAIN POSTS				
		A	W16-9	30	18		AHEAD						1																
		A	S4-3P	36	12	FYG	SCHOOL	3.00															INSTALL BELOW EXISTING SCHOOL SYMBOL SIGN.	X					
EB	5.496	A	D1-1E	72	20		Marlboro Elem. School →						1	X											RETAIN POSTS				
		A	VD1-1	72	20			10.00																	7				
EB	5.762	A	VW-092	36	36		UNSAFE TO PASS						1	X												RETAIN POSTS			
		A	VW-092	36	36			9.00																	8				
EB	5.803	A	W1-4R	30	30		RIGHT REVERSE CURVE						1		X														
EB	6.009	A	W1-8L	18	24		CHEVRON						1		X														
EB	6.053	A	R2-1	24	30		SPEED LIMIT 50						1		X														
EB	6.056	A	W1-8L	18	24		CHEVRON						1																
		A	W1-6L	48	24	FY	←	8.00								2		X							X				
EB	6.084	A	W1-8L	18	24		CHEVRON						1		X														
EB	6.324	A	VW-205	36	36		WATCH FOR TURNING VEHICLES						1		X														
SIGN SUMMARY SHEET							SHEET TOTALS	30.00	0.00	2	0	0	9.00	0	0	2	30			0	0.0	0.0	0.0	0.0	PROJECT NAME: WOODFORD-MARLBORO				
								SF	SF	EA	EA	EA	EA	EA	EA	EA	FT		EA	LB	LB	LB	LB	PROJECT NUMBER: STPG SIGN(35)					
																								FILE NAME: 10B336					
							VERMONT AGENCY OF TRANSPORTATION																		PROJECT MANAGER: A. GAMBLE				
TOWN DIRECTIONAL TOTALS																							DESIGNED BY: J. KELLY						
																								PLOT DATE: 4/10/2012					
																						DRAWN BY: J. KELLY							
																							CHECKED BY: A. GAMBLE						
																							MARLBORO EB SHEET 13						
																							SHEET 58 OF 80						

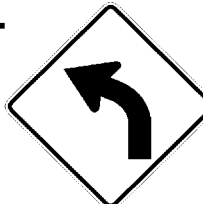
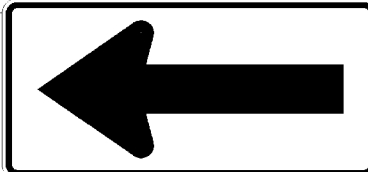
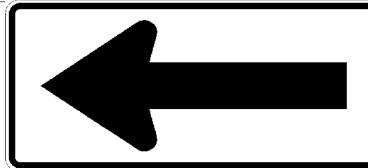
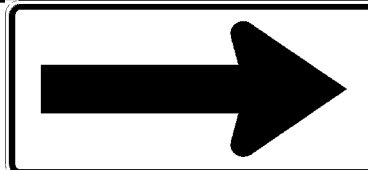
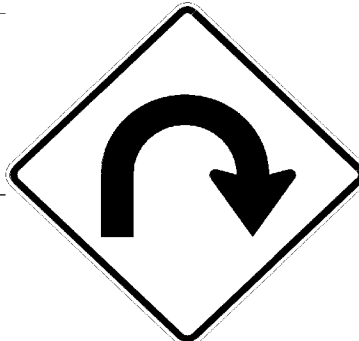
DIRECTION	MILEPOINT	LOCATION CODE (SHEET 2)	SIGN CODE	WIDTH (IN)	HEIGHT (IN)	SHEETING REMARKS	SIGN LEGEND	NEW SIGNS		EXISTING SIGNS				EXIST POST		NUMBER OF NEW POSTS	SQUARE STEEL (IN)			TUBULAR STEEL Ø (IN)				SIGN FRAME REQUIRED	REMARKS	SIGN DETAIL LOCATION			
								"A"	"B"	RETAIN	SALVAGE FROM	SALVAGE TO	REMOVE	RETAIN	REMOVE		1.75	2.00	2.50	FOUNDATION	3.0	3.50	4.00			5.00	SHSM	PROJECT SHEET #	STANDARD SHEET #
																	(LB / FT)				(LB / FT)								
																	1.88	2.42	3.35		7.6	9.00	10.80			14.60			
MARLBORO EB							FY-FLUORESCENT YELLOW FYG-FLUORESCENT YELLOW GREEN															"SHSM"-STANDARD HIGHWAY SIGNS AND MARKINGS							
EB	6.377	A	VW-205	36	36			9.00							2		X						INSTALL 50 FEET WEST OF CURRENT RIGHT CURVE SIGN LOCATION.		8				
EB	6.387	A	W1-2R	30	30		RIGHT CURVE						1		X														
EB	6.415	A	W1-2R	30	30			6.25							1		X						INSTALL 150 FEET EAST OF CURRENT LOCATION.	X					
EB	6.606	A	S3-1	30	30								1		X										TRIM BRUSH				
		A	S3-1	36	36	FYG		9.00							2		X							X					
EB	6.819	A	W1-4L	30	30			6.25							1		X						INSTALL 75 FEET WEST OF EXISTING UNSAFE TO PASS ASSEMBLY.	X					
EB	6.833	A	VW-092	36	36		UNSAFE TO PASS						1		X														
EB	6.866	A	W1-2L	30	30		RIGHT LEFT CURVE						1		X										RIGHT CURVE				
		A	W13-1	18	18		40 MPH ADVISORY						1																
		A	W1-6L	48	24			8.00							2		X							X					
EB	7.015	A	W1-4L	30	30		RIGHT REVERSE CURVE						1		X														
		A	W13-1	18	18		40 MPH ADVISORY						1																
EB	7.080	A	W8-5	30	30		SLIPPERY WHEN WET CAR SYMBOL			1				X															
		A	VW-116	24	18		ICING MAY OCCUR			1																			
EB	7.157	A	S3-1	30	30								1		X														
SIGN SUMMARY SHEET							TOTALS	38.50	0.00	2	0	0	8	0	0	8	120			0	0.0	0.0	0.0	0.0	PROJECT NAME: WOODFORD-MARLBORO				
								SF	SF	EA	EA	EA	EA	EA	EA	EA		FT		EA	LB	LB	LB	LB	PROJECT NUMBER: STPG SIGN(35)				
							VERMONT AGENCY OF TRANSPORTATION																		FILE NAME: 10B336				
							TOWN DIRECTIONAL TOTALS			634.4	0.0	28.0	1.0	1.0	127	0.0	0.0	88	1320.0			0	0.0				PLOT DATE: 4/10/2012		
																							PROJECT MANAGER: A. GAMBLE						
																							DESIGNED BY: J. KELLY						
																							MARLBORO EB SHEET 14						
																							SHEET 59 OF 80						

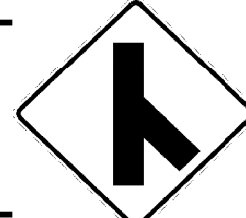
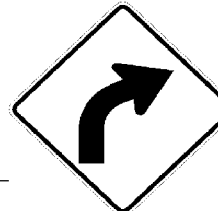
DIRECTION	MILEPOINT	LOCATION CODE (SHEET 2)	SIGN CODE	WIDTH (IN)	HEIGHT (IN)	SHEETING REMARKS	SIGN LEGEND	NEW SIGNS		EXISTING SIGNS				EXIST POST		NUMBER OF NEW POSTS	SQUARE STEEL (IN)			TUBULAR STEEL Ø (IN)				SIGN FRAME REQUIRED	REMARKS	SIGN DETAIL LOCATION				
								"A"	"B"	RETAIN	SALVAGE FROM	SALVAGE TO	REMOVE	RETAIN	REMOVE		1.75	2.00	2.50	FOUNDATION	3.0	3.50	4.00			5.00	SHSM	PROJECT SHEET #	STANDARD SHEET #	
																	(LB / FT)				(LB / FT)									
																	1.88	2.42	3.35		7.6	9.00	10.80			14.60				
MARLBORO EB							FY-FLUORESCENT YELLOW FYG-FLUORESCENT YELLOW GREEN															"SHSM"-STANDARD HIGHWAY SIGNS AND MARKINGS								
		A	S3-1	36	36	FYG		9.00							2	X								X						
EB	7.241	A	VD-062B	72	16		BUSINESS SIGN			1				X																
EB	7.309	C	VR-017	24	30								1	X					RETAIN POST					MACARTHUR RD (TH-26)		RETAIN POST				
		C	VR-017	24	30			5.00																	7					
EB	7.319	D	R1-1	30	30								1		X										MACARTHUR RD (TH-26)					
		D	R1-1	30	30			6.25								1	X								X					
EB	7.368	A	M3-2	24	12								1	X					RETAIN POST						RETAIN POST					
		A	M1-5	24	24								1																	
		A	M3-2	24	12			2.00																			E-136B			
		A	M1-5	24	24			4.00																			E-136B			
EB	7.406	A	R2-1	24	30								1	X					RETAIN POST						RETAIN POST					
		A	R2-1	24	30			5.00																	X					
EB	7.515	A	W1-4R	30	30		RIGHT REVERSE CURVE						1		X															
		A	W13-1P	18	18		40 MPH ADVISORY						1																	
EB	7.535	A	W1-4R	30	30	FY		6.25								1	X								INSTALL 100+/- FEET EAST OF EXISTING REVERSE CURVE ASSEMBLY.	X				
SIGN SUMMARY SHEET							SHEET TOTALS	37.50	0.00	1	0	0	7	0	0	4	60			0	0.0	0.0	0.0	0.0	PROJECT NAME: WOODFORD-MARLBORO					
								SF	SF	EA	EA	EA	EA	EA	EA	EA		FT		EA	LB	LB	LB	LB	PROJECT NUMBER: STPG SIGN(35)					
							VERMONT AGENCY OF TRANSPORTATION																					FILE NAME: 10B336		
							TOWN DIRECTIONAL TOTALS							634.4	0.0	28.0	1.0	1.0	127	0.0	0.0	88	1320.0			0	0.0			
																								DRAWN BY: J. KELLY						
																								CHECKED BY: A. GAMBLE						
																								DESIGNED BY: J. KELLY						
																								MARLBORO EB SHEET 15						
																								SHEET 60 OF 80						

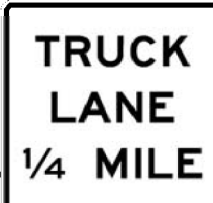
DIRECTION	MILEPOINT	LOCATION CODE (SHEET 2)	SIGN CODE	WIDTH (IN)	HEIGHT (IN)	SHEETING REMARKS	SIGN LEGEND	NEW SIGNS		EXISTING SIGNS				EXIST POST		NUMBER OF NEW POSTS	SQUARE STEEL (IN)			TUBULAR STEEL Ø (IN)				SIGN FRAME REQUIRED	REMARKS	SIGN DETAIL LOCATION			
								"A"	"B"	RETAIN	SALVAGE FROM	SALVAGE TO	REMOVE	RETAIN	REMOVE		1.75	2.00	2.50	FOUNDATION	3.0	3.50	4.00			5.00	SHSM	PROJECT SHEET #	STANDARD SHEET #
																	(LB / FT)				(LB / FT)								
																	1.88	2.42	3.35		7.6	9.00	10.80			14.60			
MARLBORO EB							FY-FLUORESCENT YELLOW FYG-FLUORESCENT YELLOW GREEN															"SHSM"-STANDARD HIGHWAY SIGNS AND MARKINGS							
			W13-1P	18	18	FY		2.25																X					
EB	7.636	A	VW-537L	48	48		LEFT ACUTE CURVE						1		X														
		A	W13-1	18	18		30 MPH ADVISORY						1												TRIM BRUSH				
		A	W1-11L	36	36	FY		9.00								2			X			SLIP BASES		SEE SHEET 2.	X	SLIP BASES			
		A	W13-1P	24	24	FY		4.00																X					
EB	7.695	A	W1-8L	24	30								1		X														
		A	W1-8L	24	30	FY		5.00								1			X						X				
EB	7.695	B	W1-8R	24	30								1		X														
		B	W1-8R	24	30	FY		5.00								1			X						X				
EB	7.717	A	W1-8L	24	30								1		X														
		A	W1-8L	24	30	FY		5.00								1			X						X				
EB	7.717	B	W1-8R	24	30								1		X														
		B	W1-8R	24	30	FY		5.00								1			X						X				
EB	7.735	A	W1-1LM	30	30		LEFT TURN WITH LEFT SIDE ROAD						1		X														
		A	W13-1P	18	18		30 MPH ADVISORY						1																
SIGN SUMMARY SHEET							SHEET TOTALS	35.25	0.00	0	0	0	8	0	0	6	90			0	0.0	0.0	0.0	0.0	PROJECT NAME: WOODFORD-MARLBORO				
								SF	SF	EA	EA	EA	EA	EA	EA	EA		FT		EA	LB	LB	LB	LB	PROJECT NUMBER: STPG SIGN(35)				
							VERMONT AGENCY OF TRANSPORTATION																			FILE NAME: 10B336			
							TOWN DIRECTIONAL TOTALS						634.4	0.0	28.0	1.0	1.0	127	0.0	0.0	88	1320.0			0	0.0			
																							DRAWN BY: J. KELLY						
																							CHECKED BY: A. GAMBLE						
																							SHEET 61 OF 80						

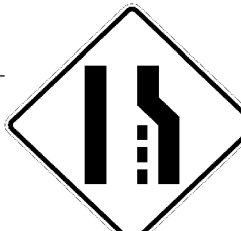
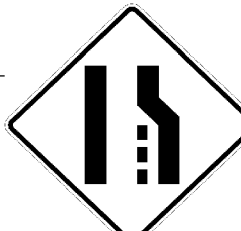
DIRECTION	MILEPOINT	LOCATION CODE (SHEET 2)	SIGN CODE	WIDTH (IN)	HEIGHT (IN)	SHEETING REMARKS	SIGN LEGEND	NEW SIGNS		EXISTING SIGNS				EXIST POST		NUMBER OF NEW POSTS	SQUARE STEEL (IN)			TUBULAR STEEL Ø (IN)				SIGN FRAME REQUIRED	REMARKS	SIGN DETAIL LOCATION			
								"A"	"B"	RETAIN	SALVAGE FROM	SALVAGE TO	REMOVE	RETAIN	REMOVE		1.75	2.00	2.50	FOUNDATION	3.0	3.50	4.00			5.00	SHSM	PROJECT SHEET #	STANDARD SHEET #
																	(LB / FT)				(LB / FT)								
																	1.88	2.42	3.35		7.6	9.00	10.80			14.60			
MARLBORO EB							FY-FLUORESCENT YELLOW FYG-FLUORESCENT YELLOW GREEN															"SHSM"-STANDARD HIGHWAY SIGNS AND MARKINGS							
		A	W1-8L	24	30	FY		5.00							1		X							X					
EB	7.735	B	W1-8R	24	30	FY		5.00							1		X							X					
EB	7.763	A	W1-8L	24	30		CHEVRON						1		X														
		A	W1-1L	30	30	FY		6.25							1		X							X					
		A	W13-1P	18	18	FY		2.25																X					
EB	7.786	A	W1-8L	24	30								1		X														
		A	W1-8L	24	30	FY		5.00							1		X							X					
EB	7.786	B	W1-8R	24	30								1		X														
		B	W1-8R	24	30	FY		5.00							1		X							X					
EB	7.812	A	W1-8L	24	30		 						1		X											R/S MM			
		A	W1-8L	24	30	FY		5.00							1		X							X					
EB	7.812	B	W1-8R	24	30								1		X														
		B	W1-8R	24	30	FY		5.00							1		X							X					
EB	7.830	A	W1-8L	24	30								1		X														
		A	W1-8L	24	30	FY		5.00							1		X							X					
SIGN SUMMARY SHEET							SHEET TOTALS	43.50	0.00	0	0	0	7	0	0	8	120			0	0.0	0.0	0.0	0.0	PROJECT NAME: WOODFORD-MARLBORO				
								SF	SF	EA	EA	EA	EA	EA	EA	EA		FT		EA	LB	LB	LB	LB	PROJECT NUMBER: STPG SIGN(35)				
																									FILE NAME: 10B336				
							VERMONT AGENCY OF TRANSPORTATION																						PROJECT MANAGER: A. GAMBLE
TOWN DIRECTIONAL TOTALS																								PLOT DATE: 4/10/2012					
																											DRAWN BY: J. KELLY		
																								DESIGNED BY: J. KELLY					
																											CHECKED BY: A. GAMBLE		
																								MARLBORO EB SHEET 17					
																											SHEET 62 OF 80		

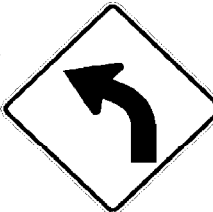
DIRECTION	MILEPOINT	LOCATION CODE (SHEET 2)	SIGN CODE	WIDTH (IN)	HEIGHT (IN)	SHEETING REMARKS	SIGN LEGEND	NEW SIGNS		EXISTING SIGNS				EXIST POST		NUMBER OF NEW POSTS	SQUARE STEEL (IN)			TUBULAR STEEL Ø (IN)				SIGN FRAME REQUIRED	REMARKS	SIGN DETAIL LOCATION							
								"A"	"B"	RETAIN	SALVAGE FROM	SALVAGE TO	REMOVE	RETAIN	REMOVE		1.75	2.00	2.50	FOUNDATION	3.0	3.50	4.00			5.00	SHSM	PROJECT SHEET #	STANDARD SHEET #				
																	(LB / FT)				(LB / FT)												
																	1.88	2.42	3.35		7.6	9.00	10.80			14.60							
MARLBORO EB							FY-FLUORESCENT YELLOW FYG-FLUORESCENT YELLOW GREEN															"SHSM"-STANDARD HIGHWAY SIGNS AND MARKINGS											
EB	7.830	B	W1-8R	24	30							1		X																			
		B	W1-8R	24	30	FY		5.00								1		X								X							
EB	7.852	A	W1-8L	24	30							1		X																			
		A	W1-8L	24	30	FY		5.00								1		X								X							
EB	7.852	B	W1-8R	24	30		 					1		X																			
		B	W1-8R	24	30	FY		5.00								1		X								X							
EB	7.885	A	S3-1	36	36	FYG		9.00								2		X						INSTALL 70 FEET WEST OF EXISTING RIGHT CURVE SIGN ASSEMBLY.	X								
EB	7.898	A	W1-2R	30	30		RIGHT CURVE					1		X																			
		A	W13-1P	18	18		35 MPH ADVISORY					1																					
EB	7.923	A	S3-1	30	30		SCHOOL BUS STOP AHEAD					1		X																			
		A	W1-2R	30	30	FY		6.25								1		X								X							
		A	W13-1P	18	18	FY		2.25																		X							
EB	8.039	A	W1-2R	30	30		RIGHT CURVE					1		X																			
EB	8.088	A	M3-2	24	12		EAST					1		X																			
		A	M1-5	24	24		VERMONT ROUTE 9					1																					
SIGN SUMMARY SHEET							SHEET TOTALS	32.50	0.00	0	0	0	9	0	0	6	90			0	0.0	0.0	0.0	0.0	PROJECT NAME: WOODFORD-MARLBORO								
								SF	SF	EA	EA	EA	EA	EA	EA	EA	FT			EA	LB	LB	LB	LB	PROJECT NUMBER: STPG SIGN(35)								
							VERMONT AGENCY OF TRANSPORTATION																					FILE NAME: 10B336			PLOT DATE: 4/10/2012		
														TOWN DIRECTIONAL TOTALS							634.4	0.0	28.0	1.0	1.0	127	0.0	0.0	88	1320.0			0
																							DESIGNED BY: J. KELLY			CHECKED BY: A. GAMBLE							
																								MARLBORO EB SHEET 18			SHEET 63 OF 80						

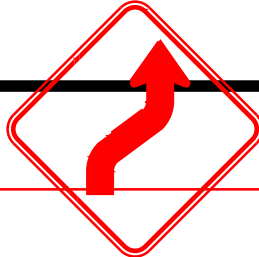
DIRECTION	MILEPOINT	LOCATION CODE (SHEET 2)	SIGN CODE	WIDTH (IN)	HEIGHT (IN)	SHEETING REMARKS	SIGN LEGEND	NEW SIGNS		EXISTING SIGNS				EXIST POST		NUMBER OF NEW POSTS	SQUARE STEEL (IN)			TUBULAR STEEL Ø (IN)				SIGN FRAME REQUIRED	REMARKS	SIGN DETAIL LOCATION			
								"A"	"B"	RETAIN	SALVAGE FROM	SALVAGE TO	REMOVE	RETAIN	REMOVE		1.75	2.00	2.50	FOUNDATION	3.0	3.50	4.00			5.00	SHSM	PROJECT SHEET #	STANDARD SHEET #
																	(LB / FT)				(LB / FT)								
																	1.88	2.42	3.35		7.6	9.00	10.80			14.60			
MARLBORO WB							FY-FLUORESCENT YELLOW FYG-FLUORESCENT YELLOW GREEN															"SHSM"-STANDARD HIGHWAY SIGNS AND MARKINGS							
WB	8.104	F	W1-2L	30	30		LEFT CURVE						1		X														
		F	W13-1P	18	18		35 MPH ADVISORY						1																
WB	8.047	F	W1-2L	30	30	FY		6.25								1		X						INSTALL 300 FEET WEST OF EXISTING LEFT CURVE SIGN ASSEMBLY.	X				
		F	W13-1P	18	18	FY		2.25																	X				
WB	8.005	F	W1-6L	48	24								1		X														
		F	W1-6L	48	24	FY			8.00								2		X						X				
WB	8.004	E	W1-6R	48	24								1		X														
WB	8.003	E	W1-6R	48	24	FY			8.00								2		X						MAINTAIN 10 FEET CLEAR SPACE BETWEEN SIGNS.	X			
WB	7.971	F	W1-6L	48	24								1		X														
		F	W1-6L	48	24	FY			8.00								2		X						X				
WB	7.970	E	W1-6R	48	24								1		X														
WB	7.969	E	W1-6R	48	24	FY			8.00								2		X						MAINTAIN 10 FEET CLEAR SPACE BETWEEN SIGNS.	X			
WB	7.945	F	VW-538RM	48	48		MODIFIED RIGHT ACUTE CURVE						1		X														
		F	W13-1	24	24								1																
		F	W1-11R	36	36	FY		9.00								2			X					SEE SHEET 2.	X				
SIGN SUMMARY SHEET							SHEET TOTALS	49.50	0.00	0	0	0	8	0	0	11	165			0	0.0	0.0	0.0	0.0	PROJECT NAME: WOODFORD-MARLBORO				
								SF	SF	EA	EA	EA	EA	EA	EA	EA		FT		EA	LB	LB	LB	LB	PROJECT NUMBER: STPG SIGN(35)				
																									FILE NAME: 10B336				
							VERMONT AGENCY OF TRANSPORTATION																					PROJECT MANAGER: A. GAMBLE	
TOWN DIRECTIONAL TOTALS																								DESIGNED BY: J. KELLY					
																											CHECKED BY: A. GAMBLE		
																											PLOT DATE: 4/10/2012		
																							DRAWN BY: J. KELLY						
																								SHEET 64 OF 80					
																								MARLBORO WB SHEET 1					

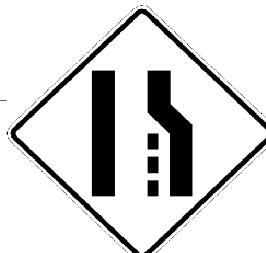
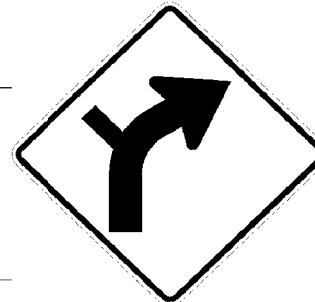
DIRECTION	MILEPOINT	LOCATION CODE (SHEET 2)	SIGN CODE	WIDTH (IN)	HEIGHT (IN)	SHEETING REMARKS	SIGN LEGEND	NEW SIGNS		EXISTING SIGNS				EXIST POST		NUMBER OF NEW POSTS	SQUARE STEEL (IN)			TUBULAR STEEL Ø (IN)				SIGN FRAME REQUIRED	REMARKS	SIGN DETAIL LOCATION						
								"A"	"B"	RETAIN	SALVAGE FROM	SALVAGE TO	REMOVE	RETAIN	REMOVE		1.75	2.00	2.50	FOUNDATION	3.0	3.50	4.00			5.00	SHSM	PROJECT SHEET #	STANDARD SHEET #			
																	(LB / FT)				(LB / FT)											
																	1.88	2.42	3.35		7.6	9.00	10.80			14.60						
MARLBORO WB							FY-FLUORESCENT YELLOW FYG-FLUORESCENT YELLOW GREEN															"SHSM"-STANDARD HIGHWAY SIGNS AND MARKINGS										
		F	W13-1	24	24	FY		4.00																X								
WB	7.898	F	W2-3L	30	30	FY		6.25							1		X							INSTALL 250 FEET WEST OF RIGHT ACUTE CURVE SIGN ASSEMBLY.	X							
WB	7.821	G	VR-017	24	30								1		X									HAMILTON RD (TH-22)								
		G	VR-017	24	30			5.00							1		X								7							
WB	7.812	H	R1-1	30	30								1		X									HAMILTON RD (TH-22)								
		H	R1-1	30	30			6.25							1		X							X								
							TOWN'S STREET NAME SIGN				1	1	1											REINSTALL ABOVE STOP SIGN USING BRACKET.								
WB	7.789	F	W1-4R	30	30		RIGHT REVERSE CURVE						1		X																	
		F	W13-1P	18	18		40 MPH ADVISORY						1																			
WB	7.751	F	W1-2R	30	30	FY		6.25							1		X							INSTALL 200 FEET WEST OF EXISTING REVERSE CURVE SIGN ASSEMBLY.	X							
		F	W13-1P	18	18	FY		2.25																	X							
WB	7.736	F	M3-4	24	12		WEST						1		X																	
		F	M1-5	24	24		VERMONT ROUTE 9						1																			
WB	7.700	F	S3-1	30	30		SCHOOL BUS STOP AHEAD						1		X																	
		F	S3-1	36	36			9.00							2		X							CUT BRUSH IN ADVANCE OF SIGN.	X	TRIM BRUSH						
SIGN SUMMARY SHEET							SHEET TOTALS	39.00	0.00	0	24	24	88	0	0	6	90			0	0.0	0.0	0.0	0.0	PROJECT NAME: WOODFORD-MARLBORO							
								SF	SF	EA	EA	EA	EA	EA	EA	EA		FT		EA	LB	LB	LB	LB	PROJECT NUMBER: STPG SIGN(35)							
							VERMONT AGENCY OF TRANSPORTATION			TOWN DIRECTIONAL TOTALS			607.1	0.0	23.0	1.0	1.0	117	0.0	0.0	70	1050.0			0	0.0				FILE NAME: 10B336		
																												DRAWN BY: J. KELLY				
																							DESIGNED BY: J. KELLY									
																							CHECKED BY: A. GAMBLE									
																							MARLBORO WB SHEET 2									
																							SHEET 65 OF 80									

DIRECTION	MILEPOINT	LOCATION CODE (SHEET 2)	SIGN CODE	WIDTH (IN)	HEIGHT (IN)	SHEETING REMARKS	SIGN LEGEND	NEW SIGNS		EXISTING SIGNS				EXIST POST		NUMBER OF NEW POSTS	SQUARE STEEL (IN)			TUBULAR STEEL Ø (IN)				SIGN FRAME REQUIRED	REMARKS	SIGN DETAIL LOCATION			
								"A"	"B"	RETAIN	SALVAGE FROM	SALVAGE TO	REMOVE	RETAIN	REMOVE		1.75	2.00	2.50	FOUNDATION	3.0	3.50	4.00			5.00	SHSM	PROJECT SHEET #	STANDARD SHEET #
																	(LB / FT)				(LB / FT)								
																	1.88	2.42	3.35		7.6	9.00	10.80			14.60			
MARLBORO WB							FY-FLUORESCENT YELLOW FYG-FLUORESCENT YELLOW GREEN															"SHSM"-STANDARD HIGHWAY SIGNS AND MARKINGS		TRIM BRUSH					
WB	7.517	F	D17-2	42	42			12.25							2		X							INSTALL 200 FEET EAST OF EXISTING BUSINESS SIGN.		6			
WB	7.479	F	VD-062B	72	16		BUSINESS SIGN			1				X															
WB	7.451	F	VD-123	36	36		511 TRAVEL INFO			1				X															
WB	7.390	F	R4-6	36	48		TRUCK LANE 500 FEET						1		X														
WB	7.345	F	W1-4R	30	30		 						1	X															
		F	W13-1P	18	18									1			RETAIN POSTS												
		F	W1-4R	30	30			6.25																		X			
		F	W13-1P	18	18			2.25																		X			
WB	7.296	F	R4-3	24	30								1	X															
		F	R4-3	24	30			5.00																		X			
WB	7.254	F	M3-4	24	12									1	X														
		F	M1-5	24	12									1															
		F	M3-4	24	12			2.00																				E-136B	
		F	M1-5	24	12			4.00																				E-136B	
WB	7.101	F	W1-2L	30	30		LEFT CURVE							1		X													
SIGN SUMMARY SHEET							SHEET TOTALS		31.75	0.00	2	0	0	7	0	0	2	30			0	0.0	0.0	0.0	0.0	PROJECT NAME: WOODFORD-MARLBORO			
									SF	SF	EA	EA	EA	EA	EA	EA	EA		FT		EA	LB	LB	LB	LB	PROJECT NUMBER: STPG SIGN(35)			
																											FILE NAME: 10B336		
																											DRAWN BY: J. KELLY		
VERMONT AGENCY OF TRANSPORTATION																								DESIGNED BY: J. KELLY					
																										CHECKED BY: A. GAMBLE			
TOWN DIRECTIONAL TOTALS									607.1	0.0	23.0	1.0	1.0	117	0.0	0.0	70	1050.0			0	0.0				MARLBORO WB SHEET 3			
																										PLOT DATE: 4/10/2012			
																							SHEET 66 OF 80						

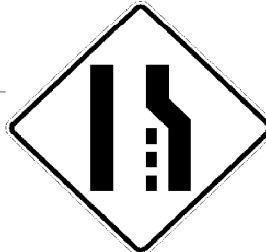
DIRECTION	MILEPOINT	LOCATION CODE (SHEET 2)	SIGN CODE	WIDTH (IN)	HEIGHT (IN)	SHEETING REMARKS	SIGN LEGEND	NEW SIGNS		EXISTING SIGNS				EXIST POST		NUMBER OF NEW POSTS	SQUARE STEEL (IN)			TUBULAR STEEL Ø (IN)				SIGN FRAME REQUIRED	REMARKS	SIGN DETAIL LOCATION			
								"A"	"B"	RETAIN	SALVAGE FROM	SALVAGE TO	REMOVE	RETAIN	REMOVE		1.75	2.00	2.50	FOUNDATION	3.0	3.50	4.00			5.00	SHSM	PROJECT SHEET #	STANDARD SHEET #
																	(LB / FT)				(LB / FT)								
																	1.88	2.42	3.35		7.6	9.00	10.80			14.60			
MARLBORO WB							FY-FLUORESCENT YELLOW FYG-FLUORESCENT YELLOW GREEN															"SHSM"-STANDARD HIGHWAY SIGNS AND MARKINGS							
		F	W13-1P	18	18		40 MPH ADVISORY						1																
WB	7.049	F	R2-1	24	30		SPEED LIMIT 50			1				X															
WB	7.003	F	W9-1R	36	36			9.00								2		X						INSTALL ON EASTERLY SIDE OF EXISTING CHEVRON.	X				
WB	7.002	E	W1-8R	18	24								1		X														
		E	W1-8R	24	30			5.00								1		X							X				
WB	6.977	F	W1-8L	18	24		CHEVRON						1		X									CURRENT CHEVRONS ARE ON AN ADJUSTABLE BRACKET.					
		E	W1-8R	18	24								1																
		E	W1-8R	24	30			5.00								1		X							X				
WB	6.954	F	W1-8L	18	24		CHEVRON						1		X									CURRENT CHEVRONS ARE ON AN ADJUSTABLE BRACKET.					
		E	W1-8R	18	24								1																
		E	W1-8R	24	30			5.00								1		X							X				
WB	6.941	F	W4-2R	36	36								1	X															
		F	W4-2R	36	36			9.00																	X				
WB	6.823	F	VR-186	24	30		TRUCK LANE ENDS						1		X														
WB	6.776	F	W1-10L	30	30		LEFT CURVE WITH SIDE ROAD RIGHT						1		X														
SIGN SUMMARY SHEET							SHEET TOTALS	33.00	0.00	1	0	0	9	0	0	5	75			0	0.0	0.0	0.0	0.0	PROJECT NAME: WOODFORD-MARLBORO				
								SF	SF	EA	EA	EA	EA	EA	EA	EA		FT		EA	LB	LB	LB	LB	PROJECT NUMBER: STPG SIGN(35)				
																									FILE NAME: 10B336				
							VERMONT AGENCY OF TRANSPORTATION																					PROJECT MANAGER: A. GAMBLE	
TOWN DIRECTIONAL TOTALS																							DESIGNED BY: J. KELLY						
																									CHECKED BY: A. GAMBLE				
																						MARLBORO WB SHEET 4							
																							PLOT DATE: 4/10/2012						
																							DRAWN BY: J. KELLY						
																							SHEET 67 OF 80						

DIRECTION	MILEPOINT	LOCATION CODE (SHEET 2)	SIGN CODE	WIDTH (IN)	HEIGHT (IN)	SHEETING REMARKS	SIGN LEGEND	NEW SIGNS		EXISTING SIGNS				EXIST POST		NUMBER OF NEW POSTS	SQUARE STEEL (IN)			TUBULAR STEEL Ø (IN)				SIGN FRAME REQUIRED	REMARKS	SIGN DETAIL LOCATION			
								"A"	"B"	RETAIN	SALVAGE FROM	SALVAGE TO	REMOVE	RETAIN	REMOVE		1.75	2.00	2.50	FOUNDATION	3.0	3.50	4.00			5.00	SHSM	PROJECT SHEET #	STANDARD SHEET #
																	(LB / FT)				(LB / FT)								
																	1.88	2.42	3.35		7.6	9.00	10.80			14.60			
MARLBORO WB							FY-FLUORESCENT YELLOW FYG-FLUORESCENT YELLOW GREEN															"SHSM"-STANDARD HIGHWAY SIGNS AND MARKINGS							
WB	6.727	F	VD-062B	72	16		WATCH FOR TURNING VEHICLES (MISSING)			+				X															
		F	W1-10L	36	36			9.00								2		X							X				
WB	6.661	G	VR-017	24	30								1	X															
		G	VR-017	24	30			5.00													RETAIN POSTS						TRIM BRUSH 7		
WB	6.654	H	R1-1	30	30		 						1	✖	X			X											
		H	R1-1	30	30			6.25																	X	TRIM BRUSH			
WB	6.619	F	VW-205	36	36			9.00								2		X										8	
WB	6.549 6.558	F	S3-1	36	36	FYG		9.00								2		X							X	INSTALL AT 6.549 ON EXISTING POSTS	6.549 ON POSTS		
WB	6.549	F	W1-2L	30	30		LEFT CURVE						1	X	✖					RETAIN POSTS									
		F	VW-133L	30	30		HIDDEN DRIVES LEFT						1	X															
WB	6.525	F	S3-1	30	30		SCHOOL BUS STOP AHEAD						1		X														
		F	W1-2L	30	30			6.25								2		X							X				
		F	VW-133L	30	30			6.25																			8		
WB	6.438	F	D17-2	42	42			12.25								2		X									6		
WB	6.255	F	R4-6	24	30		TRUCK LANE 500 FEET						1		X														
SIGN SUMMARY SHEET							SHEET TOTALS	63.00	0.00	1	2 0	2 0	9 6	0	0	10		150	0	0.0	0.0	0.0	0.0	PROJECT NAME: WOODFORD-MARLBORO					
								SF	SF	EA	EA	EA	EA	EA	EA	EA		FT		EA	LB	LB	LB	LB	PROJECT NUMBER: STPG SIGN(35)				
							TOWN DIRECTIONAL TOTALS	607.1	0.0	23.0	1.0	1.0	117	0.0	0.0	70		1050.0	0		0.0				FILE NAME: 10B336				
VERMONT AGENCY OF TRANSPORTATION																						PROJECT MANAGER: A. GAMBLE	PLOT DATE: 4/10/2012						
																								DESIGNED BY: J. KELLY	DRAWN BY: J. KELLY				
																						CHECKED BY: A. GAMBLE							
																								MARLBORO WB SHEET 5	SHEET 68 OF 80				

DIRECTION	MILEPOINT	LOCATION CODE (SHEET 2)	SIGN CODE	WIDTH (IN)	HEIGHT (IN)	SHEETING REMARKS	SIGN LEGEND	NEW SIGNS		EXISTING SIGNS				EXIST POST		NUMBER OF NEW POSTS	SQUARE STEEL (IN)			TUBULAR STEEL Ø (IN)				SIGN FRAME REQUIRED	REMARKS	SIGN DETAIL LOCATION			
								"A"	"B"	RETAIN	SALVAGE FROM	SALVAGE TO	REMOVE	RETAIN	REMOVE		1.75	2.00	2.50	FOUNDATION	3.0	3.50	4.00			5.00	SHSM	PROJECT SHEET #	STANDARD SHEET #
																	(LB / FT)				(LB / FT)								
																	1.88	2.42	3.35		7.6	9.00	10.80			14.60			
MARLBORO WB							FY-FLUORESCENT YELLOW FYG-FLUORESCENT YELLOW GREEN															"SHSM"-STANDARD HIGHWAY SIGNS AND MARKINGS							
WB	6.201												I										REMOVE AS PER JOE KELLY						
WB	6.161	F	R4-3	24	30								1	X															
		F	R4-3	24	30			5.00													RETAIN POST			X					
WB	6.124	F	VD-062B	72	16		BUSINESS SIGN			1				X															
WB	5.991	G	VR-017	24	30								1	X															
		G	VR-017	24	30			5.00														RETAIN POST			7				
WB	5.982	H	R1-1	30	30								1	X															
		H	R1-1	30	30			6.25														RETAIN POST			X				
WB	5.943	F	M3-4	24	12								1	X															
		F	M1-5	24	24								1																
		F	M3-4	24	12			2.00																	E-136B				
		F	M1-5	24	24			4.00														RETAIN POST			E-136B				
WB	5.915	F	R4-3	24	30								1	X															
		F	R4-3	24	30			5.00														RETAIN POST			X				
WB	5.835	F	W9-1R	36	36			9.00							2		X							INSTALL 200 FEET EAST OF SCHOOL FLASHING BEACON ASSEMBLY.	X				
WB	5.797	F	S1-1	36	36		SCHOOL PENTAGON			1				X										RETAIN SIGN, POSTS AND FLASHING BEACONS.					
SIGN SUMMARY SHEET							SHEET TOTALS		36.25	0.00	2	0	0	6	0	0	2	30		0	0.0	0.0	0.0	PROJECT NAME: WOODFORD-MARLBORO					
									SF	SF	EA	EA	EA	EA	EA	EA	EA		FT		EA	LB	LB	LB	LB	PROJECT NUMBER: STPG SIGN(35)			
																									FILE NAME: 10B336		PLOT DATE: 4/10/2012		
VERMONT AGENCY OF TRANSPORTATION																									DRAWN BY: J. KELLY				
																											CHECKED BY: A. GAMBLE		
TOWN DIRECTIONAL TOTALS							607.1	0.0	23.0	1.0	1.0	117	0.0	0.0	70	1050.0		0	0.0				DESIGNED BY: J. KELLY			SHEET 69 OF 80			
																									MARLBORO WB SHEET 6				

DIRECTION	MILEPOINT	LOCATION CODE (SHEET 2)	SIGN CODE	WIDTH (IN)	HEIGHT (IN)	SHEETING REMARKS	SIGN LEGEND	NEW SIGNS		EXISTING SIGNS				EXIST POST		NUMBER OF NEW POSTS	SQUARE STEEL (IN)			TUBULAR STEEL Ø (IN)				SIGN FRAME REQUIRED	REMARKS	SIGN DETAIL LOCATION			
								"A"	"B"	RETAIN	SALVAGE FROM	SALVAGE TO	REMOVE	RETAIN	REMOVE		1.75	2.00	2.50	FOUNDATION	3.0	3.50	4.00			5.00	SHSM	PROJECT SHEET #	STANDARD SHEET #
																	(LB / FT)				(LB / FT)								
																	1.88	2.42	3.35		7.6	9.00	10.80			14.60			
MARLBORO WB							FY-FLUORESCENT YELLOW FYG-FLUORESCENT YELLOW GREEN															"SHSM"-STANDARD HIGHWAY SIGNS AND MARKINGS							
		F	W16-9	30	18		AHEAD						1																
		F	S4-3P	36	12	FYG		3.00																INSTALL BELOW SCHOOL SYMBOL SIGN.	X				
WB	5.760	F	W4-2R	36	36								1	X															
		F	W4-2R	36	36			9.00																	X				
WB	5.708	F	D1-1E	72	20								1	X															
		F	VD1-1	72	20			10.00																		7			
WB	5.617	F	VR-186	24	30		TRUCK LANE ENDS							1		X													
WB	5.599	F	VD-062B	72	16		BUSINESS SIGN			1				X															
WB	5.496	F	W1-10R	30	30		 						1		X										SIGN ASSEMBLY IS MISSING.				
		F	W13-1	24	24									1															
		F	W1-10R	36	36	FY		9.00									2		X						X				
		F	W16-8P	24	8	FY		1.33																			8		
WB	5.438	F	D1-1A	72	10								1	X	*									CONTRACTOR THINKS IT'S A GOOD IDEA TO RETAIN POSTS- NEW ELECTRICAL.					
		F	VD1-1A	72	12			6.00									2		*							6			
WB	5.364	F	M3-4	24	12								1	X															
SIGN SUMMARY SHEET							SHEET TOTALS	38.33	0.00	1	0	0	8	0	0	4	60			0	0.0	0.0	0.0	0.0	PROJECT NAME: WOODFORD-MARLBORO				
								SF	SF	EA	EA	EA	EA	EA	EA	EA		FT		EA	LB	LB	LB	LB	PROJECT NUMBER: STPG SIGN(35)				
																											FILE NAME: 10B336		
							VERMONT AGENCY OF TRANSPORTATION																					PROJECT MANAGER: A. GAMBLE	
TOWN DIRECTIONAL TOTALS																								DESIGNED BY: J. KELLY					
																											MARLBORO WB SHEET 7		
																								PLOT DATE: 4/10/2012					
																								DRAWN BY: J. KELLY					
																								CHECKED BY: A. GAMBLE					
																								SHEET 70 OF 80					

DIRECTION	MILEPOINT	LOCATION CODE (SHEET 2)	SIGN CODE	WIDTH (IN)	HEIGHT (IN)	SHEETING REMARKS	SIGN LEGEND	NEW SIGNS		EXISTING SIGNS				EXIST POST		NUMBER OF NEW POSTS	SQUARE STEEL (IN)			TUBULAR STEEL Ø (IN)				SIGN FRAME REQUIRED	REMARKS	SIGN DETAIL LOCATION			
								"A"	"B"	RETAIN	SALVAGE FROM	SALVAGE TO	REMOVE	RETAIN	REMOVE		1.75	2.00	2.50	FOUNDATION	3.0	3.50	4.00			5.00	SHSM	PROJECT SHEET #	STANDARD SHEET #
																	(LB / FT)				(LB / FT)								
																	1.88	2.42	3.35		7.6	9.00	10.80			14.60			
MARLBORO WB							FY-FLUORESCENT YELLOW FYG-FLUORESCENT YELLOW GREEN															"SHSM"-STANDARD HIGHWAY SIGNS AND MARKINGS							
		F	M1-5	24	24							1																	E-136B
		F	M3-4	24	12			2.00																					
		F	M1-5	24	24			4.00																					E-136B
WB	5.328	F	R2-1	24	30		SPEED LIMIT 50						1		X														
WB	5.252	F	R2-1	24	30			5.00								1		X							INSTALL ^{600'} 400' FEET WEST OF EXISTING SPEED LIMIT 50 SIGN ASSEMBLY.	X	CHANGE LOCATION		
WB	4.803	G	VR-017	24	30								1	POST X	BENT X										CHURCH HOLLOW RD (TH-20)				
		G	VR-017	24	30			5.00																			7		
WB	4.794	H	R1-1	30	30								1	X											CHURCH HOLLOW RD (TH-20)				
		H	R1-1	30	30			6.25																		X			
WB	4.775	F	M3-4	24	12								1	X															
		F	M1-5	24	24									1															
		F	M3-4	24	12			2.00																					E-136B
		F	M1-5	24	24			4.00																					E-136B
		F	VM-120	18	24			BYWAY SIGN MISSING																			BYWAY SIGN MISSING		
WB	4.620	F	D17-2	42	42			12.25								2		X							INSTALL 820 FEET WEST OF WB ROUTE MARKER ASSEMBLY.		6		
SIGN SUMMARY SHEET							SHEET TOTALS	40.50	0.00	1	0	0	6	0	0	3	45			0	0.0	0.0	0.0	0.0	PROJECT NAME: WOODFORD-MARLBORO				
								SF	SF	EA	EA	EA	EA	EA	EA	EA		FT		EA	LB	LB	LB	LB	PROJECT NUMBER: STPG SIGN(35)				
																										FILE NAME: 10B336			
							VERMONT AGENCY OF TRANSPORTATION																				DRAWN BY: J. KELLY		
TOWN DIRECTIONAL TOTALS																							DESIGNED BY: J. KELLY						
							607.1	0.0	23.0	1.0	1.0	117	0.0	0.0	70	1050.0			0	0.0				CHECKED BY: A. GAMBLE					
																							MARLBORO WB SHEET 8						
																							SHEET 71 OF 80						

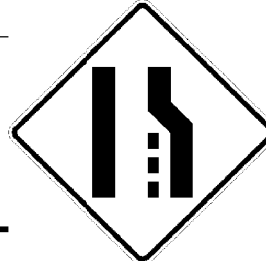
DIRECTION	MILEPOINT	LOCATION CODE (SHEET 2)	SIGN CODE	WIDTH (IN)	HEIGHT (IN)	SHEETING REMARKS	SIGN LEGEND	NEW SIGNS		EXISTING SIGNS				EXIST POST		NUMBER OF NEW POSTS	SQUARE STEEL (IN)			TUBULAR STEEL Ø (IN)				SIGN FRAME REQUIRED	REMARKS	SIGN DETAIL LOCATION			
								"A"	"B"	RETAIN	SALVAGE FROM	SALVAGE TO	REMOVE	RETAIN	REMOVE		1.75	2.00	2.50	FOUNDATION	3.0	3.50	4.00			5.00	SHSM	PROJECT SHEET #	STANDARD SHEET #
																	(LB / FT)				(LB / FT)								
																	1.88	2.42	3.35		7.6	9.00	10.80			14.60			
MARLBORO WB							FY-FLUORESCENT YELLOW FYG-FLUORESCENT YELLOW GREEN															"SHSM"-STANDARD HIGHWAY SIGNS AND MARKINGS							
WB	4.335	F	R4-3	24	30								1	X						RETAIN POST									
		F	R4-3	24	30			5.00																X					
WB	4.288	F	VW-133R	30	30		HIDDEN DRIVES RIGHT						1		X														
WB	4.212	F	W9-1R	36	36			9.00								2		X						INSTALL 200 FEET EAST OF LANE MERGE SYMBOL SIGN.	X				
WB	4.174	F	W4-2R	36	36								1	X						RETAIN POST									
		F	W4-2R	36	36			9.00																X					
WB	4.130	F	VR-020	24	30		NO PARKING ON TRAVEL LANE SIGN MISSING - REMOVE POST						1		X											SIGN MISSING - REMOVE POST			
WB	4.073	F	VR-020	24	30		NO PARKING ON TRAVEL LANE						1		X														
WB	4.052	F	VR-186	24	30		TRUCK LANE ENDS						1		X														
WB	3.858	F	VD-062B	72	16		BUSINESS SIGN			1				X															
		F	VD-062AS	72	16		BUSINESS SIGN			1																			
WB	3.795	F	D1-1A	72	10								1	X						RETAIN POST									
		F	D1-1A	72	10								1																
		F	VD1-1A	72	12			6.00																		6			
		F	VD1-1A	72	12			6.00																		6			
SIGN SUMMARY SHEET							SHEET TOTALS	35.00	0.00	2	0	0	8	0	0	2	30			0	0.0	0.0	0.0	0.0	PROJECT NAME: WOODFORD-MARLBORO				
								SF	SF	EA	EA	EA	EA	EA	EA	EA		FT		EA	LB	LB	LB	LB	PROJECT NUMBER: STPG SIGN(35)				
							TOWN DIRECTIONAL TOTALS			607.1	0.0	23.0	1.0	1.0	117	0.0	0.0	70	1050.0			0	0.0				FILE NAME: 10B336		
VERMONT AGENCY OF TRANSPORTATION																								PROJECT MANAGER: A. GAMBLE			PLOT DATE: 4/10/2012		
																											DESIGNED BY: J. KELLY		
																							MARLBORO WB SHEET 9			CHECKED BY: A. GAMBLE			
																								SHEET 72 OF 80					

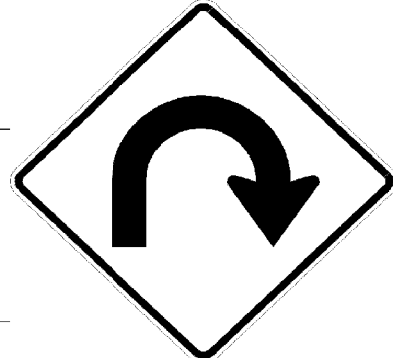
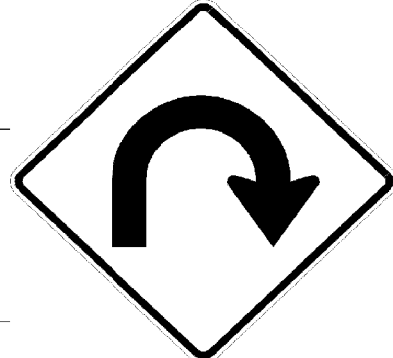
DIRECTION	MILEPOINT	LOCATION CODE (SHEET 2)	SIGN CODE	WIDTH (IN)	HEIGHT (IN)	SHEETING REMARKS	SIGN LEGEND	NEW SIGNS		EXISTING SIGNS				EXIST POST		NUMBER OF NEW POSTS	SQUARE STEEL (IN)			TUBULAR STEEL Ø (IN)				SIGN FRAME REQUIRED	REMARKS	SIGN DETAIL LOCATION			
								"A"	"B"	RETAIN	SALVAGE FROM	SALVAGE TO	REMOVE	RETAIN	REMOVE		1.75	2.00	2.50	FOUNDATION	3.0	3.50	4.00			5.00	SHSM	PROJECT SHEET #	STANDARD SHEET #
																	(LB / FT)				(LB / FT)								
																	1.88	2.42	3.35		7.6	9.00	10.80			14.60			
MARLBORO WB							FY-FLUORESCENT YELLOW FYG-FLUORESCENT YELLOW GREEN															"SHSM"-STANDARD HIGHWAY SIGNS AND MARKINGS							
WB	3.757	A	D17-2	42	42			12.25							2		X							INSTALL 200 FEET WEST OF DESTINATION SIGN ASSEMBLY.		6			
WB	3.720	G	VR-017	24	30								1	X						RETAIN POST				AUGER HOLE RD (TH-1)					
		G	VR-017	24	30			5.00																		7			
WB	3.711	H	R1-1	30	30								1	X						RETAIN POST				AUGER HOLE RD (TH-1)					
		H	R1-1	30	30			6.25																	X				
WB	3.698	F	M3-4	24	12								1	X						RETAIN POST									
		F	M1-5	24	24								1																
		F	M3-4	24	12			2.00																			E-136B		
		F	M1-5	24	24			4.00																			E-136B		
WB	3.634	F	R4-6	24	30		TRUCK LANE 500 FEET						1		X														
WB	3.590	F	R2-1	24	30								1	X						RETAIN POST									
		F	R2-1	24	30			5.00																	X				
WB	3.533	F	R4-3	24	30								1	X						RETAIN POST									
		F	R4-3	24	30			5.00																	X				
WB	3.426	F	D1-1M	72	20								1		X														
SIGN SUMMARY SHEET								TOTALS	39.50	0.00	0	0	0	8	0	0	2	30			0	0.0	0.0	0.0	0.0	PROJECT NAME: WOODFORD-MARLBORO			
								SF	SF	EA	EA	EA	EA	EA	EA	EA		FT		EA	LB	LB	LB	LB	PROJECT NUMBER: STPG SIGN(35)				
							VERMONT AGENCY OF TRANSPORTATION																			FILE NAME: 10B336			
							TOWN DIRECTIONAL TOTALS							607.1	0.0	23.0	1.0	1.0	117	0.0	0.0	70	1050.0			0	0.0		
																								PROJECT MANAGER: A. GAMBLE					
																								DESIGNED BY: J. KELLY					
																								MARLBORO WB SHEET 10					
																								CHECKED BY: A. GAMBLE					
																								SHEET 73 OF 80					

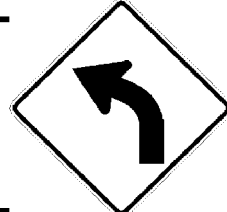
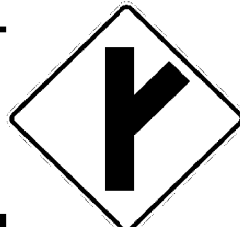
DIRECTION	MILEPOINT	LOCATION CODE (SHEET 2)	SIGN CODE	WIDTH (IN)	HEIGHT (IN)	SHEETING REMARKS	SIGN LEGEND	NEW SIGNS		EXISTING SIGNS				EXIST POST		NUMBER OF NEW POSTS	SQUARE STEEL (IN)			TUBULAR STEEL Ø (IN)				SIGN FRAME REQUIRED	REMARKS	SIGN DETAIL LOCATION			
								"A"	"B"	RETAIN	SALVAGE FROM	SALVAGE TO	REMOVE	RETAIN	REMOVE		1.75	2.00	2.50	FOUNDATION	3.0	3.50	4.00			5.00	SHSM	PROJECT SHEET #	STANDARD SHEET #
																	(LB / FT)				(LB / FT)								
																	1.88	2.42	3.35		7.6	9.00	10.80			14.60			
MARLBORO WB							FY-FLUORESCENT YELLOW FYG-FLUORESCENT YELLOW GREEN															"SHSM"-STANDARD HIGHWAY SIGNS AND MARKINGS							
		F	VD1-1	72	20		Marlboro District 1 Highway Garage →	10.00							2		X									6			
WB	3.337	F	R4-3	24	30		SLOWER TRAFFIC KEEP RIGHT						1			X													
WB	3.324	F	W9-1R	36	36		RIGHT LANE ENDS	9.00							2		X							INSTALL 300 FEET WEST ^{EAST} OF EXISTING MERGE SYMBOL SIGN.	X	INSTALL EAST			
WB	3.267	F	W4-2R	36	36								1	X						RETAIN POST									
		F	W4-2R	36	36			9.00																X					
WB	3.141	F	VR-186	24	30		TRUCK LANE ENDS						1		X														
WB	2.905	F	VW-054R	30	30		HIDDEN DRIVES RIGHT						1		X														
WB	2.840	F	W2-1R	30	30		RIGHT CURVE						1	X															
		F	VW-054R	30	30		HIDDEN DRIVES RIGHT	6.25							1		X								TRIM BRUSH	8			
WB	2.774	F	VR-023B	24	30		\$500 FINE FOR THROWING TRASH						1		X														
WB	2.714	F	W1-2R	30	30								1		X														
		F	W13-1P	18	18								1																
		F	W1-2R	30	30			6.25							1		X							X	PUT OLD SIGNS ON NEW POST. CHANGED ON 9-7-12				
		F	W13-1P	18	18		40 MPH	2.25																X					
WB	2.618	F	M3-4	24	12		WEST						1		X														
SIGN SUMMARY SHEET							SHEET TOTALS	42.75	0.00	0	0	0	9	0	0	6	90			0	0.0	0.0	0.0	0.0	PROJECT NAME: WOODFORD-MARLBORO				
								SF	SF	EA	EA	EA	EA	EA	EA	EA		FT		EA	LB	LB	LB	LB	PROJECT NUMBER: STPG SIGN(35)				
							VERMONT AGENCY OF TRANSPORTATION			TOWN DIRECTIONAL TOTALS	607.1	0.0	23.0	1.0	1.0	117	0.0	0.0	70	1050.0			0	0.0				FILE NAME: 10B336	
																						PROJECT MANAGER: A. GAMBLE			PLOT DATE: 4/10/2012				
																							DESIGNED BY: J. KELLY			DRAWN BY: J. KELLY			
																							MARLBORO WB SHEET 11			CHECKED BY: A. GAMBLE			
																							SHEET 74 OF 80						

DIRECTION	MILEPOINT	LOCATION CODE (SHEET 2)	SIGN CODE	WIDTH (IN)	HEIGHT (IN)	SHEETING REMARKS	SIGN LEGEND	NEW SIGNS		EXISTING SIGNS				EXIST POST		NUMBER OF NEW POSTS	SQUARE STEEL (IN)			TUBULAR STEEL Ø (IN)				SIGN FRAME REQUIRED	REMARKS	SIGN DETAIL LOCATION			
								"A"	"B"	RETAIN	SALVAGE FROM	SALVAGE TO	REMOVE	RETAIN	REMOVE		1.75	2.00	2.50	FOUNDATION	3.0	3.50	4.00			5.00	SHSM	PROJECT SHEET #	STANDARD SHEET #
																	(LB / FT)				(LB / FT)								
																	1.88	2.42	3.35		7.6	9.00	10.80			14.60			
MARLBORO WB							FY-FLUORESCENT YELLOW FYG-FLUORESCENT YELLOW GREEN															"SHSM"-STANDARD HIGHWAY SIGNS AND MARKINGS							
		F	M1-5	24	24		VERMONT ROUTE 9						1																
WB	2.547	F	R2-1	24	30		SPEED LIMIT 50						1		X														
		F	VW-133R	30	30			6.25								1		X								TRIM BRUSH 8			
WB	2.091	A	D17-2	42	42			12.25								2		X							INSTALL 525 FEET EAST OF EXISTING LEFT CURVE SIGN ASSEMBLY.		6		
WB	1.992	F	W1-2L	30	30			6.25					1	X															
		F	W1-2L	30	30																						X		
WB	1.964	F	R4-6	24	30		TRUCK LANE 500 FEET						1		X														
WB	1.905	E	W1-8R	24	30	FY		5.00								1		X							INSTALL 20 FEET EAST OF CLOSEST EDGE OF HUGHS RD.	X			
WB	1.900	G	VR-017	24	30			5.00					1	X															
		G	VR-017	24	30																						7		
WB	1.893	H	R1-1	30	30								1	X															
		H	R1-1	30	30			6.25																		X			
WB	1.887	F	W1-8L	24	30		CHEVRON			1				X															
WB	1.887	E	W1-8R	24	30		CHEVRON			1				X															
WB	1.860	F	W1-8L	24	30		CHEVRON			1				X															
SIGN SUMMARY SHEET							SHEET TOTALS	41.00	0.00	3	0	0	6	0	0	4	60			0	0.0	0.0	0.0	0.0	PROJECT NAME: WOODFORD-MARLBORO				
								SF	SF	EA	EA	EA	EA	EA	EA	EA		FT		EA	LB	LB	LB	LB	PROJECT NUMBER: STPG SIGN(35)				
																				EA					FILE NAME: 10B336				
VERMONT AGENCY OF TRANSPORTATION																								PROJECT MANAGER: A. GAMBLE					
							TOWN DIRECTIONAL TOTALS	607.1	0.0	23.0	1.0	1.0	117	0.0	0.0	70	1050.0			0	0.0				PLOT DATE: 4/10/2012				
																								DRAWN BY: J. KELLY					
																								CHECKED BY: A. GAMBLE					
																								MARLBORO WB SHEET 12					
																								SHEET 75 OF 80					

DIRECTION	MILEPOINT	LOCATION CODE (SHEET 2)	SIGN CODE	WIDTH (IN)	HEIGHT (IN)	SHEETING REMARKS	SIGN LEGEND	NEW SIGNS		EXISTING SIGNS				EXIST POST		NUMBER OF NEW POSTS	SQUARE STEEL (IN)			TUBULAR STEEL Ø (IN)					SIGN FRAME REQUIRED	REMARKS	SIGN DETAIL LOCATION		
								"A"	"B"	RETAIN	SALVAGE FROM	SALVAGE TO	REMOVE	RETAIN	REMOVE		1.75	2.00	2.50	FOUNDATION	3.0	3.50	4.00	5.00			SHSM	PROJECT SHEET #	STANDARD SHEET #
																	(LB / FT)				(LB / FT)								
																	1.88	2.42	3.35		7.6	9.00	10.80	14.60					
MARLBORO WB							FY-FLUORESCENT YELLOW FYG-FLUORESCENT YELLOW GREEN															"SHSM"-STANDARD HIGHWAY SIGNS AND MARKINGS							
WB	1.860	E	W1-8R	24	30		CHEVRON			1				X															
WB	1.846	F	R4-3	36	48							1		X															
		F	R4-3	24	30		SLOWER TRAFFIC KEEP RIGHT	5.00							1		X								X				
WB	1.844	E	W1-8R	24	30		CHEVRON			1		I		X											MISSING-	USE A SALVAGED ONE			
WB	1.823	F	W1-8L	24	30		CHEVRON			1				X															
WB	1.823	E	W1-8R	24	30		CHEVRON			1				X															
WB	1.799	F	W1-8L	24	30		CHEVRON			1				X															
WB	1.799	E	W1-8R	24	30		CHEVRON			1				X															
WB	1.776	F	W1-8L	24	30								1	X											RETAIN POST				
		F	W1-8L	24	30	FY	←	5.00																	X				
WB	1.776	E	W1-8R	24	30		CHEVRON			1				X															
WB	1.752	F	W1-8L	24	30								1	X											RETAIN POST				
		F	W1-8L	24	30	FY	←	5.00																	X				
WB	1.752	E	W1-8R	24	30					I			+	X											RETAIN ALL				
		E	W1-8R	24	30	FY	→	-5.00																	RETAIN X				
SIGN SUMMARY SHEET							SHEET TOTALS		15.00 20.00	0.00	8 7	0	1 0	3 4	0	0	1	15			0	0.0	0.0	0.0	0.0	PROJECT NAME: WOODFORD-MARLBORO			
									SF	SF	EA	EA	EA	EA	EA	EA	EA		FT		EA	LB	LB	LB	LB	PROJECT NUMBER: STPG SIGN(35)			
																										FILE NAME: 10B336			
																										PROJECT MANAGER: A. GAMBLE			
VERMONT AGENCY OF TRANSPORTATION							TOWN DIRECTIONAL TOTALS		607.1	0.0	23.0	1.0	1.0	117	0.0	0.0	70	1050.0			0	0.0				DESIGNED BY: J. KELLY			
																								MARLBORO WB SHEET 13					
																								PLOT DATE: 4/10/2012					
																								DRAWN BY: J. KELLY					
																								CHECKED BY: A. GAMBLE					
																								SHEET 76 OF 80					

DIRECTION	MILEPOINT	LOCATION CODE (SHEET 2)	SIGN CODE	WIDTH (IN)	HEIGHT (IN)	SHEETING REMARKS	SIGN LEGEND	NEW SIGNS		EXISTING SIGNS				EXIST POST		NUMBER OF NEW POSTS	SQUARE STEEL (IN)			TUBULAR STEEL Ø (IN)				SIGN FRAME REQUIRED	REMARKS	SIGN DETAIL LOCATION					
								"A"	"B"	RETAIN	SALVAGE FROM	SALVAGE TO	REMOVE	RETAIN	REMOVE		1.75	2.00	2.50	FOUNDATION	3.0	3.50	4.00			5.00	SHSM	PROJECT SHEET #	STANDARD SHEET #		
																	(LB / FT)				(LB / FT)										
																	1.88	2.42	3.35		7.6	9.00	10.80			14.60					
MARLBORO WB							FY-FLUORESCENT YELLOW FYG-FLUORESCENT YELLOW GREEN															"SHSM"-STANDARD HIGHWAY SIGNS AND MARKINGS									
WB	1.688	F	R2-1	24	30								1	X					RETAIN POST												
		F	R2-1	24	30			5.00								1		X						X							
WB	1.508	F	R4-3	36	48								1		X																
		F	R4-3	24	30			5.00								1		X						X							
WB	1.305	F	W9-1R	36	36	FY		9.00								2		X						INSTALL 300 FEET EAST OF LANE MERGE SYMBOL SIGN.	X	MOVED CLOSER TO ROAD TO SEE BY POLE BETTER					
WB	1.248	F	W4-2R	36	36								1	X					RETAIN POST												
		F	W4-2R	36	36	FY		9.00																	X						
WB	1.203	F	W1-5L	30	30								1		X										CUT POST OFF ABOVE MILE MARKER						
WB	1.165	F	VD-062BRN	72	16					1				X																	
WB	1.128	F	VR-186	36	48								1		X																
WB	1.086	G	VR-017	24	24								1		X									OLD HOGBACK RD. (TH-33)							
WB	1.078	H	R1-1	24	24		STOP	MISSING					+		X									OLD HOGBACK RD. (TH-33)	STOP SIGN AND POST MISSING						
WB	1.057	F	M3-4	24	12		WEST						1		X																
		F	M1-5	24	24		VERMONT ROUTE 9						1																		
WB	1.002	F	R2-1	24	30		SPEED LIMIT 50						1		X																
SIGN SUMMARY SHEET							SHEET TOTALS		28.00	0.00	1	0	0	9 10	0	0	4	60			0	0.0	0.0	0.0	0.0	PROJECT NAME: WOODFORD-MARLBORO					
									SF	SF														EA	LB	LB	LB	LB	PROJECT NUMBER: STPG SIGN(35)		
																													FILE NAME: 10B336		
							VERMONT AGENCY OF TRANSPORTATION																						PROJECT MANAGER: A. GAMBLE		
							TOWN DIRECTIONAL TOTALS		607.1	0.0	23.0	1.0	1.0	117	0.0	0.0	70	1050.0			0	0.0				DESIGNED BY: J. KELLY					
																								MARLBORO WB SHEET 14							
																								PLOT DATE: 4/10/2012							
																								DRAWN BY: J. KELLY							
																								CHECKED BY: A. GAMBLE							
																								SHEET 77 OF 80							

DIRECTION	MILEPOINT	LOCATION CODE (SHEET 2)	SIGN CODE	WIDTH (IN)	HEIGHT (IN)	SHEETING REMARKS	SIGN LEGEND	NEW SIGNS		EXISTING SIGNS				EXIST POST		NUMBER OF NEW POSTS	SQUARE STEEL (IN)			TUBULAR STEEL Ø (IN)				SIGN FRAME REQUIRED	REMARKS	SIGN DETAIL LOCATION				
								"A"	"B"	RETAIN	SALVAGE FROM	SALVAGE TO	REMOVE	RETAIN	REMOVE		1.75	2.00	2.50	FOUNDATION	3.0	3.50	4.00			5.00	SHSM	PROJECT SHEET #	STANDARD SHEET #	
																	(LB / FT)				(LB / FT)									
																	1.88	2.42	3.35		7.6	9.00	10.80			14.60				
MARLBORO WB							FY-FLUORESCENT YELLOW FYG-FLUORESCENT YELLOW GREEN															"SHSM"-STANDARD HIGHWAY SIGNS AND MARKINGS								
WB	0.917	F	W1-2L	30	30		LEFT CURVE						1		X															
WB	0.875	F	W11-2	48	48		PEDESTRIAN						1		X															
		F	VW-205	36	36			9.00								2		X								8				
WB	0.842	F	VW-205	36	36		WATCH FOR TURNING VEHICLES MISSING						+		X												MISSING			
WB	0.809	F	D6-3M	30	30		SCENIC OVERLOOK AHEAD  						1		X										REINSTALL 0.81 MILE MARKER ONTO NEW ASSEMBLY					
		A	D5-2L	42	48			14.00								2		X								9				
WB	0.778	F	W11A-2	48	48		PEDESTRIAN CROSSWALK						1																	
		F	W16-4	24	18								1																	
		F	W11-2	48	48	FYG		16.00																	RETAIN POSTS AND FLASHING BEACON.	X				
		F	W16-4	30	24	FYG		5.00																	X					
WB	0.716	F	VW-537R	48	48								1		X															
		F	W13-1	24	24								1														MOVED 145' EAST			
		F	W1-11R	36	36	FY		9.00								2		SLIP BASES	X						SEE SHEET 2.	X		SLIP BASES		
		F	W13-1	24	24	FY		4.00																	INSTALL ON LEFT POST	X		TRIM BRUSH		
WB	0.601	F	VR-020	24	30		NO PARKING ON TRAVELED LANES						1		X															
SIGN SUMMARY SHEET							SHEET TOTALS	57.00	0.00	0	0	0	9	0	0	6	90			0	0.0	0.0	0.0	0.0	PROJECT NAME: WOODFORD-MARLBORO			PROJECT NUMBER: STPG SIGN(35)		
								SF	SF	EA	EA	EA	EA	EA	EA	EA		FT		EA	LB	LB	LB	LB	FILE NAME: 10B336			PLOT DATE: 4/10/2012		
							VERMONT AGENCY OF TRANSPORTATION																			PROJECT MANAGER: A. GAMBLE			DRAWN BY: J. KELLY	
							TOWN DIRECTIONAL TOTALS	607.1	0.0	23.0	1.0	1.0	117	0.0	0.0	70	1050.0			0	0.0				DESIGNED BY: J. KELLY			CHECKED BY: A. GAMBLE		
																								MARLBORO WB SHEET 15			SHEET 78 OF 80			

DIRECTION	MILEPOINT	LOCATION CODE (SHEET 2)	SIGN CODE	WIDTH (IN)	HEIGHT (IN)	SHEETING REMARKS	SIGN LEGEND	NEW SIGNS		EXISTING SIGNS				EXIST POST		NUMBER OF NEW POSTS	SQUARE STEEL (IN)			TUBULAR STEEL Ø (IN)				SIGN FRAME REQUIRED	REMARKS	SIGN DETAIL LOCATION				
								"A"	"B"	RETAIN	SALVAGE FROM	SALVAGE TO	REMOVE	RETAIN	REMOVE		1.75	2.00	2.50	FOUNDATION	3.0	3.50	4.00			5.00	SHSM	PROJECT SHEET #	STANDARD SHEET #	
																	(LB / FT)				(LB / FT)									
																	1.88	2.42	3.35		7.6	9.00	10.80			14.60				
MARLBORO WB							FY-FLUORESCENT YELLOW FYG-FLUORESCENT YELLOW GREEN															"SHSM"-STANDARD HIGHWAY SIGNS AND MARKINGS								
WB	0.589	F		30	30		CENTERLINE RUMBLE STRIPS			X				X																
		F		24	12		END			X																				
WB	0.477	F	VR-020	24	30		NO PARKING ON TRAVELED LANES						1		X															
WB	0.424	F	VR-020	24	30		NO PARKING ON TRAVELED LANES						1		X															
WB	0.356	F	VR-020	24	30		NO PARKING ON TRAVELED LANES						1		X															
WB	0.211	F	VD-062AS	72	16		BUSINESS SIGN			1				X																
		F	VD-062BRN	72	16		BUSINESS SIGN			1																				
WB	0.178	F	W1-2L	30	30			6.25								1		X						INSTALL 175 FEET WEST OF EXISTING BUSINESS SIGNS.	X					
WB	0.093	G	VR-017	24	30		LEGAL LOAD 24,000 LBS						1		X									OLD HOGBACK RD (TH-33)						
WB	0.093	H	R1-1	30	30		STOP 						1		X									OLD HOGBACK RD (TH-33)	REMOVE MILE MARKER AS PER JOE KELLY					
WB	0.070	F	W2-3R	30	30			6.25								1		X						INSTALL BETWEEN OLD HOGBACK RD AND GRAVEL DRIVE TO WEST.	X					
SIGN SUMMARY SHEET							SHEET TOTALS	12.50	0.00	2	0	0	0	0	0	2	30			0	0.0	0.0	0.0	0.0	PROJECT NAME: WOODFORD-MARLBORO					
								SF	SF	EA	EA	EA	EA	EA	EA	EA		FT		EA	LB	LB	LB	LB	PROJECT NUMBER: STPG SIGN(35)					
																									FILE NAME: 10B336			PLOT DATE: 4/10/2012		
							VERMONT AGENCY OF TRANSPORTATION																			PROJECT MANAGER: A. GAMBLE			DRAWN BY: J. KELLY	
TOWN DIRECTIONAL TOTALS																								DESIGNED BY: J. KELLY			CHECKED BY: A. GAMBLE			
							607.1	0.0	23.0	1.0	1.0	117	0.0	0.0	70	1050.0			0	0.0				MARLBORO WB SHEET 16			SHEET 79 OF 80			

TOWN TOTAL SIGN SUMMARY SHEET

[illegible][illegible]

PROJECT NAME: WOODFORD - MARLBORO	
PROJECT NUMBER: STPG SIGN (35)	
FILE NAME: IOB336_TS.DGN	PLOT DATE: 10-APR-2012
PROJECT LEADER: A. GAMBLE	DRAWN BY: J. KELLY
DESIGNED BY: J. KELLY	CHECKED BY: A. GAMBLE
TOWN TOTAL SIGN SUMMARY SHEET	SHEET 80 OF 80