

646.402 DURABLE 4 INCH WHITE LINE, THERMOPLASTIC OR

646.403 DURABLE 4 INCH WHITE LINE, EPOXY PAINT OR

646.404 DURABLE 4 INCH WHITE LINE, POLYUREA

(ALL LINES WILL INCLUDE EDGE LINE BREAKS AND

RADIUS FOR TOWN HIGHWAYS)

CASTLETON:

STA 194+75.00 - STA 200+00.00 EDGE LINE LT & RT

646.412 DURABLE 4 INCH YELLOW LINE, THERMOPLASTIC OR

646.413 DURABLE 4 INCH YELLOW LINE, EPOXY PAINT OR

646.414 DURABLE 4 INCH YELLOW LINE, POLYUREA

(ALL LINES WILL INCLUDE C/L BREAKS FOR

TOWN HIGHWAYS) S=SOLID, D=DASHED

CASTLETON:

STA 194+75.00 - STA 200+00.00

LT

CL

RT

S

-

S

646.602 TEMPORARY 4 INCH WHITE LINE, PAINT

(ALL LINES WILL INCLUDE EDGE LINE BREAKS AND

RADIUS FOR TOWN HIGHWAYS)

CASTLETON:

STA 194+75.00 - STA 200+00.00 EDGE LINE LT & RT

646.612 TEMPORARY 4 INCH YELLOW LINE, PAINT

(ALL LINES WILL INCLUDE C/L BREAKS FOR

TOWN HIGHWAYS) S=SOLID, D=DASHED

CASTLETON:

STA 194+75.00 - STA 200+00.00

LT


CL

RT

S

-

S

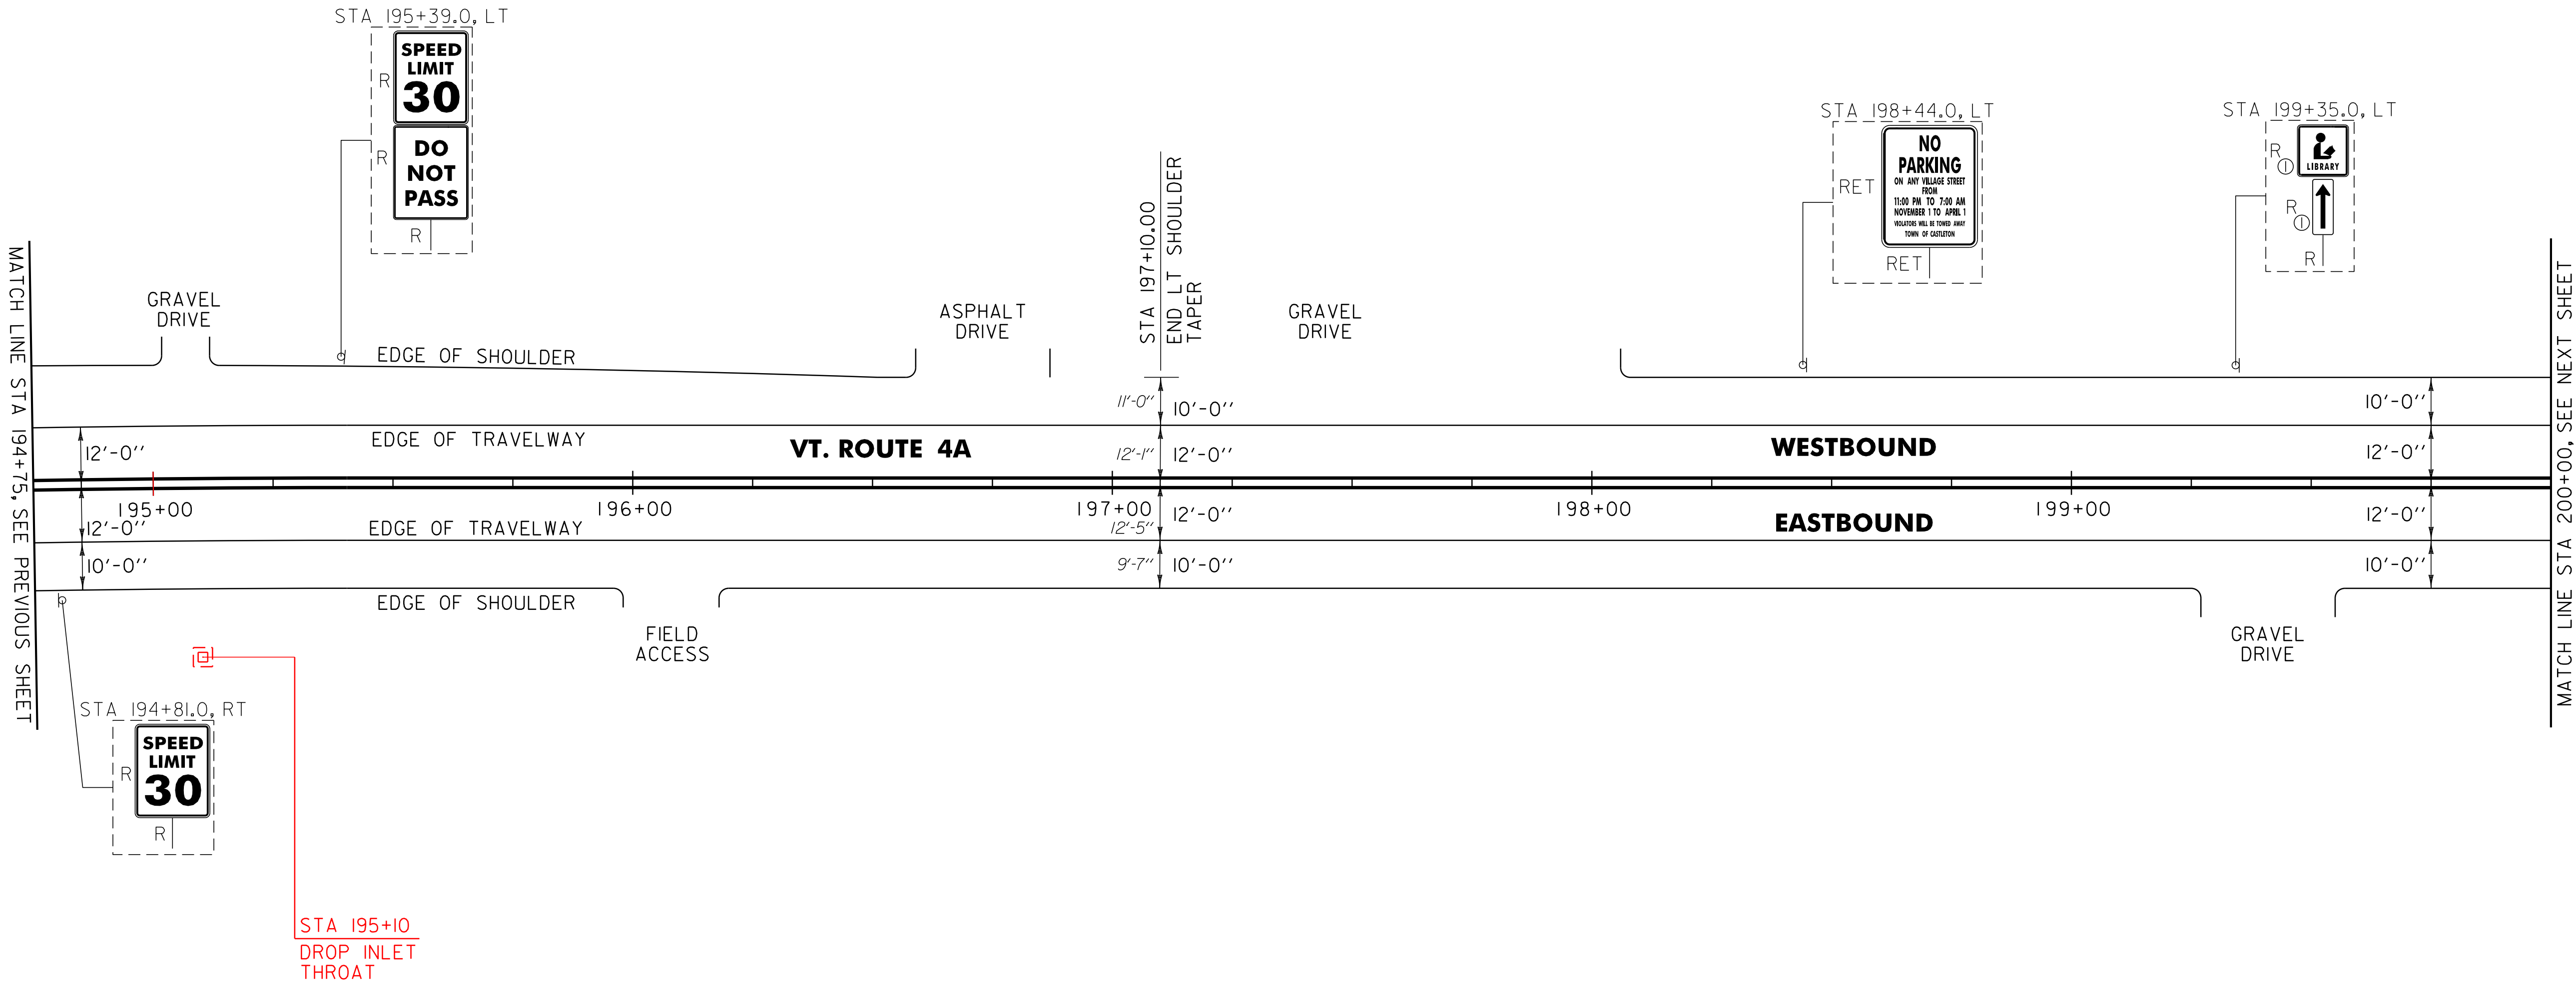

SIGN LEGEND

R = REMOVE

S = SALVAGE

N = NEW

RET = RETAIN

B-B = BACK TO BACK

EXISTING = -----

NEW = _____

R = RETURN TO TOWN

⊙ = OF CASTLETON

NOT TO SCALE

PROJECT LAYOUT SHEET #9

PROJECT NAME: CASTLETON

PROJECT NUMBER: STP 2908(1)

FILE NAME: p10c210.dgn

PROJECT LEADER: D.E.G.

DESIGNED BY: M.J.M.

IPARM FILE: p10c210109.i

PLOT DATE: 04-JUN-2013 09:2

DRAWN BY: W.G.P.

CHECKED BY: D.E.G.

SHEET 106 OF 152