


NEWBURY US ROUTE 5 - N 504+35 - N 505+18 LT (4 FEET SHOULDER)	RYEGATE US ROUTE 5 - R 0+00 - R 19+25 LT (3 FEET SHOULDER)
N 504+35 - N 505+33 RT (12 FEET SHOULDER)	R 0+00 - R 2+15 RT (3 FEET SHOULDER)
N 505+33 - N 513+24 RT (3 FEET SHOULDER)	R 2+15 - R 6+45 RT (2 FEET SHOULDER)
N 505+18 - N 517+69 LT (3 FEET SHOULDER)	R 6+45 - R 17+93 RT (3 FEET SHOULDER)
N 513+24 - N 515+91 RT (1 FEET SHOULDER)	R 17+93 - R 28+00 RT (4 FEET SHOULDER)
N 515+91 - N 517+69 RT (3 FEET SHOULDER)	R 19+25 - R 20+65 LT (2 FEET SHOULDER)
	R 20+65 - R 48+05 LT (3 FEET SHOULDER)
	R 28+00 - R 33+40 RT (3 FEET SHOULDER)
	R 33+40 - R 58+00 RT (4 FEET SHOULDER)
	R 48+05 - R 51+03 LT (4 FEET SHOULDER)
	R 51+03 - R 60+45 LT (3 FEET SHOULDER)
	R 58+00 - R 60+45 RT (2 FEET SHOULDER)

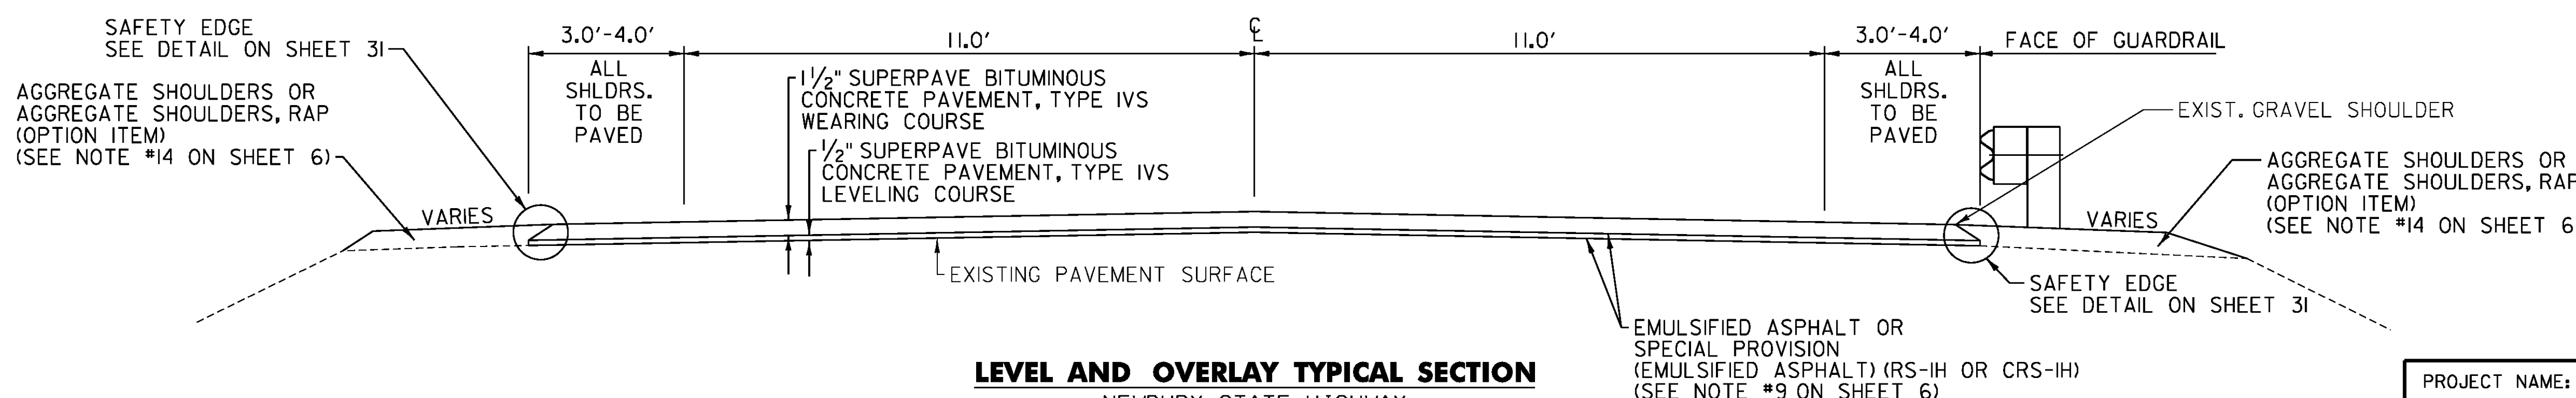

0+14 - 3+75 LT (3 FEET SHOULDER)	0+14 - 21+50 RT (4 FEET SHOULDER)
3+75 - 21+98 LT (4 FEET SHOULDER)	21+50 - 24+48.5 RT (3 FEET SHOULDER)
21+98 - 24+48.5 LT (3 FEET SHOULDER)	

NOT TO SCALE

PROJECT NAME: BRADFORD-RYEGATE	
PROJECT NUMBER: STP 2929(I)	
FILE NAME: z10c264frm.dgn	PLOT DATE: 2/4/2016
PROJECT LEADER: P. SHEDD	DRAWN BY: W. GORDON
DESIGNED BY: N. LEMAY	CHECKED BY: P. SHEDD
TYPICAL SECTIONS SHEET 5	SHEET II OF 239