

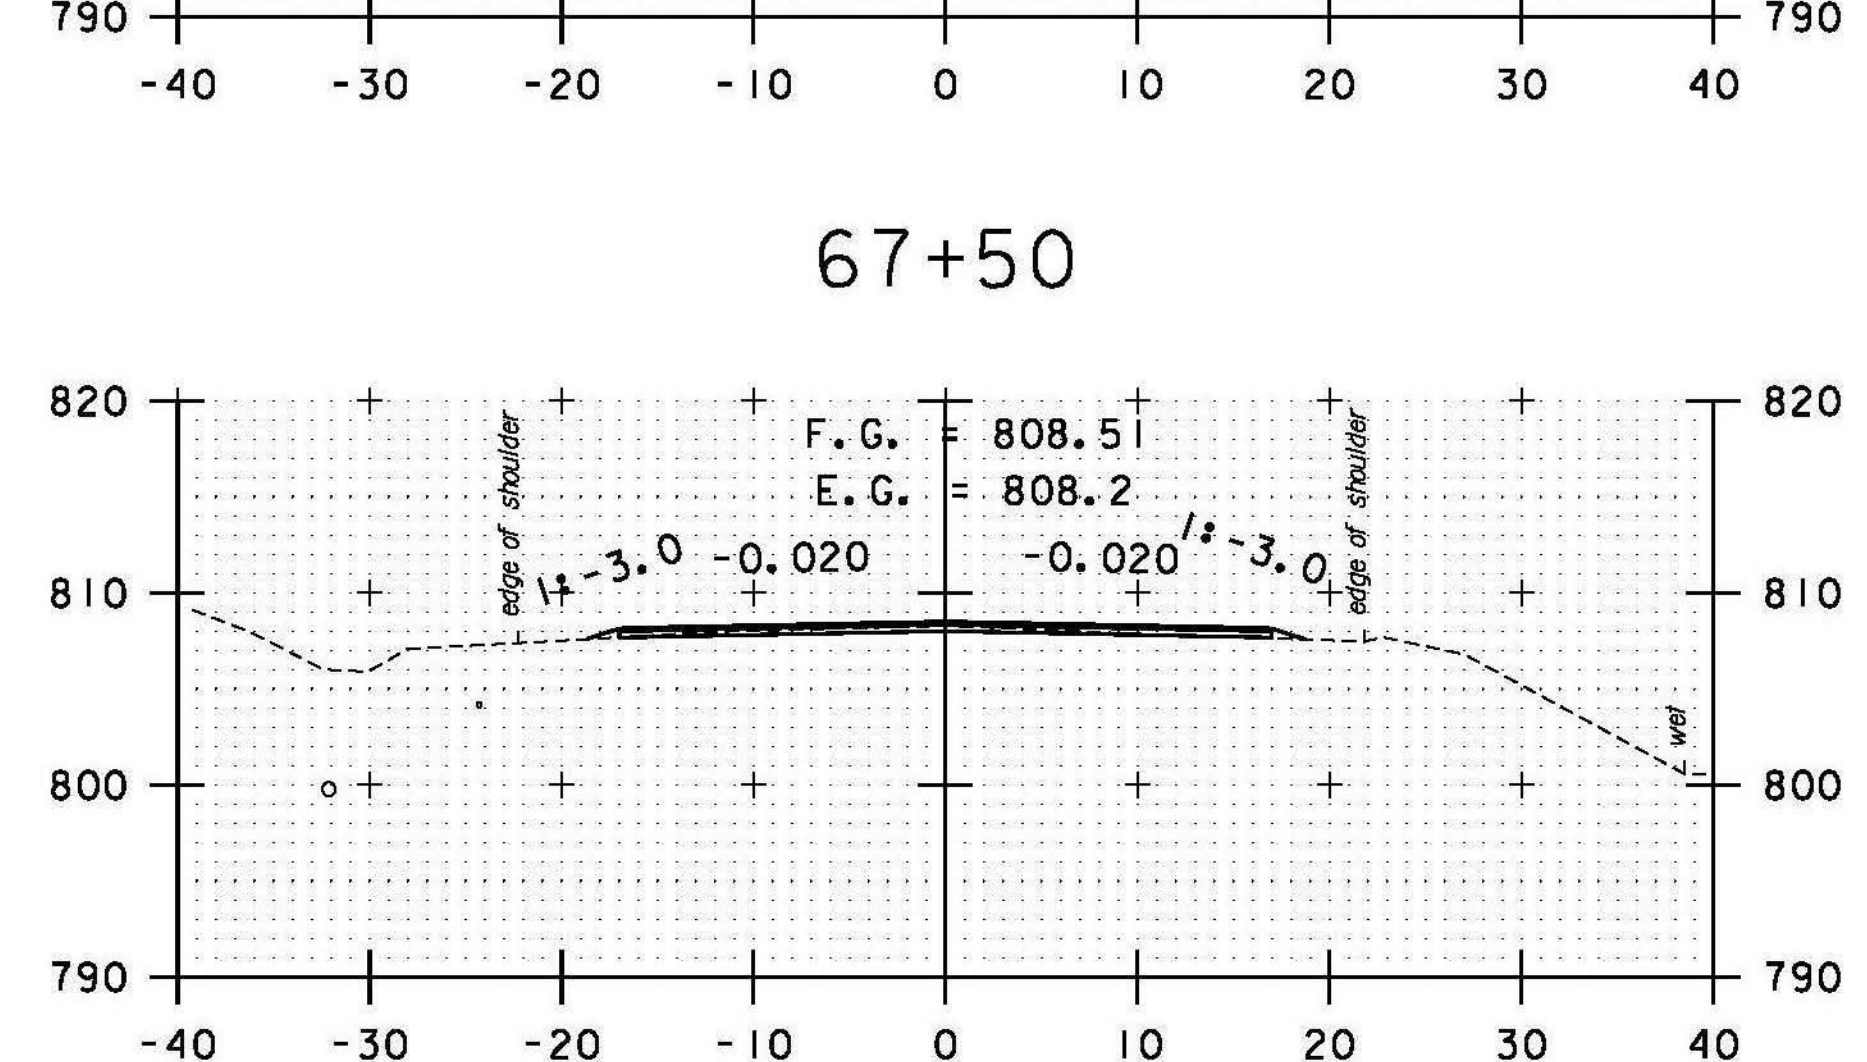
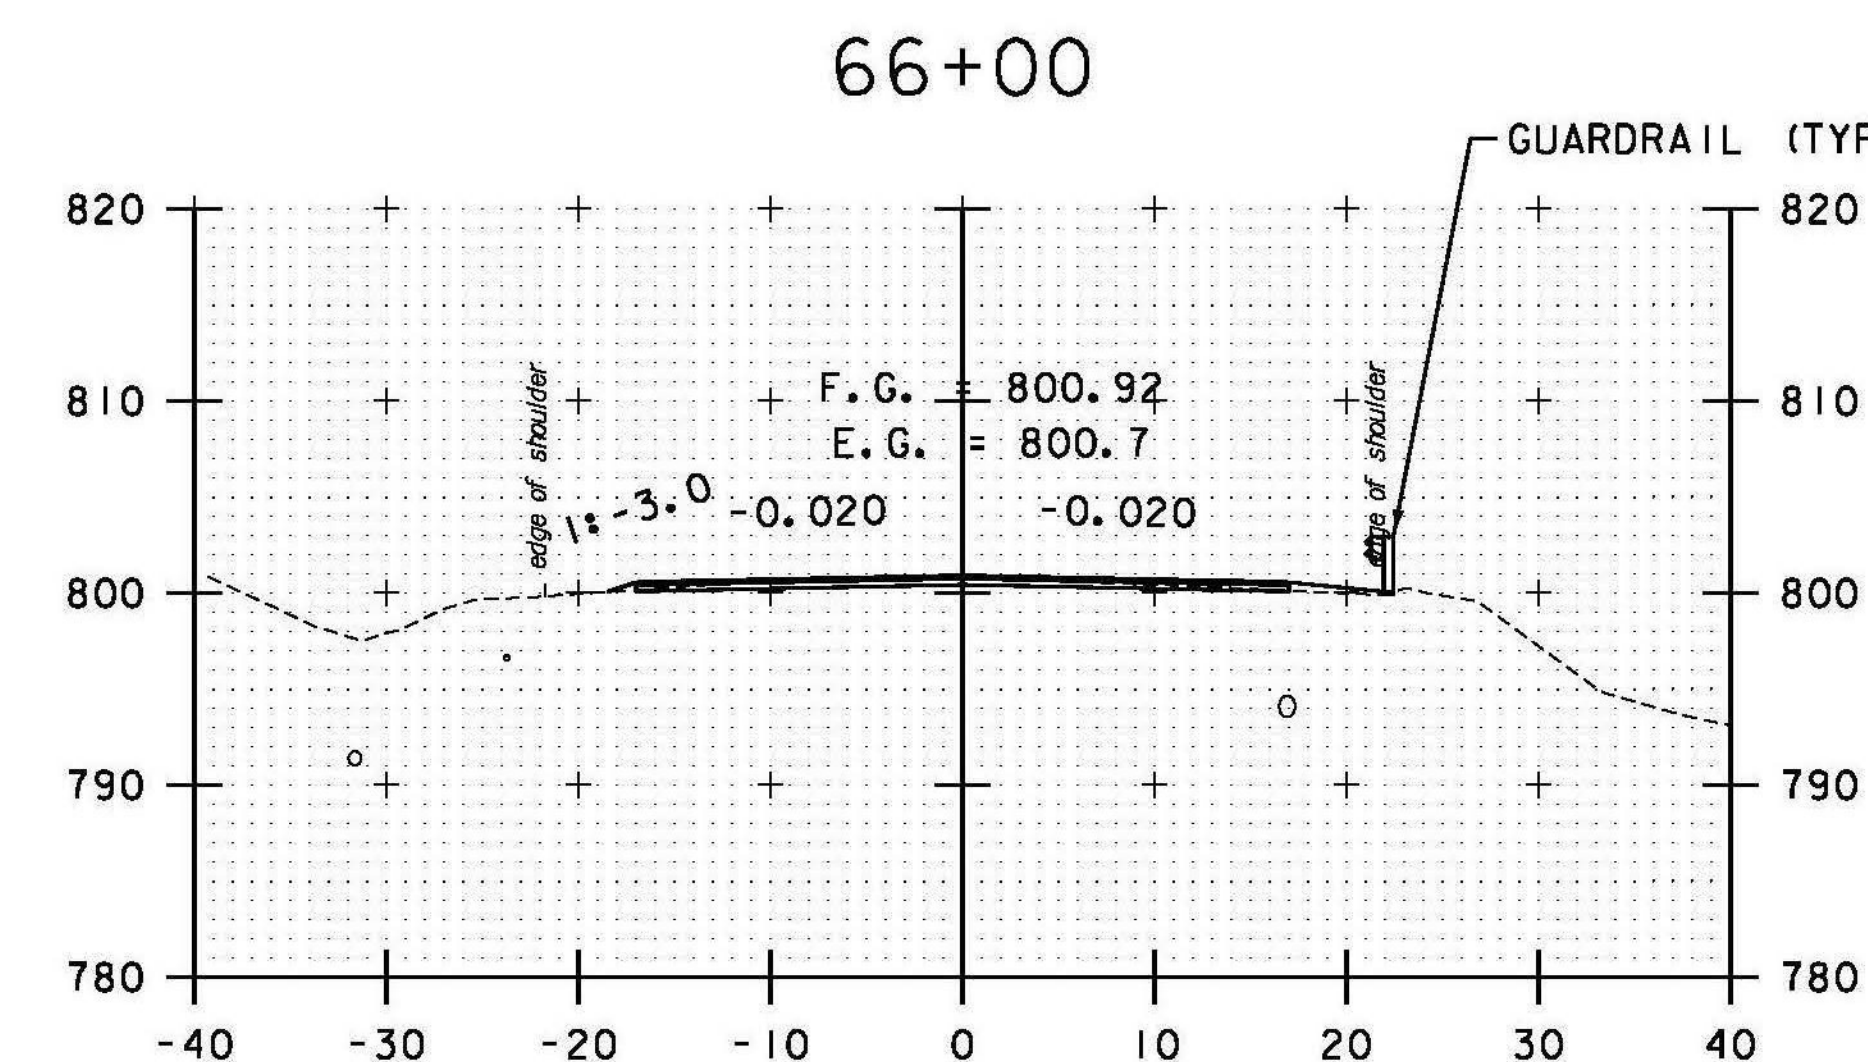
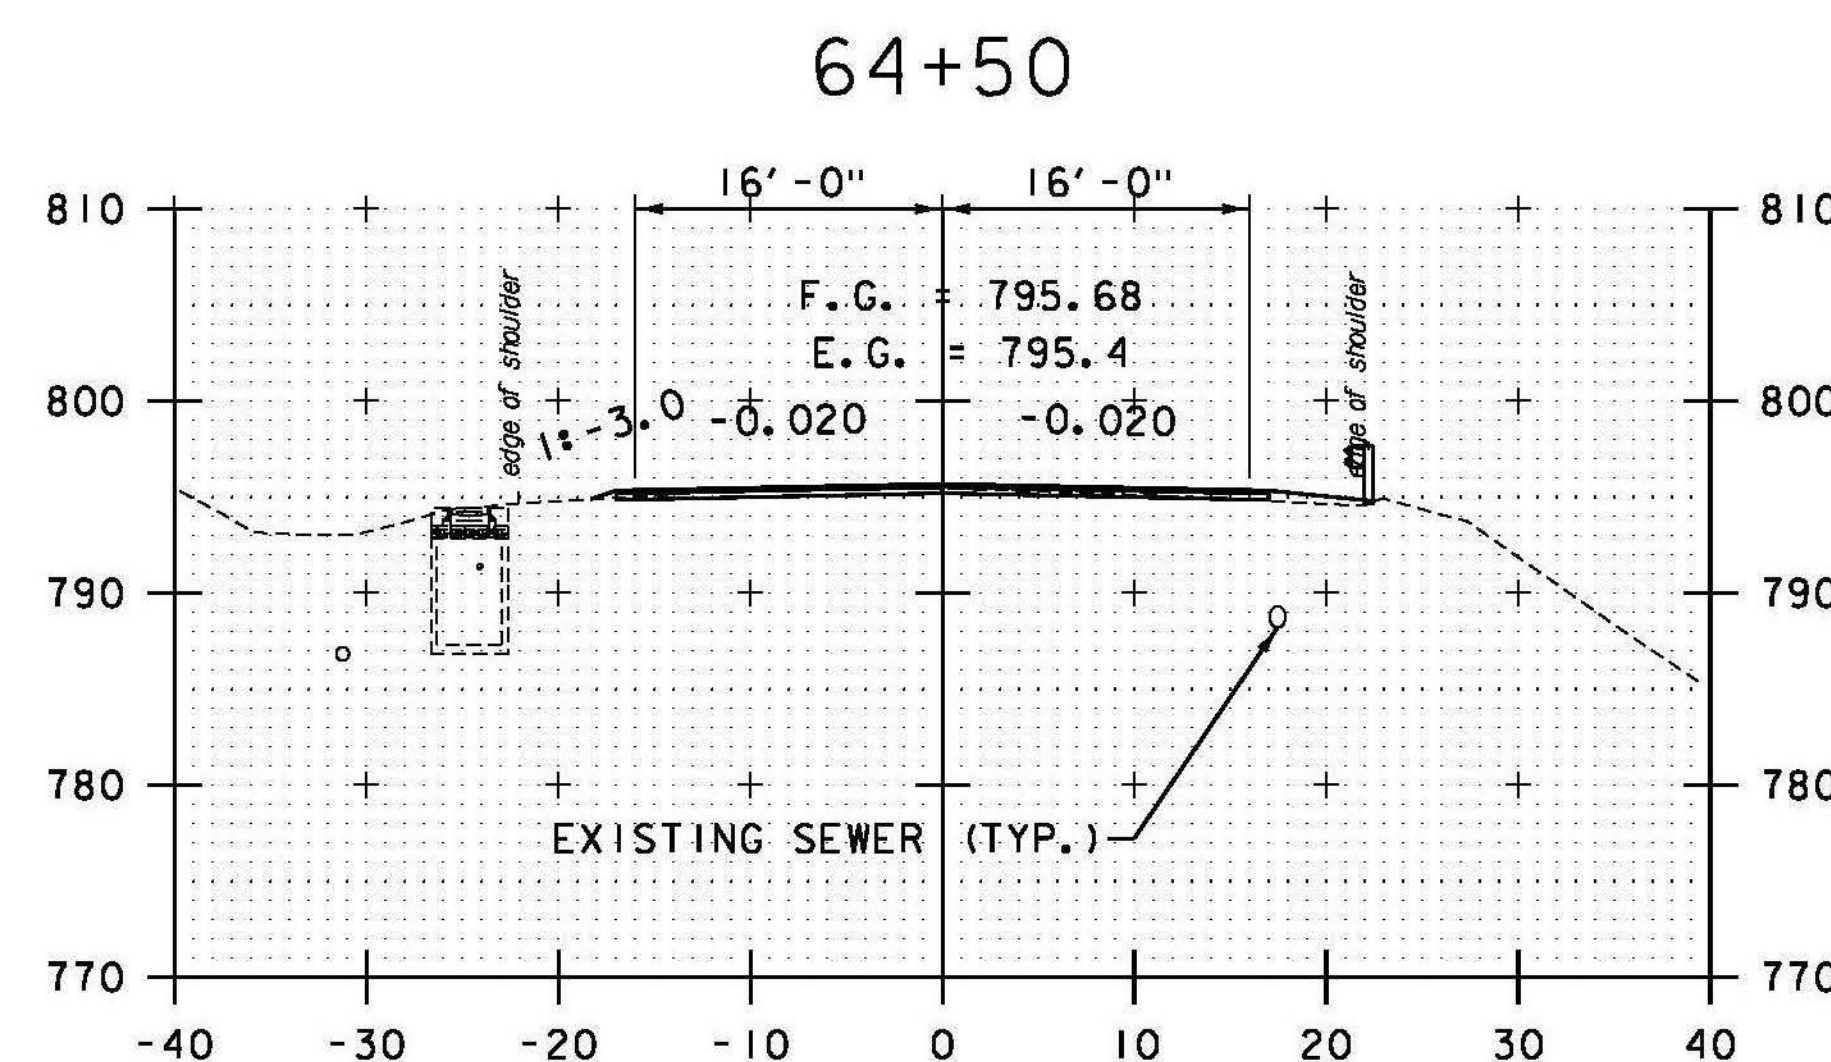
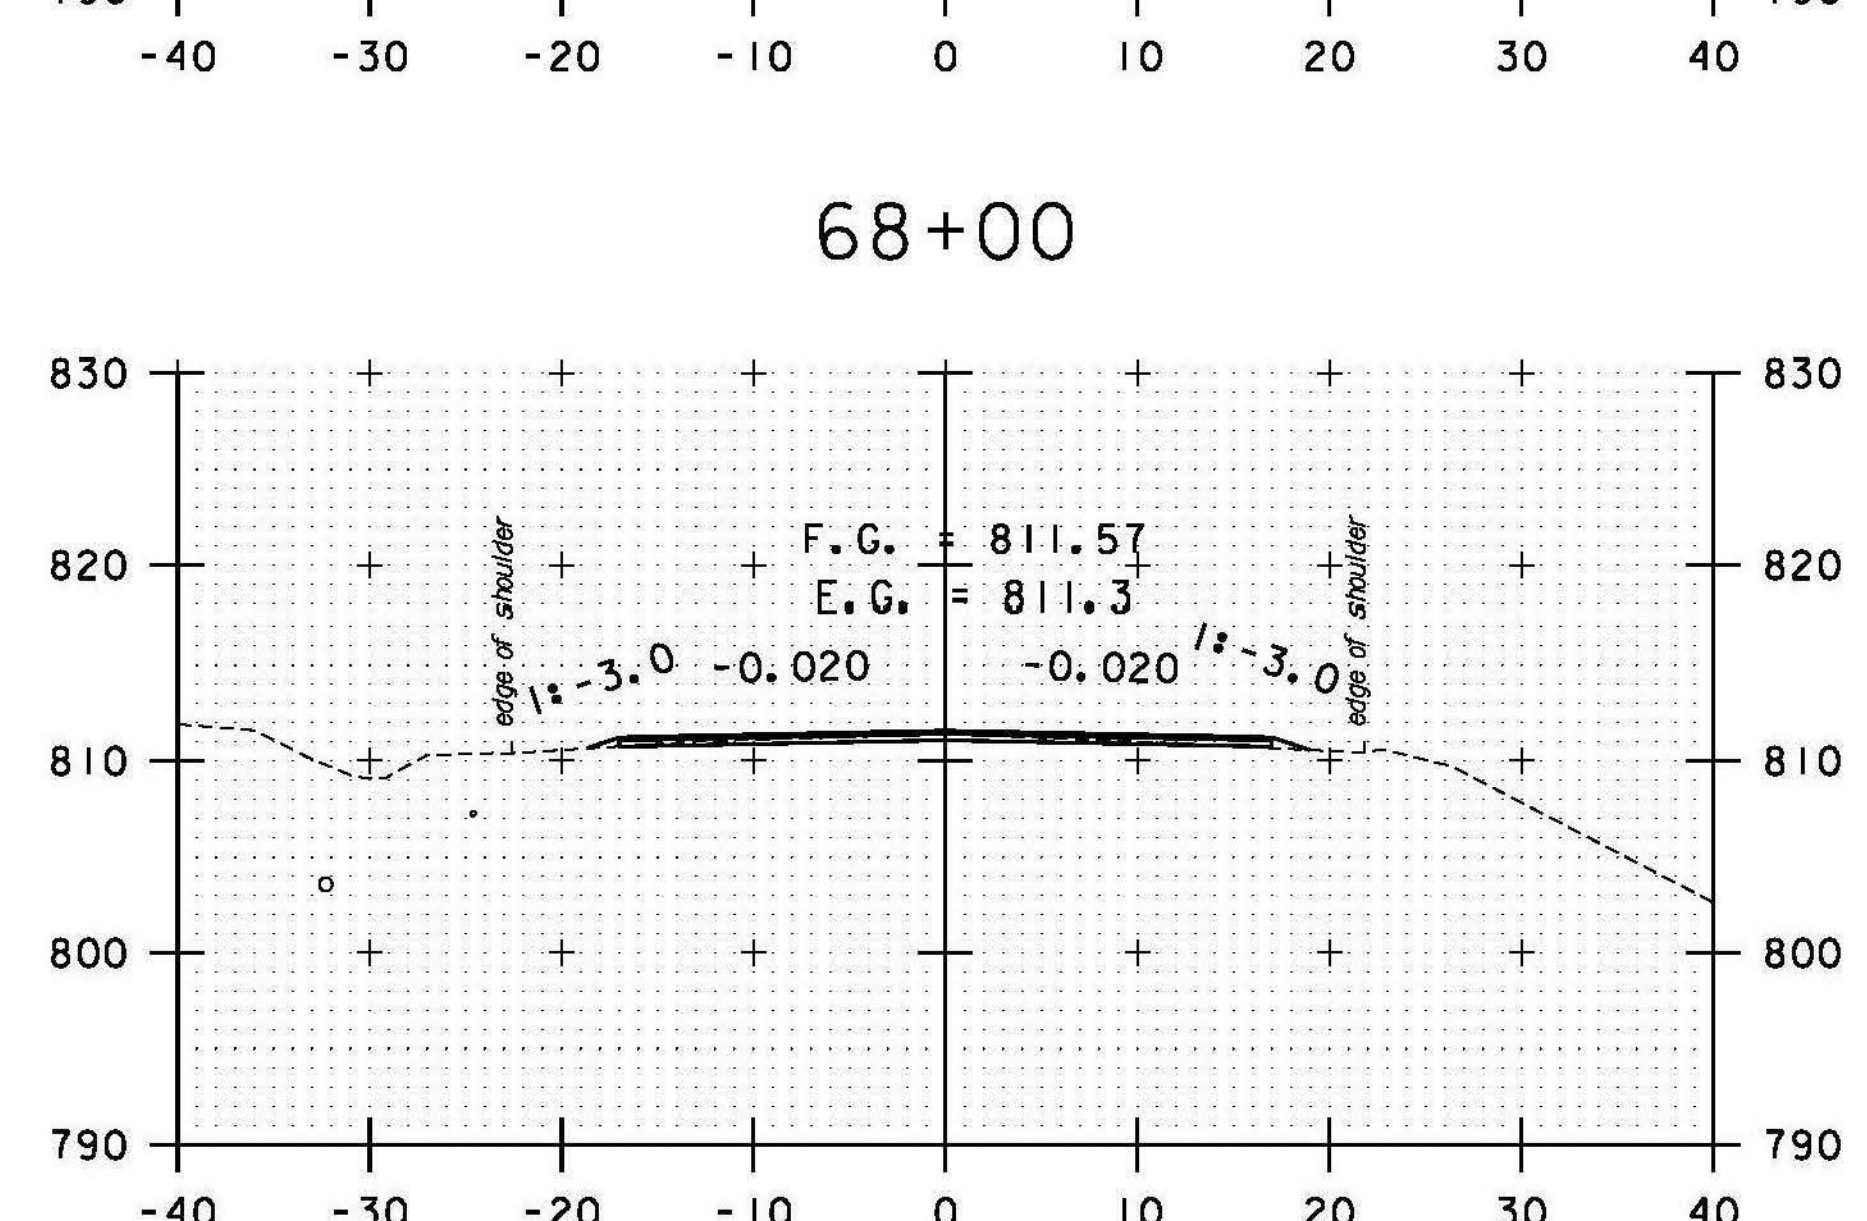
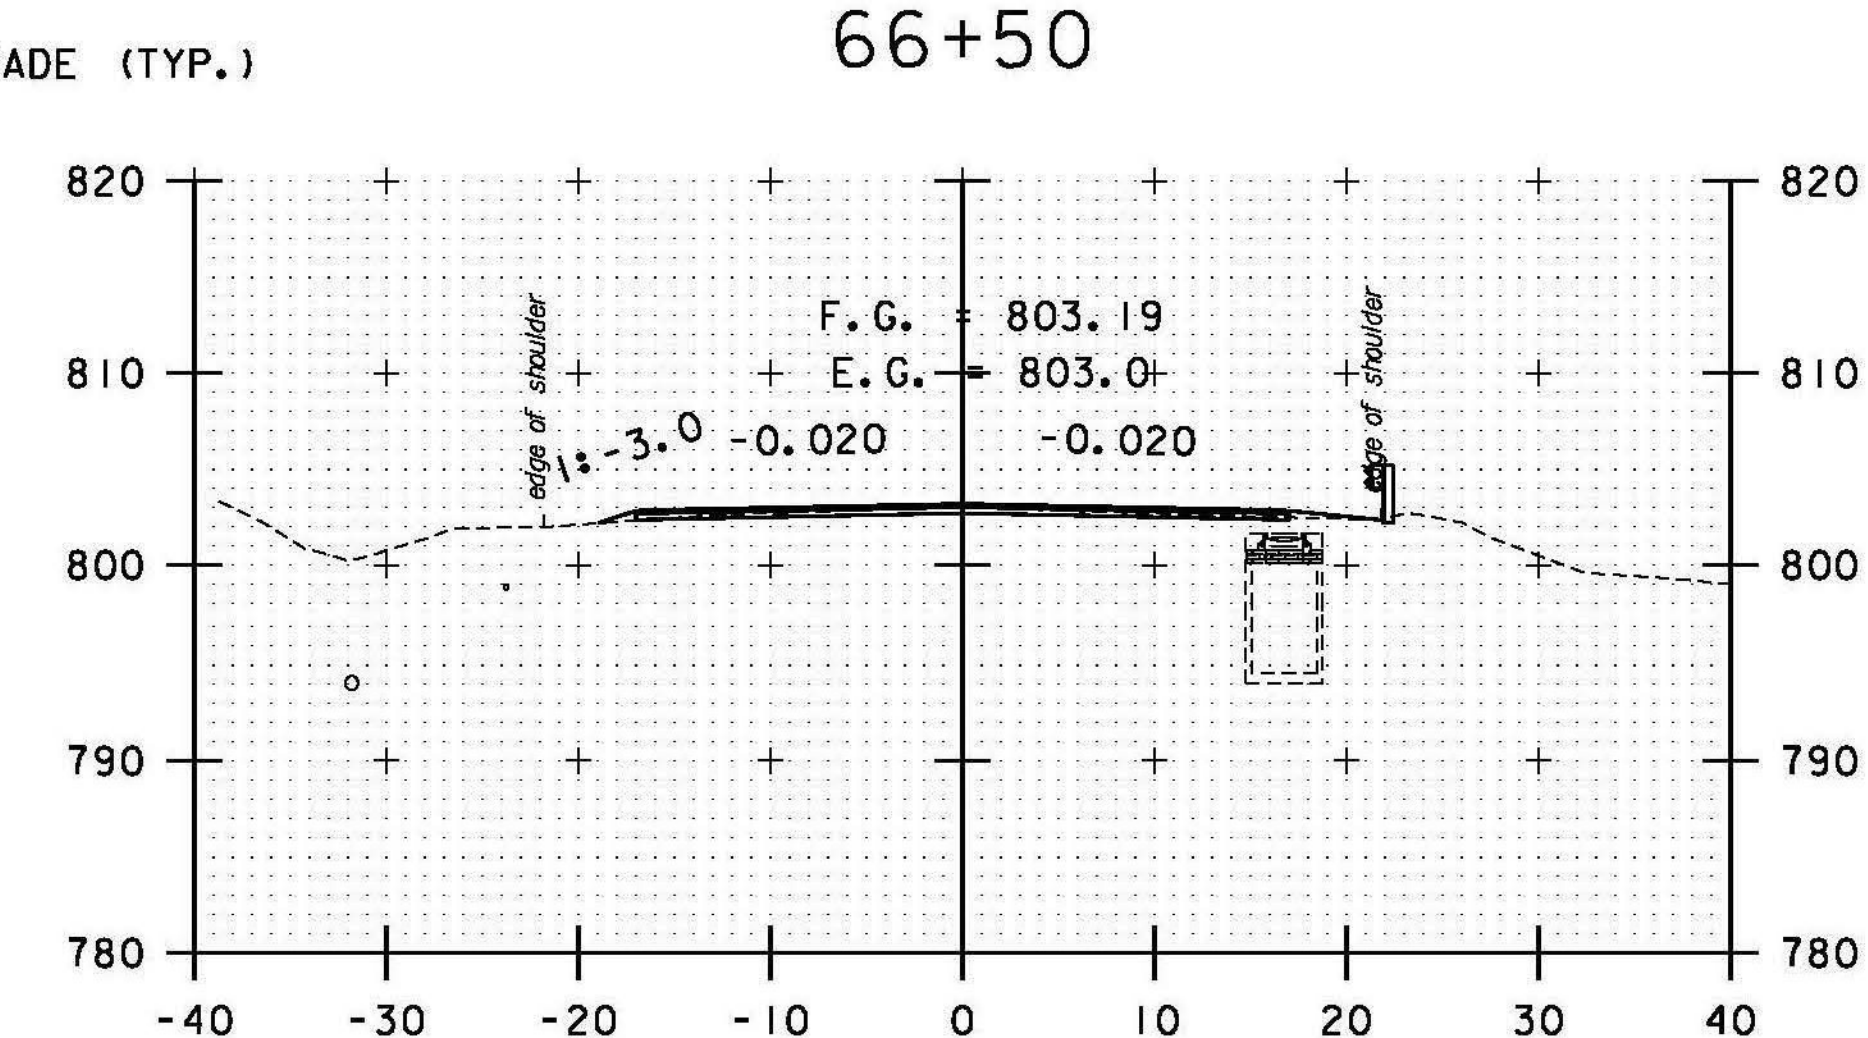
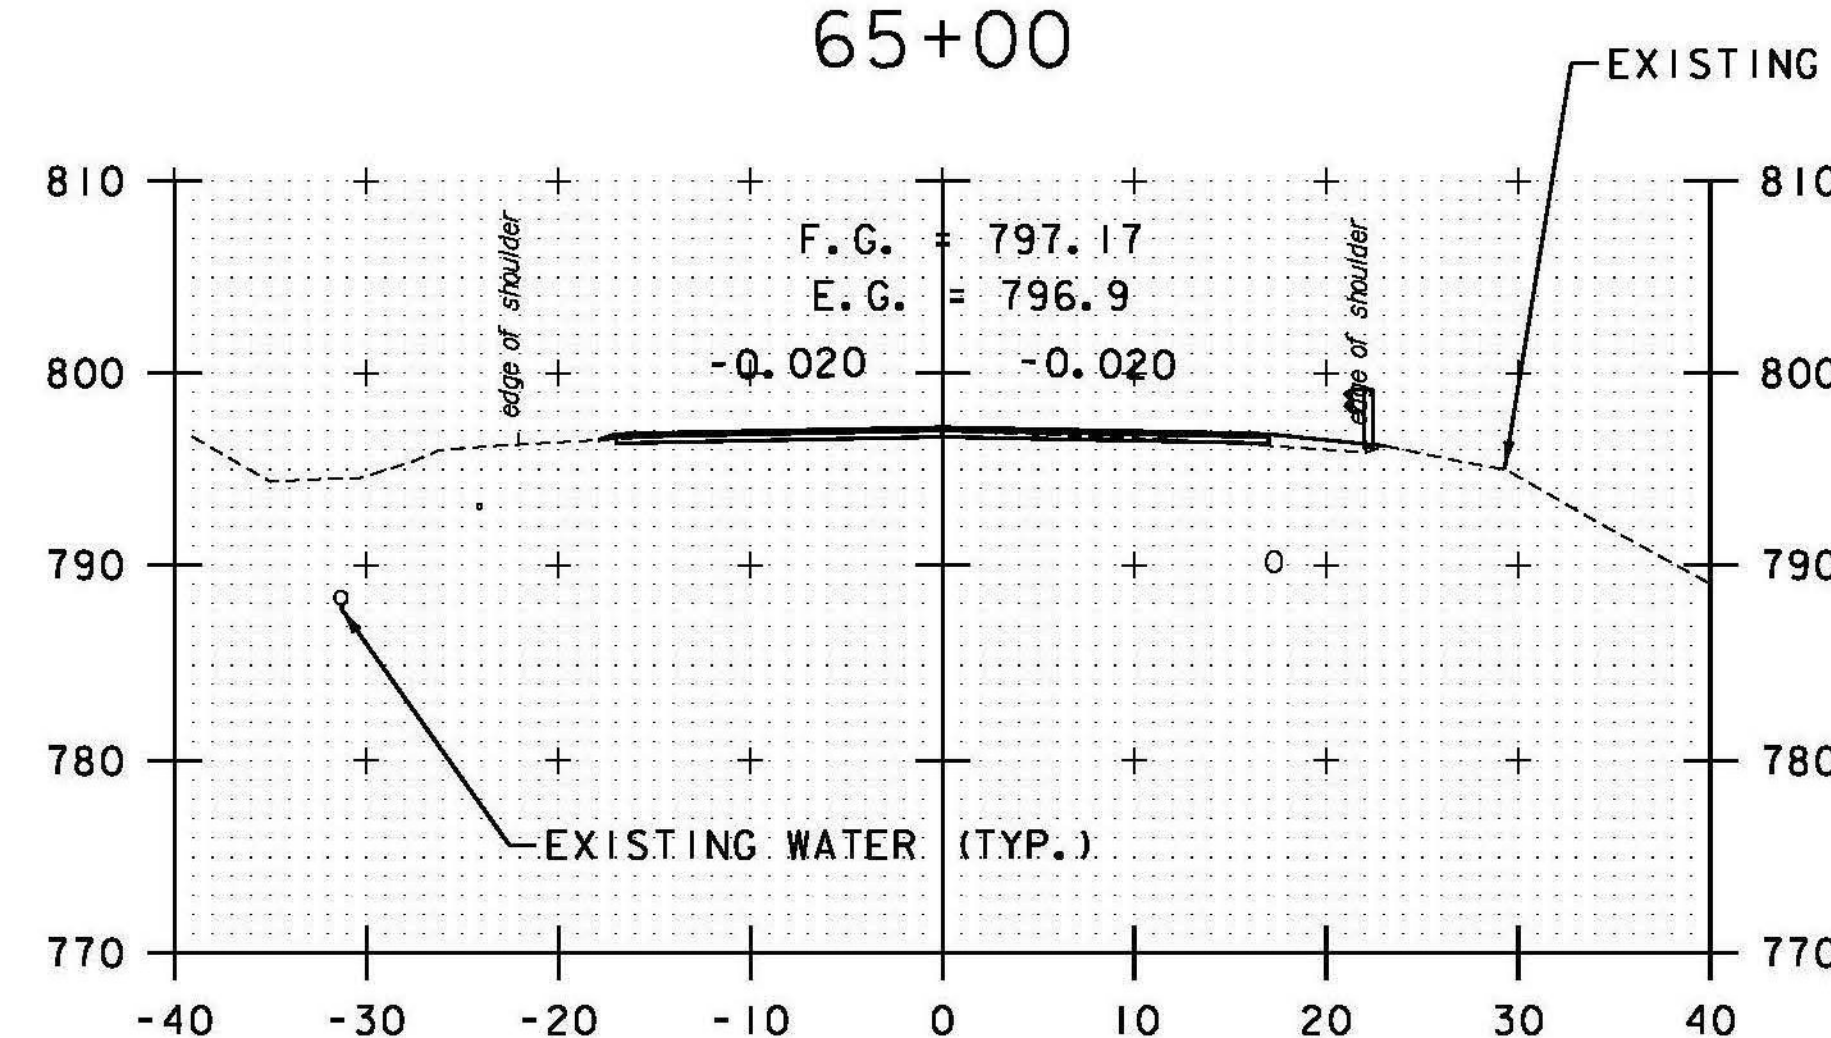
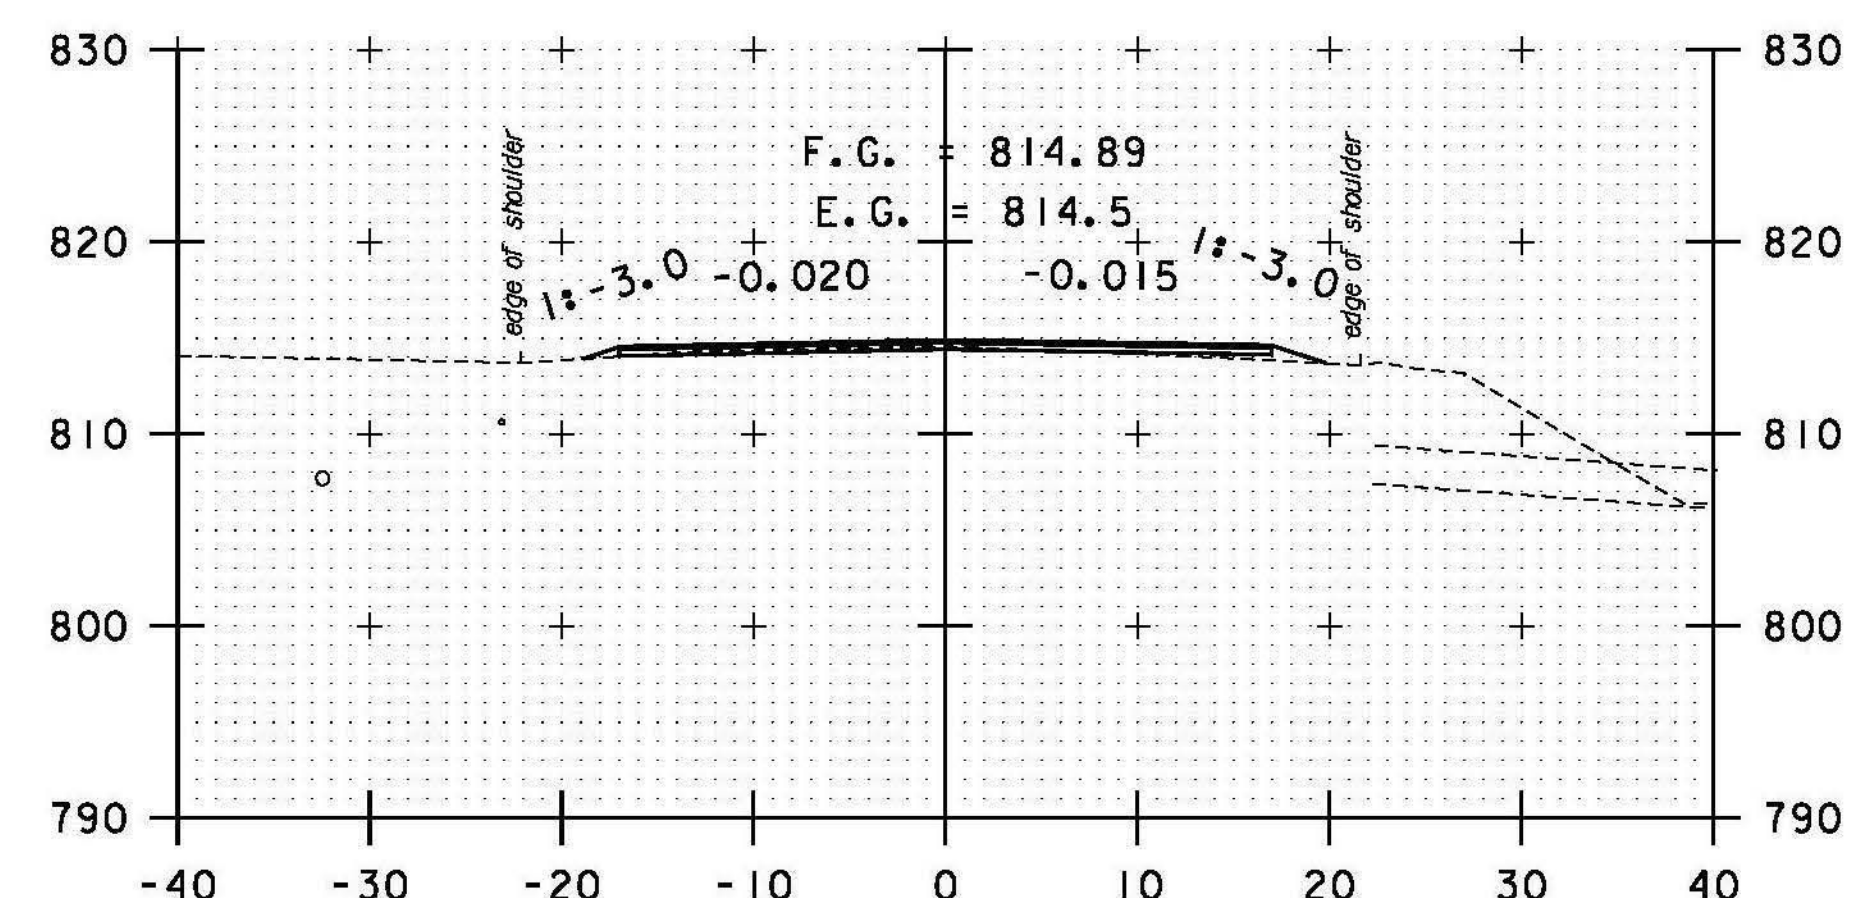
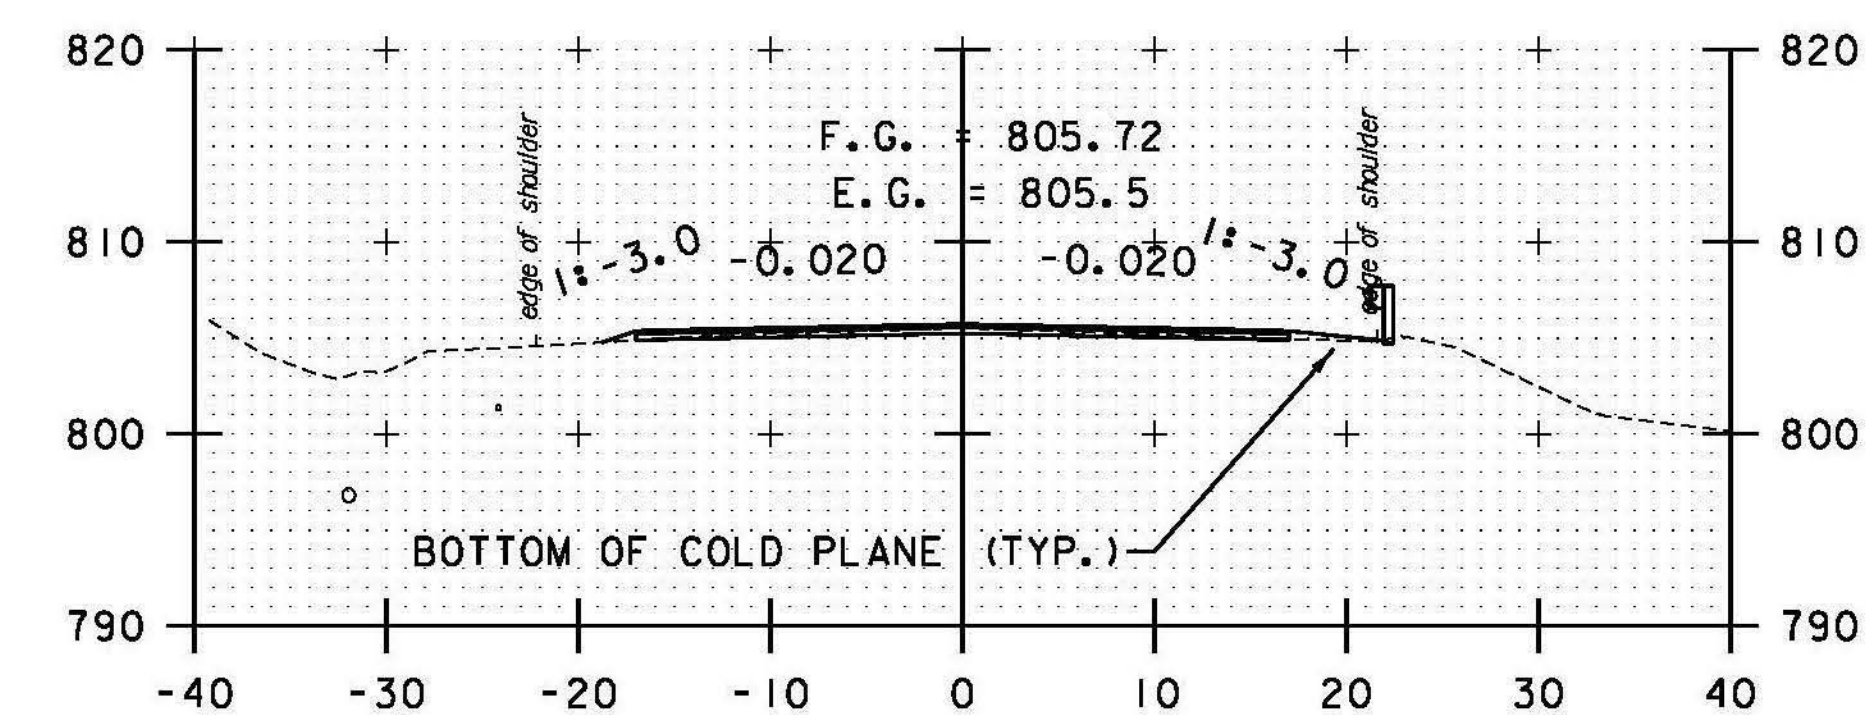


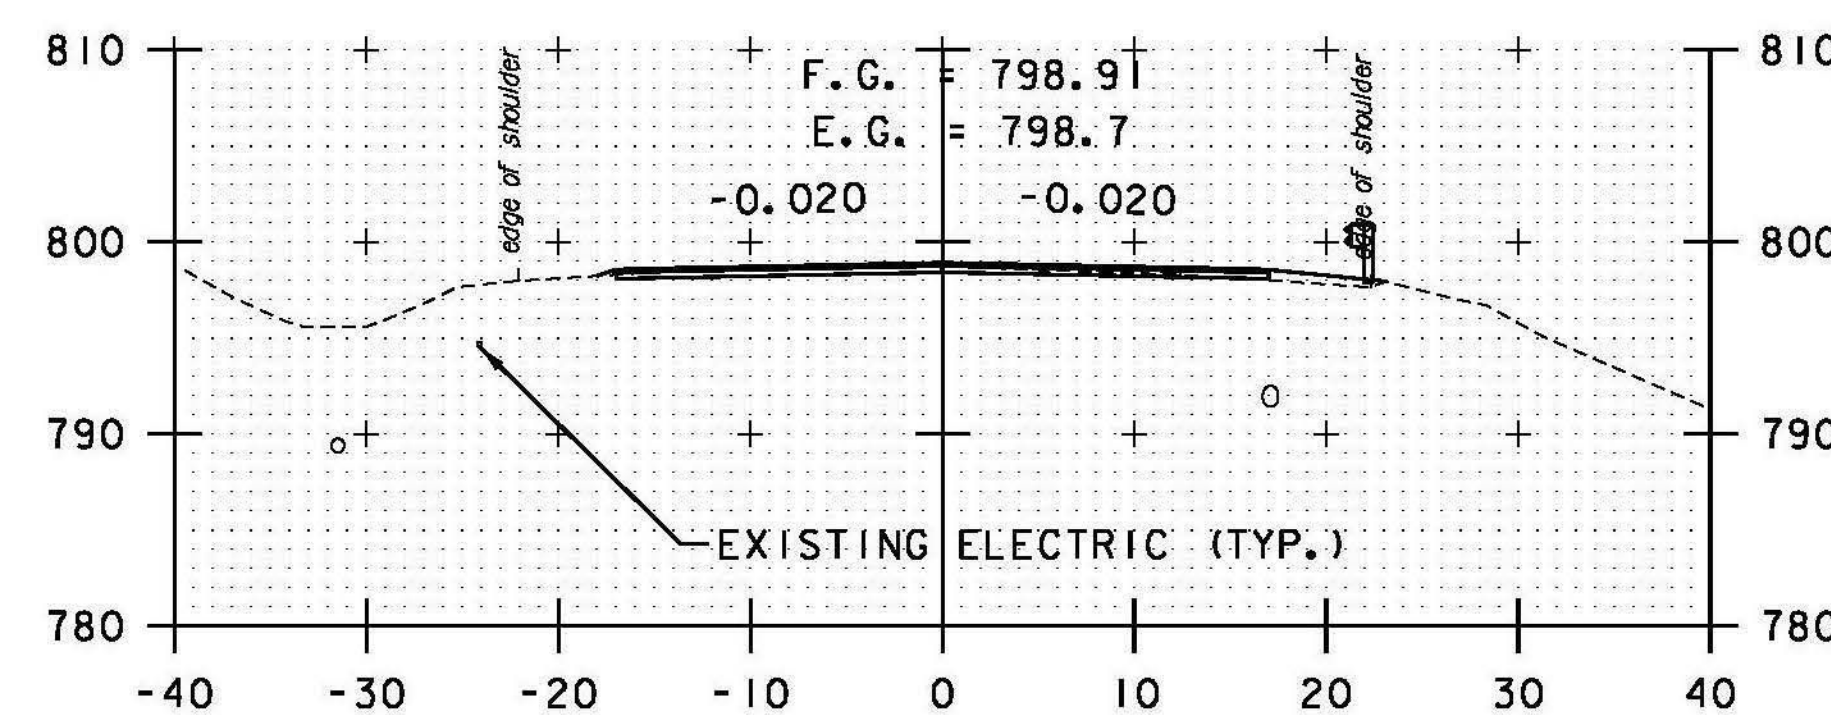

DATUM
VERTICAL NAVD 88
HORIZONTAL NAD 83 (07)

STA. 64+00 TO STA. 68+00

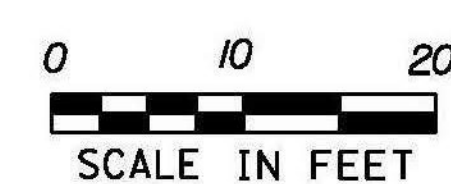

PROJECT NAME: RANDOLPH
PROJECT NUMBER: STP 2932 (1)
FILE NAME: z10c270.dgn
PROJECT LEADER: C. LATHROP
DESIGNED BY: B. BRESLEND
VT 66 CROSS SECTION SHEET 11
PLOT DATE: 6/5/2014
DRAWN BY: B. BRESLEND
CHECKED BY: C. LATHROP
SHEET 167 OF 276