

INDEX OF SHEETS
SEE SHEET 2

STATE OF VERMONT AGENCY OF TRANSPORTATION



PROPOSED IMPROVEMENT



TOWNS OF NORWICH, THETFORD, AND FAIRLEE COUNTIES OF WINDSOR AND ORANGE U.S. ROUTE 5

NORTHEAST REGION SIGN REPLACEMENT:
NORWICH MP 2.448-8.290, THETFORD MP 0.000-7.680,
FAIRLEE MP 0.000-7.278
LENGTH OF ROADWAY = 20.800 MILES
LENGTH OF PROJECT = 20.800 MILES

WORK TO BE PERFORMED UNDER THIS PROJECT INCLUDES THE REMOVAL OF EXISTING SIGNS AND POSTS
AND THE INSTALLATION OF NEW SIGNS AND SIGN POSTS AND INCIDENTAL ITEMS.


PROJECT LOCATION

NORWICH - FAIRLEE
STPG SIGN (34)

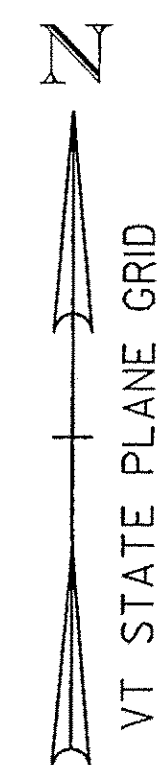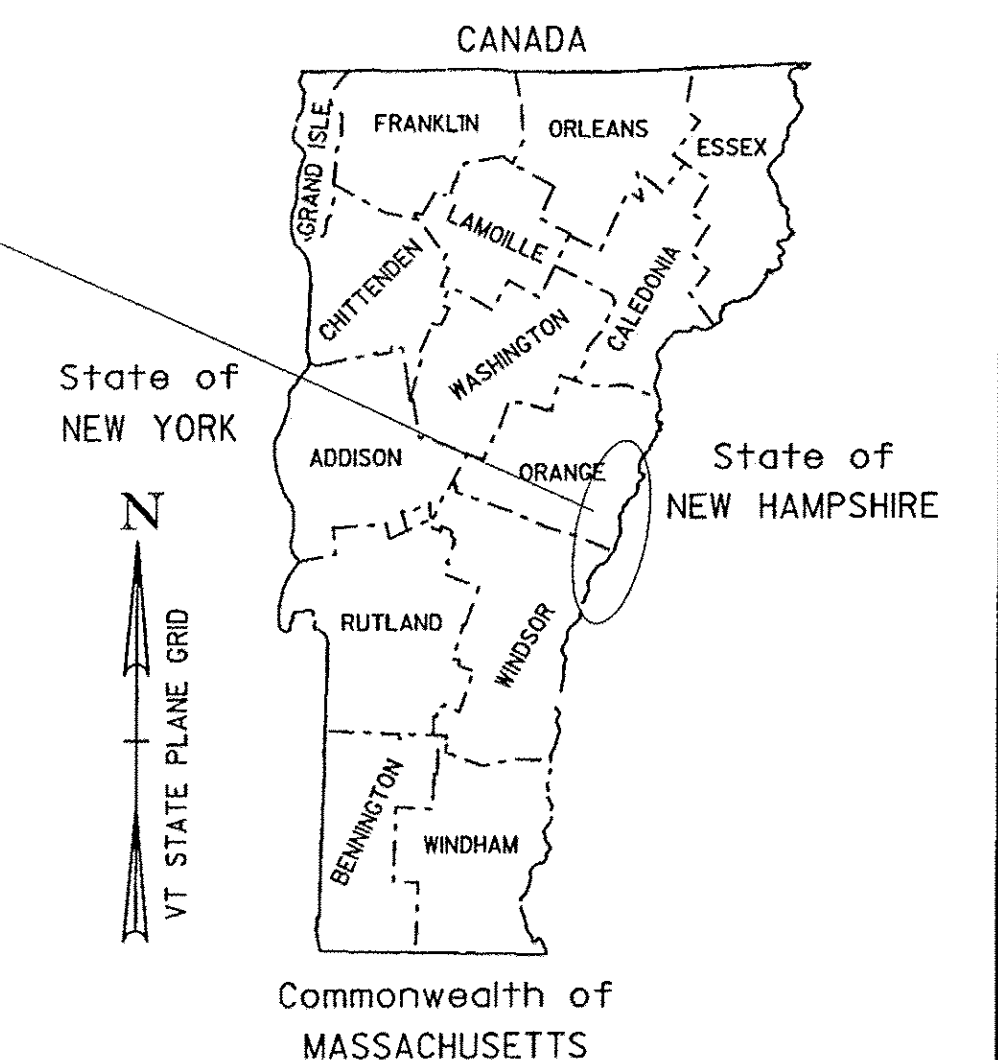

STATE OF
VERMONT

STATE OF
NEW HAMPSHIRE

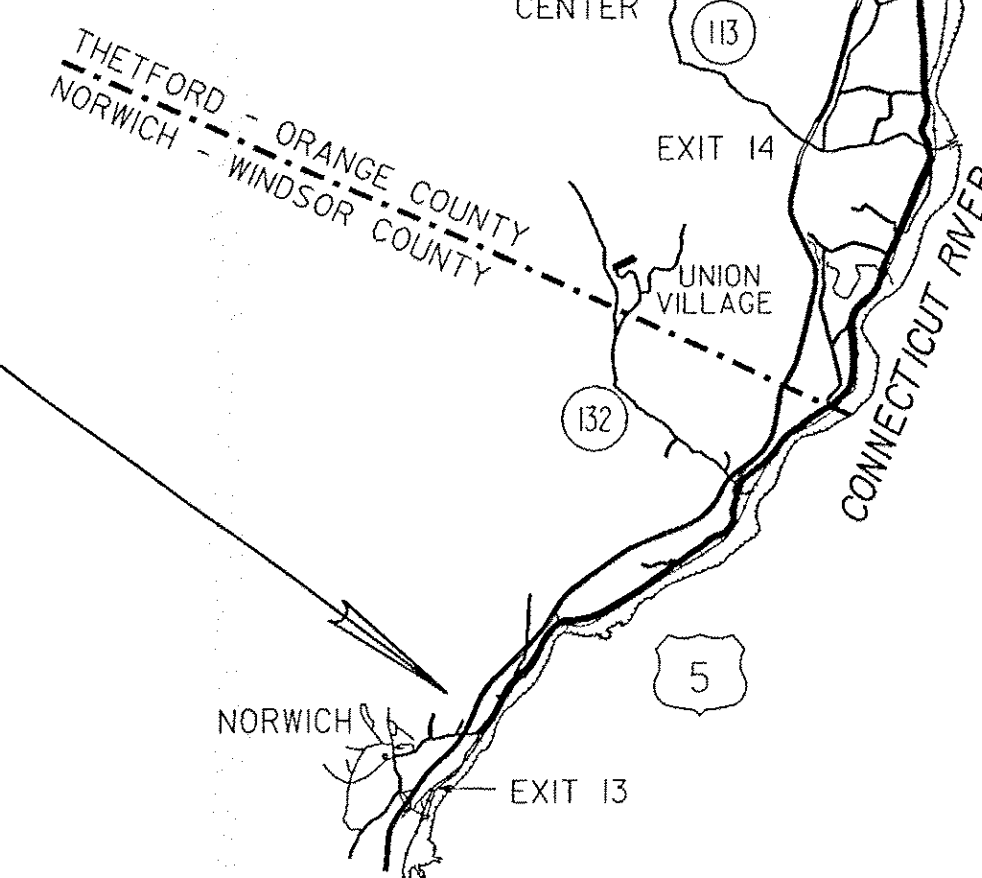

END PROJECT
NORWICH-FAIRLEE STPG SIGN (34)
US 5 FAIRLEE M.P. 7.278

BEGIN PROJECT
NORWICH-FAIRLEE STPG SIGN (34)
US 5 NORWICH M.P. 2.448

QUALITY ASSURANCE PROGRAM: LEVEL 3

CONVENTIONAL SYMBOLS

COUNTY LINE	
TOWN LINE	
LIMITS OF ACCESS	
POINT OF ACCESS	
FENCE LINE	
STONE WALL	
TRAVELED WAY	
GUARD RAIL	
RAILROAD	
SURVEY LINE	
CULVERT	
POWER POLE	
TELEPHONE POLE	
TREES	
CONTROL OF ACCESS	
PROPERTY LINE	
R.O.W. TAKING LINE	
SLOPE RIGHTS	
TOP OF CUT	
TOE OF SLOPE	

SURVEYED BY : N/A
SURVEYED DATE : N/A

DATUM

VERTICAL N/A
HORIZONTAL N/A

NOT TO SCALE

RECORD PLANS

CONTRACTOR: F. R. LAFAYETTE, INC. - ESSEX JUNCTION, VT
RESIDENT ENGINEER: M. HAUGHWOUT
CONSTRUCTION BEGAN: AUGUST 3, 2011
CONSTRUCTION COMPLETE: OCTOBER 11, 2011
RECORD PLANS BY: M. HAUGHWOUT & JENNA HYDE
I HEREBY CERTIFY THAT ALL THE CONSTRUCTION REQUIRED BY THIS SET
OF DRAWINGS HAS BEEN ACCOMPLISHED AS INDICATED HEREIN.
BY RESIDENT ENGINEER
DATE 11/7/12

NOTE: Any further information concerning final quantities, amounts or other details
relative to this project may be found at Central Files in the electronic archives.

THESE PLANS ARE SUBJECT TO SUCH ENGINEERING
CHANGES AS MAY BE REQUIRED BY THE FEDERAL HIGHWAY
ADMINISTRATION OR THE DIRECTOR OF PROGRAM
DEVELOPMENT.

CONSTRUCTION IS TO BE CARRIED ON IN ACCORDANCE
WITH THESE PLANS AND THE STANDARD SPECIFICATIONS
FOR CONSTRUCTION DATED 2006, AS APPROVED BY THE
FEDERAL HIGHWAY ADMINISTRATION ON JUNE 15, 2006
FOR USE ON THIS PROJECT, INCLUDING ALL SUBSEQUENT
REVISIONS AND SUCH REVISED SPECIFICATIONS AND
SPECIAL PROVISIONS AS ARE INCORPORATED IN THESE
PLANS.

DIRECTOR OF PROGRAM DEVELOPMENT

APPROVED DATE 5-5-2011

PROJECT MANAGER : AMY GAMBLE

PROJECT NAME : NORWICH - FAIRLEE

PROJECT NUMBER : STPG SIGN (34)

SHEET 1 OF 65 SHEETS

INDEX OF SHEETS

1	TITLE SHEET
2	GENERAL NOTES
3	QUANTITY SHEET
4-6	SIGN DETAILS
7	BLANK
8-12	NORWICH US 5 NORTHBOUND TRAFFIC SIGN SUMMARY SHEETS
13-18	NORWICH US 5 SOUTHBOUND TRAFFIC SIGN SUMMARY SHEETS
19-28	THETFORD US 5 NORTHBOUND TRAFFIC SIGN SUMMARY SHEETS
29	BLANK
30-39	THETFORD US 5 SOUTHBOUND TRAFFIC SIGN SUMMARY SHEETS
40-51	FAIRLEE US 5 NORTHBOUND TRAFFIC SIGN SUMMARY SHEETS
52-64	FAIRLEE US 5 SOUTHBOUND TRAFFIC SIGN SUMMARY SHEETS
65	TOWN TOTAL SIGN SUMMARY SHEET

STANDARDS

E-121	STANDARD SIGN PLACEMENT CONVENTIONAL ROAD	08/08/1995
E-136B	STATE ROUTE MARKER SIGN DETAILS	08/08/1995
E-136C	STATE NUMBERED TOWN HIGHWAY SIGN DETAILS	08/08/1995
E-138	MILEMARKER DETAILS STATE AND TOWN HIGHWAYS	05/30/2003
E-141	REGULATORY SIGN DETAILS	09/20/1995
E-144	REGULATORY SIGN DETAILS	03/29/1999
E-146	REGULATORY SIGN DETAILS	09/20/1995
E-154	WARNING SIGN DETAILS	05/01/2004
E-163	TUBULAR STEEL SIGN POST	05/20/1999
E-164	SQUARE STEEL SIGN POST	06/08/2009

SIGN DESIGN AND FABRICATION

- THE MUTCD SIGN CODES PROVIDED IN THESE PLANS REFER TO THE 2009 MUTCD. DESIGN DETAILS FOR SIGNS INDICATED ON THE PLANS AS FOUND IN THE SHSM, SHALL BE PER 2009 STANDARD HIGHWAY SIGN AND MARKINGS BOOK (SHSM), WHICH AT THIS TIME HAS NOT BEEN RELEASED. TO ADVANCE THE AVAILABILITY OF NEW INFORMATION FOR FIELD INSTALLATIONS AS SOON AS POSSIBLE, INTERIM RELEASES ARE PLANNED FOR ITEMS THAT ARE NEW OR SIGNIFICANTLY REVISED BY THE 2009 MUTCD AND CAN BE FOUND AT http://mutcd.fhwa.dot.gov/shsm_interim/index.htm. THE CONTRACTOR SHALL CONTACT THE ENGINEER FOR SIGN DETAILS IF NONE ARE AVAILABLE FROM THESE SOURCES.
- SIGN SHEETING FOR FLUORESCENT YELLOW (FY) AND FLUORESCENT YELLOW-GREEN (FYG) SHALL BE ASTM D4956 TYPE VII, VIII OR IX. ALL OTHER SIGN SHEETING SHALL BE TYPE III OR IV.
- SHEETING TYPES AND MANUFACTURERS SHALL NOT BE MIXED ON A SINGLE SIGN ASSEMBLY. SHEETING COLOR/TYPE SHOULD BE BY THE SAME MANUFACTURER AND BE CONSISTENT THROUGHOUT THE PROJECT.
- SIGN BASE MATERIAL FOR DELINEATORS AND MILE MARKER PLAQUES (VD-700) SHALL BE 0.063" THICK FLAT SHEET ALUMINUM. UNLESS OTHERWISE NOTED ON THE PLANS, ALL OTHER SIGNS SHALL BE FLAT SHEET ALUMINUM WITH THE FOLLOWING MINIMUM THICKNESSES:

SIGN SIZE	12" X 12"		
	18" X 18"		
	21" X 15"		
	24" X 8"		
	24" X 10"		48" X 18"
	24" X 12"	36" X 12"	48" X 24"
	24" X 18"	36" X 15"	48" X 30"
	24" X 24"	36" X 18"	48" X 42"
	24" X 30"	36" X 24"	48" X 48"
	30" X 15"	36" X 36"	48" X 60"
	30" X 18"	36" X 42"	72" X 10"
	30" X 30"	36" X 48"	72" X 12"
	30" X 42"	36" X 54"	72" X 20"
	THICKNESS	0.080"	0.100" 0.125"

SIGN POSTS


- ALL SQUARE STEEL SIGN POSTS SHALL BE INSTALLED IN A NEW ANCHOR. ALL SIGNS INSTALLED IN PAVED OR CONCRETE ISLANDS OR SIDEWALKS SHALL ALSO BE INSTALLED WITH AN 18" SLEEVE. PAYMENT FOR SLEEVE SHALL BE INCIDENTAL TO THE SIGN POST.
- 1.75" SQUARE STEEL POSTS SHALL BE 14 GAUGE STEEL. 2" AND 2.5" SQUARE STEEL POSTS SHALL BE 12 GAUGE STEEL.

SIGN INSTALLATION

- THE CONTRACTOR SHALL BE RESPONSIBLE FOR REPAIRING ANY DAMAGE TO PRIVATE OR PUBLIC PROPERTY CAUSED BY THE CONTRACTOR, AT THEIR EXPENSE.
- ALL SIGNS WITHIN THE PROJECT LIMITS ARE TO BE REPLACED UNLESS OTHERWISE NOTED OR AS DIRECTED BY THE RESIDENT ENGINEER. SIGN LOCATIONS AS SHOWN ON THE PLANS ARE APPROXIMATE. EXACT LOCATIONS TO BE DETERMINED IN THE FIELD.
- ALL SIGN PLACEMENT SHALL BE IN CONFORMANCE WITH VAOT STANDARD E-121 STANDARD SIGN PLACEMENT CONVENTIONAL ROADS, UNLESS OTHERWISE NOTED.
- ALL SIGNS, FRAMES, MOUNTING HARDWARE, POSTS, AND ANCHORS FOR ANY SIGN ASSEMBLY SHALL BE REPLACED AT THE SAME TIME. MIXING OF OLD AND NEW SIGNS ON THE SAME ASSEMBLY WILL NOT BE ALLOWED.
- NEW SIGNS WITH THEIR GREATER NIGHTTIME REFLECTIVITY CAN OBSCURE OLDER SIGNS MOUNTED ADJACENT TO THEM. TO AVOID CONFUSION OF ROAD USERS, WORK SHALL BE COORDINATED SUCH THAT ALL SIGNS ASSOCIATED WITH A CURVE, INTERSECTION, OR SPEED CHANGES, SHALL BE REPLACED ON THE SAME DAY AND NOT LEFT INCOMPLETE OR WITH A MIXTURE OF OLD AND NEW SIGNS WITHIN A GROUP OF ASSOCIATED SIGNS.

TEMPORARY TRAFFIC CONTROL NOTES

- THE CONTRACTOR SHALL SUBMIT SITE SPECIFIC TRAFFIC CONTROL PLANS CONFORMING TO THE MANUAL ON UNIFORM TRAFFIC CONTROL DEVICES (MUTCD), DATED 2009, AND ITS LATEST REVISIONS, TO THE ENGINEER AT THE PRE-CONSTRUCTION MEETING FOR REVIEW AND APPROVAL BY THE RESIDENT ENGINEER.
- WHEN WORKING IN THE VICINITY OF EXISTING PEDESTRIAN FACILITIES, ADA ACCESSIBLE PEDESTRIAN ACCOMMODATIONS SHALL BE MAINTAINED AT ALL TIMES. PAYMENT SHALL BE INCLUDED IN THE UNIT BID PRICE FOR CONTRACT ITEM 641.00 TRAFFIC CONTROL.
- THE CONTRACTOR MUST PROVIDE ACCESS THROUGH THE WORK ZONE FOR EMERGENCY VEHICLES AT ALL TIMES.
- THE CONTRACTOR SHALL CONDUCT THE WORK AT ALL TIMES IN SUCH A MANNER AND IN SUCH SEQUENCE SO AS TO ENSURE THE LEAST INTERFERENCE WITH TRAFFIC OCCURS.
- SIGNS SHALL ONLY BE VISIBLE TO MOTORISTS AT THE TIMES WHEN THE MESSAGE IS PERTINENT, I.E. A "FLAGGER AHEAD" SIGN SHALL ONLY BE VISIBLE TO MOTORISTS WHEN THE FLAGGER IS ACTUALLY PRESENT PERFORMING THEIR DUTIES.
- PAYMENT FOR CONSTRUCTION SIGNING WILL BE MADE UNDER CONTRACT ITEM 641.00 TRAFFIC CONTROL.
- SIGNS SHALL BE MOVED AS WORK AREA MOVES. AT NO TIME SHALL THE FLAGGER SIGN BE GREATER THAN 1000 FEET IN ADVANCE OF THE FLAGGER STATION.

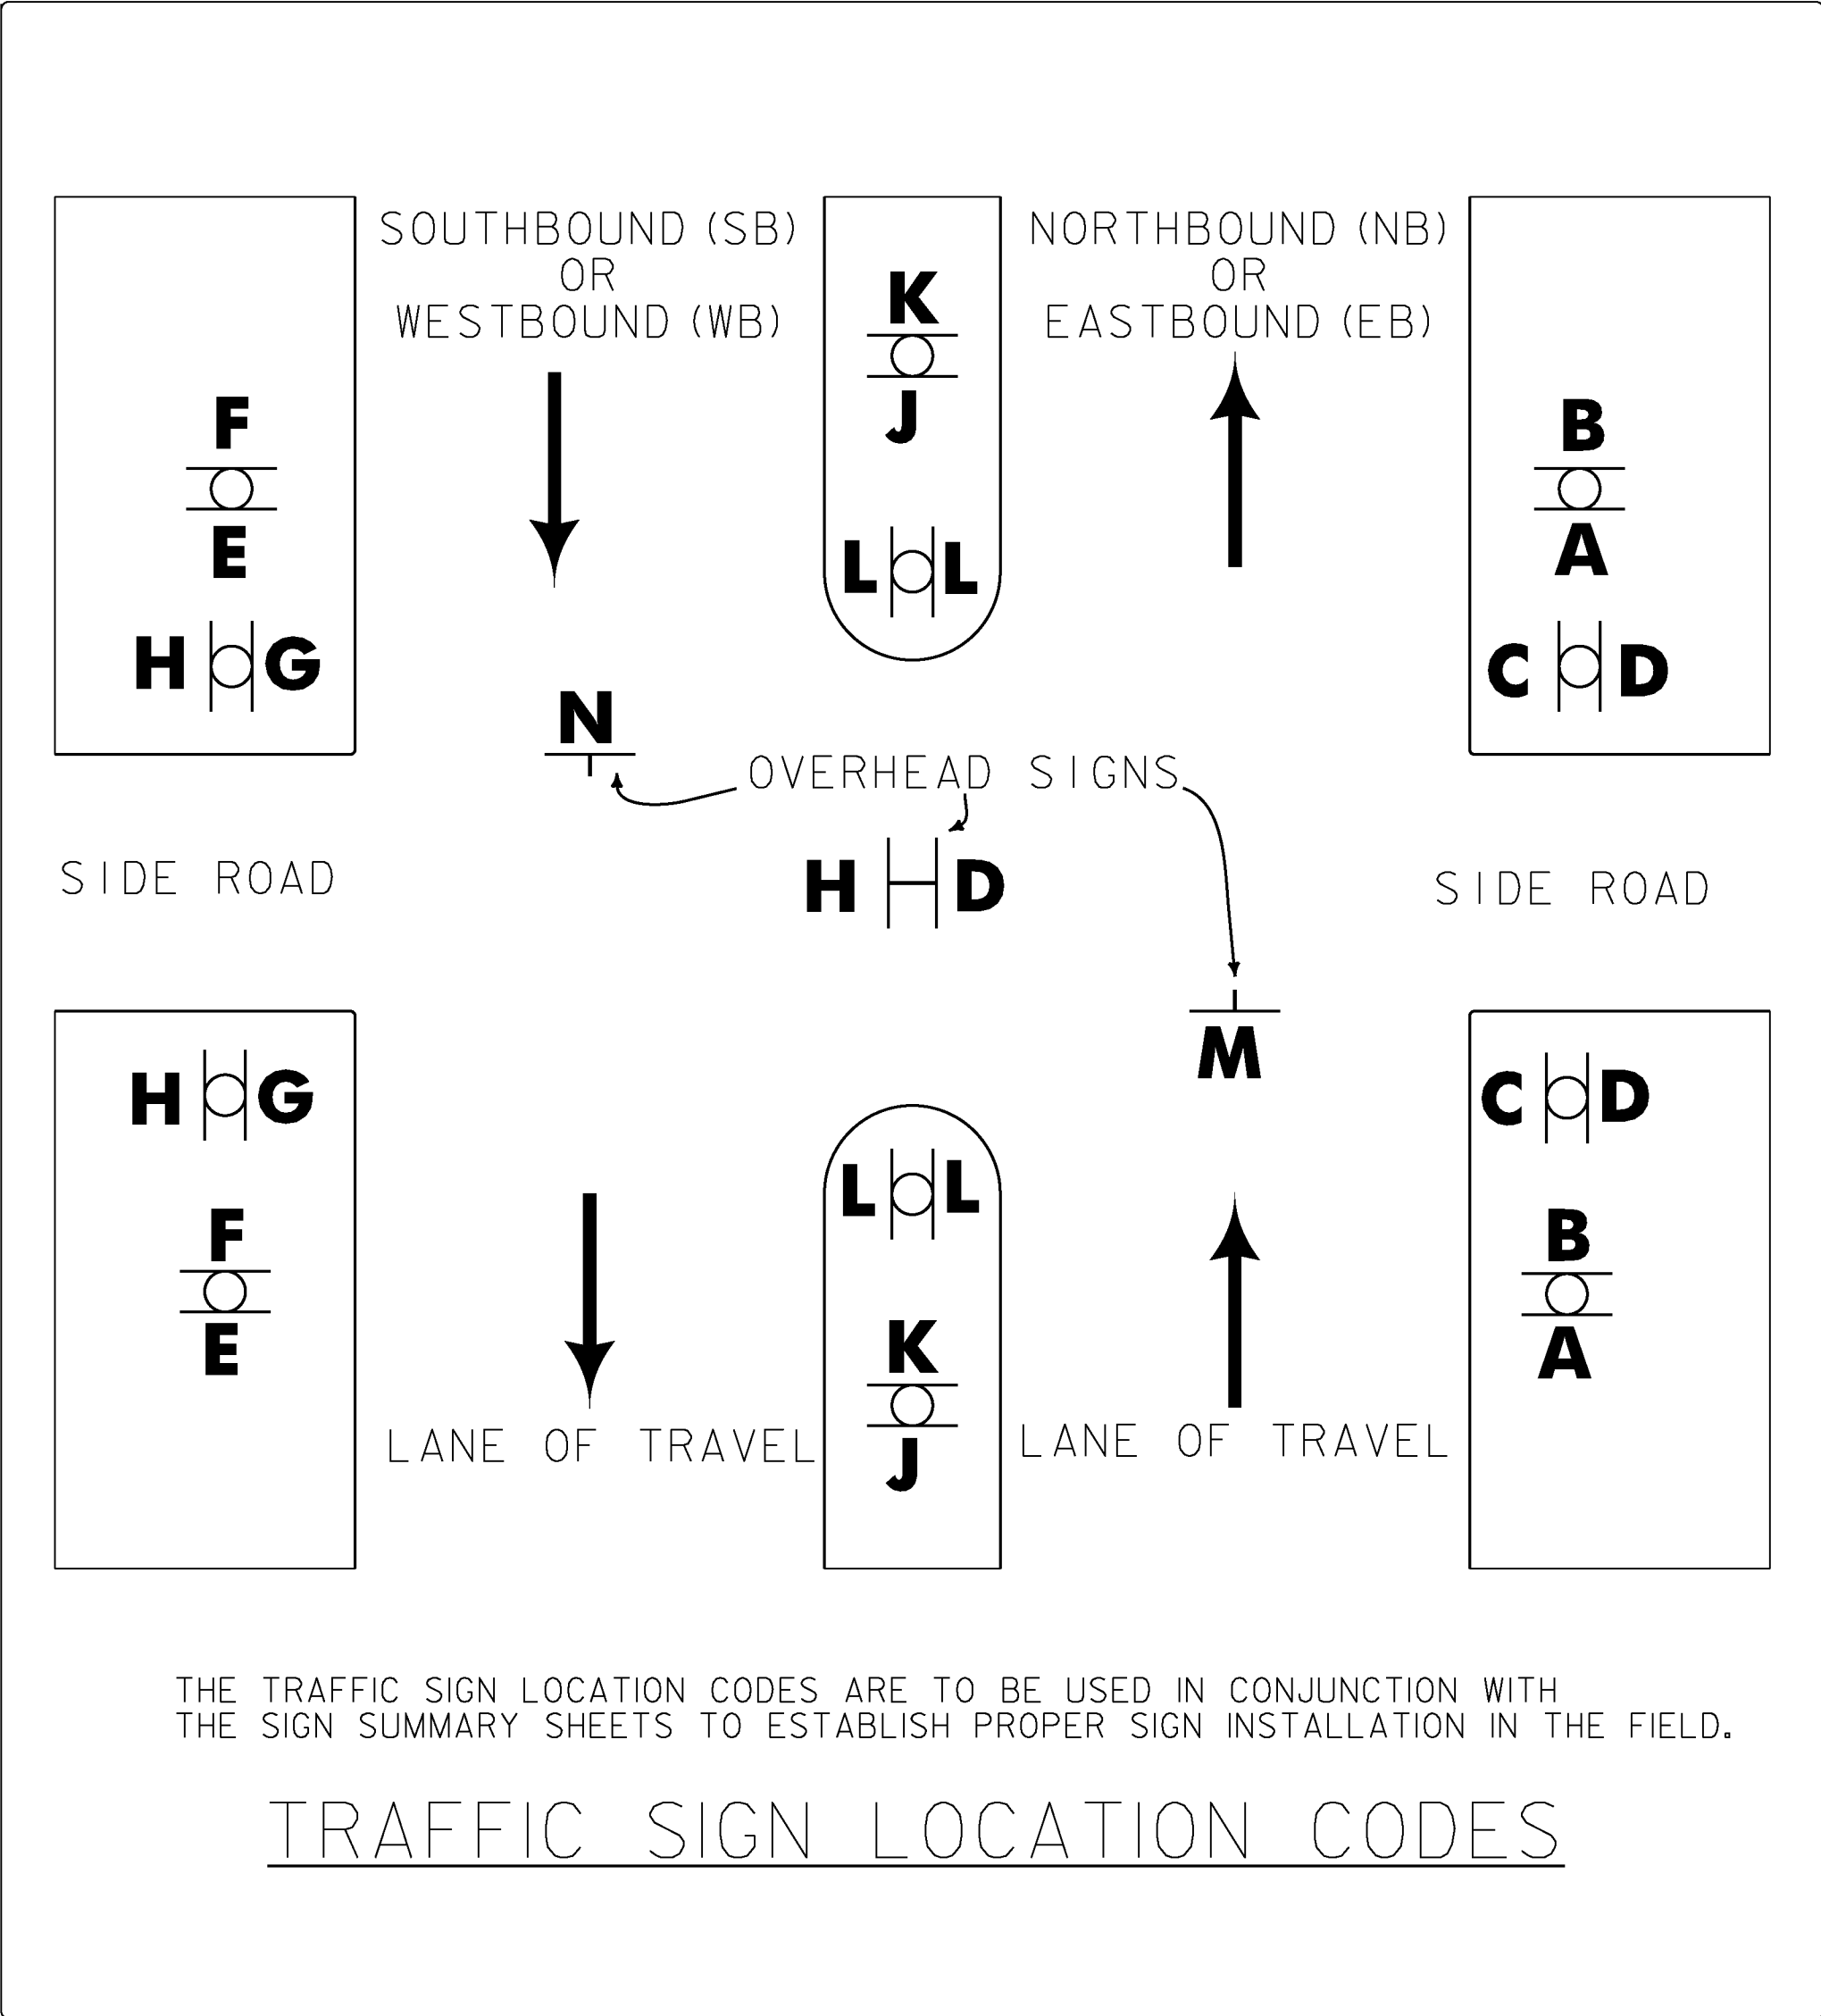

THE TRAFFIC SIGN LOCATION CODES ARE TO BE USED IN CONJUNCTION WITH THE SIGN SUMMARY SHEETS TO ESTABLISH PROPER SIGN INSTALLATION IN THE FIELD.

TRAFFIC SIGN LOCATION CODES

GENERAL NOTES

- EXISTING STAND ALONE MILE MARKERS OR MILE MARKERS ATTACHED TO A RETAINED SIGN POST ASSEMBLY SHALL BE RETAINED.
- EXISTING MILE MARKERS ON SIGN POSTS BEING REPLACED SHALL BE REMOVED AND SALVAGED ONTO THE NEW SIGN POST.
- EXISTING MILE MARKERS ATTACHED TO A SIGN ASSEMBLY THAT IS TO BE RELOCATED SHALL BE REMOVED, UNLESS OTHERWISE DIRECTED BY THE ENGINEER.
- EXISTING STREET NAME SIGNS ATTACHED TO SIGN POSTS THAT ARE TO BE REPLACED SHALL BE REMOVED AND SALVAGED ONTO NEW POST.
- ALL EXISTING STREET NAME SIGNS INSTALLED ON STAND ALONE SIGN POSTS SHALL BE RETAINED UNLESS OTHERWISE NOTED.
- AN ESTIMATED NUMBER OF MILE MARKERS AND STREET NAME SIGNS HAS BEEN ADDED TO THE CONTRACT ITEMS 675.50 REMOVING SIGNS AND 675.60 ERECTING SALVAGED SIGNS.
- SELECTIVE CUTTING OF BRUSH OR TREE BRANCHES IN THE IMMEDIATE VICINITY OF THE SIGN MAY BE NECESSARY TO PROVIDE FULL VISIBILITY FOR ANY EXISTING (RETAINED) OR NEW SIGN LOCATIONS. THIS WORK WILL BE PERFORMED AT THE DIRECTION OF THE RESIDENT ENGINEER AND PAID FOR UNDER CONTRACT ITEM 201.31 THINNING AND TRIMMING FOR SIGNS. THIS WORK SHALL BE DONE AT THE SAME TIME AS THE SIGNS ARE INSTALLED.

PROJECT NAME: NORWICH - FAIRLEE

PROJECT NUMBER: STPG SIGN (34)

FILE NAME: IOC334.DGN
PROJECT LEADER: A. GAMBLE
DESIGNED BY: D. CROSSLEY
GENERAL NOTES

PLOT DATE: 03-MAY-2011
DRAWN BY: D. CROSSLEY
CHECKED BY: A. GAMBLE
SHEET 2 OF 65

**STATE OF VERMONT
AGENCY OF TRANSPORTATION**

QUANTITY SHEET 1


[illegible]

PROJECT NAME: NORWICH - FAIRLEE


PROJECT NUMBER: STPG SIGN (34)

FILE NAME: IOC334.QS
PROJECT LEADER: A. GAMBLE
DESIGNED BY: D.CROSSLEY
QUANTITY SHEET


PLOT DATE: 04-MAY-2011
DRAWN BY: D.CROSSLEY
CHECKED BY: A. GAMBLE
SHEET 3 OF 65

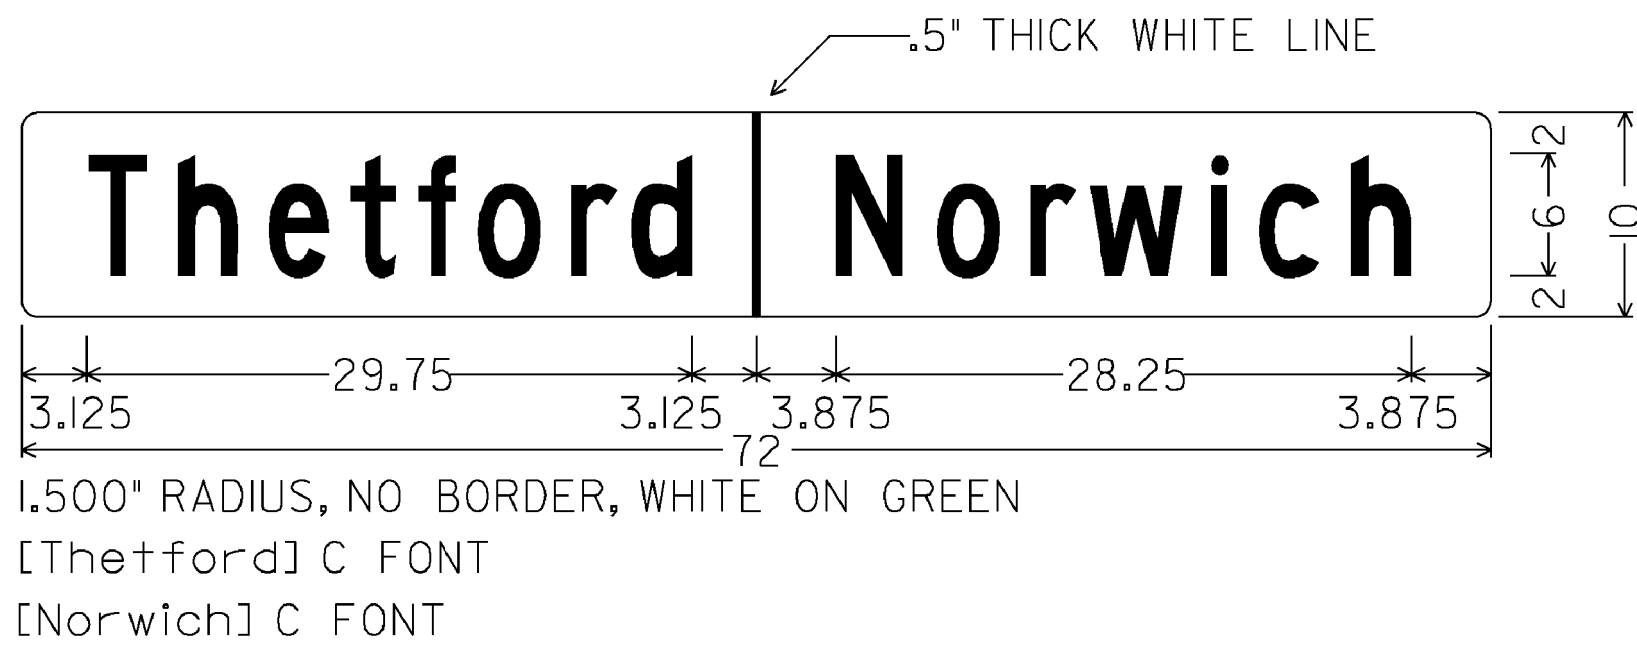



VD-024

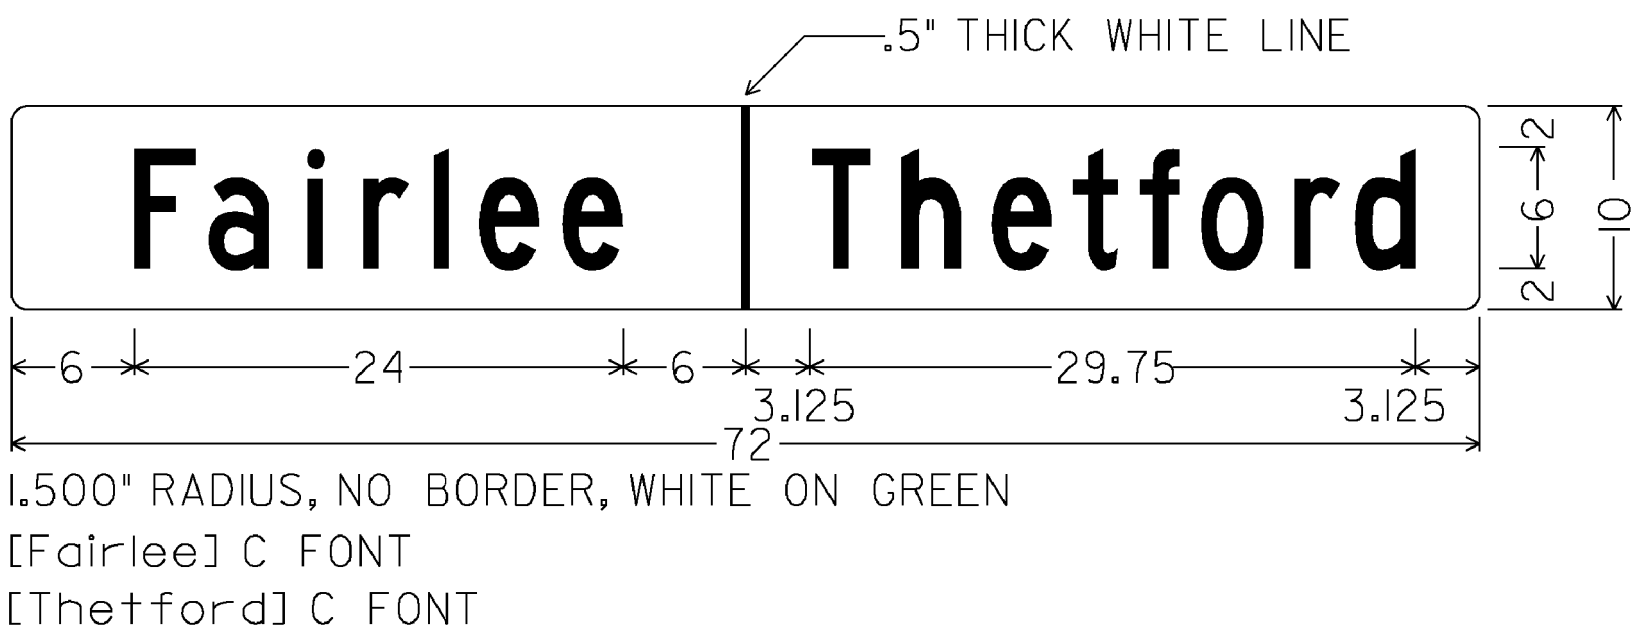

VD-024

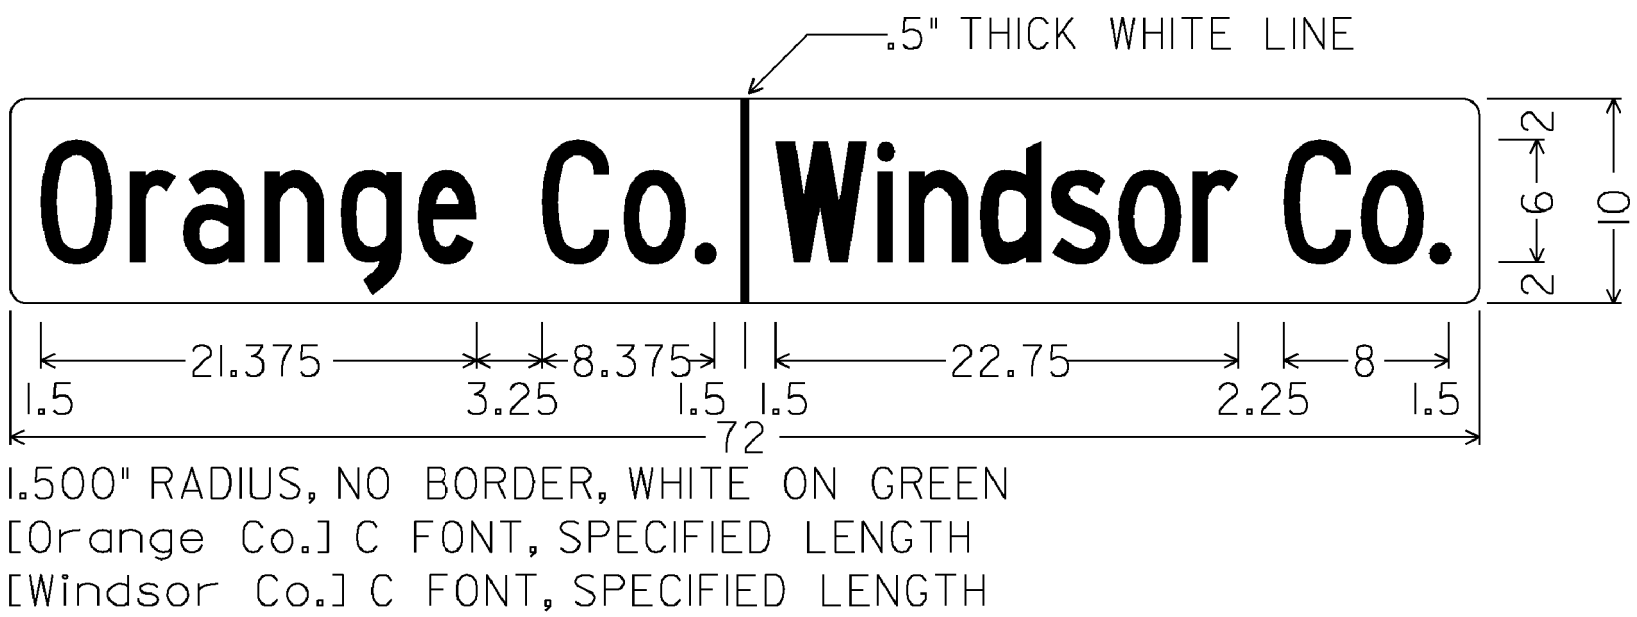

VD-025

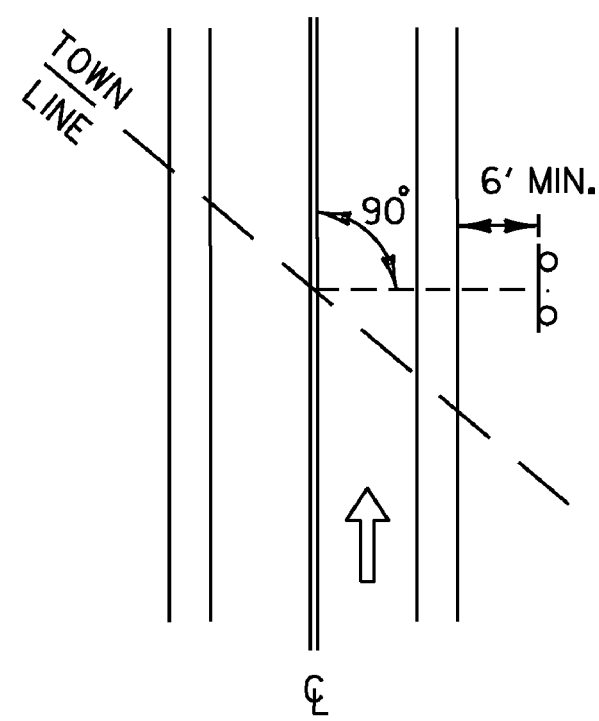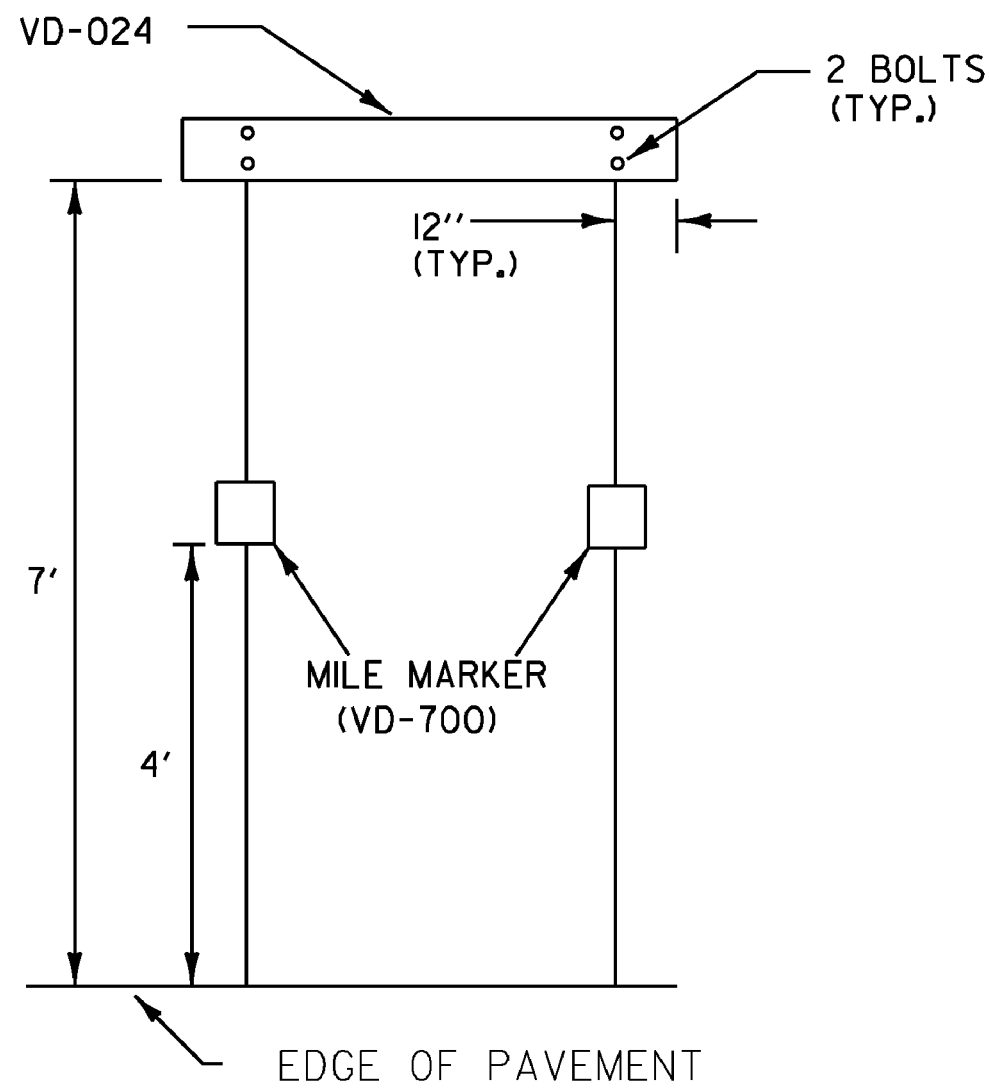

THE SIGN SHALL BE MOUNTED PARALLEL WITH THE ROADWAY, NORMALLY ON RIGHT SIDE TRAVELING WEST TO EAST OR SOUTH TO NORTH.

WHEN CROSSING COUNTY BOUNDARIES AN ADDITIONAL COUNTY LINE SIGN (VD-025) SHALL BE MOUNTED BELOW THE TOWN LINE SIGN (VD-024) MAINTAINING A SEVEN FOOT CLEARANCE.

NOT TO SCALE




* SEE NOTE 2 BELOW:

STANDARD DESTINATION SIGN NOTES VD1-1, VD1-1A, VD2-1

1.) THE DESTINATION SIGNS SHOWN ON THIS SHEET SHALL HAVE WHITE RETROREFLECTIVE ASTM TYPE III OR IV TEXT, ARROWS AND BORDERS ON A GREEN RETROREFLECTIVE ASTM TYPE III OR IV BACKGROUND.


2.) USE THE LARGEST LETTER / THICKEST FONT AVAILABLE THAT WILL SATISFY THE MINIMUM SPACING REQUIREMENTS, AS SHOWN IN THE DETAILS ABOVE; i.e. IF A 6" SERIES C LETTER DOES NOT WORK, DUE TO THE LENGTH OF THE WORD, USE A 6" SERIES B LETTER. IF A 6" SERIES B LETTER DOES NOT WORK, USE A 5" SERIES C. USE NO LESS THAN 80% KERNING.

SEE C.O.D./S.A. #IDATED 4-10-12 FOR MODIFICATION TO THIS DETAIL

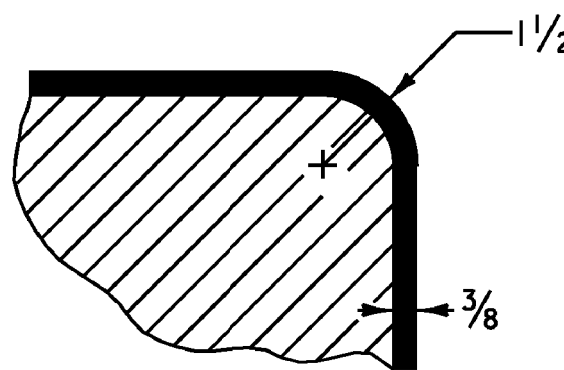


BORDER DETAIL

TRIM CORNERS

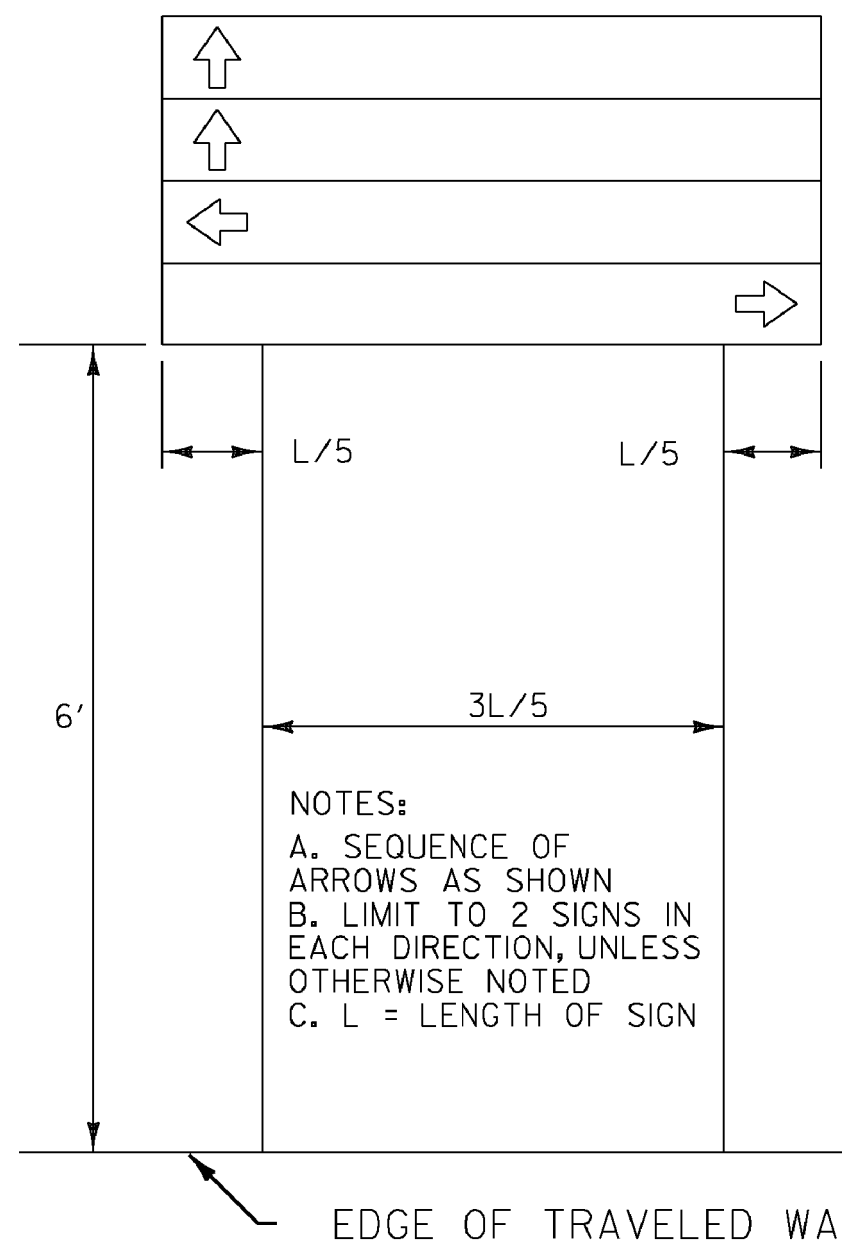

DESTINATION ASSEMBLY

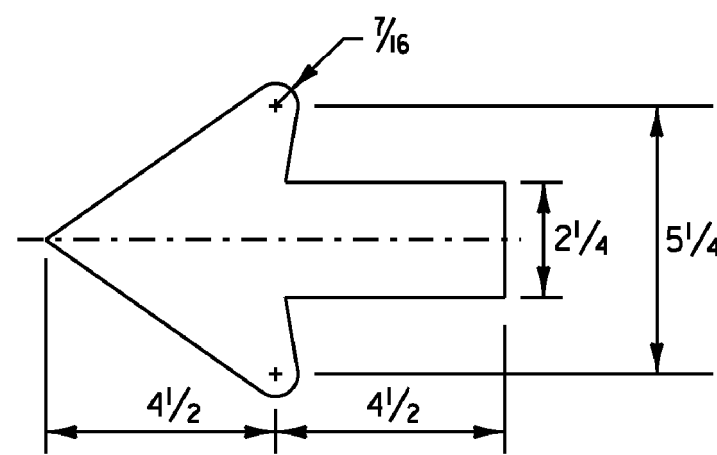

STANDARD SHS 2.25" ARROW

ALL DIMENSIONS SHOWN IN INCHES, EXCEPT WHERE NOTED.

PROJECT NAME: NORWICH - FAIRLEE

PROJECT NUMBER: STPG SIGN (34)

FILE NAME: IOC334.SD.I

PROJECT LEADER: A. GAMBLE

DESIGNED BY: D. CROSSLEY


SIGN DETAILS I

PLOT DATE: 04-MAY-2011

DRAWN BY: D. CROSSLEY


CHECKED BY: A. GAMBLE

SHEET 4 OF 65

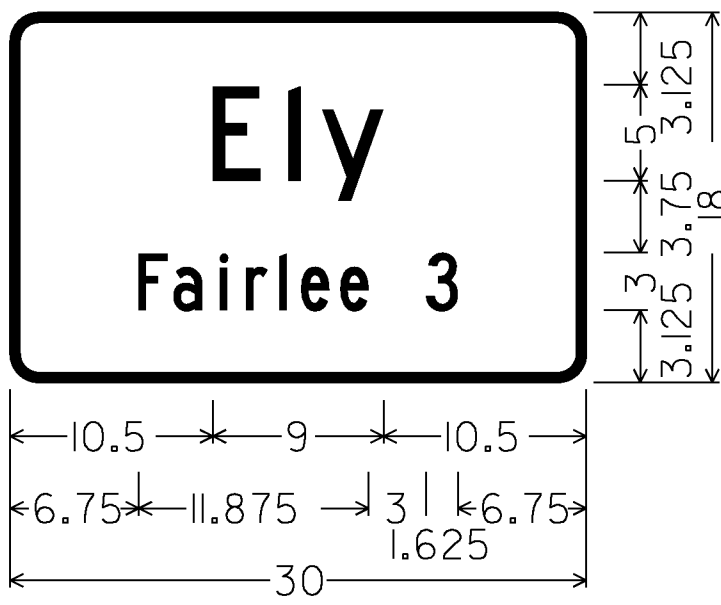


1.500" RADIUS, 0.500" BORDER, WHITE ON GREEN
[Ely] C FONT; [Fairlee 3] C FONT

VD-018

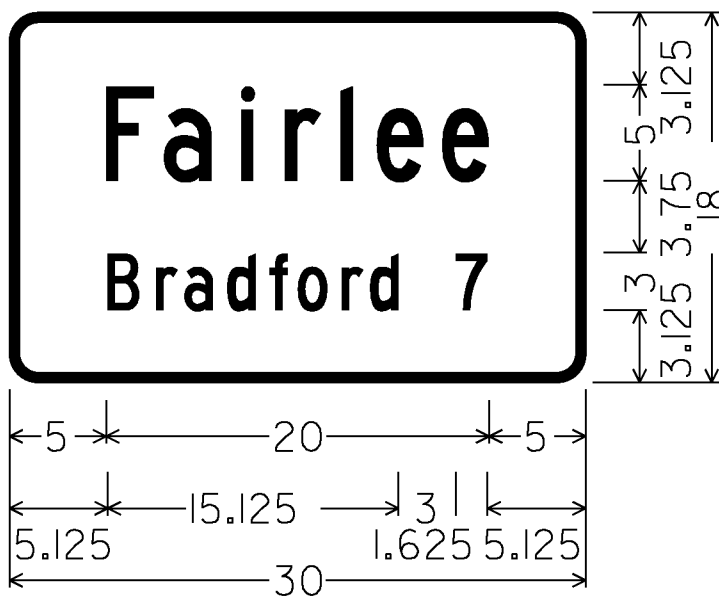


1.500" RADIUS, 0.500" BORDER, WHITE ON GREEN
[Fairlee] C FONT; [Bradford 7] C FONT

VD-018

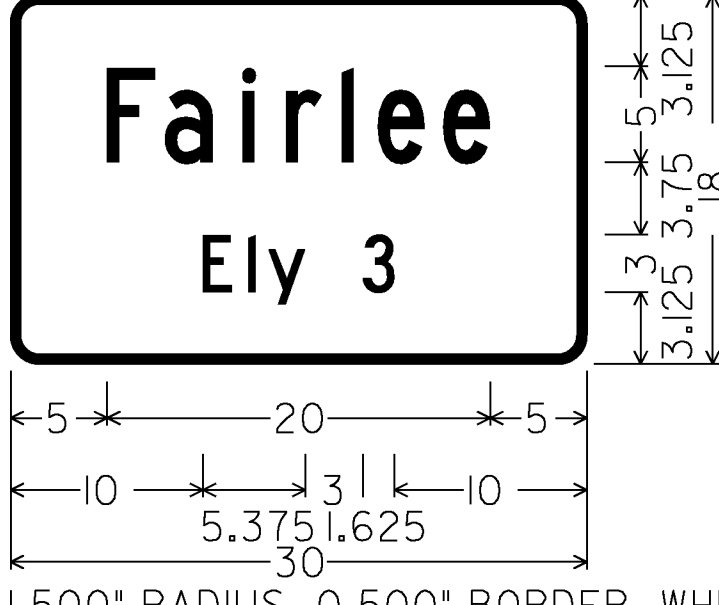


1.500" RADIUS, 0.500" BORDER, WHITE ON GREEN
[Fairlee] C FONT; [Ely 3] C FONT

VD-018

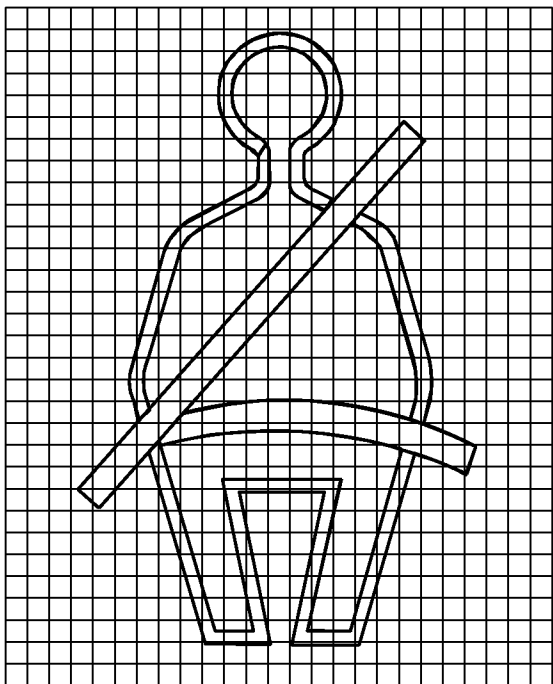


1 SQUARE = 1"

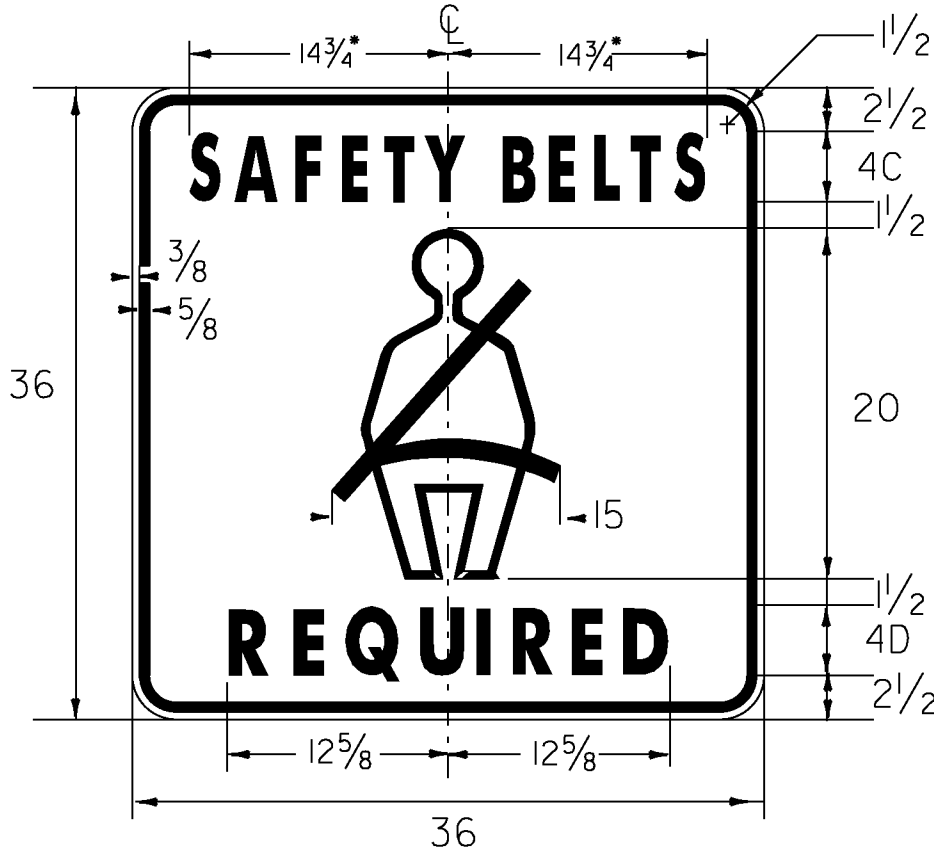


VR-601

•REDUCE SPACING 50%
BLACK ON WHITE

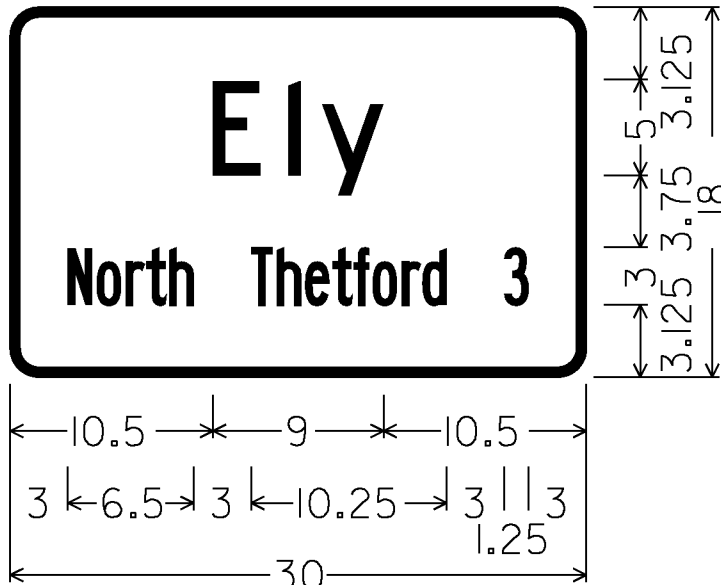


1.500" RADIUS, 0.500" BORDER, WHITE ON GREEN
[Ely] C FONT
[North Thetford 3] B FONT, SPECIFIED LENGHT

VD-018

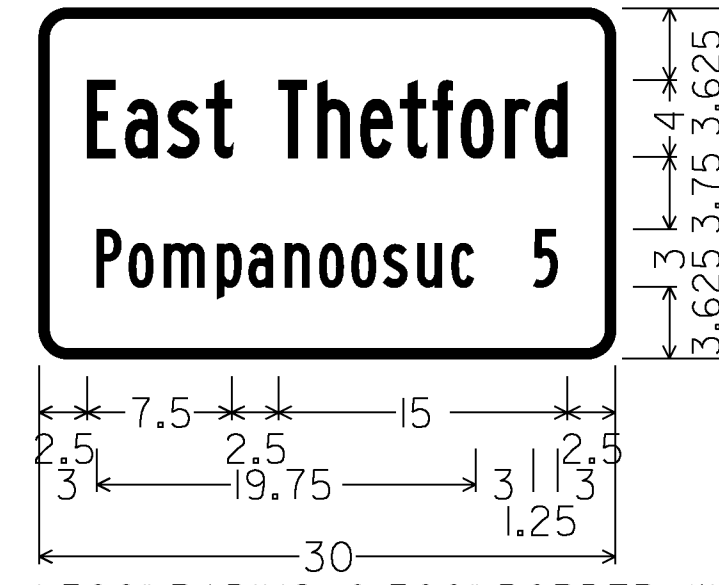


1.500" RADIUS, 0.500" BORDER, WHITE ON GREEN
[East Thetford] B FONT, SPECIFIED LENGTH
[Pompanoosuc 5] B FONT, SPECIFIED LENGHT

VD-018

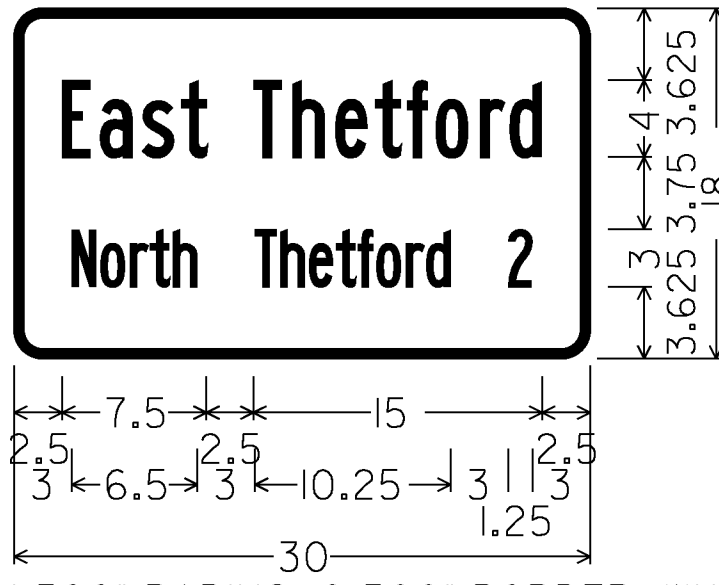


1.500" RADIUS, 0.500" BORDER, WHITE ON GREEN
[East Thetford] B FONT, SPECIFIED LENGHT
[North Thetford 2] BFONT, SPECIFIED LENGHT

VD-018

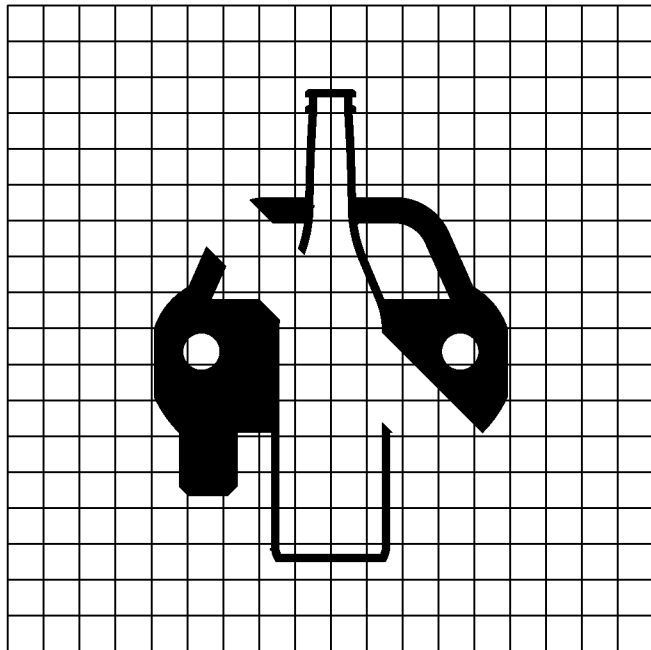


1 SQUARE = 1"

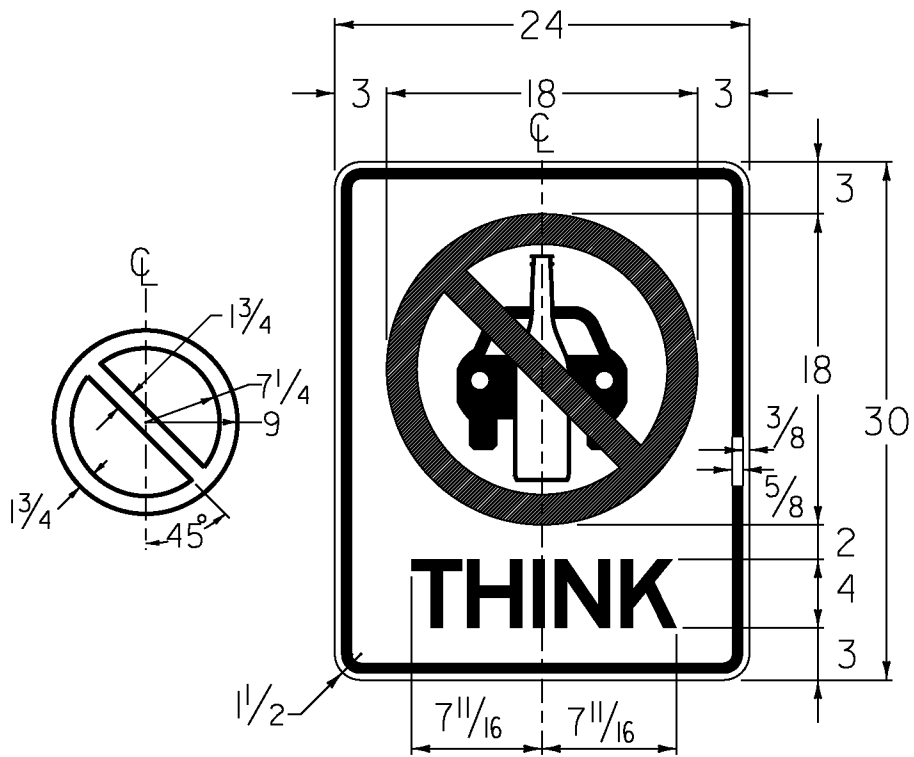


VR-072

TEXT - E FONT - BLACK (NON-REFL.)
CAR & BOTTLE SYMBOL - BLACK (NON-REFL.)
PROHIBITED SYMBOL - RED (NON-REFL.)
BACKGROUND - WHITE (REFL.)

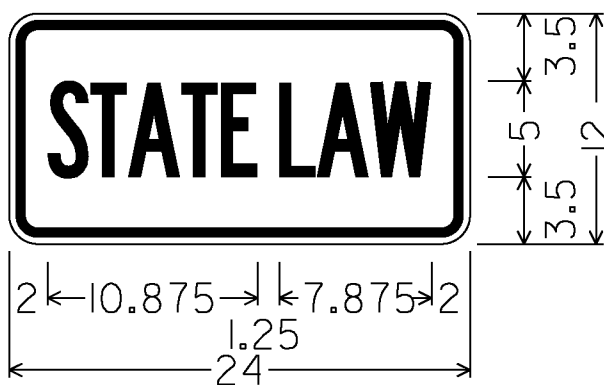

1.500" RADIUS, 0.500" BORDER, 0.375" INDENT
BLACK ON FLUORESCENT YELLOW;
[STATE LAW] B FONT, SPECIFIED LENGHT

W16-18P

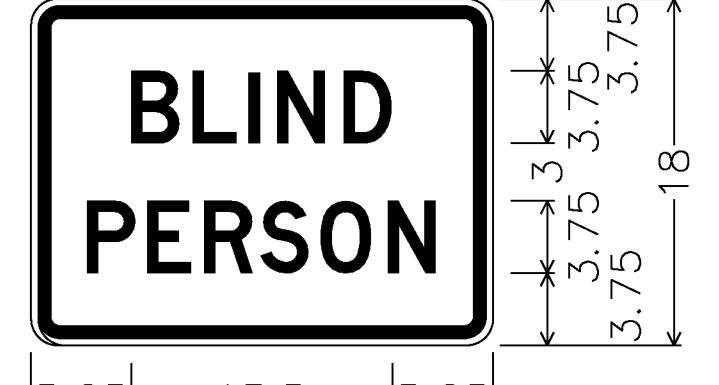


1.500" RADIUS, 0.625" BORDER, 0.375" INDENT,
BLACK ON FLUORESCENT YELLOW-GREEN;
[BLIND] D FONT;
[PERSON] D FONT;

VW-207P




1.500" RADIUS, 0.625" BORDER, 0.375" INDENT,
BLACK ON WHITE;
[NO] C FONT; [PASSING] C FONT;
[ON] C FONT; [RIGHT] C FONT;

VR-183

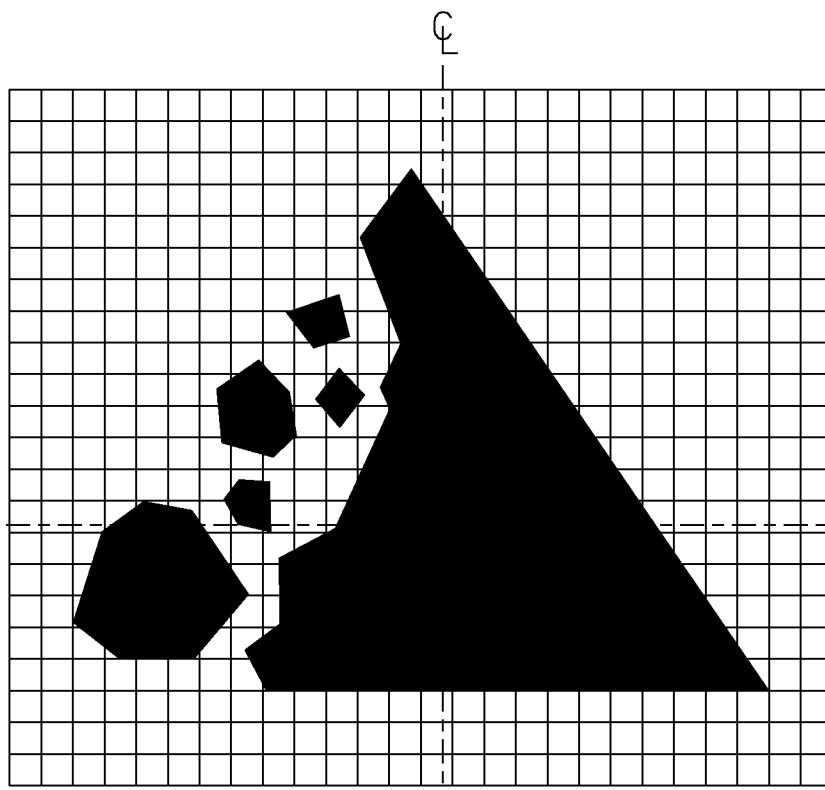

1 SQUARE = 1"

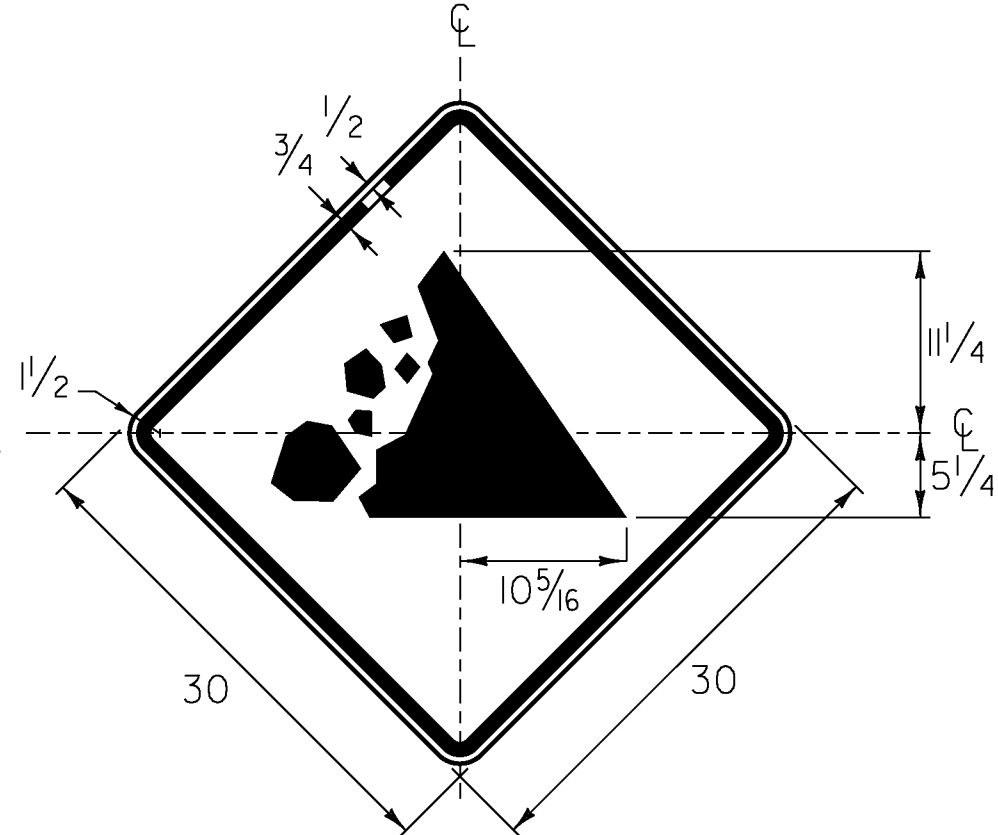

VW-285

SYMBOL AND BORDER - BLACK (NON-REFL.)
BACKGROUND - YELLOW (REFL.)

ALL DIMENSIONS SHOWN IN INCHES, EXCEPT WHERE NOTED.


PROJECT NAME: NORWICH - FAIRLEE

PROJECT NUMBER: STPG SIGN (34)

FILE NAME: IOC334.SD2
PROJECT LEADER: A. GAMBLE
DESIGNED BY: D.CROSSLEY
SIGN DETAILS 2

PLOT DATE: 04-MAY-2011
DRAWN BY: D.CROSSLEY
CHECKED BY: A. GAMBLE
SHEET 5 OF 65


ROUTE MARKER ASSEMBLY FRAMES

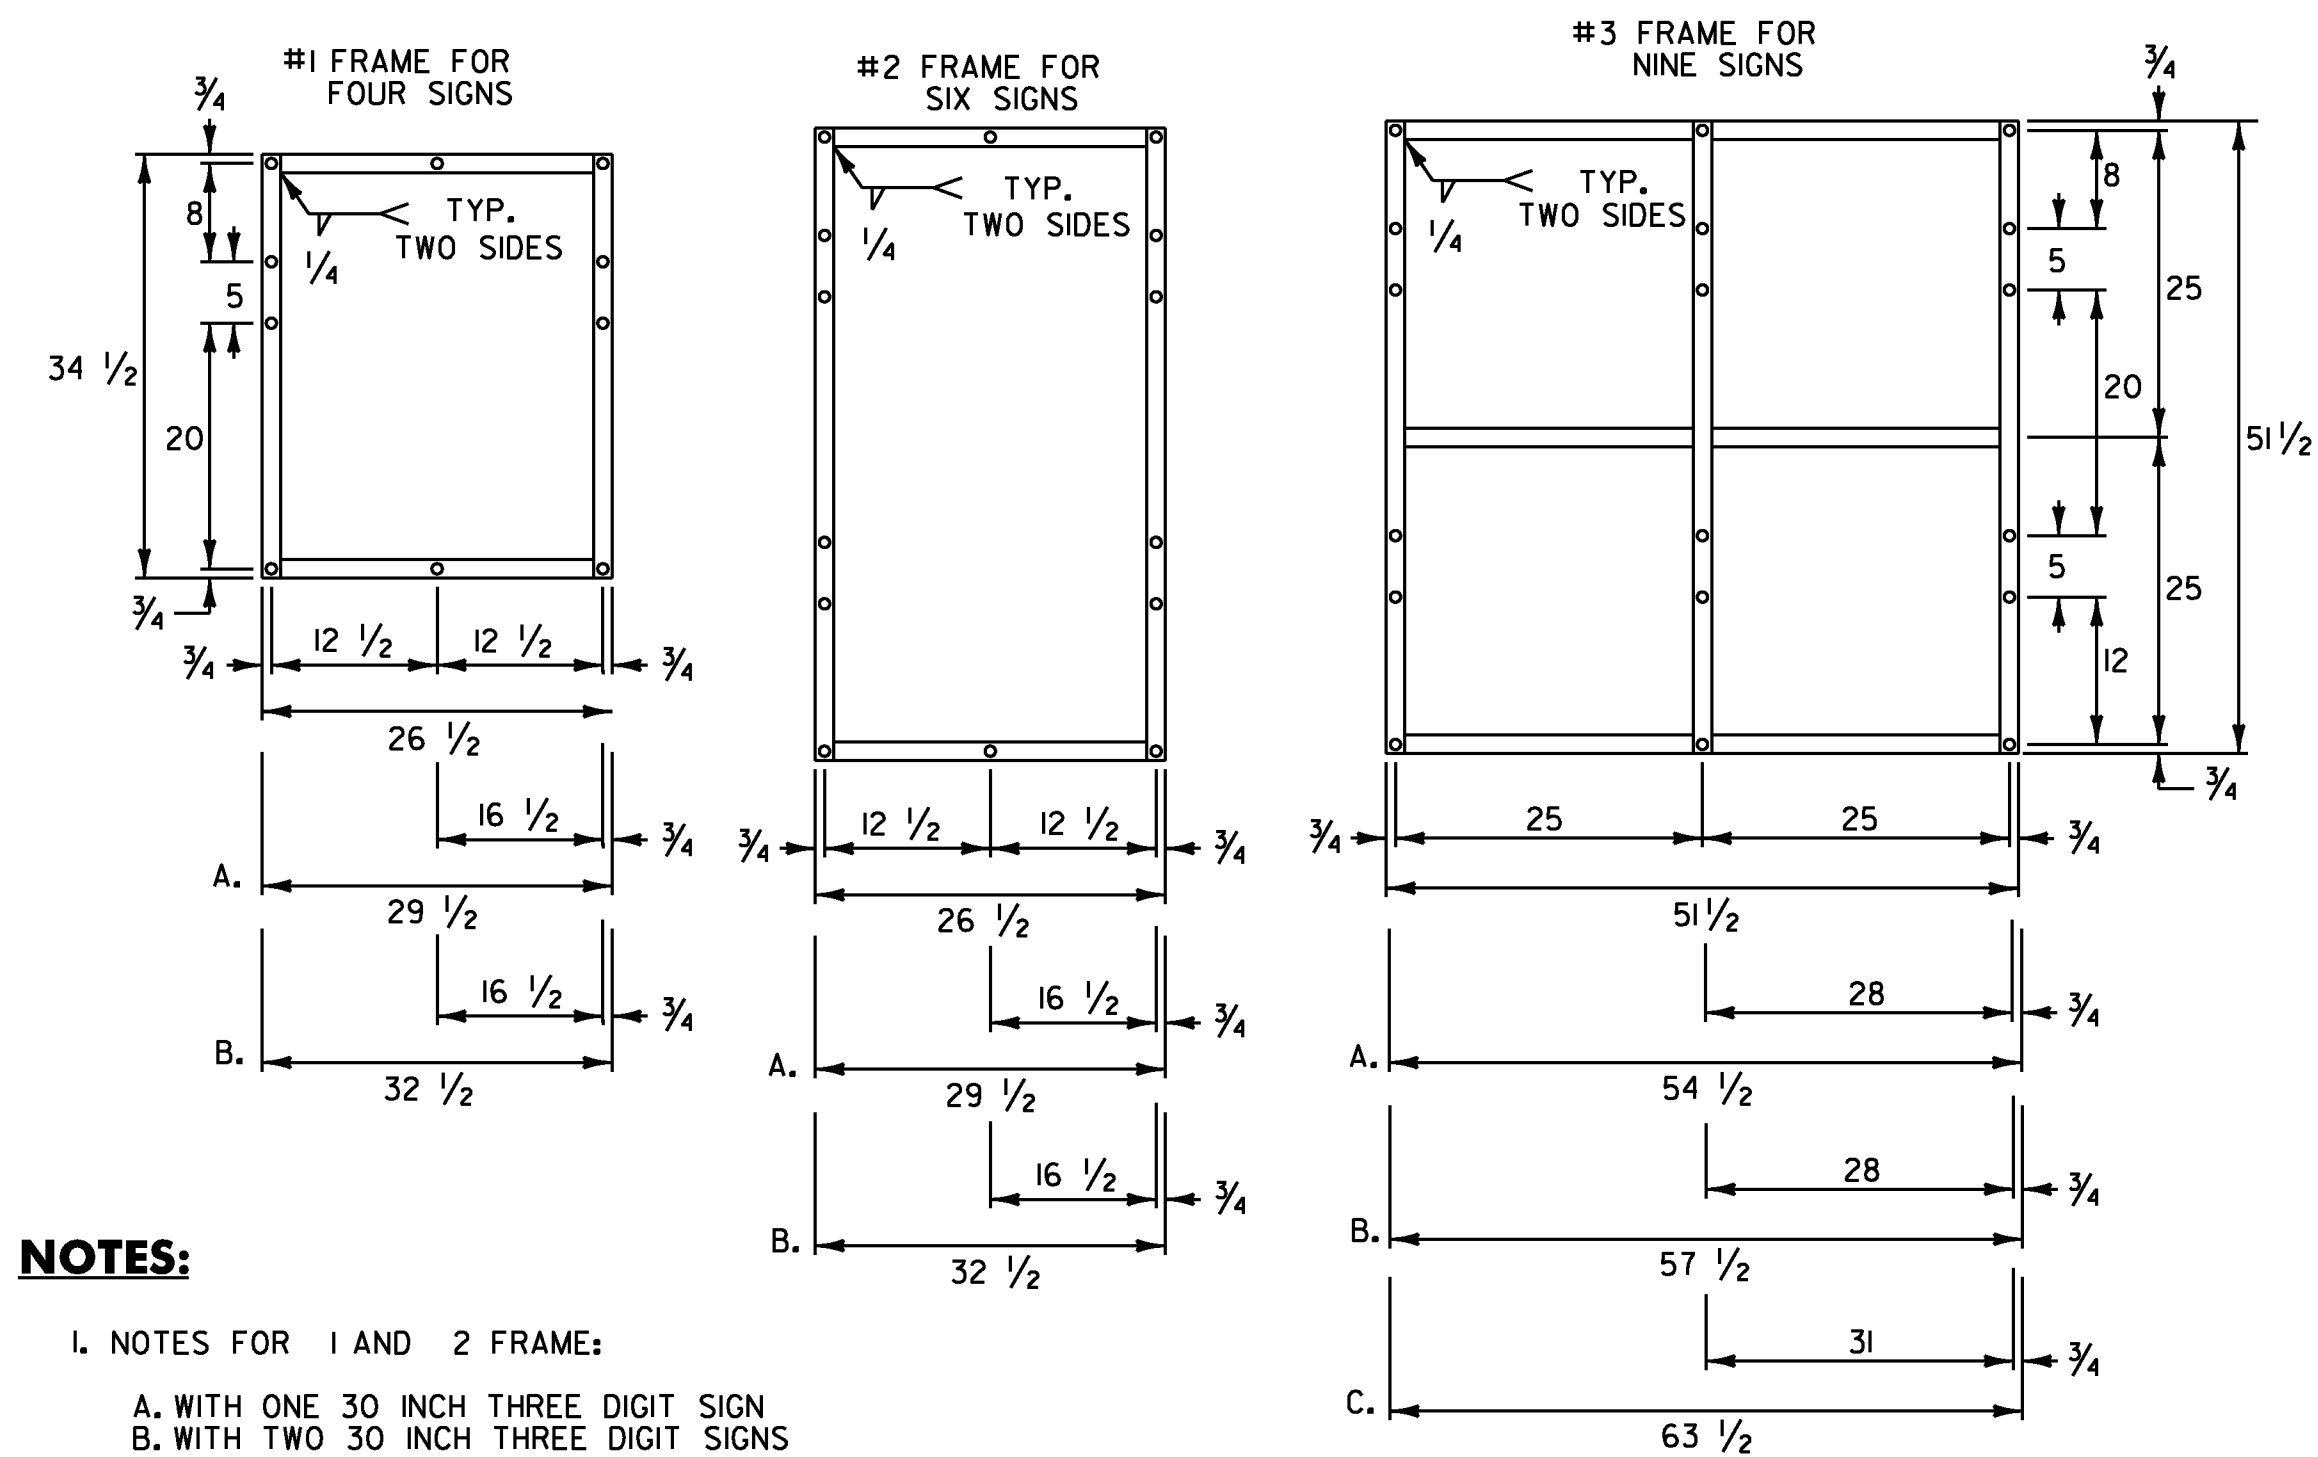

NOTES:

1. NOTES FOR 1 AND 2 FRAME:
- A. WITH ONE 30 INCH THREE DIGIT SIGN
 - B. WITH TWO 30 INCH THREE DIGIT SIGNS
2. NOTES FOR 3 FRAME:
- A. WITH ONE 30 INCH THREE DIGIT SIGN IN AN OUTSIDE POSITION.
 - B. WITH ONE 30 INCH THREE DIGIT SIGN IN THE CENTER POSITION OR TWO SUCH SIGNS IN THE OUTSIDE POSITIONS.
 - C. WITH THREE 30 INCH THREE DIGIT SIGNS.
3. ALL HOLES SHALL BE 7/16 INCH DIAMETER. FOR OTHER SIGN COMBINATIONS THAN ABOVE, THE FRAME DIMENSIONS AND HOLE SPACING SHALL BE MODIFIED AS NECESSARY. THE FRAME SHALL BE PAINTED WITH ONE COAT OF PRIMER AND A SECOND COAT OF BLACK PAINT. THE PAINT SHALL BE OF THE TYPE USED ON EXTERIOR METAL SURFACES TO PREVENT METAL CORROSION.
4. STANDARD FRAMES SHALL BE 5/16 INCH x 1 1/2 INCH WELDED A-36 STEEL.

STANDARD MOUNTING OF ROUTE MARKER ASSEMBLIES

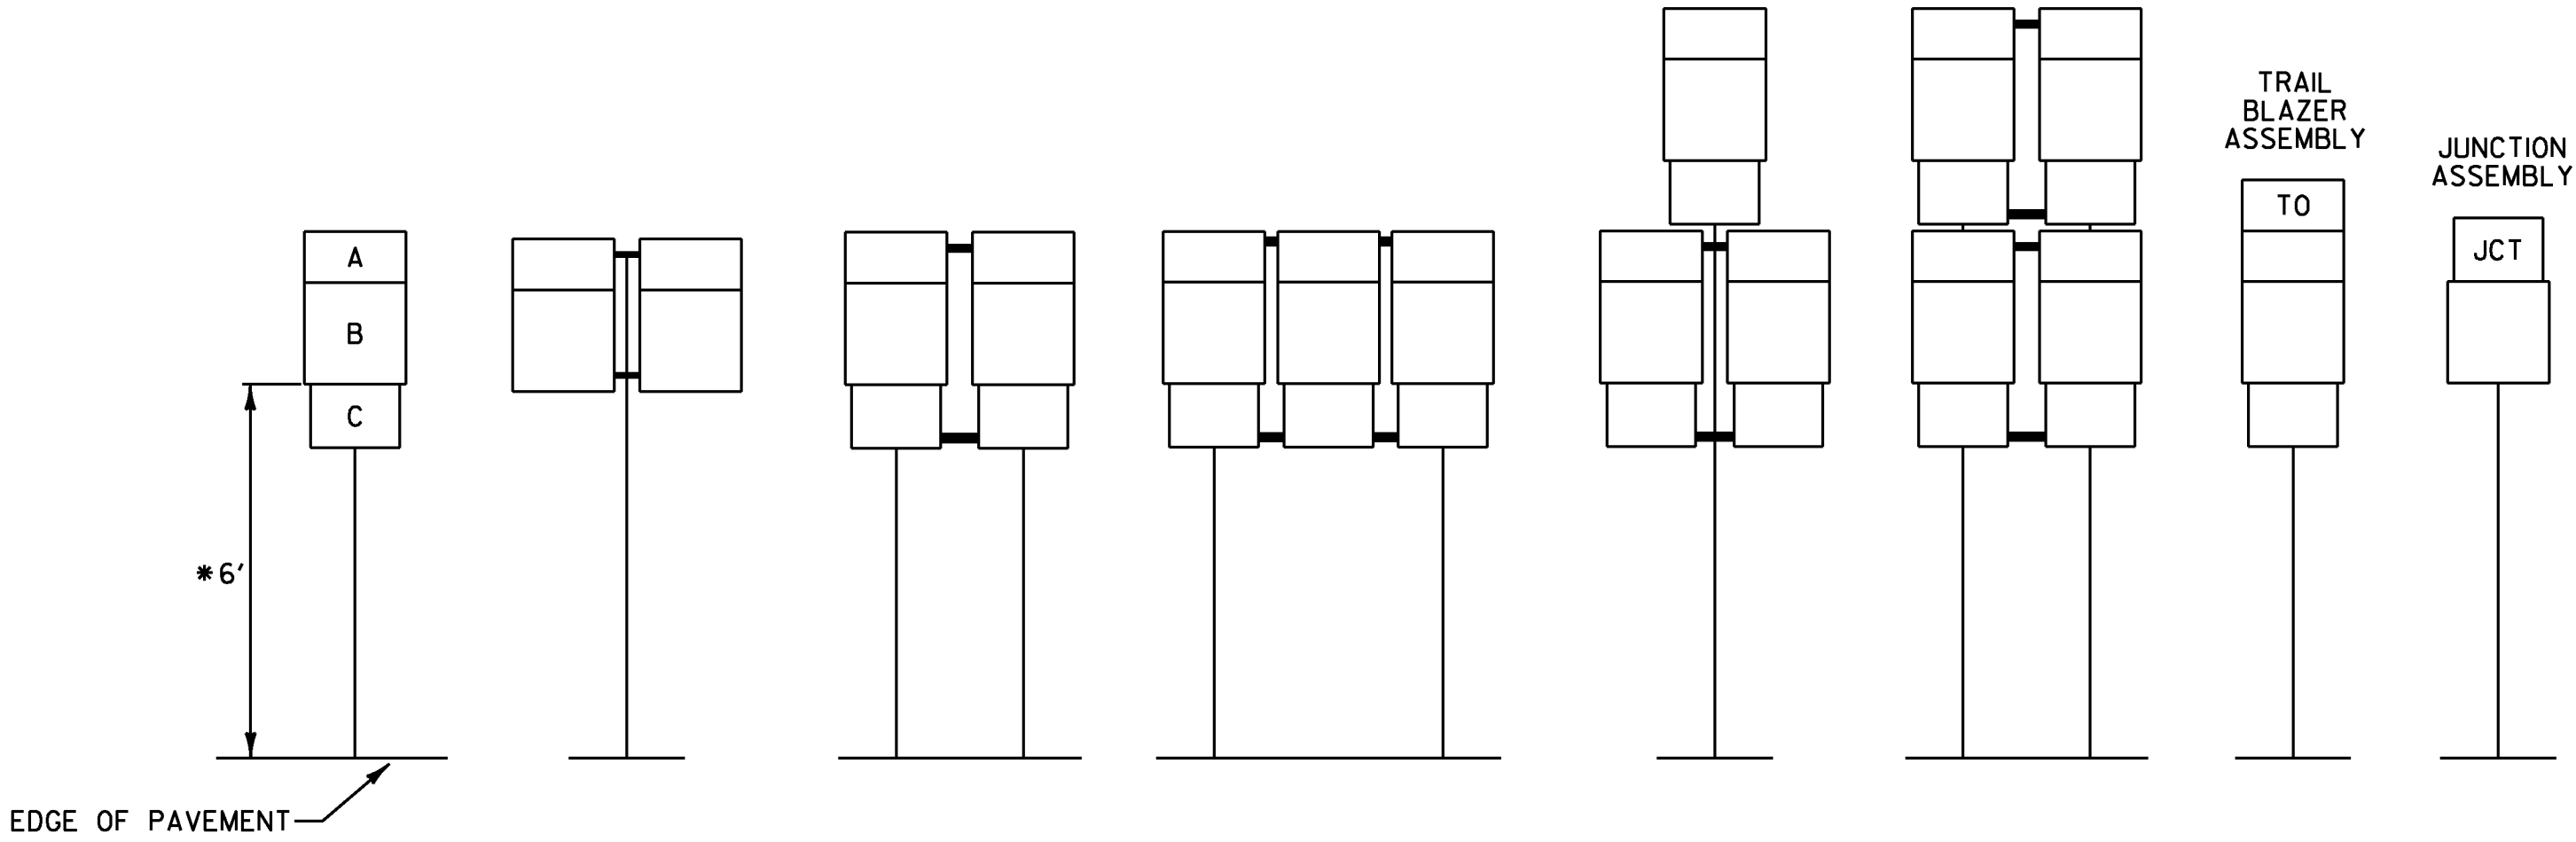

- A - CARDINAL DIRECTION MARKER
B - ROUTE NUMBER
C - ADVANCE TURN ARROW OR DIRECTIONAL ARROW

* WHERE PARKING OR PEDESTRIAN TRAFFIC WILL OCCUR IN THE IMMEDIATE VICINITY OF THESE SIGNS MINIMUM VERTICAL CLEARANCE SHALL BE INCREASED TO SEVEN FEET

NOTE:
VERTICAL FRAME MEMBERS SHALL LINE UP WITH SIGN POST ON WHICH THEY ARE MOUNTED.

INSTALLATION SEQUENCE:
IN MULTIPLE HORIZONTAL MOUNTINGS PLACE A ROUTE MARKER ASSEMBLY INDICATING A LEFT TURN ON THE LEFT SIDE OF THE ASSEMBLY; RIGHT TURN ON THE RIGHT SIDE. FOR VERTICALLY STACKED MOUNTINGS PLACE THE STRAIGHT THROUGH MOVE INDICATION ON TOP, THE LEFT OR RIGHT TURNS AS APPROPRIATE BENEATH.

ALL DIMENSIONS SHOWN IN INCHES, UNLESS OTHERWISE NOTED.

PROJECT NAME: NORWICH - FAIRLEE

PROJECT NUMBER: STPG SIGN (34)

FILE NAME: IOC332.SD4
PROJECT LEADER: A. GAMBLE
DESIGNED BY: D. CROSSLEY
SIGN DETAILS 3


PLOT DATE: 04-MAY-2011
DRAWN BY: D. CROSSLEY
CHECKED BY: A. GAMBLE
SHEET 6 OF 65

THIS PAGE INTENTIONALLY LEFT BLANK

DIRECTION	MILEPOINT	LOCATION CODE (SHEET 2)	SIGN CODE	WIDTH (IN)	HEIGHT (IN)	SHEETING REMARKS	SIGN LEGEND	NEW SIGNS		EXISTING SIGNS				EXIST POST		NUMBER OF NEW SQUARE STEEL POSTS	SQUARE STEEL (IN)			TUBULAR STEEL Ø (IN)					SIGN FRAME REQUIRED	REMARKS	SIGN DETAIL LOCATIONS		
								"A"	"B"	RETAIN	SALVAGE FROM	SALVAGE TO	REMOVE	RETAIN	REMOVE		1.75	2.00	2.50	FOUNDATION	3.00	3.50	4.00	5.00			SHSM	PROJECT SHEET #	STANDARD SHEET #
																	(LB / FT)				(LB / FT)								
																	1.88	2.42	3.35		7.60	9.00	10.80	14.60					
NORWICH US 5 NB							FY-FLUORESCENT YELLOW FYG-FLUORESCENT YELLOW GREEN																"SHSM"-STANDARD HIGHWAY SIGNS AND MARKINGS						
NB	2.462	A	M3-1	24	12		NORTH	2.00		4			I	X										OLD SIGN WAS DAMAGED. CONTRACTOR INSTALLED A NEW SIGN.					
		A	M1-4	24	24		US 5			1																			
NB	2.480	A	R2-1	24	30								1		X														
		A	R2-1	24	30			5.00							1		X								X				
NB	2.592	A	VW-285	30	30		FALLING ROCK			1				X															
NB	2.670	A	R2-1	24	30								1		X														
		A	W16-18P	24	12	FY		2.00								1		X								5			
		A	R2-1	24	30			5.00																	X				
		A	R2-5P	24	18			3.00																	X				
NB	2.880	A	VR-114F	48	60		SL 50 UNLESS OTHERWISE POSTED						1		X														
NB	2.980	A	VD-062AL	72	16		BUSINESS SIGN			1				X															
NB	3.420	A	VW-285	30	30								1		X														
		A	VW-285	30	30			6.25								1		X								5			
NB	3.760	A	VW-054	30	30								1		X														
		A	VW-054	30	30			6.25								1		X								E-154			
SIGN SUMMARY SHEET							SHEET TOTALS	29.50 27.50	0.00	4	0	0	6 5	0	0	4		60		0	0.0	0.0	0.0	0.0	PROJECT NAME: NORWICH - FAIRLEE				
								SF	SF	EA	EA	EA	EA	EA	EA	EA		FT		EA	LB	LB	LB	LB	PROJECT NUMBER: STPG SIGN (34)				
																									FILE NAME: 10C334			PLOT DATE: 5/2/2011	
							VERMONT AGENCY OF TRANSPORTATION																			PROJECT MANAGER: A.GAMBLE			DRAWN BY: D.CROSSLEY
							TOWN DIRECTIONAL TOTALS	128.2	0.0	6.0	0.0	0.0	31	0.0	0.0	16		240.0		0		0.0		DESIGNED BY: D.CROSSLEY			CHECKED BY: QAU		
																							NORWICH U.S. 5 NORTHBOUND 1			SHEET 8 OF 65			

DIRECTION	MILEPOINT	LOCATION CODE (SHEET 2)	SIGN CODE	WIDTH (IN)	HEIGHT (IN)	SHEETING REMARKS	SIGN LEGEND	NEW SIGNS		EXISTING SIGNS				EXIST POST		NUMBER OF NEW SQUARE STEEL POSTS	SQUARE STEEL (IN)			TUBULAR STEEL Ø (IN)				SIGN FRAME REQUIRED	REMARKS	SIGN DETAIL LOCATIONS				
								"A"	"B"	RETAIN	SALVAGE FROM	SALVAGE TO	REMOVE	RETAIN	REMOVE		1.75	2.00	2.50	FOUNDATION	3.00	3.50	4.00			5.00	SHSM	PROJECT SHEET #	STANDARD SHEET #	
																	(LB / FT)				(LB / FT)									
																	1.88	2.42	3.35		7.60	9.00	10.80			14.60				
NORWICH US 5 NB																						"SHSM"-STANDARD HIGHWAY SIGNS AND MARKINGS								
NB	4.220	A	N/A	24	30					1				X																
NB	5.720	A	W11-10	30	30								1		X															
		A	W16-2	24	18								1																	
		A	W11-10	30	30			6.25								1		X								X				
		A	W16-2P	24	18			3.00																		X				
NB	6.120	A	W1-2L	30	30								1		X															
NB	6.150	A	W1-2L	30	30			6.25								1		X								INSTALL 160' NORTH OF ORIGINAL SIGN LOCATION	X			
NB	6.600	A	M2-1	21	15								1		X															
		A	M1-5	30	24								1																	
		A	M2-1	21	15			2.19								1 2		X								BLACK ON WHITE	X			
		A	M1-6	30	24		0050 1411 0660	5.00			I	I	I															E-136C		
NB	6.670	C	VR-017	24	30		LLL 24,000 LBS			1				X												KENDALL STATION RD TH-69				
NB	6.678	D	R1-1	30	30								1		X											KENDALL STATION RD TH-69 WITH MILE MARKER				
		D	R1-1	30	30			6.25			I	I	I			1		X								X				
NB	6.710	A	VD1-1A	72	10		D-BOARD AND ROUTE MARKER ASSEMBLY						1		X															
SIGN SUMMARY SHEET							SHEET TOTALS		28.94	0.00	2	2 0	2 0	9 7	0	0	5	75		0	0.0	0.0	0.0	0.0	PROJECT NAME: NORWICH - FAIRLEE					
									SF	SF	EA	EA	EA	EA	EA	EA	EA	FT		EA	LB	LB	LB	LB	PROJECT NUMBER: STPG SIGN (34)					
																								FILE NAME: 10C334			PLOT DATE: 5/2/2011			
							VERMONT AGENCY OF TRANSPORTATION																	PROJECT MANAGER: A.GAMBLE			DRAWN BY: D.CROSSLEY			
							TOWN DIRECTIONAL TOTALS		128.2	0.0	6.0	0.0	0.0	31	0.0	0.0	16	240.0		0	0.0				DESIGNED BY: D.CROSSLEY			CHECKED BY: QAU		
																							NORWICH U.S. 5 NORTHBOUND 2			SHEET 9 OF 65				

DIRECTION	MILEPOINT	LOCATION CODE (SHEET 2)	SIGN CODE	WIDTH (IN)	HEIGHT (IN)	SHEETING REMARKS	SIGN LEGEND	NEW SIGNS		EXISTING SIGNS				EXIST POST		NUMBER OF NEW SQUARE STEEL POSTS	SQUARE STEEL (IN)			TUBULAR STEEL Ø (IN)				SIGN FRAME REQUIRED	REMARKS	SIGN DETAIL LOCATIONS			
								"A"	"B"	RETAIN	SALVAGE FROM	SALVAGE TO	REMOVE	RETAIN	REMOVE		1.75	2.00	2.50	FOUNDATION	3.00	3.50	4.00			5.00	SHSM	PROJECT SHEET #	STANDARD SHEET #
																	(LB / FT)				(LB / FT)								
																	1.88	2.42	3.35		7.60	9.00	10.80			14.60			
NORWICH US 5 NB							FY-FLUORESCENT YELLOW FYG-FLUORESCENT YELLOW GREEN															"SHSM"-STANDARD HIGHWAY SIGNS AND MARKINGS							
		A	VD1-1A	72	10								1																
		A	M3-4	24	12								1																
		A	M1-6	30	24								1																
		A	M6-1	21	15								1																
		A	M3-1	24	12								1																
		A	M1-4	24	24								1																
		A	M6-3	21	15								1																
		A	VD1-1A	72	12			6.00						2		X										4			
		A	VD1-1A	72	12			6.00																		4			
		A	M3-4	24	12			2.00															BLACK ON WHITE	X					
		A	M1-6	30	24		↑ East Thetford 5 ← S. Strafford 11	5.00																			E-136C		
		A	M6-1	21	15		WEST NORTH	2.19																BLACK ON WHITE	X				
		A	M3-1	24	12		132 5	2.00																BLACK ON WHITE	X				
		A	M1-4	24	24		← ↑	4.00																	X				
		A	M6-3	21	15			2.19															BLACK ON WHITE	X					
SIGN SUMMARY SHEET							SHEET TOTALS		29.38	0.00	0	0	0	7	0	0	2	30			0	0.0	0.0	0.0	0.0	PROJECT NAME: NORWICH - FAIRLEE			
									SF	SF	EA	EA	EA	EA	EA	EA	EA		FT		EA	LB	LB	LB	LB	PROJECT NUMBER: STPG SIGN (34)			
																										FILE NAME: 10C334			
							VERMONT AGENCY OF TRANSPORTATION																				PROJECT MANAGER: A.GAMBLE		
							TOWN DIRECTIONAL TOTALS		128.2	0.0	6.0	0.0	0.0	31	0.0	0.0	16	240.0			0		0.0			DESIGNED BY: D.CROSSLEY			
																								PLOT DATE: 5/2/2011					
																								DRAWN BY: D.CROSSLEY					
																								CHECKED BY: QAU					
																								NORWICH U.S. 5 NORTHBOUND 3					
																								SHEET 10 OF 65					

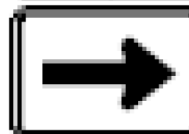DIRECTION	MILEPOINT	LOCATION CODE (SHEET 2)	SIGN CODE	WIDTH (IN)	HEIGHT (IN)	SHEETING REMARKS	SIGN LEGEND	NEW SIGNS		EXISTING SIGNS				EXIST POST		NUMBER OF NEW SQUARE STEEL POSTS	SQUARE STEEL (IN)			TUBULAR STEEL Ø (IN)				SIGN FRAME REQUIRED	REMARKS	SIGN DETAIL LOCATIONS										
								"A"	"B"	RETAIN	SALVAGE FROM	SALVAGE TO	REMOVE	RETAIN	REMOVE		1.75	2.00	2.50	FOUNDATION	3.00	3.50	4.00			5.00	SHSM	PROJECT SHEET #	STANDARD SHEET #							
																														(LB / FT)			(LB / FT)			
																														1.88	2.42	3.35	7.60	9.00	10.80	14.60
NORWICH US 5 NB							FY-FLUORESCENT YELLOW FYG-FLUORESCENT YELLOW GREEN															"SHSM"-STANDARD HIGHWAY SIGNS AND MARKINGS														
NB	6.730	C	W1-7	48	24								1		X																					
		C	W1-7	48	24			8.00								2		X								X										
NB	6.733	C	VD1-1A	72	10		D-BOARD AND ROUTE MARKER ASSEMBLY						1		X																					
		C	VD1-1A	72	10								1																							
		C	M3-1	24	12								1																							
		C	M1-4	24	24								1																							
		C	M6-1	21	15								1																							
		C	M3-3	24	12								1																							
		C	M1-4	24	24								1																							
		C	M6-1	21	15								1																							
		C	VD1-1A	72	12			6.00								2		X							ORDER REVISED		4									
		C	VD1-1A	72	12			6.00																		4										
		C	M3-3	24	12		 	2.00																	BLACK ON WHITE	X										
		C	M1-4	24	24		 	4.00																		X										
		C	M6-1	21	15		 	2.19																	BLACK ON WHITE	X										
SIGN SUMMARY SHEET							SHEET TOTALS	28.19	0.00	0	0	0	9	0	0	4	60			0	0.0	0.0	0.0	0.0	PROJECT NAME: NORWICH - FAIRLEE											
								SF	SF	EA	EA	EA	EA	EA	EA	EA	FT			EA	LB	LB	LB	LB	PROJECT NUMBER: STPG SIGN (34)											
																						FILE NAME: 10C334														
																						PROJECT MANAGER: A.GAMBLE														
VERMONT AGENCY OF TRANSPORTATION							TOWN DIRECTIONAL TOTALS	128.2	0.0	6.0	0.0	0.0	31	0.0	0.0	16	240.0			0	0.0			DESIGNED BY: D.CROSSLEY												
																						NORWICH U.S. 5 NORTHBOUND 4														
																								PLOT DATE: 5/2/2011												
																								DRAWN BY: D.CROSSLEY												
																								CHECKED BY: QAU												
																								SHEET 11 OF 65												

DIRECTION	MILEPOINT	LOCATION CODE (SHEET 2)	SIGN CODE	WIDTH (IN)	HEIGHT (IN)	SHEETING REMARKS	SIGN LEGEND	NEW SIGNS		EXISTING SIGNS				EXIST POST		NUMBER OF NEW SQUARE STEEL POSTS	SQUARE STEEL (IN)			TUBULAR STEEL Ø (IN)				SIGN FRAME REQUIRED	REMARKS	SIGN DETAIL LOCATIONS			
								"A"	"B"	RETAIN	SALVAGE FROM	SALVAGE TO	REMOVE	RETAIN	REMOVE		1.75	2.00	2.50	FOUNDATION	3.00	3.50	4.00			5.00	SHSM	PROJECT SHEET #	STANDARD SHEET #
																	(LB / FT)				(LB / FT)								
																	1.88	2.42	3.35		7.60	9.00	10.80			14.60			
NORWICH US 5 NB							FY-FLUORESCENT YELLOW FYG-FLUORESCENT YELLOW GREEN															"SHSM"-STANDARD HIGHWAY SIGNS AND MARKINGS							
		C	M3-1	24	12			2.00															BLACK ON WHITE	X					
		C	M1-4	24	24			4.00 5.00																X					
		C	M6-1	21	15			2.19															BLACK ON WHITE	X					
NB	6.800	A	M3-1	24	12		NORTH						2 1		X								REMOVE MILE MARKER						
		A	M1-4	24	24		ROUTE 5						1																
NB	6.852	A	R2-1	24	30								1		X														
		A	R2-1	24	30			5.00								1		X						X					
SIGN SUMMARY SHEET							SHEET TOTALS	13.19 14.19	0.00	0	0	0	4 3	0	0	1	15		0	0.0	0.0	0.0	0.0	PROJECT NAME: NORWICH - FAIRLEE					
								SF	SF	EA	EA	EA	EA	EA	EA	EA	FT		EA	LB	LB	LB	LB	PROJECT NUMBER: STPG SIGN (34)					
																							FILE NAME: 10C334						
VERMONT AGENCY OF TRANSPORTATION																							PLOT DATE: 5/2/2011						
							TOWN DIRECTIONAL TOTALS	128.2	0.0	6.0	0.0	0.0	31	0.0	0.0	16	240.0		0		0.0			DRAWN BY: D.CROSSLEY					
																							CHECKED BY: QAU						
																							SHEET 12 OF 65						

DIRECTION	MILEPOINT	LOCATION CODE (SHEET 2)	SIGN CODE	WIDTH (IN)	HEIGHT (IN)	SHEETING REMARKS	SIGN LEGEND	NEW SIGNS		EXISTING SIGNS				EXIST POST		NUMBER OF SQUARE STEEL NEW POSTS	SQUARE STEEL (IN)			TUBULAR STEEL Ø (IN)				SIGN FRAME REQUIRED	REMARKS	SIGN DETAIL LOCATION			
								"A"	"B"	RETAIN	SALVAGE FROM	SALVAGE TO	REMOVE	RETAIN	REMOVE		1.75	2.00	2.50	FOUNDATION	3.00	3.50	4.00			5.00	SHSM	PROJECT SHEET #	STANDARD SHEET #
																	(LB / FT)				(LB / FT)								
																	1.88	2.42	3.35		7.60	9.00	10.80			14.60			
NORWICH US5 SB							FY-FLUORESCENT YELLOW FYG-FLUORESCENT YELLOW GREEN															"SHSM"-STANDARD HIGHWAY SIGNS AND MARKINGS							
SB	8.176	G	VR-017	24	30								1		X								STEVENS RD TH-23						
		G	VR-017	24	30			5.00								1		X								E-141			
SB	8.184	H	R1-1	30	30								1		X								STEVENS RD TH-23						
		H	R1-1	30	30		 STEVENS RD	6.25			I	I	I			1		X					WITH STREET SIGN	X					
SB	7.73	F	M3-3	24	12		SOUTH						1		X														
		F	M1-4	24	24		US 5						1																
SB	6.852	F	M2-1	21	15								1		X														
		F	M1-5	30	24								1																
		F	M2-1	21	15			2.19								1		X					BLACK ON WHITE	X					
		F	M1-6	30	24			5.00																	E-136C				
SB	6.78	F	VD1-1A	72	10		D-BOARD AND ROUTE MARKER ASSEMBLY						1		X														
		F	VD1-1A	72	10								1																
		F	M3-3	24	12								1																
		F	M1-4	24	24								1																
		F	M6-3	21	15								1																
SIGN SUMMARY SHEET							SHEET TOTALS		18.44	0.00	0	0	0	12 11	0	0	3		45		0	0.0	0.0	0.0	0.0	PROJECT NAME: NORWICH - FAIRLEE			
									SF	SF	EA	EA	EA	EA	EA	EA		FT		EA	LB	LB	LB	LB	PROJECT NUMBER: STPG SIGN (34)				
							VERMONT AGENCY OF TRANSPORTATION																		FILE NAME: 10C334			PLOT DATE: 5/2/2011	
							TOWN DIRECTIONAL TOTALS		160.0	0.0	13.0	0.0	0.0	35	0.0	0.0	23		345.0		0			0.0	PROJECT MANAGER: A. GAMBLE			DRAWN BY: D.CROSSLEY	
																									DESIGNED BY: D.CROSSLEY			CHECKED BY: QAU	
																							NORWICH U.S. 5 SOUTHBOUND 1			SHEET 13 OF 65			

DIRECTION	MILEPOINT	LOCATION CODE (SHEET 2)	SIGN CODE	WIDTH (IN)	HEIGHT (IN)	SHEETING REMARKS	SIGN LEGEND	NEW SIGNS		EXISTING SIGNS				EXIST POST		NUMBER OF SQUARE STEEL NEW POSTS	SQUARE STEEL (IN)			TUBULAR STEEL Ø (IN)					SIGN FRAME REQUIRED	REMARKS	SIGN DETAIL LOCATION			
								"A"	"B"	RETAIN	SALVAGE FROM	SALVAGE TO	REMOVE	RETAIN	REMOVE		1.75	2.00	2.50	FOUNDATION	3.00	3.50	4.00	5.00						
																	(LB / FT)				(LB / FT)									
																	1.88	2.42	3.35		7.60	9.00	10.80	14.60						
NORWICH US5 SB							FY-FLUORESCENT YELLOW FYG-FLUORESCENT YELLOW GREEN																"SHSM"-STANDARD HIGHWAY SIGNS AND MARKINGS							
		F	M3-4	24	12		↑ Norwich 5 S. Strafford 11 → SOUTH WEST 5 132 ↑ →																							
		F	M1-5	30	24																									
		F	M6-1	21	15																									
		F	VD1-1A	72	12			6.00							2		X									NOTE REVISED ORDER		4		
		F	VD1-1A	72	12			6.00																			4			
		F	M3-3	24	12			2.00																		BLACK ON WHITE	X			
		F	M1-4	24	24			4.00																			X			
		F	M6-3	21	15			2.19																		BLACK ON WHITE	X			
		F	M3-4	24	12			2.00																		BLACK ON WHITE	X			
		F	M1-6	30	24			5.00																				E-136C		
		F	M6-1	21	15		2.19																		BLACK ON WHITE	X				
SB	6.75	F	VR-017	24	30		LLL 24,000 LBS			1				X												ROUTE 132				
SB	6.73	F	RI-1 VR-017	24	30		STOP			1				X												ROUTE 132				
SB	6.67	G	VR-017	24	30		LEGAL LOAD LIMIT 24,000 POUNDS						1		X											OLD BRIDGE ROAD TH-88				
		G	VR-017	24	30			5.00									1		X									E-141		
SIGN SUMMARY SHEET							SHEET TOTALS		34.38	0.00	2	0	0	4	0	0	3	45		0	0.0	0.0	0.0	0.0	PROJECT NAME: NORWICH - FAIRLEE					
									SF	SF	EA	EA	EA	EA	EA	EA	EA	FT		EA	LB	LB	LB	LB	PROJECT NUMBER: STPG SIGN (34)					
																									FILE NAME: 10C334					
									VERMONT AGENCY OF TRANSPORTATION			TOWN DIRECTIONAL TOTALS		160.0	0.0	13.0	0.0	0.0	35	0.0	0.0	23	345.0		0	0.0				PROJECT MANAGER: A. GAMBLE
																							DESIGNED BY: D.CROSSLEY			PLOT DATE: 5/2/2011				
																								NORWICH U.S. 5 SOUTHBOUND 2			DRAWN BY: D.CROSSLEY			
																								SHEET 14 OF 65			CHECKED BY: QAU			

DIRECTION	MILEPOINT	LOCATION CODE (SHEET 2)	SIGN CODE	WIDTH (IN)	HEIGHT (IN)	SHEETING REMARKS	SIGN LEGEND	NEW SIGNS		EXISTING SIGNS				EXIST POST		NUMBER OF SQUARE STEEL NEW POSTS	SQUARE STEEL (IN)			TUBULAR STEEL Ø (IN)					SIGN FRAME REQUIRED	REMARKS	SIGN DETAIL LOCATION		
								"A"	"B"	RETAIN	SALVAGE FROM	SALVAGE TO	REMOVE	RETAIN	REMOVE		1.75	2.00	2.50	FOUNDATION	3.00	3.50	4.00	5.00					
																	(LB / FT)				(LB / FT)								
																	1.88	2.42	3.35		7.60	9.00	10.80	14.60					
NORWICH US5 SB																							"SHSM"-STANDARD HIGHWAY SIGNS AND MARKINGS						
SB	6.664	H	R1-1	30	30								1		X										OLD BRIDGE ROAD TH-88				
		H	R1-1	30	30			6.25								1		X								X			
SB	6.363	G	VR-017	24	24								1		X										HEMLOCK RD TH-89				
		G	VR-017	24	30			5.00			1	1	1			1		X									E-141		
SB	6.355	H	R1-1	24	24								1		X										HEMLOCK RD TH-89				
		H	R1-1	30	30			6.25			1	1	1			1		X							WITH MILEMARKER	X			
SB	5.65	G	VR-017	24	24		LLL 24,000 LBS			1				X											FARRELL FARM RD TH-99				
SB	5.57	G	R1-1	24	24		STOP			1				X											FARRELL FARM RD TH-99				
SB	4.9	F	N/A	24	30		WELL HEAD PROTECTION ZONE			1				X															
SB	4.53	F	VW-054R	30	30								1		X														
SB	4.48	F	VW-054R	30	30			6.25								1		X							INSTALL 260' SOUTH OF ORIGINAL SIGN LOCATION			E-154	
SB	4.05	G	VR-017	24	30		LLL 24,000 LBS			1				X											BUTTERNUT LN TH-28				
SB	4.039	H	R1-1	24	24								1		X										BUTTERNUT LN TH-28				
		H	R1-1	30	30			6.25			1	1	1			1		X							WITH MILE MARKER	X			
SIGN SUMMARY SHEET							SHEET TOTALS		30.00	0.00	4	30	30	85	0	0	5		75		0	0.0	0.0	0.0	0.0	PROJECT NAME: NORWICH - FAIRLEE			
									SF	SF	EA	EA	EA	EA	EA	EA	EA		FT		EA	LB	LB	LB	LB	PROJECT NUMBER: STPG SIGN (34)			
																								FILE NAME: 10C334			PLOT DATE: 5/2/2011		
							VERMONT AGENCY OF TRANSPORTATION		TOWN DIRECTIONAL TOTALS										160.0	0.0	13.0	0.0	0.0	35	0.0	0.0	23		345.0
																								DRAWN BY: D.CROSSLEY					
																								CHECKED BY: QAU					
																								SHEET 15 OF 65					

DIRECTION	MILEPOINT	LOCATION CODE (SHEET 2)	SIGN CODE	WIDTH (IN)	HEIGHT (IN)	SHEETING REMARKS	SIGN LEGEND	NEW SIGNS		EXISTING SIGNS				EXIST POST		NUMBER OF SQUARE STEEL NEW POSTS	SQUARE STEEL (IN)			TUBULAR STEEL Ø (IN)				SIGN FRAME REQUIRED	REMARKS	SIGN DETAIL LOCATION			
								"A"	"B"	RETAIN	SALVAGE FROM	SALVAGE TO	REMOVE	RETAIN	REMOVE		1.75	2.00	2.50	FOUNDATION	3.00	3.50	4.00			5.00	SHSM	PROJECT SHEET #	STANDARD SHEET #
																	(LB / FT)				(LB / FT)								
																	1.88	2.42	3.35		7.60	9.00	10.80			14.60			
NORWICH US5 SB							FY-FLUORESCENT YELLOW FYG-FLUORESCENT YELLOW GREEN															"SHSM"-STANDARD HIGHWAY SIGNS AND MARKINGS							
SB	3.685	F	VW-285	30	30			6.25							1		X						INSTALL 200' +/- SOUTH OF PAVED DRIVE # 419		5				
SB	3.21	F	W2-3	30	30								1			X													
		F	W2-3R	30	30			6.25							1		X								X				
SB	3.09	G	VR-017	24	24								1			X							GOODRICH FOUR CORNERS TH-24						
			VR-017	24	30			5.00							1		X									E-141			
SB	3.07	H	R1-1	30	30								1			X							GOODRICH FOUR CORNERS TH-24						
			R1-1	30	30			6.25							1		X								X				
SB	2.97		M4-14	24	12			2.00							1		X						BLACK ON WHITE		X				
			R8-3	24	24			4.00															INSTALL 200' NORTH OF EXISTING END NO PARKING SIGN		X				
SB	2.932	F	R8-3a	24	24								1			X													
		F	M4-6	24	12								1																
		F	M4-6	24	12			2.00							1		X						BLACK ON WHITE		X				
		F	R8-3	24	24			4.00																	X				
SB	2.929	G	VR-017	24	24								1			X							LOVELAND RD TH-86						
		G	VR-017	24	30			5.00							1		X									E-141			
SIGN SUMMARY SHEET							SHEET TOTALS		40.75	0.00	0	0	0	6	0	0	7	105		0	0.0	0.0	0.0	0.0	PROJECT NAME: NORWICH - FAIRLEE				
									SF	SF	EA	EA	EA	EA	EA	EA	EA		FT		EA	LB	LB	LB	LB	PROJECT NUMBER: STPG SIGN (34)			
																											FILE NAME: 10C334		
							VERMONT AGENCY OF TRANSPORTATION																					PROJECT MANAGER: A. GAMBLE	
							TOWN DIRECTIONAL TOTALS		160.0	0.0	13.0	0.0	0.0	35	0.0	0.0	23	345.0		0	0.0				PLOT DATE: 5/2/2011				
																							DRAWN BY: D.CROSSLEY						
																							CHECKED BY: QAU						
																							SHEET 16 OF 65						
																							NORWICH U.S. 5 SOUTHBOUND 4						


DIRECTION	MILEPOINT	LOCATION CODE (SHEET 2)	SIGN CODE	WIDTH (IN)	HEIGHT (IN)	SHEETING REMARKS	SIGN LEGEND	NEW SIGNS		EXISTING SIGNS				EXIST POST		NUMBER OF SQUARE STEEL NEW POSTS	SQUARE STEEL (IN)			TUBULAR STEEL Ø (IN)					SIGN FRAME REQUIRED	REMARKS	SIGN DETAIL LOCATION		
								"A"	"B"	RETAIN	SALVAGE FROM	SALVAGE TO	REMOVE	RETAIN	REMOVE		1.75	2.00	2.50	FOUNDATION	3.00	3.50	4.00	5.00					
																	(LB / FT)				(LB / FT)								
																	1.88	2.42	3.35		7.60	9.00	10.80	14.60					
NORWICH US5 SB																							"SHSM"-STANDARD HIGHWAY SIGNS AND MARKINGS						
SB	2.923	H	R1-1	24	24		0050 1411 0292 STOP						1		X										LOVELAND RD TH-86				
		H	R1-1	30	30			6.25			1	1	1			1		X							WITH MILE MARKER	X			
SB	2.871	F	VW-285	30	30		FALLING ROCK			1				X															
SB	2.802	F	W3-5	36	36		SPEED REDUCTION AHEAD 40 MPH			1				X															
SB	2.733	F	W1-2R	30	30								1		X														
		F	W1-2R	30	30			6.25								1		X								X			
SB	2.67	F	R2-1	24	30		SPEED LIMIT 40						1		X														
		F	R2-1	30	36			7.50								1		X								X			
SB	2.624	F	VD-018	30	18		NORWICH WILDER 4			1				X															
SB	2.541	F	W1-10R	30	30		MODIFIED CURVE RIGHT			1				X															
SB	2.51	F	M4-5	24	12		ROUTE MARKER ASSEMBLY						1		X														
		F	M1-1	24	24								1																
		F	M6-2	21	15								1																
		F	M3-3	24	12								1																
		F	M1-4	24	24								1																
SIGN SUMMARY SHEET							SHEET TOTALS		20.00	0.00	4	10	10	98	0	0	3		45		0	0.0	0.0	0.0	0.0	PROJECT NAME: NORWICH - FAIRLEE			
									SF	SF	EA	EA	EA	EA	EA	EA		FT		EA	LB	LB	LB	LB	PROJECT NUMBER: STPG SIGN (34)				
																									FILE NAME: 10C334				
																									PROJECT MANAGER: A. GAMBLE				
VERMONT AGENCY OF TRANSPORTATION																									PLOT DATE: 5/2/2011				
																									DRAWN BY: D.CROSSLEY				
																									CHECKED BY: QAU				
																									SHEET 17 OF 65				
TOWN DIRECTIONAL TOTALS							160.0	0.0	13.0	0.0	0.0	35	0.0	0.0	23		345.0	0	0.0			NORWICH U.S. 5 SOUTHBOUND 5							

DIRECTION	MILEPOINT	LOCATION CODE (SHEET 2)	SIGN CODE	WIDTH (IN)	HEIGHT (IN)	SHEETING REMARKS	SIGN LEGEND	NEW SIGNS		EXISTING SIGNS				EXIST POST		NUMBER OF SQUARE STEEL NEW POSTS	SQUARE STEEL (IN)			TUBULAR STEEL Ø (IN)				SIGN FRAME REQUIRED	REMARKS	SIGN DETAIL LOCATION							
								"A"	"B"	RETAIN	SALVAGE FROM	SALVAGE TO	REMOVE	RETAIN	REMOVE		1.75	2.00	2.50	FOUNDATION	3.00	3.50	4.00			5.00	SHSM	PROJECT SHEET #	STANDARD SHEET #				
																	(LB / FT)				(LB / FT)												
																	1.88	2.42	3.35		7.60	9.00	10.80			14.60							
NORWICH US5 SB							FY-FLUORESCENT YELLOW FYG-FLUORESCENT YELLOW GREEN															"SHSM"-STANDARD HIGHWAY SIGNS AND MARKINGS											
		F	M6-2	21	15							1																					
		F	M4-5	24	12			2.00						2		X					2	WHITE ON BLUE	X										
		F	M1-1	24	24			4.00														X											
		F	M6-2	21	15			2.19														X											
		F	M3-3	24	12			2.00														X											
		F	M1-4	24	24			4.00														X											
		F	M6-2	21	15			2.19														X											
SB	2.457	F	D1-1M	72	12		<=== 45 DEG HANOVER N.H. 1			1			X																				
		F	D1-1A	72	10		NORWICH 1 ==>> 45 DEG			1																							
		F	D1-1A	72	12		WHITE RIVER JCT 6 ==>> 45 DEG			1																							
SIGN SUMMARY SHEET							SHEET TOTALS				16.38	0.00	3	0	0	1	0	0	2	30			0	0.0	0.0	0.0	0.0	PROJECT NAME: NORWICH - FAIRLEE					
											SF	SF	EA	EA	EA	EA	EA	EA	EA	FT			EA	LB	LB	LB	LB	PROJECT NUMBER: STPG SIGN (34)					
																											FILE NAME: 10C334			PLOT DATE: 5/2/2011			
																											PROJECT MANAGER: A. GAMBLE			DRAWN BY: D.CROSSLEY			
VERMONT AGENCY OF TRANSPORTATION																											DESIGNED BY: D.CROSSLEY			CHECKED BY: QAU			
							TOWN DIRECTIONAL TOTALS				160.0	0.0	13.0	0.0	0.0	35	0.0	0.0	23	345.0			0	0.0				NORWICH U.S. 5 SOUTHBOUND 6			SHEET 18 OF 65		

DIRECTION	MILEPOINT	LOCATION CODE (SHEET 2)	SIGN CODE	WIDTH (IN)	HEIGHT (IN)	SHEETING REMARKS	SIGN LEGEND	NEW SIGNS		EXISTING SIGNS				EXIST POST		NUMBER OF NEW SQUARE STEEL POSTS	SQUARE STEEL (IN)			TUBULAR STEEL Ø (IN)				SIGN FRAME REQUIRED	REMARKS	SIGN DETAIL LOCATION								
								"A"	"B"	RETAIN	SALVAGE FROM	SALVAGE TO	REMOVE	RETAIN	REMOVE		1.75	2.00	2.50	FOUNDATION	3.00	3.50	4.00			5.00	SHSM	PROJECT SHEET #	STANDARD SHEET #					
																	(LB / FT)				(LB / FT)													
																	1.88	2.42	3.35		7.60	9.00	10.80			14.60								
THETFORD US 5 NB							FY-FLUORESCENT YELLOW FYG-FLUORESCENT YELLOW GREEN																"SHSM"-STANDARD HIGHWAY SIGNS AND MARKINGS											
NB	0.000	C	VD-024	60	7.5		Thetford Orange Co. Norwich Windsor Co. 0050 0911 0000 0050 1411 0829						1		X																			
		C	VD-025	60	7.5								1																					
		C	VD-700	6	10								1																					
		C	VD-024	72	10			5.00								2		X									4							
		C	VD-025	72	10			5.00																			4							
		C	VD-700	6	10			0.42																			E-138							
		C	VD-700	6	10			0.42																			E-138							
NB	1.840	A	W10-3R	30	30		RAILROAD CROSSING			1				X																				
NB	1.900	A	VD-062B	72	16		BUSINESS SIGN			1				X																				
NB	1.960	C	VR-017	24	30		LEGAL LOAD LIMIT 24,000 POUNDS						1		X										PAVILLION RD TH-44 (SOUTH)									
		C	VR-017	24	30			5.00								1		X									E-141							
NB	1.960	D	R1-1	30	30		STOP			1				X											PAVILLION RD TH-44 (SOUTH)									
NB	2.540	A	R2-5A	24	30		↑ SPEED LIMIT 40 REDUCED SPEED AHEAD						1		X																			
		A	W3-5	36	36			9.00								2		X								X								
NB	2.605	A	VD-018	30	18								1		X																			
SIGN SUMMARY SHEET							SHEET TOTALS		24.84	0.00	3	0	0	6	0	0	5	75		0	0	0	0	0	PROJECT NAME: NORWICH - FAIRLEE									
									SF	SF	EA	EA	EA	EA	EA	EA	EA	EA	EA	EA	EA	EA	EA	EA	EA	EA	EA	EA	EA	EA	PROJECT NUMBER: STPG SIGN (34)			
																																FILE NAME: 10C334		
																																PROJECT MANAGER: A.GAMBLE		
VERMONT AGENCY OF TRANSPORTATION							TOWN DIRECTIONAL TOTALS		243.9	0.0	25.0	2.0	2.0	65	0.0	0.0	28	420.0		4	364.8				PLOT DATE: 5/2/2011									
																															DRAWN BY: D.CROSSLEY			
																										CHECKED BY: QAU								
																										SHEET 19 OF 65								


DIRECTION	MILEPOINT	LOCATION CODE (SHEET 2)	SIGN CODE	WIDTH (IN)	HEIGHT (IN)	SHEETING REMARKS	SIGN LEGEND	NEW SIGNS		EXISTING SIGNS				EXIST POST		NUMBER OF NEW SQUARE STEEL POSTS	SQUARE STEEL (IN)			TUBULAR STEEL Ø (IN)				SIGN FRAME REQUIRED	REMARKS	SIGN DETAIL LOCATION			
								"A"	"B"	RETAIN	SALVAGE FROM	SALVAGE TO	REMOVE	RETAIN	REMOVE		1.75	2.00	2.50	FOUNDATION	3.00	3.50	4.00			5.00	SHSM	PROJECT SHEET #	STANDARD SHEET #
																	(LB / FT)				(LB / FT)								
																	1.88	2.42	3.35		7.60	9.00	10.80			14.60			
THETFORD US 5 NB							FY-FLUORESCENT YELLOW FYG-FLUORESCENT YELLOW GREEN															"SHSM"-STANDARD HIGHWAY SIGNS AND MARKINGS							
		A	VD-018	30	18		East Thetford North Thetford 2	3.75						1		X									5				
NB	2.680	A	R2-1	24	30		SPEED LIMIT 40						1		X														
		A	R2-1	30	36			7.50						1		X								X					
NB	2.710	A	VD-062AS	72	16		BUSINESS SIGN			1			X																
NB	2.740	A	R2-5A	24	30		↑ SPEED LIMIT 30 REDUCED SPEED AHEAD						1		X														
		A	W3-5	36	36			9.00						2		X								X					
NB	2.770	A	W10-3R	30	30		RAILROAD CROSSING			1			X																
NB	2.800	A	R2-1	24	30		SPEED LIMIT 30						1		X														
		A	R2-1	30	36			7.50						1		X								X					
NB	2.833	A	M2-1	21	15		JCT						1		X														
		A	M1-5A	30	24		ROUTE 113						1																
NB	2.833	C	VR-017	24	24								1		X									PAVILLION RD TH-44 (NORTH)					
		C	VR-017	24	30		LEGAL LOAD LIMIT 24,000 POUNDS	5.00							1		X									E-141			
NB	2.850	D	R1-1	30	30								1		X									PAVILLION RD TH-44 (NORTH)					
		D	R1-1	30	30		STOP	6.25							1		X								X				
SIGN SUMMARY SHEET							SHEET TOTALS		39.00	0.00	2	0	0	7	0	0	7	105		0	0	0	0	0	PROJECT NAME: NORWICH - FAIRLEE				
									SF	SF	EA	EA	EA	EA	EA	EA	EA	FT		EA	LB	LB	LB	LB	PROJECT NUMBER: STPG SIGN (34)				
																									FILE NAME: 10C334				
																									PROJECT MANAGER: A.GAMBLE				
VERMONT AGENCY OF TRANSPORTATION							TOWN DIRECTIONAL TOTALS		243.9	0.0	25.0	2.0	2.0	65	0.0	0.0	28	420.0		4	364.8				PLOT DATE: 5/2/2011				
																								DRAWN BY: D.CROSSLEY					
																								DESIGNED BY: D.CROSSLEY					
																							THETFORD U.S. 5 NORTHBOUND 2						
																								CHECKED BY: QAU					
																								SHEET 20 OF 65					

DIRECTION	MILEPOINT	LOCATION CODE (SHEET 2)	SIGN CODE	WIDTH (IN)	HEIGHT (IN)	SHEETING REMARKS	SIGN LEGEND	NEW SIGNS		EXISTING SIGNS				EXIST POST		NUMBER OF NEW SQUARE STEEL POSTS	SQUARE STEEL (IN)			TUBULAR STEEL Ø (IN)				SIGN FRAME REQUIRED	REMARKS	SIGN DETAIL LOCATION					
								"A"	"B"	RETAIN	SALVAGE FROM	SALVAGE TO	REMOVE	RETAIN	REMOVE		1.75	2.00	2.50	FOUNDATION	3.00	3.50	4.00			5.00	SHSM	PROJECT SHEET #	STANDARD SHEET #		
																	(LB / FT)				(LB / FT)										
																	1.88	2.42	3.35		7.60	9.00	10.80			14.60					
THETFORD US 5 NB							FY-FLUORESCENT YELLOW FYG-FLUORESCENT YELLOW GREEN															"SHSM"-STANDARD HIGHWAY SIGNS AND MARKINGS									
NB	2.870	A	D1-1M	72	10		MAP NORTH THETFORD 2						1		X																
		A	D1-1A	72	10		MAP FAIRLEE 8						1																		
		A	D1-1A	72	10		MAP THETFORD HILL 2						1																		
		A	D1-1A	72	10		MAP CHELSEA 23						1																		
		A	D1-1A	72	10		LYME NH ---->						1																		
		A	M2-1	21	15			2.19								1		X							GREEN ON WHITE	X					
		A	M1-5A	30	24			5.00																				E-136B			
NB	2.890	A	R2-1	24	30			5.00								1		X							INSTALL 10'+ SOUTH OF POLE #6/4	X					
NB	2.920	A	M4-14	24	12			2.00								1		X							BLACK ON WHITE	X					
		A	R8-3	24	24			4.00																	INSTALL AT MIDPOINT OF SMALL ISLAND IN FRONT OF AUTOMOTIVE	X					
NB	2.940	A	R8-3	24	24			4.00								1		X							INSTALL BETWEEN IRVING SIGN AND NORTH END OF ISLAND	X					
NB	2.953	A	M3-4	24	12		ROUTE MARKER ASSEMBLY						1		X																
		A	M1-5A	30	24								1																		
		A	M5-1	21	15								1																		
		A	M3-1	24	12								1																		
SIGN SUMMARY SHEET							SHEET TOTALS		22.19	0.00	0	0	0	9	0	0	4	60			0	0	0	0	0	PROJECT NAME: NORWICH - FAIRLEE			PROJECT NUMBER: STPG SIGN (34)		
								SF	SF	EA	EA	EA	EA	EA	EA	EA		FT		EA	LB	LB	LB	LB	FILE NAME: 10C334			PLOT DATE: 5/2/2011			
																									PROJECT MANAGER: A.GAMBLE			DRAWN BY: D.CROSSLEY			
							VERMONT AGENCY OF TRANSPORTATION																		DESIGNED BY: D.CROSSLEY			CHECKED BY: QAU			
							TOWN DIRECTIONAL TOTALS		243.9	0.0	25.0	2.0	2.0	65	0.0	0.0	28	420.0			4	364.8				THETFORD U.S. 5 NORTHBOUND 3			SHEET 21 OF 65		

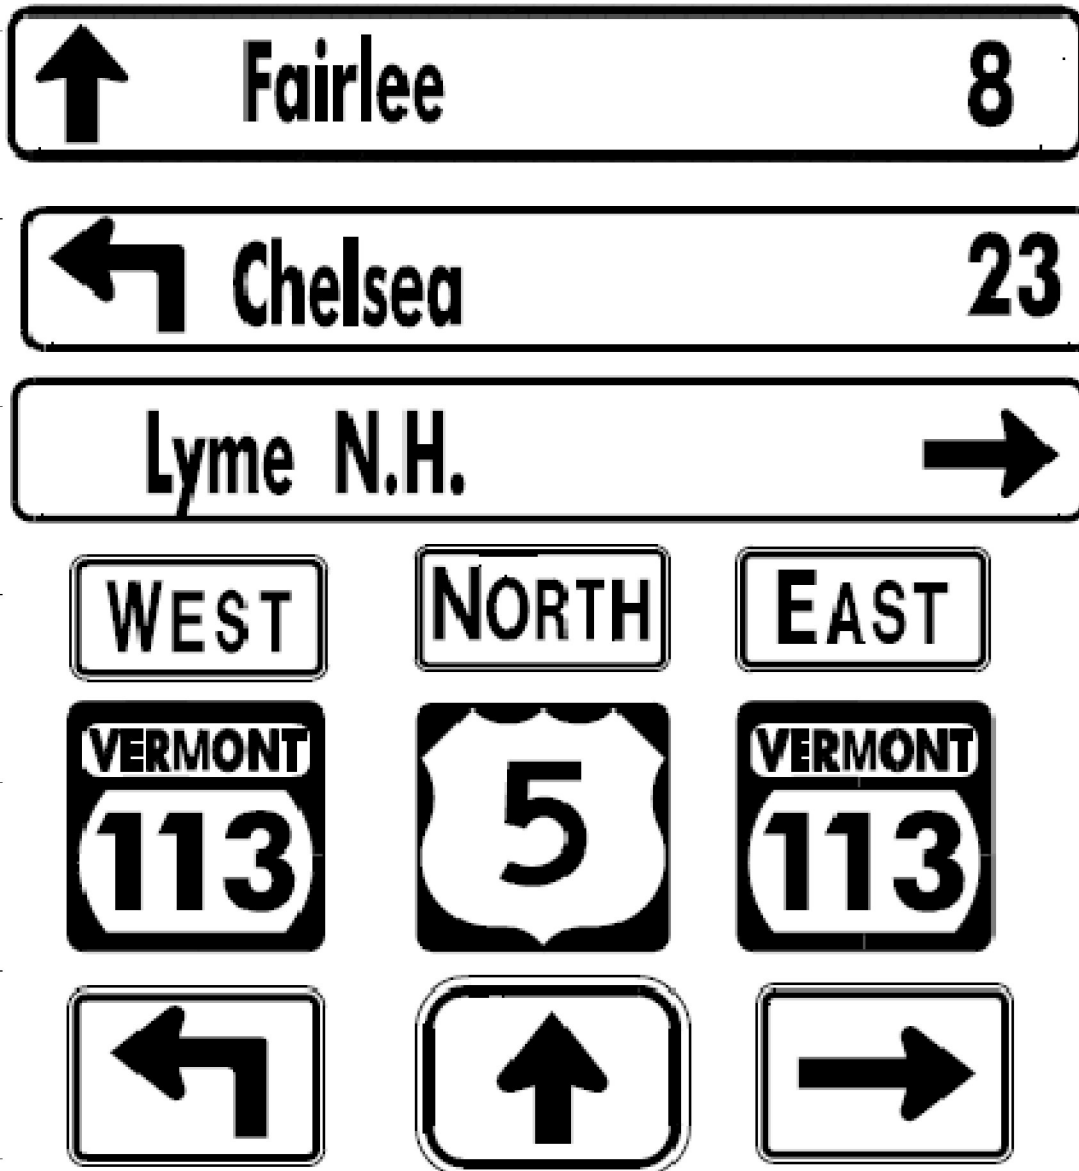DIRECTION	MILEPOINT	LOCATION CODE (SHEET 2)	SIGN CODE	WIDTH (IN)	HEIGHT (IN)	SHEETING REMARKS	SIGN LEGEND	NEW SIGNS		EXISTING SIGNS				EXIST POST		NUMBER OF NEW SQUARE STEEL POSTS	SQUARE STEEL (IN)			TUBULAR STEEL Ø (IN)				SIGN FRAME REQUIRED	REMARKS	SIGN DETAIL LOCATION									
								"A"	"B"	RETAIN	SALVAGE FROM	SALVAGE TO	REMOVE	RETAIN	REMOVE		1.75	2.00	2.50	FOUNDATION	3.00	3.50	4.00			5.00	SHSM	PROJECT SHEET #	STANDARD SHEET #						
																	(LB / FT)				(LB / FT)														
																	1.88	2.42	3.35		7.60	9.00	10.80			14.60									
THETFORD US 5 NB							FY-FLUORESCENT YELLOW FYG-FLUORESCENT YELLOW GREEN																"SHSM"-STANDARD HIGHWAY SIGNS AND MARKINGS												
		A	M1-4	24	24							1																							
		A	M6-3	21	15								1																						
		A	M3-2	24	12								1																						
		A	M1-5A	30	24								1																						
		A	M6-1	21	15								1																						
		A	VD1-1A	72	12				6.00									2	182.4				3B			4									
		A	VD1-1A	72	12				6.00																	4									
		A	VD1-1	72	12				6.00																	4									
		A	M3-4	24	12				2.00															GREEN ON WHITE	X										
		A	M1-5A	30	24				5.00																	E-136B									
		A	M5-1	21	15				2.19															GREEN ON WHITE	X										
		A	M3-1	24	12				2.00															BLACK ON WHITE	X										
		A	M1-4	24	24				4.00																X										
		A	M6-3	21	15				2.19															BLACK ON WHITE	X										
		A	M3-2	24	12				2.00															GREEN ON WHITE	X										
SIGN SUMMARY SHEET							SHEET TOTALS	37.38	0.00	0	0	0	5	0	0	0	0			2	182.4	0	0	0	PROJECT NAME: NORWICH - FAIRLEE										
								SF	SF	EA	EA	EA	EA	EA	EA	EA		FT		EA	LB	LB	LB	LB	PROJECT NUMBER: STPG SIGN (34)										
																								FILE NAME: 10C334						PLOT DATE: 5/2/2011					
VERMONT AGENCY OF TRANSPORTATION							TOWN DIRECTIONAL TOTALS	243.9	0.0	25.0	2.0	2.0	65	0.0	0.0	28	420.0			4	364.8				PROJECT MANAGER: A.GAMBLE										
																								DESIGNED BY: D.CROSSLEY						DRAWN BY: D.CROSSLEY					
																								THETFORD U.S. 5 NORTHBOUND 4						CHECKED BY: QAU					
																														SHEET 22 OF 65					

DIRECTION	MILEPOINT	LOCATION CODE (SHEET 2)	SIGN CODE	WIDTH (IN)	HEIGHT (IN)	SHEETING REMARKS	SIGN LEGEND	NEW SIGNS		EXISTING SIGNS				EXIST POST		NUMBER OF NEW SQUARE STEEL POSTS	SQUARE STEEL (IN)			TUBULAR STEEL Ø (IN)				SIGN FRAME REQUIRED	REMARKS	SIGN DETAIL LOCATION							
								"A"	"B"	RETAIN	SALVAGE FROM	SALVAGE TO	REMOVE	RETAIN	REMOVE		1.75	2.00	2.50	FOUNDATION	3.00	3.50	4.00			5.00	SHSM	PROJECT SHEET #	STANDARD SHEET #				
																	(LB / FT)				(LB / FT)												
																	1.88	2.42	3.35		7.60	9.00	10.80			14.60							
THETFORD US 5 NB							FY-FLUORESCENT YELLOW FYG-FLUORESCENT YELLOW GREEN															"SHSM"-STANDARD HIGHWAY SIGNS AND MARKINGS											
		A	M1-5A	30	24			5.00																	E-136B								
		A	M6-1	21	15			2.19															GREEN ON WHITE	X									
NB	2.955	A	VR-644	24	12		BEGIN						1		X																		
		A	R8-3A	24	24		NO PARKING						1																				
NB	2.970	A	R8-3	24	24			4.00							1		X						INSTALL 80' +/- NORTH OF REMOVED BEGIN NO PARKING	X									
NB	2.998	A	R8-3A	24	24		NO PARKING			1				X																			
NB	3.026	A	D1-1A	72	10		D-BEARD AND ROUTE MARKER ASSEMBLY						1		X																		
		A	D1-1A	72	10								1																				
		A	D1-1A	72	10								1																				
		A	D1-1A	72	10								1																				
		A	M3-4	24	12								1																				
		A	M1-5A	30	24								1																				
		A	M6-1	21	15								1																				
		A	M4-5	24	12								1																				
		A	M1-1	24	24								1																				
SIGN SUMMARY SHEET							SHEET TOTALS		11.19	0.00	1	0	0	11	0	0	1	15			0	0	0	0	0	PROJECT NAME: NORWICH - FAIRLEE							
									SF	SF	EA	EA	EA	EA	EA	EA	EA	EA	EA	EA	EA	EA	EA	EA	EA	EA	EA	EA	EA	EA	PROJECT NUMBER: STPG SIGN (34)		
																															FILE NAME: 10C334		
																															PLOT DATE: 5/2/2011		
VERMONT AGENCY OF TRANSPORTATION							TOWN DIRECTIONAL TOTALS		243.9	0.0	25.0	2.0	2.0	65	0.0	0.0	28	420.0			4	364.8				PROJECT MANAGER: A.GAMBLE							
																														DRAWN BY: D.CROSSLEY			
																														CHECKED BY: QAU			
																								THETFORD U.S. 5 NORTHBOUND 5									
																								SHEET 23 OF 65									

DIRECTION	MILEPOINT	LOCATION CODE (SHEET 2)	SIGN CODE	WIDTH (IN)	HEIGHT (IN)	SHEETING REMARKS	SIGN LEGEND	NEW SIGNS		EXISTING SIGNS				EXIST POST		NUMBER OF NEW SQUARE STEEL POSTS	SQUARE STEEL (IN)			TUBULAR STEEL Ø (IN)				SIGN FRAME REQUIRED	REMARKS	SIGN DETAIL LOCATION					
								"A"	"B"	RETAIN	SALVAGE FROM	SALVAGE TO	REMOVE	RETAIN	REMOVE		1.75	2.00	2.50	FOUNDATION	3.00	3.50	4.00			5.00	SHSM	PROJECT SHEET #	STANDARD SHEET #		
																	(LB / FT)				(LB / FT)										
																	1.88	2.42	3.35		7.60	9.00	10.80			14.60					
THETFORD US 5 NB							FY-FLUORESCENT YELLOW FYG-FLUORESCENT YELLOW GREEN															"SHSM"-STANDARD HIGHWAY SIGNS AND MARKINGS									
		A	M6-1	21	15		↑ Fairlee 8 ← West Fairlee 10 ← Chelsea 23 WEST TO NORTH VERMONT 113 INTERSTATE 91 5 ← ← ↑ <td></td> <td></td> 		A	M3-1	24	12																										
		A	M1-4	24	24																										
		A	M6-3	21	15																										
		A	VD1-1A	72	12			6.00									2		182			3A				4					
		A	VD1-1A	72	12			6.00																		4					
		A	VD1-1A	72	12			6.00																		4					
		A	M3-4	24	12			2.00															GREEN ON WHITE	X							
		A	M1-5A	30	24			5.00																			E-136B				
		A	M6-1	21	15			2.19															GREEN ON WHITE	X							
		A	M4-5	24	12			2.00															WHITE ON BLUE	X							
		A	M1-1	24	24			4.00																X							
		A	M6-1	21	15			2.19															WHITE ON BLUE	X							
		A	M3-1	24	12			2.00															BLACK ON WHITE	X							
		A	M1-4	24	24			4.00																X							
SIGN SUMMARY SHEET							SHEET TOTALS		41.38	0.00	0	0	0	4	0	0	0	0			2	0	182	0	0	PROJECT NAME: NORWICH - FAIRLEE					
									SF	SF	EA	EA	EA	EA	EA	EA	EA	FT			EA	LB	LB	LB	LB	PROJECT NUMBER: STPG SIGN (34)					
																										FILE NAME: 10C334					
																										PROJECT MANAGER: A.GAMBLE					
VERMONT AGENCY OF TRANSPORTATION							TOWN DIRECTIONAL TOTALS		243.9	0.0	25.0	2.0	2.0	65	0.0	0.0	28	420.0			4	364.8				PLOT DATE: 5/2/2011					
																									DRAWN BY: D.CROSSLEY						
																									CHECKED BY: QAU						
																							THETFORD U.S. 5 NORTHBOUND 6			SHEET 24 OF 65					

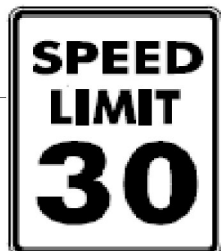DIRECTION	MILEPOINT	LOCATION CODE (SHEET 2)	SIGN CODE	WIDTH (IN)	HEIGHT (IN)	SHEETING REMARKS	SIGN LEGEND	NEW SIGNS		EXISTING SIGNS				EXIST POST		NUMBER OF NEW SQUARE STEEL POSTS	SQUARE STEEL (IN)			TUBULAR STEEL Ø (IN)				SIGN FRAME REQUIRED	REMARKS	SIGN DETAIL LOCATION			
								"A"	"B"	RETAIN	SALVAGE FROM	SALVAGE TO	REMOVE	RETAIN	REMOVE		1.75	2.00	2.50	FOUNDATION	3.00	3.50	4.00			5.00	SHSM	PROJECT SHEET #	STANDARD SHEET #
																	(LB / FT)				(LB / FT)								
																	1.88	2.42	3.35		7.60	9.00	10.80			14.60			
THETFORD US 5 NB							FY-FLUORESCENT YELLOW FYG-FLUORESCENT YELLOW GREEN															"SHSM"-STANDARD HIGHWAY SIGNS AND MARKINGS							
		A	M6-3	21	15			2.19															BLACK ON WHITE	X					
NB	3.050	A	R8-3A	24	24		NO PARKING						1		X														
		A	M4-6	24	12		END						1																
		A	R8-3	24	24			4.00							1		X								X				
NB	3.051	C	VR-020	24	30		NO PARKING ON TRAVELED LANES						1		X														
NB	3.060	A	R2-1	24	30								1		X														
		A	R2-1	24	30			5.00							1		X								X				
NB	3.070	C	VR-020	24	30		NO PARKING ON TRAVELED LANES						1		X														
NB	3.100	A	R8-3	24	24			4.00							1		X							INSTALL 75' +/- NORTH OF BANK EXIT	X				
NB	3.120	A	VR-048	24	30		STATE LAW STOP FOR SCHOOL BUS						1		X														
		A	M3-1	24	12			2.00							1		X							BLACK ON WHITE	X				
		A	M1-4	24	24			4.00																	X				
		A	VM-120	18	24		CONNECTICUT RIVER BYWAY					1											SALVAGE FROM 3.170 BELOW ROUTE MARKER						
		A	D6-4A	18	9		AMERICA'S BYWAYS					1											SALVAGE FROM 3.170 ON BOTTOM						
NB	3.140	A	M4-6	24	12			2.00							1		X							BLACK ON WHITE	X				
SIGN SUMMARY SHEET							SHEET TOTALS		23.19	0.00	0	0	2	6	0	0	5	75			0	0	0	0	0	PROJECT NAME: NORWICH - FAIRLEE			
									SF	SF	EA	EA	EA	EA	EA	EA	EA	FT				EA	LB	LB	LB	LB	PROJECT NUMBER: STPG SIGN (34)		
																											FILE NAME: 10C334		
																											PLOT DATE: 5/2/2011		
VERMONT AGENCY OF TRANSPORTATION																								PROJECT MANAGER: A.GAMBLE					
																											DRAWN BY: D.CROSSLEY		
TOWN DIRECTIONAL TOTALS									243.9	0.0	25.0	2.0	2.0	65	0.0	0.0	28	420.0			4	364.8				CHECKED BY: QAU			
																											THETFORD U.S. 5 NORTHBOUND 7		
																								SHEET 25	OF	65			

DIRECTION	MILEPOINT	LOCATION CODE (SHEET 2)	SIGN CODE	WIDTH (IN)	HEIGHT (IN)	SHEETING REMARKS	SIGN LEGEND	NEW SIGNS		EXISTING SIGNS				EXIST POST		NUMBER OF NEW SQUARE STEEL POSTS	SQUARE STEEL (IN)			TUBULAR STEEL Ø (IN)				SIGN FRAME REQUIRED	REMARKS	SIGN DETAIL LOCATION										
								"A"	"B"	RETAIN	SALVAGE FROM	SALVAGE TO	REMOVE	RETAIN	REMOVE		1.75	2.00	2.50	FOUNDATION	3.00	3.50	4.00			5.00	SHSM	PROJECT SHEET #	STANDARD SHEET #							
																														(LB / FT)			(LB / FT)			
																														1.88	2.42	3.35	7.60	9.00	10.80	14.60
THETFORD US 5 NB							FY-FLUORESCENT YELLOW FYG-FLUORESCENT YELLOW GREEN																"SHSM"-STANDARD HIGHWAY SIGNS AND MARKINGS													
			R8-3	24	24			4.00																INSTALL 100'+/- NORTH OF NEW US 5 SIGN	X											
NB	3.170	A	M3-1	24	12								1		X																					
		A	M1-4	24	24		US 5						1																							
		A	VM-120	18	24		CONNECTICUT RIVER BYWAY				1		1																							
		A	D6-4A	18	9		AMERICA'S BYWAYS				1		1																							
		A	VD2-1	72	12			6.00								2		X								4										
		A	VD2-1	72	12			6.00																		4										
NB	3.196	A	VW-054R	30	30		HIDDEN DRIVE RIGHT						1		X																					
NB	3.210	A	R2-1	24	30								1		X																					
		A	R2-1	24	30			5.00								1		X							X											
NB	3.220	A	VR-072	24	24		NO DRINK AND DRIVE						1		X																					
		A	VR-655	24	12		STRICTLY ENFORCED						1																							
NB	3.272	A	VR-023B	24	30		 \$500 FINE FOR THROWING TRASH						1		X																					
		A	VW-054R	30	30			6.25								1		X									E-154									
NB	3.308	A	VD2-1	72	10		NORTH THETFORD 2						1		X																					
SIGN SUMMARY SHEET							SHEET TOTALS		27.25	0.00	0	2	0	10	0	0	4	60		0	0	0	0	0	PROJECT NAME: NORWICH - FAIRLEE											
									SF	SF	EA	EA	EA	EA	EA	EA	EA	EA	EA	EA	EA	EA	EA	EA	EA	EA	EA	EA	EA	EA	PROJECT NUMBER: STPG SIGN (34)					
																																FILE NAME: 10C334				
																																PLOT DATE: 5/2/2011				
VERMONT AGENCY OF TRANSPORTATION							TOWN DIRECTIONAL TOTALS		243.9	0.0	25.0	2.0	2.0	65	0.0	0.0	28	420.0		4	364.8				PROJECT MANAGER: A.GAMBLE											
																															DRAWN BY: D.CROSSLEY					
																										CHECKED BY: QAU										
																										THETFORD U.S. 5 NORTHBOUND 8										
																										SHEET 26 OF 65										

DIRECTION	MILEPOINT	LOCATION CODE (SHEET 2)	SIGN CODE	WIDTH (IN)	HEIGHT (IN)	SHEETING REMARKS	SIGN LEGEND	NEW SIGNS		EXISTING SIGNS				EXIST POST		NUMBER OF NEW SQUARE STEEL POSTS	SQUARE STEEL (IN)			TUBULAR STEEL Ø (IN)				SIGN FRAME REQUIRED	REMARKS	SIGN DETAIL LOCATION			
								"A"	"B"	RETAIN	SALVAGE FROM	SALVAGE TO	REMOVE	RETAIN	REMOVE		1.75	2.00	2.50	FOUNDATION	3.00	3.50	4.00			5.00	SHSM	PROJECT SHEET #	STANDARD SHEET #
																	(LB / FT)				(LB / FT)								
																	1.88	2.42	3.35		7.60	9.00	10.80			14.60			
THETFORD US 5 NB							FY-FLUORESCENT YELLOW FYG-FLUORESCENT YELLOW GREEN																"SHSM"-STANDARD HIGHWAY SIGNS AND MARKINGS						
		A	VD2-1	72	10		FAIRLEE 8						1																
NB	3.340	A	R2-1	48	60								1		X														
		A	W16-18P	24	12	FY	STATE LAW SPEED LIMIT 50 UNLESS OTHERWISE POSTED	2.00								1		X									5		
		A	R2-1	24	30			5.00																	X				
		A	R2-5P	24	18			3.00																	X				
NB	3.730	A	M3-1	24	12		NORTH						1		X														
		A	M1-4	24	24		US 5						1																
NB	4.622	A	W3-5	36	36		SPEED REDUCTION 40			1				X															
NB	4.729	A	VW-054R	30	30		HIDDEN DRIVE RIGHT			1				X															
NB	4.763	A	R2-1	24	30		SPEED LIMIT 40						1		X														
		A	R2-1	30	36			7.50							1	X									X				
NB	4.875	A	W1-2R	30	30		RIGHT CURVE			1				X															
NB	5.032	A	VD-018	30	18		NORTH THETFORD ELY 3			1				X															
NB	5.119	A	R2-1	30	36		SPEED LIMIT 35			1				X															
NB	5.227	A	W1-1L	36	36		LEFT TURN					1		X															
SIGN SUMMARY SHEET							SHEET TOTALS		17.50	0.00	6	0	0	5	0	0	2	30			0	0	0	0	0	PROJECT NAME: NORWICH - FAIRLEE			
									SF	SF	EA	EA	EA	EA	EA	EA	EA	FT				EA	LB	LB	LB	LB	PROJECT NUMBER: STPG SIGN (34)		
																											FILE NAME: 10C334		
							VERMONT AGENCY OF TRANSPORTATION																					PROJECT MANAGER: A.GAMBLE	
							TOWN DIRECTIONAL TOTALS		243.9	0.0	25.0	2.0	2.0	65	0.0	0.0	28	420.0			4	364.8				PLOT DATE: 5/2/2011			
																								DRAWN BY: D.CROSSLEY					
																							CHECKED BY: QAU						
																							THETFORD U.S. 5 NORTHBOUND 9						
																							SHEET 27 OF 65						

DIRECTION	MILEPOINT	LOCATION CODE (SHEET 2)	SIGN CODE	WIDTH (IN)	HEIGHT (IN)	SHEETING REMARKS	SIGN LEGEND	NEW SIGNS		EXISTING SIGNS				EXIST POST		NUMBER OF NEW SQUARE STEEL POSTS	SQUARE STEEL (IN)			TUBULAR STEEL Ø (IN)				SIGN FRAME REQUIRED	REMARKS	SIGN DETAIL LOCATION			
								"A"	"B"	RETAIN	SALVAGE FROM	SALVAGE TO	REMOVE	RETAIN	REMOVE		1.75	2.00	2.50	FOUNDATION	3.00	3.50	4.00			5.00	SHSM	PROJECT SHEET #	STANDARD SHEET #
																	(LB / FT)				(LB / FT)								
																	1.88	2.42	3.35		7.60	9.00	10.80			14.60			
THETFORD US 5 NB							FY-FLUORESCENT YELLOW FYG-FLUORESCENT YELLOW GREEN															"SHSM"-STANDARD HIGHWAY SIGNS AND MARKINGS							
		A	W13-1	18	18		20 MPH PLAQUE			1																			
NB	5.316	A	W1-6	48	24		<=== LEFT LARGE ARROW			1				X															
NB	5.316	C	W1-6	48	24		RIGHT ==> LARGE ARROW			1				X															
NB	5.323	C	VR-017	24	30		LLL 24,000 LBS			1				X									BRIDGE ROAD TH-19						
NB	5.328	D	R1-1	30	30		STOP			1				X									BRIDGE ROAD TH-19						
NB	5.329	A	W1-6	48	24		<=== LEFT LARGE ARROW			1				X															
NB	5.331	B	W1-6	48	24		RIGHT ==> LARGE ARROW			1				X															
NB	5.337	D	R1-1	30	30		STOP			1				X															
NB	5.359	A	M3-1	24	12		NORTH						1		X														
		A	M1-4	24	24		US 5						1																
NB	5.432	A	R2-1	24	30		SPEED LIMIT 35			1				X															
NB	5.619	A	R2-1	24	30		SPEED LIMIT 40			1				X															
NB	5.804	A	R2-1	24	30		SPEED LIMIT 50			1				X															
NB	6.180	A	W1-2R	30	30		RIGHT CURVE			1				X															
NB	7.200	A	VD-062B	72	16		BUSINESS SIGN			1				X															
SIGN SUMMARY SHEET							SHEET TOTALS		0.00	0.00	13	0	0	2	0	0	0	0			0	0	0	0	PROJECT NAME: NORWICH - FAIRLEE				
									SF	SF	EA	EA	EA	EA	EA	EA	EA	FT			EA	LB	LB	LB	LB	PROJECT NUMBER: STPG SIGN (34)			
																										FILE NAME: 10C334			
							VERMONT AGENCY OF TRANSPORTATION																				PLOT DATE: 5/2/2011		
							TOWN DIRECTIONAL TOTALS		243.9	0.0	25.0	2.0	2.0	65	0.0	0.0	28	420.0			4	364.8				PROJECT MANAGER: A.GAMBLE			
																										DRAWN BY: D.CROSSLEY			
																										CHECKED BY: QAU			
																										THETFORD U.S. 5 NORTHBOUND 10			
																										SHEET 28 OF 65			

THIS PAGE INTENTIONALLY LEFT BLANK

DIRECTION	MILEPOINT	LOCATION CODE (SHEET 2)	SIGN CODE	WIDTH (IN)	HEIGHT (IN)	SHEETING REMARKS	SIGN LEGEND	NEW SIGNS		EXISTING SIGNS				EXIST POST		NUMBER OF NEW SQUARE STEEL POSTS	SQUARE STEEL (IN)			TUBULAR STEEL Ø (IN)					SIGN FRAME REQUIRED	REMARKS	SIGN DETAIL LOCATION					
								"A"	"B"	RETAIN	SALVAGE FROM	SALVAGE TO	REMOVE	RETAIN	REMOVE		1.75	2.00	2.50	FOUNDATION	3.00	3.50	4.00	5.00			SHSM	PROJECT SHEET #	STANDARD SHEET #			
																	(LB / FT)				(LB / FT)											
																	1.88	2.42	3.35		7.60	9.00	10.80	14.60								
THETFORD US 5 SB																						"SHSM"-STANDARD HIGHWAY SIGNS AND MARKINGS										
SB	7.633	F	R2-1	24	30		SPEED LIMIT 50			1				X									THINNING AND TRIMMING									
SB	6.400	F	W1-2L	30	30		LEFT CURVE			1				X																		
SB	6.300	F	W2-2MR	30	30		SIDE ROAD RIGHT			1				X																		
		F	W16-8A	18	8		CLAY RD			1																						
SB	6.210	G	VR-017	24	30		LEGAL LOAD LIMIT 24,000 POUNDS						1		X								CLAY RD TH-16									
		G	VR-017	24	30			5.00								1		X					THINNING AND TRIMMING			E-141						
SB	6.210	H	R1-1	30	30		STOP						1		X								CLAY RD TH-16									
		H	R1-1	30	30		0050 1411 0292	6.25		1	1	1				1		X					WITH MILEMARKER	X								
SB	6.017	F	VW-054R	30	30		HIDDEN DRIVE RIGHT				1	1	1	X	X	1							POST WAS DAMAGED. IT WAS REPLACED.									
SB	5.964	F	W3-5	36	36		SPEED REDUCTION SL 40			1				X																		
SB	5.804	F	R2-1	24	30		SPEED LIMIT 40						1	X																		
		F	R2-1	30	36			7.50																X								
SB	5.706	F	VD-018	30	18		NORTH THETFORD E. THETFORD 2			1				X																		
SB	5.606	F	R2-1	30	36		SPEED LIMIT 35			1				X									THINNING AND TRIMMING									
SB	5.390	F	W1-1R	36	36		RIGHT TURN			1				X																		
SIGN SUMMARY SHEET							SHEET TOTALS		18.75	0.00	8	2 1	2 4	5 4	0	0	2	30			0	0.0	0.0	0.0	0.0	PROJECT NAME: NORWICH - FAIRLEE PROJECT NUMBER: STPG SIGN (34)						
									SF	SF	EA	EA	EA	EA	EA	EA	EA		FT		EA	LB	LB	LB	LB	FILE NAME: 10C334 PROJECT MANAGER A.GAMBLE			PLOT DATE: 5/2/2011 DRAWN BY: D.CROSSLEY			
																											DESIGNED BY: D.CROSSLEY THETFORD US 5 SOUTHBOUND 1			CHECKED QAU SHEET 30 OF 65		
							TOWN DIRECTIONAL TOTALS		245.6	0.0	26	3	3	61	0	0	29	435.0			4	364.8										
VERMONT AGENCY OF TRANSPORTATION																																

DIRECTION	MILEPOINT	LOCATION CODE (SHEET 2)	SIGN CODE	WIDTH (IN)	HEIGHT (IN)	SHEETING REMARKS	SIGN LEGEND	NEW SIGNS		EXISTING SIGNS				EXIST POST		NUMBER OF NEW SQUARE STEEL POSTS	SQUARE STEEL (IN)			TUBULAR STEEL Ø (IN)				SIGN FRAME REQUIRED	REMARKS	SIGN DETAIL LOCATION					
								"A"	"B"	RETAIN	SALVAGE FROM	SALVAGE TO	REMOVE	RETAIN	REMOVE		1.75	2.00	2.50	FOUNDATION	3.00	3.50	4.00			5.00	SHSM	PROJECT SHEET #	STANDARD SHEET #		
																	(LB / FT)				(LB / FT)										
																	1.88	2.42	3.35		7.60	9.00	10.80			14.60					
THETFORD US 5 SB							FY-FLUORESCENT YELLOW FYG-FLUORESCENT YELLOW GREEN															"SHSM"-STANDARD HIGHWAY SIGNS AND MARKINGS									
		F	W13-1	18	18		20 MPH PLAQUE			1				X																	
SB	5.265	F	M3-3	24	12		SOUTH						1		X																
		F	M1-4	24	24		US 5						1																		
SB	5.225	G	VR-017	24	30		LLL 24,000 LBS			1				X										CIDER MILL RD TH-16							
SB	5.215	H	R1-1	30	30		STOP			1				X										CIDER MILL RD TH-16 - ISLAND							
SB	5.205	H	R1-1	30	30		STOP			1				X										CIDER MILL RD TH-16							
SB	5.184	F	R2-1	24	30		SPEED LIMIT 40			1				X																	
SB	5.032	F	W1-10L	30	30		LEFT CURVE			1				X																	
SB	5.032	F	W16-8A	18	8		LATHAM RD			1				X																	
SB	4.963	F	W1-6	48	24		LEFT <=== LARGE ARROW			1				X																	
SB	4.962	E	W1-6	48	24		RIGHT ==> LARGE ARROW			1				X																	
SB	4.901	G	VR-017	24	30		LLL 24,000 LBS			1				X										LATHAM RD TH-5							
SB	4.901	H	R1-1	30	30		STOP			1				X										LATHAM RD TH-5							
SB	4.763	F	R2-1	24	30		SPEED LIMIT 50			1				X																	
SB	3.750	F	D9-1	24	24		PHONE						1		X																
SIGN SUMMARY SHEET							SHEET TOTALS		0.00	0.00	12	0	0	3	0	0	0	0			0	0.0	0.0	0.0	0.0	PROJECT NAME: NORWICH - FAIRLEE					
									SF	SF	EA	EA	EA	EA	EA	EA		FT		EA	LB		LB	LB	LB	PROJECT NUMBER: STPG SIGN (34)					
																										FILE NAME 10C334			PLOT DATE: 5/2/2011		
							VERMONT AGENCY OF TRANSPORTATION																				PROJECT MANAGER A.GAMBLE			DRAWN BY: D.CROSSLEY	
							TOWN DIRECTIONAL TOTALS		245.6	0.0	26	3	3	61	0	0	29	435.0			4	364.8				DESIGNED BY: D.CROSSLEY			CHECKED QAU		
																								THETFORD US 5 SOUTHBOUND 2			SHEET 31 OF 65				

DIRECTION	MILEPOINT	LOCATION CODE (SHEET 2)	SIGN CODE	WIDTH (IN)	HEIGHT (IN)	SHEETING REMARKS	SIGN LEGEND	NEW SIGNS		EXISTING SIGNS			EXIST POST		NUMBER OF NEW SQUARE STEEL POSTS	SQUARE STEEL (IN)			TUBULAR STEEL Ø (IN)					SIGN FRAME REQUIRED	REMARKS	SIGN DETAIL LOCATION						
								"A"	"B"	RETAIN	SALVAGE FROM	SALVAGE TO	REMOVE	RETAIN		REMOVE	1.75 2.00 2.50			FOUNDATION	3.00 3.50 4.00 5.00					SHSM	PROJECT SHEET #	STANDARD SHEET #				
																	(LB / FT)				(LB / FT)											
																	1.88	2.42	3.35		7.60	9.00	10.80						14.60			
THETFORD US 5 SB							FY-FLUORESCENT YELLOW FYG-FLUORESCENT YELLOW GREEN															"SHSM"-STANDARD HIGHWAY SIGNS AND MARKINGS										
		F	W16-9P	24	8		AHEAD						1																			
SB	3.670	G	VR-017	24	30		LEGAL LOAD LIMIT 24,000 POUNDS						1		X									SANBORN RD TH 35								
			VR-017	24	30			5.00						1		X										E-141						
SB	3.670	H	R1-1	30	30		STOP			1				X										SANBORN RD TH 35								
SB	3.520	F	R2-5A	24	30		↑ SPEED LIMIT 40 REDUCED SPEED AHEAD						1		X																	
		F	W3-5	36	36			9.00						2		X									X							
SB	3.460	F	VD-018	30	18		East Thetford Pompanoosuc 5						1		X																	
		F	VD-018	30	18			3.75						1		X									5							
SB	3.420	F	VD-062AS	72	16		BUSINESS SIGN			1				X																		
SB	3.400	F	W7-1B	30	30		SPEED LIMIT 40 STEEP GRADE 8%						1		X																	
		F	R2-1	30	36			7.50						1		X									X							
SB	3.370	F	R2-1	24	30		TRUCK 8% SPEED LIMIT 40						1		X																	
		F	W7-1A	30	30			6.25						1		X									X							
SB	3.280	F	R2-5A	24	30		↑ SPEED LIMIT 30 REDUCED SPEED AHEAD						1		X																	
		F	W3-5	36	36			9.00						2		X										X						
SIGN SUMMARY SHEET							SHEET TOTALS		40.50	0.00	2	0	0	7	0	0	8	120			0	0.0	0.0	0.0	0.0	PROJECT NAME: NORWICH - FAIRLEE						
									SF	SF	EA	EA	EA	EA	EA	EA	EA	FT			EA	LB	LB	LB	LB	PROJECT NUMBER: STPG SIGN (34)						
							VERMONT AGENCY OF TRANSPORTATION		TOWN DIRECTIONAL TOTALS		245.6	0.0	26	3	3	61	0	0	29	435.0			4	364.8			FILE NAME: 10C334			PLOT DATE: 5/2/2011		
																											PROJECT MANAGER: A.GAMBLE			DRAWN BY: D.CROSSLEY		
																								DESIGNED BY: D.CROSSLEY			CHECKED: QAU					
																								THETFORD US 5 SOUTHBOUND 3			SHEET 32 OF 65					

DIRECTION	MILEPOINT	LOCATION CODE (SHEET 2)	SIGN CODE	WIDTH (IN)	HEIGHT (IN)	SHEETING REMARKS	SIGN LEGEND	NEW SIGNS		EXISTING SIGNS				EXIST POST		NUMBER OF NEW SQUARE STEEL POSTS	SQUARE STEEL (IN)			TUBULAR STEEL Ø (IN)				SIGN FRAME REQUIRED	REMARKS	SIGN DETAIL LOCATION					
								"A"	"B"	RETAIN	SALVAGE FROM	SALVAGE TO	REMOVE	RETAIN	REMOVE		1.75	2.00	2.50	FOUNDATION	3.00	3.50	4.00			5.00	SHSM	PROJECT SHEET #	STANDARD SHEET #		
																	(LB / FT)				(LB / FT)										
																	1.88	2.42	3.35		7.60	9.00	10.80			14.60					
THETFORD US 5 SB																						"SHSM"-STANDARD HIGHWAY SIGNS AND MARKINGS									
SB	3.210	F	R2-1	24	30								1		X																
		F	R2-1	30	36			7.50								1		X								X					
SB	3.175	F	M2-1	21	15								1		X																
		F	M1-5A	30	24								1																		
		F	M2-1	21	15			2.19								1		X							GREEN ON WHITE	X					
		F	M1-5	30	24			5.00																				E-136B			
SB	3.140	F	R2-1	24	30		SPEED LIMIT 30						1		X																
		F	M4-14	24	12			2.00								1		X							BLACK ON WHITE	X					
		F	R8-3	24	24			4.00																		X					
SB	3.115	F	R2-1	24	30			5.00								1		X							INSTALL 130'+/- SOUTH OF ORIGINAL SIGN LOCATION	X					
SB	3.088	F	D1-1	72	10		D-BOARD ASSEMBLY						1		X																
		F	D1-1A	72	10								1																		
		F	D1-1 A	72	10								1																		
		F	D1-1A	72	10								1																		
		F	D1-1A	72	10								1																		
SIGN SUMMARY SHEET							SHEET TOTALS		25.69	0.00	0	0	0	9	0	0	4	60			0	0.0	0.0	0.0	0.0	PROJECT NAME: NORWICH - FAIRLEE					
									SF	SF	EA	EA	EA	EA	EA	EA	EA		FT		EA	LB	LB	LB	LB	PROJECT NUMBER: STPG SIGN (34)					
																										FILE NAME 10C334			PLOT DATE: 5/2/2011		
							VERMONT AGENCY OF TRANSPORTATION																			PROJECT MANAGER A.GAMBLE			DRAWN BY: D.CROSSLEY		
							TOWN DIRECTIONAL TOTALS		245.6	0.0	26	3	3	61	0	0	29	435.0			4	364.8				DESIGNED BY: D.CROSSLEY			CHECKED QAU		
																										THETFORD US 5 SOUTHBOUND 4			SHEET 33 OF 65		

DIRECTION	MILEPOINT	LOCATION CODE (SHEET 2)	SIGN CODE	WIDTH (IN)	HEIGHT (IN)	SHEETING REMARKS	SIGN LEGEND	NEW SIGNS		EXISTING SIGNS				EXIST POST		NUMBER OF NEW SQUARE STEEL POSTS	SQUARE STEEL (IN)			TUBULAR STEEL Ø (IN)				SIGN FRAME REQUIRED	REMARKS	SIGN DETAIL LOCATION		
								"A"	"B"	RETAIN	SALVAGE FROM	SALVAGE TO	REMOVE	RETAIN	REMOVE		1.75	2.00	2.50	3.00	3.50	4.00	5.00					
																	(LB / FT)			(LB / FT)								
																	1.88	2.42	3.35	FOUNDATION	7.60	9.00	10.80			14.60		
THETFORD US 5 SB																						"SHSM"-STANDARD HIGHWAY SIGNS AND MARKINGS						
		F	VD1-1A	72	12		↑ Norwich 10 ← Lyme N.H. Chelsea 23 →	6.00							2		X									4		
		F	VD1-1A	72	12			6.00																	4			
		F	VD1-1A	72	12			6.00																	4			
SB	3.080	G	R8-3	24	24		Ⓜ	4.00							1		X							INSTALL 20' +/- SOUTH OF CATCH BASIN AT N.E. CORNER OF "WING'S MARKET"	X			
SB	3.060	F	M3-3	24	12		ROUTE MARKER ASSEMBLY						1		X													
		F	M1-4	24	24								1															
		F	M3-2	24	12								1															
		F	M1-5A	30	24								1															
		F	M6-3	21	15								1															
		F	M3-4	24	12								1															
		F	M1-5A	30	24								1															
		F	M6-1	21	15								1															
		F	M4-5	24	12								1															
		F	M1-1	24	24								1															
		F	M6-1	21	15								1															
SIGN SUMMARY SHEET							SHEET TOTALS	22.00	0.00	0	0	0	11	0	0	3	45			0	0.0	0.0	0.0	0.0	PROJECT NAME: NORWICH - FAIRLEE			
								SF	SF	EA	EA	EA	EA	EA	EA	EA		FT		EA	LB	LB	LB	LB	PROJECT NUMBER: STPG SIGN (34)			
																								FILE NAME 10C334				
																								PROJECT MANAGER A.GAMBLE				
																								DESIGNED BY: D.CROSSLEY				
																								THETFORD US 5 SOUTHBOUND 5				
																								PLOT DATE: 5/2/2011				
																								DRAWN BY: D.CROSSLEY				
																								CHECKED QAU				
																								SHEET 34 OF 65				
VERMONT AGENCY OF TRANSPORTATION							TOWN DIRECTIONAL TOTALS	245.6	0.0	26	3	3	61	0	0	29	435.0			4	364.8							

DIRECTION	MILEPOINT	LOCATION CODE (SHEET 2)	SIGN CODE	WIDTH (IN)	HEIGHT (IN)	SHEETING REMARKS	SIGN LEGEND	NEW SIGNS		EXISTING SIGNS				EXIST POST		NUMBER OF NEW SQUARE STEEL POSTS	SQUARE STEEL (IN)			TUBULAR STEEL Ø (IN)					SIGN FRAME REQUIRED	REMARKS	SIGN DETAIL LOCATION								
								"A"	"B"	RETAIN	SALVAGE FROM	SALVAGE TO	REMOVE	RETAIN	REMOVE		1.75	2.00	2.50	FOUNDATION	3.00	3.50	4.00	5.00			SHSM	PROJECT SHEET #	STANDARD SHEET #						
																	(LB / FT)				(LB / FT)														
																	1.88	2.42	3.35		7.60	9.00	10.80	14.60											
THETFORD US 5 SB																							"SHSM"-STANDARD HIGHWAY SIGNS AND MARKINGS												
		F	M3-3	24	12		SOUTH WEST 5 113 SEE STANDARD E-136B ↑ → EAST TO 113 91 ↙ →	2.00																	2	182.4				2 - 2A	BLACK ON WHITE	X			
		F	M1-4	24	24			4.00																			X								
		F	M6-3	21	15			2.19																			X								
		F	M3-2	24	12			2.00																			X								
		F	M1-5A M1-6	30	24			5.00																					E-136C						
		F	M5-1	21	15			2.19																			X								
		F	M3-4	24	12			2.00																			X								
		F	M1-5A M1-6	30	24			5.00																					E-136C						
		F	M6-1	21	15			2.19																			X								
		F	M4-5	24	12			2.00																			X								
		F	M1-1	24	24			4.00																			X								
		F	M6-1	21	15			2.19																			X								
SB	3.055	F	R8-3A	24	24		NO PARKING						1		X																				
		F	VR-644	24	12		BEGIN						1																						
SB	3.013	F	D1-1M	72	10		D-BOARD AND ROUTE MARKER ASSEMBLY						1		X																				
SIGN SUMMARY SHEET							SHEET TOTALS		34.76	0.00	0	0	0	3	0	0	0	0			2	182.4	0.0	0.0	0.0	PROJECT NAME: NORWICH - FAIRLEE			PROJECT NUMBER: STPG SIGN (34)						
									SF	SF	EA	EA	EA	EA	EA	EA	EA		FT		EA	LB	LB	LB	LB				FILE NAME: 10C334			PLOT DATE: 5/2/2011			
																														PROJECT MANAGER A.GAMBLE			DRAWN BY: D.CROSSLEY		
							VERMONT AGENCY OF TRANSPORTATION																							DESIGNED BY: D.CROSSLEY			CHECKED QAU		
							TOWN DIRECTIONAL TOTALS		245.6	0.0	26	3	3	61	0	0	29	435.0			4	364.8				THETFORD US 5 SOUTHBOUND 6			SHEET 35 OF 65						

DIRECTION	MILEPOINT	LOCATION CODE (SHEET 2)	SIGN CODE	WIDTH (IN)	HEIGHT (IN)	SHEETING REMARKS	SIGN LEGEND	NEW SIGNS		EXISTING SIGNS				EXIST POST		NUMBER OF NEW SQUARE STEEL POSTS	SQUARE STEEL (IN)			TUBULAR STEEL Ø (IN)					SIGN FRAME REQUIRED	REMARKS	SIGN DETAIL LOCATION		
								"A"	"B"	RETAIN	SALVAGE FROM	SALVAGE TO	REMOVE	RETAIN	REMOVE		1.75	2.00	2.50	FOUNDATION	3.00	3.50	4.00	5.00			SHSM	PROJECT SHEET #	STANDARD SHEET #
																	(LB / FT)				(LB / FT)								
																	1.88	2.42	3.35		7.60	9.00	10.80	14.60					
THETFORD US 5 SB																							"SHSM"-STANDARD HIGHWAY SIGNS AND MARKINGS						
		F	M3-2	24	12		↑ Pompanoosuc5 ↑ Norwich10 ← Lyme N.H. EAST VERMONT113 ←					1																	
		F	M1-5A	30	24							1																	
		F	M6-1	21	15							1																	
		F	VD1-1A	72	12			6.00									2	182.4							THINNING AND TRIMMING		4		
		F	VD1-1A	72	12			6.00																		4			
		F	VD1-1	72	12			6.00																		4			
		F	M3-2	24	12			2.00																	GREEN ON WHITE	X			
		F	M1-5A	30	24			5.00																			E-136B		
		F	M6-1	21	15		2.19																	GREEN ON WHITE	X				
SB	2.987	F	R8-3	24	24		NO PARKING	4.00		←			1	X											X				
			M4-6	24	12		END						1											OLD SIGN WAS REPLACED					
SB	2.950	F	W10-3L	36	36		SIDE ROAD WARNING WITH TRACKS			1				X															
	2.945	F	VR-020	24	30		NO PARKING ON TRAVELED LANES						1		X														
			R2-1	24	30		SPEED LIMIT30	5.00								1		X								X			
			R8-3	24	24		Ⓡ	4.00																		X			
SIGN SUMMARY SHEET							SHEET TOTALS		40.19 36.19	0.00	1 2-	0	0	6 5-	0	0	1	15			2	182.4	0.0	0.0	0.0	PROJECT NAME: NORWICH - FAIRLEE			
									SF	SF	EA	EA	EA	EA	EA	EA	EA		FT		EA	LB	LB	LB	LB	PROJECT NUMBER: STPG SIGN (34)			
																										FILE NAME: 10C334			
							VERMONT AGENCY OF TRANSPORTATION																				PROJECT MANAGER A.GAMBLE		
							TOWN DIRECTIONAL TOTALS		245.6	0.0	26	3	3	61	0	0	29	435.0			4	364.8				PLOT DATE: 5/2/2011			
																										DRAWN BY: D.CROSSLEY			
																										CHECKED QAU			
																				THETFORD US 5 SOUTHBOUND 7				SHEET 36 OF 65					

DIRECTION	MILEPOINT	LOCATION CODE (SHEET 2)	SIGN CODE	WIDTH (IN)	HEIGHT (IN)	SHEETING REMARKS	SIGN LEGEND	NEW SIGNS		EXISTING SIGNS				EXIST POST		NUMBER OF NEW SQUARE STEEL POSTS	SQUARE STEEL (IN)			TUBULAR STEEL Ø (IN)				SIGN FRAME REQUIRED	REMARKS	SIGN DETAIL LOCATION			
								"A"	"B"	RETAIN	SALVAGE FROM	SALVAGE TO	REMOVE	RETAIN	REMOVE		1.75	2.00	2.50	FOUNDATION	3.00	3.50	4.00			5.00	SHSM	PROJECT SHEET #	STANDARD SHEET #
																	(LB / FT)				(LB / FT)								
																	1.88	2.42	3.35		7.60	9.00	10.80			14.60			
THETFORD US 5 SB							FY-FLUORESCENT YELLOW FYG-FLUORESCENT YELLOW GREEN															"SHSM"-STANDARD HIGHWAY SIGNS AND MARKINGS							
SB	2.935	F	R2-1	24	30		SPEED LIMIT 30						1		X														
		F	VR-020	24	30		NO PARKING ON TRAVELED LANES						1																
		F	M4-6	24	12		END	2.00						1			X						BLACK ON WHITE	X					
		F	R8-3	24	24		R	4.00																X					
SB	2.900	F	M3-3	24	12								1		X														
		F	M1-4	24	24								1																
		F	M3-3	24	12		SOUTH	2.00						1			X						BLACK ON WHITE	X					
		F	M1-4	24	24		5	4.00																X					
		F	VM-120	18	24		CONNECTICUT RIVER BYWAY				1	1	1										INSTALL BELOW ROUTE MARKER						
		F	D6-4A	18	9		AMERICA'S BYWAYS				1	1	1										INSTALL BELOW CT. RIVER BYWAY						
SB	2.860	F	D2-1	72	10								1		X														
		F	D2-1	72	10								1																
		F	VD2-1	72	12		Norwich 10	6.00								2		X							4				
		F	VD2-1	72	12		White River Jct 15	6.00																	4				
SB	2.800	F	R2-1	24	30								1		X														
SIGN SUMMARY SHEET							SHEET TOTALS	24.00	0.00	0	2	2	9	0	0	4	60			0	0.0	0.0	0.0	0.0	PROJECT NAME: NORWICH - FAIRLEE				
								SF	SF	EA	EA	EA	EA	EA	EA	EA		FT		EA	LB	LB	LB	LB	PROJECT NUMBER: STPG SIGN (34)				
																									FILE NAME 10C334				
							VERMONT AGENCY OF TRANSPORTATION																		PROJECT MANAGER A.GAMBLE				
TOWN DIRECTIONAL TOTALS								245.6	0.0	26	3	3	61	0	0	29	435.0			4	364.8				DESIGNED BY: D.CROSSLEY				
																							PLOT DATE: 5/2/2011						
																							DRAWN BY: D.CROSSLEY						
																							CHECKED QAU						
																							SHEET 37 OF 65						
																							THETFORD US 5 SOUTHBOUND 8						

DIRECTION	MILEPOINT	LOCATION CODE (SHEET 2)	SIGN CODE	WIDTH (IN)	HEIGHT (IN)	SHEETING REMARKS	SIGN LEGEND	NEW SIGNS		EXISTING SIGNS				EXIST POST		NUMBER OF NEW SQUARE STEEL POSTS	SQUARE STEEL (IN)			TUBULAR STEEL Ø (IN)					SIGN FRAME REQUIRED	REMARKS	SIGN DETAIL LOCATION						
								"A"	"B"	RETAIN	SALVAGE FROM	SALVAGE TO	REMOVE	RETAIN	REMOVE		1.75	2.00	2.50	FOUNDATION	3.00	3.50	4.00	5.00			SHSM	PROJECT SHEET #	STANDARD SHEET #				
																					(LB / FT)									(LB / FT)			
																					1.88	2.42	3.35	7.60						9.00	10.80	14.60	
THETFORD US 5 SB							FY-FLUORESCENT YELLOW FYG-FLUORESCENT YELLOW GREEN																"SHSM"-STANDARD HIGHWAY SIGNS AND MARKINGS										
		F	R2-1	24	30			5.00							1		X								X								
SB	2.760	F	VR-048	24	30		STATE LAW STOP FOR SCHOOL BUS						1		X																		
SB	2.710	F	VR-023B	24	30		\$500 FINE FOR THROWING TRASH						1		X																		
SB	2.680	F	R2-1	24	30		 						1		X																		
		F	W16-18P	24	12	FY		2.00							1		X									5							
		F	R2-1	24	30			5.00																	X								
		F	R2-5P	24	18			3.00																	X								
SB	2.640	F	VR-654	24	24		NO DWI						1		X																		
		F	VR-655	24	18		STRICTLY ENFORCED						1																				
SB	2.160	F	W10-2L	30	30		RAILROAD CROSSING				1			X																			
SB	1.960	G	VR-017	24	30		LLL 24,000 LBS				1			X											VAUGH FARMS RD TH-45								
SB	1.960	H	R1-1	30	30								1		X																		
SB	1.960	H	R1-1	30	30			6.25									1		X						X								
SB	1.690	G	VR-017	24	30								1		X											QUAIL JOHN RD TH- 58							
		G	VR-017	24	30			5.00									1		X							E-141							
SIGN SUMMARY SHEET							SHEET TOTALS		26.25	0.00	2	0	0	7	0	0	4	60		0	0.0	0.0	0.0	0.0	PROJECT NAME: NORWICH - FAIRLEE								
									SF	SF	EA	EA	EA	EA	EA	EA		FT		EA	LB	LB	LB	LB	PROJECT NUMBER: STPG SIGN (34)								
																							FILE NAME 10C334					PLOT DATE: 5/2/2011					
																							PROJECT MANAGER A.GAMBLE					DRAWN BY: D.CROSSLEY					
VERMONT AGENCY OF TRANSPORTATION																							DESIGNED BY: D.CROSSLEY					CHECKED QAU					
																							THETFORD US 5 SOUTHBOUND 9					SHEET 38 OF 65					
TOWN DIRECTIONAL TOTALS							245.6	0.0	26	3	3	61	0	0	29	435.0		4	364.8														

DIRECTION	MILEPOINT	LOCATION CODE (SHEET 2)	SIGN CODE	WIDTH (IN)	HEIGHT (IN)	SHEETING REMARKS	SIGN LEGEND	NEW SIGNS		EXISTING SIGNS				EXIST POST		NUMBER OF NEW SQUARE STEEL POSTS	SQUARE STEEL (IN)			TUBULAR STEEL Ø (IN)				SIGN FRAME REQUIRED	REMARKS	SIGN DETAIL LOCATION		
								"A"	"B"	RETAIN	SALVAGE FROM	SALVAGE TO	REMOVE	RETAIN	REMOVE		1.75	2.00	2.50	FOUNDATION	3.00	3.50	4.00			5.00		
																	(LB / FT)				(LB / FT)							
																	1.88	2.42	3.35		7.60	9.00	10.80			14.60		
THETFORD US 5 SB							FY-FLUORESCENT YELLOW FYG-FLUORESCENT YELLOW GREEN															"SHSM"-STANDARD HIGHWAY SIGNS AND MARKINGS						
SB	1.690	H	R1-1	30	30								1		X								QUAIL JOHN RD TH- 58					
		H	R1-1	30	30			6.25		1	1	1			1		X						WITH MILE MARKER	X				
SB	0.830	G	VR-017	24	24								1		X								RABBIT RD TH- 60					
		G	VR-017	24	30			5.00						1		X									E-141			
SB	0.830	H	R1-1	24	24								1		X								RABBIT RD TH- 60					
		H	R1-1	30	30			6.25		2	2	2			1		X						WITH STREET SIGN AND MILE MARKER	X				
SIGN SUMMARY SHEET							SHEET TOTALS		17.50	0.00	0	30	30	63	0	0	3	45		0	0.0	0.0	0.0	0.0	PROJECT NAME: NORWICH - FAIRLEE PROJECT NUMBER: STPG SIGN (34)			
							SF	SF	EA	EA	EA	EA	EA	EA	EA		FT		EA	LB	LB	LB	LB	FILE NAME: 10C334 PROJECT MANAGER A.GAMBLE DESIGNED BY: D.CROSSLEY THETFORD US 5 SOUTHBOUND 10		PLOT DATE: 5/2/2011 DRAWN BY: D.CROSSLEY CHECKED QAU SHEET 39 OF 65		
							TOWN DIRECTIONAL TOTALS		245.6	0.0	26	3	3	61	0	0	29	435.0		4	364.8							


DIRECTION	MILEPOINT	LOCATION CODE (SHEET 2)	SIGN CODE	WIDTH (IN)	HEIGHT (IN)	SHEETING REMARKS	SIGN LEGEND	NEW SIGNS		EXISTING SIGNS				EXIST POST		NUMBER OF NEW SQUARE STEEL POSTS	SQUARE STEEL (IN)			TUBULAR STEEL Ø (IN)					SIGN FRAME REQUIRED	REMARKS	SIGN DETAIL LOCATION		
								"A"	"B"	RETAIN	SALVAGE FROM	SALVAGE TO	REMOVE	RETAIN	REMOVE		1.75	2.00	2.50	FOUNDATION	3.00	3.50	4.00	5.00					
																	(LB / FT)				(LB / FT)								
																	1.88	2.42	3.35		7.60	9.00	10.80	14.60					
FAIRLEE US 5 NB																						"SHSM"-STANDARD HIGHWAY SIGNS AND MARKINGS							
NB	0.000	C	VD-024	72	10		FAIRLEE/THETFORD																						
		C	VD-700	6	10		2 - MILE MARKERS																						
		C	VD-024	72	10 12		Fairlee Thetford	5.00 6.00								2		X								4			
		C	VD-700	6	10		0050 0906 0000 0050 0911 0768	0.42																			E-138		
		C	VD-700	6	10			0.42																			E-138		
NB	0.020	A	W10-3R	36	36		RAILROAD CROSSING			1				X															
NB	0.060	A	VD-018	30	18		Ely Fairlee 3						1		X														
		A	VD-018	30	18		LEGAL LOAD LIMIT 24,000 POUNDS	3.75								1		X								5			
NB	0.095	C	VR-017	24	30			5.00								1		X						ELY RD TH-2			E-141		
NB	0.100	E	VR-017	24	24		LLL, 2400																	ELY RD TH-2					
NB	0.100	D	R1-1	30	30		STOP ELY RD																	ELY RD TH-2					
		D	R1-1	30	30			6.25			1	1	1			1		X					WITH STREET SIGN	X					
NB	0.220	A	M2-1	21	15		0050 0906 0022																						
		A	M1-5A	30	24		JCT VERMONT 244																						
		A	M2-1	21	15			2.19			1	1	1			1		X						GREEN ON WHITE	X				
SIGN SUMMARY SHEET							SHEET TOTALS		23.03 24.03	0.00	1	2 0	2 0	10 8	0	0	6	90			0	0	0	0	0	PROJECT NAME: NORWICH - FAIRLEE			
									SF	SF	EA	EA	EA	EA	EA	EA	EA	FT			EA	LB	LB	LB	LB	PROJECT NUMBER: STPG SIGN (34)			
																										FILE NAME: 10C334			
							VERMONT AGENCY OF TRANSPORTATION																				PLOT DATE: 5/2/2011		
							TOWN DIRECTIONAL TOTALS		343.6	0.0	9.0	4.0	4.0	90	0.0	0.0	51	765.0			0	0.0				DRAWN BY: D.CROSSLEY			
																								DESIGNED BY: D.CROSSLEY					
																								FAIRLEE US 5 NORTHBOUND 1					
																								CHECKED BY: QAU					
																								SHEET 40 OF 65					

DIRECTION	MILEPOINT	LOCATION CODE (SHEET 2)	SIGN CODE	WIDTH (IN)	HEIGHT (IN)	SHEETING REMARKS	SIGN LEGEND	NEW SIGNS		EXISTING SIGNS				EXIST POST		NUMBER OF NEW SQUARE STEEL POSTS	SQUARE STEEL (IN)			TUBULAR STEEL Ø (IN)				SIGN FRAME REQUIRED	REMARKS	SIGN DETAIL LOCATION			
								"A"	"B"	RETAIN	SALVAGE FROM	SALVAGE TO	REMOVE	RETAIN	REMOVE		(LB / FT)			FOUNDATION	(LB / FT)					SHSM	PROJECT SHEET NUMBER	STANDARD SHEET NUMBER	
																	1.75	2.00	2.50		3.00	3.50	4.00						5.00
FAIRLEE US 5 NB							FY-FLUORESCENT YELLOW FYG-FLUORESCENT YELLOW GREEN																"SHSM"-STANDARD HIGHWAY SIGNS AND MARKINGS						
		A	M1-5	30	24			5.00															WITH MILE MARKER			E-136B			
NB	0.270	A	D1-1A	72	10		D-BOARD ASSEMBLY						1		X														
		A	D1-1A	72	10								1																
		A	D1-1A	72	10								1																
		A	D1-1A	72	10								1																
		A	VD1-1A	72	12		↑ Fairlee3	6.00							2		X									4			
		A	VD1-1A	72	12		↑ Bradford9	6.00																		4			
		A	VD1-1A	72	12		← Lake Fairlee3	6.00																		4			
NB	0.310	A	M3-4	24	12		ROUTE MARKER ASSEMBLY						1		X														
		A	M1-5	30	24								1																
		A	M6-1	21	15								1																
		A	M3-1	24	12								1																
		A	M1-4	24	24								1																
		A	M6-3	21	15								1																
		A	M3-4	24	12			2.00							2		X					1A	GREEN ON WHITE	X					
SIGN SUMMARY SHEET							SHEET TOTALS		25.00	0.00	0	0	0	10	0	0	4	60	0	0	0	0	0	PROJECT NAME: NORWICH - FAIRLEE					
									SF	SF	EA	EA	EA	EA	EA	EA	EA	FT	EA	LB	LB	LB	LB	PROJECT NUMBER: STPG SIGN (34)					
																									FILE NAME: 10C334				
																										PLOT DATE: 5/2/2011			
VERMONT AGENCY OF TRANSPORTATION							TOWN DIRECTIONAL TOTALS		343.6	0.0	9.0	4.0	4.0	90	0.0	0.0	51	765.0	0	0.0				DESIGNED BY: A.GAMBLE					
																									DRAWN BY: D.CROSSLEY				
																						CHECKED BY: QAU							
																							FAIRLEE US 5 NORTHBOUND 2						
																							SHEET 41 OF 65						

DIRECTION	MILEPOINT	LOCATION CODE (SHEET 2)	SIGN CODE	WIDTH (IN)	HEIGHT (IN)	SHEETING REMARKS	SIGN LEGEND	NEW SIGNS		EXISTING SIGNS				EXIST POST		NUMBER OF NEW SQUARE STEEL POSTS	SQUARE STEEL (IN)			TUBULAR STEEL Ø (IN)				SIGN FRAME REQUIRED	REMARKS	SIGN DETAIL LOCATION			
								"A"	"B"	RETAIN	SALVAGE FROM	SALVAGE TO	REMOVE	RETAIN	REMOVE		1.75	2.00	2.50	FOUNDATION	3.00	3.50	4.00			5.00	SHSM	PROJECT SHEET NUMBER	STANDARD SHEET NUMBER
																	(LB / FT)				(LB / FT)								
																	1.88	2.42	3.35		7.60	9.00	10.80			14.60			
FAIRLEE US 5 NB							FY-FLUORESCENT YELLOW FYG-FLUORESCENT YELLOW GREEN															"SHSM"-STANDARD HIGHWAY SIGNS AND MARKINGS							
		A	M1-5	30	24		WEST VERMONT 244 ← NORTH 5 ↑	5.00																			E-136B		
		A	M6-1	21	15			2.19																GREEN ON WHITE	X				
		A	M3-1	24	12			2.00																BLACK ON WHITE	X				
		A	M1-4	24	24			4.00																	X				
		A	M6-3	21	15			2.19																	BLACK ON WHITE	X			
NB	0.350	A	M3-1	24	12		NORTH						1		X														
		A	M1-4	24	24		US 5						1																
NB	0.352	A	M3-1	24	12		NORTH 5	2.00							1		X								BLACK ON WHITE	X			
		A	M1-4	24	24			4.00																INSTALL 100' NORTH OF ORIGINAL LOCATION	X				
NB	0.620	A	VR-023B	24	30		\$500 FINE FOR THROWING TRASH						1		X										WITH MILE MARKER				
NB	1.260	A	N/A				LIONS INTERNATIONAL ASSEMBLY						3		X										REMOVE FROM ROW RETURN TO TOWN				
NB	1.660	A	S3-1	30	30		SCHOOL BUS STOP AHEAD			1				X															
NB	1.890	A	S3-1	30	30		SCHOOL BUS STOP AHEAD			1				X															
NB	1.940	C	VR-017	24	24		LEGAL LOAD LIMIT 24,000 POUNDS						1		X										BIRCH MEADOW RD TH-15				
		C	VR-017	24	30			5.00								1		X									E-141		
SIGN SUMMARY SHEET							SHEET TOTALS		26.38	0.00	2	0	0	7	0	0	2	30		0	0	0	0	0	PROJECT NAME: NORWICH - FAIRLEE				
									SF	SF	EA	EA	EA	EA	EA	EA	EA	FT		EA	LB	LB	LB	LB	PROJECT NUMBER: STPG SIGN (34)				
																									FILE NAME: 10C334				
							VERMONT AGENCY OF TRANSPORTATION																			PROJECT MANAGER: A.GAMBLE			
							TOWN DIRECTIONAL TOTALS		343.6	0.0	9.0	4.0	4.0	90	0.0	0.0	51	765.0		0	0.0				DESIGNED BY: D.CROSSLEY				
																								FAIRLEE US 5 NORTHBOUND 3					
																								PLOT DATE: 5/2/2011					
																								DRAWN BY: D.CROSSLEY					
																								CHECKED BY: QAU					
																								SHEET 42 OF 65					

DIRECTION	MILEPOINT	LOCATION CODE (SHEET 2)	SIGN CODE	WIDTH (IN)	HEIGHT (IN)	SHEETING REMARKS	SIGN LEGEND	NEW SIGNS		EXISTING SIGNS				EXIST POST		NUMBER OF NEW SQUARE STEEL POSTS	SQUARE STEEL (IN)			TUBULAR STEEL Ø (IN)					SIGN FRAME REQUIRED	REMARKS	SIGN DETAIL LOCATION		
								"A"	"B"	RETAIN	SALVAGE FROM	SALVAGE TO	REMOVE	RETAIN	REMOVE		1.75	2.00	2.50	FOUNDATION	3.00	3.50	4.00	5.00			SHSM	PROJECT SHEET NUMBER	STANDARD SHEET NUMBER
																	(LB / FT)				(LB / FT)								
																	1.88	2.42	3.35		7.60	9.00	10.80	14.60					
FAIRLEE US 5 NB																						"SHSM"-STANDARD HIGHWAY SIGNS AND MARKINGS							
NB	1.940	D	R1-1	30	30		STOP BIRCH MEADOW RD 0050 0906 0194						1		X									BIRCH MEADOW RD TH-15					
		D	R1-1	30	30			6.25		2	2	2				1		X						WITH STREET SIGN AND MILE MARKER	X				
NB	2.120	A	W3-5	36	36		SPEED REDUCTION AHEAD 40			1				X															
NB	2.160	A	VD-018	30	18		Fairlee Bradford 7	3.75					1		X			X								5			
		A	VD-018	30	18											1		X											
NB	2.220	A	R2-1	24	30		SPEED LIMIT 40	7.50					1		X			X								X			
		A	R2-1	30	36											1		X											
NB	2.375	D	R1-1	30	30		STOP			1				X										DUMP ROAD					
NB	2.400	A	R2-5A	24	30		↑ SPEED LIMIT 30 REDUCED SPEED AHEAD 0050 0906 0240	9.00					1		X											WITH MILE MARKER			
		A	W3-5	36	36					1	1	1				2		X							X				
NB	2.470	A	R2-1	24	30		SPEED LIMIT 30	7.50					1		X			X								X			
		A	R2-1	30	36											1		X											
NB	2.640	A	D1-1A	72	10								1		X														
NB	2.640	A	D1-1A	72	10		↑ Orford NH. 1 ← Lake Morey	6.00																					
		A	VD1-1A	72	12											2		X								4			
SIGN SUMMARY SHEET							SHEET TOTALS		40.00	0.00	2	30	30	107	0	0	8	120			0	0	0	0	0	PROJECT NAME: NORWICH - FAIRLEE			
									SF	SF	EA	EA	EA	EA	EA	EA	EA		FT		EA	LB	LB	LB	LB	PROJECT NUMBER: STPG SIGN (34)			
																										FILE NAME: 10C334			
																										PLOT DATE: 5/2/2011			
VERMONT AGENCY OF TRANSPORTATION							TOWN DIRECTIONAL TOTALS		343.6	0.0	9.0	4.0	4.0	90	0.0	0.0	51	765.0			0	0.0				DRAWN BY: D.CROSSLEY			
																									CHECKED BY: QAU				
																								DESIGNED BY: D.CROSSLEY					
																								FAIRLEE US 5 NORTHBOUND 4					
																								SHEET 43 OF 65					



DIRECTION	MILEPOINT	LOCATION CODE (SHEET 2)	SIGN CODE	WIDTH (IN)	HEIGHT (IN)	SHEETING REMARKS	SIGN LEGEND	NEW SIGNS		EXISTING SIGNS				EXIST POST		NUMBER OF NEW SQUARE STEEL POSTS	SQUARE STEEL (IN)			TUBULAR STEEL Ø (IN)				SIGN FRAME REQUIRED	REMARKS	SIGN DETAIL LOCATION									
								"A"	"B"	RETAIN	SALVAGE FROM	SALVAGE TO	REMOVE	RETAIN	REMOVE		1.75	2.00	2.50	3.00	3.50	4.00	5.00			SHSM	PROJECT SHEET NUMBER	STANDARD SHEET NUMBER							
																													(LB / FT)			(LB / FT)			
																													1.88	2.42	3.35	FOUNDATION	7.60	9.00	10.80
FAIRLEE US 5 NB							FY-FLUORESCENT YELLOW FYG-FLUORESCENT YELLOW GREEN															"SHSM"-STANDARD HIGHWAY SIGNS AND MARKINGS													
		A	VD1-1A	72	12			6.00																	4										
NB	2.660	A	W11-2	30	30								1		X																				
		A	VW-207P	24	18																														
		A	W16-7	24	12																														
		A	W11-2	30	30	FYG		6.25							1		X							X											
		A	VW-207P	24	18	FYG		3.00																	5										
		A	W16-7	24	12	FYG		2.00																X											
NB	2.670	A	VR-020	24	30								1		X																				
		A	VR-020	24	30			5.00							1		X									E-146									
NB	2.700	A	M4-5	24	12		ROUTE MARKER ASSEMBLY						1	X																					
		A	M1-1	24	24								1																						
		A	M6-1	21	15								1																						
		A	M3-1	24	12								1																						
		A	M1-4	24	24								1																						
		A	M6-3	21	15								1																						
SIGN SUMMARY SHEET							SHEET TOTALS		22.25	0.00	0	0	0	10	0	0	2	30		0	0	0	0	0	PROJECT NAME: NORWICH - FAIRLEE										
									SF	SF	EA	EA	EA	EA	EA	EA	EA	FT		EA	LB	LB	LB	LB	PROJECT NUMBER: STPG SIGN (34)										
																									FILE NAME: 10C334										
							VERMONT AGENCY OF TRANSPORTATION																			PROJECT MANAGER: A.GAMBLE									
							TOWN DIRECTIONAL TOTALS		343.6	0.0	9.0	4.0	4.0	90	0.0	0.0	51	765.0		0	0.0				DESIGNED BY: D.CROSSLEY										
																							PLOT DATE: 5/2/2011												
																							DRAWN BY: D.CROSSLEY												
																							CHECKED BY: QAU												
																							FAIRLEE US 5 NORTHBOUND 5												
																							SHEET 44 OF 65												

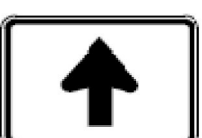DIRECTION	MILEPOINT	LOCATION CODE (SHEET 2)	SIGN CODE	WIDTH (IN)	HEIGHT (IN)	SHEETING REMARKS	SIGN LEGEND	NEW SIGNS		EXISTING SIGNS				EXIST POST		NUMBER OF NEW SQARE STEEL POSTS	SQUARE STEEL (IN)			TUBULAR STEEL Ø (IN)				SIGN FRAME REQUIRED	REMARKS	SIGN DETAIL LOCATION									
								"A"	"B"	RETAIN	SALVAGE FROM	SALVAGE TO	REMOVE	RETAIN	REMOVE		1.75	2.00	2.50	3.00	3.50	4.00	5.00			SHSM	PROJECT SHEET NUMBER	STANDARD SHEET NUMBER							
																													(LB / FT)			(LB / FT)			
																													1.88	2.42	3.35	FOUNDATION	7.60	9.00	10.80
FAIRLEE US 5 NB							FY-FLUORESCENT YELLOW FYG-FLUORESCENT YELLOW GREEN															"SHSM"-STANDARD HIGHWAY SIGNS AND MARKINGS													
		A	M4-5	24	12								1																						
		A	M1-5A	24	24								1																						
		A	M6-3	21	15								1																						
		A	M4-5	24	12			2.00														3	WHITE ON BLUE	X											
		A	M1-1	24	24			4.00																X											
		A	M6-1	21	15			2.19																WHITE ON BLUE	X										
		A	M3-1	24	12			2.00																BLACK ON WHITE	X										
		A	M1-4	24	24			4.00																X											
		A	M6-3	21	15			2.19																BLACK ON WHITE	X										
		A	M4-5	24	12		  	2.00																GREEN ON WHITE	X										
		A	M1-5A	24	24		  	4.00																			E-136B								
		A	M6-3	21	15			2.19																GREEN ON WHITE	X										
NB	2.695	A	VR-020	24	30								1		X																				
		A	VR-020	24	30			5.00								1		X									E-146								
NB	2.715	D	R1-1	30	30								1		X																				
SIGN SUMMARY SHEET							SHEET TOTALS	29.57	0.00	0	0	0	5	0	0	1	15	0	0	0	0	0	PROJECT NAME: NORWICH - FAIRLEE												
								SF	SF	EA	EA	EA	EA	EA	EA	EA	FT		EA	LB	LB	LB	LB	PROJECT NUMBER: STPG SIGN (34)											
																									FILE NAME: 10C334										
							VERMONT AGENCY OF TRANSPORTATION																			PROJECT MANAGER: A.GAMBLE									
							TOWN DIRECTIONAL TOTALS	343.6	0.0	9.0	4.0	4.0	90	0.0	0.0	51	765.0	0		0.0		DESIGNED BY: D.CROSSLEY													
																					FAIRLEE US 5 NORTHBOUND 6														
																					PLOT DATE: 5/2/2011														
																					DRAWN BY: D.CROSSLEY														
																					CHECKED BY: QAU														
																					SHEET 45 OF 65														



DIRECTION	MILEPOINT	LOCATION CODE (SHEET 2)	SIGN CODE	WIDTH (IN)	HEIGHT (IN)	SHEETING REMARKS	SIGN LEGEND	NEW SIGNS		EXISTING SIGNS				EXIST POST		NUMBER OF NEW SQUARE STEEL POSTS	SQUARE STEEL (IN)			TUBULAR STEEL Ø (IN)				SIGN FRAME REQUIRED	REMARKS	SIGN DETAIL LOCATION										
								"A"	"B"	RETAIN	SALVAGE FROM	SALVAGE TO	REMOVE	RETAIN	REMOVE		1.75	2.00	2.50	FOUNDATION	3.00	3.50	4.00			5.00	SHSM	PROJECT SHEET NUMBER	STANDARD SHEET NUMBER							
																														(LB / FT)			(LB / FT)			
																														1.88	2.42	3.35	7.60	9.00	10.80	14.60
FAIRLEE US 5 NB							FY-FLUORESCENT YELLOW FYG-FLUORESCENT YELLOW GREEN															"SHSM"-STANDARD HIGHWAY SIGNS AND MARKINGS														
		D	R1-1	30	30			6.25							1		X								X											
NB	2.724	A	M3-1	24	12		NORTH						1		X																					
		A	M1-4	24	24		US 5						1																							
		A	VM-120	18	24		CONNECTICUT RIVER BYWAYS				1		1											SALVAGE TO NB MP 2.76												
		A	D6-4A	18	9		AMERICA'S BYWAYS				1		1											SALVAGE TO NB MP 2.76												
NB	2.760	A	D2-1	72	10								1		X																					
		A	D2-1	72	10								1																							
		A	VD2-1	72	12		 Orford N.H. 1	6.00							2		X									4										
		A	VD2-1	72	12		 Bradford 7	6.00																		4										
			NORTH																																	
		A	M3-1	24	12			2.00																BLACK ON WHITE	X											
		A	M1-4	24	24			4.00																X												
		A	VM-120	18	24		CONNECTICUT RIVER BYWAYS						1											INSTALL ON LEFT POST												
		A	D6-4A	18	9		AMERICA'S BYWAYS						1											INSTALL BELOW CT. RIVER BYWAY												
NB	2.790	A	R2-1	24	30								1		X																					
		A	VR-183	24	30								1																							
SIGN SUMMARY SHEET							SHEET TOTALS	24.25	0.00	0	2	2	8	0	0	3	45		0	0	0	0	0	PROJECT NAME: NORWICH - FAIRLEE												
								SF	SF	EA	EA	EA	EA	EA	EA	EA		FT		EA	LB	LB	LB	LB	PROJECT NUMBER: STPG SIGN (34)											
																										FILE NAME: 10C334										
							VERMONT AGENCY OF TRANSPORTATION																				PROJECT MANAGER: A.GAMBLE									
							TOWN DIRECTIONAL TOTALS	343.6	0.0	9.0	4.0	4.0	90	0.0	0.0	51	765.0		0	0.0				DESIGNED BY: D.CROSSLEY												
																						FAIRLEE US 5 NORTHBOUND 7														
																						PLOT DATE: 5/2/2011														
																						DRAWN BY: D.CROSSLEY														
																						CHECKED BY: QAU														
																						SHEET 46 OF 65														

DIRECTION	MILEPOINT	LOCATION CODE (SHEET 2)	SIGN CODE	WIDTH (IN)	HEIGHT (IN)	SHEETING REMARKS	SIGN LEGEND	NEW SIGNS		EXISTING SIGNS				EXIST POST		NUMBER OF NEW SQUARE STEEL POSTS	SQUARE STEEL (IN)			TUBULAR STEEL Ø (IN)					SIGN FRAME REQUIRED	REMARKS	SIGN DETAIL LOCATION		
								"A"	"B"	RETAIN	SALVAGE FROM	SALVAGE TO	REMOVE	RETAIN	REMOVE		1.75	2.00	2.50	FOUNDATION	3.00	3.50	4.00	5.00			SHSM	PROJECT SHEET NUMBER	STANDARD SHEET NUMBER
																	(LB / FT)				(LB / FT)								
																	1.88	2.42	3.35		7.60	9.00	10.80	14.60					
FAIRLEE US 5 NB																							"SHSM"-STANDARD HIGHWAY SIGNS AND MARKINGS						
		A	R2-1	24	30		 	5.00							1		X									X			
		A	VR-183	24	30			5.00																			5		
NB	2.870	A	W11-2	30	30		   0050 0906 0282																						
		A	VW-207P	24	18																								
		A	W16-7	24	12																								
		A	W11-2	30	30	FYG		6.25								1		X								X			
		A	VW-207P	24	18	FYG		3.00																			5		
		A	W16-7	24	12	FYG	2.00			1	1	1													WITH MILE MARKER	X			
NB	2.900	B	D1-1E	72	20		SAMUEL MOREY ELEMENTARY SCHOOL			1				X															
		A	D1-1E	72	20		SAMUEL MOREY ELEMENTARY SCHOOL			1																			
NB	2.970	A	R2-1	24	30																								
NB	2.970	A	R2-1	24	30			5.00								1		X								X			
NB	3.070	A	M2-1	21	15		 																						
		A	M1-5A	24	24																								
		A	M2-1	21	15			2.19								1		X								GREEN ON WHITE	X		
SIGN SUMMARY SHEET							SHEET TOTALS	28.44	0.00	2	0	0	6	0	0	4	60			0	0	0	0	0	PROJECT NAME: NORWICH - FAIRLEE				
								SF	SF	EA	EA	EA	EA	EA	EA	EA		FT		EA	LB	LB	LB	LB	PROJECT NUMBER: STPG SIGN (34)				
																										FILE NAME: 10C334			
																											PROJECT MANAGER: A.GAMBLE		
VERMONT AGENCY OF TRANSPORTATION																								DESIGNED BY: D.CROSSLEY					
																										FAIRLEE US 5 NORTHBOUND 8			
TOWN DIRECTIONAL TOTALS																								PLOT DATE: 5/2/2011					
																												DRAWN BY: D.CROSSLEY	
																								CHECKED BY: QAU					
																												SHEET 47 OF 65	

DIRECTION	MILEPOINT	LOCATION CODE (SHEET 2)	SIGN CODE	WIDTH (IN)	HEIGHT (IN)	SHEETING REMARKS	SIGN LEGEND	NEW SIGNS		EXISTING SIGNS				EXIST POST		NUMBER OF NEW SQUARE STEEL POSTS	SQUARE STEEL (IN)			TUBULAR STEEL Ø (IN)				SIGN FRAME REQUIRED	REMARKS	SIGN DETAIL LOCATION			
								"A"	"B"	RETAIN	SALVAGE FROM	SALVAGE TO	REMOVE	RETAIN	REMOVE		1.75	2.00	2.50	FOUNDATION	3.00	3.50	4.00			5.00	SHSM	PROJECT SHEET NUMBER	STANDARD SHEET NUMBER
																	(LB / FT)				(LB / FT)								
																	1.88	2.42	3.35		7.60	9.00	10.80			14.60			
FAIRLEE US 5 NB							FY-FLUORESCENT YELLOW FYG-FLUORESCENT YELLOW GREEN															"SHSM"-STANDARD HIGHWAY SIGNS AND MARKINGS							
		A	M1-5A	24	24			4.00																	E-136B				
NB	3.130	A	D1-1A	72	10								1		X														
		A	D1-1A	72	10								1																
		A	VD1-1A	72	12		↑ Bradford 7 Orford N.H. →	6.00							2		X									4			
		A	VD1-1A	72	12			6.00																	4				
NB	3.160	A	W10-2R	36	36		RAILROAD CROSSING			1					X														
NB	3.175	A	M3-1	24	12		ROUTE MARKER ASSEMBLY						1		X														
		A	M1-4	24	24								1																
		A	M6-3	21	15								1																
		A	M3-2	24	12								1																
		A	M1-5A	24	24								1																
		A	M6-1	21	15								1																
		A	M3-1	24	12			2.00							2		X					2	BLACK ON WHITE	X					
		A	M1-4	24	24			4.00																X					
		A	M6-3	21	15			2.19															BLACK ON WHITE	X					
SIGN SUMMARY SHEET							SHEET TOTALS		24.19	0.00	1	0	0	8	0	0	4	60		0	0	0	0	0	PROJECT NAME: NORWICH - FAIRLEE				
									SF	SF	EA	EA	EA	EA	EA	EA	EA	FT		EA	LB	LB	LB	LB	PROJECT NUMBER: STPG SIGN (34)				
																									FILE NAME: 10C334				
																									PLOT DATE: 5/2/2011				
VERMONT AGENCY OF TRANSPORTATION							TOWN DIRECTIONAL TOTALS		343.6	0.0	9.0	4.0	4.0	90	0.0	0.0	51	765.0		0	0.0				PROJECT MANAGER: A.GAMBLE				
																									DESIGNED BY: D.CROSSLEY				
																							CHECKED BY: QAU						
																							SHEET 48 OF 65						

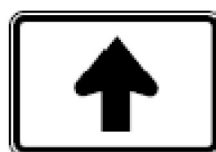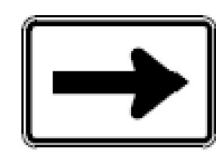DIRECTION	MILEPOINT	LOCATION CODE (SHEET 2)	SIGN CODE	WIDTH (IN)	HEIGHT (IN)	SHEETING REMARKS	SIGN LEGEND	NEW SIGNS		EXISTING SIGNS				EXIST POST		NUMBER OF NEW SQUARE STEEL POSTS	SQUARE STEEL (IN)			TUBULAR STEEL Ø (IN)				SIGN FRAME REQUIRED	REMARKS	SIGN DETAIL LOCATION			
								"A"	"B"	RETAIN	SALVAGE FROM	SALVAGE TO	REMOVE	RETAIN	REMOVE		1.75	2.00	2.50	FOUNDATION	3.00	3.50	4.00			5.00	SHSM	PROJECT SHEET NUMBER	STANDARD SHEET NUMBER
																	(LB / FT)				(LB / FT)								
																	1.88	2.42	3.35		7.60	9.00	10.80			14.60			
FAIRLEE US 5 NB							FY-FLUORESCENT YELLOW FYG-FLUORESCENT YELLOW GREEN															"SHSM"-STANDARD HIGHWAY SIGNS AND MARKINGS							
		A	M3-4	24	12		 	2.00															GREEN ON WHITE	X					
		A	M1-5	24	24		 	4.00																		E-136B			
		A	M6-1	21	15		 	2.19															GREEN ON WHITE	X					
NB	3.250	A	R2-1	24	30		SPEED LIMIT 30					1		X															
NB	3.250	A	VM-120	18	24		CONNECTICUT RIVER BYWAY				1	1	1		X	1		X						INSTALL BELOW ROUTE 5 SIGN					
		A	D6-4A	18	9		AMERICA'S BYWAYS				1	1	1										INSTALL BELOW CONN. BYWAY SIGN						
		A	M3-1	24	12		 	2.00															BLACK ON WHITE	X					
		A	M1-4	24	24			4.00																X					
NB	3.270	A	R2-1	24	30			5.00								1		X						INSTALL IN ISLAND BETWEEN BANK EXIT / ENTRANCE	X				
NB	3.360	A	R2-1	24	30							1		X															
		A	R2-1	24	30			5.00								1		X						X					
NB	3.400	A	VD2-1	72	10								1		X														
		A	VD2-1	72	12			6.00								2		X								4			
NB	3.430	A		24	30		BUCKLE UP IT IS THE LAW						1		X														
NB	3.480	A	VR-048	24	30		STATE LAW STOP FOR SCHOOL BUS						1		X														
SIGN SUMMARY SHEET							SHEET TOTALS		30.19	0.00	0	2	2	7	0	0	5	75		0	0	0	0	0	PROJECT NAME: NORWICH - FAIRLEE				
									SF	SF	EA	EA	EA	EA	EA	EA	EA	FT			EA	LB	LB	LB	LB	PROJECT NUMBER: STPG SIGN (34)			
																									FILE NAME: 10C334				
							VERMONT AGENCY OF TRANSPORTATION																			PROJECT MANAGER: A.GAMBLE			
							TOWN DIRECTIONAL TOTALS		343.6	0.0	9.0	4.0	4.0	90	0.0	0.0	51	765.0		0	0.0				DESIGNED BY: D.CROSSLEY				
																							PLOT DATE: 5/2/2011						
																							DRAWN BY: D.CROSSLEY						
																							CHECKED BY: QAU						
																							FAIRLEE US 5 NORTHBOUND 10						
																							SHEET 49 OF 65						

DIRECTION	MILEPOINT	LOCATION CODE (SHEET 2)	SIGN CODE	WIDTH (IN)	HEIGHT (IN)	SHEETING REMARKS	SIGN LEGEND	NEW SIGNS		EXISTING SIGNS				EXIST POST		NUMBER OF NEW SQUARE STEEL POSTS	SQUARE STEEL (IN)			TUBULAR STEEL Ø (IN)				SIGN FRAME REQUIRED	REMARKS	SIGN DETAIL LOCATION			
								"A"	"B"	RETAIN	SALVAGE FROM	SALVAGE TO	REMOVE	RETAIN	REMOVE		1.75	2.00	2.50	FOUNDATION	3.00	3.50	4.00			5.00	SHSM	PROJECT SHEET NUMBER	STANDARD SHEET NUMBER
																	(LB / FT)				(LB / FT)								
																	1.88	2.42	3.35		7.60	9.00	10.80			14.60			
FAIRLEE US 5 NB							FY-FLUORESCENT YELLOW FYG-FLUORESCENT YELLOW GREEN															"SHSM"-STANDARD HIGHWAY SIGNS AND MARKINGS							
NB	3.520	A	VR-654	24	24		NO DWI						1		X														
		A	VR-655	24	18		STRICTLY ENFORCED						1																
NB	3.570	A	R2-1	24	30								1		X														
			W16-18P	24	12	FY		2.00							1		X									5			
			R2-1	24	30			5.00																	X				
			R2-5P	24	18			3.00																	X				
NB	3.720	A	VR-023B	24	30		 \$500 FINE FOR THROWING TRASH						1		X														
NB	3.850	C	VR-023B	24	30			5.00							1		X								INSTALL IN MIDDLE OF PULL OFF			E-144	
NB	4.710	A	W11-2	30	30								1		X														
		A	W11-2	30	30	FYG		6.25							1		X									X			
		A	W16-9P	24	12	FYG		2.00																		X			
NB	5.350	A	VW-054L	30	30		HIDDEN DRIVE LEFT						1		X														
NB	5.415	A	VW-054L	30	30			6.25							1		X								INSTALL 350' NORTH OF ORIGINAL			E-154	
NB	5.780	A	VW-285	30	30		FALLING ROCK						1		X														
NB	5.820	A	R2-1	24	30		SPEED LIMIT 50						1		X														
SIGN SUMMARY SHEET							SHEET TOTALS		29.50	0.00	0	0	0	8	0	0	4	60		0	0	0	0	0	PROJECT NAME: NORWICH - FAIRLEE				
									SF	SF	EA	EA	EA	EA	EA	EA	EA	FT		EA	LB	LB	LB	LB	PROJECT NUMBER: STPG SIGN (34)				
																									FILE NAME: 10C334				
																									PLOT DATE: 5/2/2011				
VERMONT AGENCY OF TRANSPORTATION							TOWN DIRECTIONAL TOTALS		343.6	0.0	9.0	4.0	4.0	90	0.0	0.0	51	765.0		0	0.0				PROJECT MANAGER: A.GAMBLE				
																									DESIGNED BY: D.CROSSLEY				
																									CHECKED BY: QAU				
																									SHEET 50 OF 65				

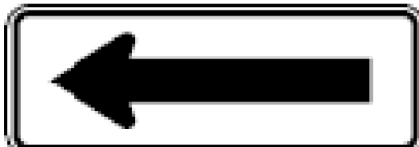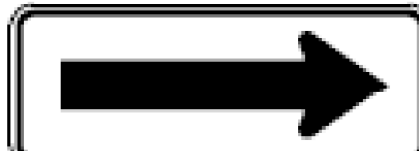DIRECTION	MILEPOINT	LOCATION CODE (SHEET 2)	SIGN CODE	WIDTH (IN)	HEIGHT (IN)	SHEETING REMARKS	SIGN LEGEND	NEW SIGNS		EXISTING SIGNS				EXIST POST		NUMBER OF NEW SQUARE STEEL POSTS	SQUARE STEEL (IN)			TUBULAR STEEL Ø (IN)					SIGN FRAME REQUIRED	REMARKS	SIGN DETAIL LOCATION			
								"A"	"B"	RETAIN	SALVAGE FROM	SALVAGE TO	REMOVE	RETAIN	REMOVE		1.75	2.00	2.50	FOUNDATION	3.00	3.50	4.00	5.00			SHSM	PROJECT SHEET NUMBER	STANDARD SHEET NUMBER	
																														(LB / FT)
																1.88	2.42	3.35												
FAIRLEE US 5 NB							FY-FLUORESCENT YELLOW FYG-FLUORESCENT YELLOW GREEN																	"SHSM"-STANDARD HIGHWAY SIGNS AND MARKINGS						
NB	5.910	A	VW-285	30	30			6.25								1		X							INSTALL 475' +/- NORTH OF REMOVED SL 50		5			
NB	6.170	A	W1-2L	30	30		LEFT CURVE						1		X															
		A	W13-1	18	18		35 MPH 						1																	
NB	6.198	A	W1-2L	30	30			6.25								1		X							INSTALL 150' +/- NORTH OF ORIGINAL SIGN LOCATION	X				
NB	6.290	A	S3-1	30	30		SCHOOL BUS STOP AHEAD			1				X																
NB	6.330	A	W1-6	48	24								1		X															
		A	W1-6	48	24	FY		8.00								2		X									X			
NB	6.331	B	W1-6	48	24								1		X															
		B	W1-6	48	24	FY		8.00								2		X									X			
NB	6.965	C	VR-017	24	30		 ** SEE NOTE **						1		X										MALLARY RD TH-6					
		C	VR-017	24	30		 	5.00								1		X							* NOTE: TOWN ADDED 2 MORE SIGNS TO THE POST, SINCE THEY ARE NOT ON CONTRACTORS WORK SHEET					E-141
NB	6.965	D	R1-1	30	30		 MALLORY RD						1		X										MALLARY RD TH-6					
		D	R1-1	30	30			6.25			1	1	1			1		X							WITH STREET SIGN	X				
NB	6.74	A	VW-060	30	30			6.25							1	X									ADDED TO PROJECT BY D. CROSSLEY, TRAFFIC OPERATION DIVISION.					
SIGN SUMMARY SHEET							SHEET TOTALS		39.75	0.00	1	0	0	6	0	0	8	120			0	0	0	0	0	PROJECT NAME: NORWICH - FAIRLEE				
									SF	SF	EA	EA	EA	EA	EA	EA	EA	FT			EA	LB	LB	LB	LB	PROJECT NUMBER: STPG SIGN (34)				
																										FILE NAME: 10C334				
VERMONT AGENCY OF TRANSPORTATION							TOWN DIRECTIONAL TOTALS		343.6	0.0	9.0	4.0	4.0	90	0.0	0.0	51	765.0			0	0.0				PLOT DATE: 5/2/2011				
																										DRAWN BY: D.CROSSLEY				
																										CHECKED BY: QAU				
																							DESIGNED BY: D.CROSSLEY							
																							FAIRLEE US 5 NORTHBOUND 12							
																								SHEET 51 OF 65						

DIRECTION	MILEPOINT	LOCATION CODE (SHEET 2)	SIGN CODE	WIDTH (IN)	HEIGHT (IN)	SHEETING REMARKS	SIGN LEGEND	NEW SIGNS		EXISTING SIGNS				EXIST POST		NUMBER OF NEW SQUARE STEEL POSTS	SQUARE STEEL (IN)			TUBULAR STEEL Ø (IN)					SIGN FRAME REQUIRED	REMARKS	SIGN DETAIL LOCATION			
								"A"	"B"	RETAIN	SALVAGE FROM	SALVAGE TO	REMOVE	RETAIN	REMOVE		1.75	2.00	2.50	FOUNDATION	3.00	3.50	4.00	5.00						
																	(LB / FT)				(LB / FT)									
																	1.88	2.42	3.35		7.60	9.00	10.80	14.60						
FAIRLEE US 5 SB							FY-FLUORESCENT YELLOW FYG-FLUORESCENT YELLOW GREEN																"SHS"-STANDARD HIGHWAY SIGNS AND MARKINGS							
SB	6.900	F	S3-1	30	30		SCHOOL BUS STOP AHEAD						1		X															
SB	6.860	F	VW-054R	30	30		 HIDDEN DRIVE RIGHT				1		1		X															
		F	S3-1	36	36	FYG		-9.00								-2	X								SIGN WAS NOT INSTALLED. NO LONGER A SCHOOL BUS STOP	X				
SB	6.840	F	VW-054R	30	30		HIDDEN DRIVE RIGHT					1				1	X								INSTALLSALVAGED SIGN 500' +/- SOUTH OF ORIGINAL SIGN LOCATION 625					
SB	6.430	F	W1-2R	30	30		CURVE RIGHT						1		X															
		F	W13-1	18	18		35 MPH						1																	
SB	6.400	F	VW-285	30	30		 0050 0906 0640 FALLING ROCK						1		X											WITH MILE MARKER				
		F	W1-2R	30	30			6.25		1	1	1				1	X								X					
SB	6.300	F	VW-285	30	30		 FALLING ROCK	6.25								1	X									INSTALL 50'+/- NORTH OF PULL-OFF, MINIMUM 10' FROM POLE		5		
SB	5.600	F	VW-054R	30	30			HIDDEN DRIVE RIGHT					1		X															
SB	5.050	G	VR-017	24	24		 LEGAL LOAD LIMIT 24,000 POUNDS	4.00								1	X									MOUNTAIN RD TH-10			E-141	
SB	5.049	H	R1-1	24	24		 MOUNTAIN RD						1		X											MOUNTAIN RD TH-10				
		H	R1-1	30	30			6.25								1	X									WITH STREET SIGN	X			
SB	4.950	F	W11-2	30	30		 AHEAD						1		X															
		F	W11-2	30	30	FYG		6.25								1	X									X				
SIGN SUMMARY SHEET							SHEET TOTALS	29.00 38.00	0.00	0	3 1	3 1	10 8	0	0	8		120		0	0	0	0	0	PROJECT NAME: NORWICH - FAIRLEE PROJECT NUMBER: STPG SIGN (34)					
								SF	SF	EA	EA	EA	EA	EA	EA	EA		FT		EA	LB	LB	LB	LB	FILE NAME: 10C334 PROJECT MANAGER: A.GAMBLE DESIGNED BY: D.CROSSLEY FAIRLEE US 5 SOUTHBOUND 1			PLOT DATE: 5/2/2011 DRAWN BY: D.CROSSLEY CHECKED BY: QAU SHEET 52 OF 65		
							TOWN DIRECTIONAL TOTALS							341.0	0.0	7.0	5.0	5.0	94	0.0	0.0	45	675.0	4	364.8					
VERMONT AGENCY OF TRANSPORTATION																														

DIRECTION	MILEPOINT	LOCATION CODE (SHEET 2)	SIGN CODE	WIDTH (IN)	HEIGHT (IN)	SHEETING REMARKS	SIGN LEGEND	NEW SIGNS		EXISTING SIGNS				EXIST POST		NUMBER OF NEW SQUARE STEEL POSTS	SQUARE STEEL (IN)			TUBULAR STEEL Ø (IN)				SIGN FRAME REQUIRED	REMARKS	SIGN DETAIL LOCATION			
								"A"	"B"	RETAIN	SALVAGE FROM	SALVAGE TO	REMOVE	RETAIN	REMOVE		1.75	2.00	2.50	FOUNDATION	3.00	3.50	4.00			5.00	SHSM	PROJECT SHEET #	STANDARD SHEET #
																	(LB / FT)				(LB / FT)								
																	1.88	2.42	3.35		7.60	9.00	10.80			14.60			
FAIRLEE US 5 SB							FY-FLUORESCENT YELLOW FYG-FLUORESCENT YELLOW GREEN															"SHS"-STANDARD HIGHWAY SIGNS AND MARKINGS							
		F	W16-9P	24	12	FYG		2.00																X					
SB	4.735	F	VW-045L	30	30		HIDDEN DRIVE LEFT						1		X														
SB	3.870	F	W1-4L	30	30		LEFT REVERSE CURVE						1		X														
		F	W13-1	18	18		45 MPH						1																
SB	3.750	F	N/A	X	X		LION'S INTERNATIONAL SIGN ASSEMBLY						3		X								REMOVE SIGNS IN ROW. RETURN TO TOWN						
SB	3.725	F	W1-2R	30	30			6.25							1		X						INSTALL 75' +/- SOUTH OF SOUTH END OF GUARD RAIL	X					
SB	3.635	F	W3-5	36	36		SPEED REDUCTION AHEAD 40			1				X															
SB	3.570	F	R2-1	24	30								1		X														
		F	R2-1	30	36			7.50							1		X							X					
SB	3.500	F	R2-5A	24	30								1		X														
		F	W3-5	36	36			9.00								2		X						X					
SB	3.460	F	VD-018	30	18								1		X														
		F	VD-018	30	18			3.75								1		X							5				
SB	3.420	F	M2-1	21	15		JCT			1				X															
		F	M1-5	24	24		ROUTE 25A				1																		
SIGN SUMMARY SHEET							SHEET TOTALS		28.50	0.00	3	0	0	9	0	0	5	75		0	0	0	0	0	PROJECT NAME: NORWICH - FAIRLEE				
									SF	SF	EA	EA	EA	EA	EA	EA	EA	FT			EA	LB	LB	LB	LB	PROJECT NUMBER: STPG SIGN (34)			
																							FILE NAME: 10C334		PLOT DATE: 5/2/2011				
																							PROJECT MANAGER: A.GAMBLE		DRAWN BY: D.CROSSLEY				
VERMONT AGENCY OF TRANSPORTATION							TOWN DIRECTIONAL TOTALS		341.0	0.0	7.0	5.0	5.0	94	0.0	0.0	45	675.0		4	364.8				DESIGNED BY: D.CROSSLEY				
																							FAIRLEE US 5 SOUTHBOUND 2		CHECKED BY: QAU				
																							SHEET 53 OF 65						


DIRECTION	MILEPOINT	LOCATION CODE (SHEET 2)	SIGN CODE	WIDTH (IN)	HEIGHT (IN)	SHEETING REMARKS	SIGN LEGEND	NEW SIGNS		EXISTING SIGNS				EXIST POST		NUMBER OF NEW SQUARE STEEL POSTS	SQUARE STEEL (IN)			TUBULAR STEEL Ø (IN)					SIGN FRAME REQUIRED	REMARKS	SIGN DETAIL LOCATION		
								"A"	"B"	RETAIN	SALVAGE FROM	SALVAGE TO	REMOVE	RETAIN	REMOVE		1.75	2.00	2.50	FOUNDATION	3.00	3.50	4.00	5.00			SHSM	PROJECT SHEET #	STANDARD SHEET #
																	(LB / FT)				(LB / FT)								
																	1.88	2.42	3.35		7.60	9.00	10.80	14.60					
FAIRLEE US 5 SB							FY-FLUORESCENT YELLOW FYG-FLUORESCENT YELLOW GREEN															"SHS"-STANDARD HIGHWAY SIGNS AND MARKINGS							
		F	M4-5	24	12			2.00															WHITE ON BLUE	X					
		F	M1-1	24	24			4.00																X					
		F	M6-3	21	15			2.19															WHITE ON BLUE	X					
SB	3.255	F	M3-2	24	12		ROUTE MARKER ASSEMBLY						1		X														
		F	M1-5A	24	24								1																
		F	M6-1	21	15								1																
		F	M3-3	24	12								1																
		F	M1-4	24	24								1																
		F	M6-3	21	15								1																
		F	M4-5	24	12								1																
		F	M1-1	24	24								1																
		F	M6-3	21	15								1																
SB	3.200	F	R2-1	24	30								1		X														
		F	R2-1	24	30			5.00								1		X							X				
SB	3.176	G	VR-017	24	30								+		*					OLD SIGN WAS MISSING			TOWN COMMON RD TH-26 (NORTH)						
SIGN SUMMARY SHEET							SHEET TOTALS		13.19	0.00	0	0	0	10	0	0	1	15		0	0	0	0	0	PROJECT NAME: NORWICH - FAIRLEE				
									SF	SF	EA	EA	EA	EA	EA	EA	EA		FT		EA	LB	LB	LB	LB	PROJECT NUMBER: STPG SIGN (34)			
																										FILE NAME: 10C334			
							VERMONT AGENCY OF TRANSPORTATION																				PROJECT MANAGER: A.GAMBLE		
TOWN DIRECTIONAL TOTALS																							DESIGNED BY: D.CROSSLEY						
									341.0	0.0	7.0	5.0	5.0	94	0.0	0.0	45	675.0		4	364.8			FAIRLEE US 5 SOUTHBOUND 4					
																							PLOT DATE: 5/2/2011						
																							DRAWN BY: D.CROSSLEY						
																							CHECKED BY: QAU						
																							SHEET 55 OF 65						

DIRECTION	MILEPOINT	LOCATION CODE (SHEET 2)	SIGN CODE	WIDTH (IN)	HEIGHT (IN)	SHEETING REMARKS	SIGN LEGEND	NEW SIGNS		EXISTING SIGNS				EXIST POST		NUMBER OF NEW SQUARE STEEL POSTS	SQUARE STEEL (IN)			TUBULAR STEEL Ø (IN)					SIGN FRAME REQUIRED	REMARKS	SIGN DETAIL LOCATION		
								"A"	"B"	RETAIN	SALVAGE FROM	SALVAGE TO	REMOVE	RETAIN	REMOVE		1.75	2.00	2.50	FOUNDATION	3.00	3.50	4.00	5.00					
																	(LB / FT)				(LB / FT)								
																	1.88	2.42	3.35		7.60	9.00	10.80	14.60					
FAIRLEE US 5 SB																							"SHS"-STANDARD HIGHWAY SIGNS AND MARKINGS						
		G	VR-017	24	30		LEGAL LOAD LIMIT 24,000 POUNDS	5.00							1		X										E-141		
SB	3.184	H	R1-1	24	24		STOP TOWN COMMON RD						1		X										TOWN COMMON RD TH-26 (NORTH)				
		H	R1-1	30	30			6.25					1			X								GAVE SIGN TO TOWN WITH STREET SIGN	X				
SB	3.165	F	M3-3	24	12								1		X														
		F	M1-4	24	24								1																
		F	VM-120	18	24		CONNECTICUT RIVER BYWAYS				1	1	1												INTALL BELOW NEW ROUTE 5 SIGN				
		F	D6-4A	18	9		AMERICA'S BYWAYS				1	1	1												INSTALL BELOW CT. RIVER BYWAY				
		F	M4-5	24	12								1																
		F	M1-1	24	24								1																
		F	M3-3	24	12		SOUTH 5 TO INTERSTATE 91	2.00							2		X							1	BLACK ON WHITE	X			
		F	M1-4	24	24			4.00																	X				
		F	M4-5	24	12			2.00																	WHITE ON BLUE	X			
		F	M1-1	24	24			4.00																	X				
SB	3.126	G	VR-017	24	30		LEGAL LOAD LIMIT 24,000 POUNDS	5.00							4		X	THIS SIGN WAS NOT INSTALLED. IT IS A LOOP ROAD.						TOWN COMMON RD TH-26 (SOUTH)			E-141		
SB	3.118	H	R1-1	24	24								1		X										TOWN COMMON RD TH-26 (SOUTH)				
SIGN SUMMARY SHEET							SHEET TOTALS		23.25 28.25	0.00	0	2	2	9 8	0	0	5		75		0	0	0	0	0	PROJECT NAME: NORWICH - FAIRLEE			
									SF	SF	EA	EA	EA	EA	EA	EA	EA		FT		EA	LB	LB	LB	LB	PROJECT NUMBER: STPG SIGN (34)			
																											FILE NAME: 10C334		
							VERMONT AGENCY OF TRANSPORTATION																				PROJECT MANAGER: A.GAMBLE		
							TOWN DIRECTIONAL TOTALS		341.0	0.0	7.0	5.0	5.0	94	0.0	0.0	45		675.0	4	364.8					DESIGNED BY: D.CROSSLEY			
																								PLOT DATE: 5/2/2011					
																								DRAWN BY: D.CROSSLEY					
																								CHECKED BY: QAU					
																								SHEET 56 OF 65					

DIRECTION	MILEPOINT	LOCATION CODE (SHEET 2)	SIGN CODE	WIDTH (IN)	HEIGHT (IN)	SHEETING REMARKS	SIGN LEGEND	NEW SIGNS		EXISTING SIGNS				EXIST POST		NUMBER OF NEW SQUARE STEEL POSTS	SQUARE STEEL (IN)			TUBULAR STEEL Ø (IN)					SIGN FRAME REQUIRED	REMARKS	SIGN DETAIL LOCATION		
								"A"	"B"	RETAIN	SALVAGE FROM	SALVAGE TO	REMOVE	RETAIN	REMOVE		1.75	2.00	2.50	FOUNDATION	3.00	3.50	4.00	5.00					
																	(LB / FT)				(LB / FT)								
																	1.88	2.42	3.35		7.60	9.00	10.80	14.60					
FAIRLEE US 5 SB							FY-FLUORESCENT YELLOW FYG-FLUORESCENT YELLOW GREEN															"SHS"-STANDARD HIGHWAY SIGNS AND MARKINGS							
		H	R1-1	30	30		0050 0906 0312 TOWN COMMON RD STOP	6.25			1	1	2			1		X						MILE MARKER-REINSTALLED ON NEW POST. TAKEN TO TOWN WITH STREET SIGN GARAGE	X				
SB	3.080	F	R2-1	24	30		SPEED LIMIT 30						1		X														
SB	2.960	F	R2-1	24	30								1		X														
		F	VR-183	24	30								1																
		F	R2-1	24	30		SPEED LIMIT 30	5.00							1		X							X					
		F	VR-183	24	30		NO PASSING ON RIGHT	5.00																	5				
SB	2.920	G	R8-3	24	24		R	4.00							1		X							INSTALL 100' NORTH OF SCHOOL STREET	X				
		G	M6-1	24	12		←	2.00																BLACK ON WHITE	X				
SB	2.915	G	R8-3A	24	24		NO PARKING						1		X														
		G	N/A	24	12		HERE TO CORNER						1																
SB	2.900	G	VR-017	24	30		LEGAL LOAD LIMIT 24,000 POUNDS						1		X									SCHOOL STREET TH-23					
		G	VR-017	24	30			5.00							1		X									E-141			
SB	2.889	H	R1-1	30	30		SCHOOL ST STOP						1		X									SCHOOL STREET TH-23					
		H	R1-1	30	30		STOP 0050 0906 0290	6.25			2	2	2			1		X						WITH MILE MARKER AND STREET SIGN	X				
SB	2.880	F	W11-2	30	30								1		X														
SIGN SUMMARY SHEET							SHEET TOTALS		33.50	0.00	0	30	30	128	0	0	5		75		0	0	0	0	0	PROJECT NAME: NORWICH - FAIRLEE			
									SF	SF	EA	EA	EA	EA	EA	EA		FT		EA	LB	LB	LB	LB	PROJECT NUMBER: STPG SIGN (34)				
																									FILE NAME: 10C334				
																									PROJECT MANAGER: A.GAMBLE				
VERMONT AGENCY OF TRANSPORTATION							TOWN DIRECTIONAL TOTALS		341.0	0.0	7.0	5.0	5.0	94	0.0	0.0	45		675.0		4			364.8	PLOT DATE: 5/2/2011				
																									DRAWN BY: D.CROSSLEY				
																								DESIGNED BY: D.CROSSLEY					
																								CHECKED BY: QAU					
																								FAIRLEE US 5 SOUTHBOUND 6					
																								SHEET 57 OF 65					

DIRECTION	MILEPOINT	LOCATION CODE (SHEET 2)	SIGN CODE	WIDTH (IN)	HEIGHT (IN)	SHEETING REMARKS	SIGN LEGEND	NEW SIGNS		EXISTING SIGNS				EXIST POST		NUMBER OF NEW SQUARE STEEL POSTS	SQUARE STEEL (IN)			TUBULAR STEEL Ø (IN)				SIGN FRAME REQUIRED	REMARKS	SIGN DETAIL LOCATION			
								"A"	"B"	RETAIN	SALVAGE FROM	SALVAGE TO	REMOVE	RETAIN	REMOVE		1.75	2.00	2.50	FOUNDATION	3.00	3.50	4.00			5.00	SHSM	PROJECT SHEET #	STANDARD SHEET #
																	(LB / FT)				(LB / FT)								
																	1.88	2.42	3.35		7.60	9.00	10.80			14.60			
FAIRLEE US 5 SB																						"SHS"-STANDARD HIGHWAY SIGNS AND MARKINGS							
		F	VW-207P	24	18								1																
		F	W16-7	24	12								1																
		F	W11-2	30	30	FYG		6.25						1		X								X					
		F	VW-207P	24	18	FYG		3.00																	5				
		F	W16-7	24	12	FYG		2.00																X					
SB	2.790	F	D1-1A	72	10		^ UP LAKE FAIRLEE 5						1		X														
		F	D1-1A	72	10		^ UP NORWICH 14						1																
SB	2.730	F	M3-3	24	12		ROUTE MARKER ASSEMBLY						1		X														
		F	M1-4	24	24								1																
		F	M6-3	21	15								1																
		F	M4-5	24	12								1																
		F	M1-1	24	24								1																
		F	M6-1	21	15								1																
		F	VD1-1A	72	12			6.00								0 2			2	182.4				2	THINNING AND TRIMMING		4		
		F	VD1-1A	72	12			6.00																	4				
SIGN SUMMARY SHEET							SHEET TOTALS		23.25	0.00	0	0	0	10	0	0	1 3		45		2	182.4	0	0	0	PROJECT NAME: NORWICH - FAIRLEE			
									SF	SF	EA	EA	EA	EA	EA	EA	EA		FT		EA	LB	LB	LB	LB	PROJECT NUMBER: STPG SIGN (34)			
																										FILE NAME: 10C334			
																											PROJECT MANAGER: A.GAMBLE		
VERMONT AGENCY OF TRANSPORTATION																								PLOT DATE: 5/2/2011					
																										DRAWN BY: D.CROSSLEY			
																								CHECKED BY: QAU					
																										DESIGNED BY: D.CROSSLEY			
																								FAIRLEE US 5 SOUTHBOUND 7					
																										SHEET 58 OF 65			

DIRECTION	MILEPOINT	LOCATION CODE (SHEET 2)	SIGN CODE	WIDTH (IN)	HEIGHT (IN)	SHEETING REMARKS	SIGN LEGEND	NEW SIGNS		EXISTING SIGNS				EXIST POST		NUMBER OF NEW SQUARE STEEL POSTS	SQUARE STEEL (IN)			TUBULAR STEEL Ø (IN)				SIGN FRAME REQUIRED	REMARKS	SIGN DETAIL LOCATION			
								"A"	"B"	RETAIN	SALVAGE FROM	SALVAGE TO	REMOVE	RETAIN	REMOVE		1.75	2.00	2.50	FOUNDATION	3.00	3.50	4.00			5.00	SHSM	PROJECT SHEET #	STANDARD SHEET #
																	(LB / FT)				(LB / FT)								
																	1.88	2.42	3.35		7.60	9.00	10.80			14.60			
FAIRLEE US 5 SB							FY-FLUORESCENT YELLOW FYG-FLUORESCENT YELLOW GREEN															"SHS"-STANDARD HIGHWAY SIGNS AND MARKINGS							
		F	M3-3	24	12		↑ Lake Fairlee 5 Lake Morey → SOUTH TO 5 91 ↑ → <td>2.00</td> <td></td> <td></td> <td></td> <td></td> <td></td> <td></td> <td></td> <td></td> <td></td> <td></td> <td></td> <td></td> <td></td> <td></td> <td></td> <td>BLACK ON WHITE</td> <td>X</td> <td></td> <td></td>	2.00																BLACK ON WHITE	X				
		F	M1-4	24	24			4.00															X						
		F	M6-3	21	15			2.19															BLACK ON WHITE	X					
		F	M4-5	24	12			2.00															WHITE ON BLUE	X					
		F	M1-1	24	24			4.00																X					
		F	M6-1	21	15			2.19																WHITE ON BLUE	X				
SB	2.690	F	M3-3	24	12							1	X																
		F	M1-4	24	24							1																	
		F	VM-120	18	24		CONNECTICUT RIVER BYWAYS				1	1	1											INTALL BELOW NEW ROUTE 5 SIGN					
		F	D6-4A	18	9		AMERICA'S BYWAYS				1	1	1											INSTALL BELOW CT. RIVER BYWAY					
		F	VD2-1	72	12		Lake Fairlee 5	6.00						2	X											4			
		F	VD2-1	72	12		East Thetford 8	6.00																		4			
		F	M3-3	24	12		SOUTH 5	2.00																BLACK ON WHITE	X				
		F	M1-4	24	24			4.00																X					
SB	2.664	F	W11-2	30	30							1	X																
SIGN SUMMARY SHEET							SHEET TOTALS	34.38	0.00	0	2	2	5	0	0	2	30			0	0	0	0	0	PROJECT NAME: NORWICH - FAIRLEE				
								SF	SF	EA	EA	EA	EA	EA	EA	EA	FT		EA	LB	LB	LB	LB	PROJECT NUMBER: STPG SIGN (34)					
																								FILE NAME: 10C334					
							VERMONT AGENCY OF TRANSPORTATION	TOWN DIRECTIONAL TOTALS	341.0	0.0	7.0	5.0	5.0	94	0.0	0.0	45	675.0			4	364.8				PROJECT MANAGER: A.GAMBLE			
																							PLOT DATE: 5/2/2011						
																							DRAWN BY: D.CROSSLEY						
																							CHECKED BY: QAU						
																							FAIRLEE US 5 SOUTHBOUND 8						
																							SHEET 59 OF 65						

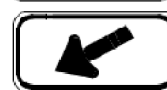DIRECTION	MILEPOINT	LOCATION CODE (SHEET 2)	SIGN CODE	WIDTH (IN)	HEIGHT (IN)	SHEETING REMARKS	SIGN LEGEND	NEW SIGNS		EXISTING SIGNS				EXIST POST		NUMBER OF NEW SQUARE STEEL POSTS	SQUARE STEEL (IN)			TUBULAR STEEL Ø (IN)					SIGN FRAME REQUIRED	REMARKS	SIGN DETAIL LOCATION		
								"A"	"B"	RETAIN	SALVAGE FROM	SALVAGE TO	REMOVE	RETAIN	REMOVE		1.75	2.00	2.50	FOUNDATION	3.00	3.50	4.00	5.00			SHSM	PROJECT SHEET #	STANDARD SHEET #
																	(LB / FT)				(LB / FT)								
																	1.88	2.42	3.35		7.60	9.00	10.80	14.60					
FAIRLEE US 5 SB							FY-FLUORESCENT YELLOW FYG-FLUORESCENT YELLOW GREEN															"SHS"-STANDARD HIGHWAY SIGNS AND MARKINGS							
		F	VW-207P	24	18		  						1																
		F	W16-7	24	12								1																
		F	W11-2	30	30	FYG		6.25							1		X								THINNING AND TRIMMING	X			
		F	VW-207P	24	18	FYG		3.00																		5			
		F	W16-7	24	12	FYG	2.00																			X			
SB	2.636	F	R2-1	24	30								1		X														
		F	R2-1	24	30			5.00							1		X									X			
SB	2.610	F	D2-1	72	10		LAKE FAIRLEE 5						1		X														
		F	D2-1	72	10		EAST THETFORD 8						1																
SB	2.585	G	VR-017	24	30								1		X											ADAMS RD TH-12			
		G	VR-017	24	30			5.00							1		X										E-141		
SB	2.575	H	R1-1	30	30		 ADAM'S RD						1		X											ADAMS RD TH-12			
		H	R1-1	30	30			6.25			2	2	2			1		X							WITH MILE MARKER AND STREET SIGN	X			
SB	2.490	F	R16-1	24	30		BUCKLE UP - IT'S THE LAW						1		X														
SB	2.470	G	VR-017	24	30								1		X											WOODLAND TH-22			
SIGN SUMMARY SHEET									SHEET TOTALS		27.50	0.00	0	20	20	119	0	0	4	60	0	0	0	0	0	PROJECT NAME: NORWICH - FAIRLEE			
									SF	SF	EA	EA	EA	EA	EA	EA	EA		FT		EA	LB	LB	LB	LB	PROJECT NUMBER: STPG SIGN (34)			
VERMONT AGENCY OF TRANSPORTATION																										FILE NAME: 10C334			
																									PROJECT MANAGER: A.GAMBLE				
																									DESIGNED BY: D.CROSSLEY				
																									FAIRLEE US 5 SOUTHBOUND 9				
																									PLOT DATE: 5/2/2011				
																									DRAWN BY: D.CROSSLEY				
																									CHECKED BY: QAU				
																									SHEET 60 OF 65				
TOWN DIRECTIONAL TOTALS								341.0	0.0	7.0	5.0	5.0	94	0.0	0.0	45	675.0	4	364.8										

DIRECTION	MILEPOINT	LOCATION CODE (SHEET 2)	SIGN CODE	WIDTH (IN)	HEIGHT (IN)	SHEETING REMARKS	SIGN LEGEND	NEW SIGNS		EXISTING SIGNS				EXIST POST		NUMBER OF NEW SQUARE STEEL POSTS	SQUARE STEEL (IN)			TUBULAR STEEL Ø (IN)				SIGN FRAME REQUIRED	REMARKS	SIGN DETAIL LOCATION							
								"A"	"B"	RETAIN	SALVAGE FROM	SALVAGE TO	REMOVE	RETAIN	REMOVE		1.75	2.00	2.50	FOUNDATION	3.00	3.50	4.00			5.00	SHSM	PROJECT SHEET #	STANDARD SHEET #				
																	(LB / FT)				(LB / FT)												
																	1.88	2.42	3.35		7.60	9.00	10.80			14.60							
FAIRLEE US 5 SB							FY-FLUORESCENT YELLOW FYG-FLUORESCENT YELLOW GREEN															"SHS"-STANDARD HIGHWAY SIGNS AND MARKINGS											
		G	VR-017	24	30			5.00							1		X									E-141							
SB	2.462	H	R1-1	24	24		 WOODLAND TERR 0050 0906 0247					1		X										WOODLAND TH-22									
		H	R1-1	30	30			6.25			2	2	2			1		X						WITH MILE MARKER AND STREET SIGN	X								
SB	2.460	F	R2-1	24	30							1		X																			
		F	R2-1	24	30			5.00								1		X							X								
SB	2.310	F	VR-048	24	30		STATE LAW - STOP FOR -SCHOOL BUS -FLASHING - RED LIGHTS						1		X																		
SB	2.220	F	R2-1	24	30								1		X																		
		F	W16-18P	24	12	FY	  	2.00							1		X									5							
		F	R2-1	24	30			5.00																	X								
		F	R2-5P	24	18			3.00																	X								
SB	2.150	F	VR-023B	24	30		\$500 FINE FOR THROWING TRASH						1		X																		
SB	1.595	F	VR-114	48	60		STATE OF VERMONT - SPEED - LIMIT - 50 UNLESS OTHERWISE - POSTED - RADAR ENFORCEMENT						1		X																		
SB	1.200	F	VD-062B	72	16		BUSINESS SIGN			1	2	2	2	X																			
SB	0.530	F	^{054L} VW-060	30	30		HIDDEN DRIVE 	6.25		4			1	X										NEW SIGN INSTALLED TO BETTER IDENTIFY THE DRIVE LOCATION. USED SAME POST.									
SB	0.500	F	VD-018	30	18								1	X																			
SIGN SUMMARY SHEET							SHEET TOTALS		32.50 26.25	0.00	2	2 0	2 0	10 7	0	0	4		60		0	0	0	0	0	PROJECT NAME: NORWICH - FAIRLEE PROJECT NUMBER: STPG SIGN (34)							
									SF	SF	EA	EA	EA	EA	EA	EA		FT		EA	LB	LB	LB	LB				FILE NAME: 10C334 PROJECT MANAGER: A.GAMBLE DESIGNED BY: D.CROSSLEY FAIRLEE US 5 SOUTHBOUND 10			PLOT DATE: 5/2/2011 DRAWN BY: D.CROSSLEY CHECKED BY: QAU SHEET 61 OF 65		
							VERMONT AGENCY OF TRANSPORTATION		TOWN DIRECTIONAL TOTALS		341.0	0.0	7.0	5.0	5.0	94	0.0	0.0	45		675.0	4		364.8									

DIRECTION	MILEPOINT	LOCATION CODE (SHEET 2)	SIGN CODE	WIDTH (IN)	HEIGHT (IN)	SHEETING REMARKS	SIGN LEGEND	NEW SIGNS		EXISTING SIGNS				EXIST POST		NUMBER OF NEW SQUARE STEEL POSTS	SQUARE STEEL (IN)			TUBULAR STEEL Ø (IN)				SIGN FRAME REQUIRED	REMARKS	SIGN DETAIL LOCATION										
								"A"	"B"	RETAIN	SALVAGE FROM	SALVAGE TO	REMOVE	RETAIN	REMOVE		1.75	2.00	2.50	FOUNDATION	3.00	3.50	4.00			5.00	SHSM	PROJECT SHEET #	STANDARD SHEET #							
																														(LB / FT)			(LB / FT)			
																														1.88	2.42	3.35	7.60	9.00	10.80	14.60
FAIRLEE US 5 SB							FY-FLUORESCENT YELLOW FYG-FLUORESCENT YELLOW GREEN															"SHS"-STANDARD HIGHWAY SIGNS AND MARKINGS														
		F	VD-018	30	18		Ely North Thetford 3	3.75							1		X									5										
SB	0.430	F	M2-1	21	15								1		X																					
		F	M1-5A	24	24								1																							
		F	M2-1	21	15		JCT VERMONT 244	2.19							1		X							GREEN ON WHITE	X											
		F	M1-5	30	24			5.00																		E-136B										
SB	0.380	F	D1-1 A	72	10								1		X																					
		F	D1-1 A	72	10								1																							
		F	D1-1A	72	10								1																							
		F	D1-1A	72	10								1																							
		F	VD1-1 A	72	12		↑ East Thetford 5	6.00							2		X									4										
		F	VD1-1A	72	12		Lake Fairlee 3 →	6.00																		4										
		F	VD1-1A	72	12		Post Mills 6 →	6.00																		4										
SB	0.340	F	M3-3	24	12		ROUTE MARKER ASSEMBLY						1		X																					
		F	M1-4	24	24								1																							
		F	M6-3	21	15								1																							
SIGN SUMMARY SHEET							SHEET TOTALS	28.94	0.00	0	0	0	9	0	0	4	60			0	0	0	0	0	PROJECT NAME: NORWICH - FAIRLEE											
								SF	SF	EA	EA	EA	EA	EA	EA	EA	FT			EA	LB	LB	LB	LB	PROJECT NUMBER: STPG SIGN (34)											
																								FILE NAME: 10C334												
																								PROJECT MANAGER: A.GAMBLE												
																								PLOT DATE: 5/2/2011												
																								DRAWN BY: D.CROSSLEY												
																								CHECKED BY: QAU												
VERMONT AGENCY OF TRANSPORTATION																								SHEET 62 OF 65												
TOWN DIRECTIONAL TOTALS								341.0	0.0	7.0	5.0	5.0	94	0.0	0.0	45	675.0			4	364.8				FAIRLEE US 5 SOUTHBOUND 11											

DIRECTION	MILEPOINT	LOCATION CODE (SHEET 2)	SIGN CODE	WIDTH (IN)	HEIGHT (IN)	SHEETING REMARKS	SIGN LEGEND	NEW SIGNS		EXISTING SIGNS				EXIST POST		NUMBER OF NEW SQUARE STEEL POSTS	SQUARE STEEL (IN)			TUBULAR STEEL Ø (IN)				SIGN FRAME REQUIRED	REMARKS	SIGN DETAIL LOCATION			
								"A"	"B"	RETAIN	SALVAGE FROM	SALVAGE TO	REMOVE	RETAIN	REMOVE		1.75	2.00	2.50	FOUNDATION	3.00	3.50	4.00			5.00	SHSM	PROJECT SHEET #	STANDARD SHEET #
																	(LB / FT)				(LB / FT)								
																	1.88	2.42	3.35		7.60	9.00	10.80			14.60			
FAIRLEE US 5 SB							FY-FLUORESCENT YELLOW FYG-FLUORESCENT YELLOW GREEN															"SHS"-STANDARD HIGHWAY SIGNS AND MARKINGS							
		F	M3-4	24	12		SOUTH WEST 5 VERMONT 244 ↑ →					1																	
		F	M1-5A	24	24								1																
		F	M6-1	21	15								1																
		F	M3-3	24	12			2.00							2	X							2A	BLACK ON WHITE	X				
		F	M1-4	24	24			4.00																X					
		F	M6-3	21	15			2.19																X					
		F	M3-4	24	12			2.00																X					
		F	M1-5	30	24			5.00																		E-136B			
		F	M6-1	21	15		2.19																X						
SB	0.280	F	M3-3	24	12		SOUTH 5					1		X															
		F	M1-4	24	24								1																
		F	M3-3	24	12			2.00							1	X								X					
		F	M1-4	24	24			4.00																X					
SB	0.170	F	W10-2L	36	36		RAILROAD CROSSING			1				X															
SIGN SUMMARY SHEET							SHEET TOTALS		23.38	0.00	1	0	0	5	0	0	3	45			0	0	0	0	0	PROJECT NAME: NORWICH - FAIRLEE			
									SF	SF	EA	EA	EA	EA	EA	EA	EA	FT		EA	LB	LB	LB	LB	PROJECT NUMBER: STPG SIGN (34)				
																								FILE NAME: 10C334					
																								PROJECT MANAGER: A.GAMBLE					
VERMONT AGENCY OF TRANSPORTATION																								DRAWN BY: D.CROSSLEY					
							TOWN DIRECTIONAL TOTALS		341.0	0.0	7.0	5.0	5.0	94	0.0	0.0	45	675.0			4	364.8					CHECKED BY: QAU		
																									FAIRLEE US 5 SOUTHBOUND 12				
																								PLOT DATE: 5/2/2011					
																								SHEET 63 OF 65					

TOWN TOTAL SIGN SUMMARY SHEET

NORWICH - FAIRLEE STPG SIGN (34)

[illegible]

PROJECT NAME: NORWICH - FAIRLEE

PROJECT NUMBER: STPG SIGN (34)

FILE NAME: IOC334. TSSS
PROJECT LEADER: A. GAMBLE
DESIGNED BY: D. CROSSLEY
TOWN TOTAL SIGN SUMMARY SHEET

PLOT DATE: 04-MAY-2011
DRAWN BY: D.CROSSLEY
CHECKED BY: A. GAMBLE
SHEET 65 OF 65