


STATE OF VERMONT
AGENCY OF TRANSPORTATION

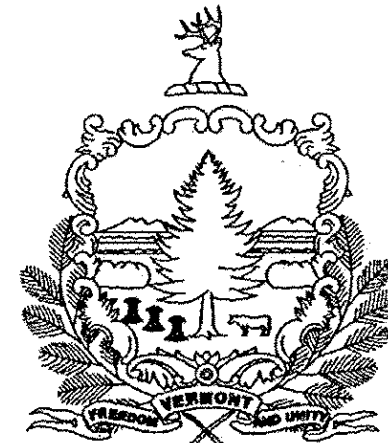

INDEX OF SHEETS
SEE SHEET 2


PROPOSED IMPROVEMENT
TOWNS OF PAWLET, DANBY, TINMOUTH,
MIDDLETOWN SPRINGS,
IRA, CLARENDON AND WEST RUTLAND
COUNTY OF RUTLAND
VERMONT ROUTE 133

SOUTHWEST REGION SIGN REPLACEMENT - 21.464 MILES:
PAWLET MP 0.000-5.325, DANBY MP 0.000-0.024, TINMOUTH MP 0.000-2.150,
MIDDLETOWN SPRINGS MP 0.000-5.975, TINMOUTH MP 2.150-3.216,
IRA MP 0.000-4.780, CLARENDON MP 0.000-1.434, WEST RUTLAND MP 0.000-0.710


LENGTH OF ROADWAY = 21.464 MILES
LENGTH OF PROJECT = 21.464 MILES

WORK TO BE PERFORMED UNDER THIS PROJECT INCLUDES THE REMOVAL OF EXISTING SIGNS AND POSTS
AND THE INSTALLATION OF NEW SIGNS AND SIGN POSTS AND INCIDENTAL ITEMS.

RECORD PLANS	
CONTRACTOR:	EMI GUIDE RAIL LLC- SCHENECTADY, NY
RESIDENT ENGINEER:	TIM POCKETTE
CONSTRUCTION BEGAN:	APRIL 16, 2012
CONSTRUCTION COMPLETE:	JULY 11, 2012
RECORD PLANS BY:	TIM POCKETTE & JENNA HYDE
I HEREBY CERTIFY THAT ALL THE CONSTRUCTION REQUIRED BY THIS SET OF DRAWINGS HAS BEEN ACCOMPLISHED AS INDICATED HEREIN.	
BY	RESIDENT ENGINEER
DATE 11-05-12	
NOTE: Any further information concerning final quantities, amounts or other details relative to this project may be found at Central Files in the electronic archives.	

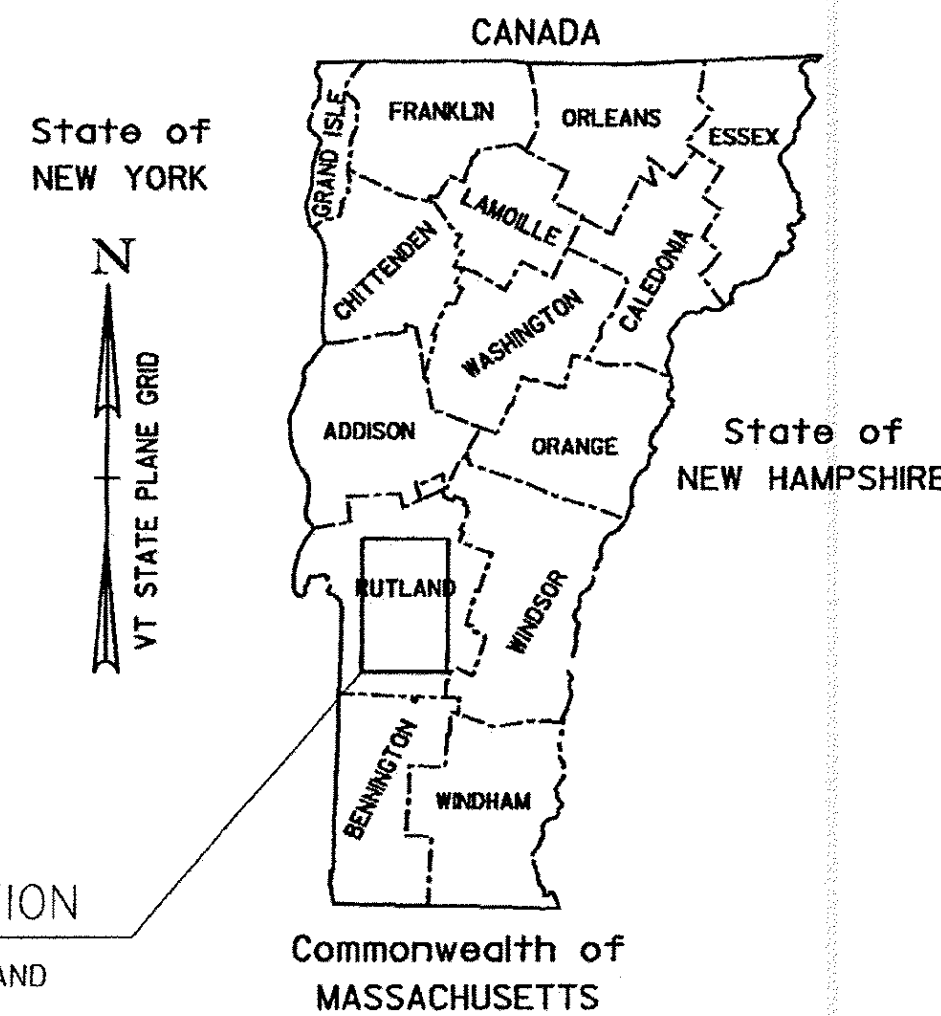

NOT TO SCALE

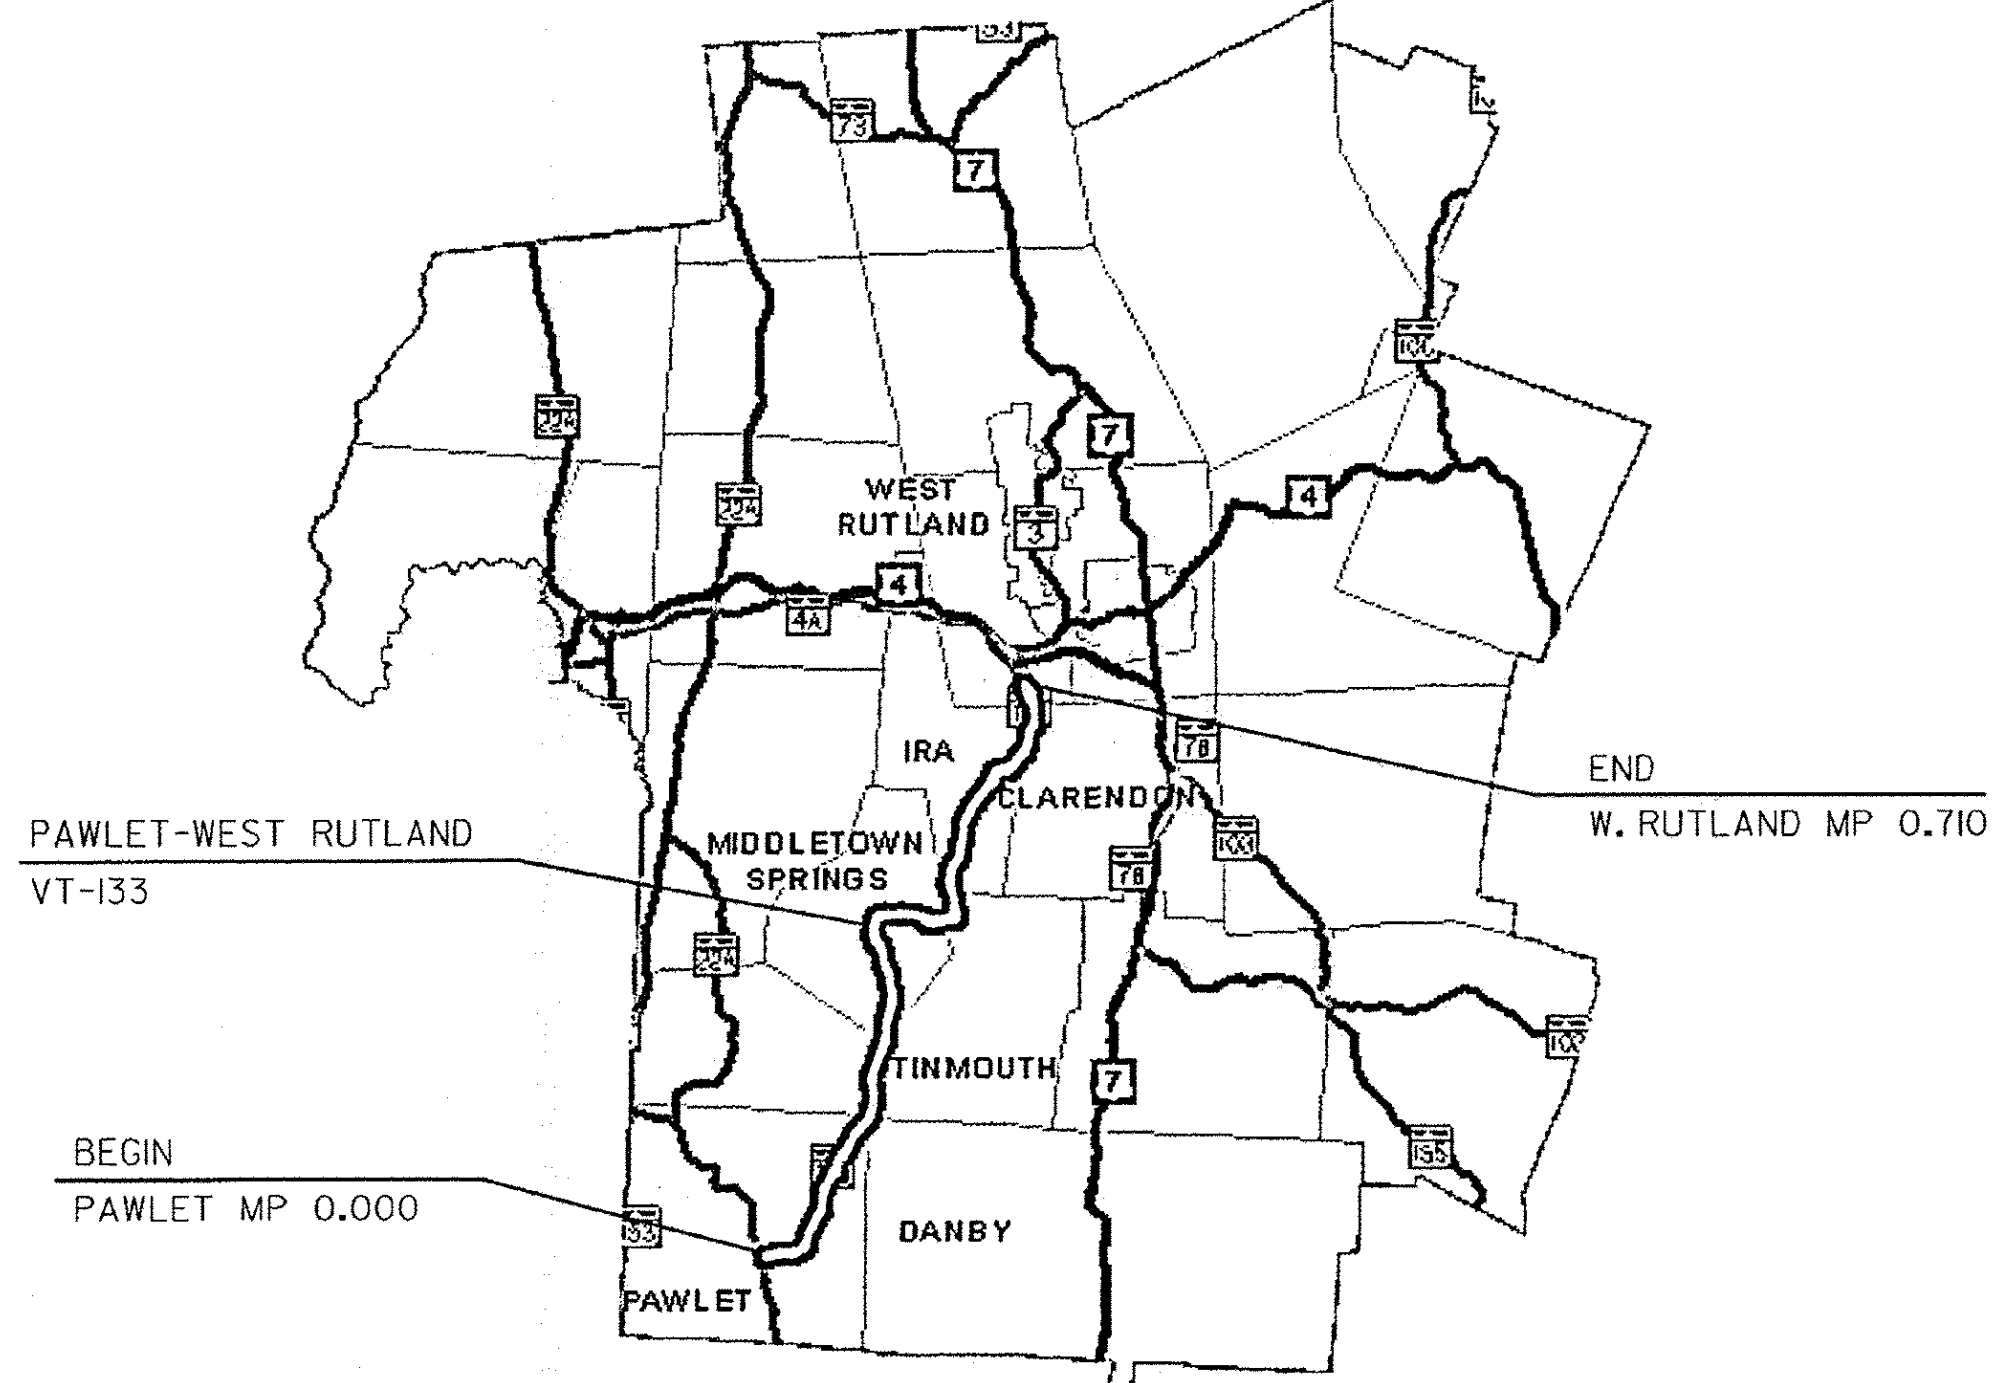

NOT TO SCALE

QUALITY ASSURANCE PROGRAM: LEVEL 3

CONVENTIONAL SYMBOLS	
COUNTY LINE	
TOWN LINE	
LIMITS OF ACCESS	
POINT OF ACCESS	
FENCE LINE	
STONE WALL	
TRAVELED WAY	
GUARD RAIL	
RAILROAD	
SURVEY LINE	
CULVERT	
POWER POLE	
TELEPHONE POLE	
TREES	
CONTROL OF ACCESS	
PROPERTY LINE	
R.O.W. TAKING LINE	
SLOPE RIGHTS	
TOP OF CUT	
TOE OF SLOPE	

SURVEYED BY :	N/A
SURVEYED DATE :	N/A
DATUM	
VERTICAL	N/A
HORIZONTAL	N/A

THESE PLANS ARE SUBJECT TO SUCH ENGINEERING CHANGES AS MAY BE REQUIRED BY THE FEDERAL HIGHWAY ADMINISTRATION OR THE DIRECTOR OF PROGRAM DEVELOPMENT.
CONSTRUCTION IS TO BE CARRIED ON IN ACCORDANCE WITH THESE PLANS AND THE STANDARD SPECIFICATIONS FOR CONSTRUCTION DATED 2006, AS APPROVED BY THE FEDERAL HIGHWAY ADMINISTRATION ON JUNE 15, 2006 FOR USE ON THIS PROJECT, INCLUDING ALL SUBSEQUENT REVISIONS AND SUCH REVISED SPECIFICATIONS AND SPECIAL PROVISIONS AS ARE INCORPORATED IN THESE PLANS.

DIRECTOR OF PROGRAM DEVELOPMENT	
APPROVED	DATE 5/9/11
PROJECT MANAGER : AMY GAMBLE	
PROJECT NAME : PAWLET - WEST RUTLAND	
PROJECT NUMBER : STPG SIGN (37)	
SHEET 1 OF 61 SHEETS	

GENERAL NOTES

INDEX SHEETS

1	TITLE SHEET
2	GENERAL NOTES
3	QUANTITY SHEET I
4-7	SIGN DETAILS
8	ROUTE MARKER SIGN ASSEMBLY
9-15	PAWLET NB VT-133 TRAFFIC SIGN SUMMARY SHEETS 1-7
16-23	PAWLET SB VT-133 TRAFFIC SIGN SUMMARY SHEETS 1-8
24	DANBY NB & SB VT-133 TRAFFIC SIGN SUMMARY SHEET I
25-26	TINMOUTH NB (SOUTH OF MIDDLETOWN SPRINGS) VT-133 TRAFFIC SIGN SUMMARY SHEETS 1-2
27-29	TINMOUTH SB (SOUTH OF MIDDLETOWN SPRINGS) VT-133 TRAFFIC SIGN SUMMARY SHEETS 1-3
30-35	MIDDLETOWN SPRINGS NB VT-133 TRAFFIC SIGN SUMMARY SHEETS 1-6
36-42	MIDDLETOWN SPRINGS SB VT-133 TRAFFIC SIGN SUMMARY SHEETS 1-7
43-44	TINMOUTH NB (NORTH OF MIDDLETOWN SPRINGS) VT-133 TRAFFIC SIGN SUMMARY 1-2
45-47	TINMOUTH SB (NORTH OF MIDDLETOWN SPRINGS) VT-133 TRAFFIC SIGN SUMMARY 1-3
48-50	IRA NB VT-133 TRAFFIC SIGN SUMMARY SHEETS 1-3
51-53	IRA SB VT-133 TRAFFIC SIGN SUMMARY SHEETS 1-3
54-55	CLARENDON NB VT-133 TRAFFIC SIGN SUMMARY SHEETS 1-2
56-57	CLARENDON SB VT-133 TRAFFIC SIGN SUMMARY SHEETS 1-2
58-59	WEST RUTLAND NB VT-133 TRAFFIC SIGN SUMMARY SHEETS 1-2
60	WEST RUTLAND SB VT-133 TRAFFIC SIGN SUMMARY SHEET I
61	TOWN TOTAL SIGN SUMMARY SHEET

STANDARDS

E-121	STANDARD SIGN PLACEMENT CONVENTIONAL ROAD	08/08/1995
E-136B	STATE ROUTE MARKER SIGN DETAILS	08/08/1995
E-136C	STATE NUMBERED TOWN HIGHWAY SIGN DETAILS	08/08/1995
E-138	MILE MARKER DETAILS STATE AND TOWN HIGHWAYS	05/30/2003
E-163	TUBULAR STEEL SIGN POSTS	05/20/1999
E-164	SQUARE STEEL SIGN POST	06/08/2009

SIGN DESIGN AND FABRICATION

- THE MUTCD SIGN CODES PROVIDED IN THESE PLANS REFER TO THE 2009 MUTCD. DESIGN DETAILS FOR SIGNS INDICATED ON THE PLANS AS FOUND IN THE SHSM, SHALL BE PER 2009 STANDARD HIGHWAY SIGN AND MARKINGS BOOK (SHSM), WHICH AT THIS TIME HAS NOT BEEN RELEASED. TO ADVANCE THE AVAILABILITY OF NEW INFORMATION FOR FIELD INSTALLATIONS AS SOON AS POSSIBLE, INTERIM RELEASES ARE PLANNED FOR ITEMS THAT ARE NEW OR SIGNIFICANTLY REVISED BY THE 2009 MUTCD AND CAN BE FOUND AT <http://mutcd.fhwa.dot.gov/shsm.InterIm/Index.htm>. THE CONTRACTOR SHALL CONTACT THE ENGINEER FOR SIGN DETAILS IF NONE ARE AVAILABLE FROM THESE SOURCES.
- SIGN SHEETING FOR FLUORESCENT YELLOW (FY) AND FLUORESCENT YELLOW-GREEN (FYG) SHALL BE ASTM D4956 TYPE VII, VIII OR IX. ALL OTHER SIGN SHEETING SHALL BE TYPE III OR IV.
- SHEETING TYPES AND MANUFACTURERS SHALL NOT BE MIXED ON A SINGLE SIGN ASSEMBLY. SHEETING COLOR/TYPE SHOULD BE BY THE SAME MANUFACTURER AND BE CONSISTENT THROUGHOUT THE PROJECT.
- SIGN BASE MATERIAL FOR DELINEATORS AND MILE MARKER PLAQUES (VD-700) SHALL BE 0.063" THICK FLAT SHEET ALUMINUM. UNLESS OTHERWISE NOTED ON THE PLANS, ALL OTHER SIGNS SHALL BE FLAT SHEET ALUMINUM WITH THE FOLLOWING MINIMUM THICKNESSES:

SIGN SIZE	9" X 12"		
	12" X 12"		
	18" X 18"		
	21" X 15"		
	24" X 10"		48" X 18"
	24" X 12"	36" X 12"	48" X 24"
	24" X 18"	36" X 15"	48" X 30"
	24" X 24"	36" X 18"	48" X 42"
	24" X 30"	36" X 24"	48" X 48"
	30" X 15"	30" X 42"	48" X 60"
	30" X 18"	36" X 36"	72" X 10"
	30" X 30"	36" X 48"	72" X 12"
	30" X 42"	36" X 54"	72" X 20"
THICKNESS	0.080"	0.100"	0.125"

SIGN POSTS


- ALL SQUARE STEEL SIGN POSTS SHALL BE INSTALLED IN A NEW ANCHOR. ALL SIGNS INSTALLED IN PAVED OR CONCRETE ISLANDS OR SIDEWALKS SHALL ALSO BE INSTALLED WITH AN 18" SLEEVE. PAYMENT FOR SLEEVE SHALL BE INCIDENTAL TO THE SIGN POST.
- 1.75" SQUARE STEEL POSTS SHALL BE 14 GAUGE STEEL. 2" AND 2.5" SQUARE STEEL POSTS SHALL BE 12 GAUGE STEEL.

SIGN INSTALLATION

- THE CONTRACTOR SHALL BE RESPONSIBLE FOR REPAIRING ANY DAMAGE TO PRIVATE OR PUBLIC PROPERTY CAUSED BY THE CONTRACTOR, AT THEIR EXPENSE.
- ALL SIGNS WITHIN THE PROJECT LIMITS ARE TO BE REPLACED UNLESS OTHERWISE NOTED OR AS DIRECTED BY THE RESIDENT ENGINEER. SIGN LOCATIONS AS SHOWN ON THE PLANS ARE APPROXIMATE. EXACT LOCATIONS TO BE DETERMINED IN THE FIELD.
- ALL SIGN PLACEMENT SHALL BE IN CONFORMANCE WITH VAOT STANDARD E-121 STANDARD SIGN PLACEMENT CONVENTIONAL ROADS, UNLESS OTHERWISE NOTED.
- ALL SIGNS, FRAMES, MOUNTING HARDWARE, POSTS, AND ANCHORS FOR ANY SIGN ASSEMBLY SHALL BE REPLACED AT THE SAME TIME. MIXING OF OLD AND NEW SIGNS ON THE SAME ASSEMBLY WILL NOT BE ALLOWED.
- NEW SIGNS WITH THEIR GREATER NIGHTTIME REFLECTIVITY CAN OBSCURE OLDER SIGNS MOUNTED ADJACENT TO THEM. TO AVOID CONFUSION OF ROAD USERS, WORK SHALL BE COORDINATED SUCH THAT ALL SIGNS ASSOCIATED WITH A CURVE, INTERSECTION, OR SPEED CHANGES, SHALL BE REPLACED ON THE SAME DAY AND NOT LEFT INCOMPLETE OR WITH A MIXTURE OF OLD AND NEW SIGNS WITHIN A GROUP OF ASSOCIATED SIGNS.
- ALL NEW SIGN INSTALLATIONS SHALL BE NO CLOSER THAN 10 FEET FROM UTILITY POLES.

TEMPORARY TRAFFIC CONTROL NOTES

- THE CONTRACTOR SHALL SUBMIT SITE SPECIFIC TRAFFIC CONTROL PLANS CONFORMING TO THE MANUAL ON UNIFORM TRAFFIC CONTROL DEVICES (MUTCD), DATED 2009, AND ITS LATEST REVISIONS, AT THE PRE-CONSTRUCTION MEETING FOR REVIEW AND APPROVAL BY THE RESIDENT ENGINEER.
- WHEN WORKING IN THE VICINITY OF EXISTING PEDESTRIAN FACILITIES, ADA ACCESSIBLE PEDESTRIAN ACCOMMODATIONS SHALL BE MAINTAINED AT ALL TIMES. PAYMENT SHALL BE INCLUDED IN THE UNIT BID PRICE FOR CONTRACT ITEM 641.10 TRAFFIC CONTROL.
- THE CONTRACTOR MUST PROVIDE ACCESS THROUGH THE WORK ZONE FOR EMERGENCY VEHICLES AT ALL TIMES.
- THE CONTRACTOR SHALL CONDUCT THE WORK AT ALL TIMES IN SUCH A MANNER AND IN SUCH SEQUENCE SO AS TO ENSURE THE LEAST INTERFERENCE WITH TRAFFIC OCCURS.
- SIGNS SHALL ONLY BE VISIBLE TO MOTORISTS AT THE TIMES WHEN THE MESSAGE IS PERTINENT. I.E. A "FLAGGER AHEAD" SIGN SHALL ONLY BE VISIBLE TO MOTORISTS WHEN THE FLAGGER IS ACTUALLY PRESENT PERFORMING THEIR DUTIES.
- PAYMENT FOR CONSTRUCTION SIGNING WILL BE MADE UNDER CONTRACT ITEM 641.10.
- SIGNS SHALL BE MOVED AS WORK AREA MOVES. AT NO TIME SHALL THE FLAGGER SIGN BE GREATER THAN 1000 FEET IN ADVANCE OF THE FLAGGER STATION.

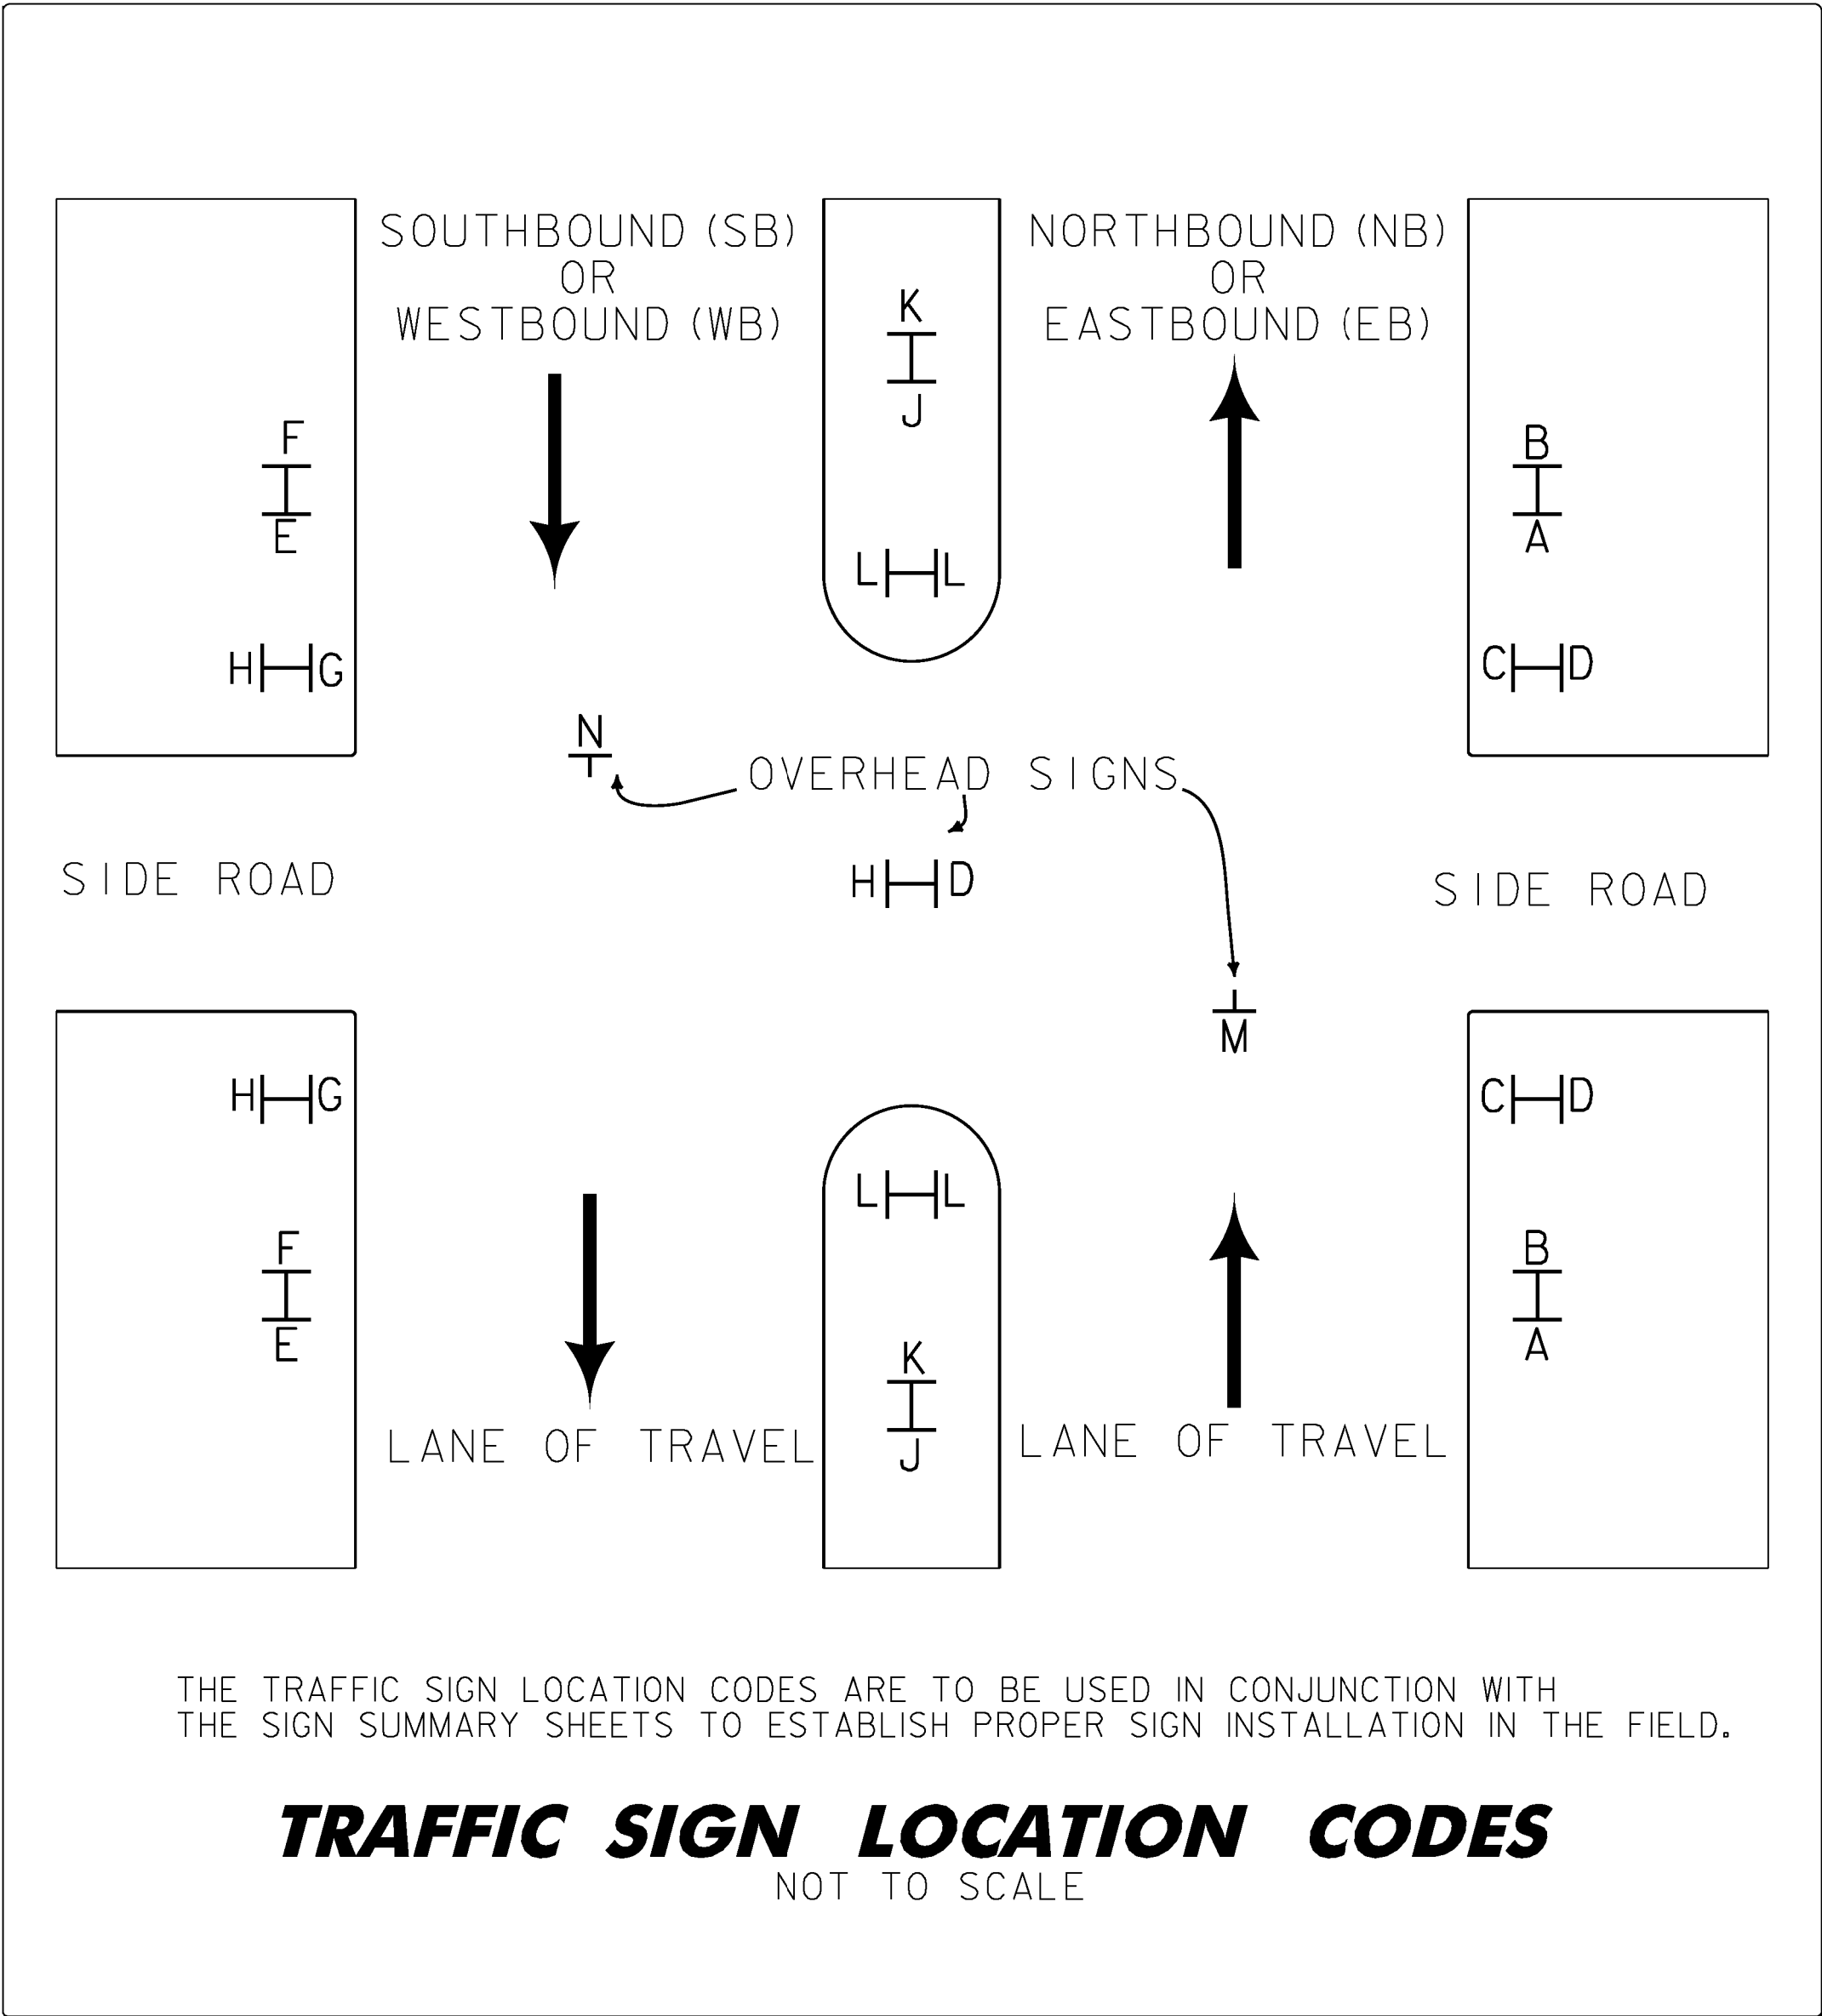

GENERAL NOTES

- EXISTING STAND ALONE MILE MARKERS OR MILE MARKERS ATTACHED TO A RETAINED SIGN POST ASSEMBLY SHALL BE RETAINED.
- EXISTING MILE MARKERS ON SIGN POSTS BEING REPLACED SHALL BE REMOVED AND SALVAGED ONTO THE NEW SIGN POST.
- EXISTING MILE MARKERS ATTACHED TO A SIGN ASSEMBLY THAT IS TO BE RELOCATED SHALL BE REMOVED, AND REINSTALLED ON A NEW POST UNLESS OTHERWISE DIRECTED BY THE ENGINEER.
- EXISTING STREET NAME SIGNS ATTACHED TO SIGN POSTS THAT ARE TO BE REPLACED SHALL BE REMOVED AND SALVAGED ONTO NEW POST.
- ALL EXISTING STREET NAME SIGNS INSTALLED ON STAND ALONE SIGN POSTS SHALL BE RETAINED UNLESS OTHERWISE NOTED.
- AN ESTIMATED QUANTITY FOR CONTRACT ITEMS 675.50 REMOVING SIGNS AND 675.60 ERECTING SALVAGED SIGNS HAS BEEN INCLUDED FOR MILE MARKERS AND STREET NAME SIGNS.
- SELECTIVE CUTTING OF BRUSH OR TREE BRANCHES IN THE IMMEDIATE VICINITY OF THE SIGN MAY BE NECESSARY TO PROVIDE FULL VISIBILITY FOR ANY EXISTING (RETAINED) OR NEW SIGN LOCATIONS. THIS WORK WILL BE PERFORMED AT THE DIRECTION OF THE RESIDENT ENGINEER AND PAID FOR UNDER CONTRACT ITEM 201.31 THINNING AND TRIMMING FOR SIGNS. THIS WORK SHALL BE DONE AT THE SAME TIME AS THE SIGNS ARE INSTALLED.

PROJECT NAME: PAWLET - WEST RUTLAND

PROJECT NUMBER: STPG SIGN (37)











FILE NAME: IOC340_TS.DGN
PROJECT LEADER: A. GAMBLE
DESIGNED BY: J. KELLY
GENERAL NOTES

PLOT DATE: \$\$\$DATE\$\$\$
DRAWN BY: J. KELLY
CHECKED BY: A. GAMBLE
SHEET 2 OF 61

QUANTITY SHEET 1

[illegible]

PROJECT NAME: PAWLET - WEST RUTLAND	
PROJECT NUMBER: STPG SIGN (37)	
FILE NAME: IOC340_TS.DGN	PLOT DATE: \$\$\$\$DATE\$\$\$
PROJECT LEADER: A. GAMBLE	DRAWN BY: J. KELLY
DESIGNED BY: J. KELLY	CHECKED BY: A. GAMBLE
QUANTITY SHEET 1	SHEET 3 OF 61

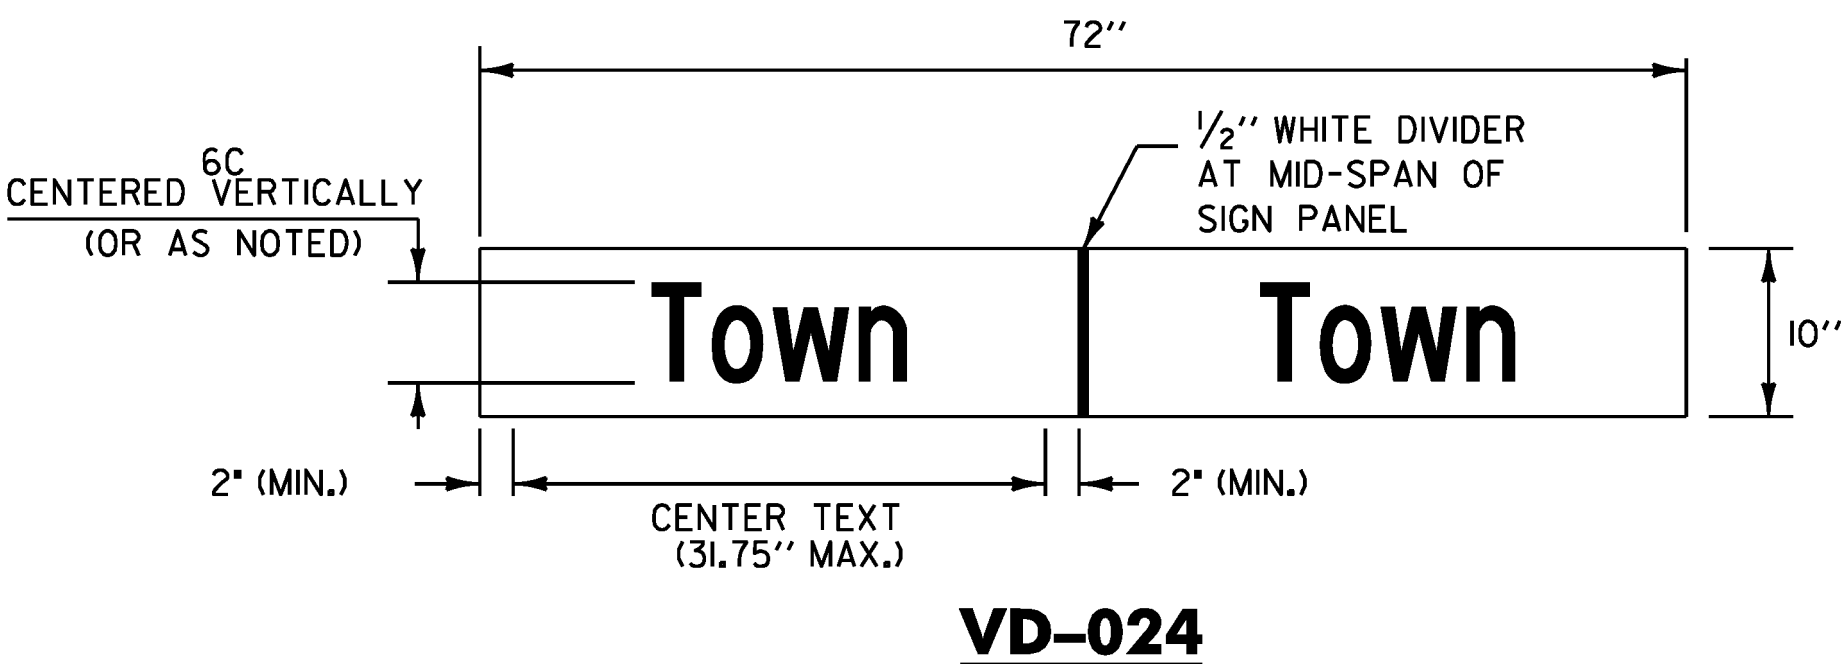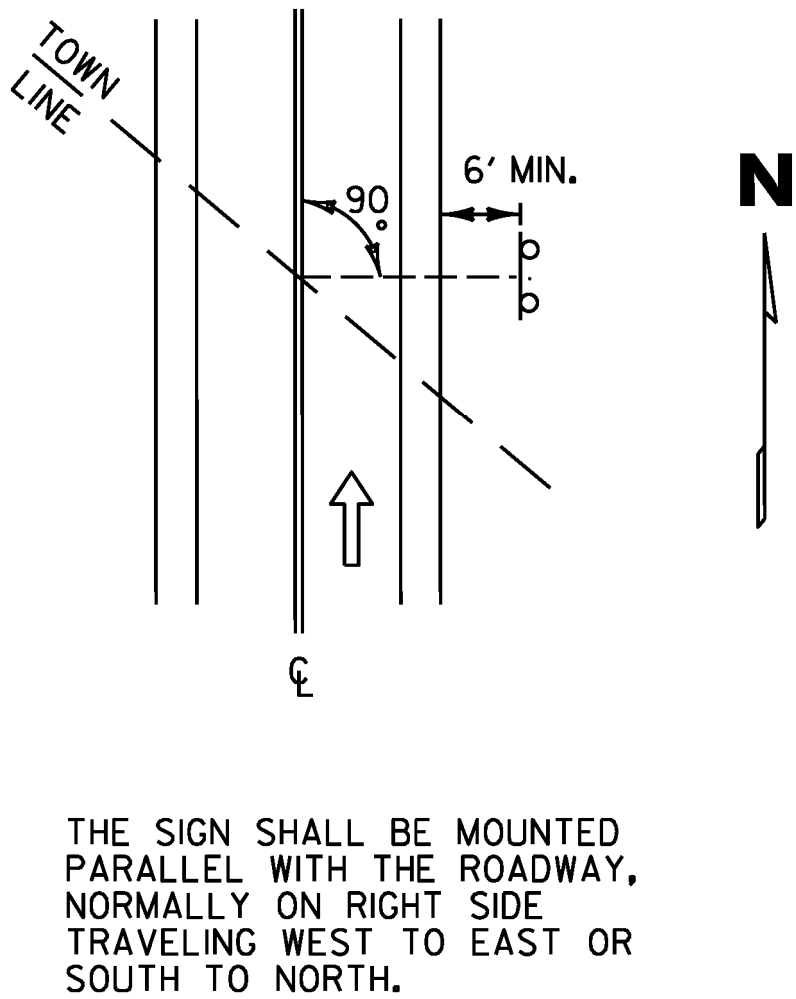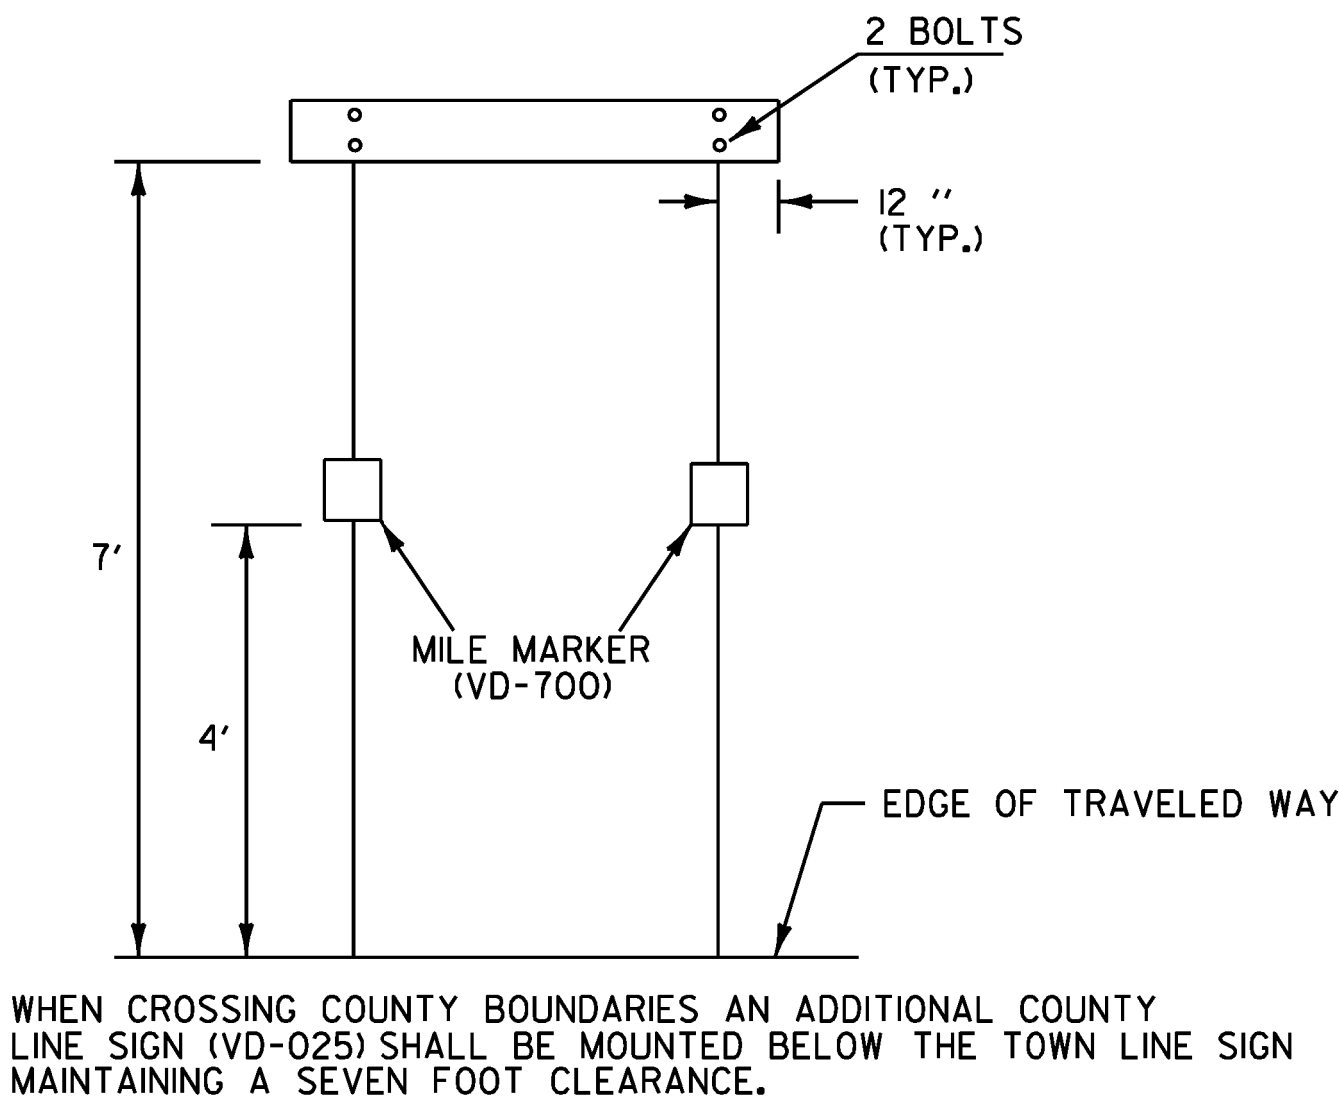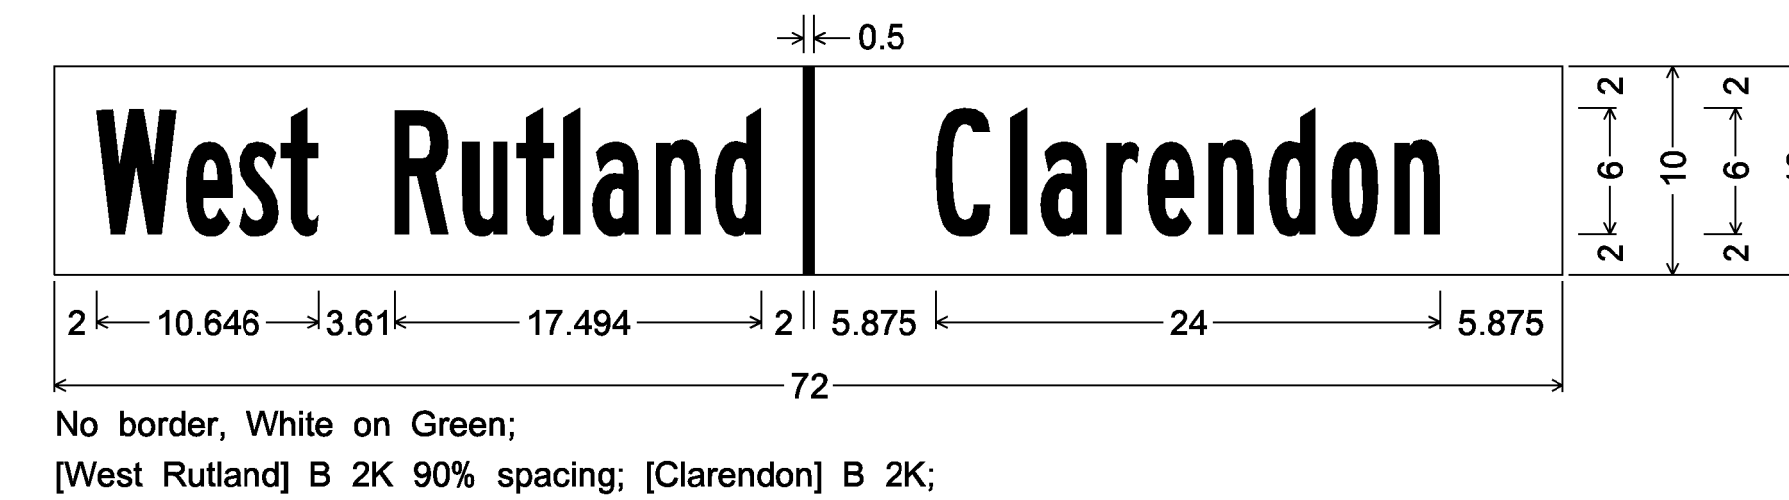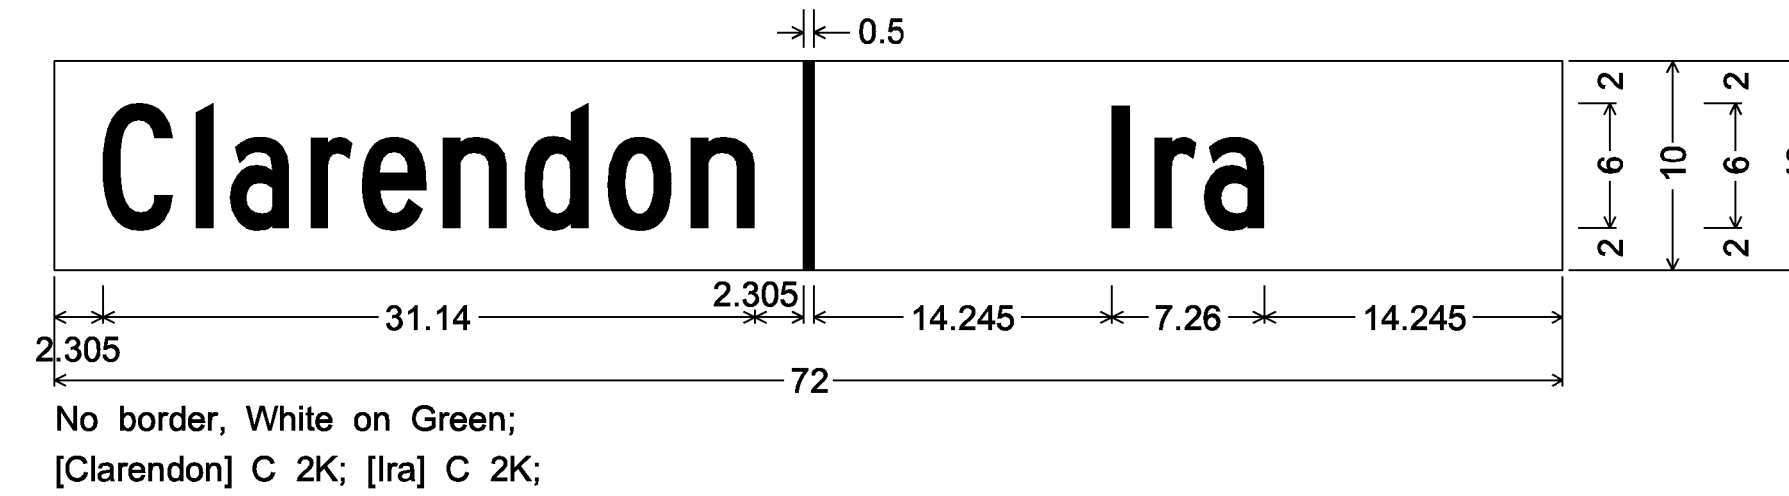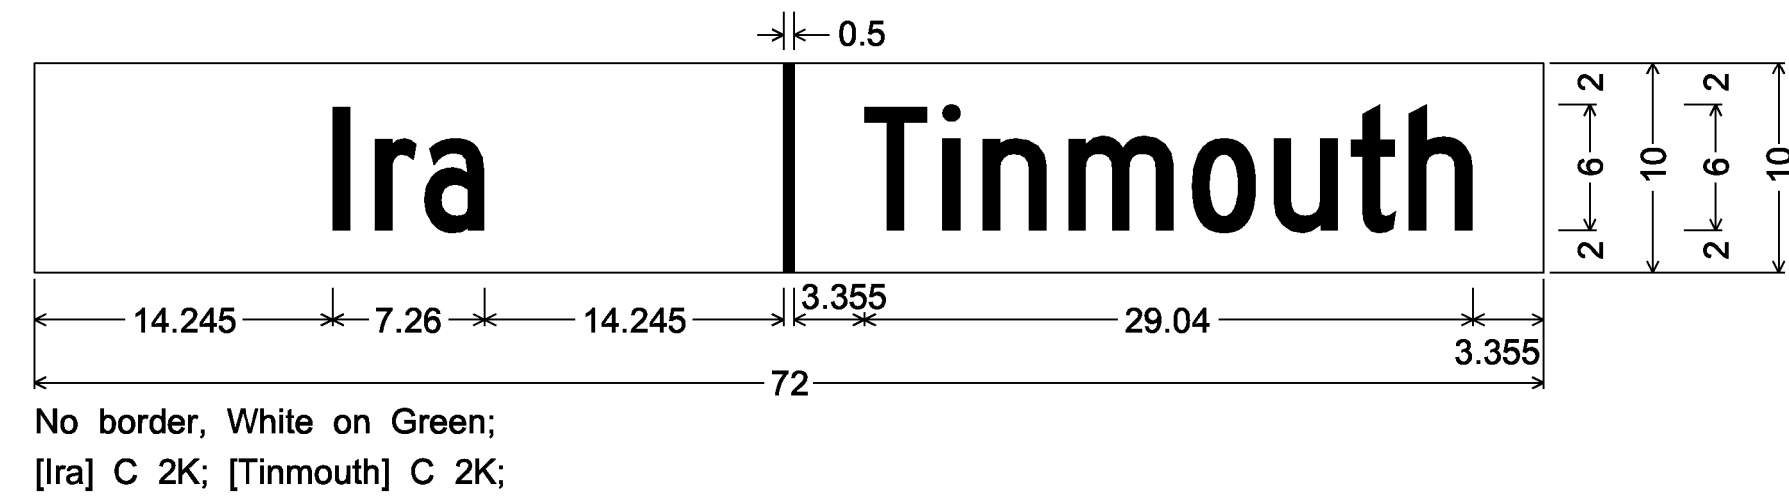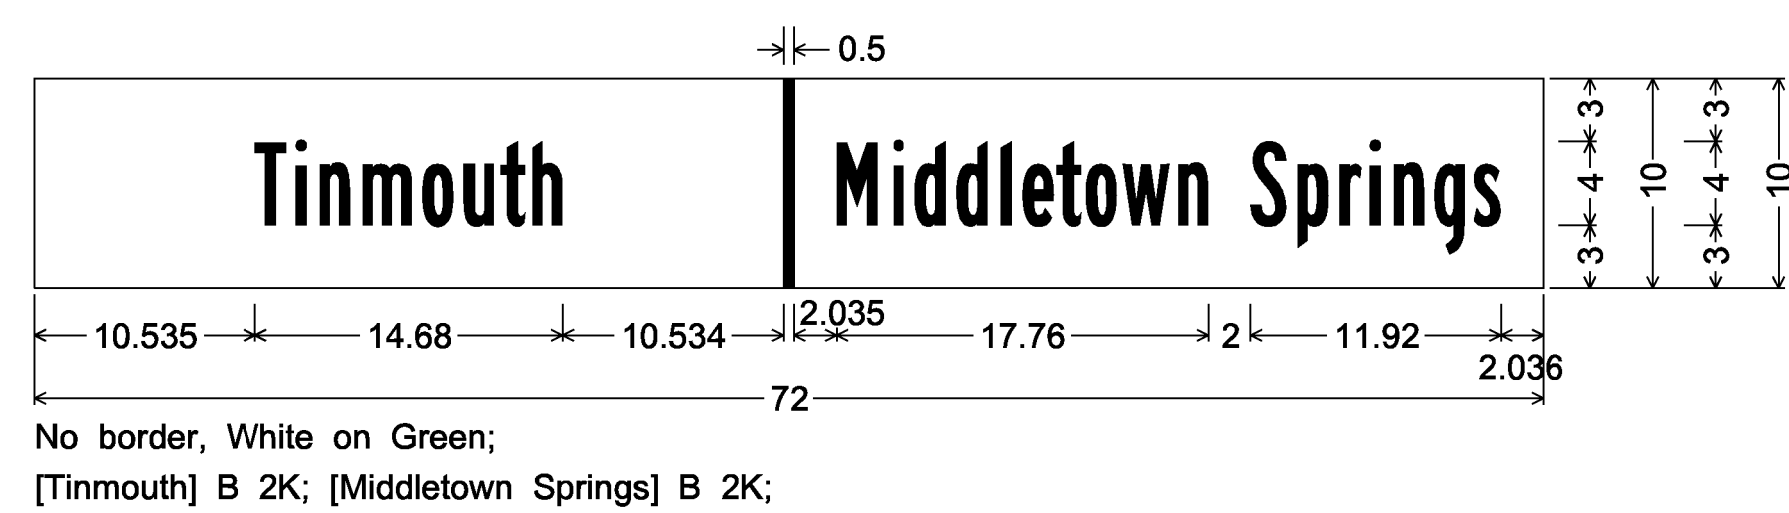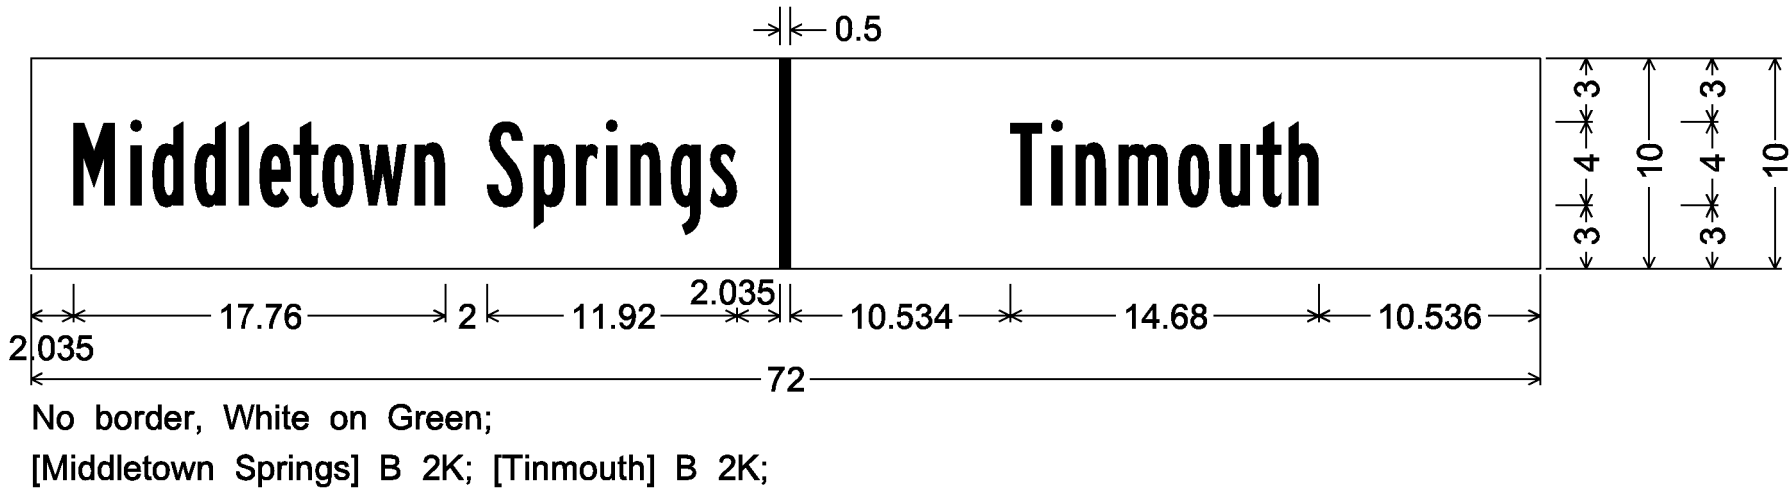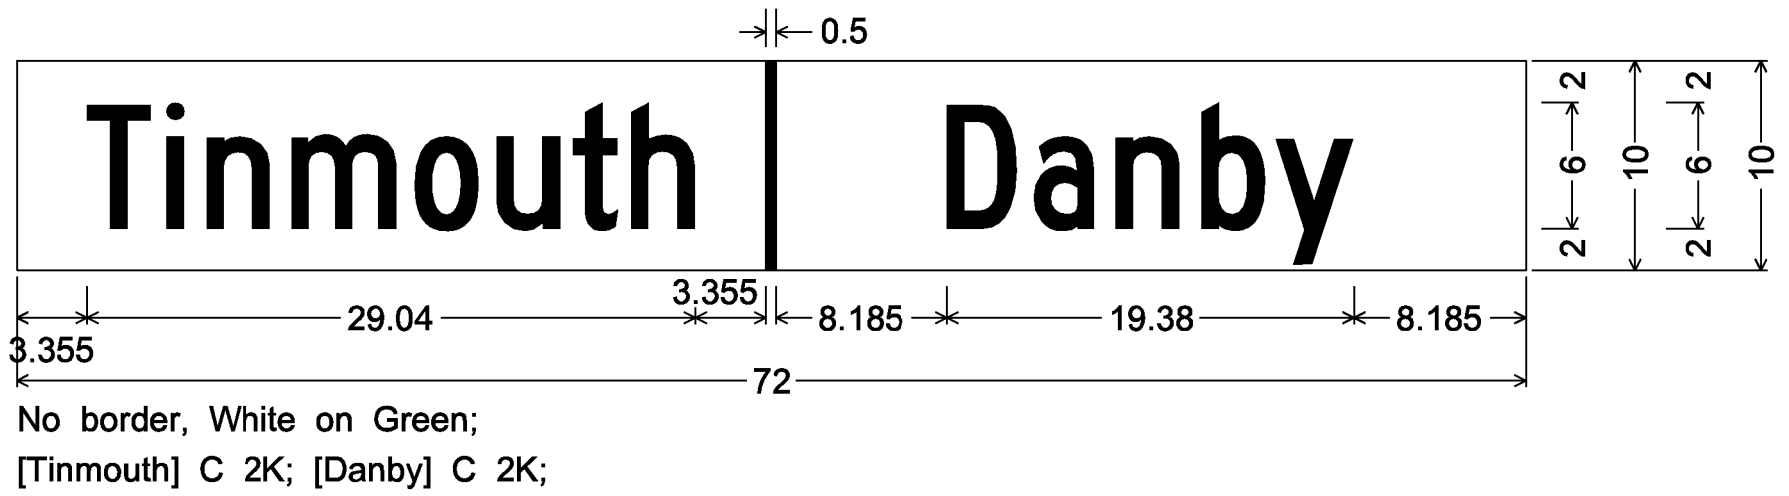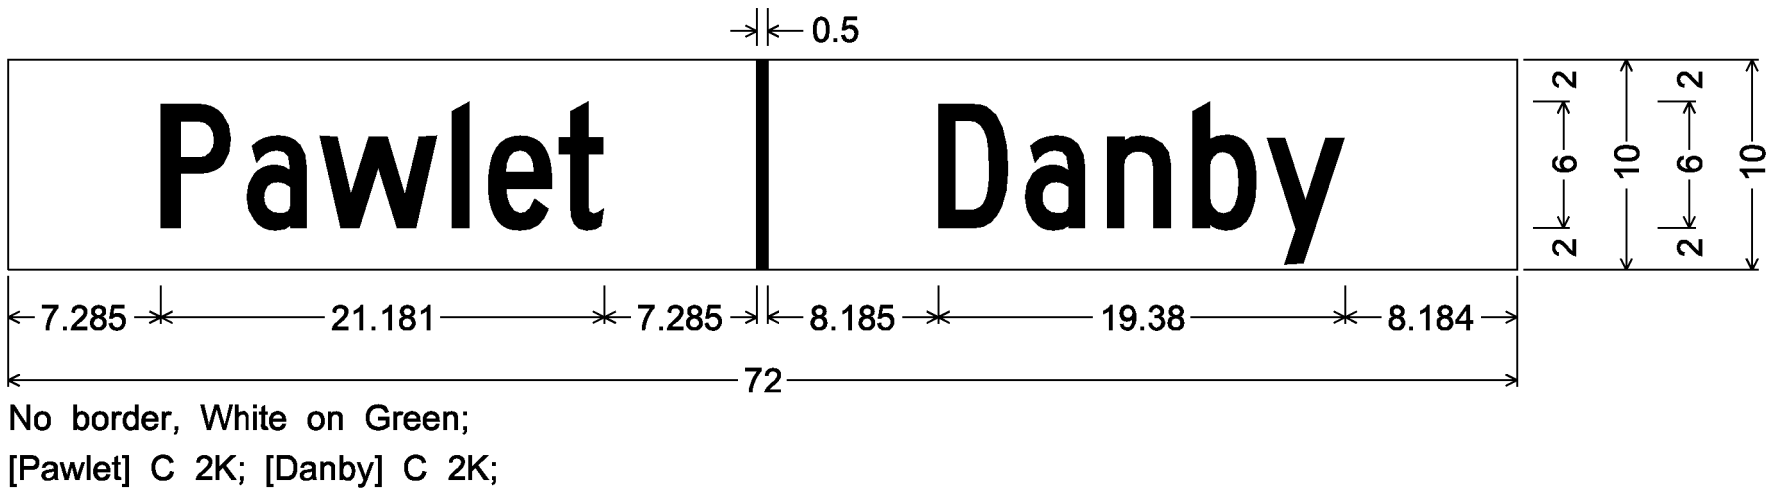

TOWN NAMES		
TEXT	SERIES	DIMENSIONS
Pawlet	C (6")	21.81
Danby	C (6")	19.38
Tinmouth	C (6")	29.04
Middletown Springs	B (4")	31.68
Ira	C (6")	7.26
Clarendon	C (6")	31.14
West Rutland	B (6")	31.75


NOTES:

- WORD TO WORD SPACING FOR MULTIPLE TEXT TOWN NAMES IS ADJUSTABLE TO ACCOMMODATE DIMENSION REQUIREMENTS.
- DIMENSIONS SHOWN ARE APPROXIMATE AND MAY BE ADJUSTED SLIGHTLY TO ACCOMMODATE VARIOUS MANUFACTURER'S LETTER WIDTHS.
- ALL DIMENSIONS ARE IN INCHES UNLESS OTHERWISE NOTED
- ALL TEXT ON AN INDIVIDUAL SIGN SHALL BE OF THE SAME SIZE AND FONT.


TOWN/COUNTY LINE SIGN NOTES:

- THE SIGN BASE MATERIAL SHALL BE HIGH DENSITY OVERLAID PLYWOOD 5/8 INCH THICK OR ALUMINUM SHEETING 0.125" MINIMUM THICKNESS. THE RETROREFLECTIVE MATERIAL SHALL BE SHEETING APPLIED TO THE ENTIRE BACKGROUND OF THE SIGN. THE LEGEND SHALL BE CUT-OUT RETROREFLECTIVE LEGEND. ALL RETROREFLECTIVE MATERIAL SHALL BE EQUAL TO OR EXCEEDING THE "THE AMERICAN SOCIETY OF TESTING AND MATERIALS" (ASTM) TYPE III.
- SIGNS SHALL HAVE A MINIMUM ASTM TYPE III SHEETING WITH A WHITE LEGEND ON A GREEN BACKGROUND.
- LEGEND SHALL CONFORM WITH THE STANDARD ALPHABETS FOR HIGHWAY SIGNS APPROVED BY THE NATIONAL JOINT COMMITTEE ON UNIFORM TRAFFIC CONTROL DEVICES. SIGNS SHALL BE FABRICATED IN UPPER/LOWER CASE TEXT AS SHOWN IN SIGN DETAIL.
- ALL SIGNS SHALL BE IN ACCORDANCE WITH "THE MANUAL ON UNIFORM TRAFFIC CONTROL DEVICES" (2009 MUTCD) AND THE "STANDARD HIGHWAY SIGNS" BOOK (2004 SHS) PUBLISHED BY THE FEDERAL HIGHWAY ADMINISTRATION (FHWA).


PROJECT NAME: PAWLET - WEST RUTLAND	
PROJECT NUMBER: STPG SIGN (37)	
FILE NAME: IOC340_TS.DGN	PLOT DATE: \$\$\$DATE\$\$\$
PROJECT LEADER: A. GAMBLE	DRAWN BY: J. KELLY
DESIGNED BY: J. KELLY	CHECKED BY: A. GAMBLE
SIGN DETAILS (I)	SHEET 4 OF 61

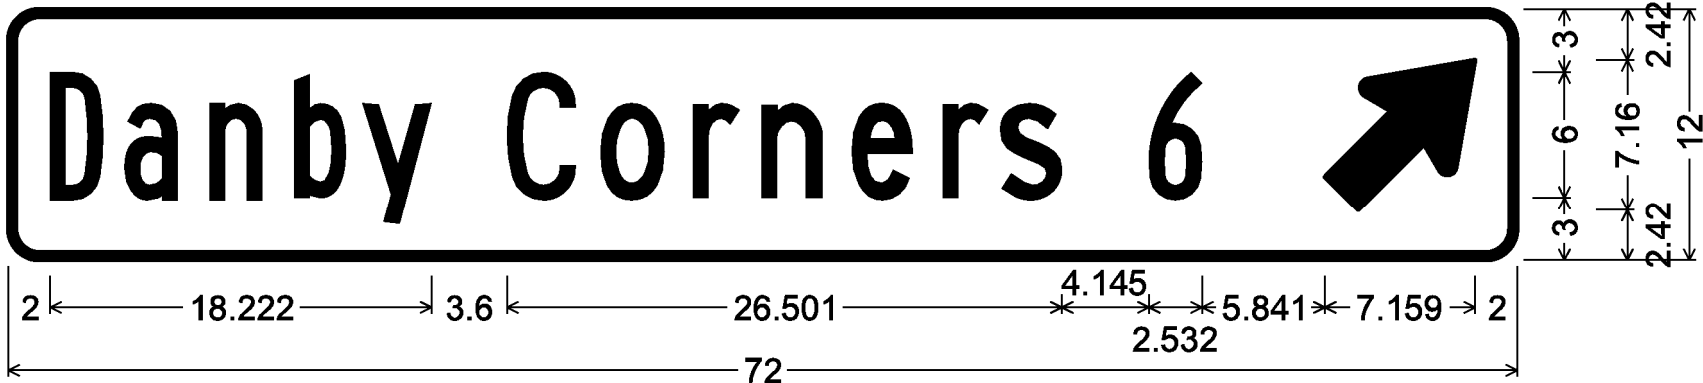

1.500" Radius, 0.375" Border, White on Green;
[Danby] B [Corners] C 90% spacing; [6] B 90% spacing;
Standard Arrow Custom 9.000" X 6.125" 45°;

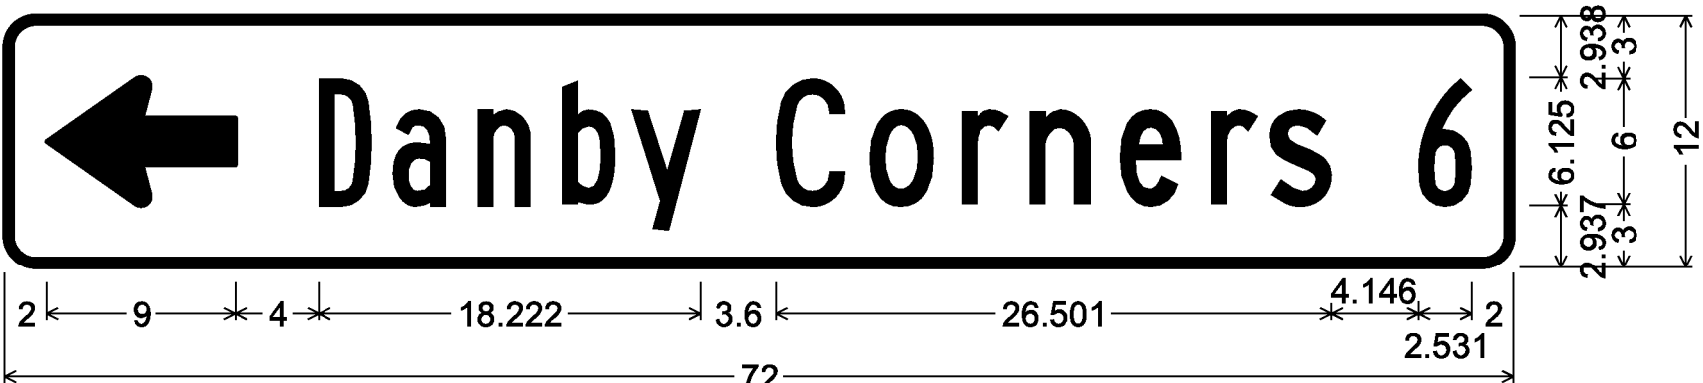


1.500" Radius, 0.375" Border, White on Green;
Standard Arrow Custom 9.000" X 6.125" 180°; [Danby] B [Corners] C 90% spacing;
[6] B 90% spacing;

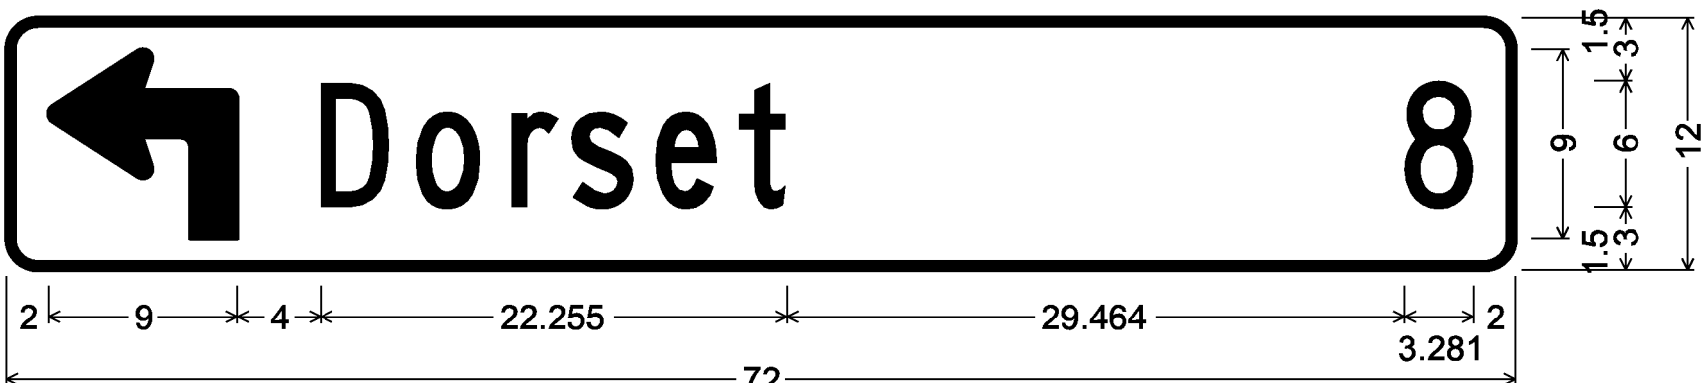


1.500" Radius, 0.375" Border, White on Green;
90 Deg Advanced Turn Arrow Custom 9.000" X 9.000"; [Dorset] C; [8] C;



1.500" Radius, 0.375" Border, White on Green;
90 Deg Advanced Turn Arrow Custom 9.000" X 9.000"; [Manchester] C; [15] C;

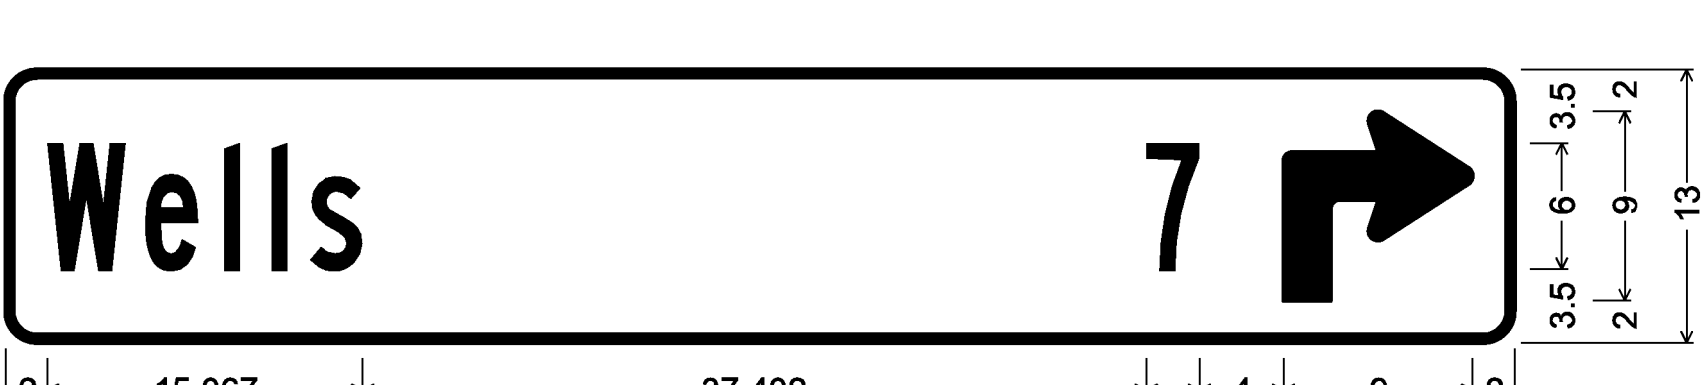


1.500" Radius, 0.375" Border, White on Green;
[Wells] B 90% spacing; [7] B 90% spacing;
90 Deg Advanced Turn Arrow Custom 9.000" X 9.000";

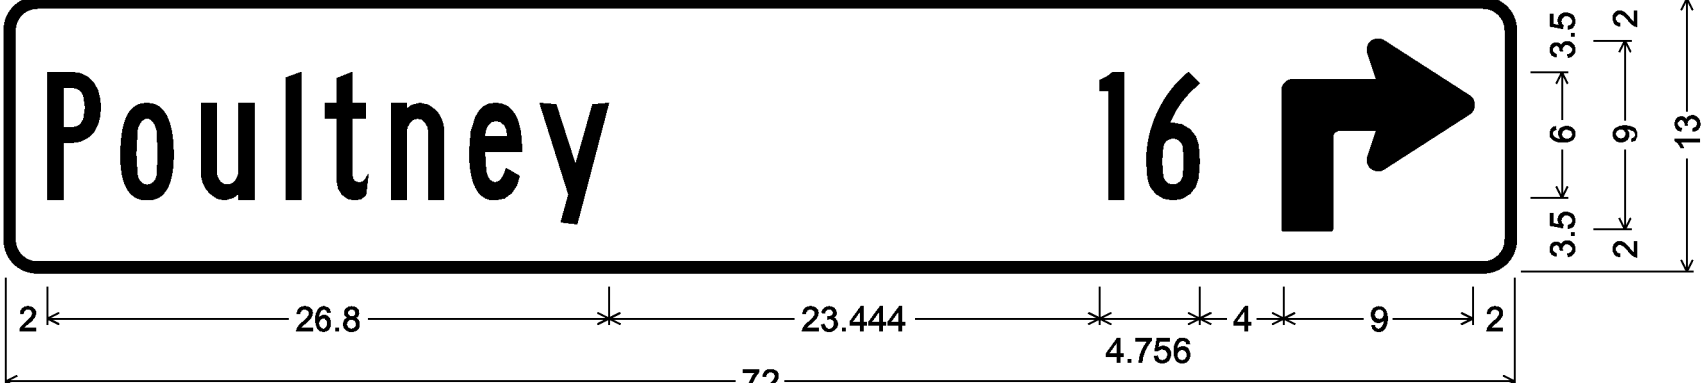


1.500" Radius, 0.375" Border, White on Green;
[Poultney] B 90% spacing; [16] B 90% spacing;
90 Deg Advanced Turn Arrow Custom 9.000" X 9.000";




1.500" Radius, 0.375" Border, White on Green;
Standard Arrow Custom 9.000" X 6.125" 180°; [Wells] C; [5] C;

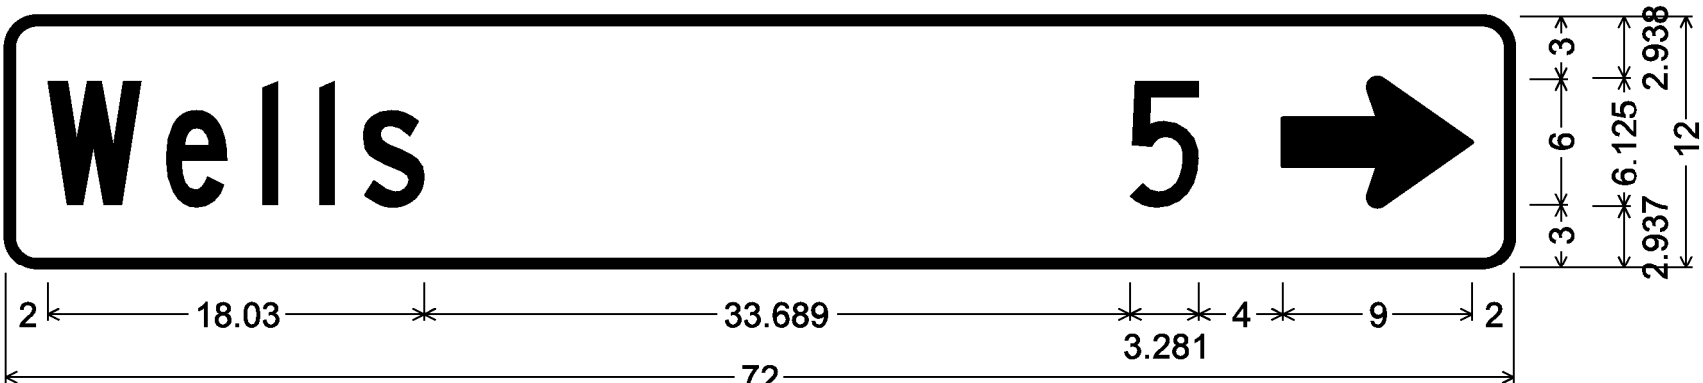


1.500" Radius, 0.375" Border, White on Green;
[Wells] C; [5] C; Standard Arrow Custom 9.000" X 6.125" 0°;

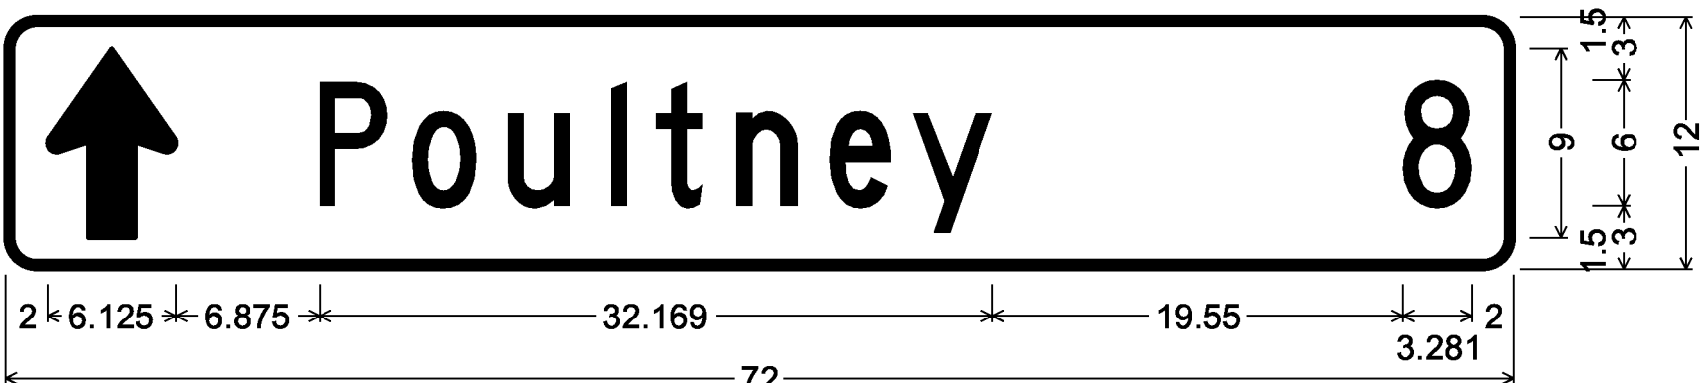


1.500" Radius, 0.375" Border, White on Green;
Standard Arrow Custom 9.000" X 6.125" 90°; [Poultney] C; [8] C;

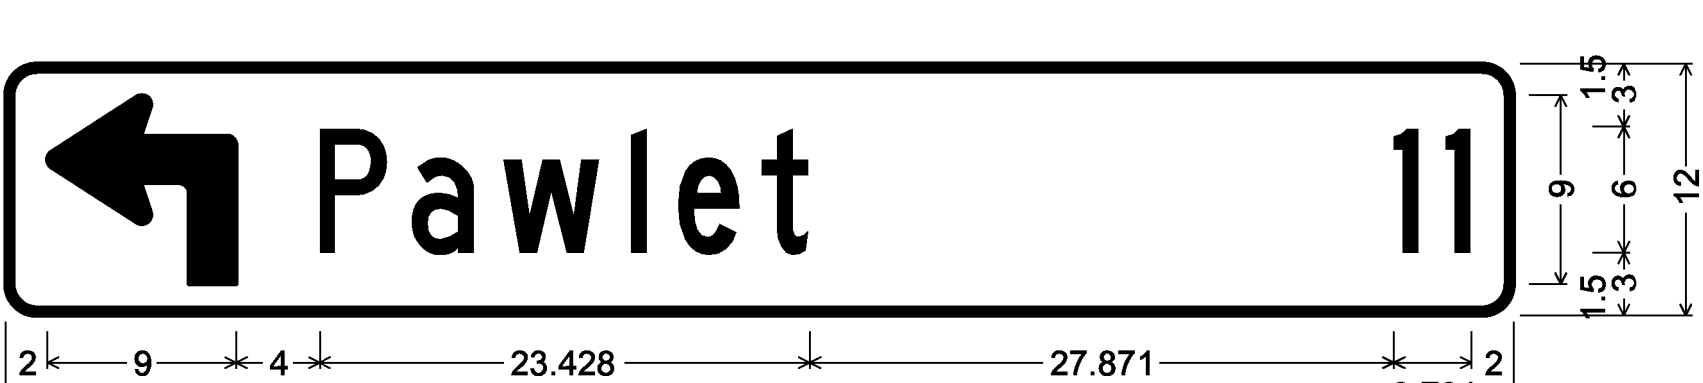


1.500" Radius, 0.375" Border, White on Green;
90 Deg Advanced Turn Arrow Custom 9.000" X 9.000"; [Pawlet] C; [11] C;

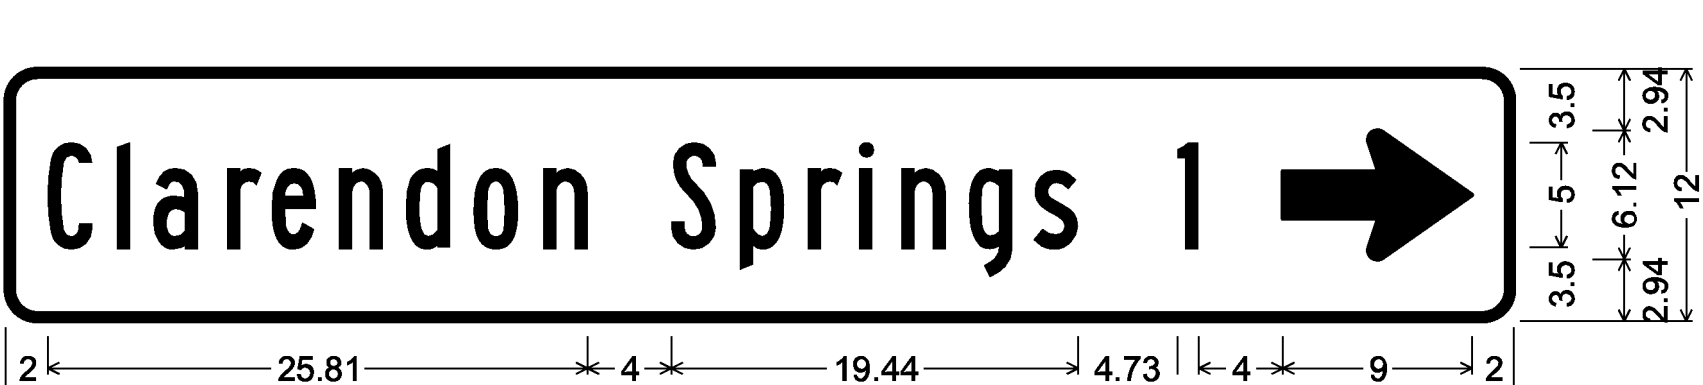

1.50" Radius, 0.38" Border, White on Green;
[Clarendon Springs] B; [1] B; Standard Arrow Custom 9.00" X 6.13" 0°;

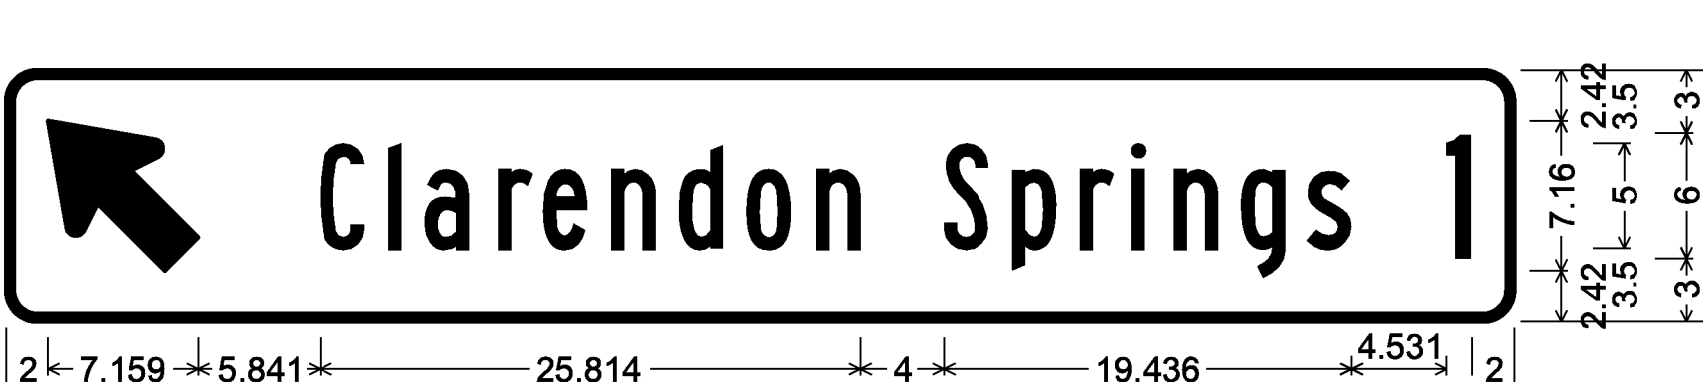


1.500" Radius, 0.375" Border, White on Green;
Standard Arrow Custom 9.000" X 6.125" 135°; [Clarendon Springs] B; [1] C;

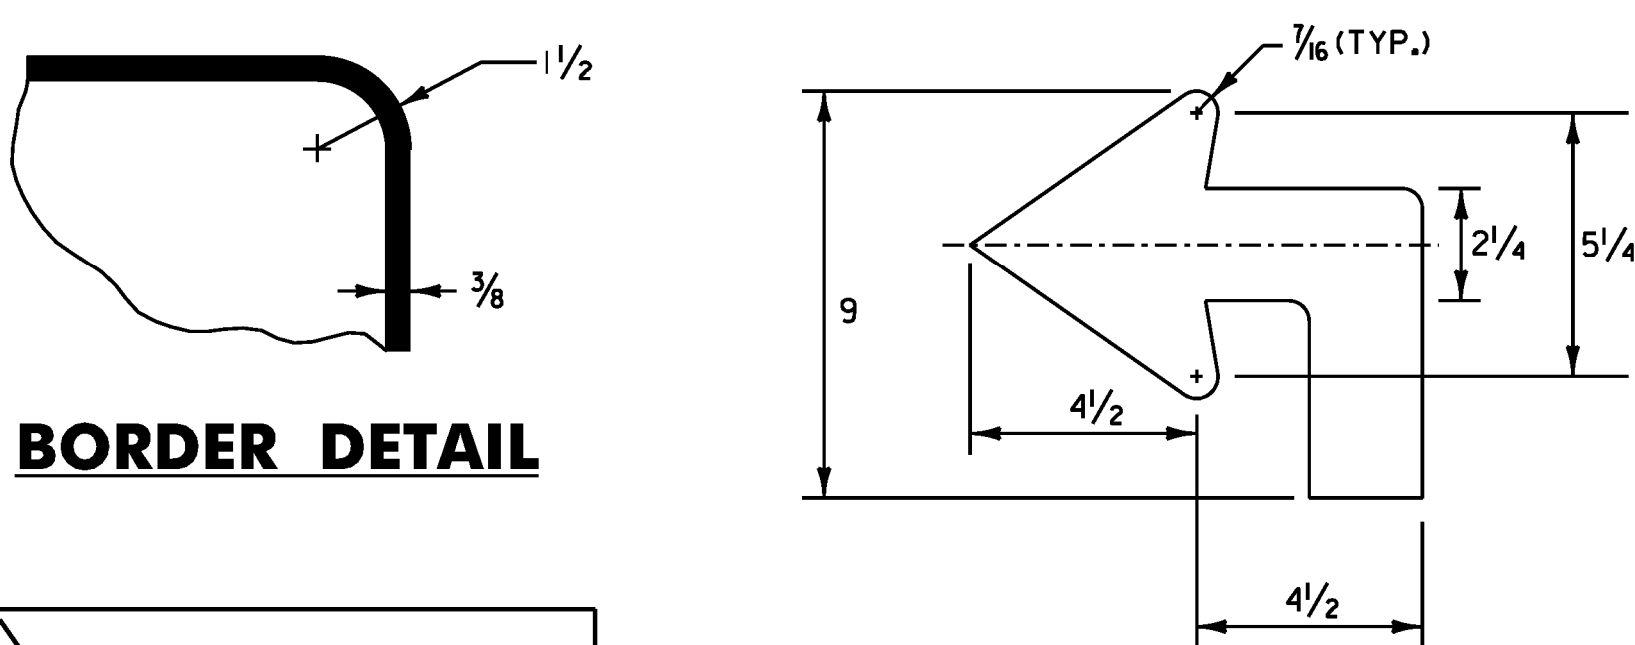

BORDER DETAIL

ADVANCE TURN ARROW
DETAIL USING
STANDARD 2.25" ARROW

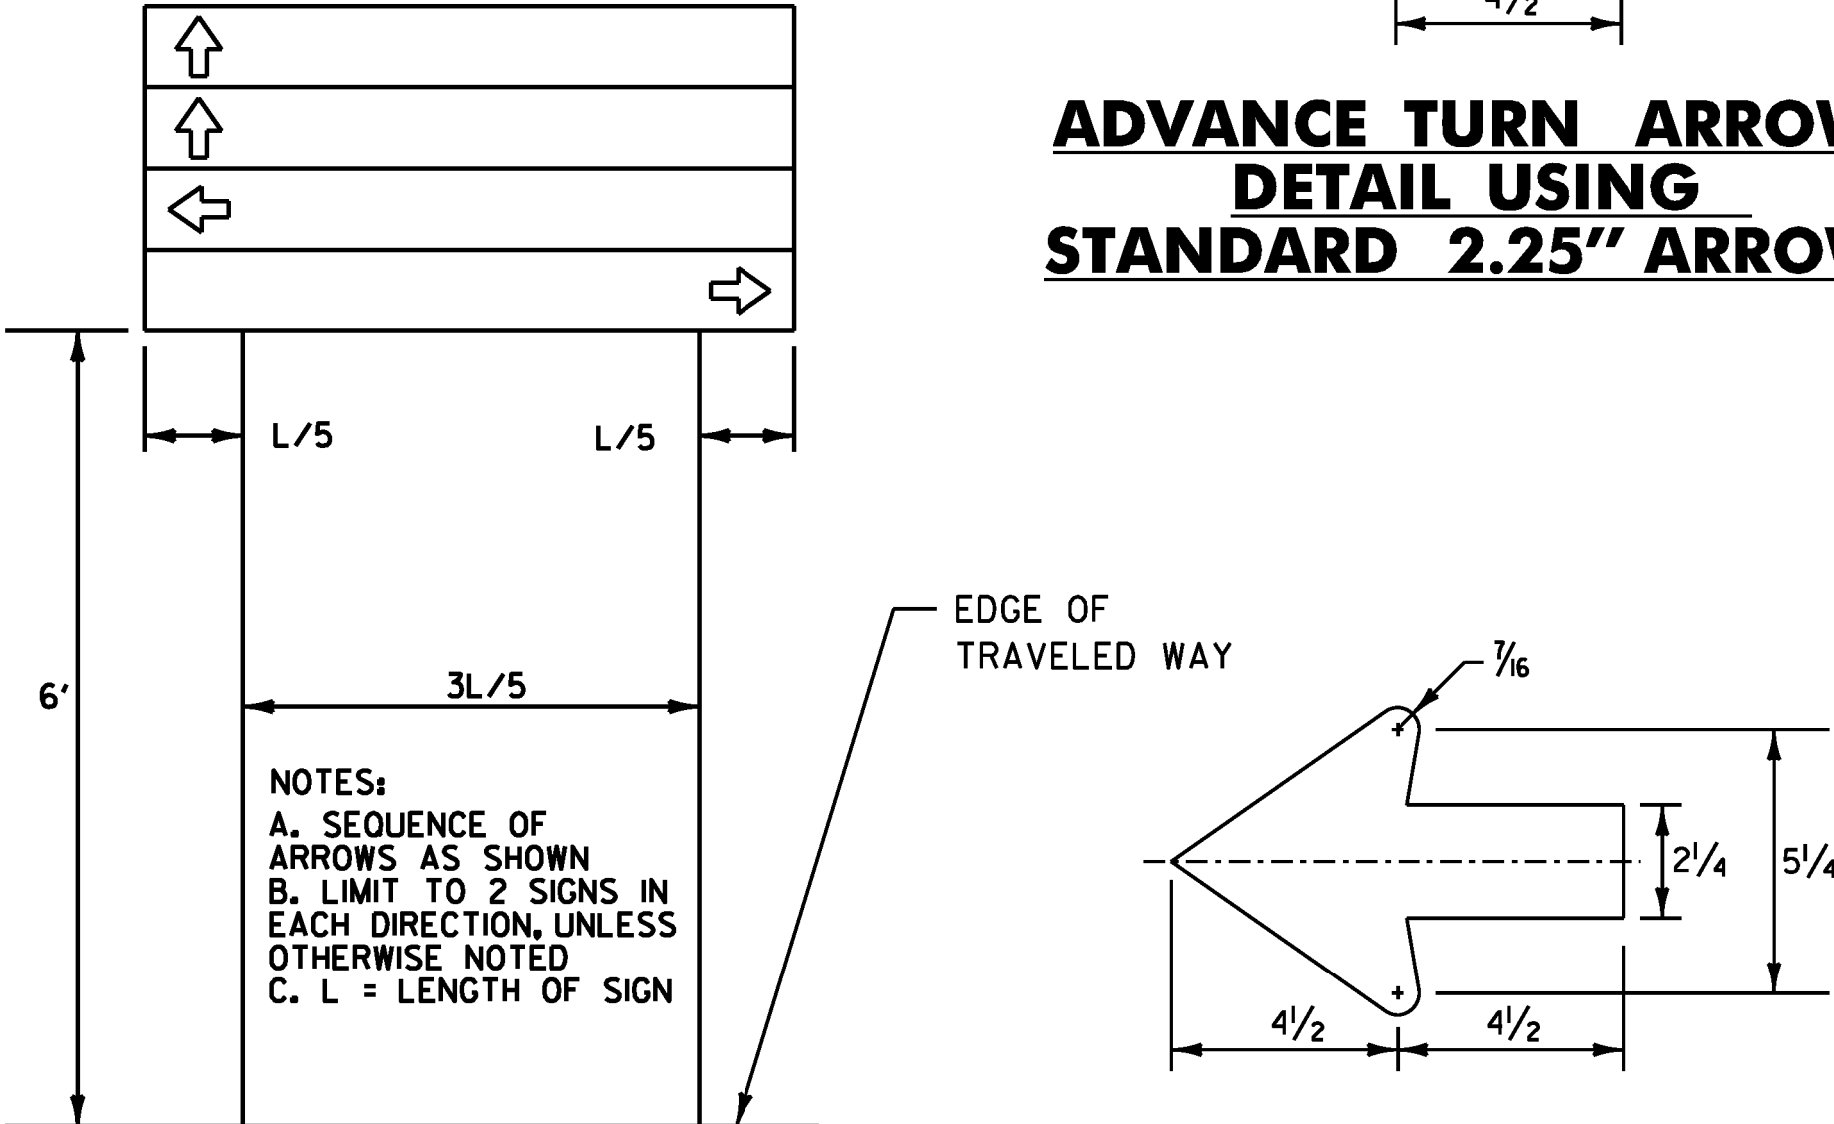

DESTINATION ASSEMBLY

STANDARD 2.25"
VERTICAL/HORIZONTAL ARROW

STANDARD DESTINATION SIGN NOTES
VD1-1, VD1-1A, VD1-2, VD2-1

1. THE DESTINATION SIGNS SHOWN ON THIS SHEET SHALL HAVE WHITE RETROREFLECTIVE ASTM TYPE III TEXT, ARROWS AND BORDERS ON A GREEN RETROREFLECTIVE ASTM TYPE III BACKGROUND. THE COLORS SHALL CONFORM WITH THE COLORS ADOPTED BY AASHTO AND APPROVED BY THE FHWA.
2. USE THE LARGEST LETTER / THICKEST FONT AVAILABLE THAT WILL SATISFY THE MINIMUM SPACING REQUIREMENTS, AS SHOWN IN THE DETAILS ABOVE (E.G. IF A 6" SERIES C LETTER DOES NOT WORK DUE TO THE LENGTH OF THE WORD, USE A 6" SERIES B LETTER. IF A 6" SERIES B LETTER DOES NOT WORK, USE A 5" SERIES C. USE NO LESS THAN 80% KERNING.

ALL DIMENSIONS SHOWN IN INCHES UNLESS OTHERWISE NOTED.

PROJECT NAME: PAWLET - WEST RUTLAND

PROJECT NUMBER: STPG SIGN (37)


FILE NAME: IOC340_TS.DGN
PROJECT LEADER: A. GAMBLE
DESIGNED BY: J. KELLY
SIGN DETAILS (2)

PLOT DATE: \$\$\$DATE\$\$\$
DRAWN BY: J. KELLY
CHECKED BY: A. GAMBLE
SHEET 5 OF 61


VD1-1A SIGN DETAILS




VR-020;
1.500" Radius, 0.625" Border, 0.375" Indent, Red on White;
"NO" D 2K;
"PARKING" B 2K;
"ON TRAVELED" B 2K;
"LANE" B 2K;

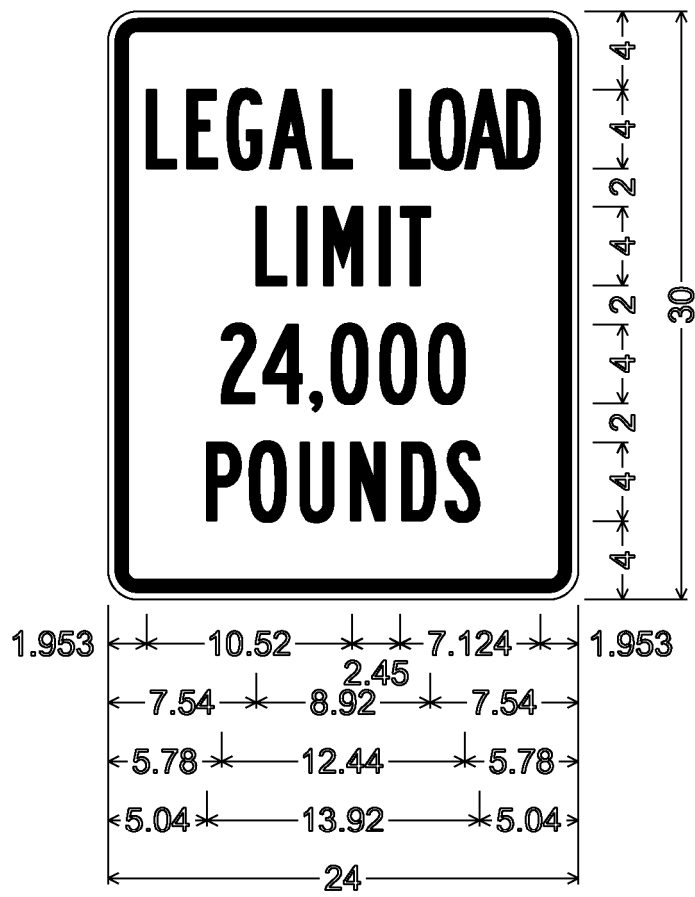

VR-017;
1.500" Radius, 0.625" Border, 0.375" Indent, Black on White;
"LEGAL" B 2K " LOAD" Highway B;
"LIMIT" B 2K;
"24,000" B 2K;
"POUNDS" B 2K;

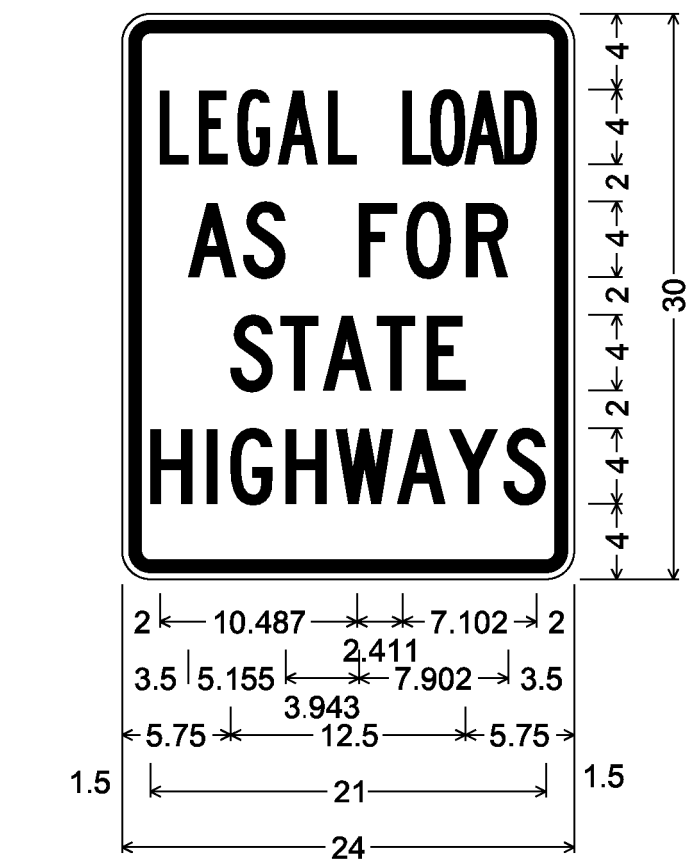

VR-017;
1.500" Radius, 0.625" Border, 0.375" Indent, Black on White;
[LEGAL] B 2K [LOAD] Highway B specified length;
[AS FOR] C 2K specified length;
[STATE] C 2K specified length;
[HIGHWAYS] C 2K specified length;

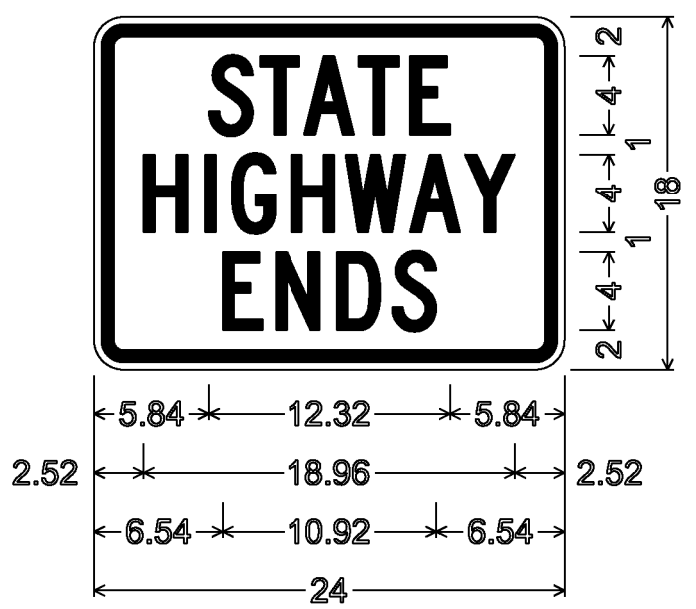

VR-038;
1.500" Radius, 0.625" Border, 0.375" Indent, Black on White;
"STATE" C 2K;
"HIGHWAY" C 2K;
"ENDS" C 2K;





VR-039;
1.500" Radius, 0.625" Border, 0.375" Indent, Black on White;
"STATE" C 2K;
"HIGHWAY" C 2K;
"BEGINS" C 2K;

ALL DIMENSIONS SHOWN IN INCHES UNLESS OTHERWISE NOTED.


PROJECT NAME: PAWLET - WEST RUTLAND

PROJECT NUMBER: STPG SIGN (37)



FILE NAME: IOC340_TS.DGN	PLOT DATE: \$\$\$\$DATE\$\$\$
PROJECT LEADER: A. GAMBLE	DRAWN BY: J. KELLY
DESIGNED BY: J. KELLY	CHECKED BY: A. GAMBLE
SIGN DETAILS (3)	SHEET 6 OF 61

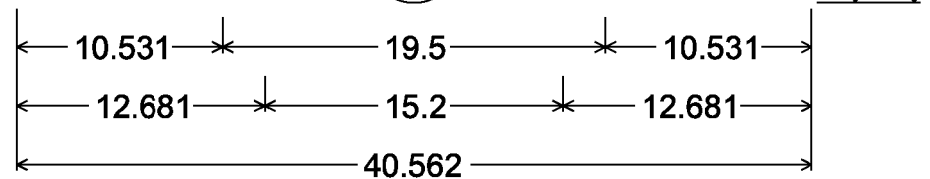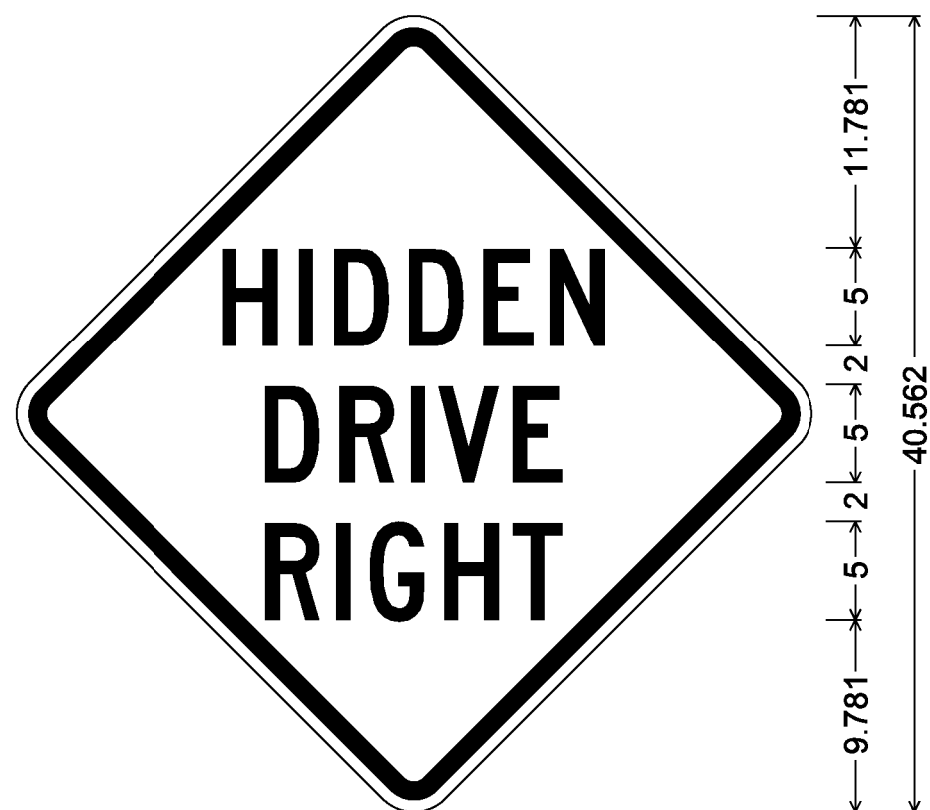


VW-054;
30.000" across sides 2.250" Radius, 0.875" Border, 0.625" Indent, Black on Yellow;
[HIDDEN] C 2K; [DRIVE] C 2K; [RIGHT] C 2K;

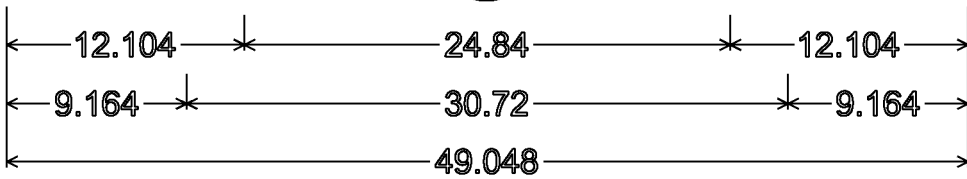


VW-202;
36.000" across sides 2.250" Radius, 0.875" Border, 0.625" Indent, Black on Yellow;
"TRUCKS" C 2K; "ENTERING" C 2K;

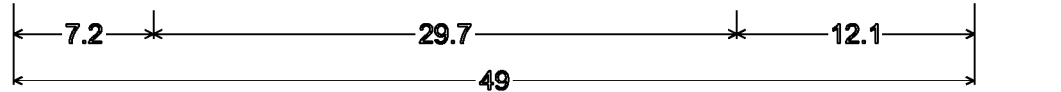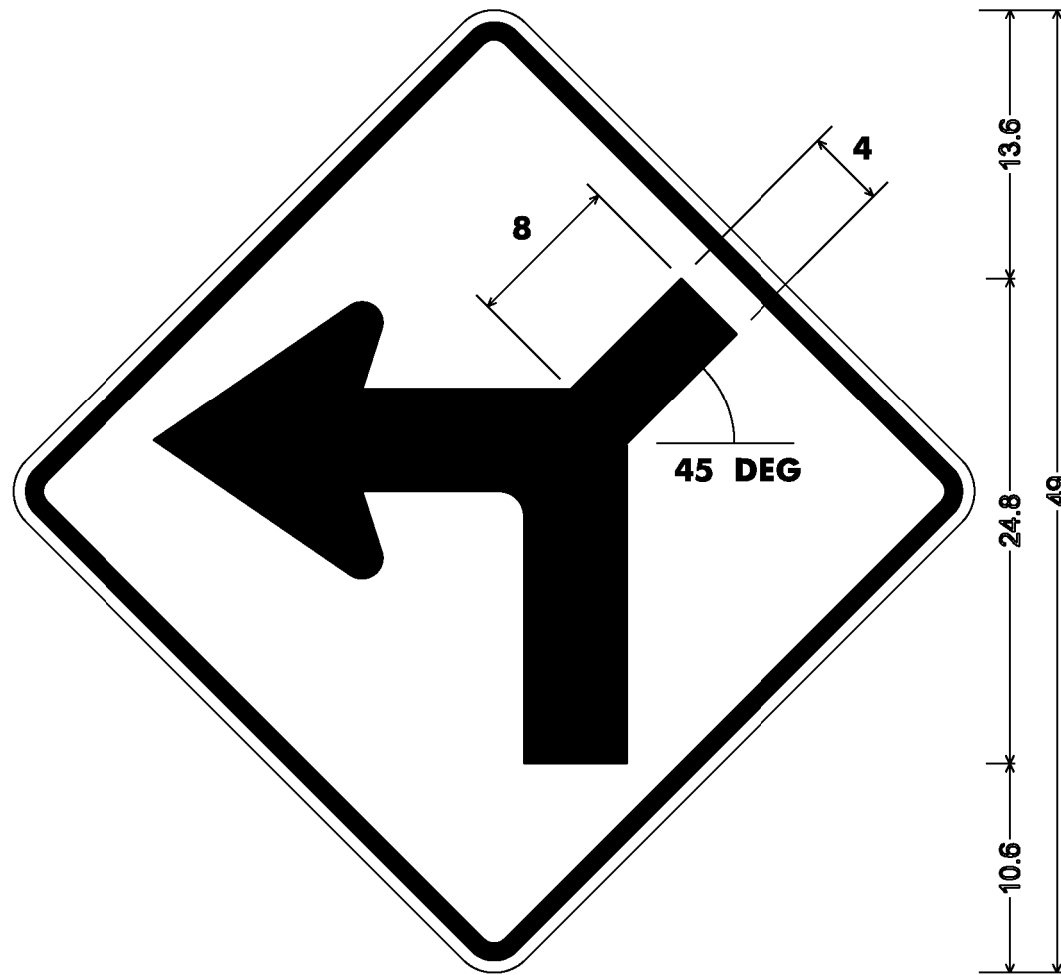


VW1-1LM
Left turn, 4" right road 36x36;
36.0" across sides 2.3" Radius, 0.9" Border, 0.6" Indent, Black on Yellow;

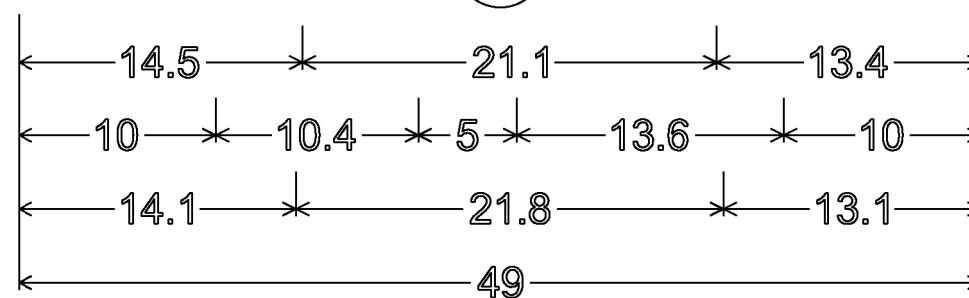



VS3-4;
36.0" across sides 2.3" Radius, 0.9" Border, 0.6" Indent, Black on Bright yellow green;
"SCHOOL" C; "BUS TURN" C; "AROUND" C;

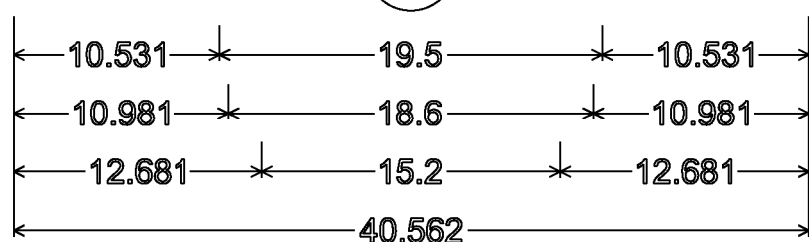



VW-133;
30.000" across sides 2.250" Radius, 0.875" Border, 0.625" Indent, Black on Yellow;
"HIDDEN" C 2K; "DRIVES" C 2K;
"RIGHT" C 2K;

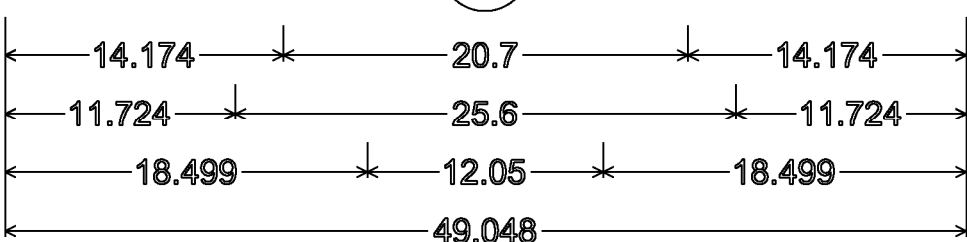


VW-202L;
36.000" across sides 2.250" Radius, 0.875" Border, 0.625" Indent, Black on Yellow;
"TRUCKS" C 2K; "ENTERING" C 2K; "LEFT" C 2K;

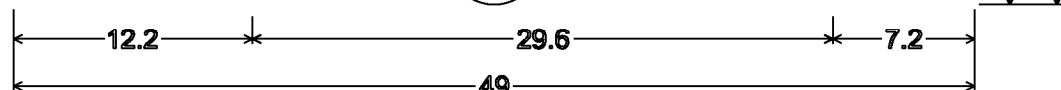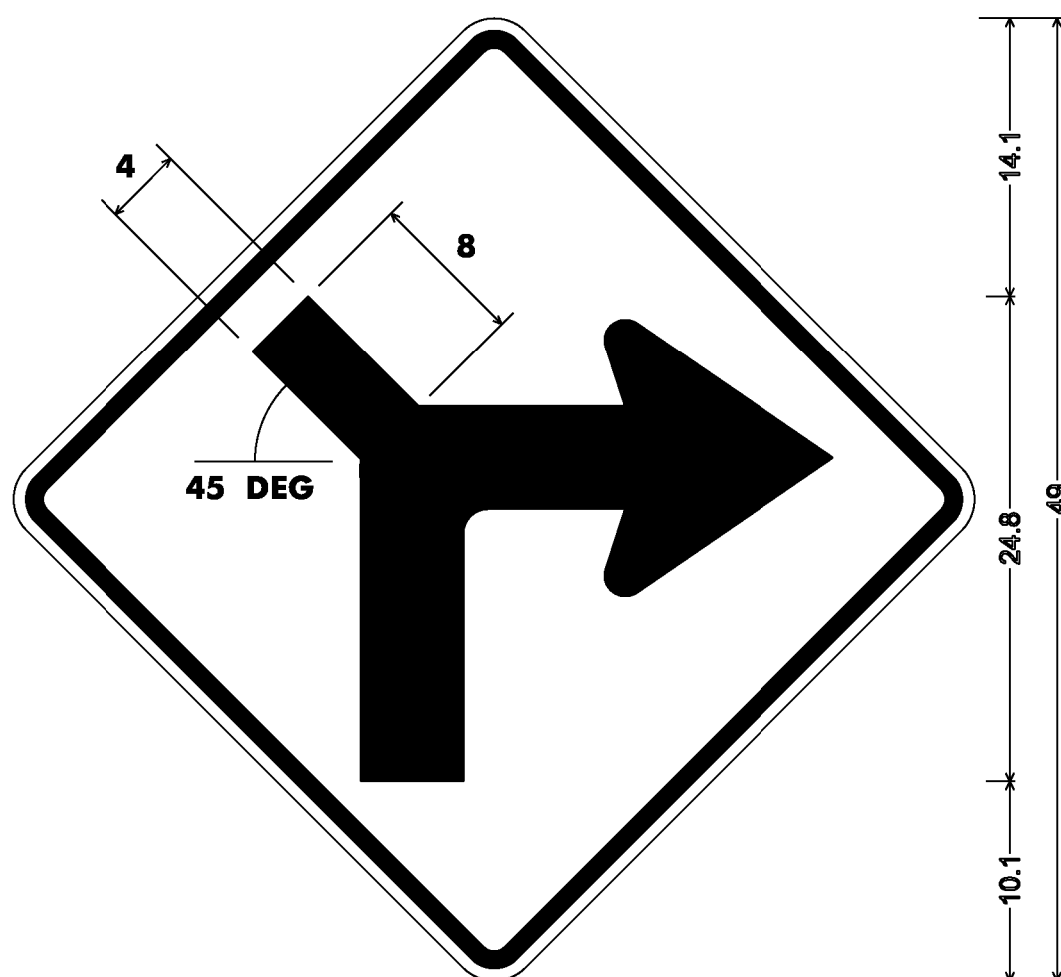


VW1-1RM;
Right turn, 4" left road 36x36;
36.0" across sides 2.3" Radius, 0.9" Border, 0.6" Indent, Black on Yellow;

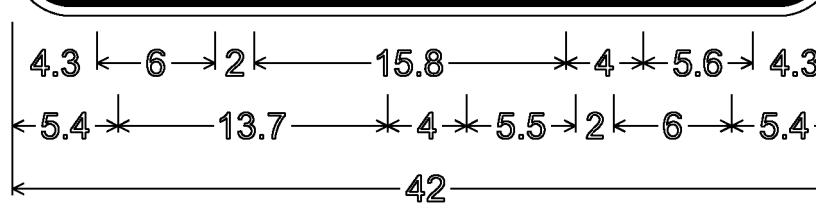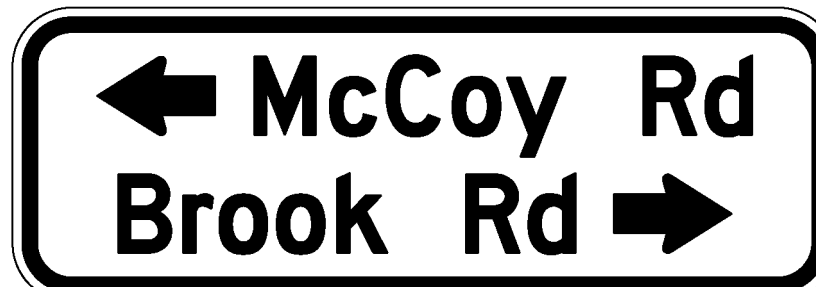


W16-8AP;
3.0" Radius, 0.8" Border, 0.5" Indent, Black on Yellow;
Standard Arrow Custom 6.0" X 4.0" 180°;
"McCoy Rd" D 2K; "Brook Rd" D 2K;
Standard Arrow Custom 6.0" X 4.0" 0°;

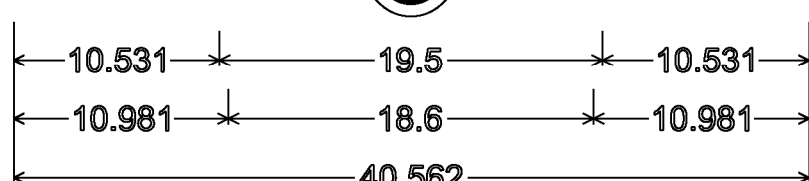


VD-060;
30.000" across sides 2.250" Radius, 0.875" Border, 0.625" Indent, Black on Yellow;
"HIDDEN" C 2K; "DRIVES" C 2K;

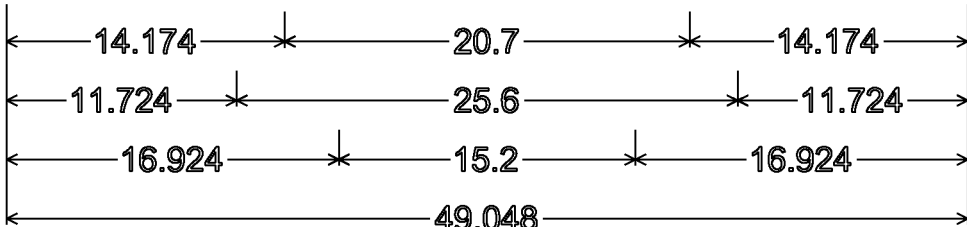

VW-202R;
36.000" across sides 2.250" Radius, 0.875" Border, 0.625" Indent, Black on Yellow;
"TRUCKS" C 2K; "ENTERING" C 2K; "RIGHT" C 2K;

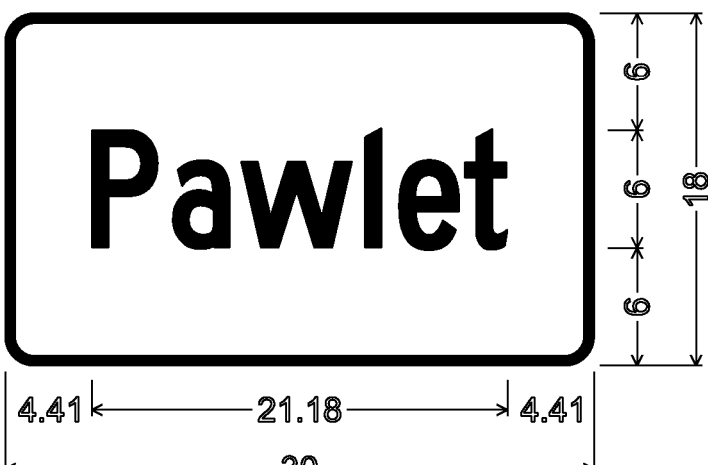

VD-018A
1.500" Radius, 0.500" Border, White on Green;
"Pawlet" C 2K;

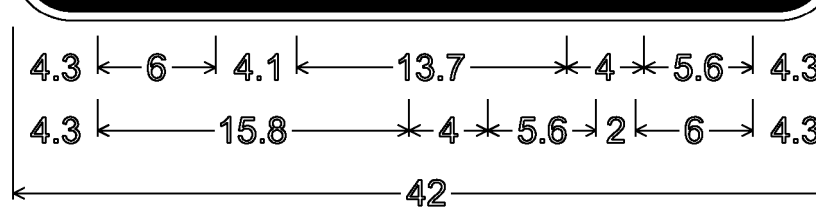

W16-8AP;
3.0" Radius, 0.8" Border, 0.5" Indent, Black on Yellow;
Standard Arrow Custom 6.0" X 4.0" 180°;
"Brook Rd" D 2K; "McCoy Rd" D 2K;
Standard Arrow Custom 6.0" X 4.0" 0°;

ALL DIMENSIONS SHOWN IN INCHES UNLESS OTHERWISE NOTED.


PROJECT NAME: PAWLET - WEST RUTLAND

PROJECT NUMBER: STPG SIGN (37)

FILE NAME: IOC340_TS.DGN
PROJECT LEADER: A. GAMBLE
DESIGNED BY: J. KELLY
SIGN DETAILS (4)


PLOT DATE: \$\$\$DATE\$\$\$
DRAWN BY: J. KELLY
CHECKED BY: A. GAMBLE
SHEET 7 OF 61

ROUTE MARKER ASSEMBLY FRAMES

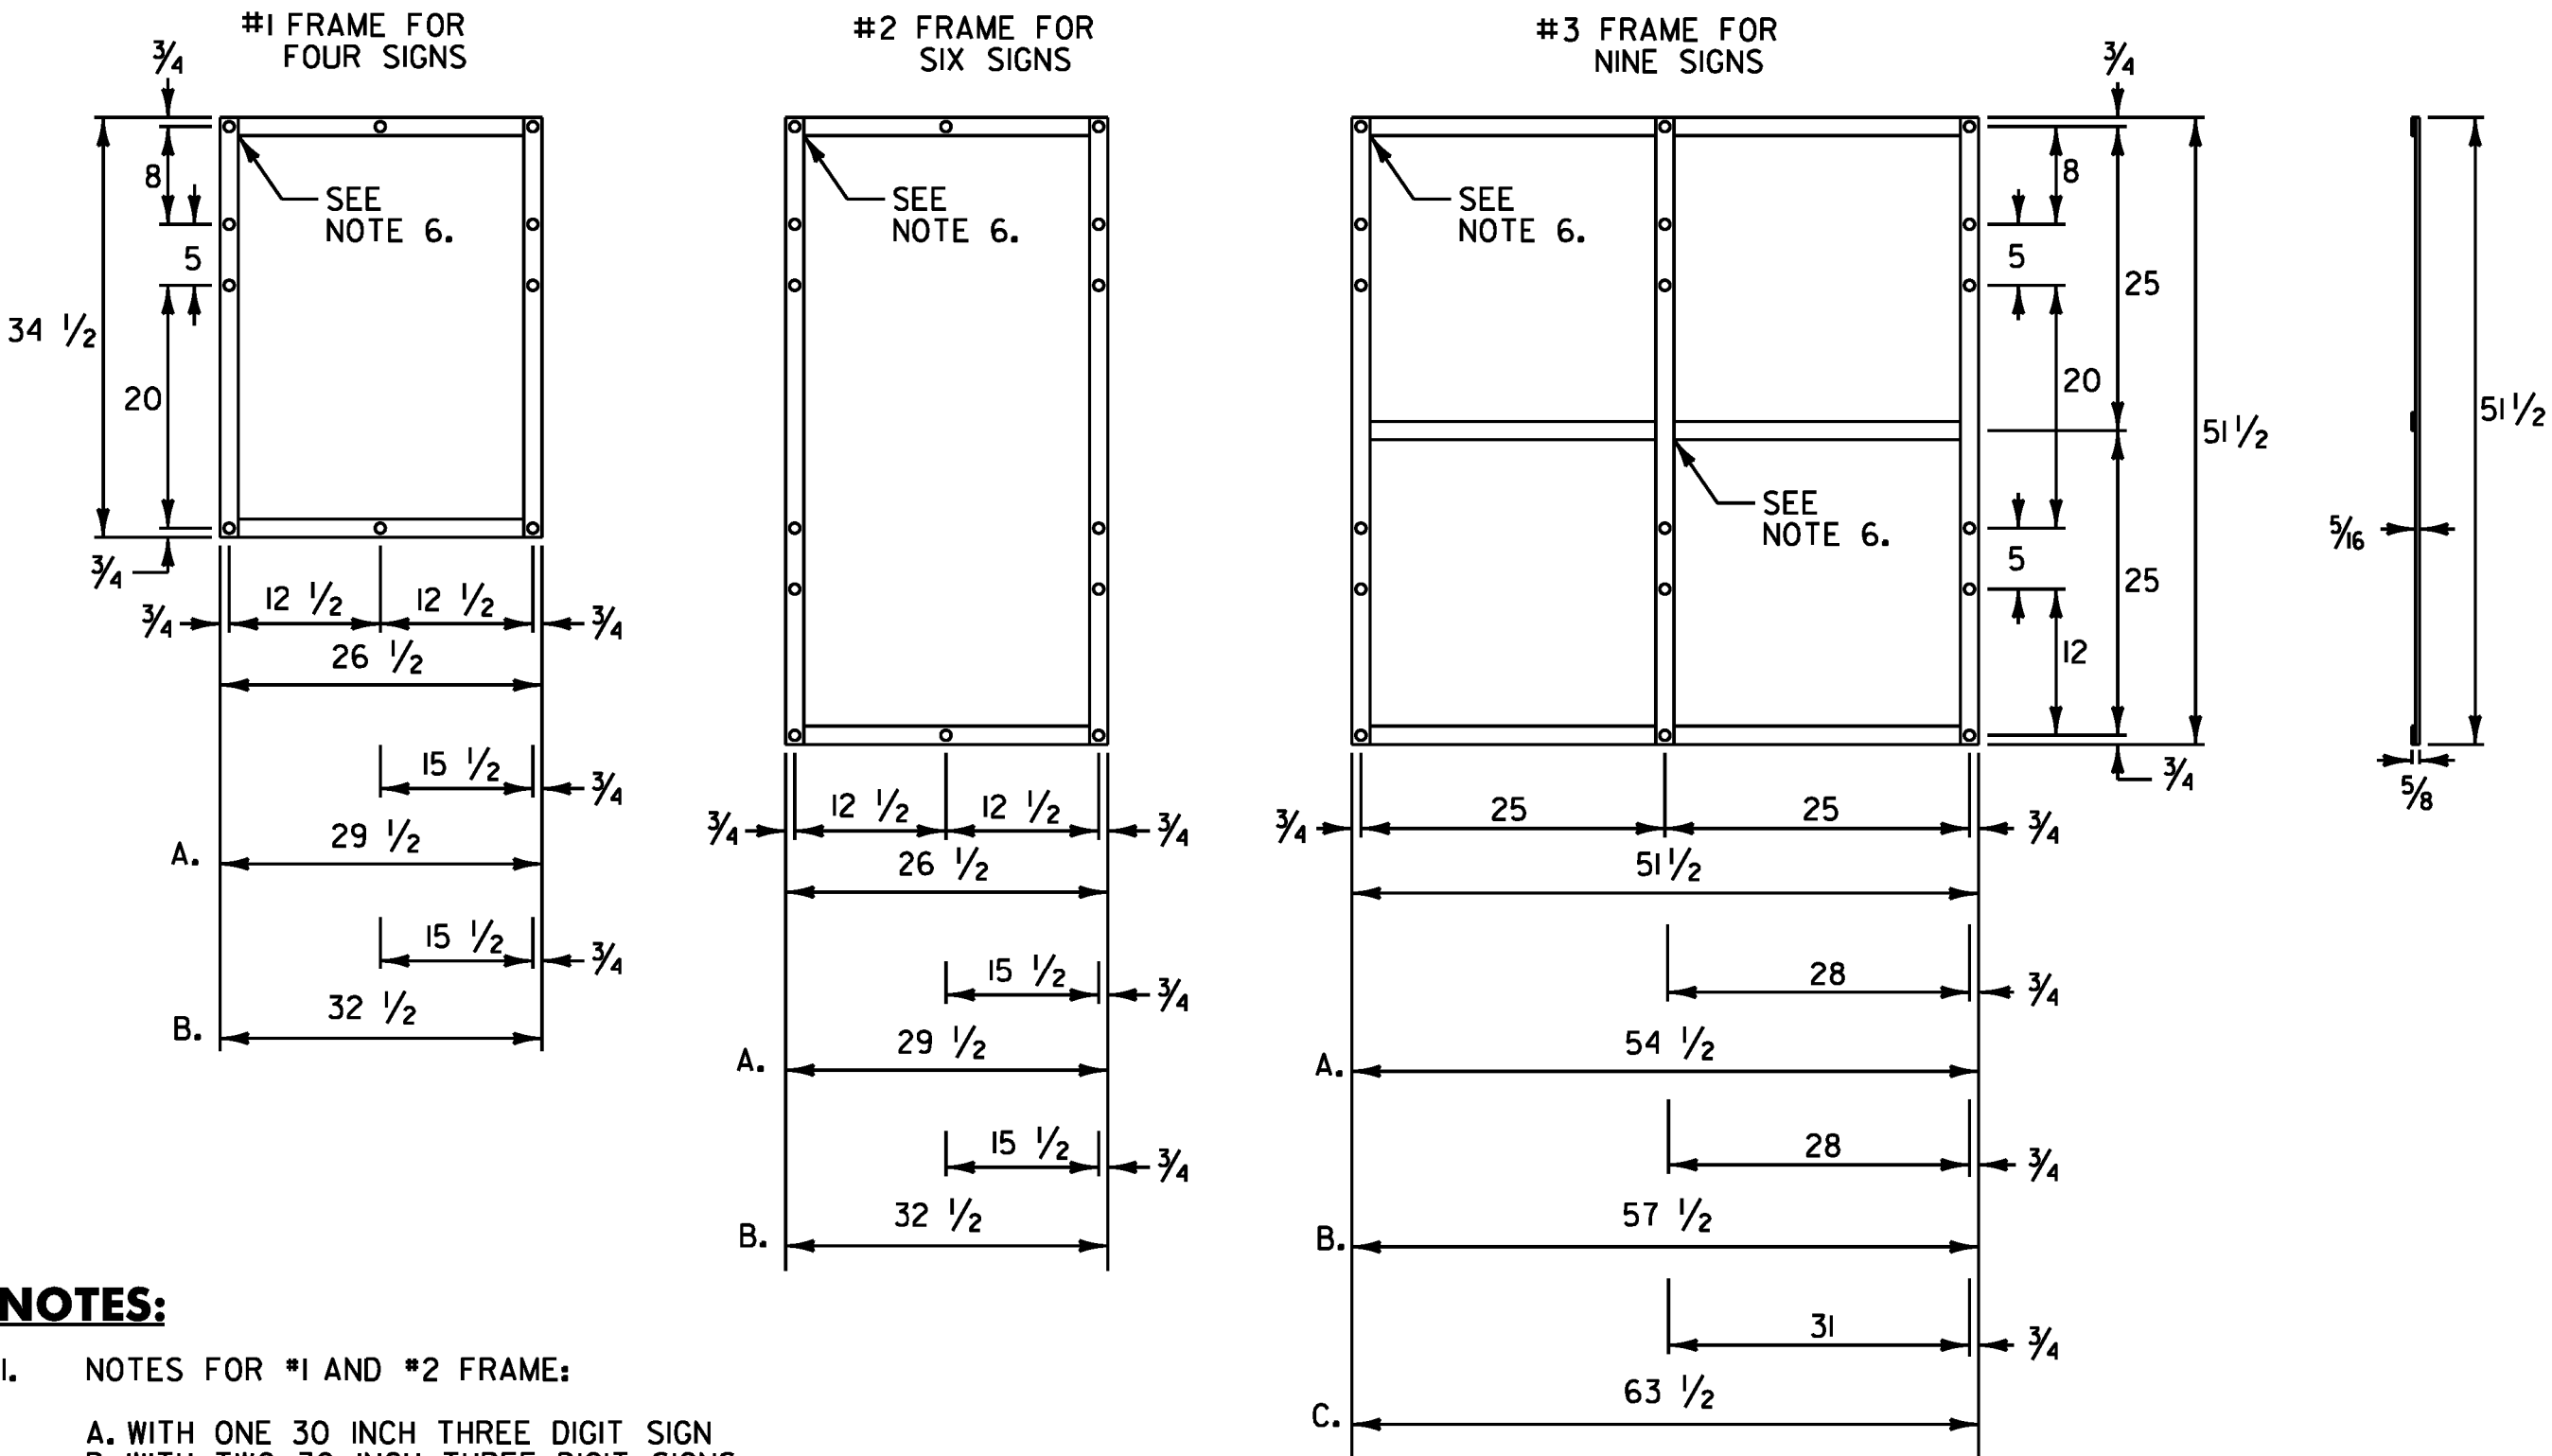

- NOTES:**
- NOTES FOR #1 AND #2 FRAME:
A. WITH ONE 30 INCH THREE DIGIT SIGN
B. WITH TWO 30 INCH THREE DIGIT SIGNS
 - NOTES FOR #3 FRAME:
A. WITH ONE 30 INCH THREE DIGIT SIGN IN AN OUTSIDE POSITION.
B. WITH ONE 30 INCH THREE DIGIT SIGN IN THE CENTER POSITION
OR TWO SUCH SIGNS IN THE OUTSIDE POSITIONS.
C. WITH THREE 30 INCH THREE DIGIT SIGNS.
 - ALL HOLES SHALL BE $\frac{7}{16}$ INCH DIAMETER. FOR OTHER SIGN COMBINATIONS THAN ABOVE, THE FRAME DIMENSIONS AND HOLE SPACING SHALL BE MODIFIED AS NECESSARY. THE FRAME SHALL BE PAINTED WITH ONE COAT OF PRIMER AND A SECOND COAT OF BLACK PAINT. THE PAINT SHALL BE OF THE TYPE USED ON EXTERIOR METAL SURFACES TO PREVENT METAL CORROSION.
 - FRAMES SHALL BE CONSTRUCTED OF $\frac{3}{16}$ INCH $\times$ $1\frac{1}{2}$ INCH A-36 STEEL.
 - ALL OVERLAPPED CONNECTIONS SHALL BE WELDED WITH TWO $\frac{1}{4}$ INCH WIDE FILLET WELDS, $1\frac{1}{2}$ INCHES LONG.

STANDARD MOUNTING OF ROUTE MARKER ASSEMBLIES

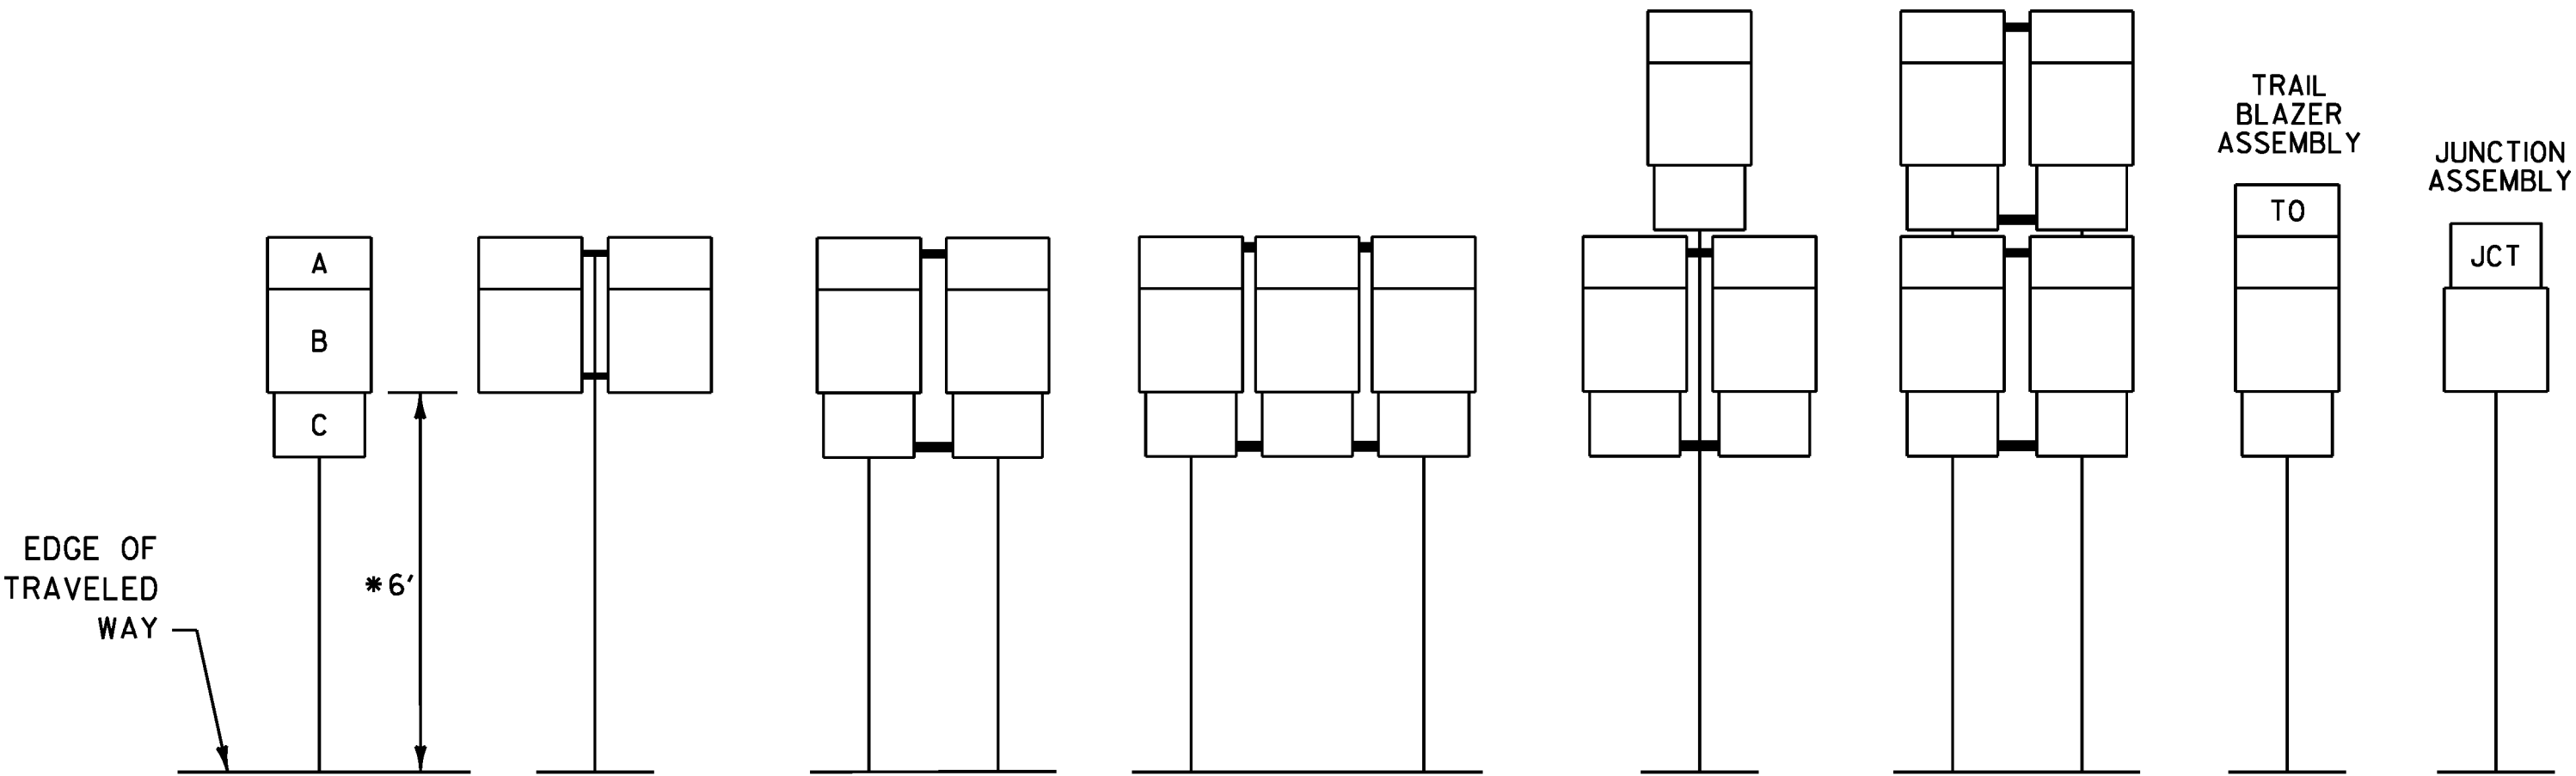

- A - CARDINAL DIRECTION MARKER
B - ROUTE NUMBER
C - ADVANCE TURN ARROW OR DIRECTIONAL ARROW
- * WHERE PARKING OR PEDESTRIAN TRAFFIC WILL OCCUR IN THE IMMEDIATE VICINITY OF THESE SIGNS MINIMUM VERTICAL CLEARANCE SHALL BE INCREASED TO SEVEN FEET

- INSTALLATION SEQUENCE:
- IN MULTIPLE HORIZONTAL MOUNTINGS PLACE A ROUTE MARKER ASSEMBLY INDICATING A LEFT TURN ON THE LEFT SIDE OF THE ASSEMBLY; RIGHT TURN ON THE RIGHT SIDE. FOR VERTICALLY STACKED MOUNTINGS PLACE THE STRAIGHT THROUGH MOVE INDICATION ON TOP, THE LEFT OR RIGHT TURNS AS APPROPRIATE BENEATH.

- NOTES:**
- ALL DIMENSIONS SHOWN IN INCHES UNLESS OTHERWISE NOTED.
 - VERTICAL FRAME MEMBERS SHALL LINE UP WITH SIGN POST ON WHICH THEY ARE MOUNTED.

ALL DIMENSIONS SHOWN IN INCHES UNLESS OTHERWISE NOTED.

PROJECT NAME: PAWLET - WEST RUTLAND

PROJECT NUMBER: STPG SIGN (37)

FILE NAME: IOC340_TS.DGN

PROJECT LEADER: A. GAMBLE

DESIGNED BY: J. KELLY


ROUTE MARKER SIGN ASSEMBLY



PLOT DATE: \$\$\$DATE\$\$\$


DRAWN BY: J. KELLY




CHECKED BY: A. GAMBLE

SHEET 8 OF 61

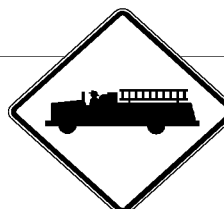
DIRECTION	MILEPOINT	LOCATION CODE (SHEET 2)	SIGN CODE	WIDTH (IN)	HEIGHT (IN)	SHEETING REMARKS	SIGN LEGEND	NEW SIGNS		EXISTING SIGNS				EXIST POST		NUMBER OF NEW POSTS	SQUARE STEEL (IN)			TUBULAR STEEL Ø (IN)				SIGN FRAME REQUIRED	REMARKS	SIGN DETAIL LOCATION			
								"A"	"B"	RETAIN	SALVAGE FROM	SALVAGE TO	REMOVE	RETAIN	REMOVE		1.75	2.00	2.50	FOUNDATION	3.00	3.50	4.00			5.00	SHSM	PROJECT SHEET #	STANDARD SHEET #
																	(LB / FT)				(LB / FT)								
																	1.88	2.42	3.35		7.60	9.00	10.80			14.60			
PAWLET NB						FY-FLUORESCENT YELLOW FYG-FLUORESCENT YELLOW GREEN																"SHSM"-STANDARD HIGHWAY SIGNS AND MARKINGS							
NB	0.025	A	M3-1	24	12		NORTH			1				X															
		A	M1-5	30	24		VERMONT 133			1																			
NB	0.070	A	W11-8	30	30							1	X																
		A	W11-8	30	30			6.25																INSTALL NEW SIGN ON EXISTING POST.	X				
NB	0.120	A	R2-1	24	30							1		X															
		A	R2-1	24	30			5.00						1		X									X				
NB	0.400	A	OM3-R	12	36									X															
		A	OM3-R	12	36			3.00							1		X								INSTALL AT HEIGHT OF 4 FEET TO BOTTOM OF SIGN.	X			
		A	VD-701	6	8		BRIDGE MARKER			1	1	1												REINSTALL BELOW OBJECT MARKER.					
NB	0.410	B	OM3-L	12	36							1		X															
		B	OM3-L	12	36			3.00							1		X								INSTALL AT HEIGHT OF 4 FEET TO BOTTOM OF SIGN.	X			
NB	0.600	A	VW-202	30	30		TRUCKS ENTERING					1		X															
		A	VD-700	6	8		0.60 MILE MARKER			1	1	1				1	X							REINSTALL MILE MARKER ON NEW POST.					
NB	0.605	A	OM-3R	12	36							1		X															
		A	OM-3R	12	36			3.00								1		X							INSTALL AT HEIGHT OF 4 FEET TO BOTTOM OF SIGN.	X			
SIGN SUMMARY SHEET							SHEET TOTALS		20.25	0.00	2	2	2	8	0	0	5	75.0		0	0.0	0.0	0.0	0.0	PROJECT NAME: PAWLET - WEST RUTLAND				
									SF	SF	EA	EA	EA	EA	EA	EA	EA	FT		EA	LB	LB	LB	LB	PROJECT NUMBER: STPG SIGN(37)				
																								FILE NAME: 10C340			PLOT DATE: 5/6/2011		
							VERMONT AGENCY OF TRANSPORTATION		TOWN DIRECTIONAL TOTALS			233.8	0.0	4	4	4	50	0	0	39	585.0		0	0.0				PROJECT MANAGER: A. GAMBLE	
																								DESIGNED BY: J. KELLY			CHECKED A. GAMBLE		
																								PAWLET NB SHEET 1			SHEET 9 OF 61		

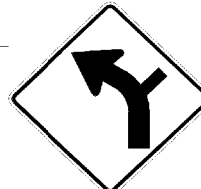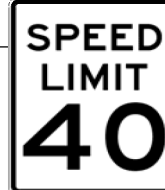
DIRECTION	MILEPOINT	LOCATION CODE (SHEET 2)	SIGN CODE	WIDTH (IN)	HEIGHT (IN)	SHEETING REMARKS	SIGN LEGEND	NEW SIGNS		EXISTING SIGNS				EXIST POST		NUMBER OF NEW POSTS	SQUARE STEEL (IN)			TUBULAR STEEL Ø (IN)					SIGN FRAME REQUIRED	REMARKS	SIGN DETAIL LOCATION					
								"A"	"B"	RETAIN	SALVAGE FROM	SALVAGE TO	REMOVE	RETAIN	REMOVE		1.75	2.00	2.50	FOUNDATION	3.00	3.50	4.00	5.00			SHSM	PROJECT SHEET #	STANDARD SHEET #			
																	(LB / FT)				(LB / FT)											
																	1.88	2.42	3.35		7.60	9.00	10.80	14.60								
PAWLET NB						FY-FLUORESCENT YELLOW FYG-FLUORESCENT YELLOW GREEN																"SHSM"-STANDARD HIGHWAY SIGNS AND MARKINGS										
		A	VD-701	6	8		BRIDGE MARKER				1	1	1										REINSTALL BELOW OBJECT MARKER									
NB	0.615	B	OM3-L	12	36								1		X																	
		B	OM3-L	12	36			3.00							1		X							INSTALL AT HEIGHT OF 4 FEET TO BOTTOM OF SIGN.	X							
NB	0.670	A	W1-2L	30	30		LEFT CURVE						1		X																	
NB	0.725	A	W2-2R	30	30		RIGHT SIDE ROAD						1		X																	
		A	W1-10L	36	36			9.00								2		X								X						
NB	0.820	C	VR-017	24	24								1		X									HERRICK BROOK RD (TH-28)								
		C	VR-017	24	30			5.00								1		X						INSTALL CLOSER TO VT-133		6						
		C	R2-1					TOWN'S SPEED LIMIT 30			1	1	1											REINSTALL BELOW NEW LEGAL LOAD SIGN								
NB	0.825	D	R1-1	30	30		 SALVAGED						1		X									HERRICK BROOK RD (TH-28)								
		D	R1-1	30	30			6.25								1		X						REPLACE ASSEMBLY IN ISLAND.	X							
NB	0.830	D	R1-1	30	30								1		X																	
		D	R1-1	30	30			6.25								1		X						HERRICK BROOK RD (TH-28)	X							
NB	0.910	A	R2-1	24	30								1		X																	
		A	R2-1	24	30			5.00								1		X								X						
SIGN SUMMARY SHEET							SHEET TOTALS		34.50	0.00	0	3	2	3	10	0	0	7	105.0			0	0.0	0.0	0.0	0.0	PROJECT NAME: PAWLET - WEST RUTLAND					
									SF	SF	EA	EA	EA	EA	EA	EA	EA	EA	EA	EA	EA	EA	FT		EA	LB	LB	LB	LB	PROJECT NUMBER: STPG SIGN(37)		
																														FILE NAME: 10C340		
																														PROJECT MANAGER: A. GAMBLE		
VERMONT AGENCY OF TRANSPORTATION							TOWN DIRECTIONAL TOTALS		233.8	0.0	4	4	4		50	0	0	39	585.0			0	0.0				PLOT DATE: 5/6/2011					
																													DRAWN BY: J. KELLY			
																								CHECKED A. GAMBLE								
																								SHEET 10 OF 61								


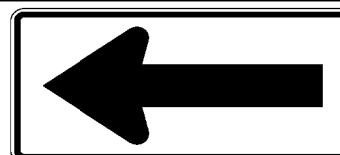
DIRECTION	MILEPOINT	LOCATION CODE (SHEET 2)	SIGN CODE	WIDTH (IN)	HEIGHT (IN)	SHEETING REMARKS	SIGN LEGEND	NEW SIGNS		EXISTING SIGNS				EXIST POST		NUMBER OF NEW POSTS	SQUARE STEEL (IN)			TUBULAR STEEL Ø (IN)					SIGN FRAME REQUIRED	REMARKS	SIGN DETAIL LOCATION		
								"A"	"B"	RETAIN	SALVAGE FROM	SALVAGE TO	REMOVE	RETAIN	REMOVE		1.75	2.00	2.50	FOUNDATION	3.00	3.50	4.00	5.00			SHSM	PROJECT SHEET #	STANDARD SHEET #
																	(LB / FT)				(LB / FT)								
																	1.88	2.42	3.35		7.60	9.00	10.80	14.60					
PAWLET NB						FY-FLUORESCENT YELLOW FYG-FLUORESCENT YELLOW GREEN																"SHSM"-STANDARD HIGHWAY SIGNS AND MARKINGS							
NB	1.100	A	R2-1	24	30								1	X															
		A	R2-1	24	30			5.00															REPLACE SIGN. RETAIN POST.	X					
NB	1.150	A	D1-1A	72	10		<--- MIDDLETOWN 10						1		X														
		A	D1-1A	72	10								1																
		A	VD1-1A	72	12			6.00								2		X									5		
NB	1.200	A	VD-062B	72	16		BUSINESS SIGN			1				X															
		A	VD-062B	72	16		BUSINESS SIGN			1																			
NB	1.240	A	W1-1ML	36	36		LEFT TURN SIGN NOT THERE						1		X														
		A	W13-1	18	18								1																
		A	VW1-1LM	36	36			9.00								2		X									7		
		A	W13-1	18	18			2.25																	X				
NB	1.275	A	M3-1	24	12		NORTH						1		X														
		A	M1-5	30	24		VERMONT 133						1																
		A	M6-1	21	15		LEFT ARROW						1																
NB	1.295	A	W1-6L	48	24			8.00								2		X							INSTALL NEW ON SOUTH SIDE OF POLE (W/ GUY WIRES AND WIRES INTO GROUND).	X			
SIGN SUMMARY SHEET							SHEET TOTALS		30.25	0.00	2	0	0	7 8	0	0	6	90.0			0	0.0	0.0	0.0	0.0	PROJECT NAME: PAWLET - WEST RUTLAND			
									SF	SF	EA	EA	EA	EA	EA	EA	EA		FT		EA	LB	LB	LB	LB	PROJECT NUMBER: STPG SIGN(37)			
																							FILE NAME: 10C340			PLOT DATE: 5/6/2011			
							VERMONT AGENCY OF TRANSPORTATION																PROJECT MANAGER: A. GAMBLE			DRAWN BY: J. KELLY			
							TOWN DIRECTIONAL TOTALS		233.8	0.0	4	4	4	50	0	0	39	585.0			0	0.0				CHECKED A. GAMBLE			
																							PAWLET NB SHEET 3			SHEET 11 OF 61			

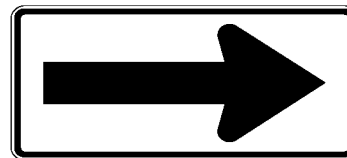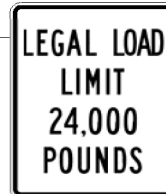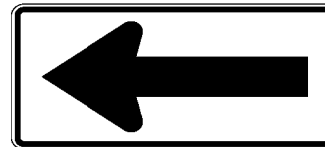DIRECTION	MILEPOINT	LOCATION CODE (SHEET 2)	SIGN CODE	WIDTH (IN)	HEIGHT (IN)	SHEETING REMARKS	SIGN LEGEND	NEW SIGNS		EXISTING SIGNS				EXIST POST		NUMBER OF NEW POSTS	SQUARE STEEL (IN)			TUBULAR STEEL Ø (IN)					SIGN FRAME REQUIRED	REMARKS	SIGN DETAIL LOCATION			
								"A"	"B"	RETAIN	SALVAGE FROM	SALVAGE TO	REMOVE	RETAIN	REMOVE		1.75	2.00	2.50	FOUNDATION	3.00	3.50	4.00	5.00			SHSM	PROJECT SHEET #	STANDARD SHEET #	
																	(LB / FT)				(LB / FT)									
																	1.88	2.42	3.35		7.60	9.00	10.80	14.60						
PAWLET NB						FY-FLUORESCENT YELLOW FYG-FLUORESCENT YELLOW GREEN																"SHSM"-STANDARD HIGHWAY SIGNS AND MARKINGS								
NB	1.300	B	W1-6R	48	24								1		X															
		B	W1-6R	48	24			8.00								2		X							INSTALL 10 FEET SOUTH OF CURRENT LOCATION.	X				
NB	1.300	C	VR-017	24	30		STOP - 18 B STOP - 18 A	6.25 6.25				I	I	24		X	I	X							DANBY/PAWLET RD	EXTRA ON #18A	REMOVE AND SALVAGE			
		C	VR-017	24	30			5.00							X	1		X								INSTALL NORTH OF ISLAND ON TOWN HIGHWAY		6		
NB	1.310	A	W1-6L	48	24									1		X														
		A	W1-6L	48	24			8.00								2		X								REPLACE ASSEMBLY IN ISLAND.	X			
NB	1.310	D	R1-1	30	30		MILE MARKER					I	I	I		X										DANBY/PAWLET RD				
		D	R1-1	30	30			6.25 5.25						1												REPLACE SIGN IN ISLAND. RETAIN POST.	X			
NB	1.310	C	VR-017	24	30		LEGAL LOAD 24,000 LBS							1		X										REMOVE ASSEMBLY FROM ISLAND.				
NB	1.320	D	R1-1	30	30									1		X										DANBY/PAWLET RD				
		D	R1-1	30	30			6.25																		REPLACE SIGN AND RETAIN POST.	X			
NB	1.355	A	M3-1	24	12			2.00								1		X								INSTALL 50 FEET NORTH OF DRIVE #1326.			E-136B	
			M1-5	30	24			5.00																				E-136B		
NB	1.580	A	S3-1	36	36			9.00								2		X								INSTALL ON SOUTH SIDE OF UTILITY POLE #16/43	X			
NB	2.320	A	W1-2L	30	30		LEFT CURVE							1		X														
SIGN SUMMARY SHEET							SHEET TOTALS		62.0 48.50	0.00	0	20	20	87	0	0	8	120.0			0	0.0	0.0	0.0	0.0	PROJECT NAME: PAWLET - WEST RUTLAND				
									SF	SF	EA	EA	EA	EA	EA	EA	EA	FT			EA	LB	LB	LB	LB	PROJECT NUMBER: STPG SIGN(37)				
																									FILE NAME: 10C340		PLOT DATE: 5/6/2011			
VERMONT AGENCY OF TRANSPORTATION							TOWN DIRECTIONAL TOTALS		233.8	0.0	4	4	4	50	0	0	39	585.0			0	0.0				DRAWN BY: J. KELLY				
																								CHECKED A. GAMBLE						
																								SHEET 12 OF 61						


DIRECTION	MILEPOINT	LOCATION CODE (SHEET 2)	SIGN CODE	WIDTH (IN)	HEIGHT (IN)	SHEETING REMARKS	SIGN LEGEND	NEW SIGNS		EXISTING SIGNS				EXIST POST		NUMBER OF NEW POSTS	SQUARE STEEL (IN)			TUBULAR STEEL Ø (IN)					SIGN FRAME REQUIRED	REMARKS	SIGN DETAIL LOCATION		
								"A"	"B"	RETAIN	SALVAGE FROM	SALVAGE TO	REMOVE	RETAIN	REMOVE		1.75	2.00	2.50	FOUNDATION	3.00	3.50	4.00	5.00			SHSM	PROJECT SHEET #	STANDARD SHEET #
																	(LB / FT)				(LB / FT)								
																	1.88	2.42	3.35		7.60	9.00	10.80	14.60					
PAWLET NB						FY-FLUORESCENT YELLOW FYG-FLUORESCENT YELLOW GREEN																"SHSM"-STANDARD HIGHWAY SIGNS AND MARKINGS							
		A	W13-1	18	18		40 MPH ADVISORY						1																
NB	2.380	A	W1-2L	30	30			6.25							1		X							INSTALL 325 FEET NORTH OF EXISTING ASSEMBLY AND SOUTH OF POLE	X				
		A	W13-1	18	18			2.25																	X				
NB	2.410	A	W1-8L	18	24								1	X															
		B	W1-8R	18	24								1	X															
		A	W1-8L	18	24			3.00																INSTALL NEW SIGNS ON EXISTING POSTS. EXISTING POSTS BENT	X				
		B	W1-8R	18	24			3.00																	X				
NB	2.430	A	W1-8L	18	24								1	X															
		B	W1-8R	18	24								1	X															
		A	W1-8L	18	24			3.00																INSTALL NEW SIGNS ON EXISTING POSTS.	X				
		B	W1-8R	18	24			3.00																	X				
NB	2.440	A	W1-8L	18	24		CHEVRON						1		X														
		B	W1-8R	18	24		CHEVRON						1																
NB	2.450	A	W1-8L	18	24			3.00							1		X							INSTALL BACK TO BACK ON SEPARATE POSTS.	X				
		B	W1-8R	18	24			3.00							1		X							INSTALL NORTH OF EXISTING TO MAINTAIN 100 FT SPACING OF CHEVRON ASSEMBLIES.	X				
SIGN SUMMARY SHEET							SHEET TOTALS	26.50	0.00	0	0	0	7	0	0	3	45.0			0	0.0	0.0	0.0	0.0	PROJECT NAME: PAWLET - WEST RUTLAND				
								SF	SF	EA	EA	EA	EA	EA	EA	EA	FT			EA	LB	LB	LB	LB	PROJECT NUMBER: STPG SIGN(37)				
							VERMONT AGENCY OF TRANSPORTATION			TOWN DIRECTIONAL TOTALS	233.8	0.0	4	4	4	50	0	0	39	585.0			0	0.0				FILE NAME: 10C340 PROJECT MANAGER: A. GAMBLE DESIGNED BY: J. KELLY PAWLET NB SHEET 5	

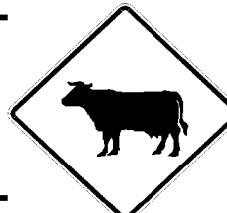
DIRECTION	MILEPOINT	LOCATION CODE (SHEET 2)	SIGN CODE	WIDTH (IN)	HEIGHT (IN)	SHEETING REMARKS	SIGN LEGEND	NEW SIGNS		EXISTING SIGNS				EXIST POST		NUMBER OF NEW POSTS	SQUARE STEEL (IN)			TUBULAR STEEL Ø (IN)					SIGN FRAME REQUIRED	REMARKS	SIGN DETAIL LOCATION			
								"A"	"B"	RETAIN	SALVAGE FROM	SALVAGE TO	REMOVE	RETAIN	REMOVE		1.75	2.00	2.50	FOUNDATION	3.00	3.50	4.00	5.00			SHSM	PROJECT SHEET #	STANDARD SHEET #	
																	(LB / FT)				(LB / FT)									
																	1.88	2.42	3.35		7.60	9.00	10.80	14.60						
PAWLET NB						FY-FLUORESCENT YELLOW FYG-FLUORESCENT YELLOW GREEN																"SHSM"-STANDARD HIGHWAY SIGNS AND MARKINGS								
NB	2.710	C	VR-017	24	30								1		X									KELLEY HILL RD (TH-14)						
		C	VR-017	24	30			5.00							1		X								6					
		C		24	30									1																
							TOWN'S REDUCED SPEED AHEAD																							
NB	2.715	D	R1-1	30	30								1	X										KELLEY HILL RD (TH-14)						
		D	R1-1	30	30			6.25																INSTALL NEW SIGN ON EXISTING POST.	X					
NB	2.910	A	W1-2R	30	30		RIGHT CURVE						1		X															
		A	W13-1	18	18		40 MPH ADVISORY						1																	
NB	2.960	A	W1-2R	30	30			6.25								1		X						INSTALL 250 FEET NORTH OF EXISTING AND ON EDGE OF CEMETERY LAWN.	X					
		A	W13-1	18	18			2.25																THINNING AND TRIMING	X					
NB	2.995	A	VW-202	30	30								1		X															
		A	VW-202	36	36			9.00								2		X							7					
NB	3.400	A	W11-4	30	30		 MM 3.4	6.25								1		X						INSTALL AT 3.40 MILE MARKER	X					
NB	3.540	A	W1-2L	30	30		LEFT CURVE						1		X									LEFT CURVE SIGN MISSING						
		A	W13-1	18	18		NOT THERE - NO REMOVAL 35 MPH ADVISORY						1																	
NB	3.580	A	S3-1	30	30		SCHOOL BUS STOP AHEAD						1		X															
SIGN SUMMARY SHEET							SHEET TOTALS	35.00	0.00	0	0	0	9	0	0	5	75.0			0	0.0	0.0	0.0	0.0	PROJECT NAME: PAWLET - WEST RUTLAND PROJECT NUMBER: STPG SIGN(37)					
								SF	SF	EA	EA	EA	EA	EA	EA	EA		FT		EA	LB	LB	LB	LB	FILE NAME: 10C340 PROJECT MANAGER: A. GAMBLE			PLOT DATE: 5/6/2011 DRAWN BY: J. KELLY		
							VERMONT AGENCY OF TRANSPORTATION																			DESIGNED BY: J. KELLY PAWLET NB SHEET 6			CHECKED A. GAMBLE SHEET 14 OF 61	
TOWN DIRECTIONAL TOTALS								233.8	0.0	4	4	4	50	0	0	39	585.0			0	0.0									


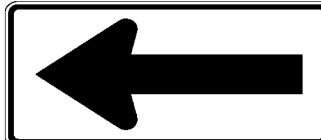
DIRECTION	MILEPOINT	LOCATION CODE (SHEET 2)	SIGN CODE	WIDTH (IN)	HEIGHT (IN)	SHEETING REMARKS	SIGN LEGEND	NEW SIGNS		EXISTING SIGNS				EXIST POST		NUMBER OF NEW POSTS	SQUARE STEEL (IN)			TUBULAR STEEL Ø (IN)				SIGN FRAME REQUIRED	REMARKS	SIGN DETAIL LOCATION			
								"A"	"B"	RETAIN	SALVAGE FROM	SALVAGE TO	REMOVE	RETAIN	REMOVE		1.75	2.00	2.50	FOUNDATION	3.00	3.50	4.00			5.00	SHSM	PROJECT SHEET #	STANDARD SHEET #
																	(LB / FT)				(LB / FT)								
																	1.88	2.42	3.35		7.60	9.00	10.80			14.60			
PAWLET NB						FY-FLUORESCENT YELLOW FYG-FLUORESCENT YELLOW GREEN																"SHSM"-STANDARD HIGHWAY SIGNS AND MARKINGS							
NB	3.625	A	W1-2L	30	30			6.25							1		X						INSTALL 450 FEET NORTH OF EXISTING ASSEMBLY.	X					
		A	W13-1	18	18			2.25																X					
NB	3.660	A	W1-6L	48	24			8.00							2		X						INSTALL SOUTH OF UTILITY POLE #86	X					
NB	3.662	B	W1-6R	48	24			8.00							2		X						INSTALL SOUTH OF UTILITY POLE #86	X					
NB	4.350	A	W11-5	30	30		FARM MACHINERY 					1	X																
		A	W11-5	30	30			6.25															INSTALL NEW SIGNS ON EXISTING POST.	X					
		A	W7-3A	24	18			3.00																X					
NB	5.320	C	VR-017	24	24							1	X										LILLY HILL RD (TH-5 IN DANBY)						
		C	VR-017	24	30			5.00															INSTALL NEW SIGN ON EXISTING POST. RETAIN ALL OTHER SIGNS.		6				
SIGN SUMMARY SHEET							SHEET TOTALS	38.75	0.00	0	0	0	2	0	0	5	75.0			0	0.0	0.0	0.0	0.0	PROJECT NAME: PAWLET - WEST RUTLAND				
								SF	SF	EA	EA	EA	EA	EA	EA	EA	FT			EA	LB	LB	LB	LB	PROJECT NUMBER: STPG SIGN(37)				
							VERMONT AGENCY OF TRANSPORTATION			TOWN DIRECTIONAL TOTALS	233.8	0.0	4	4	4	50	0	0	39	585.0			0	0.0				FILE NAME: 10C340 PROJECT MANAGER: A. GAMBLE DESIGNED BY: J. KELLY PAWLET NB SHEET 7	

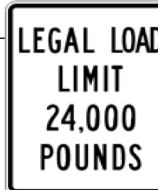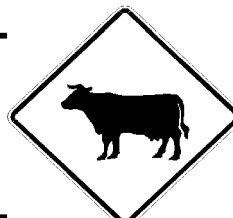DIRECTION	MILEPOINT	LOCATION CODE (SHEET 2)	SIGN CODE	WIDTH (IN)	HEIGHT (IN)	SHEETING REMARKS	SIGN LEGEND	NEW SIGNS		EXISTING SIGNS				EXIST POST		NUMBER OF NEW POSTS	SQUARE STEEL (IN)			TUBULAR STEEL Ø (IN)					SIGN FRAME REQUIRED	REMARKS	SIGN DETAIL LOCATION		
								"A"	"B"	RETAIN	SALVAGE FROM	SALVAGE TO	REMOVE	RETAIN	REMOVE		1.75	2.00	2.50	FOUNDATION	3.00	3.50	4.00	5.00			SHSM	PROJECT SHEET #	STANDARD SHEET #
																	(LB / FT)				(LB / FT)								
																	1.88	2.42	3.35		7.60	9.00	10.80	14.60					
PAWLET SB						FY-FLUORESCENT YELLOW FYG-FLUORESCENT YELLOW GREEN																"SHSM"-STANDARD HIGHWAY SIGNS AND MARKINGS							
SB	4.110	G	VR-017	24	24							1	X										TADMER RD. (TH-12)						
		G	VR-017	24	30		5.00																INSTALL NEW SIGN ON EXISTING POST.		6				
SB	4.100	H	R1-1	30	30							1	X										TADMER RD. (TH-12)						
		H	R1-1	30	30		6.25																INSTALL NEW SIGN ON EXISTING POST.	X					
SB	3.827	F	S3-1	30	30	SCHOOL BUS STOP AHEAD						1		X															
SB	3.775	F	W1-2R	30	30	RIGHT CURVE						1		X															
		F	W13-1	18	18	35 MPH ADVISORY						1																	
SB	3.715	F	W1-2R	30	30		6.25								1		X							INSTALL 315 FEET SOUTH OF EXISTING ASSEMBLY	X				
		F	W13-1	18	18		2.25																		X				
SB	3.677	F	W11-4	30	30		6.25								1		X							INSTALL 200 FEET SOUTH OF NEW RIGHT CURVE/35 MPH ADVISORY ASSEMBLY.	X				
SB	3.160	F	VW-202	30	30	TRUCKS ENTERING						1		X										THINNING AND TRIMMING					
SB	3.140	F	VW-202	36	36		9.00								2		X							INSTALL 100 FEET SOUTH OF EXISTING ASSEMBLY		7			
SB	3.085	F	W1-2L	30	30	LEFT CURVE						1		X															
		F	W13-1	18	18	40 MPH ADVISORY (NOT PRESENT)																							
SB	3.075	G	VR-017	24	24							1		X										WAITE HILL RD. (TH-15)					
SIGN SUMMARY SHEET							SHEET TOTALS		35.00	0.00	0	0	0	89	0	0	4	60.0			0	0.0	0.0	0.0	0.0	PROJECT NAME: PAWLET - WEST RUTLAND			
									SF	SF	EA	EA	EA	EA	EA	EA	EA		FT		EA	LB	LB	LB	LB	PROJECT NUMBER: STPG SIGN(37)			
																							FILE NAME: 10C340			PLOT DATE: 5/6/2011			
							VERMONT AGENCY OF TRANSPORTATION																PROJECT MANAGER: A. GAMBLE			DRAWN BY: J. KELLY			
							TOWN DIRECTIONAL TOTALS		244.0	0.0	1	2	2	52	0	0	36	540.0			0	0.0				CHECKED A. GAMBLE			
																							PAWLET SB SHEET 1			SHEET 16 OF 61			

DIRECTION	MILEPOINT	LOCATION CODE (SHEET 2)	SIGN CODE	WIDTH (IN)	HEIGHT (IN)	SHEETING REMARKS	SIGN LEGEND	NEW SIGNS		EXISTING SIGNS				EXIST POST		NUMBER OF NEW POSTS	SQUARE STEEL (IN)			TUBULAR STEEL Ø (IN)					SIGN FRAME REQUIRED	REMARKS	SIGN DETAIL LOCATION								
								"A"	"B"	RETAIN	SALVAGE FROM	SALVAGE TO	REMOVE	RETAIN	REMOVE		1.75	2.00	2.50	FOUNDATION	3.00	3.50	4.00	5.00			SHSM	PROJECT SHEET #	STANDARD SHEET #						
																	(LB / FT)				(LB / FT)														
																	1.88	2.42	3.35		7.60	9.00	10.80	14.60											
PAWLET SB						FY-FLUORESCENT YELLOW FYG-FLUORESCENT YELLOW GREEN																"SHSM"-STANDARD HIGHWAY SIGNS AND MARKINGS													
		G	VR-017	24	30			5.00							1		X									6									
SB	3.065	H	R1-1	24	24								1	X										WAITE HILL RD. (TH-15)											
		H	R1-1	30	30			6.25																INSTALL NEW SIGN ON EXISTING POST.	X										
SB	3.050	F	W1-2L	30	30			6.25							1		X							INSTALL 180 FEET SOUTH OF EXISTING ASSEMBLY.	X										
		F	W13-1	18	18			2.25																THINNING AND TRIMMING	X										
SB	3.030	E	W1-8R	18	24			3.00							1		X							INSTALL 50 FEET NORTH OF NORTHERN MOST EXISTING CHEVRON.	X										
SB	3.020	E	W1-8R	18	24		CHEVRON						1		X																				
SB	3.010	E	W1-8R	18	24								1		X																				
		F	W1-8L	18	24			3.00							1		X							INSTALL BACK TO BACK ON SEPARATE POSTS AND FACING TRAFFIC.	X										
		E	W1-8R	18	24			3.00							1		X									X									
SB	3.000	E	W1-8R	18	24		CHEVRON						1		X																				
		F	W1-8L	18	24		CHEVRON						1		X																				
SB	2.990	F	W1-8L	18	24								1		X																				
		E	W1-8R	18	24								1		X																				
		F	W1-8L	18	24			3.00							1		X							INSTALL BACK TO BACK ON SEPARATE POSTS AND FACING TRAFFIC.	X										
SIGN SUMMARY SHEET							SHEET TOTALS	31.75	0.00	0	0	0	7	0	0	6	90.0			0	0.0	0.0	0.0	0.0	PROJECT NAME: PAWLET - WEST RUTLAND										
								SF	SF	EA	EA	EA	EA	EA	EA	EA		FT		EA	LB	LB	LB	LB	PROJECT NUMBER: STPG SIGN(37)										
																								FILE NAME: 10C340						PLOT DATE: 5/6/2011					
							VERMONT AGENCY OF TRANSPORTATION																	PROJECT MANAGER: A. GAMBLE						DRAWN BY: J. KELLY					
							TOWN DIRECTIONAL TOTALS	244.0	0.0	1	2	2	52	0	0	36	540.0			0	0.0				CHECKED A. GAMBLE										
																								SHEET 17 OF 61											

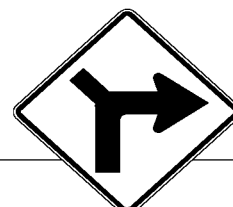DIRECTION	MILEPOINT	LOCATION CODE (SHEET 2)	SIGN CODE	WIDTH (IN)	HEIGHT (IN)	SHEETING REMARKS	SIGN LEGEND	NEW SIGNS		EXISTING SIGNS				EXIST POST		NUMBER OF NEW POSTS	SQUARE STEEL (IN)			TUBULAR STEEL Ø (IN)					SIGN FRAME REQUIRED	REMARKS	SIGN DETAIL LOCATION					
								"A"	"B"	RETAIN	SALVAGE FROM	SALVAGE TO	REMOVE	RETAIN	REMOVE		1.75	2.00	2.50	FOUNDATION	3.00	3.50	4.00	5.00			SHSM	PROJECT SHEET #	STANDARD SHEET #			
																	(LB / FT)				(LB / FT)											
																	1.88	2.42	3.35		7.60	9.00	10.80	14.60								
PAWLET SB						FY-FLUORESCENT YELLOW FYG-FLUORESCENT YELLOW GREEN																"SHSM"-STANDARD HIGHWAY SIGNS AND MARKINGS										
		E	W1-8R	18	24			3.00							1		X							NOTE: CHEVRONS SHOULD BE SPACED AT 100 FEET.	X							
SB	2.970	F	W1-8L	18	24			3.00							1		X							INSTALL 100 FEET SOUTH OF LAST ASSEMBLY	X							
SB	2.540	F	W1-2R	30	30		RIGHT CURVE						1		X																	
		F	W13-1	18	18		35 MPH ADVISORY						1																			
SB	2.510	F	S3-1	30	30		SCHOOL BUS STOP AHEAD						1		X																	
SB	2.465	F	W1-2R	30	30			6.25							1		X							INSTALL 400 FEET SOUTH OF EXISTING CURVE WARNING ASSEMBLY	X							
		F	W13-1	18	18			2.25																	X							
SB	1.790	G	VR-017	24	30								1	X										ANDRUS HILL RD. (TH-35)								
		G	VR-017	24	30			5.00																INSTALL NEW SIGN ON EXISTING POST.		6						
SB	1.780	H	R1-1	30	30								1		X									ANDRUS HILL RD. (TH-35)								
		H	R1-1	30	30			6.25							1		X								X							
SB	1.440	F	W1-1MR	30	30		MODIFIED RIGHT TURN						1		X																	
		F	W13-1	18	18		30 MPH ADVISORY						1																			
SB	1.400	F	VW1-1RM	36	36			9.00							2		X							INSTALL 200 FEET SOUTH OF EXISTING ASSEMBLY AT 1.40 MILE MARKER		7						
		F	W13-1	18	18			2.25																	X							
SIGN SUMMARY SHEET							SHEET TOTALS	37.00	0.00	0	0	0	7	0	0	6	90.0			0	0.0	0.0	0.0	0.0	PROJECT NAME: PAWLET - WEST RUTLAND							
								SF	SF	EA	EA	EA	EA	EA	EA	EA	FT			EA	LB	LB	LB	LB	PROJECT NUMBER: STPG SIGN(37)							
							VERMONT AGENCY OF TRANSPORTATION			TOWN DIRECTIONAL TOTALS			244.0	0.0	1	2	2	52	0	0	36	540.0			0	0.0				FILE NAME: 10C340 PROJECT MANAGER: A. GAMBLE DESIGNED BY: J. KELLY PAWLET SB SHEET 3		
																											PLOT DATE: 5/6/2011 DRAWN BY: J. KELLY CHECKED A. GAMBLE SHEET 18 OF 61					

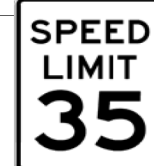DIRECTION	MILEPOINT	LOCATION CODE (SHEET 2)	SIGN CODE	WIDTH (IN)	HEIGHT (IN)	SHEETING REMARKS	SIGN LEGEND	NEW SIGNS		EXISTING SIGNS				EXIST POST		NUMBER OF NEW POSTS	SQUARE STEEL (IN)			TUBULAR STEEL Ø (IN)					SIGN FRAME REQUIRED	REMARKS	SIGN DETAIL LOCATION		
								"A"	"B"	RETAIN	SALVAGE FROM	SALVAGE TO	REMOVE	RETAIN	REMOVE		1.75	2.00	2.50	FOUNDATION	3.00	3.50	4.00	5.00			SHSM	PROJECT SHEET #	STANDARD SHEET #
																	(LB / FT)				(LB / FT)								
																	1.88	2.42	3.35		7.60	9.00	10.80	14.60					
PAWLET SB						FY-FLUORESCENT YELLOW FYG-FLUORESCENT YELLOW GREEN																"SHSM"-STANDARD HIGHWAY SIGNS AND MARKINGS							
SB	1.362	F	VD1-1A	72	12			6.00							2		X							INSTALL 200 FEET SOUTH OF 1.40 MILE MARKER		5			
SB	1.275	F	M3-3	24	12			2.00							1		X							INSTALL ACROSS FROM NEW LARGE ARROW FOR NB.			E-136B		
		F	M1-5	30	24			5.00																		E-136B			
SB	1.190	F	W3-5	36	36			9.00							2		X							INSTALL 500 FEET NORTH OF SPEED LIMIT 40/50 TRANSITION POINT.	X				
SB	1.145	F	VD-018A	30	18		MISSING VILLAGE SIGN - EMPTY POST							X															
		F	VD-018A	30	18			3.75																INSTALL NEW SIGN ON EXISTING EMPTY POST.		7			
SB	1.100	F	R2-1	24	30								+	X										EXISTING POST BENT, REPLACED POST					
		F	R2-1	30	36			7.50																INSTALL NEW SIGN ON EXISTING POST.	X				
SB	0.910	F	R2-1	24	30								1	X															
		F	R2-1	30	36			7.50																INSTALL NEW SIGN ON EXISTING POST.	X				
SB	0.870	F	W1-2R	30	30		RIGHT CURVE						1		X														
		F	S3-1	30	30		SCHOOL BUS STOP AHEAD						1																
SB	0.832	F	VW-133	30	30			6.25							1		X							INSTALL 115 FEET NORTH OF EXISTING HIDDEN DRIVE SIGN.		7			
SB	0.810	F	VW-202	30	30		TRUCKS ENTERING						1		X														
		F	VW-060	24	24		HIDDEN DRIVE						1																
SIGN SUMMARY SHEET							SHEET TOTALS	47.00	0.00	0	0	0	6	0	0	6	90.0			0	0.0	0.0	0.0	0.0	PROJECT NAME: PAWLET - WEST RUTLAND				
								SF	SF	EA	EA	EA	EA	EA	EA	EA		FT		EA	LB	LB	LB	LB	PROJECT NUMBER: STPG SIGN(37)				
							TOWN DIRECTIONAL TOTALS	244.0	0.0	1	2	2	52	0	0	36	540.0			0	0.0				FILE NAME: 10C340 PROJECT MANAGER: A. GAMBLE DESIGNED BY: J. KELLY PAWLET SB SHEET 4			PLOT DATE: 5/6/2011 DRAWN BY: J. KELLY CHECKED A. GAMBLE SHEET 19 OF 61	

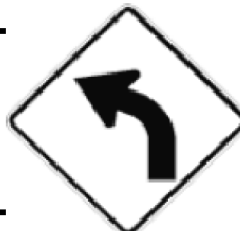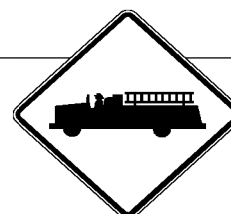DIRECTION	MILEPOINT	LOCATION CODE (SHEET 2)	SIGN CODE	WIDTH (IN)	HEIGHT (IN)	SHEETING REMARKS	SIGN LEGEND	NEW SIGNS		EXISTING SIGNS				EXIST POST		NUMBER OF NEW POSTS	SQUARE STEEL (IN)			TUBULAR STEEL Ø (IN)				SIGN FRAME REQUIRED	REMARKS	SIGN DETAIL LOCATION				
								"A"	"B"	RETAIN	SALVAGE FROM	SALVAGE TO	REMOVE	RETAIN	REMOVE		1.75	2.00	2.50	FOUNDATION	3.00	3.50	4.00			5.00	SHSM	PROJECT SHEET #	STANDARD SHEET #	
																	(LB / FT)				(LB / FT)									
																	1.88	2.42	3.35		7.60	9.00	10.80			14.60				
PAWLET SB						FY-FLUORESCENT YELLOW FYG-FLUORESCENT YELLOW GREEN																"SHSM"-STANDARD HIGHWAY SIGNS AND MARKINGS								
SB	0.795	F	W1-2R	30	30			6.25							1		X							INSTALL 75 FEET SOUTH OF TRUCKS ENTERING/HIDDEN DRIVE ASSEMBLY.	X					
SB	0.615	F	OM-3R	12	36								1		X									THINNING AND TRIMMING						
		F	OM-3R	12	36			3.00							1		X							INSTALL AT HEIGHT OF 4 FEET TO BOTTOM OF SIGN.	X					
		F	VD-701	6	8		BRIDGE MARKER "2"				1	1	1											REINSTALL BRIDGE MARKER BELOW NEW OBJECT MARKER.						
SB	0.605	E	OM-3L	12	36								1		X															
		E	OM-3L	12	36			3.00							1		X							INSTALL AT HEIGHT OF 4 FEET TO BOTTOM OF SIGN.	X					
SB	0.405	F	OM-3R	12	36								1		X															
		F	OM-3R	12	36			3.00							1		X							INSTALL AT HEIGHT OF 4 FEET TO BOTTOM OF SIGN.	X					
		F	VD-701	6	8		BRIDGE MARKER "1"				1	1	1											REINSTALL BRIDGE MARKER BELOW NEW OBJECT MARKER.						
SB	0.395	E	OM-3L	12	36								1		X															
		E	OM-3L	12	36			3.00							1		X							INSTALL AT HEIGHT OF 4 FEET TO BOTTOM OF SIGN.	X					
SB	0.325	F	W1-2L	30	30		LEFT CURVE						1		X									THINNING AND TRIMMING						
SB	0.295	F	W1-2L	30	30			6.25								1		X						INSTALL 150 FEET SOUTH OF EXISTING ASSEMBLY.	X					
SB	0.260	F	W11-8	30	30								1	X																
		F	W11-8	30	30			6.25																INSTALL NEW SIGN ON EXISTING POST.	X					
SIGN SUMMARY SHEET							SHEET TOTALS	30.75	0.00	0	2	2	8	0	0	6	90.0			0	0.0	0.0	0.0	0.0	PROJECT NAME: PAWLET - WEST RUTLAND					
								SF	SF	EA	EA	EA	EA	EA	EA	EA		FT		EA	LB	LB	LB	LB	PROJECT NUMBER: STPG SIGN(37)					
							VERMONT AGENCY OF TRANSPORTATION																		FILE NAME: 10C340			PLOT DATE: 5/6/2011		
							TOWN DIRECTIONAL TOTALS			244.0	0.0	1	2	2	52	0	0	36	540.0			0	0.0				PROJECT MANAGER: A. GAMBLE			DRAWN BY: J. KELLY
																							DESIGNED BY: J. KELLY			CHECKED A. GAMBLE				
																							PAWLET SB SHEET 5			SHEET 20 OF 61				

DIRECTION	MILEPOINT	LOCATION CODE (SHEET 2)	SIGN CODE	WIDTH (IN)	HEIGHT (IN)	SHEETING REMARKS	SIGN LEGEND	NEW SIGNS		EXISTING SIGNS				EXIST POST		NUMBER OF NEW POSTS	SQUARE STEEL (IN)			TUBULAR STEEL Ø (IN)				SIGN FRAME REQUIRED	REMARKS	SIGN DETAIL LOCATION			
								"A"	"B"	RETAIN	SALVAGE FROM	SALVAGE TO	REMOVE	RETAIN	REMOVE		1.75	2.00	2.50	FOUNDATION	3.00	3.50	4.00			5.00	SHSM	PROJECT SHEET #	STANDARD SHEET #
																	(LB / FT)				(LB / FT)								
																	1.88	2.42	3.35		7.60	9.00	10.80			14.60			
PAWLET SB						FY-FLUORESCENT YELLOW FYG-FLUORESCENT YELLOW GREEN																"SHSM"-STANDARD HIGHWAY SIGNS AND MARKINGS							
SB	0.145	F	M2-1	21	15		ROUTE MARKER ASSEMBLY						1		X									REMOVE BLACK/WHITE ROUTE MARKER SIGNS.					
		F	M1-6	24	24								1																
		F	M4-6	24	12								1																
		F	M1-6	30	24								1																
		F	M2-1	21	15			2.15							2		X						#1A	INSTALL GREEN/WHITE ROUTE MARKER SIGNS.		8	E-136B		
		F	M1-5	24	24			4.00																			E-136B		
		F	M4-6	24	12		JCT VERMONT 30 END VERMONT 133	2.00																					E-136B
		F	M1-5	30	24			5.00																			E-136B		
SB	0.105	F	W3-1	30	30		STOP AHEAD			1				X															
SB	0.075	F	D1-1A	72	10								1		X									THINNING AND TRIMMING					
		F	D1-1A	72	10								1																
		F	D1-1A	72	10								1																
		F	D1-1A	72	10								1																
		F	VD1-1A	72	12		← Dorset 8	6.00								2		X									5		
		F	VD1-1A	72	12		← Manchester 15	6.00																			5		
SIGN SUMMARY SHEET							SHEET TOTALS		25.15	0.00	1	0	0	8	0	0	4	60.0		0	0.0	0.0	0.0	0.0	PROJECT NAME: PAWLET - WEST RUTLAND				
									SF	SF	EA	EA	EA	EA	EA	EA	EA	FT			EA	LB	LB	LB	LB	PROJECT NUMBER: STPG SIGN(37)			
																											FILE NAME: 10C340		
							VERMONT AGENCY OF TRANSPORTATION																				PROJECT MANAGER: A. GAMBLE		
							TOWN DIRECTIONAL TOTALS		244.0	0.0	1	2	2	52	0	0	36	540.0		0	0.0				DESIGNED BY: J. KELLY				
																							PLOT DATE: 5/6/2011						
																							DRAWN BY: J. KELLY						
																							CHECKED A. GAMBLE						
																							SHEET 21 OF 61						


DIRECTION	MILEPOINT	LOCATION CODE (SHEET 2)	SIGN CODE	WIDTH (IN)	HEIGHT (IN)	SHEETING REMARKS	SIGN LEGEND	NEW SIGNS		EXISTING SIGNS				EXIST POST		NUMBER OF NEW POSTS	SQUARE STEEL (IN)			TUBULAR STEEL Ø (IN)				SIGN FRAME REQUIRED	REMARKS	SIGN DETAIL LOCATION			
								"A"	"B"	RETAIN	SALVAGE FROM	SALVAGE TO	REMOVE	RETAIN	REMOVE		1.75	2.00	2.50	FOUNDATION	3.00	3.50	4.00			5.00	SHSM	PROJECT SHEET #	STANDARD SHEET #
																	(LB / FT)				(LB / FT)								
																	1.88	2.42	3.35		7.60	9.00	10.80			14.60			
PAWLET SB						FY-FLUORESCENT YELLOW FYG-FLUORESCENT YELLOW GREEN																"SHSM"-STANDARD HIGHWAY SIGNS AND MARKINGS							
		F	VD1-1A	72	12		Wells7	6.00																	5				
		F	VD1-1A	72	12		Poultney16	6.00																	5				
SB	0.045	F	M3-3	24	12		ROUTE MARKER ASSEMBLY						1		X								REMOVE BLACK/WHITE ROUTE MARKERS.						
		F	M1-6	24	24								1																
		F	M5-1	21	15								1																
		F	M3-1	24	12								1																
		F	M1-6	24	24								1																
		F	M5-1	21	15								1																
		F	M3-3	24	12			2.00							2		X					#2	INSTALL GREEN/WHITE ROUTE MARKERS.		8	E-136B			
		F	M1-5	24	24			4.00																	E-136B				
		F	M5-1L	21	15			2.19																	E-136B				
		F	M3-1	24	12		SOUTH VERMONT 30 ← NORTH VERMONT 30 →	2.00																			E-136B		
		F	M1-5	24	24			4.00																	E-136B				
		F	M5-1R	21	15			2.19																	E-136B				
SB	0.010	F	R1-1	30	30								1		X														
SIGN SUMMARY SHEET							SHEET TOTALS	28.38	0.00	0	0	0	7	0	0	2	30.0			0	0.0	0.0	0.0	0.0	PROJECT NAME: PAWLET - WEST RUTLAND				
								SF	SF	EA	EA	EA	EA	EA	EA	EA		FT		EA	LB	LB	LB	LB	PROJECT NUMBER: STPG SIGN(37)				
							TOWN DIRECTIONAL TOTALS	244.0	0.0	1	2	2	52	0	0	36	540.0			0	0.0				FILE NAME: 10C340				
VERMONT AGENCY OF TRANSPORTATION																								PROJECT MANAGER: A. GAMBLE			PLOT DATE: 5/6/2011		
																											DESIGNED BY: J. KELLY		
																								PAWLET SB SHEET 7			CHECKED A. GAMBLE		
																											SHEET 22 OF 61		




DIRECTION	MILEPOINT	LOCATION CODE (SHEET 2)	SIGN CODE	WIDTH (IN)	HEIGHT (IN)	SHEETING REMARKS	SIGN LEGEND	NEW SIGNS		EXISTING SIGNS				EXIST POST		NUMBER OF NEW POSTS	SQUARE STEEL (IN)			TUBULAR STEEL Ø (IN)				SIGN FRAME REQUIRED	REMARKS	SIGN DETAIL LOCATION			
								"A"	"B"	RETAIN	SALVAGE FROM	SALVAGE TO	REMOVE	RETAIN	REMOVE		1.75	2.00	2.50	FOUNDATION	3.00	3.50	4.00			5.00	SHSM	PROJECT SHEET #	STANDARD SHEET #
																	(LB / FT)				(LB / FT)								
																	1.88	2.42	3.35		7.60	9.00	10.80			14.60			
PAWLET SB						FY-FLUORESCENT YELLOW FYG-FLUORESCENT YELLOW GREEN																"SHSM"-STANDARD HIGHWAY SIGNS AND MARKINGS							
		F	R1-1	36	36			9.00							2	X							VT-30 INTERSECTION.	X					
SIGN SUMMARY SHEET							SHEET TOTALS	9.00	0.00	0	0	0	0	0	0	2	30.0	0	0.0	0.0	0.0	0.0	PROJECT NAME: PAWLET - WEST RUTLAND PROJECT NUMBER: STPG SIGN(37)						
							SF	SF	EA	EA	EA	EA	EA	EA	EA	EA	FT	EA	LB	LB	LB	LB	FILE NAME: 10C340 PROJECT MANAGER: A. GAMBLE DESIGNED BY: J. KELLY PAWLET SB SHEET 8						
VERMONT AGENCY OF TRANSPORTATION							TOWN DIRECTIONAL TOTALS	244.0	0.0	1	2	2	52	0	0	36	540.0	0	0.0				PLOT DATE: 5/6/2011 DRAWN BY: J. KELLY CHECKED: A. GAMBLE SHEET 23 OF 61						

DIRECTION	MILEPOINT	LOCATION CODE (SHEET 2)	SIGN CODE	WIDTH (IN)	HEIGHT (IN)	SHEETING REMARKS	SIGN LEGEND	NEW SIGNS		EXISTING SIGNS				EXIST POST		NUMBER OF NEW POSTS	SQUARE STEEL (IN)			TUBULAR STEEL Ø (IN)					SIGN FRAME REQUIRED	REMARKS	SIGN DETAIL LOCATION		
								"A"	"B"	RETAIN	SALVAGE FROM	SALVAGE TO	REMOVE	RETAIN	REMOVE		1.75	2.00	2.50	FOUNDATION	3.00	3.50	4.00	5.00					
																	(LB / FT)				(LB / FT)								
																	1.88	2.42	3.35		7.60	9.00	10.80	14.60					
DANBY NB/SB						FY-FLUORESCENT YELLOW FYG-FLUORESCENT YELLOW GREEN																"SHSM"-STANDARD HIGHWAY SIGNS AND MARKINGS							
NB	0.004	D	R1-1	30	30								1		X									LILLY HILL RD. (TH-5)					
		D	R1-1	30	30			6.25									1	X								X			
SB	0.024	G	VD-024	60	7.5		DANBY/TINMOUTH TOWN LINE SIGN						1		X									NEW TOWN LINE SIGN TO BE INSTALLED ON OPPOSITE SIDE OF ROAD.					
SB	0.000	G	VD-024	60	7.5		Pawlet Danby 1330 1114 0533 1330 1106 0000						1		X														
		G	VD-024	72	10			5.00									2	X							INSTALL DIRECTLY ACROSS FROM CENTER OF TOWN HIGHWAY.		4		
		G	VD-700	6	10			0.42																	INSTALL ON LH POST BELOW PAWLET.			E-138	
		G	VD-700	6	10			0.42																	INSTALL ON RH POST BELOW DANBY.			E-138	
SIGN SUMMARY SHEET							SHEET TOTALS		12.09	0.00	0	0	0	3	0	0	3	45.0			0	0.0	0.0	0.0	0.0	PROJECT NAME: PAWLET - WEST RUTLAND			
									SF	SF	EA	EA	EA	EA	EA	EA	EA	FT			EA	LB	LB	LB	LB	PROJECT NUMBER: STPG SIGN(37)			
																										FILE NAME: 10C340			
							VERMONT AGENCY OF TRANSPORTATION																				PLOT DATE: 5/6/2011		
TOWN DIRECTIONAL TOTALS																								DRAWN BY: J. KELLY					
																										CHECKED A. GAMBLE			
									12.1	0.0	0	0	0	3	0	0	3	45.0			0	0.0			DANBY NB/SB SHEET 1				
																								SHEET 24 OF 61					

DIRECTION	MILEPOINT	LOCATION CODE (SHEET 2)	SIGN CODE	WIDTH (IN)	HEIGHT (IN)	SHEETING REMARKS	SIGN LEGEND	NEW SIGNS		EXISTING SIGNS				EXIST POST		NUMBER OF NEW POSTS	SQUARE STEEL (IN)			TUBULAR STEEL Ø (IN)					SIGN FRAME REQUIRED	REMARKS	SIGN DETAIL LOCATION		
								"A"	"B"	RETAIN	SALVAGE FROM	SALVAGE TO	REMOVE	RETAIN	REMOVE		1.75	2.00	2.50	FOUNDATION	3.00	3.50	4.00	5.00			SHSM	PROJECT SHEET #	STANDARD SHEET #
																	(LB / FT)				(LB / FT)								
																	1.88	2.42	3.35		7.60	9.00	10.80	14.60					
TINMOUTH NB							FY-FLUORESCENT YELLOW FYG-FLUORESCENT YELLOW GREEN																"SHSM"-STANDARD HIGHWAY SIGNS AND MARKINGS						
NB	0.000	C	VD-024	72	10		Tinmouth Danby	5.00							2		X							INSTALL ACROSS FROM EXISTING TOWN LINE SIGN AND BEHIND POLE #123-1.		4			
		C	VD-700	6	10		1330 1124 0000 1330 1106 0002	0.42																INSTALL ON LEFT POST BELOW TINMOUTH			E-138		
		C	VD-700	6	10			0.42																INSTALL ON RIGHT POST BELOW DANBY			E-138		
NB	0.490	A	W2-1 M	30	30		MODIFIED CROSSROAD						1		X														
NB	0.535	A	W2-7L	30	30		← Brook Rd McCoy Rd →	6.25							1		X								INSTALL 225 FEET NORTH OF EXISTING INTERSECTION ASSEMBLY.	X			
		A	W16-8AP	42	15			4.38																THINNING AND TRIMMING		7			
NB	0.630	C	VR-017	24	30		LEGAL LOAD LIMIT 24,000 POUNDS						1		X									MCCOY RD (TH-28)					
		C	VR-017	24	30			5.00							1		X							THINNING AND TRIMMING		6			
NB	0.635	D	R1-1	24	24		STOP						1		X									MCCOY RD (TH-28)					
		D	R1-1	30	30			6.25							1		X							THINNING AND TRIMMING	X				
NB	0.640	A	OM-3R	12	36								1		X														
		A	OM-3R	12	36			3.00							1		X							INSTALL AT HEIGHT OF 4 FEET ABOVE ROAD.	X				
		A	VD-701	6	8		BRIDGE MARKER				1	1	1											INSTALL BELOW OBJECT MARKER.					
NB	0.650	B	OM-3L	12	36		(SIGN IS MISSING)						4		X														
		B	OM-3L	12	36			3.00							1		X							INSTALL AT HEIGHT OF 4 FEET ABOVE ROAD.	X				
SIGN SUMMARY SHEET							SHEET TOTALS		33.72	0.00	0	1	1	5.6	0	0	7	105.0			0	0.0	0.0	0.0	0.0	PROJECT NAME: PAWLET - WEST RUTLAND			
									SF	SF	EA	EA	EA	EA	EA	EA	EA		FT		EA	LB	LB	LB	LB	PROJECT NUMBER: STPG SIGN(37)			
																										FILE NAME: 10C340			
							VERMONT AGENCY OF TRANSPORTATION																				PROJECT MANAGER: A. GAMBLE		
							TOWN DIRECTIONAL TOTALS		49.7	0.0	1	1	1	13	0	0	11	165.0			0	0.0				PLOT DATE: 5/6/2011			
																								DRAWN BY: J. KELLY					
																								CHECKED A. GAMBLE					
																							SHEET 25 OF 61						

DIRECTION	MILEPOINT	LOCATION CODE (SHEET 2)	SIGN CODE	WIDTH (IN)	HEIGHT (IN)	SHEETING REMARKS	SIGN LEGEND	NEW SIGNS		EXISTING SIGNS				EXIST POST		NUMBER OF NEW POSTS	SQUARE STEEL (IN)			TUBULAR STEEL Ø (IN)					SIGN FRAME REQUIRED	REMARKS	SIGN DETAIL LOCATION		
								"A"	"B"	RETAIN	SALVAGE FROM	SALVAGE TO	REMOVE	RETAIN	REMOVE		1.75	2.00	2.50	FOUNDATION	3.00	3.50	4.00	5.00			SHSM	PROJECT SHEET #	STANDARD SHEET #
																	(LB / FT)				(LB / FT)								
																	1.88	2.42	3.35		7.60	9.00	10.80	14.60					
TINMOUTH NB							FY-FLUORESCENT YELLOW FYG-FLUORESCENT YELLOW GREEN																"SHSM"-STANDARD HIGHWAY SIGNS AND MARKINGS						
NB	0.960	A	W11-5	30	30		FARM MACHINERY						1		X														
NB	1.061	A	W11-4	30	30		CATTLE						1		X									THINNING AND TRIMMING					
		A	VD1-1A	72	12		← Wells 5	6.00								2		X							THINNING AND TRIMMING		5		
NB	1.080	A	D1-1A	54	7.5		<--- WELLS 5						1		X														
		A	D1-1G	54	7.5		<--- LAKE ST CATHERINE 8						1																
NB	1.145	A	M3-1	24	12								1		X									REMOVE BLACK/WHITE ROUTE MARKERS					
		A	M1-6	24	24								+											THINNING AND TRIMMING					
		A	M3-1	24	12		NORTH VERMONT 133	2.00								1		X							INSTALL GREEN/WHITE ROUTE MARKERS.			E-136B	
		A	M1-5	30	24		133	3.00																			E-136B		
NB	1.245	A	R2-1	24	30								2 +		X									THINNING AND TRIMMING					
		A	R2-1	24	30		SPEED LIMIT 50	5.00								1		X								X			
NB	2.026	D	R1-1	24	24		STOP			1				X										GULF RD. (TH-14)					
SIGN SUMMARY SHEET							SHEET TOTALS	16.00	0.00	1	0	0	5 7	0	0	4	60.0			0	0.0	0.0	0.0	0.0	PROJECT NAME: PAWLET - WEST RUTLAND				
								SF	SF	EA	EA	EA	EA	EA	EA	EA		FT		EA	LB		LB	LB	LB	PROJECT NUMBER: STPG SIGN(37)			
							TOWN DIRECTIONAL TOTALS	49.7	0.0	1	1	1	13	0	0	11	165.0			0	0.0				FILE NAME: 10C340 PROJECT MANAGER: A. GAMBLE DESIGNED BY: J. KELLY TINMOUTH NB SHEET 2			PLOT DATE: 5/6/2011 DRAWN BY: J. KELLY CHECKED A. GAMBLE SHEET 26 OF 61	
VERMONT AGENCY OF TRANSPORTATION																													

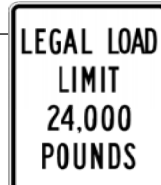
DIRECTION	MILEPOINT	LOCATION CODE (SHEET 2)	SIGN CODE	WIDTH (IN)	HEIGHT (IN)	SHEETING REMARKS	SIGN LEGEND	NEW SIGNS		EXISTING SIGNS				EXIST POST		NUMBER OF NEW POSTS	SQUARE STEEL (IN)			TUBULAR STEEL Ø (IN)				SIGN FRAME REQUIRED	REMARKS	SIGN DETAIL LOCATION					
								"A"	"B"	RETAIN	SALVAGE FROM	SALVAGE TO	REMOVE	RETAIN	REMOVE		1.75	2.00	2.50	FOUNDATION	3.00	3.50	4.00			5.00	SHSM	PROJECT SHEET #	STANDARD SHEET #		
																	(LB / FT)				(LB / FT)										
																	1.88	2.42	3.35		7.60	9.00	10.80			14.60					
TINMOUTH SB							FY-FLUORESCENT YELLOW FYG-FLUORESCENT YELLOW GREEN															"SHSM"-STANDARD HIGHWAY SIGNS AND MARKINGS									
SB	2.153	A	W11-5	30	30								1	X																	
		A	W7-3A	24	18								1																		
		A	W11-5	30	30			6.25																	INSTALL NEW SIGNS ON EXISTING POST.	X					
		A	W7-3A	24	18			3.00																		X					
SB	1.394	F	W11-5	30	30		FARM MACHINERY						1		X																
		F	W11-4	30	30		CATTLE						1																		
SB	1.180	F	VD1-1A	72	12		Wells5➡	6.00				I	I			2		X			ADDITIONAL SIGN RELOCATED PER REQUEST FROM PROPERTY OWNER 8FT			INSTALL 10 FEET FROM POLE, 150 FEET NORTH OF EXISTING.		5					
SB	1.150	F	D1-1A	72	10		WELLS 5 ---->						1		X																
		F	D1-1G	72	10		LAKE ST CATHERINE 8 ---->						1																		
SB	1.128	H	R1-1	24	24								1		X										E. WELLS RD. (TH-5)						
		H	R1-1	30	30			6.25								1		X							INSTALL BACK TO BACK ON SAME POST WITH LL24K	X					
SB	1.128	G	VR-017	24	30								1		X										E. WELLS RD. (TH-5)						
		G	VR-017	24	30			5.00																	INSTALL BACK TO BACK ON SAME POST WITH STOP SIGN (ABOVE) AND CLOSER TO VT-133.		6				
		G					TOWN'S REDUCED SPEED AHEAD SIGN						1																		
SB	1.120	H	R1-1	30	30								1		X																
SIGN SUMMARY SHEET							SHEET TOTALS		26.50	0.00	0	0	0	9 19	0	0	3	45.0			0	0.0	0.0	0.0	0.0	PROJECT NAME: PAWLET - WEST RUTLAND					
									SF	SF	EA	EA	EA	EA	EA	EA	EA		FT		EA	LB	LB	LB	LB	PROJECT NUMBER: STPG SIGN(37)					
																									FILE NAME: 10C340			PLOT DATE: 5/6/2011			
							VERMONT AGENCY OF TRANSPORTATION																		PROJECT MANAGER: A. GAMBLE			DRAWN BY: J. KELLY			
							TOWN DIRECTIONAL TOTALS		67.6	0.0	0	1	1	18	0	0	10	150.0			0	0.0				DESIGNED BY: J. KELLY			CHECKED A. GAMBLE		
																									TINMOUTH SB SHEET 1			SHEET 27 OF 61			

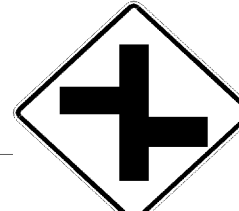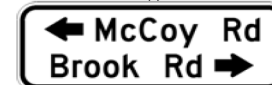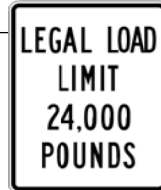DIRECTION	MILEPOINT	LOCATION CODE (SHEET 2)	SIGN CODE	WIDTH (IN)	HEIGHT (IN)	SHEETING REMARKS	SIGN LEGEND	NEW SIGNS		EXISTING SIGNS				EXIST POST		NUMBER OF NEW POSTS	SQUARE STEEL (IN)			TUBULAR STEEL Ø (IN)					SIGN FRAME REQUIRED	REMARKS	SIGN DETAIL LOCATION		
								"A"	"B"	RETAIN	SALVAGE FROM	SALVAGE TO	REMOVE	RETAIN	REMOVE		1.75	2.00	2.50	FOUNDATION	3.00	3.50	4.00	5.00			SHSM	PROJECT SHEET #	STANDARD SHEET #
																	(LB / FT)				(LB / FT)								
																	1.88	2.42	3.35		7.60	9.00	10.80	14.60					
TINMOUTH SB							FY-FLUORESCENT YELLOW FYG-FLUORESCENT YELLOW GREEN															"SHSM"-STANDARD HIGHWAY SIGNS AND MARKINGS							
		H	R1-1	30	30			6.25							1		X							E. WELLS RD. (TH-5)	X				
SB	1.075	F	M3-3	24	12								1		X									REMOVE BLACK/WHITE SIGNS.					
		F	M1-6	24	30								1											THINNING AND TRIMMING					
		F	M3-3	24	12			2.00							1		X								INSTALL GREEN/WHITE SIGNS.			E-136B	
		F	M1-5	30	24			5.00																			E-136B		
SB	0.855	F	W2-1	30	30		MODIFIED CROSSROAD						1		X														
SB	0.730	F	W2-7R	30	30			6.25								1		X							INSTALL 500 FEET SOUTH OF EXISTING. TRIM TREES WHERE NEEDED.	X			
		F	W16-8AP	42	15			4.38																	THINNING AND TRIMMING		7		
SB	0.655	F	OM-3R	12	36								1		X														
		F	OM-3R	12	36			3.00								1		X							INSTALL AT HEIGHT OF 4 FEET TO BOTTOM OF SIGN.	X			
		F	VD-701	6	8		BRIDGE MARKER "5"				1	1	1												REINSTALL BELOW NEW OBJECT MARKER.				
SB	0.650	E	OM-3L	12	36								1		X														
		E	OM-3L	12	36			3.00								1		X							INSTALL AT HEIGHT OF 4 FEET TO BOTTOM OF SIGN.	X			
SB	0.629	G	VR-017	24	30								1		X										BROOK RD. (TH-27)				
		G	VR-017	24	30			5.00								1		X							THINNING AND TRIMMING		7		
SIGN SUMMARY SHEET							SHEET TOTALS		34.88	0.00	0	1	1	7	0	0	6	90.0			0	0.0	0.0	0.0	0.0	PROJECT NAME: PAWLET - WEST RUTLAND			
									SF	SF	EA	EA	EA	EA	EA	EA	EA		FT		EA	LB	LB	LB	LB	PROJECT NUMBER: STPG SIGN(37)			
																									FILE NAME: 10C340		PLOT DATE: 5/6/2011		
VERMONT AGENCY OF TRANSPORTATION							TOWN DIRECTIONAL TOTALS		67.6	0.0	0	1	1	18	0	0	10	150.0			0	0.0				PROJECT MANAGER: A. GAMBLE			
																					DESIGNED BY: J. KELLY			DRAWN BY: J. KELLY					
																									CHECKED A. GAMBLE				
																									SHEET 28 OF 61				

DIRECTION	MILEPOINT	LOCATION CODE (SHEET 2)	SIGN CODE	WIDTH (IN)	HEIGHT (IN)	SHEETING REMARKS	SIGN LEGEND	NEW SIGNS		EXISTING SIGNS				EXIST POST		NUMBER OF NEW POSTS	SQUARE STEEL (IN)			TUBULAR STEEL Ø (IN)				SIGN FRAME REQUIRED	REMARKS	SIGN DETAIL LOCATION			
								"A"	"B"	RETAIN	SALVAGE FROM	SALVAGE TO	REMOVE	RETAIN	REMOVE		1.75	2.00	2.50	FOUNDATION	3.00	3.50	4.00			5.00	SHSM	PROJECT SHEET #	STANDARD SHEET #
																	(LB / FT)				(LB / FT)								
																	1.88	2.42	3.35		7.60	9.00	10.80			14.60			
TINMOUTH SB							FY-FLUORESCENT YELLOW FYG-FLUORESCENT YELLOW GREEN															"SHSM"-STANDARD HIGHWAY SIGNS AND MARKINGS							
SB	0.621	H	R1-1	30	30								1		X								BROOK RD. (TH-27)						
		H	R1-1	30	30			6.25								1		X						X					
SIGN SUMMARY SHEET							SHEET TOTALS	6.25	0.00	0	0	0	1	0	0	1	15.0			0	0.0	0.0	0.0	0.0	PROJECT NAME: PAWLET - WEST RUTLAND				
								SF	SF	EA	EA	EA	EA	EA	EA	EA	FT			EA	LB	LB	LB	LB	PROJECT NUMBER: STPG SIGN(37)				
							VERMONT AGENCY OF TRANSPORTATION																				FILE NAME: 10C340		
TOWN DIRECTIONAL TOTALS																							PROJECT MANAGER: A. GAMBLE						
							67.6	0.0	0	1	1	18	0	0	10	150.0			0	0.0				DESIGNED BY: J. KELLY					
																						PLOT DATE: 5/6/2011							
																						DRAWN BY: J. KELLY							
																						CHECKED A. GAMBLE							
																						SHEET 29 OF 61							
																						TINMOUTH SB SHEET 3							

DIRECTION	MILEPOINT	LOCATION CODE (SHEET 2)	SIGN CODE	WIDTH (IN)	HEIGHT (IN)	SHEETING REMARKS	SIGN LEGEND	NEW SIGNS		EXISTING SIGNS				EXIST POST		NUMBER OF NEW POSTS	SQUARE STEEL (IN)			TUBULAR STEEL Ø (IN)					SIGN FRAME REQUIRED	REMARKS	SIGN DETAIL LOCATION		
								"A"	"B"	RETAIN	SALVAGE FROM	SALVAGE TO	REMOVE	RETAIN	REMOVE		1.75	2.00	2.50	FOUNDATION	3.00	3.50	4.00	5.00			SHSM	PROJECT SHEET #	STANDARD SHEET #
																	(LB / FT)				(LB / FT)								
																	1.88	2.42	3.35		7.60	9.00	10.80	14.60					
MIDDLETOWN SPRINGS NB							FY-FLUORESCENT YELLOW FYG-FLUORESCENT YELLOW GREEN															"SHSM"-STANDARD HIGHWAY SIGNS AND MARKINGS							
NB	0.000	C	VD-024	60	7.5										X														
		C	VD-024	72	10		Middletown Springs	5.00								2		X									4		
		C	VD-700	6	10		1330 1111 0000	0.42																INSTALL ON LH POST BELOW MIDDLETOWN SPRINGS.				E-138	
		C	VD-700	6	10			0.42															INSTALL ON RH POST BELOW TINMOUTH. LEAVE BOTTOM SET OF NUMBERS BLANK.				E-138		
NB	0.525	A	W1-2R	30	30		RIGHT CURVE				1		1		X									RELOCATE ASSEMBLY 300 FEET NORTH OF EXISTING.					
		A	W13-1	18	18		40 MPH ADVISORY				1		1																
NB	0.582	A	W1-2R	30	30		RIGHT CURVE					1				1		X						INSTALL 300 FEET NORTH OF EXISTING.					
		A	W13-1	18	18		40 MPH ADVISORY					1											THINNING AND TRIMMING						
NB	0.965	A	W1-4R	30	30		RIGHT REVERSE CURVE				1			X															
NB	1.187	A	W11-7	30	30		EQUESTRIAN				1	2 4	2 4		X	1		X						RETAIN SIGN AND INSTALL ON NEW POST.					
NB	1.541	A	W11-5	30	30		FARM MACHINERY				1			X									THINNING AND TRIMMING						
NB	1.615	C	VR-017	24	30								1		X									DAISY HOLLOW RD (TH-20)					
		C	VR-017	24	30		LEGAL LOAD LIMIT 24,000 POUNDS	5.00								1		X								6			
NB	1.619	D	R1-1	30	30		STOP				1			X										DAISY HOLLOW RD (TH-20)					
NB	2.140	A	W1-10R	30	30		MODIFIED RIGHT CURVE					1	1	1		X	1		X					RETAIN SIGNS AND INSTALL ON NEW POST.					
SIGN SUMMARY SHEET							SHEET TOTALS	10.84	0.00	3	4	5 4	8 6	0	0	6	90.0			0	0.0	0.0	0.0	0.0	PROJECT NAME: PAWLET - WEST RUTLAND				
								SF	SF	EA	EA	EA	EA	EA	EA	EA		FT		EA	LB	LB	LB	LB	PROJECT NUMBER: STPG SIGN(37)				
							VERMONT AGENCY OF TRANSPORTATION																			FILE NAME: 10C340			
TOWN DIRECTIONAL TOTALS								44.1	0.0	42	13	13	22	0	0	16	240.0			0	0.0				PROJECT MANAGER: A. GAMBLE				
																							PLOT DATE: 5/6/2011						
																							DRAWN BY: J. KELLY						
																							CHECKED A. GAMBLE						
																							MIDDLETOWN SPRINGS NB SHEET 1						
																							SHEET 30 OF 61						



DIRECTION	MILEPOINT	LOCATION CODE (SHEET 2)	SIGN CODE	WIDTH (IN)	HEIGHT (IN)	SHEETING REMARKS	SIGN LEGEND	NEW SIGNS		EXISTING SIGNS				EXIST POST		NUMBER OF NEW POSTS	SQUARE STEEL (IN)			TUBULAR STEEL Ø (IN)					SIGN FRAME REQUIRED	REMARKS	SIGN DETAIL LOCATION		
								"A"	"B"	RETAIN	SALVAGE FROM	SALVAGE TO	REMOVE	RETAIN	REMOVE		1.75	2.00	2.50	FOUNDATION	3.00	3.50	4.00	5.00			SHSM	PROJECT SHEET #	STANDARD SHEET #
																	(LB / FT)				(LB / FT)								
																	1.88	2.42	3.35		7.60	9.00	10.80	14.60					
MIDDLETOWN SPRINGS NB							FY-FLUORESCENT YELLOW FYG-FLUORESCENT YELLOW GREEN															"SHSM"-STANDARD HIGHWAY SIGNS AND MARKINGS							
		A	W13-1	18	18		40 MPH ADVISORY				1	1	1																
NB	2.809	A	W3-5	36	36		SPEED REDUCTION			1				X															
NB	2.860	A	VD-018	30	18		MIDDLETOWN SPRINGS			1				X															
NB	2.921	A	R2-1	24	30		SPEED LIMIT 40			1				X															
NB	3.111	A	R2-1	24	30		SPEED LIMIT 35			1				X															
NB	3.315	A	R2-1	24	30		SPEED LIMIT 35				1	1	1		X	1		X						REMOVE AND REINSTALL SALVAGED SIGN. REPLACE POST.					
NB	3.499	A	R2-1	24	30		SPEED LIMIT 35				1	2 4	2 4		X	1		X						REMOVE AND REINSTALL SALVAGED SIGN. REPLACE POST.	THINNING AND TRIMMING				
NB	3.640	C	VR-017	24	30								1	X										MONTVERT RD (TH-26)					
		C	VR-017	24	30		LEGAL LOAD LIMIT 24,000 POUNDS	5.00																INSTALL NEW SIGN ON EXISTING POST.		6			
NB	3.640	D	R1-1	30	30		STOP			1				X										MONTVERT RD (TH-26)					
NB	3.653	D	R1-1	30	30		STOP			1				X										MONTVERT RD (TH-26)					
NB	3.696	A	S1-1	30	30		SCHOOL			1				X															
		A	W16-9	24	12		AHEAD			1																			
NB	3.724	A	M2-1	21	15		JCT				1	1	1		X	1		X						REMOVE AND REINSTALL SALVAGED SIGNS. REPLACE POST.					
		A	M1-6	30	24		ROUTE 140				1	1	1																
SIGN SUMMARY SHEET							SHEET TOTALS	5.00	0.00	8	5	6 5	7 6	0	0	3	45.0			0	0.0	0.0	0.0	0.0	PROJECT NAME: PAWLET - WEST RUTLAND				
								SF	SF	EA	EA	EA	EA	EA	EA	EA		FT		EA	LB	LB	LB	LB	PROJECT NUMBER: STPG SIGN(37)				
																											FILE NAME: 10C340		
							VERMONT AGENCY OF TRANSPORTATION																					PROJECT MANAGER: A. GAMBLE	
							TOWN DIRECTIONAL TOTALS	44.1	0.0	42	13	13	22	0	0	16	240.0			0	0.0				PLOT DATE: 5/6/2011				
																							DRAWN BY: J. KELLY						
																							DESIGNED BY: J. KELLY						
																							CHECKED A. GAMBLE						
																							MIDDLETOWN SPRINGS NB SHEET 2						
																							SHEET 31 OF 61						

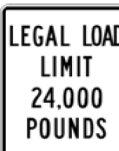
DIRECTION	MILEPOINT	LOCATION CODE (SHEET 2)	SIGN CODE	WIDTH (IN)	HEIGHT (IN)	SHEETING REMARKS	SIGN LEGEND	NEW SIGNS		EXISTING SIGNS				EXIST POST		NUMBER OF NEW POSTS	SQUARE STEEL (IN)			TUBULAR STEEL Ø (IN)					SIGN FRAME REQUIRED	REMARKS	SIGN DETAIL LOCATION		
								"A"	"B"	RETAIN	SALVAGE FROM	SALVAGE TO	REMOVE	RETAIN	REMOVE		1.75	2.00	2.50	FOUNDATION	3.00	3.50	4.00	5.00			SHSM	PROJECT SHEET #	STANDARD SHEET #
																	(LB / FT)				(LB / FT)								
																	1.88	2.42	3.35		7.60	9.00	10.80	14.60					
MIDDLETOWN SPRINGS NB							FY-FLUORESCENT YELLOW FYG-FLUORESCENT YELLOW GREEN															"SHSM"-STANDARD HIGHWAY SIGNS AND MARKINGS							
NB	3.760	A	VR-020	24	30								1	X															
		A	VR-020	24	30			5.00																INSTALL ON EXISTING FLANGED CHANNEL POST.		6			
NB	3.765	C	VR-017	24	30								1	X										BURDOCK AVE (TH-24)					
		C	VR-017	24	30			5.00																REPLACE SIGN AND RETAIN POST.		6			
NB	3.770	D	R1-1	30	30		STOP			1				X										BURDOCK AVE (TH-24)					
NB	3.784	A	S1-1	30	30		SCHOOL			1				X															
		A	W16-7	24	12		DIAGONAL ARROW			1																			
NB	3.823	A	D1-1A	72	12		<--- POULTNEY 8			1				X															
		A	D1-1A	72	12		IRA 6 --->			1																			
		A	D1-1A	72	12		WEST RUTLAND 11 ---->			1																			
NB	3.849	A	M3-4	24	12		WEST			1				X															
		A	M1-6	30	24		ROUTE 140	5.00		4			1																
		A	M6-1	21	15		<--- LEFT			1																			
		A	M3-1	24	12		NORTH			1																			
		A	M1-5	30	24		VERMONT 133			1																			
SIGN SUMMARY SHEET							SHEET TOTALS	15.00 10.00	0.00	11	0	0	3 2	0	0	0	0.0			0	0.0	0.0	0.0	0.0	PROJECT NAME: PAWLET - WEST RUTLAND				
								SF	SF	EA	EA	EA	EA	EA	EA	EA	FT			EA	LB	LB	LB	LB	PROJECT NUMBER: STPG SIGN(37)				
							VERMONT AGENCY OF TRANSPORTATION																				FILE NAME: 10C340		
TOWN DIRECTIONAL TOTALS																								PROJECT MANAGER: A. GAMBLE					
							44.1	0.0	42	13	13	22	0	0	16	240.0			0	0.0									
																								DRAWN BY: J. KELLY					
																								CHECKED A. GAMBLE					
																								SHEET 32 OF 61					

DIRECTION	MILEPOINT	LOCATION CODE (SHEET 2)	SIGN CODE	WIDTH (IN)	HEIGHT (IN)	SHEETING REMARKS	SIGN LEGEND	NEW SIGNS		EXISTING SIGNS				EXIST POST		NUMBER OF NEW POSTS	SQUARE STEEL (IN)			TUBULAR STEEL Ø (IN)				SIGN FRAME REQUIRED	REMARKS	SIGN DETAIL LOCATION						
								"A"	"B"	RETAIN	SALVAGE FROM	SALVAGE TO	REMOVE	RETAIN	REMOVE		1.75	2.00	2.50	FOUNDATION	3.00	3.50	4.00			5.00	SHSM	PROJECT SHEET #	STANDARD SHEET #			
																	(LB / FT)				(LB / FT)											
																	1.88	2.42	3.35		7.60	9.00	10.80			14.60						
MIDDLETOWN SPRINGS NB							FY-FLUORESCENT YELLOW FYG-FLUORESCENT YELLOW GREEN															"SHSM"-STANDARD HIGHWAY SIGNS AND MARKINGS										
		A	M6-1	21	15		RIGHT --->			1																						
		A	M3-2	24	12		EAST			1																						
		A	M1-6	30	24		ROUTE 140	5.00		+																						
		A	M6-1	21	15		RIGHT --->			1																						
NB	3.851	A	R1-1	30	30								1	X									ROUTE 140 & NORTH ST									
		A	R1-1	30	30			6.25															INSTALL NEW SIGNS ON EXISTING POST.	X								
		A	R1-3	12	6			4-WAY						1									REMOVE 4-WAY SIGN AND REPLACE WITH AN "ALL WAY" SIGN.									
		A	R1-3P	18	6				0.75																X							
NB	3.927	C	VR-017	24	30		LLL 24,000 LBS			1				X									BURDOCK AVE (TH-24)									
NB	3.932	D	R1-1	30	30		STOP			1				X									BURDOCK AVE (TH-24)									
NB	3.936	A	M3-1	24	12		NORTH			1				X																		
		A	M1-5	30	24		VERMONT 133			1																						
		A	M4-5	24	12		TO			1																						
		A	M3-2	24	12		EAST			1																						
		A	M1-6	30	24		ROUTE 140			1																						
SIGN SUMMARY SHEET							SHEET TOTALS	12.00 7.00	0.00	11	0	0	3 2	0	0	0	0.0			0	0.0	0.0	0.0	0.0	PROJECT NAME: PAWLET - WEST RUTLAND PROJECT NUMBER: STPG SIGN(37)							
								SF	SF	EA	EA	EA	EA	EA	EA	EA	FT			EA	LB	LB	LB	LB	FILE NAME: 10C340 PROJECT MANAGER: A. GAMBLE DESIGNED BY: J. KELLY			PLOT DATE: 5/6/2011 DRAWN BY: J. KELLY CHECKED A. GAMBLE				
																											MIDDLETOWN SPRINGS NB SHEET 4			SHEET 33 OF 61		
							VERMONT AGENCY OF TRANSPORTATION							TOWN DIRECTIONAL TOTALS	44.1	0.0	42	13	13	22	0	0	16	240.0			0	0.0				

DIRECTION	MILEPOINT	LOCATION CODE (SHEET 2)	SIGN CODE	WIDTH (IN)	HEIGHT (IN)	SHEETING REMARKS	SIGN LEGEND	NEW SIGNS		EXISTING SIGNS				EXIST POST		NUMBER OF NEW POSTS	SQUARE STEEL (IN)			TUBULAR STEEL Ø (IN)					SIGN FRAME REQUIRED	REMARKS	SIGN DETAIL LOCATION											
								"A"	"B"	RETAIN	SALVAGE FROM	SALVAGE TO	REMOVE	RETAIN	REMOVE		1.75	2.00	2.50	FOUNDATION	3.00	3.50	4.00	5.00			SHSM	PROJECT SHEET #	STANDARD SHEET #									
																	(LB / FT)				(LB / FT)																	
																	1.88	2.42	3.35		7.60	9.00	10.80	14.60														
MIDDLETOWN SPRINGS NB							FY-FLUORESCENT YELLOW FYG-FLUORESCENT YELLOW GREEN															"SHSM"-STANDARD HIGHWAY SIGNS AND MARKINGS																
NB	4.171	A	R2-1	24	30		SPEED LIMIT 40			1				X																								
NB	4.283	C	VR-017	24	30								1	X											FITZGERALD RD (TH-18)													
		C	VR-017	24	30		LEGAL LOAD LIMIT 24,000 POUNDS	5.00																		INSTALL NEW SIGN ON EXISTING POST.		6										
NB	4.287	D	R1-1	30	30		STOP			1				X											FITZGERALD RD (TH-18)													
NB	4.355	A	R2-1	24	30		SPEED LIMIT 40			1				X																								
NB	4.396	A	W1-5L	30	30		LEFT WINDING CURVES			1				X																								
		A	W7-3A	24	18		NEXT 1 MILE			1																												
NB	4.452	A	W1-4L	30	30		LEFT REVERSE CURVE				1		1		X																							
NB	4.500	A	W1-4L	30	30		LEFT REVERSE CURVE					1				1		X							RELOCATE SIGN ASSEMBLY 250 FEET NORTH OF EXISTING													
NB	4.773	A	W1-4L	30	30		LEFT REVERSE CURVE				1	1	1		X	1		X							INSTALL EXISTING SIGN ON NEW POST.													
NB	5.065	A	W1-1R	30	30		RIGHT TURN			1				X																								
		A	W13-1	18	18		30 MPH ADVISORY			1																												
NB	5.401	A	W1-2L	30	30		LEFT CURVE			1				X																								
		A	W13-1	18	18		30 MPH ADVISORY			1																												
NB	5.450	A	W1-6L	48	24		LEFT LARGE ARROW					1				2		X							INSTALL 50 FEET SOUTH OF EXISTING LOCATION													
SIGN SUMMARY SHEET							SHEET TOTALS		5.00	0.00	9	2	3	3	0	0	4	60.0			0	0.0	0.0	0.0	0.0	PROJECT NAME: PAWLET - WEST RUTLAND												
									SF	SF	EA	EA	EA	EA	EA	EA	EA		FT		EA	LB	LB	LB	LB	PROJECT NUMBER: STPG SIGN(37)												
																									FILE NAME: 10C340			PLOT DATE: 5/6/2011										
							VERMONT AGENCY OF TRANSPORTATION		TOWN DIRECTIONAL TOTALS											44.1					0.0	42	13	13	22	0	0	16	240.0			0	0.0	
																								DESIGNED BY: J. KELLY			CHECKED A. GAMBLE											
																								MIDDLETOWN SPRINGS NB SHEET 5			SHEET 34 OF 61											

DIRECTION	MILEPOINT	LOCATION CODE (SHEET 2)	SIGN CODE	WIDTH (IN)	HEIGHT (IN)	SHEETING REMARKS	SIGN LEGEND	NEW SIGNS		EXISTING SIGNS				EXIST POST		NUMBER OF NEW POSTS	SQUARE STEEL (IN)			TUBULAR STEEL Ø (IN)				SIGN FRAME REQUIRED	REMARKS	SIGN DETAIL LOCATION			
								"A"	"B"	RETAIN	SALVAGE FROM	SALVAGE TO	REMOVE	RETAIN	REMOVE		1.75	2.00	2.50	FOUNDATION	3.00	3.50	4.00			5.00	SHSM	PROJECT SHEET #	STANDARD SHEET #
																	(LB / FT)				(LB / FT)								
																	1.88	2.42	3.35		7.60	9.00	10.80			14.60			
MIDDLETOWN SPRINGS NB							FY-FLUORESCENT YELLOW FYG-FLUORESCENT YELLOW GREEN															"SHSM"-STANDARD HIGHWAY SIGNS AND MARKINGS							
NB	5.463	A	W1-6L	48	24		LEFT LARGE ARROW				1		1		X								MOVE 50 FEET SOUTH.						
NB	5.478	B	W1-6R	48	24		RIGHT LARGE ARROW				1		1		X								MOVE 100 FEET NORTH						
NB	5.498	B	W1-6R	48	24		RIGHT LARGE ARROW					1				2		X					INSTALL 100 FEET NORTH OF EXISTING LOCATION.						
NB	5.520	A	VW-060	30	30		HIDDEN DRIVES						1		X														
NB	5.540	A	VW-060	30	30		HIDDEN DRIVES	6.25								1		X						INSTALL 100 FEET NORTH OF EXISTING LOCATION		7			
SIGN SUMMARY SHEET							SHEET TOTALS		6.25	0.00	0	2	1	3	0	0	3	45.0		0	0.0	0.0	0.0	0.0	PROJECT NAME: PAWLET - WEST RUTLAND				
									SF	SF	EA	EA	EA	EA	EA	EA	EA	FT		EA	LB	LB	LB	LB	PROJECT NUMBER: STPG SIGN(37)				
							VERMONT AGENCY OF TRANSPORTATION		TOWN DIRECTIONAL TOTALS		44.1	0.0	42	13	13	22	0	0	16	240.0		0	0.0		FILE NAME: 10C340 PLOT DATE: 5/6/2011				
																									PROJECT MANAGER: A. GAMBLE DRAWN BY: J. KELLY				
																					DESIGNED BY: J. KELLY CHECKED A. GAMBLE								
																					MIDDLETOWN SPRINGS NB SHEET 6 SHEET 35 OF 61								

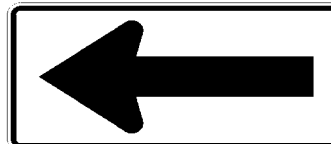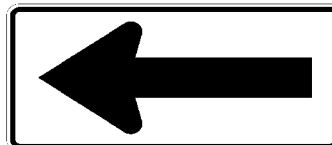DIRECTION	MILEPOINT	LOCATION CODE (SHEET 2)	SIGN CODE	WIDTH (IN)	HEIGHT (IN)	SHEETING REMARKS	SIGN LEGEND	NEW SIGNS		EXISTING SIGNS				EXIST POST		NUMBER OF NEW POSTS	SQUARE STEEL (IN)			TUBULAR STEEL Ø (IN)					SIGN FRAME REQUIRED	REMARKS	SIGN DETAIL LOCATION		
								"A"	"B"	RETAIN	SALVAGE FROM	SALVAGE TO	REMOVE	RETAIN	REMOVE		1.75	2.00	2.50	FOUNDATION	3.00	3.50	4.00	5.00			SHSM	PROJECT SHEET #	STANDARD SHEET #
																	(LB / FT)				(LB / FT)								
																	1.88	2.42	3.35		7.60	9.00	10.80	14.60					
MIDDLETOWN SPRINGS SB							FY-FLUORESCENT YELLOW FYG-FLUORESCENT YELLOW GREEN															"SHSM"-STANDARD HIGHWAY SIGNS AND MARKINGS							
SB	5.538	F	W1-1R	30	30		RIGHT TURN			1				X															
		F	W13-1	18	18		30 MPH ADVISORY			1																			
SB	5.293	F	W1-5R	30	30		RIGHT WINDING CURVES			1				X															
		F	W7-3A	24	18		NEXT 1 MILE			1																			
SB	5.194	F	W1-1L	30	30		LEFT TURN				1		1		X										MOVE 75 FEET SOUTH				
		F	W13-1	18	18		30 MPH ADVISORY				1		1																
		F	VD-700	6	10		5.20 MILE MARKER				1	1	1			1	X								REINSTALL 5.20 MILE MARKER ON NEW POST.				
SB	5.180	F	W1-1L	30	30		LEFT TURN					1				1		X							INSTALL 75 FEET SOUTH OF EXISTING				
		F	W13-1	18	18		30 MPH ADVISORY					1																	
SB	5.140	F	W1-6L	48	24								1		X										INSTALL LARGE ARROWS BACK TO BACK ON SEPARATE POSTS.				
		F	W1-6L	48	24			8.00								2		X								X			
		E	W1-6R	48	24			8.00								2		X								X			
SB	5.120	E	W1-6R	48	24								1		X														
		E	W1-6R	48	24			8.00								2		X							X				
SB	5.115	F	W1-6L	48	24			8.00								2		X							INSTALL BETWEEN UTILITY POLE AND NORTH EDGE OF DRIVE	X			
SIGN SUMMARY SHEET							SHEET TOTALS		32.00	0.00	4	3	3	5	0	0	10	150.0			0	0.0	0.0	0.0	0.0	PROJECT NAME: PAWLET - WEST RUTLAND			
									SF	SF	EA	EA	EA	EA	EA	EA	EA		FT		EA	LB	LB	LB	LB	PROJECT NUMBER: STPG SIGN(37)			
																										FILE NAME: 10C340			
							VERMONT AGENCY OF TRANSPORTATION																				PROJECT MANAGER: A. GAMBLE		
							TOWN DIRECTIONAL TOTALS		116.3	0.0	31	20	20	38	0	0	25	375.0			2	228.0				PLOT DATE: 5/6/2011			
																								DRAWN BY: J. KELLY					
																								CHECKED A. GAMBLE					
																								MIDDLETOWN SPRINGS SB SHEET 1					
																								SHEET 36 OF 61					

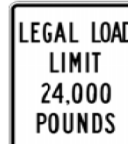DIRECTION	MILEPOINT	LOCATION CODE (SHEET 2)	SIGN CODE	WIDTH (IN)	HEIGHT (IN)	SHEETING REMARKS	SIGN LEGEND	NEW SIGNS		EXISTING SIGNS				EXIST POST		NUMBER OF NEW POSTS	SQUARE STEEL (IN)			TUBULAR STEEL Ø (IN)					SIGN FRAME REQUIRED	REMARKS	SIGN DETAIL LOCATION		
								"A"	"B"	RETAIN	SALVAGE FROM	SALVAGE TO	REMOVE	RETAIN	REMOVE		1.75	2.00	2.50	FOUNDATION	3.00	3.50	4.00	5.00			SHSM	PROJECT SHEET #	STANDARD SHEET #
																	(LB / FT)				(LB / FT)								
																	1.88	2.42	3.35		7.60	9.00	10.80	14.60					
MIDDLETOWN SPRINGS SB							FY-FLUORESCENT YELLOW FYG-FLUORESCENT YELLOW GREEN															"SHSM"-STANDARD HIGHWAY SIGNS AND MARKINGS							
SB	5.080	F	W1-6L	48	24		• NOT THERE - NO REMOVAL LEFT LARGE ARROW							X									REMOVE DAMAGED SIGN DEBRIS FROM SOUTH SIDE OF DRIVE.						
SB	5.000	G	VR-017	24	30									X									HALEY RD. (TH-10)						
		G	VR-017	24	30			5.00							1		X							6					
		G		24	24			TOWN'S DEAD END SIGN				1	1	1		1		X					INSTALL 50 FEET NORTHERLY ON TOWN HIGHWAY AND ON SEPARATE POST.						
SB	4.988	H	R1-1	30	30		STOP				1	1	1		X	1		X					HALEY RD. (TH-10) REINSTALL SIGN ON NEW POST.						
SB	4.620	F	W1-6L	48	24		LEFT LARGE ARROW					1				2		X					INSTALL 75 FEET NORTH OF EXISTING LARGE ARROW						
SB	4.605	F	W1-6L	48	24		LEFT LARGE ARROW				1		1		X								RELOCATE 75 FEET NORTH.						
SB	4.603	E	W1-6R	48	24		RIGHT LARGE ARROW			1				X															
SB	4.600	G	VR-017	24	30									2 +		X							DUDLEY RD. (TH-9)						
		G	VR-017	24	30			5.00								1		X						6					
		G	R2-1					TOWN'S SPEED LIMIT SIGN				1	1	1									REINSTALL BELOW NEW LEGAL LOAD SIGN.						
SB	4.593	H	R1-1	30	30		STOP				1	1	1		X	1		X					DUDLEY RD. (TH-9) REINSTALL SIGN ON NEW POST BEFORE MAILBOXES AND LARGE TREE.						
SB	4.355	F	R2-1	24	30		SPEED LIMIT 40			1				X															
SB	4.299	F	VD-018	30	18		VILLAGE SIGN				1	1	1		X	1		X					REINSTALL SIGN ON NEW POST.						
SB	4.171	F	R2-1	24	30		SPEED LIMIT 35				1			X															
SIGN SUMMARY SHEET							SHEET TOTALS	10.00	0.00	3	6	6	9	0	0	8	120.0			0	0.0	0.0	0.0	0.0	PROJECT NAME: PAWLET - WEST RUTLAND				
								SF	SF	EA	EA	EA	EA	EA	EA	EA		FT		EA	LB	LB	LB	LB	PROJECT NUMBER: STPG SIGN(37)				
							VERMONT AGENCY OF TRANSPORTATION	TOWN DIRECTIONAL TOTALS	116.3	0.0	31	20	20	38	0	0	25	375.0			2	228.0				FILE NAME: 10C340 PROJECT MANAGER: A. GAMBLE DESIGNED BY: J. KELLY MIDDLETOWN SPRINGS SB SHEET 2			PLOT DATE: 5/6/2011 DRAWN BY: J. KELLY CHECKED A. GAMBLE SHEET 37 OF 61

DIRECTION	MILEPOINT	LOCATION CODE (SHEET 2)	SIGN CODE	WIDTH (IN)	HEIGHT (IN)	SHEETING REMARKS	SIGN LEGEND	NEW SIGNS		EXISTING SIGNS				EXIST POST		NUMBER OF NEW POSTS	SQUARE STEEL (IN)			TUBULAR STEEL Ø (IN)				SIGN FRAME REQUIRED	REMARKS	SIGN DETAIL LOCATION			
								"A"	"B"	RETAIN	SALVAGE FROM	SALVAGE TO	REMOVE	RETAIN	REMOVE		1.75	2.00	2.50	FOUNDATION	3.00	3.50	4.00			5.00	SHSM	PROJECT SHEET #	STANDARD SHEET #
																	(LB / FT)				(LB / FT)								
																	1.88	2.42	3.35		7.60	9.00	10.80			14.60			
MIDDLETOWN SPRINGS SB							FY-FLUORESCENT YELLOW FYG-FLUORESCENT YELLOW GREEN															"SHSM"-STANDARD HIGHWAY SIGNS AND MARKINGS							
SB	4.057	F	M2-1	21	15		JCT			1				X															
		F	M3-4	24	12		WEST			1																			
		F	M1-5A	30	24		ROUTE 140			1																			
SB	3.956	F	W3-1	36	36		STOP AHEAD			1				X															
SB	3.929	F	VD1-1A	72	12		↑ Poultney 8	6.00											2	228.0					INSTALL NEW ON TWO POSTS ABOVE ROUTE MARKERS.		5		
		F	VD1-1A	72	12		↶ Pawlet 11	6.00																		5			
		F	M3-3	24	12		SOUTH				1	1	1		X								#2B	REMOVE POSTS. REINSTALL ROUTE MARKERS ON NEW FRAME.		8			
		F	M1-5	24	24		VERMONT 133				1	1	1																
		F	M5-1	21	15		<--- LEFT (90 DEG)				1	1	1																
		F	M3-4	24	12		WEST				1	1	1																
		F	M1-6	30	24		ROUTE 140				1	1	1																
		F	M6-3	21	15		^UP ARROW				1	1	1																
SB	3.899	G	VR-017	24	30		LL 24K			1				X											PARK AVE. (TH-22)				
SB	3.903	H	R1-1	30	30		STOP			1				X											PARK AVE. (TH-22)				
SB	3.870	F	R1-1	30	30								1	X											ROUTE 140 (TH-1) & NORTH ST. (TH-6)				
SIGN SUMMARY SHEET							SHEET TOTALS		12.00	0.00	6	6	6	7	0	0	0	0.0			2	228.0	0.0	0.0	0.0	PROJECT NAME: PAWLET - WEST RUTLAND			
									SF	SF	EA	EA	EA	EA	EA	EA	EA	FT			EA	LB	LB	LB	LB	PROJECT NUMBER: STPG SIGN(37)			
							VERMONT AGENCY OF TRANSPORTATION		TOWN DIRECTIONAL TOTALS		116.3	0.0	31	20	20	38	0	0	25	375.0			2	228.0				FILE NAME: 10C340 PROJECT MANAGER: A. GAMBLE DESIGNED BY: J. KELLY MIDDLETOWN SPRINGS SB SHEET 3	

DIRECTION	MILEPOINT	LOCATION CODE (SHEET 2)	SIGN CODE	WIDTH (IN)	HEIGHT (IN)	SHEETING REMARKS	SIGN LEGEND	NEW SIGNS		EXISTING SIGNS				EXIST POST		NUMBER OF NEW POSTS	SQUARE STEEL (IN)			TUBULAR STEEL Ø (IN)				SIGN FRAME REQUIRED	REMARKS	SIGN DETAIL LOCATION			
								"A"	"B"	RETAIN	SALVAGE FROM	SALVAGE TO	REMOVE	RETAIN	REMOVE		1.75	2.00	2.50	FOUNDATION	3.00	3.50	4.00			5.00	SHSM	PROJECT SHEET #	STANDARD SHEET #
																	(LB / FT)				(LB / FT)								
																	1.88	2.42	3.35		7.60	9.00	10.80			14.60			
MIDDLETOWN SPRINGS SB							FY-FLUORESCENT YELLOW FYG-FLUORESCENT YELLOW GREEN															"SHSM"-STANDARD HIGHWAY SIGNS AND MARKINGS							
		F	R1-1	30	30			6.25															INSTALL NEW SIGNS ON EXISTING POST.	X					
		F	R1-3	12	6		4-WAY						1																
		F	R1-3P	18	6			0.75																X					
SB	3.860	G	VR-017	24	30								1		X									NORTH ST. (TH-6)					
		G	VR-017	24	30			5.00								1		X								6			
SB	3.860	H	R1-1	30	30								1	X										NORTH ST. (TH-6)					
		H	R1-1	30	30			6.25																INSTALL NEW SIGNS ON EXISTING POST.	X				
		H	R1-3	12	6		4-WAY MISSING						+																
		F	R1-3P	18	6			0.75																	X				
SB	3.860	G	VR-079	24	30								1		X									ROUTE 140 (TH-1)					
		G	VR-079	24	30			5.00								1		X								6			
		G	M3-4	24	12		WEST				1		1											RELOCATE B/W ROUTE MARKERS 50 FT WESTERLY ON ROUTE 140.					
		G	M1-6	30	24		ROUTE 140				1		1																
SB	3.860	G	M3-4	24	12		WEST					1				1		X						RELOCATE B/W ROUTE MARKERS 50 FT WESTERLY ON ROUTE 140.					
		G	M1-6	30	24		ROUTE 140					1																	
SIGN SUMMARY SHEET							SHEET TOTALS		24.00	0.00	0	2	2	67	0	0	3	45.0			0	0.0	0.0	0.0	0.0	PROJECT NAME: PAWLET - WEST RUTLAND			
									SF	SF	EA	EA	EA	EA	EA	EA	EA		FT		EA	LB	LB	LB	LB	PROJECT NUMBER: STPG SIGN(37)			
																										FILE NAME: 10C340			
																											DRAWN BY: J. KELLY		
VERMONT AGENCY OF TRANSPORTATION							TOWN DIRECTIONAL TOTALS		116.3	0.0	31	20	20	38	0	0	25	375.0			2	228.0				DESIGNED BY: J. KELLY			
																							MIDDLETOWN SPRINGS SB SHEET 4						
																							PLOT DATE: 5/6/2011						
																							CHECKED A. GAMBLE						
																							SHEET 39 OF 61						

DIRECTION	MILEPOINT	LOCATION CODE (SHEET 2)	SIGN CODE	WIDTH (IN)	HEIGHT (IN)	SHEETING REMARKS	SIGN LEGEND	NEW SIGNS		EXISTING SIGNS				EXIST POST		NUMBER OF NEW POSTS	SQUARE STEEL (IN)			TUBULAR STEEL Ø (IN)				SIGN FRAME REQUIRED	REMARKS	SIGN DETAIL LOCATION			
								"A"	"B"	RETAIN	SALVAGE FROM	SALVAGE TO	REMOVE	RETAIN	REMOVE		1.75	2.00	2.50	FOUNDATION	3.00	3.50	4.00			5.00	SHSM	PROJECT SHEET #	STANDARD SHEET #
																	(LB / FT)				(LB / FT)								
																	1.88	2.42	3.35		7.60	9.00	10.80			14.60			
MIDDLETOWN SPRINGS SB							FY-FLUORESCENT YELLOW FYG-FLUORESCENT YELLOW GREEN															"SHSM"-STANDARD HIGHWAY SIGNS AND MARKINGS							
SB	3.860	H	R1-1	30	30								1	X										ROUTE 140 (TH-1)					
		H	R1-1	30	30			6.25																INSTALL NEW SIGNS ON EXISTING POST.	X				
		H	R1-3	12	6			4-WAY						1															
		H	R1-3P	18	6				0.75																	X			
SB	3.844	F	M3-3	24	12		SOUTH			1				X															
		F	M1-5	30	24		VERMONT 133			1																			
SB	3.835	F	S1-1	30	30		SCHOOL			1				X															
		F	W16-9	24	12		AHEAD			1																			
SB	3.790	F	S1-1	30	30		SCHOOL			1				X															
		F	W16-7	24	12		DIAGONAL ARROW			1																			
SB	3.785	G	VR-017	24	30								1	X										SCHOOL HOUSE RD. (TH-23)	THINNING AND TRIMMING				
		G	VR-017	24	30			5.00																INSTALL NEW SIGN ON EXISTING POST.		6			
SB	3.780	H	R1-1	30	30		STOP			1				X										SCHOOL HOUSE RD. (TH-23)					
SB	3.740	F	VR-020	24	30								1	X															
		F	VR-020	24	30			5.00																INSTALL NEW SIGN ON EXISTING POST.		6			
SIGN SUMMARY SHEET							SHEET TOTALS	17.00	0.00	7	0	0	4	0	0	0	0.0			0	0.0	0.0	0.0	0.0	PROJECT NAME: PAWLET - WEST RUTLAND				
								SF	SF	EA	EA	EA	EA	EA	EA	EA		FT		EA	LB	LB	LB	LB	PROJECT NUMBER: STPG SIGN(37)				
																											FILE NAME: 10C340		
							VERMONT AGENCY OF TRANSPORTATION																					PROJECT MANAGER: A. GAMBLE	
							TOWN DIRECTIONAL TOTALS	116.3	0.0	31	20	20	38	0	0	25	375.0			2	228.0				PLOT DATE: 5/6/2011				
																							DRAWN BY: J. KELLY						
																							CHECKED A. GAMBLE						
																							SHEET 40 OF 61						


DIRECTION	MILEPOINT	LOCATION CODE (SHEET 2)	SIGN CODE	WIDTH (IN)	HEIGHT (IN)	SHEETING REMARKS	SIGN LEGEND	NEW SIGNS		EXISTING SIGNS				EXIST POST		NUMBER OF NEW POSTS	SQUARE STEEL (IN)			TUBULAR STEEL Ø (IN)					SIGN FRAME REQUIRED	REMARKS	SIGN DETAIL LOCATION		
								"A"	"B"	RETAIN	SALVAGE FROM	SALVAGE TO	REMOVE	RETAIN	REMOVE		1.75	2.00	2.50	FOUNDATION	3.00	3.50	4.00	5.00			SHSM	PROJECT SHEET #	STANDARD SHEET #
																	(LB / FT)				(LB / FT)								
																	1.88	2.42	3.35		7.60	9.00	10.80	14.60					
MIDDLETOWN SPRINGS SB							FY-FLUORESCENT YELLOW FYG-FLUORESCENT YELLOW GREEN															"SHSM"-STANDARD HIGHWAY SIGNS AND MARKINGS							
SB	3.499	F	R2-1	24	30		SPEED LIMIT 35			1				X															
SB	3.346	G	VR-017	24	30								1		X										BUXTON AVE. (TH-27)				
		G	VR-017	24	30		LEGAL LOAD LIMIT 24,000 POUNDS	5.00								1		X								6			
SB	3.340	H	R1-1	30	30		STOP			1				X											BUXTON AVE. (TH-27)				
SB	3.315	F	R2-1	24	30		SPEED LIMIT 35			1				X															
SB	3.255	G	VR-017	24	30		THINNING AND TRIMMING						1	X											COY HILL RD. (TH-4)	THINNING AND TRIMMING			
		G	VR-017	24	30		LEGAL LOAD LIMIT 24,000 POUNDS	5.00																		INSTALL NEW SIGN ON EXISTING POST.	6		
SB	3.250	H	R1-1	30	30		STOP			1				X											COY HILL RD. (TH-4)				
SB	3.111	F	R2-1	24	30		SPEED LIMIT 40			1				X															
SB	2.906	F	R2-1	24	30		SPEED LIMIT 50			1				X															
SB	2.272	F	W1-10L	30	30		MODIFIED LEFT CURVE			1				X															
SB	2.187	G	VR-017	24	30								1	X											GARRON RD. (TH-21)				
		G	VR-017	24	30		LEGAL LOAD LIMIT 24,000 POUNDS	5.00																		INSTALL NEW SIGN ON EXISTING POST.	6		
SB	2.183	H	R1-1	30	30		STOP			1				X											GARRON RD. (TH-21)				
SB	1.693	F	W11-5	30	30																				SIGN AND POST ARE MISSING.				
SIGN SUMMARY SHEET							SHEET TOTALS		15.00	0.00	8	0	0	3	0	0	1	15.0			0	0.0	0.0	0.0	0.0	PROJECT NAME: PAWLET - WEST RUTLAND			
									SF	SF	EA	EA	EA	EA	EA	EA	EA		FT		EA	LB	LB	LB	LB	PROJECT NUMBER: STPG SIGN(37)			
																										FILE NAME: 10C340			
							VERMONT AGENCY OF TRANSPORTATION																				PROJECT MANAGER: A. GAMBLE		
							TOWN DIRECTIONAL TOTALS		116.3	0.0	31	20	20	38	0	0	25	375.0			2	228.0				DESIGNED BY: J. KELLY			
																								PLOT DATE: 5/6/2011					
																								DRAWN BY: J. KELLY					
																								CHECKED A. GAMBLE					
																								SHEET 41 OF 61					

DIRECTION	MILEPOINT	LOCATION CODE (SHEET 2)	SIGN CODE	WIDTH (IN)	HEIGHT (IN)	SHEETING REMARKS	SIGN LEGEND	NEW SIGNS		EXISTING SIGNS				EXIST POST		NUMBER OF NEW POSTS	SQUARE STEEL (IN)			TUBULAR STEEL Ø (IN)					SIGN FRAME REQUIRED	REMARKS	SIGN DETAIL LOCATION		
								"A"	"B"	RETAIN	SALVAGE FROM	SALVAGE TO	REMOVE	RETAIN	REMOVE		1.75	2.00	2.50	FOUNDATION	3.00	3.50	4.00	5.00			SHSM	PROJECT SHEET #	STANDARD SHEET #
																	(LB / FT)				(LB / FT)								
																	1.88	2.42	3.35		7.60	9.00	10.80	14.60					
MIDDLETOWN SPRINGS SB							FY-FLUORESCENT YELLOW FYG-FLUORESCENT YELLOW GREEN															"SHSM"-STANDARD HIGHWAY SIGNS AND MARKINGS							
		F	W11-5	30	30			6.25							1		X							INSTALL 200 FEET NORTH OF POLE # 342/10T/7/46.	X				
SB	1.380	F	W11-7	30	30		EQUESTRIAN				1	1	1		X	1		X						REINSTALL SIGN ON NEW POST.					
SB	1.303	F	W1-4R	30	30		RIGHT REVERSE CURVE			1				X															
SB	0.706	F	W1-2L	30	30		LEFT CURVE				1		1		X									RELOCATE SIGN ASSEMBLY 300 FEET SOUTH					
		F	W13-1	18	18		40 MPH ADVISORY				1		1																
SB	0.649	F	W1-2L	30	30		LEFT CURVE					1				1		X						INSTALL SIGN ASSEMBLY 300 FEET SOUTH OF EXISTING.					
		F	W13-1	18	18		40 MPH ADVISORY					1																	
SB	0.615	F	W1-6L	48	24		LEFT LARGE ARROW			1				X															
		E	W1-6R	48	24		RIGHT LARGE ARROW			1																			
SIGN SUMMARY SHEET							SHEET TOTALS	6.25	0.00	3	3	3	3	0	0	3	45.0			0	0.0	0.0	0.0	0.0	PROJECT NAME: PAWLET - WEST RUTLAND				
								SF	SF	EA	EA	EA	EA	EA	EA	EA		FT		EA	LB	LB	LB	LB	PROJECT NUMBER: STPG SIGN(37)				
																									FILE NAME: 10C340				
							VERMONT AGENCY OF TRANSPORTATION	TOWN DIRECTIONAL TOTALS	116.3	0.0	31	20	20	38	0	0	25	375.0			2	228.0				PROJECT MANAGER: A. GAMBLE			
																							DESIGNED BY: J. KELLY			PLOT DATE: 5/6/2011			
																								MIDDLETOWN SPRINGS SB SHEET 7			DRAWN BY: J. KELLY		
																								SHEET 42 OF 61			CHECKED A. GAMBLE		

DIRECTION	MILEPOINT	LOCATION CODE (SHEET 2)	SIGN CODE	WIDTH (IN)	HEIGHT (IN)	SHEETING REMARKS	SIGN LEGEND	NEW SIGNS		EXISTING SIGNS				EXIST POST		NUMBER OF NEW POSTS	SQUARE STEEL (IN)			TUBULAR STEEL Ø (IN)					SIGN FRAME REQUIRED	REMARKS	SIGN DETAIL LOCATION												
								"A"	"B"	RETAIN	SALVAGE FROM	SALVAGE TO	REMOVE	RETAIN	REMOVE		1.75	2.00	2.50	FOUNDATION	3.00	3.50	4.00	5.00			SHSM	PROJECT SHEET #	STANDARD SHEET #										
																	(LB / FT)				(LB / FT)																		
																	1.88	2.42	3.35		7.60	9.00	10.80	14.60															
TINMOUTH NB																							"SHSM"-STANDARD HIGHWAY SIGNS AND MARKINGS																
NB	2.150	C	VD-024	54	7.5								1		X																								
		C	VD-024	72	10		Tinmouth Middletown Springs	5.00								2		X									4												
		C	VD-700	6	10		13301124 13301111	0.42																INSTALL ON LH POST BELOW TINMOUTH. LEAVE BOTTOM SET OF NUMBERS BLANK.				E-138											
		C	VD-700	6	10			0.42															INSTALL ON RH POST BELOW MIDDLETOWN SPRINGS. LEAVE BOTTOM SET OF NUMBERS BLANK.				E-138												
NB	2.171	A	M2-1	21	15		JCT			1				X																									
		A	M3-2	24	12		EAST			1																													
		A	M1-6	30	24		ROUTE 140			1																													
NB	2.240	A	D1-1A	72	12		<--- (45 DEG) IRA 5			1				X																									
		A	D1-1A	72	12		<--- (45 DEG) WEST RUTLAND 9			1																													
		A	D1-1A	72	12		TINMOUTH 3 --->			1																													
		A	D1-1A	72	12		WALLINGFORD 9 ---->			1																													
NB	2.275	A	M3-1	24	12		NORTH				1	1	1		X	2		X						REMOVE AND SALVAGE SIGNS AND FRAME. INSTALL ON NEW POSTS.															
		A	M1-5	30	24		VERMONT 133				1	1	1																										
		A	M6-2	21	15		<--- LEFT (45 DEG)				1	1	1																										
		A	M3-2	24	12		EAST				1	1	1																										
SIGN SUMMARY SHEET							SHEET TOTALS		5.84	0.00	7	4	4	5	0	0	4	60.0			0	0.0	0.0	0.0	0.0	PROJECT NAME: PAWLET - WEST RUTLAND													
									SF	SF	EA	EA	EA	EA	EA	EA	EA		FT		EA	LB	LB	LB	LB	LB	PROJECT NUMBER: STPG SIGN(37)												
																									FILE NAME: 10C340			PLOT DATE: 5/6/2011											
							VERMONT AGENCY OF TRANSPORTATION		TOWN DIRECTIONAL TOTALS											35.1					0.0	11	6	6	10	0	0	8	120.0			0	0.0		
																								DESIGNED BY: J. KELLY			CHECKED A. GAMBLE												
																								TINMOUTH NB SHEET 1			SHEET 43 OF 61												



DIRECTION	MILEPOINT	LOCATION CODE (SHEET 2)	SIGN CODE	WIDTH (IN)	HEIGHT (IN)	SHEETING REMARKS	SIGN LEGEND	NEW SIGNS		EXISTING SIGNS				EXIST POST		NUMBER OF NEW POSTS	SQUARE STEEL (IN)			TUBULAR STEEL Ø (IN)				SIGN FRAME REQUIRED	REMARKS	SIGN DETAIL LOCATION										
								"A"	"B"	RETAIN	SALVAGE FROM	SALVAGE TO	REMOVE	RETAIN	REMOVE		1.75	2.00	2.50	FOUNDATION	3.00	3.50	4.00			5.00	SHSM	PROJECT SHEET #	STANDARD SHEET #							
																	(LB / FT)				(LB / FT)															
																	1.88	2.42	3.35		7.60	9.00	10.80			14.60										
TINMOUTH NB						FY-FLUORESCENT YELLOW FYG-FLUORESCENT YELLOW GREEN																"SHSM"-STANDARD HIGHWAY SIGNS AND MARKINGS														
		A	M1-6	30	24		ROUTE 140				1	1	1																							
		A	M6-1	21	15		RIGHT ---->				1	1	1																							
NB	2.278	C	VR-017	24	30								1	X									ROUTE 140 (CLASS 2)													
		C	VR-017	24	30			5.00															INSTALL NEW SIGN ON EXISTING POST.		6											
NB	2.290	D	R1-1	30	30								1	X									ROUTE 140 (CLASS 2)													
		D	R1-1	30	30			6.25															INSTALL NEW SIGN ON EXISTING POST.	X												
NB	2.313	A	M3-1	24	12		NORTH			1				X																						
		A	M1-5	30	24		VERMONT 133			1																										
NB	2.331	A	R2-1	24	30		SPEED LIMIT 50			1				X																						
NB	2.415	A	S3-1	36	36	FYG		9.00								2		X					INSTALL 450 FEET NORTH OF EXISTING SL 50 SIGN AND NORTH OF FIELD ACCESS.	X												
NB	2.860	A	W11-7	30	30			EQUESTRIAN			1				X																					
NB	2.920	A	VW-407A	30	30		SCHOOL BUS ENTERING						1		X																					
		A	VS3-4	36	36	FYG		9.00								2		X							7											
SIGN SUMMARY SHEET							SHEET TOTALS	29.25	0.00	4	2	2	5	0	0	4	60.0			0	0.0	0.0	0.0	0.0	PROJECT NAME: PAWLET - WEST RUTLAND											
								SF	SF	EA	EA	EA	EA	EA	EA	EA		FT		EA	LB	LB	LB	LB	PROJECT NUMBER: STPG SIGN(37)											
							VERMONT AGENCY OF TRANSPORTATION			TOWN DIRECTIONAL TOTALS				35.1	0.0	11	6	6	10	0	0	8	120.0			0	0.0				FILE NAME: 10C340 PROJECT MANAGER: A. GAMBLE DESIGNED BY: J. KELLY TINMOUTH NB SHEET 2			PLOT DATE: 5/6/2011 DRAWN BY: J. KELLY CHECKED A. GAMBLE SHEET 44 OF 61		


DIRECTION	MILEPOINT	LOCATION CODE (SHEET 2)	SIGN CODE	WIDTH (IN)	HEIGHT (IN)	SHEETING REMARKS	SIGN LEGEND	NEW SIGNS		EXISTING SIGNS				EXIST POST		NUMBER OF NEW POSTS	SQUARE STEEL (IN)			TUBULAR STEEL Ø (IN)					SIGN FRAME REQUIRED	REMARKS	SIGN DETAIL LOCATION		
								"A"	"B"	RETAIN	SALVAGE FROM	SALVAGE TO	REMOVE	RETAIN	REMOVE		1.75	2.00	2.50	FOUNDATION	3.00	3.50	4.00	5.00			SHSM	PROJECT SHEET #	STANDARD SHEET #
																	(LB / FT)				(LB / FT)								
																	1.88	2.42	3.35		7.60	9.00	10.80	14.60					
TINMOUTH SB							FY-FLUORESCENT YELLOW FYG-FLUORESCENT YELLOW GREEN																"SHSM"-STANDARD HIGHWAY SIGNS AND MARKINGS						
SB	3.150	F	VW-054R	30	30								1	X										THINNING AND TRIMMING					
		F	VW-054R	30	30			6.25																INSTALL NEW SIGN ON EXISTING POST.		7			
SB	3.130	F	VW-407A	30	30		THINNING AND TRIMMING SCHOOL BUS ENTERING						1		X									THINNING AND TRIMMING					
		F	VS3-4	36	36	FYG		9.00								2		X								7			
SB	2.600	F	S3-1	36	36	FYG		9.00								2		X						INSTALL 500 FEET NORTH OF DRIVE #74, AT 2.60 MILE MARKER.	X				
SB	3.089	F	W11-7	30	30		EQUESTRIAN				1	1	1		X	1		X						REINSTALL SIGN ON NEW POST.					
SB	2.480	F	W3-5	36	36		SPEED REDUCTION 40			1				X															
SB	2.435	F	M2-1	21	15		JCT				1	1	1		X	1		X						REINSTALL SIGNS ON NEW POST.					
		F	M3-2	24	12		EAST				1	1	1																
		F	M1-6	30	24		ROUTE 140				1	1	1																
SB	2.397	F	W1-10R	30	30		MODIFIED RIGHT CURVE			1				X															
SB	2.450	G	VR-023B	24	30		• NOT THERE - NO REMOVAL \$500 FINE FOR THROWING TRASH						+		X														
SB	2.359	F	D1-1A	72	12		<--- TINMOUTH 3			1				X															
		F	D1-1A	72	12		<--- WALLINGFORD 9			1																			
		F	D1-1A	72	12		MIDDLETOWN SPRINGS 2 ----> (45 DEG)			1																			
SIGN SUMMARY SHEET						SHEET TOTALS		24.25	0.00	5	4	4	6	0	0	6	90.0			0	0.0	0.0	0.0	0.0	PROJECT NAME: PAWLET - WEST RUTLAND				
								SF	SF	EA	EA	EA	EA	EA	EA	EA		FT		EA	LB	LB	LB	LB	PROJECT NUMBER: STPG SIGN(37)				
						VERMONT AGENCY OF TRANSPORTATION		TOWN DIRECTIONAL TOTALS		32.3	0.0	22	4	4	8	0	0	8	120.0			0	0.0				FILE NAME: 10C340 PROJECT MANAGER: A. GAMBLE DESIGNED BY: J. KELLY TINMOUTH SB SHEET 1		

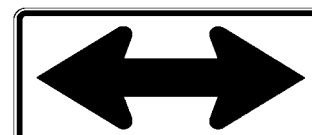
DIRECTION	MILEPOINT	LOCATION CODE (SHEET 2)	SIGN CODE	WIDTH (IN)	HEIGHT (IN)	SHEETING REMARKS	SIGN LEGEND	NEW SIGNS		EXISTING SIGNS				EXIST POST		NUMBER OF NEW POSTS	SQUARE STEEL (IN)			TUBULAR STEEL Ø (IN)				SIGN FRAME REQUIRED	REMARKS	SIGN DETAIL LOCATION				
								"A"	"B"	RETAIN	SALVAGE FROM	SALVAGE TO	REMOVE	RETAIN	REMOVE		1.75	2.00	2.50	FOUNDATION	3.00	3.50	4.00			5.00	SHSM	PROJECT SHEET #	STANDARD SHEET #	
																	(LB / FT)				(LB / FT)									
																	1.88	2.42	3.35		7.60	9.00	10.80			14.60				
TINMOUTH SB						FY-FLUORESCENT YELLOW FYG-FLUORESCENT YELLOW GREEN																"SHSM"-STANDARD HIGHWAY SIGNS AND MARKINGS								
		F	D1-1A	72	12		PAWLET 14 ----> (45 DEG)			1																				
SB	2.313	F	M3-2	24	12		EAST			1				X																
		F	M1-6	30	24		ROUTE 140			1																				
		F	M6-1	21	15		<--- LEFT			1																				
		F	M3-3	24	12		SOUTH			1																				
		F	M1-5	30	24		VERMONT 133			1																				
		F	M6-2	21	15		RIGHT ----> (45 DEG)			1																				
		F	M4-5	24	12		TO			1																				
		F	M3-4	24	12		WEST			1																				
		F	M1-6	24	24		ROUTE 140			1																				
		F	M6-2	21	15		RIGHT ----> (45 DEG)			1																				
SB	2.290	G	W1-7	48	24							1		X																
		G	W1-7	48	24			8.00							2		X								X					
SB	2.268	F	M3-3	24	12		SOUTH			1				X																
		F	M1-5	30	24		VERMONT 133			1																				
SIGN SUMMARY SHEET						SHEET TOTALS		8.00	0.00	13	0	0	1	0	0	2	30.0	0	0.0	0.0	0.0	0.0	PROJECT NAME: PAWLET - WEST RUTLAND							
								SF	SF	EA	EA	EA	EA	EA	EA	EA	FT	EA	LB	LB	LB	LB	PROJECT NUMBER: STPG SIGN(37)							
																							FILE NAME: 10C340			PLOT DATE: 5/6/2011				
						VERMONT AGENCY OF TRANSPORTATION		TOWN DIRECTIONAL TOTALS										32.3	0.0	22	4	4	8	0	0	8	120.0	0	0.0	





DIRECTION		MILEPOINT	LOCATION CODE (SHEET 2)	SIGN CODE	WIDTH (IN)	HEIGHT (IN)	SHEETING REMARKS	SIGN LEGEND	NEW SIGNS		EXISTING SIGNS				EXIST POST		NUMBER OF NEW POSTS	SQUARE STEEL (IN)			TUBULAR STEEL Ø (IN)				SIGN FRAME REQUIRED	REMARKS	SIGN DETAIL LOCATION						
									"A"	"B"	RETAIN	SALVAGE FROM	SALVAGE TO	REMOVE	RETAIN	REMOVE		1.75	2.00	2.50	FOUNDATION	3.00	3.50	4.00			5.00	SHSM	PROJECT SHEET #	STANDARD SHEET #			
																		(LB / FT)				(LB / FT)											
																		1.88	2.42	3.35		7.60	9.00	10.80			14.60						
TINMOUTH SB							FY-FLUORESCENT YELLOW FYG-FLUORESCENT YELLOW GREEN															"SHSM"-STANDARD HIGHWAY SIGNS AND MARKINGS											
			F	M4-5	21	12		TO			1																						
			F	M3-4	24	12		WEST			1																						
			F	M1-6	30	24		ROUTE 140			1																						
SB	2.249		F	R2-1	24	30		SPEED LIMIT 40			1			X																			
SIGN SUMMARY SHEET								SHEET TOTALS		0.00	0.00	4	0	0	0	0	0	0	0.0			0	0.0	0.0	0.0	0.0	PROJECT NAME: PAWLET - WEST RUTLAND						
										SF	SF	EA	EA	EA	EA	EA	EA	EA	FT			EA	LB	LB	LB	LB	PROJECT NUMBER: STPG SIGN(37)						
																										FILE NAME: 10C340			PLOT DATE: 5/6/2011				
								VERMONT AGENCY OF TRANSPORTATION		TOWN DIRECTIONAL TOTALS										32.3	0.0	22	4	4	8	0	0	8	120.0			0	0.0


DIRECTION	MILEPOINT	LOCATION CODE (SHEET 2)	SIGN CODE	WIDTH (IN)	HEIGHT (IN)	SHEETING REMARKS	SIGN LEGEND	NEW SIGNS		EXISTING SIGNS				EXIST POST		NUMBER OF NEW POSTS	SQUARE STEEL (IN)			TUBULAR STEEL Ø (IN)					SIGN FRAME REQUIRED	REMARKS	SIGN DETAIL LOCATION		
								"A"	"B"	RETAIN	SALVAGE FROM	SALVAGE TO	REMOVE	RETAIN	REMOVE		1.75	2.00	2.50	FOUNDATION	3.00	3.50	4.00	5.00			SHSM	PROJECT SHEET #	STANDARD SHEET #
																	(LB / FT)				(LB / FT)								
																	1.88	2.42	3.35		7.60	9.00	10.80	14.60					
IRA NB							FY-FLUORESCENT YELLOW FYG-FLUORESCENT YELLOW GREEN																"SHSM"-STANDARD HIGHWAY SIGNS AND MARKINGS						
NB	0.000	C	VD-024	60	7.5		Ira Tinmouth					1		X															
		C	VD-024	72	10			5.00							2		X									4			
		C	VD-700	6	10		1330 1109 0000 1330 1124	0.42																INSTALL ON LEFT POST BELOW IRA.			E-138		
		C	VD-700	6	10			0.42															INSTALL ON RIGHT POST BELOW TINMOUTH. LEAVE BOTTOM SET OF NUMBERS BLANK.			E-138			
NB	0.260	A	W1-2R	30	30		THINNING AND TRIMMING RIGHT CURVE				1		1		X									MOVE 370 FEET NORTH.					
NB	0.330	A	W1-2R	30	30		RIGHT CURVE					1			1		X						INSTALL 370 FEET NORTH OF EXISTING AND AT EDGE OF MOWED LAWN.	X					
NB	1.405	A	S3-1	36	36	FYG																							

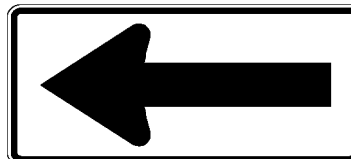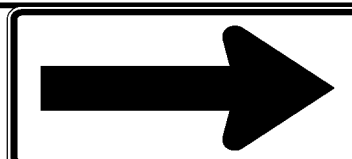DIRECTION	MILEPOINT	LOCATION CODE (SHEET 2)	SIGN CODE	WIDTH (IN)	HEIGHT (IN)	SHEETING REMARKS	SIGN LEGEND	NEW SIGNS		EXISTING SIGNS				EXIST POST		NUMBER OF NEW POSTS	SQUARE STEEL (IN)			TUBULAR STEEL Ø (IN)					SIGN FRAME REQUIRED	REMARKS	SIGN DETAIL LOCATION			
								"A"	"B"	RETAIN	SALVAGE FROM	SALVAGE TO	REMOVE	RETAIN	REMOVE		1.75	2.00	2.50	FOUNDATION	3.00	3.50	4.00	5.00			SHSM	PROJECT SHEET #	STANDARD SHEET #	
																	(LB / FT)				(LB / FT)									
																	1.88	2.42	3.35		7.60	9.00	10.80	14.60						
IRA NB							FY-FLUORESCENT YELLOW FYG-FLUORESCENT YELLOW GREEN																"SHSM"-STANDARD HIGHWAY SIGNS AND MARKINGS							
NB	3.208	A	W11-4H	30	30		HINGED CATTLE CROSSING			1				X																
NB	3.254	A	W1-2L	30	30		LEFT CURVE				1		1		X									MOVE 400 FEET NORTH.						
NB	3.330	A	W1-2L	30	30		LEFT CURVE					1			1	X								INSTALL 400 FEET NORTH OF EXISTING AND ACROSS FROM UTILITY POLE #68/25/90.						
NB	3.360	A	W1-8L	18	24		LEFT CHEVRON						1		X															
NB	3.365	B	W1-8R	18	24		RIGHT CHEVRON						1		X															
NB	3.385	A	W1-6L	48	24			8.00								2	X							INSTALL 50 FEET NORTH OF SOUTHERLY GATE FOR CEMETERY.	X					
NB	3.390	B	W1-6R	48	24			8.00								2	X							INSTALL 75 FEET NORTH OF SOUTHERLY GATE FOR CEMETERY.	X					
NB	3.405	A	W1-8L	18	24		LEFT CHEVRON						1		X															
		B	W1-8R	18	24		RIGHT CHEVRON						1		X															
NB	3.435	A	W1-8L	18	24		LEFT CHEVRON						1		X															
		B	W1-8R	18	24		RIGHT CHEVRON						1		X															
NB	3.542	A	W1-2R	30	30		RIGHT CURVE				1		1		X									MOVE 290 FEET NORTH.						
		A	W13-1	18	18		35 MPH ADVISORY				1		1																	
NB	3.597	A	W1-2R	30	30		RIGHT CURVE					1			1	X								INSTALL 290 FEET NORTH OF EXISTING AND 10 FEET SOUTH OF UTILITY POLE 20T/60/98.	X					
		A	W13-1	18	18		35 MPH ADVISORY					1													X					
SIGN SUMMARY SHEET							SHEET TOTALS		16.00	0.00	1	3	3	9	0	0	6	90.0			0	0.0	0.0	0.0	0.0	PROJECT NAME: PAWLET - WEST RUTLAND				
									SF	SF	EA	EA	EA	EA	EA	EA	EA	FT		EA	LB	LB	LB	LB	PROJECT NUMBER: STPG SIGN(37)					
																									FILE NAME: 10C340			PLOT DATE: 5/6/2011		
							VERMONT AGENCY OF TRANSPORTATION		TOWN DIRECTIONAL TOTALS										60.6	0.0	5	4	4	17	0	0	14	210.0		
																								DESIGNED BY: J. KELLY			CHECKED A. GAMBLE			
																								IRA NB SHEET 2			SHEET 49 OF 61			




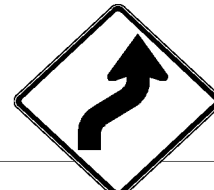
DIRECTION	MILEPOINT	LOCATION CODE (SHEET 2)	SIGN CODE	WIDTH (IN)	HEIGHT (IN)	SHEETING REMARKS	SIGN LEGEND	NEW SIGNS		EXISTING SIGNS				EXIST POST		NUMBER OF NEW POSTS	SQUARE STEEL (IN)			TUBULAR STEEL Ø (IN)				SIGN FRAME REQUIRED	REMARKS	SIGN DETAIL LOCATION																																																																																																																																																																																																																																																																																																																																																																																																																																																																																																																																																																						
								"A"	"B"	RETAIN	SALVAGE FROM	SALVAGE TO	REMOVE	RETAIN	REMOVE		1.75	2.00	2.50	FOUNDATION	3.00	3.50	4.00			5.00	SHSM	PROJECT SHEET #	STANDARD SHEET #																																																																																																																																																																																																																																																																																																																																																																																																																																																																																																																																																																			
																	(LB / FT)				(LB / FT)																																																																																																																																																																																																																																																																																																																																																																																																																																																																																																																																																																											
																	1.88	2.42	3.35		7.60	9.00	10.80			14.60																																																																																																																																																																																																																																																																																																																																																																																																																																																																																																																																																																						
IRA NB							FY-FLUORESCENT YELLOW FYG-FLUORESCENT YELLOW GREEN															"SHSM"-STANDARD HIGHWAY SIGNS AND MARKINGS																																																																																																																																																																																																																																																																																																																																																																																																																																																																																																																																																																										
NB	4.170	C	VR-017	24	30									1	X								WEAVER HILL RD. (TH-9)																																																																																																																																																																																																																																																																																																																																																																																																																																																																																																																																																																									
		C	VR-017	24	30			5.00															INSTALL NEW SIGN ON EXISTING POST.		6																																																																																																																																																																																																																																																																																																																																																																																																																																																																																																																																																																							
NB	4.176	D	R1-1	24	24		THINNING AND TRIMMING							1	X								WEAVER HILL RD. (TH-9)																																																																																																																																																																																																																																																																																																																																																																																																																																																																																																																																																																									
		D	R1-1	30	30			6.25															INSTALL NEW SIGN ON EXISTING POST.	X																																																																																																																																																																																																																																																																																																																																																																																																																																																																																																																																																																								
NB	4.560	A	W1-4R	30	30		RIGHT REVERSE CURVE							1		X																																																																																																																																																																																																																																																																																																																																																																																																																																																																																																																																																																																
		A	W13-1	18	18		35 MPH ADVISORY							1																																																																																																																																																																																																																																																																																																																																																																																																																																																																																																																																																																																		
NB	4.605	A	W1-4R	30	30			6.25								1		X						INSTALL 240 FEET NORTH OF EXISTING AND BEHIND RAIL.	X																																																																																																																																																																																																																																																																																																																																																																																																																																																																																																																																																																							
		A	W13-1	18	18			2.25																THINNING AND TRIMMING	X																																																																																																																																																																																																																																																																																																																																																																																																																																																																																																																																																																							
SIGN SUMMARY SHEET							SHEET TOTALS		19.75	0.00	0	0	0	4	0	0	1	15.0			0	0.0	0.0	0.0	0.0	PROJECT NAME: PAWLET - WEST RUTLAND																																																																																																																																																																																																																																																																																																																																																																																																																																																																																																																																																																						
									SF	SF	EA	EA	EA	EA	EA	EA	EA	FT			EA	LB	LB	LB	LB	PROJECT NUMBER: STPG SIGN(37)																																																																																																																																																																																																																																																																																																																																																																																																																																																																																																																																																																						
																				FILE NAME: 10C340			DRAWN DATE: 5/6/2011																																																																																																																																																																																																																																																																																																																																																																																																																																																																																																																																																																									
							VERMONT AGENCY OF TRANSPORTATION		TOWN DIRECTIONAL TOTALS											60.6			0.0			5			4			4			17			0			0			14			210.0			0			0.0			PROJECT MANAGER: A. GAMBLE			DRAWN BY: J. KELLY																																																																																																																																																																																																																																																																																																																																																																																																																																																																																																																																					

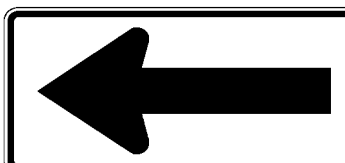
DIRECTION	MILEPOINT	LOCATION CODE (SHEET 2)	SIGN CODE	WIDTH (IN)	HEIGHT (IN)	SHEETING REMARKS	SIGN LEGEND	NEW SIGNS		EXISTING SIGNS				EXIST POST		NUMBER OF NEW POSTS	SQUARE STEEL (IN)			TUBULAR STEEL Ø (IN)					SIGN FRAME REQUIRED	REMARKS	SIGN DETAIL LOCATION			
								"A"	"B"	RETAIN	SALVAGE FROM	SALVAGE TO	REMOVE	RETAIN	REMOVE		1.75	2.00	2.50	FOUNDATION	3.00	3.50	4.00	5.00			SHSM	PROJECT SHEET #	STANDARD SHEET #	
																	(LB / FT)				(LB / FT)									
																	1.88	2.42	3.35		7.60	9.00	10.80	14.60						
IRA SB							FY-FLUORESCENT YELLOW FYG-FLUORESCENT YELLOW GREEN																"SHSM"-STANDARD HIGHWAY SIGNS AND MARKINGS							
SB	4.745	F	W1-2L	30	30		LEFT CURVE								X															
		F	W13-1	18	18		35 MPH ADVISORY								X															
SB	4.715	F	W1-2L	30	30			6.25								1		X							INSTALL 160 FEET SOUTH OF EXISTING AND 10 FEET NORTH OF UTILITY POLE.	X				
		F	W13-1	18	18			2.25																		X				
SB	4.668	F	W1-6L	48	24										X															
		F	W1-6L	48	24			8.00								2		X								X				
SB	4.617	G	VR-017	24	30										X									PYKA RD. (TH-3)						
		G	VR-017	24	30			5.00								1		X								6				
SB	4.610	H	R1-1	30	30										X									PYKA RD. (TH-3)						
		H	R1-1	30	30			6.25								1		X							REINSTALL STREET NAME SIGN ABOVE NEW SIGN.	X				
SB	3.900	F	W1-2L	30	30		LEFT CURVE								X															
		F	W13-1	18	18		35 MPH ADVISORY																							
SB	3.805	F	S3-1	30	30		SCHOOL BUS STOP AHEAD								X															
		F	W1-2L	30	30			6.25																	INSTALL NEW SIGNS ON EXISTING POST.	X				
		F	W13-1	18	18			2.25																		X				
SIGN SUMMARY SHEET							SHEET TOTALS	36.25	0.00	0	0	0	87	0	0	5	75.0			0	0.0	0.0	0.0	0.0	PROJECT NAME: PAWLET - WEST RUTLAND					
								SF	SF	EA	EA	EA	EA	EA	EA	EA		FT		EA	LB	LB	LB	LB	PROJECT NUMBER: STPG SIGN(37)					
							VERMONT AGENCY OF TRANSPORTATION																			FILE NAME: 10C340				
							TOWN DIRECTIONAL TOTALS					126.5	0.0	2	0	0	21	0	0	13	195.0			0	0.0				PROJECT MANAGER: A. GAMBLE	
																							PLOT DATE: 5/6/2011							
																							DRAWN BY: J. KELLY							
																							CHECKED A. GAMBLE							
																							DESIGNED BY: J. KELLY							
																							IRA SB SHEET 1							
																							SHEET 51 OF 61							

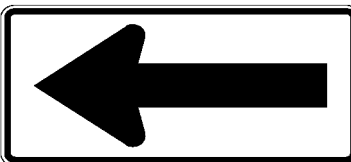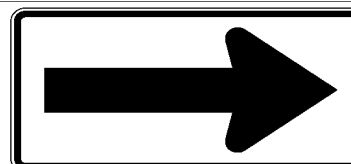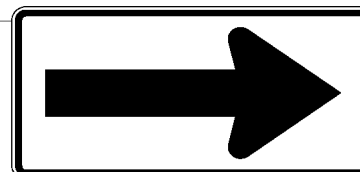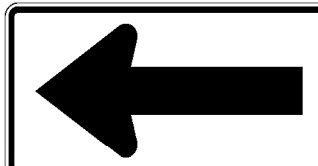DIRECTION	MILEPOINT	LOCATION CODE (SHEET 2)	SIGN CODE	WIDTH (IN)	HEIGHT (IN)	SHEETING REMARKS	SIGN LEGEND	NEW SIGNS		EXISTING SIGNS				EXIST POST		NUMBER OF NEW POSTS	SQUARE STEEL (IN)			TUBULAR STEEL Ø (IN)				SIGN FRAME REQUIRED	REMARKS	SIGN DETAIL LOCATION					
								"A"	"B"	RETAIN	SALVAGE FROM	SALVAGE TO	REMOVE	RETAIN	REMOVE		1.75	2.00	2.50	FOUNDATION	3.00	3.50	4.00			5.00	SHSM	PROJECT SHEET #	STANDARD SHEET #		
																	(LB / FT)				(LB / FT)										
																	1.88	2.42	3.35		7.60	9.00	10.80			14.60					
IRA SB							FY-FLUORESCENT YELLOW FYG-FLUORESCENT YELLOW GREEN															"SHSM"-STANDARD HIGHWAY SIGNS AND MARKINGS									
SB	3.722	F	W1-6L	48	24									1	X																
		F	W1-6L	48	24			8.00																INSTALL NEW SIGN ON EXISTING POSTS.	X						
SB	3.720	E	W1-6R	48	24									1	X																
		E	W1-6R	48	24			8.00																INSTALL NEW SIGN ON EXISTING POSTS.	X						
SB	3.665	E	W1-6R	48	24									1	X									REINSTALL STREET NAME SIGN ABOVE NEW SIGN.							
		E	W1-6R	48	24			8.00								1	X							RETAIN EXISTING POST. INSTALL NEW SIGN AND SECOND POST.							
SB	3.670	G	VR-017	24	30									1		X								CROSS RD. (TH-7)							
		G	VR-017	24	30			5.00									1	X								6					
SB	3.655	H	R1-1	30	30									1		X								CROSS RD. (TH-7)							
		H	R1-1	30	30			6.25									1	X								X					
SB	3.635	F	W1-6L	48	24									1	X																
		F	W1-6L	48	24			8.00																INSTALL NEW SIGN ON EXISTING POSTS.	X						
SB	3.480	F	W11-3A	30	30									1	X																
		F	W7-3A	24	18									1																	
		F	W11-3A	30	30			6.25																INSTALL NEW SIGNS ON EXISTING POST.	X						
SIGN SUMMARY SHEET							SHEET TOTALS		49.50	0.00	0	0	0	8	0	0	3	45.0			0	0.0	0.0	0.0	0.0	PROJECT NAME: PAWLET - WEST RUTLAND					
									SF	SF	EA	EA	EA	EA	EA	EA	EA		FT		EA	LB	LB	LB	LB	PROJECT NUMBER: STPG SIGN(37)					
																										FILE NAME: 10C340					
									VERMONT AGENCY OF TRANSPORTATION										TOWN DIRECTIONAL TOTALS										PROJECT MANAGER: A. GAMBLE		
									126.5	0.0	2	0	0	21	0	0	13	195.0			0	0.0				PLOT DATE: 5/6/2011					
																								DRAWN BY: J. KELLY							
																								CHECKED A. GAMBLE							
																								IRA SB SHEET 2							
																								SHEET 52 OF 61							

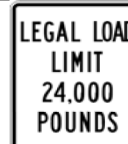
DIRECTION	MILEPOINT	LOCATION CODE (SHEET 2)	SIGN CODE	WIDTH (IN)	HEIGHT (IN)	SHEETING REMARKS	SIGN LEGEND	NEW SIGNS		EXISTING SIGNS				EXIST POST		NUMBER OF NEW POSTS	SQUARE STEEL (IN)			TUBULAR STEEL Ø (IN)				SIGN FRAME REQUIRED	REMARKS	SIGN DETAIL LOCATION					
								"A"	"B"	RETAIN	SALVAGE FROM	SALVAGE TO	REMOVE	RETAIN	REMOVE		1.75	2.00	2.50	FOUNDATION	3.00	3.50	4.00			5.00	SHSM	PROJECT SHEET #	STANDARD SHEET #		
																	(LB / FT)				(LB / FT)										
																	1.88	2.42	3.35		7.60	9.00	10.80			14.60					
IRA SB							FY-FLUORESCENT YELLOW FYG-FLUORESCENT YELLOW GREEN															"SHSM"-STANDARD HIGHWAY SIGNS AND MARKINGS									
		F	W7-3A	24	18			3.00																X							
SB	3.405	F	W11-4H	30	30		HINGED CATTLE CROSSING			1				X																	
SB	2.976	H	R1-1	30	30																		WEST RD. (TH-2)								
		G	VR-017	24	30																										
		H	R1-1	30	30																										
		G	VR-017	24	30				6.25							1		X							X						
		G	VR-017	24	30			5.00																	6						
SB	2.970	H	R1-1	30	30																		WEST RD. (TH-2)								
		H	R1-1	30	30				6.25							1		X						X							
SB	2.920	G	VR-017	24	30		LEGAL LOAD 24,000 LBS.																TOWN OFFICE RD. (TH-10)								
SB	2.915	H	R1-1	30	30																		TOWN OFFICE RD. (TH-10)								
		H	R1-1	30	30				6.25							1		X						X							
SB	2.880	F	R2-1	24	30																										
		F	R2-1	24	30				5.00															INSTALL NEW SIGN ON EXISTING POST.	X						
SB	2.650	F	R2-1	24	30		SPEED LIMIT 50			1				X																	
SB	1.600	F	S3-1	36	36	FYG	 MOVED 40FT NORTH DUE TO LEDGE ROCK	9.00								2		X						INSTALL 50 FEET NORTH AND ACROSS FROM 1.59 MILE MARKER.	X						
SIGN SUMMARY SHEET							 SHEET TOTALS	40.75	0.00	2	0	0	6	0	0	5	75.0			0	0.0	0.0	0.0	0.0	PROJECT NAME: PAWLET - WEST RUTLAND						
								SF	SF	EA	EA	EA	EA	EA	EA	EA	FT		EA	LB	LB	LB	LB	PROJECT NUMBER: STPG SIGN(37)							
																							FILE NAME: 10C340			PROJECT MANAGER: A. GAMBLE			PLOT DATE: 5/6/2011		
								VERMONT AGENCY OF TRANSPORTATION															DESIGNED BY: J. KELLY			DRAWN BY: J. KELLY			CHECKED A. GAMBLE		
TOWN DIRECTIONAL TOTALS							126.5	0.0	2	0	0	21	0	0	13	195.0			0	0.0				IRA SB SHEET 3			SHEET 53 OF 61				

DIRECTION	MILEPOINT	LOCATION CODE (SHEET 2)	SIGN CODE	WIDTH (IN)	HEIGHT (IN)	SHEETING REMARKS	SIGN LEGEND	NEW SIGNS		EXISTING SIGNS				EXIST POST		NUMBER OF NEW POSTS	SQUARE STEEL (IN)			TUBULAR STEEL Ø (IN)				SIGN FRAME REQUIRED	REMARKS	SIGN DETAIL LOCATION			
								"A"	"B"	RETAIN	SALVAGE FROM	SALVAGE TO	REMOVE	RETAIN	REMOVE		1.75	2.00	2.50	FOUNDATION	3.00	3.50	4.00			5.00	SHSM	PROJECT SHEET #	STANDARD SHEET #
																	(LB / FT)				(LB / FT)								
																	1.88	2.42	3.35		7.60	9.00	10.80			14.60			
CLARENDON NB							FY-FLUORESCENT YELLOW FYG-FLUORESCENT YELLOW GREEN															"SHSM"-STANDARD HIGHWAY SIGNS AND MARKINGS							
NB	0.000	C	VD-024	60	7.5		Clarendon Ira 1330 1105 0000 1330 1109 0478						1		X														
		C	VD-024	72	10			5.00								2		X								4			
		C	VD-700	6	10			0.42																INSTALL ON LEFT POST BELOW CLARENDON.			E-138		
		C	VD-700	6	10			0.42																INSTALL ON RIGHT POST BELOW IRA.			E-138		
NB	0.245	A	R2-1	24	30		SPEED LIMIT 40							1	X									THINNING AND TRIMMING					
		A	R2-1	24	30			5.00																INSTALL NEW SIGN ON EXISTING POST.	X				
NB	0.735	A	W1-4R	30	30		RIGHT REVERSE CURVE							1		X													
		A	S3-1	30	30		SCHOOL BUS STOP AHEAD							1															
NB	0.742	A	S3-1	36	36			9.00								2		X							INSTALL 200 FEET SOUTH OF CLARENDON SPRINGS D-BOARD.	X	THINNING AND TRIMMING		
NB	0.780	A	D1-1A	54	7.5		Clarendon Springs 1 →							1		X								THINNING AND TRIMMING					
		A	VD1-1A	72	12			6.00								2		X								5			
NB	0.840	C	VR-017	24	30		(MISSING) SPEED LIMIT 35				1	2	2 4		X														
		C	VR-017	24	30		LEGAL LOAD LIMIT 24,000 POUNDS	5.00				1	2			1		X						WALKER MOUNTAIN RD (TH-3). INSTALL EAST OF TRIANGLE.			6		
NB	0.845	D	R1-1	30	30		STOP			1				X									LOCATED IN ISLAND.						
NB	0.846	A	W1-6L	48	24								1	X															
SIGN SUMMARY SHEET							SHEET TOTALS	30.84	0.00	1	0	0	8 7	0	0	7	105.0			0	0.0	0.0	0.0	0.0	PROJECT NAME: PAWLET - WEST RUTLAND				
								SF	SF	EA	EA	EA	EA	EA	EA	EA		FT		EA	LB	LB	LB	LB	PROJECT NUMBER: STPG SIGN(37)				
							VERMONT AGENCY OF TRANSPORTATION																					FILE NAME: 10C340	
							TOWN DIRECTIONAL TOTALS	73.8	0.0	2	1	1	11	0	0	14	210.0			0	0.0				PROJECT MANAGER: A. GAMBLE				
																								PLOT DATE: 5/6/2011					
																								DRAWN BY: J. KELLY					
																								CHECKED A. GAMBLE					
																								SHEET 54 OF 61					

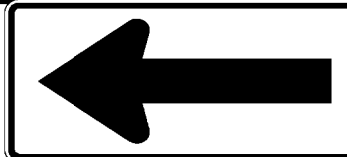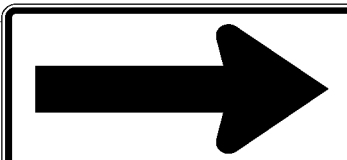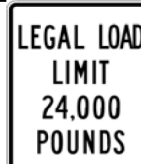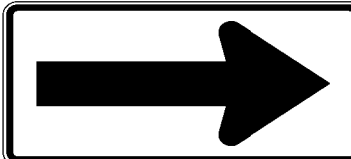DIRECTION	MILEPOINT	LOCATION CODE (SHEET 2)	SIGN CODE	WIDTH (IN)	HEIGHT (IN)	SHEETING REMARKS	SIGN LEGEND	NEW SIGNS		EXISTING SIGNS				EXIST POST		NUMBER OF NEW POSTS	SQUARE STEEL (IN)			TUBULAR STEEL Ø (IN)					SIGN FRAME REQUIRED	REMARKS	SIGN DETAIL LOCATION		
								"A"	"B"	RETAIN	SALVAGE FROM	SALVAGE TO	REMOVE	RETAIN	REMOVE		1.75	2.00	2.50	FOUNDATION	3.00	3.50	4.00	5.00			SHSM	PROJECT SHEET #	STANDARD SHEET #
																	(LB / FT)				(LB / FT)								
																	1.88	2.42	3.35		7.60	9.00	10.80	14.60					
CLARENDON NB							FY-FLUORESCENT YELLOW FYG-FLUORESCENT YELLOW GREEN																"SHSM"-STANDARD HIGHWAY SIGNS AND MARKINGS						
		A	W1-6L	48	24			8.00																REPLACE SIGN IN ISLAND. INSTALL ON EXISTING POSTS.	X				
NB	0.847	B	W1-6R	48	24								1	X															
		B	W1-6R	48	24			8.00																REPLACE SIGN IN ISLAND. INSTALL ON EXISTING POSTS.	X				
NB	0.855	D	R1-1	30	30		STOP			1				X															
NB	0.855	C	VR-017	24	30		• ELIMINATE • 	5.00							1		X							INSTALL NEW IN ISLAND AND ACROSS FROM STOP SIGN.		6			
NB	0.865	B	W1-6R	48	24			8.00								2		X						INSTALL NEW NEXT TO CEDAR HEDGE AND FACING SB TRAFFIC.	X				
NB	0.960	A	VW-202	30	30								1		X														
		A	VW-202R	36	36			9.00								2		X								7			
NB	1.000	A	R2-1	24	30		SPEED LIMIT 40						1	X															
		A	VD-700	6	8		CUT POST AT MILE MARKER 1.00 MILE MARKER				1	1	1			1	X							REINSTALL 1.00 MILE MARKER ON NEW POST.					
NB	1.090	A	R2-1	24	30			5.00								1		X						INSTALL 450 FEET NORTH OF EXISTING.	X				
SIGN SUMMARY SHEET							SHEET TOTALS	43.00	0.00	1	1	1	34	0	0	7	105.0			0	0.0	0.0	0.0	0.0	PROJECT NAME: PAWLET - WEST RUTLAND				
								SF	SF	EA	EA	EA	EA	EA	EA	EA		FT		EA	LB	LB	LB	LB	PROJECT NUMBER: STPG SIGN(37)				
							TOWN DIRECTIONAL TOTALS	73.8	0.0	2	1	1	11	0	0	14	210.0			0	0.0				FILE NAME: 10C340 PROJECT MANAGER: A. GAMBLE DESIGNED BY: J. KELLY CLARENDON NB SHEET 2			PLOT DATE: 5/6/2011 DRAWN BY: J. KELLY CHECKED A. GAMBLE SHEET 55 OF 61	
VERMONT AGENCY OF TRANSPORTATION																													

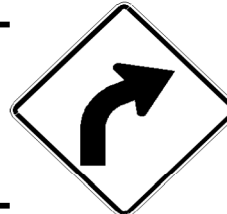DIRECTION	MILEPOINT	LOCATION CODE (SHEET 2)	SIGN CODE	WIDTH (IN)	HEIGHT (IN)	SHEETING REMARKS	SIGN LEGEND	NEW SIGNS		EXISTING SIGNS				EXIST POST		NUMBER OF NEW POSTS	SQUARE STEEL (IN)			TUBULAR STEEL Ø (IN)				SIGN FRAME REQUIRED	REMARKS	SIGN DETAIL LOCATION			
								"A"	"B"	RETAIN	SALVAGE FROM	SALVAGE TO	REMOVE	RETAIN	REMOVE		1.75	2.00	2.50	FOUNDATION	3.00	3.50	4.00			5.00	SHSM	PROJECT SHEET #	STANDARD SHEET #
																	(LB / FT)				(LB / FT)								
																	1.88	2.42	3.35		7.60	9.00	10.80			14.60			
CLARENDON SB						FY-FLUORESCENT YELLOW FYG-FLUORESCENT YELLOW GREEN																"SHSM"-STANDARD HIGHWAY SIGNS AND MARKINGS							
SB	1.410	F	R2-1	24	30								1	X															
		F	R2-1	24	30			5.00																INSTALL NEW SIGN ON EXISTING POST.	X				
SB	1.190	F	VW-202	30	30		TRUCKS ENTERING LEFT						1		X														
		F	VD-700	6	10		1.20 MILE MARKER									1	X								INSTALL MILE MARKER ON NEW POST.				
SB	1.160	F	VW-202L	36	36			9.00								2		X							INSTALL 160 FEET SOUTH OF EXISTING LOCATION, 10 FEET NORTH OF POLE.		7		
SB	1.040	F	R2-1	24	30		SPEED LIMIT 40						1		X														
SB	1.000	F	S3-1	36	36		 MOUNTED 40FT SOUTH DUE TO LEDGE ROCK	9.00								2		X							INSTALL ACROSS FROM NB SPEED LIMIT 40.				
SB	0.980	F	W1-4R	30	30		RIGHT REVERSE CURVE						1		X														
		F	S3-1	30	30		SCHOOL BUS STOP AHEAD						1																
SB	0.963	F	VD1-1A	72	12			6.00								2		X							INSTALL 150 FEET NORTH OF EXISTING CLARENDON SPRINGS DESTINATION SIGN.		5		
SB	0.935	F	D1-1A	54	7.5		<--- CLARENDON SPRINGS 1						1		X														
SB	0.925	F	W1-2R	30	30			6.25								1		X							INSTALL 50 FEET SOUTH OF EXISTING CLARENDON SPRINGS DESTINATION SIGN.	X			
SB	0.795	F	M3-3	24	12		SOUTH						1	X															
		F	M1-6	30	24		ROUTE 133						1																
		F	R2-1	24	30			5.00																	INSTALL NEW SIGN ON EXISTING POST.	X			
SIGN SUMMARY SHEET						SHEET TOTALS		40.25	0.00	0	0	0	0	3	0	0	8	120.0			0	0.0	0.0	0.0	0.0	PROJECT NAME: PAWLET - WEST RUTLAND			
								SF	SF	EA	EA	EA	EA	EA	EA	EA		FT		EA	LB	LB	LB	LB	PROJECT NUMBER: STPG SIGN(37)				
																										FILE NAME: 10C340			
VERMONT AGENCY OF TRANSPORTATION						TOWN DIRECTIONAL TOTALS		51.5	0.0	2	1	1	13	0	0	8	120.0			0	0.0				PROJECT MANAGER: A. GAMBLE				
																										PLOT DATE: 5/6/2011			

DIRECTION	MILEPOINT	LOCATION CODE (SHEET 2)	SIGN CODE	WIDTH (IN)	HEIGHT (IN)	SHEETING REMARKS	SIGN LEGEND	NEW SIGNS		EXISTING SIGNS				EXIST POST		NUMBER OF NEW POSTS	SQUARE STEEL (IN)			TUBULAR STEEL Ø (IN)					SIGN FRAME REQUIRED	REMARKS	SIGN DETAIL LOCATION					
								"A"	"B"	RETAIN	SALVAGE FROM	SALVAGE TO	REMOVE	RETAIN	REMOVE		1.75	2.00	2.50	FOUNDATION	3.00	3.50	4.00	5.00			SHSM	PROJECT SHEET #	STANDARD SHEET #			
																	(LB / FT)				(LB / FT)											
																	1.88	2.42	3.35		7.60	9.00	10.80	14.60								
WEST RUTLAND NB																							"SHSM"-STANDARD HIGHWAY SIGNS AND MARKINGS									
NB	0.000	C	VD-024	60	7.5		West Rutland Clarendon						1		X																	
		C	VD-024	72	10			5.00								2		X									4					
		C	VD-700	6	10			1330 1128 0000																	INSTALL ON LEFT POST BELOW WEST RUTLAND.				E-138			
		C	VD-700	6	10																				INSTALL ON RIGHT POST BELOW CLARENDON				E-138			
NB	0.005	A	R2-1	24	30		SPEED LIMIT 40						1		X																	
NB	0.172	A	W1-2L	30	30		LEFT CURVE						1		X																	
NB	0.200	A	W1-2L	30	30	FY		6.25								1		X							INSTALL 150 FEET NORTH OF EXISTING.	X						
NB	0.205	A	VD-701	6	8		BRIDGE MARKER"17"				1	1	1		X	1	X							REMOVE EXISTING POST AND REINSTALL BRIDGE MARKER ON NEW POST.								
NB	0.240	D	R1-1	30	30		(SIGN IS MISSING)						+		X										GORHAM RD (TH-17)							
		D	R1-1	30	30			6.25								1		X							INSTALL IN ISLAND	X						
NB	0.245	C	VR-017	24	30		(SIGN IS MISSING)						+		X										GORHAM RD (TH-17)							
		C	VR-017	24	30		LEGAL LOAD LIMIT 24,000 POUNDS	5.00								1		X							INSTALL NEAR GARAGE.			6				
NB	0.250	D	R1-1	30	30								1		X																	
		D	R1-1	30	30			6.25								1		X							GORHAM RD (TH-17)	X						
NB	0.270	A	W1-6L	48	24								1	X																		
SIGN SUMMARY SHEET							SHEET TOTALS	29.59	0.00	0	1	1	68	0	0	7	105.0			0	0.0	0.0	0.0	0.0	PROJECT NAME: PAWLET - WEST RUTLAND							
								SF	SF	EA	EA	EA	EA	EA	EA	EA		FT		EA	LB	LB	LB	LB	PROJECT NUMBER: STPG SIGN(37)							
																										FILE NAME: 10C340						
							VERMONT AGENCY OF TRANSPORTATION																				PROJECT MANAGER: A. GAMBLE			PLOT DATE: 5/6/2011		
							TOWN DIRECTIONAL TOTALS	53.6	0.0	0	1	1	15	0	0	7	105.0			0	0.0				DESIGNED BY: J. KELLY			DRAWN BY: J. KELLY				
																								WEST RUTLAND NB SHEET 1			CHECKED A. GAMBLE			SHEET 58 OF 61		

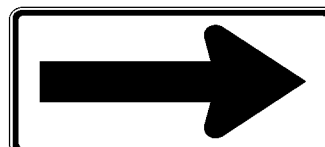DIRECTION	MILEPOINT	LOCATION CODE (SHEET 2)	SIGN CODE	WIDTH (IN)	HEIGHT (IN)	SHEETING REMARKS	SIGN LEGEND	NEW SIGNS		EXISTING SIGNS				EXIST POST		NUMBER OF NEW POSTS	SQUARE STEEL (IN)			TUBULAR STEEL Ø (IN)				SIGN FRAME REQUIRED	REMARKS	SIGN DETAIL LOCATION			
								"A"	"B"	RETAIN	SALVAGE FROM	SALVAGE TO	REMOVE	RETAIN	REMOVE		1.75	2.00	2.50	FOUNDATION	3.00	3.50	4.00			5.00	SHSM	PROJECT SHEET #	STANDARD SHEET #
																	(LB / FT)				(LB / FT)								
																	1.88	2.42	3.35		7.60	9.00	10.80			14.60			
WEST RUTLAND NB						FY-FLUORESCENT YELLOW FYG-FLUORESCENT YELLOW GREEN																"SHSM"-STANDARD HIGHWAY SIGNS AND MARKINGS							
		A	W1-6L	48	24	FY		8.00															INSTALL NEW SIGN ON EXISTING POSTS.	X					
NB	0.290	A	S3-1	30	30		SCHOOL BUS STOP AHEAD						1		X														
NB	0.315	B	W1-6R	48	24								1	X															
		B	W1-6R	48	24	FY		8.00															INSTALL NEW SIGN ON EXISTING POSTS.	X					
NB	0.670	A					(REMOVE EMPTY POST - UNKNOWN SIGN)						1		X								REMOVE EMPTY POST						
NB	0.700	A	R2-1	24	30		 REMOVED AND REPLACED ON 5-24-12						1	X									INSTALL NEW SIGNS ON EXISTING POST.		6				
		A	VR-038	24	18			3.00						I															
		A	R2-1	24	30			5.00						I										X					
		A		24	24			TOWN'S ENGINE BRAKE SIGN						+										REMOVE TOWN SIGN					
		B	VR-039	24	18		STATE HIGHWAY BEGINS						1																
		B	VR-041	24	24		THROUGH WAY BEGINS HERE						+																
SIGN SUMMARY SHEET							SHEET TOTALS	24.00	0.00	0	0	0	9 7	0	0	0	0.0			0	0.0	0.0	0.0	0.0	PROJECT NAME: PAWLET - WEST RUTLAND				
								SF	SF	EA	EA	EA	EA	EA	EA	EA		FT		EA	LB	LB	LB	LB		PROJECT NUMBER: STPG SIGN(37)			
																											FILE NAME: 10C340		
							VERMONT AGENCY OF TRANSPORTATION	TOWN DIRECTIONAL TOTALS	53.6	0.0	0	1	1	15	0	0	7	105.0			0	0.0				PROJECT MANAGER: A. GAMBLE			PLOT DATE: 5/6/2011
																							DRAWN BY: J. KELLY						
																							CHECKED A. GAMBLE						
																							WEST RUTLAND NB SHEET 2						
																							SHEET 59 OF 61						

DIRECTION	MILEPOINT	LOCATION CODE (SHEET 2)	SIGN CODE	WIDTH (IN)	HEIGHT (IN)	SHEETING REMARKS	SIGN LEGEND	NEW SIGNS		EXISTING SIGNS				EXIST POST		NUMBER OF NEW POSTS	SQUARE STEEL (IN)			TUBULAR STEEL Ø (IN)				SIGN FRAME REQUIRED	REMARKS	SIGN DETAIL LOCATION			
								"A"	"B"	RETAIN	SALVAGE FROM	SALVAGE TO	REMOVE	RETAIN	REMOVE		1.75	2.00	2.50	FOUNDATION	3.00	3.50	4.00			5.00	SHSM	PROJECT SHEET #	STANDARD SHEET #
																	(LB / FT)				(LB / FT)								
																	1.88	2.42	3.35		7.60	9.00	10.80			14.60			
WEST RUTLAND SB							FY-FLUORESCENT YELLOW FYG-FLUORESCENT YELLOW GREEN															"SHSM"-STANDARD HIGHWAY SIGNS AND MARKINGS							
SB	0.700	F	R2-1	24	30		 						1		X									SOUTH OF INTERSECTION WITH SKYLINE DRIVE.			6		
		F	VR-039	24	18			3.00							1		X												
		F	R2-1	24	30			5.00																	X				
		E	VR-038	24	18			STATE HIGHWAY ENDS						1															
		E	VR-040	24	24			THROUGH WAY ENDS HERE						1															
SB	0.375	F	W1-2R	30	30		RIGHT CURVE						1		X														
		F	S3-1	30	30		SCHOOL BUS STOP AHEAD						1																
SB	0.365	F	W1-2R	30	30	FY		6.25								1		X						INSTALL 50 FEET SOUTH OF EXISTING RIGHT CURVE SIGN AND AT NORTH EDGE OF DRIVE.	X				
SIGN SUMMARY SHEET							SHEET TOTALS		14.25	0.00	0	0	0	5	0	0	2	30.0			0	0.0	0.0	0.0	0.0	PROJECT NAME: PAWLET - WEST RUTLAND			
									SF	SF	EA	EA	EA	EA	EA	EA	EA		FT		EA	LB	LB	LB	LB		PROJECT NUMBER: STPG SIGN(37)		
																											FILE NAME: 10C340		
																											PROJECT MANAGER: A. GAMBLE		
VERMONT AGENCY OF TRANSPORTATION							TOWN DIRECTIONAL TOTALS																	PLOT DATE: 5/6/2011					
																											DRAWN BY: J. KELLY		
																							CHECKED A. GAMBLE						
																								DESIGNED BY: J. KELLY					
																								WEST RUTLAND SB SHEET 1					
																								SHEET 60 OF 61					

TOWN TOTAL SIGN SUMMARY SHEET

PAWLET - WEST RUTLAND STPG SIGN(37)

Townname-Route	County	Town Mileage	NEW SIGNS (SF)		EXISTING SIGNS (EA)						NUMBER OF NEW SQUARE STEEL POSTS (EA)				SQUARE STEEL (IN)			TUBULAR STEEL Ø (IN)											
			TYPE A	TYPE B	RETAIN	SALVAGE FROM	SALVAGE TO	REMOVE			1.75"	2"	2.5"	TOTAL SQUARE STEEL POSTS	1.75	2.00	2.50	FOUNDATION	3.00	3.50	4.00	5.00							
											(LB / FT)				(LB / FT)				(LB / FT)										
											1.88	2.42	3.35		1.88	2.42	3.35		7.60	9.00	10.80	14.60							
Pawlet VT-133 NB	Rutland	5.325	233.8	247.3	0	4	8	4	8	4	52	50			1	38	0	39	0	15	570	563	0						
Pawlet VT-133 SB	Rutland	5.325	244.0		0	1	2		2		50	52			0	36	0	36	0		540	488	0						
Danby VT-133 NB/SB	Rutland	0.024	12.1		0	0	0		0		3				0	3	0	3	0		45	35	0						
Tinmouth VT-133 NB	Rutland	3.126	84.8		0	11	9	7	9	7	23	24			0	19	0	19	0		285	249	0						
Tinmouth VT-133 SB	Rutland	3.126	99.9		0	22	7	5	7	5	26				0	18	0	18	0		270	243	0						
Midd. Spr. VT-133 NB	Rutland	5.975	44.1	54.1	0	42	16	14	16	14	28	23			0	16	0	16	0		240	208	0						
Midd. Spr. VT-133 SB	Rutland	5.975	116.3	121.3	0	31	21	20	21	20	38				1	24	0	25	0	15	360	332	0	2	228				
Ira VT-133 NB	Rutland	4.780	60.6		0	3	4	6	4	6	16	19			0	14	0	14	0		210	182	0						
Ira VT-133 SB	Rutland	4.780	126.5		0	1	0	4	0	4	22				0	13	0	13	0		195	170	0						
Clarendon VT-133 NB	Rutland	1.434	73.8	68.8	0	2	3	4	3	4	13	11			1	13	0	14	15		195	175	0						
Clarendon VT-133 SB	Rutland	1.434	51.5		0	2	0	4	0	4	12	13			1	7	0	8	0	15	105	98	0						
W. Rutland VT-133 NB	Rutland	0.710	53.6		0	0	1		1		15				1	6	0	7	0	15	90	82	0						
W. Rutland VT-133 SB	Rutland	0.710	14.3		0	0	0		0		5				0	2	0	2	0		30	28	0						
				Sub-Total			62		62		301				Sub-Total				75	31	35	0							
							71		71		303								0		28	53							
Estimated Salvaged Street Name Signs to be erected onto new posts =									-6		-6																		
		TOTAL =	1215.3		0	119	62		68		307			33	5	209	0	214	3210				2	228	0	0	0		

1238.8

71 71 303

2853

220

PROJECT NAME: PAWLET - WEST RUTLAND	
PROJECT NUMBER: STPG SIGN (37)	
FILE NAME: IOB012_TS.DGN	PLOT DATE: \$\$\$DATE\$\$\$
PROJECT LEADER: A. GAMBLE	DRAWN BY: J. KELLY
DESIGNED BY: J. KELLY	CHECKED BY: A. GAMBLE
TOWN TOTAL SIGN SUMMARY SHEET	SHEET 61 OF 61