




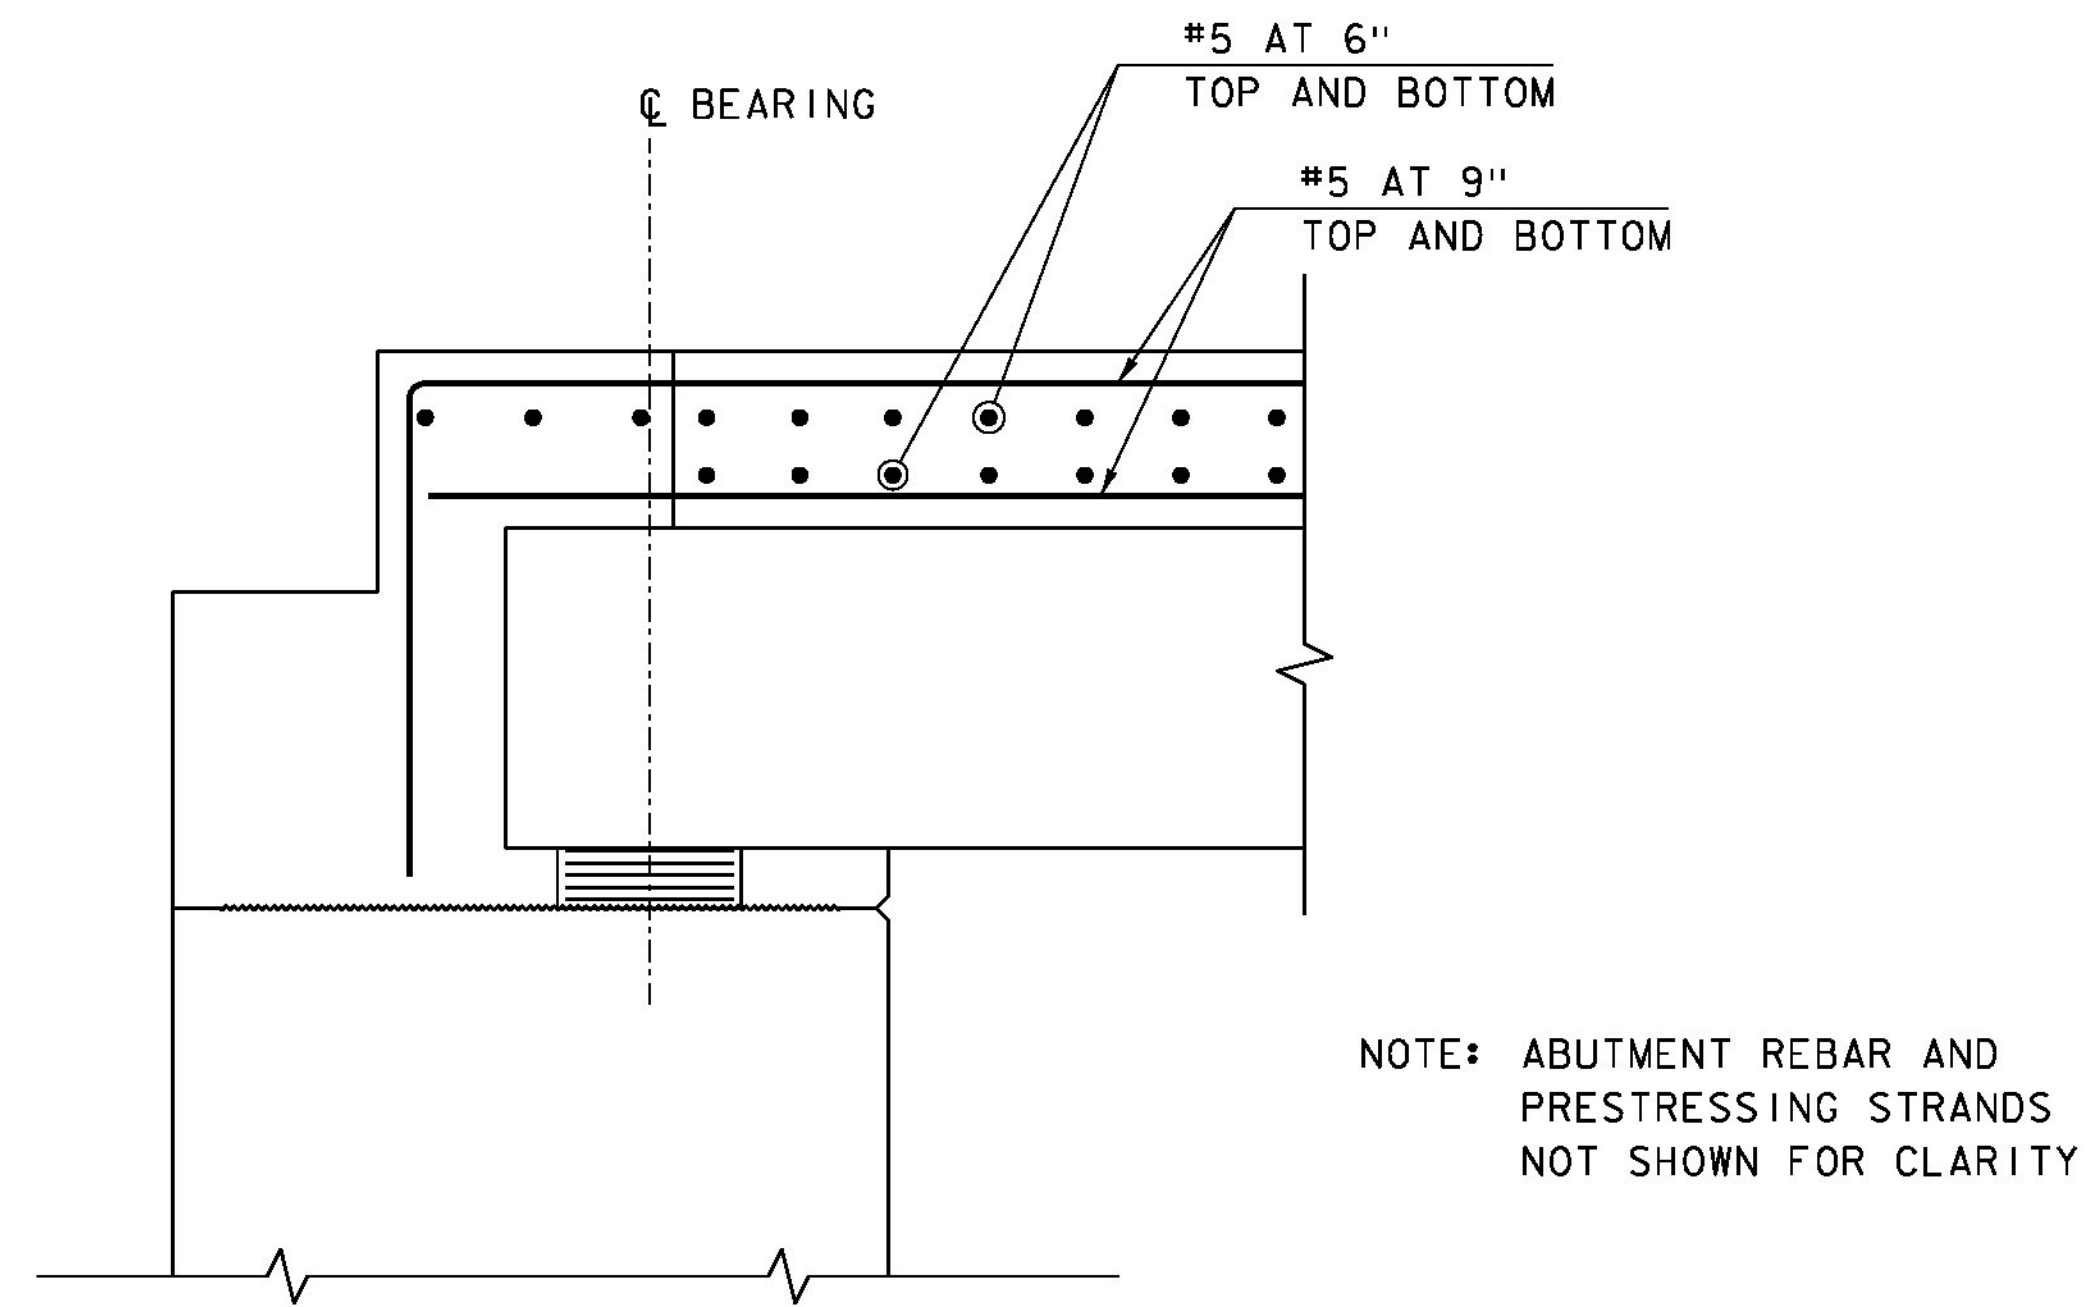


TYPICAL DECK REINFORCING AT BEAM END
SCALE: 1" = 1'-0"

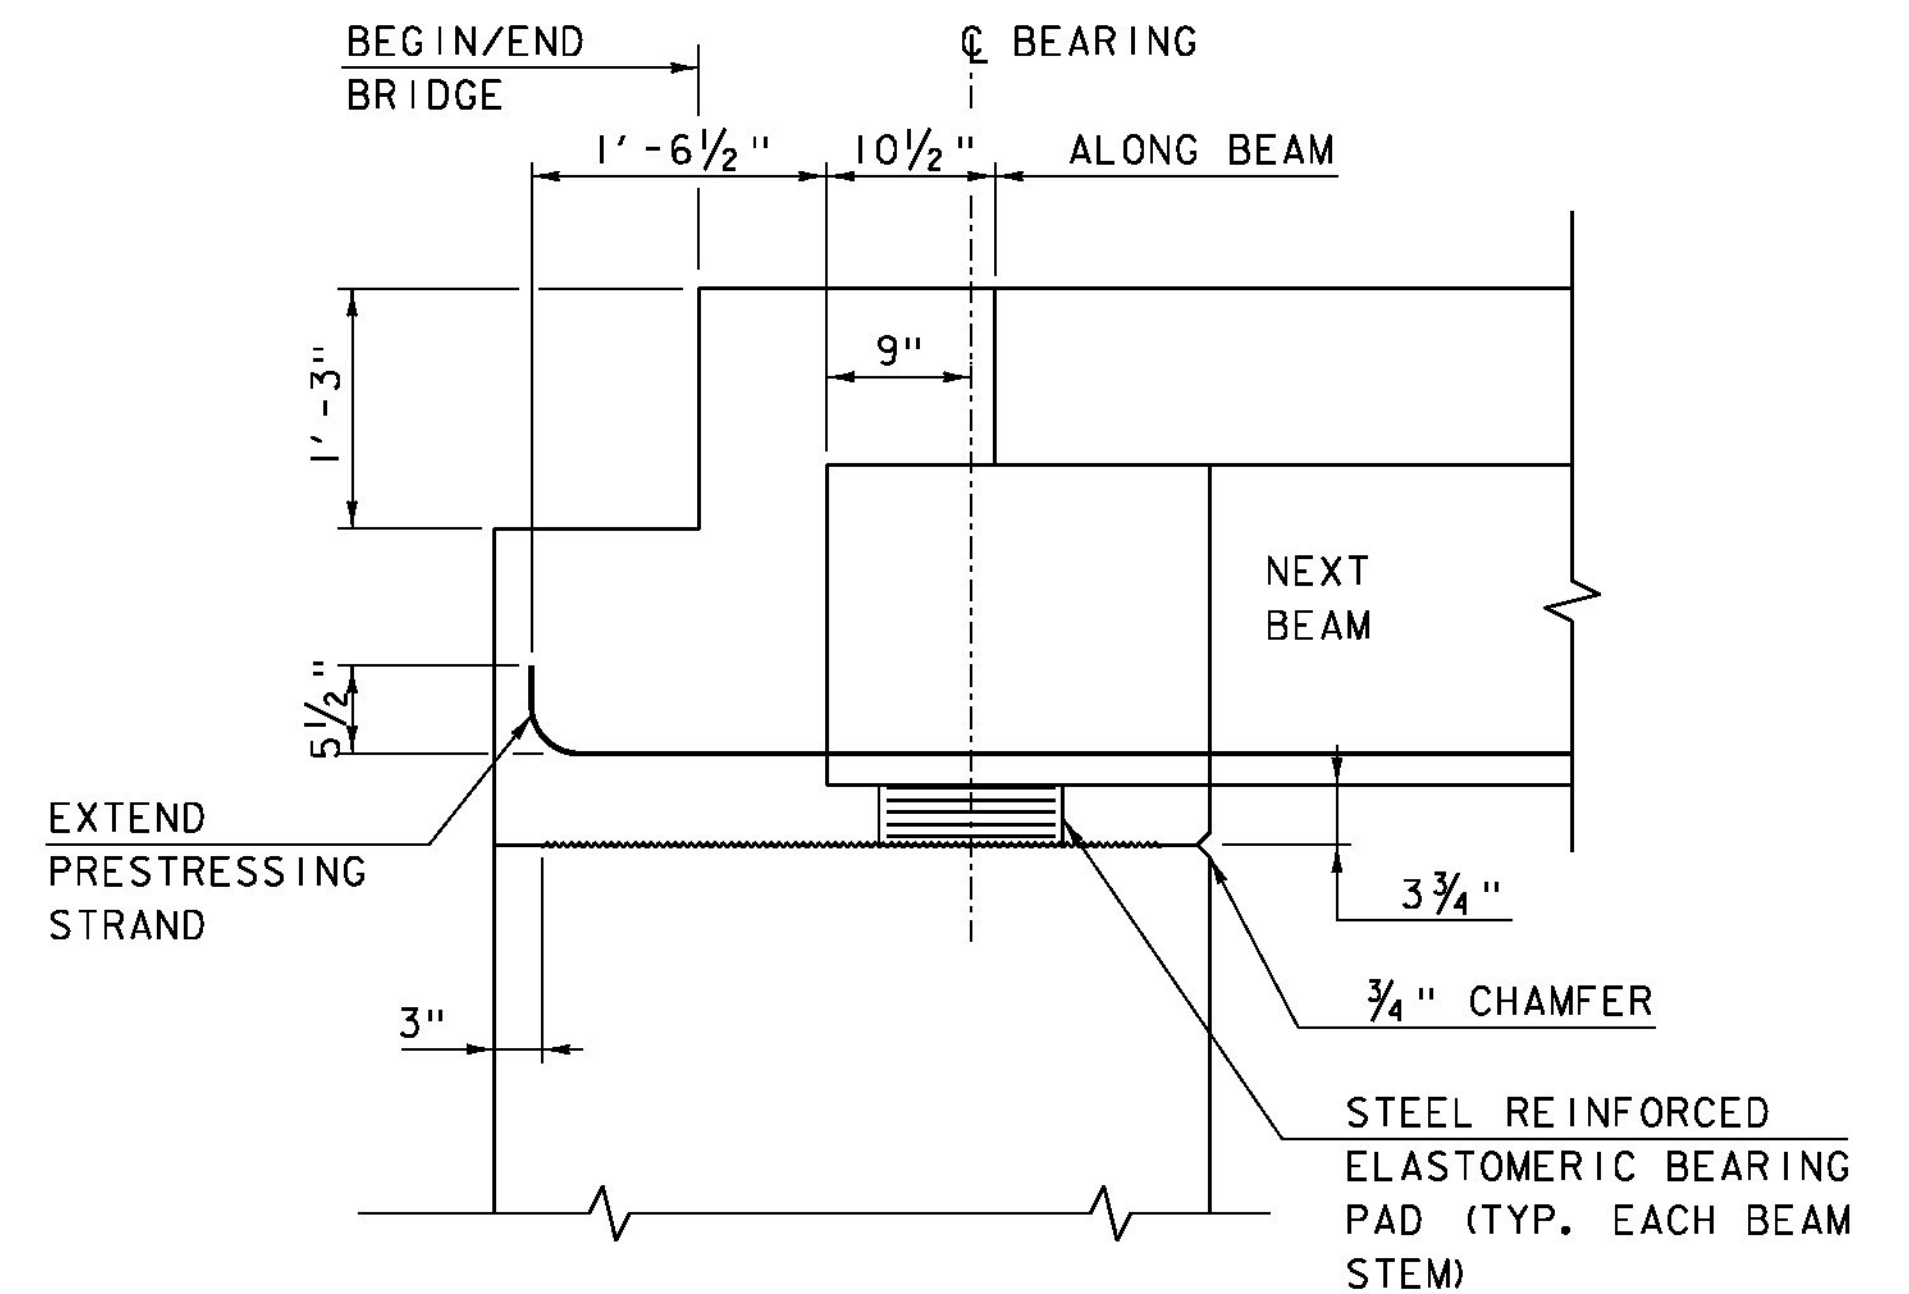

TYPICAL BEAM END DETAIL
SCALE: 1" = 1'-0"

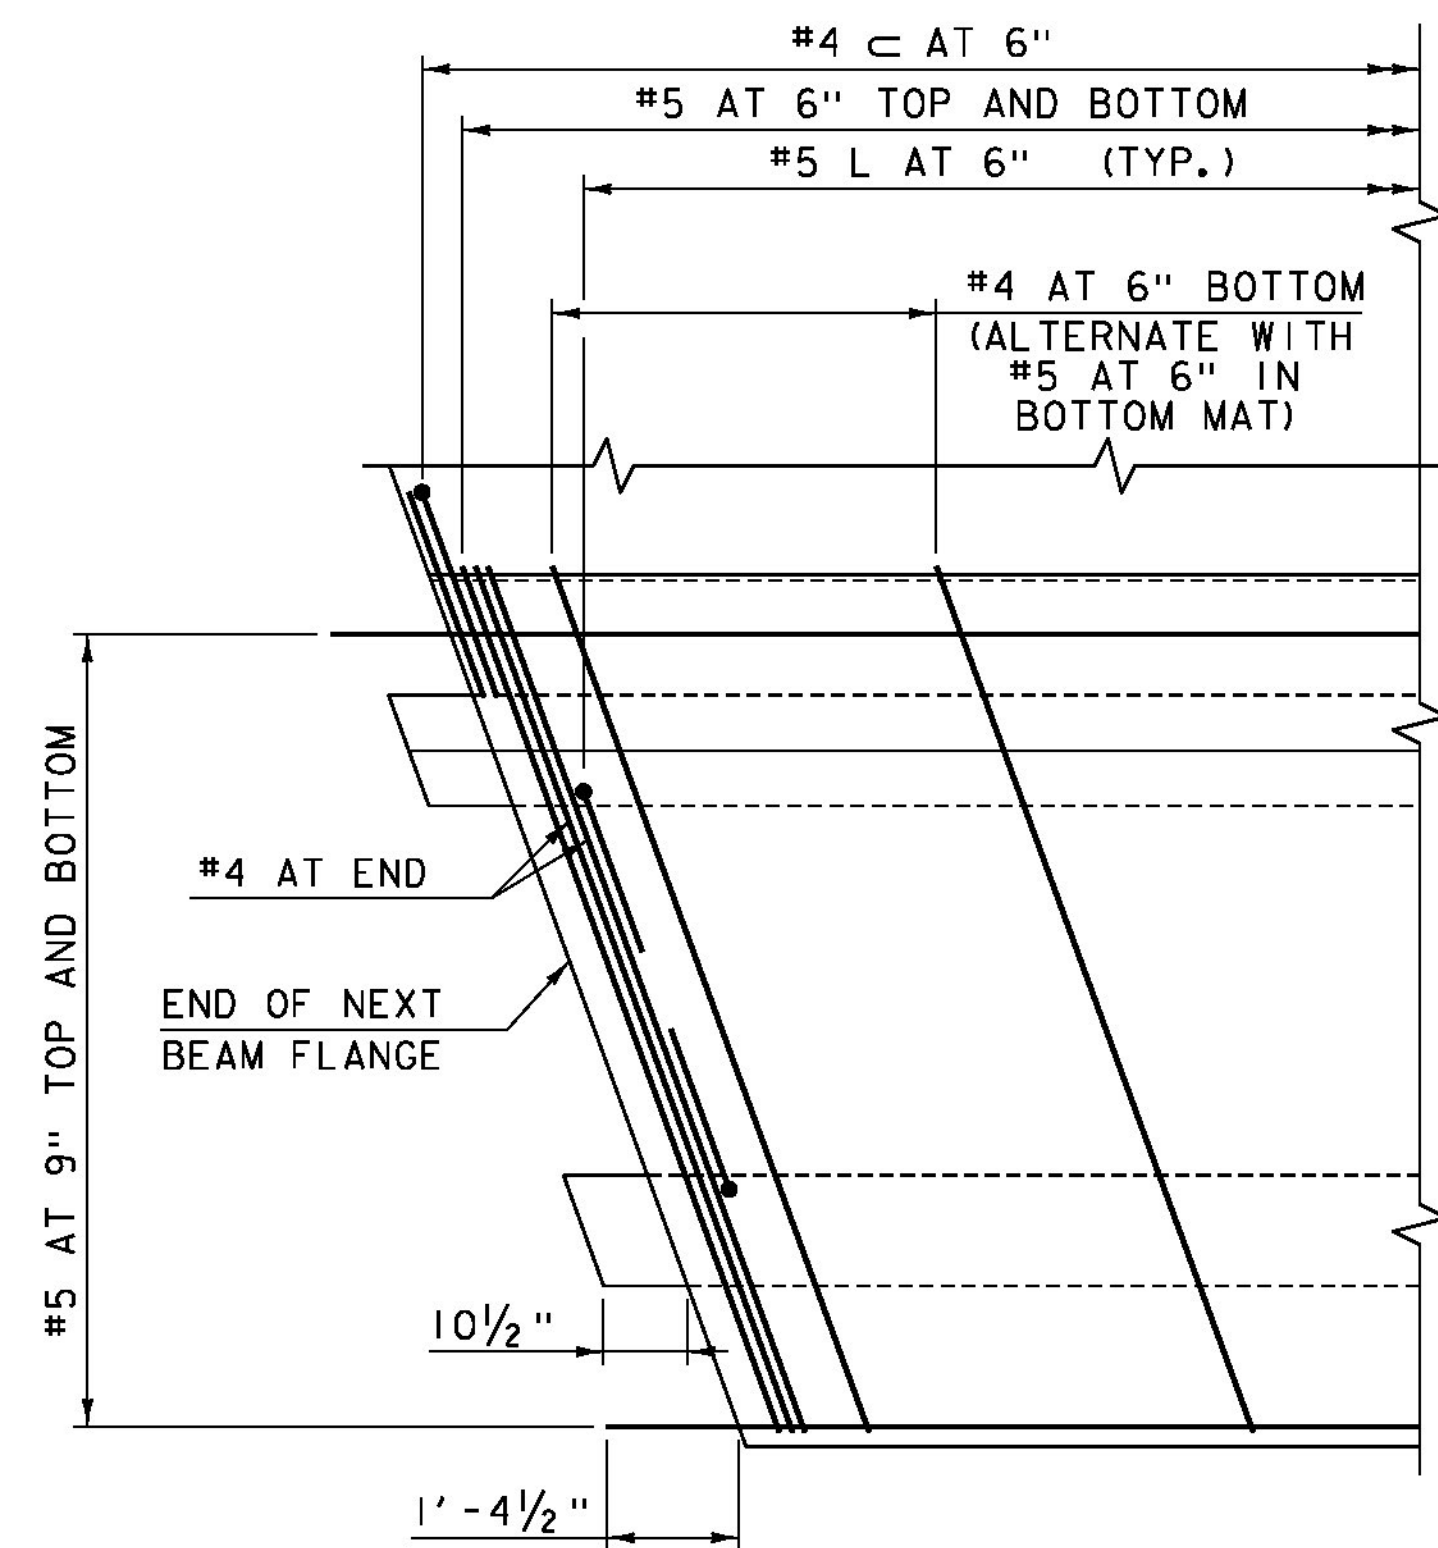

PARTIAL BEAM FLANGE PLAN
SCALE: 1/2" = 1'-0"

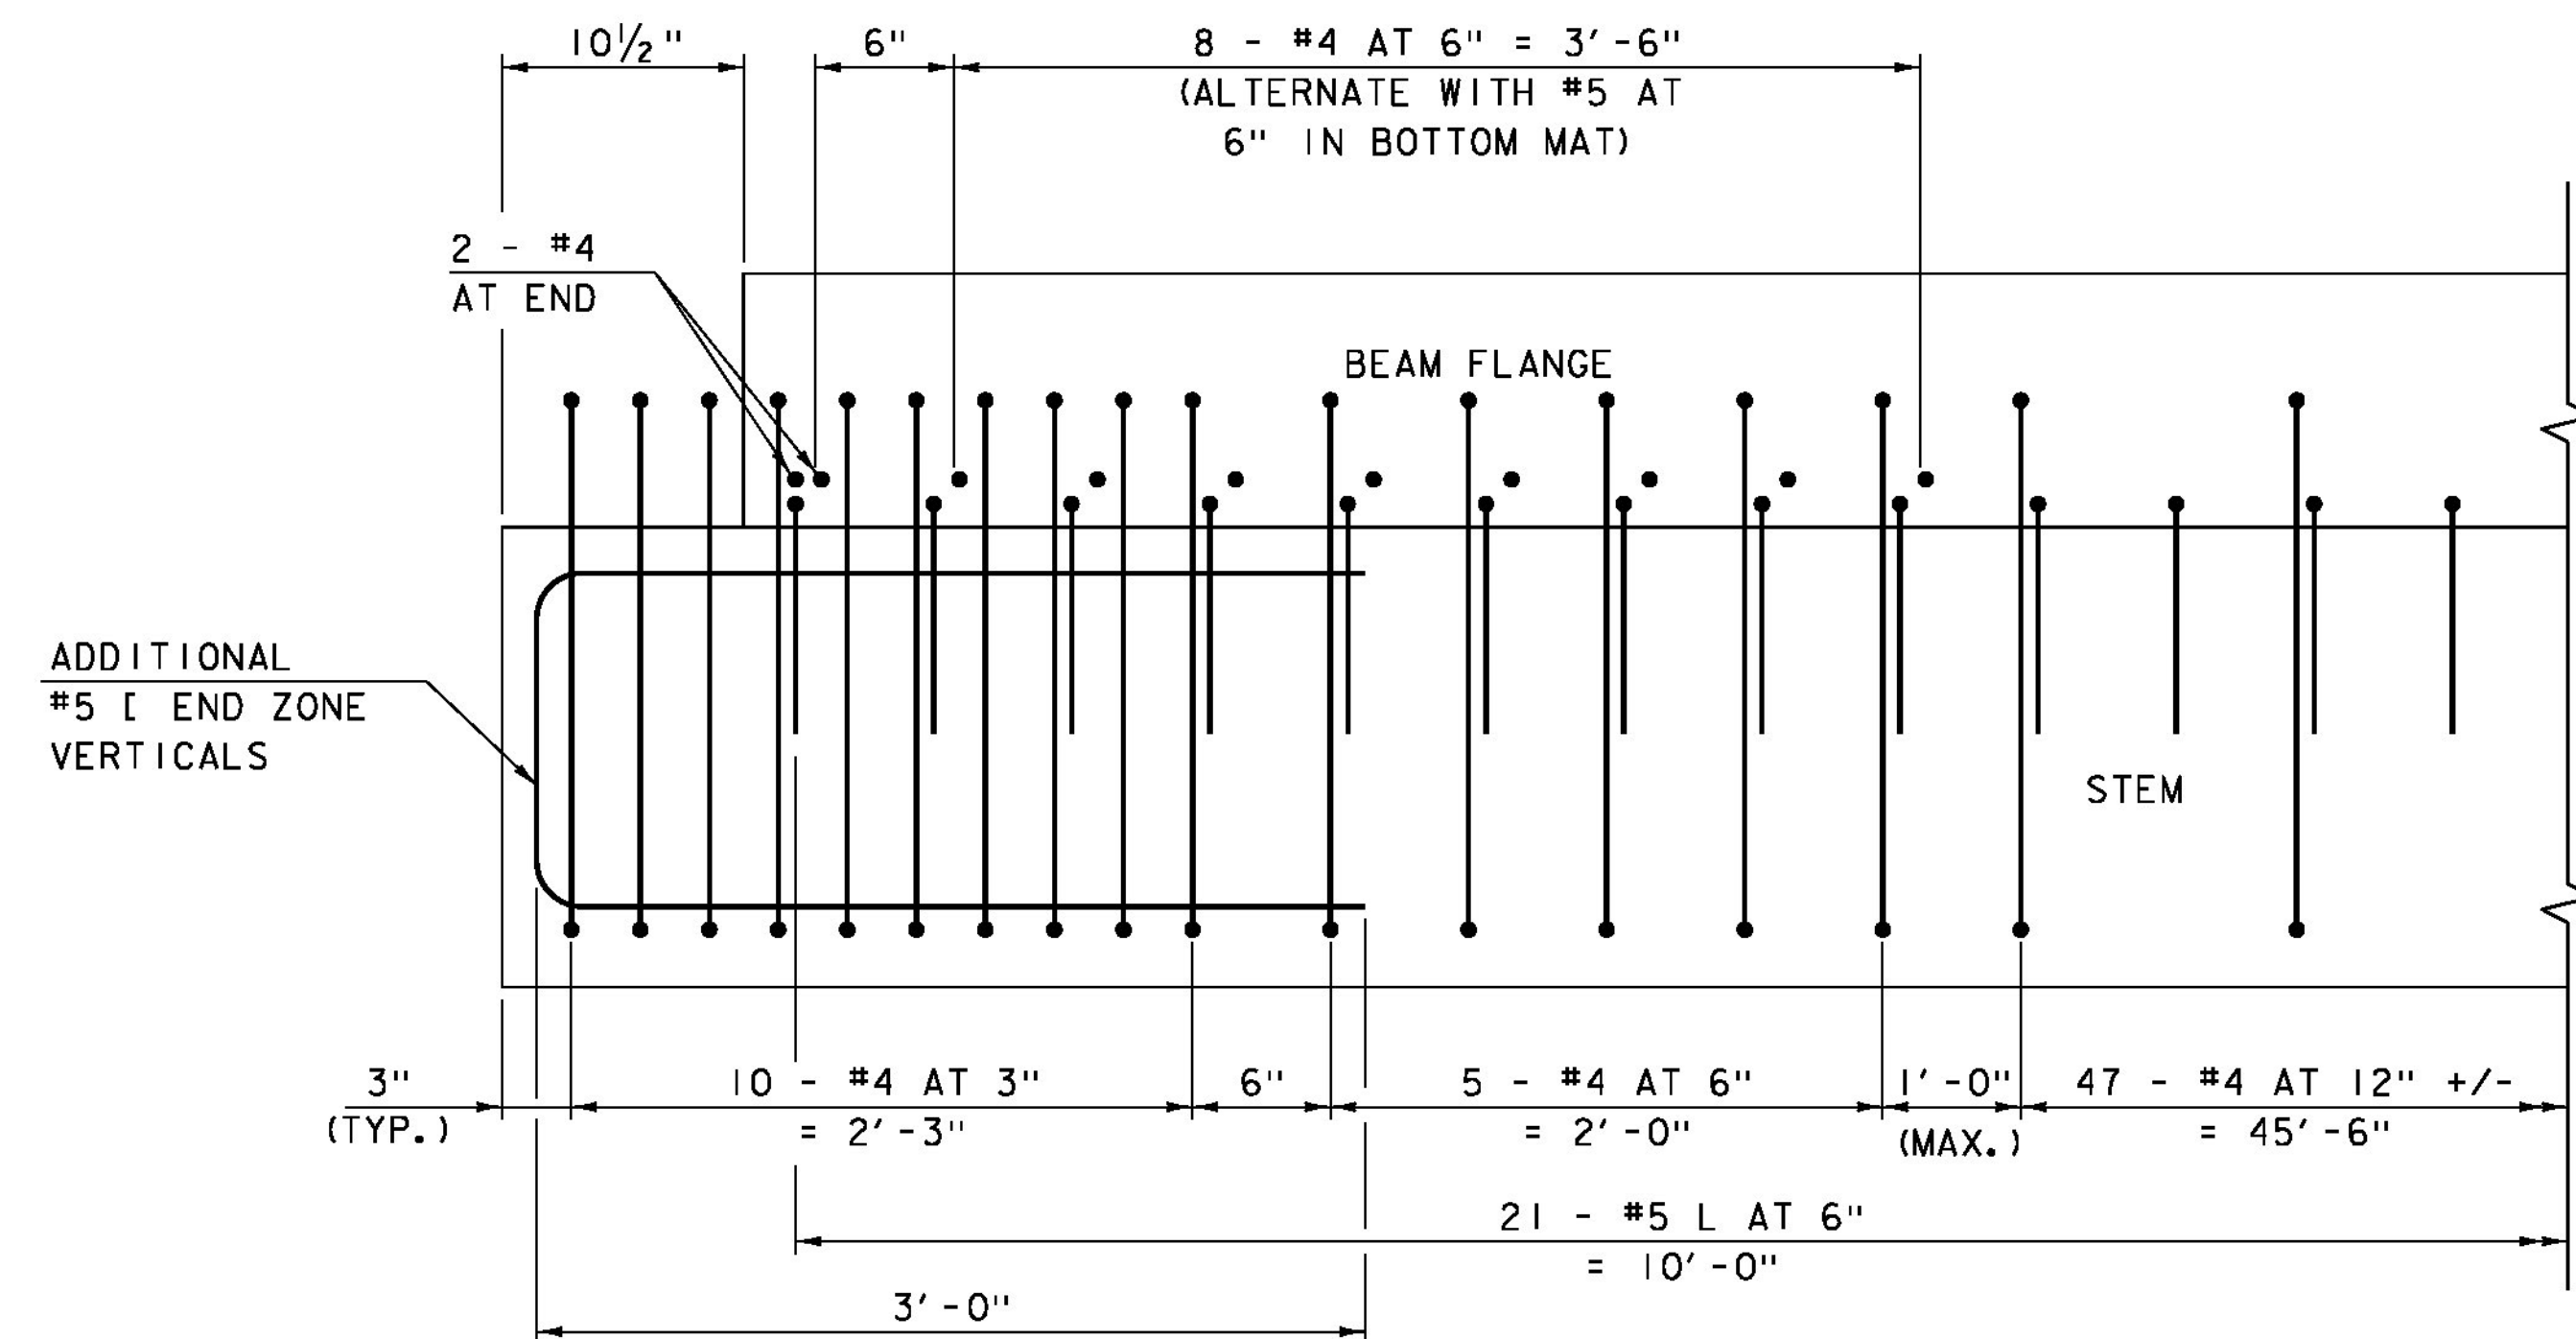

LONGITUDINAL SECTION
SCALE: 1 1/2" = 1'-0"

PROJECT NAME: BURKE
PROJECT NUMBER: BRF 0269(I3)
FILE NAME: z10c412sup.dgn
PROJECT LEADER: J. BYATT
DESIGNED BY: S. BEAUMONT
NEXT BEAM DETAILS (5 OF 5)

PLOT DATE: 10/14/2014
DRAWN BY: M. SMITH
CHECKED BY: J. BYATT
SHEET 40 OF 73

