




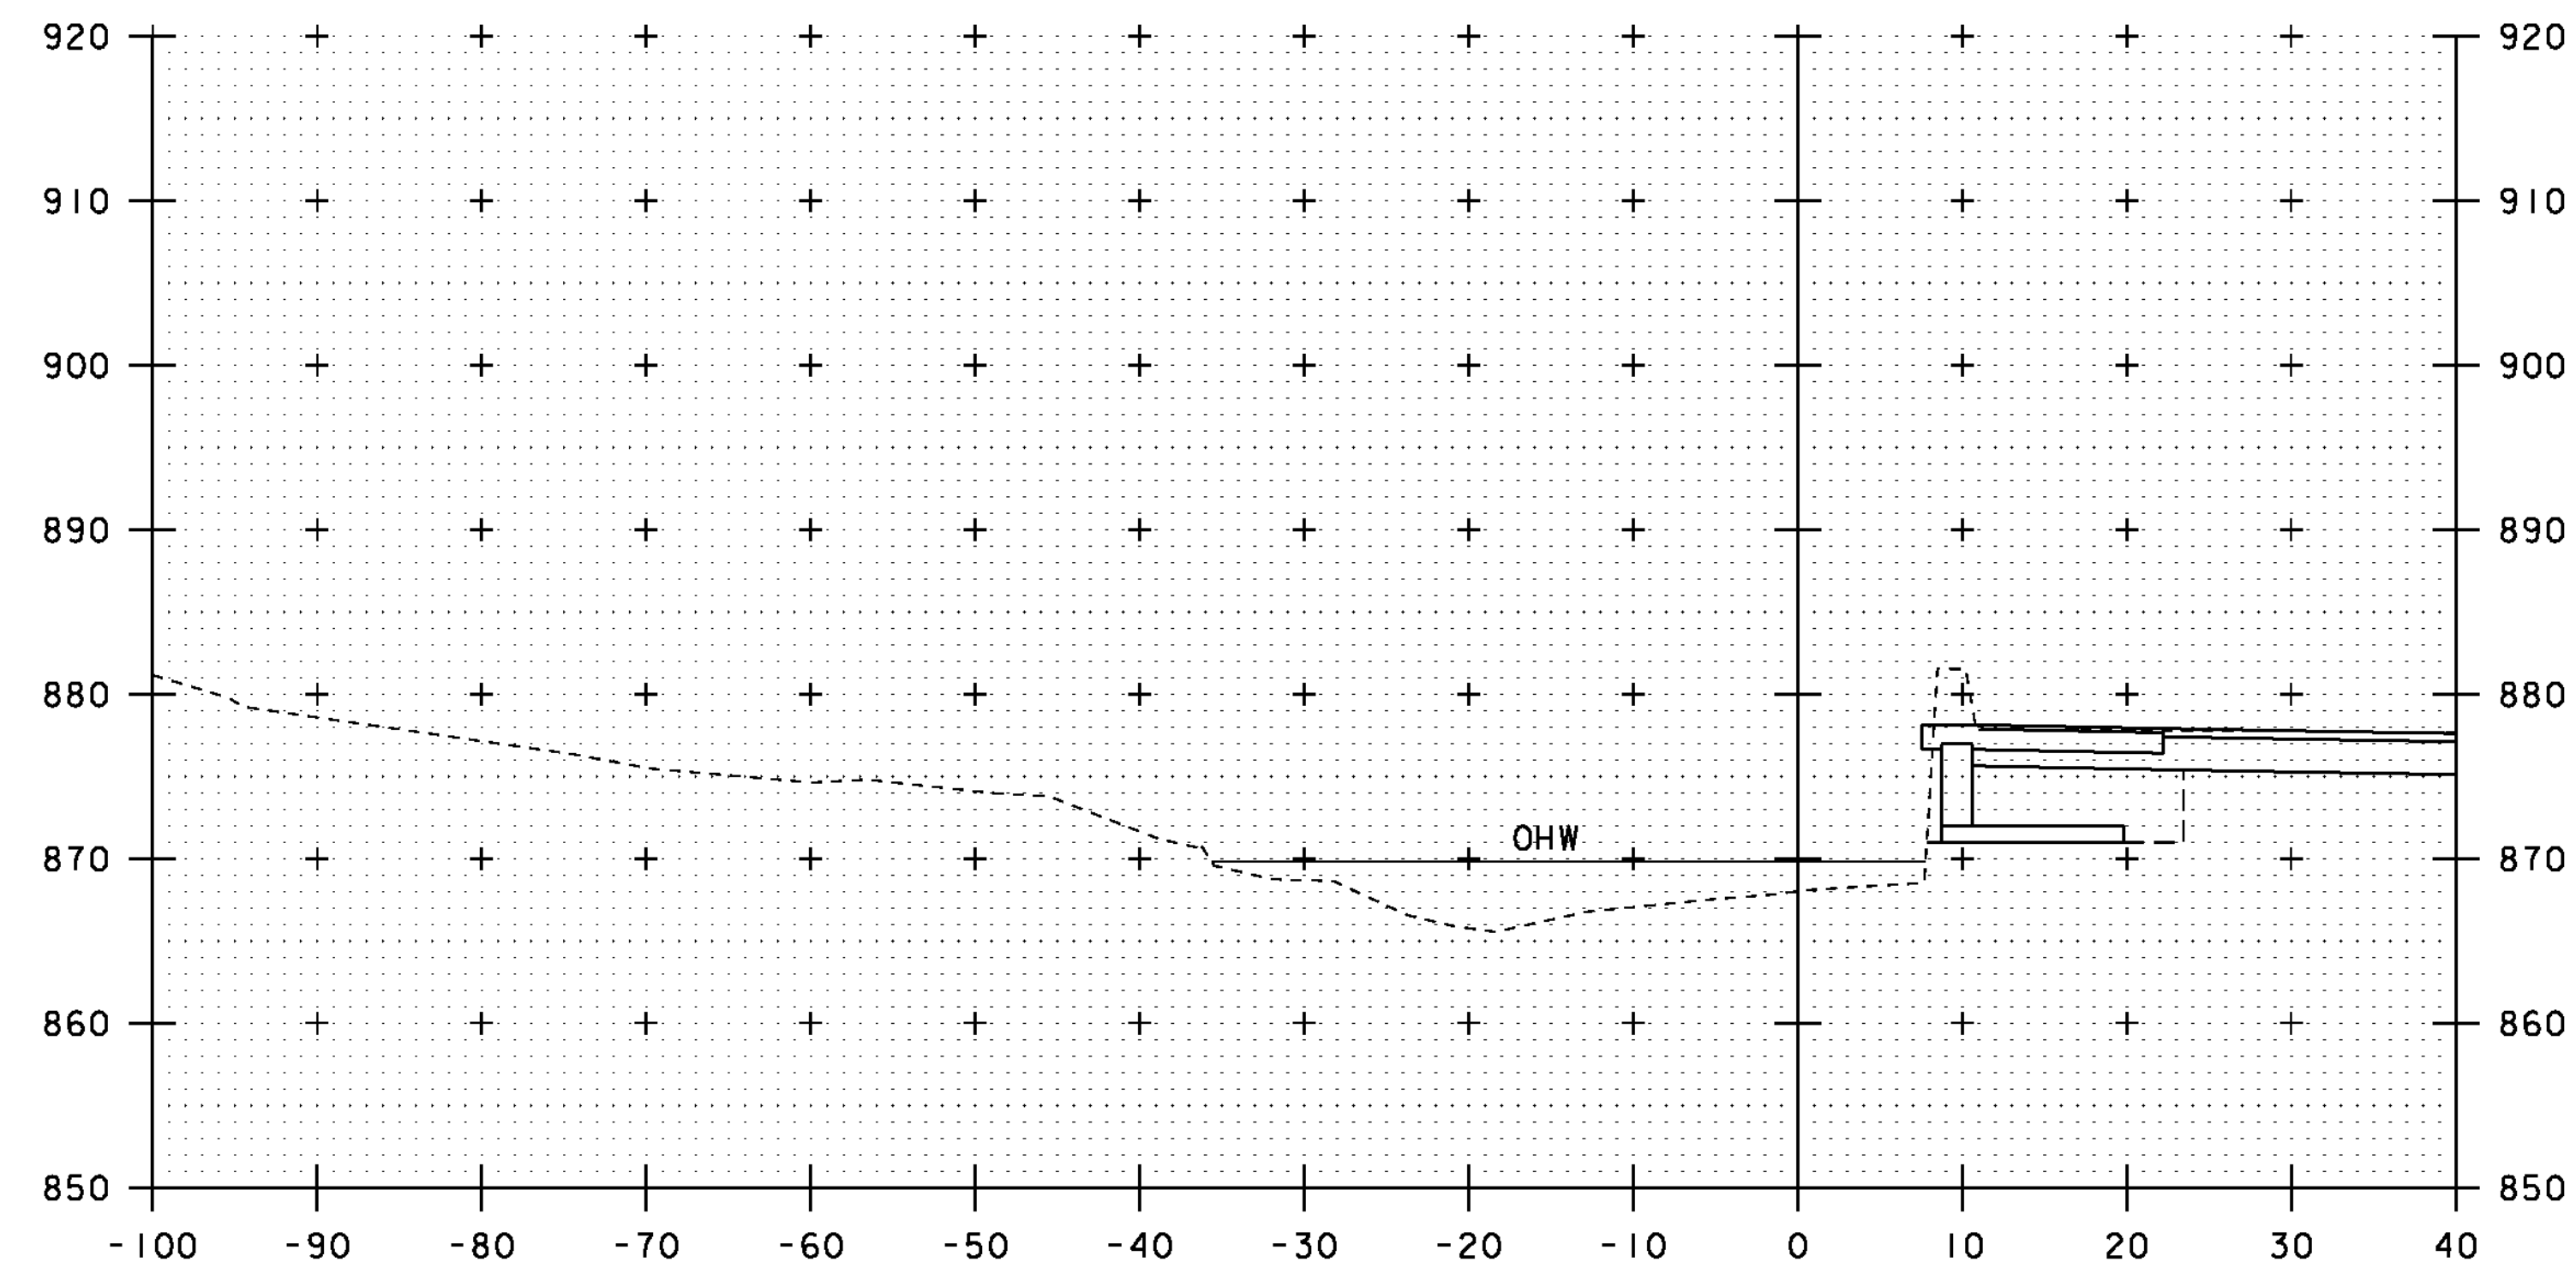


51+20

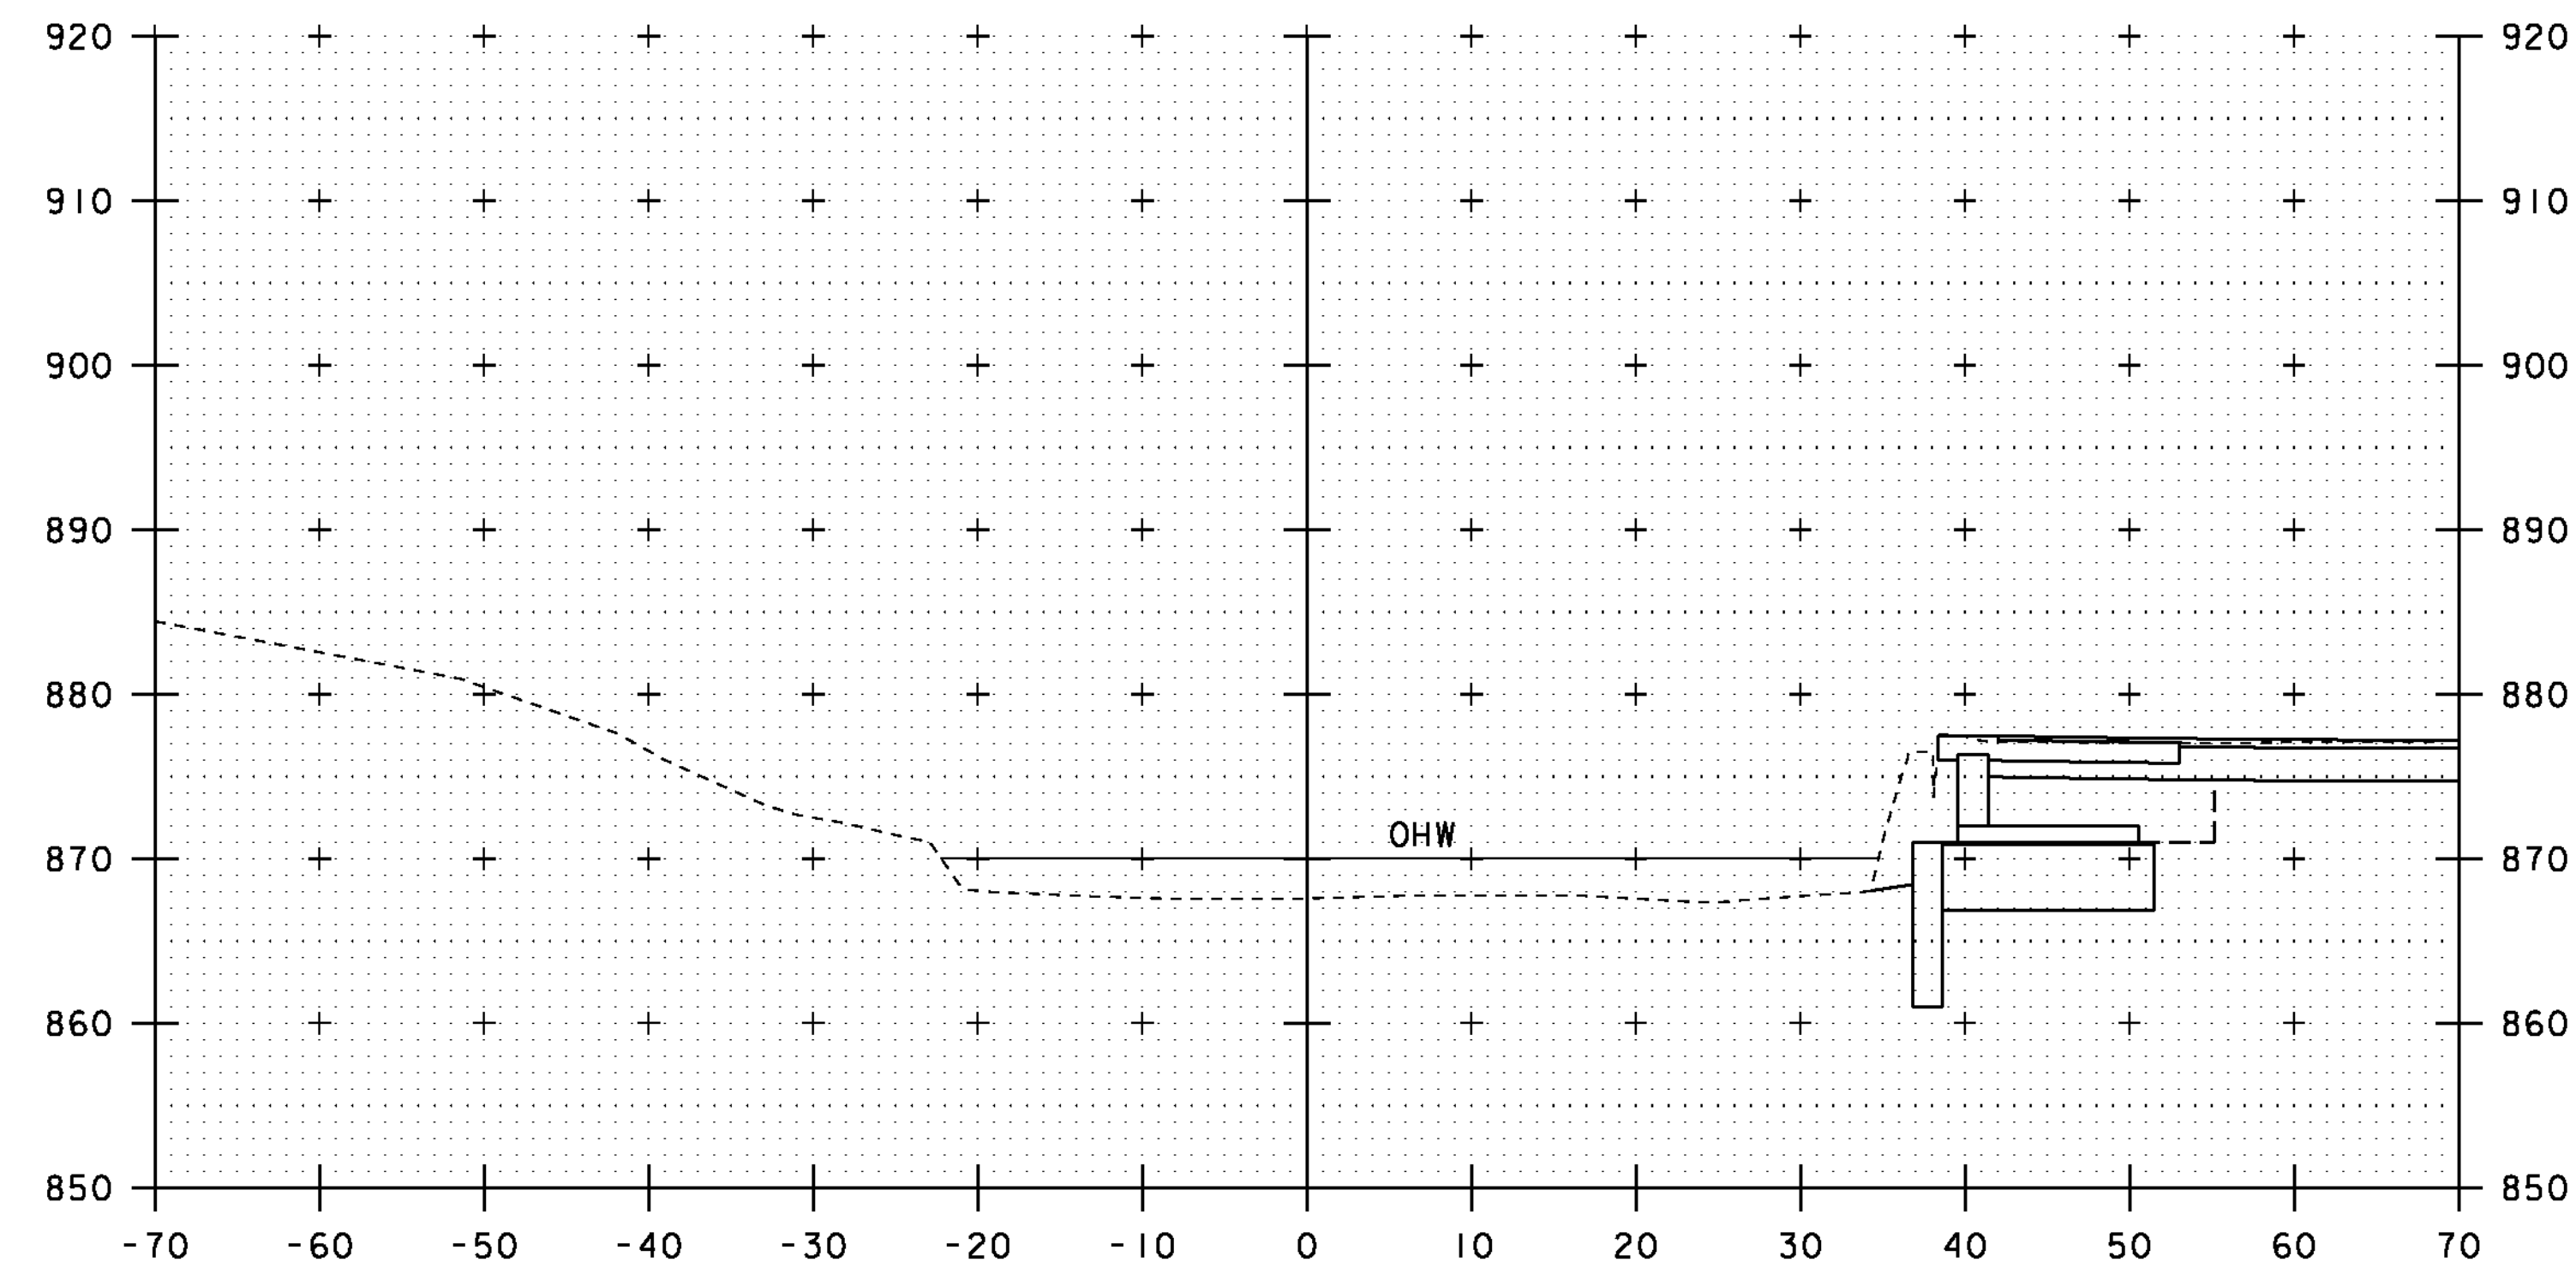

51+40

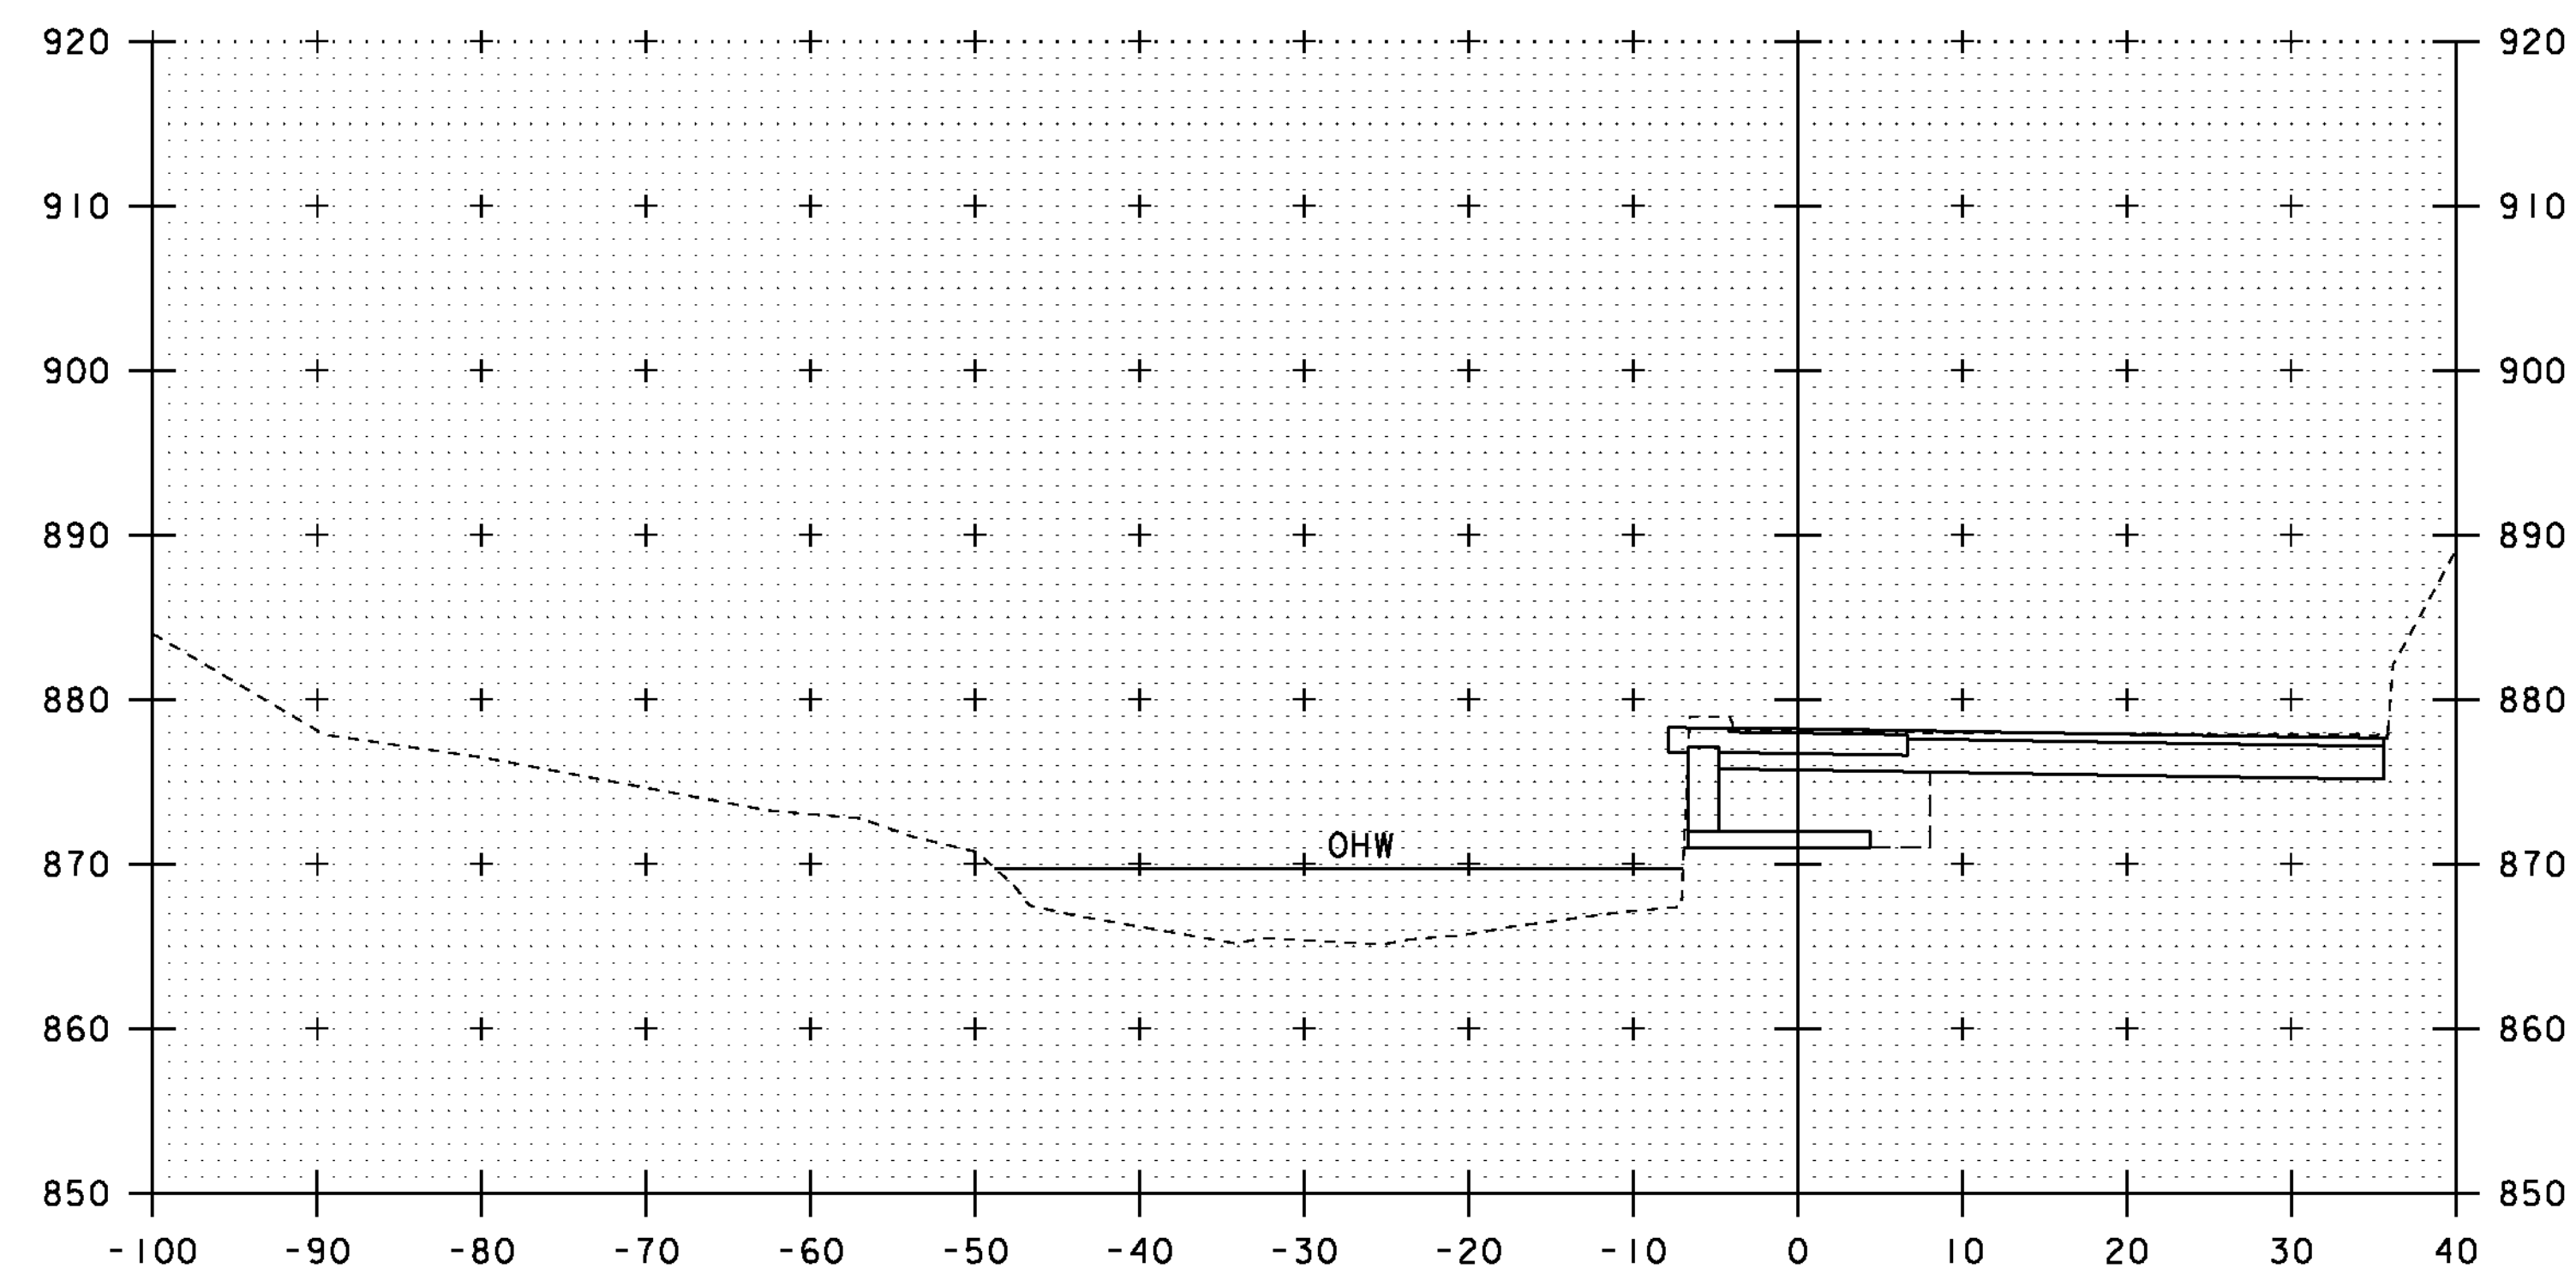

51+10

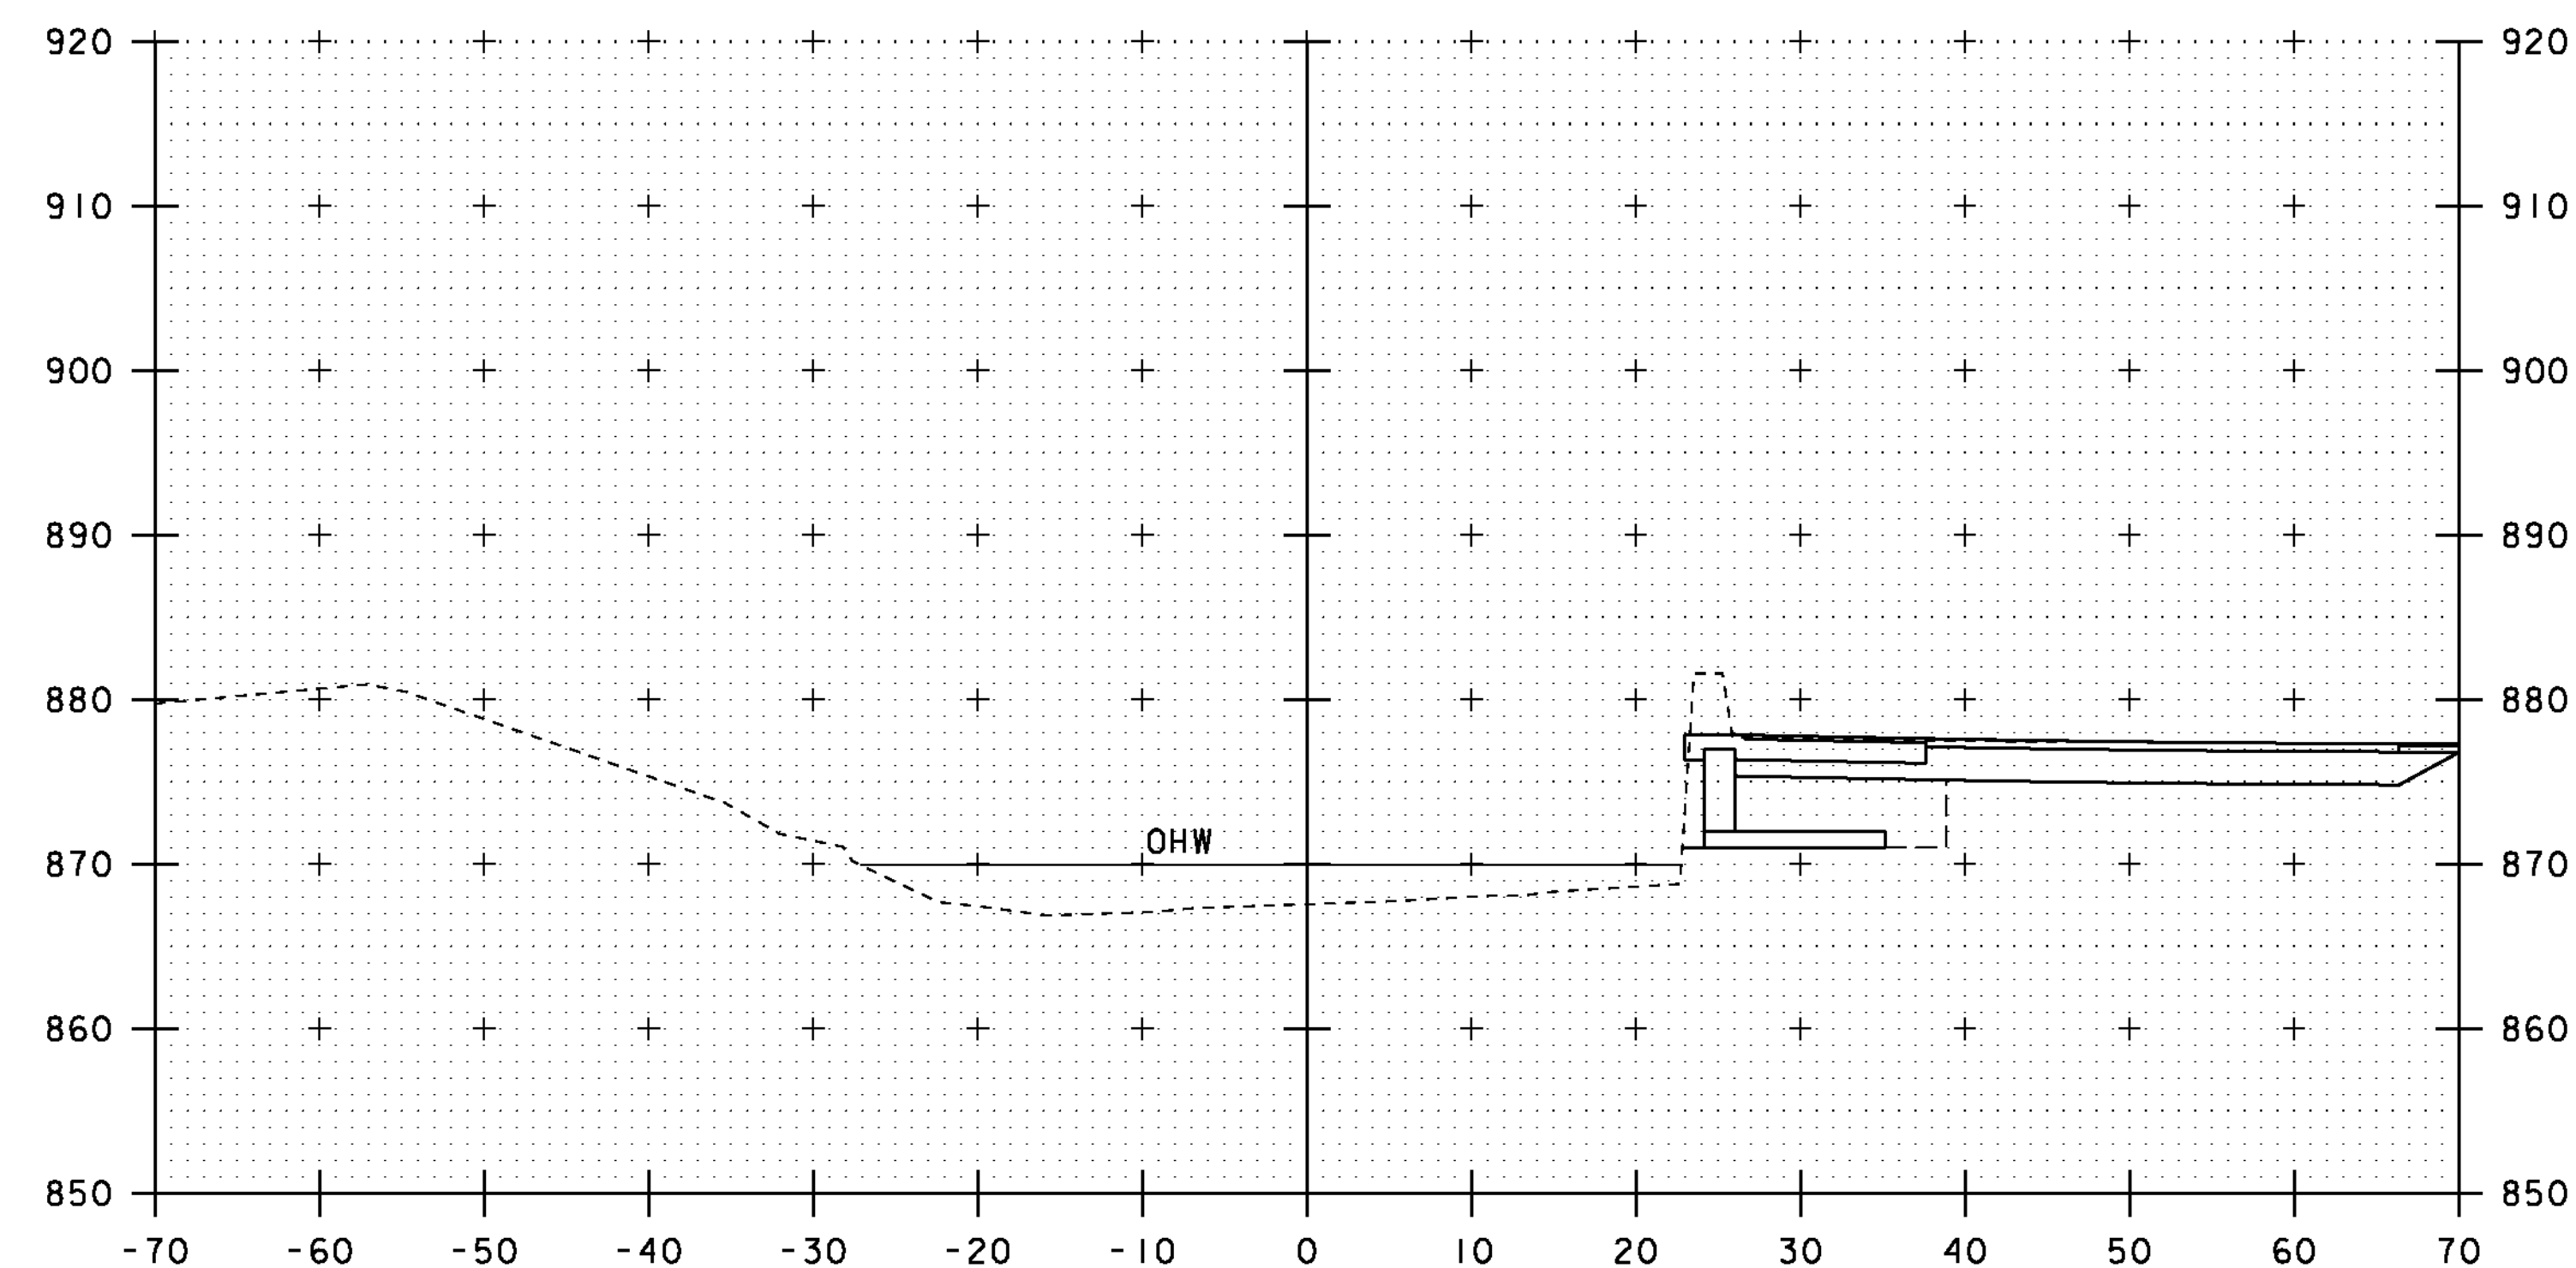

51+30

10 0 10
SCALE: 1" = 10'-0"

STA. 51+10 TO STA. 51+40

PROJECT NAME: ROXBURY	
PROJECT NUMBER: BHF 0187(8)	
FILE NAME: slOc420xsl.dgn	PLOT DATE: 21-SEP-2011
PROJECT LEADER: C. P. WILLIAMS	DRAWN BY: G. ROY
DESIGNED BY: G. ROY	CHECKED BY: T. FILLBACH
CHANNEL LINE CROSS SECTIONS (3)	SHEET 40 OF 54