
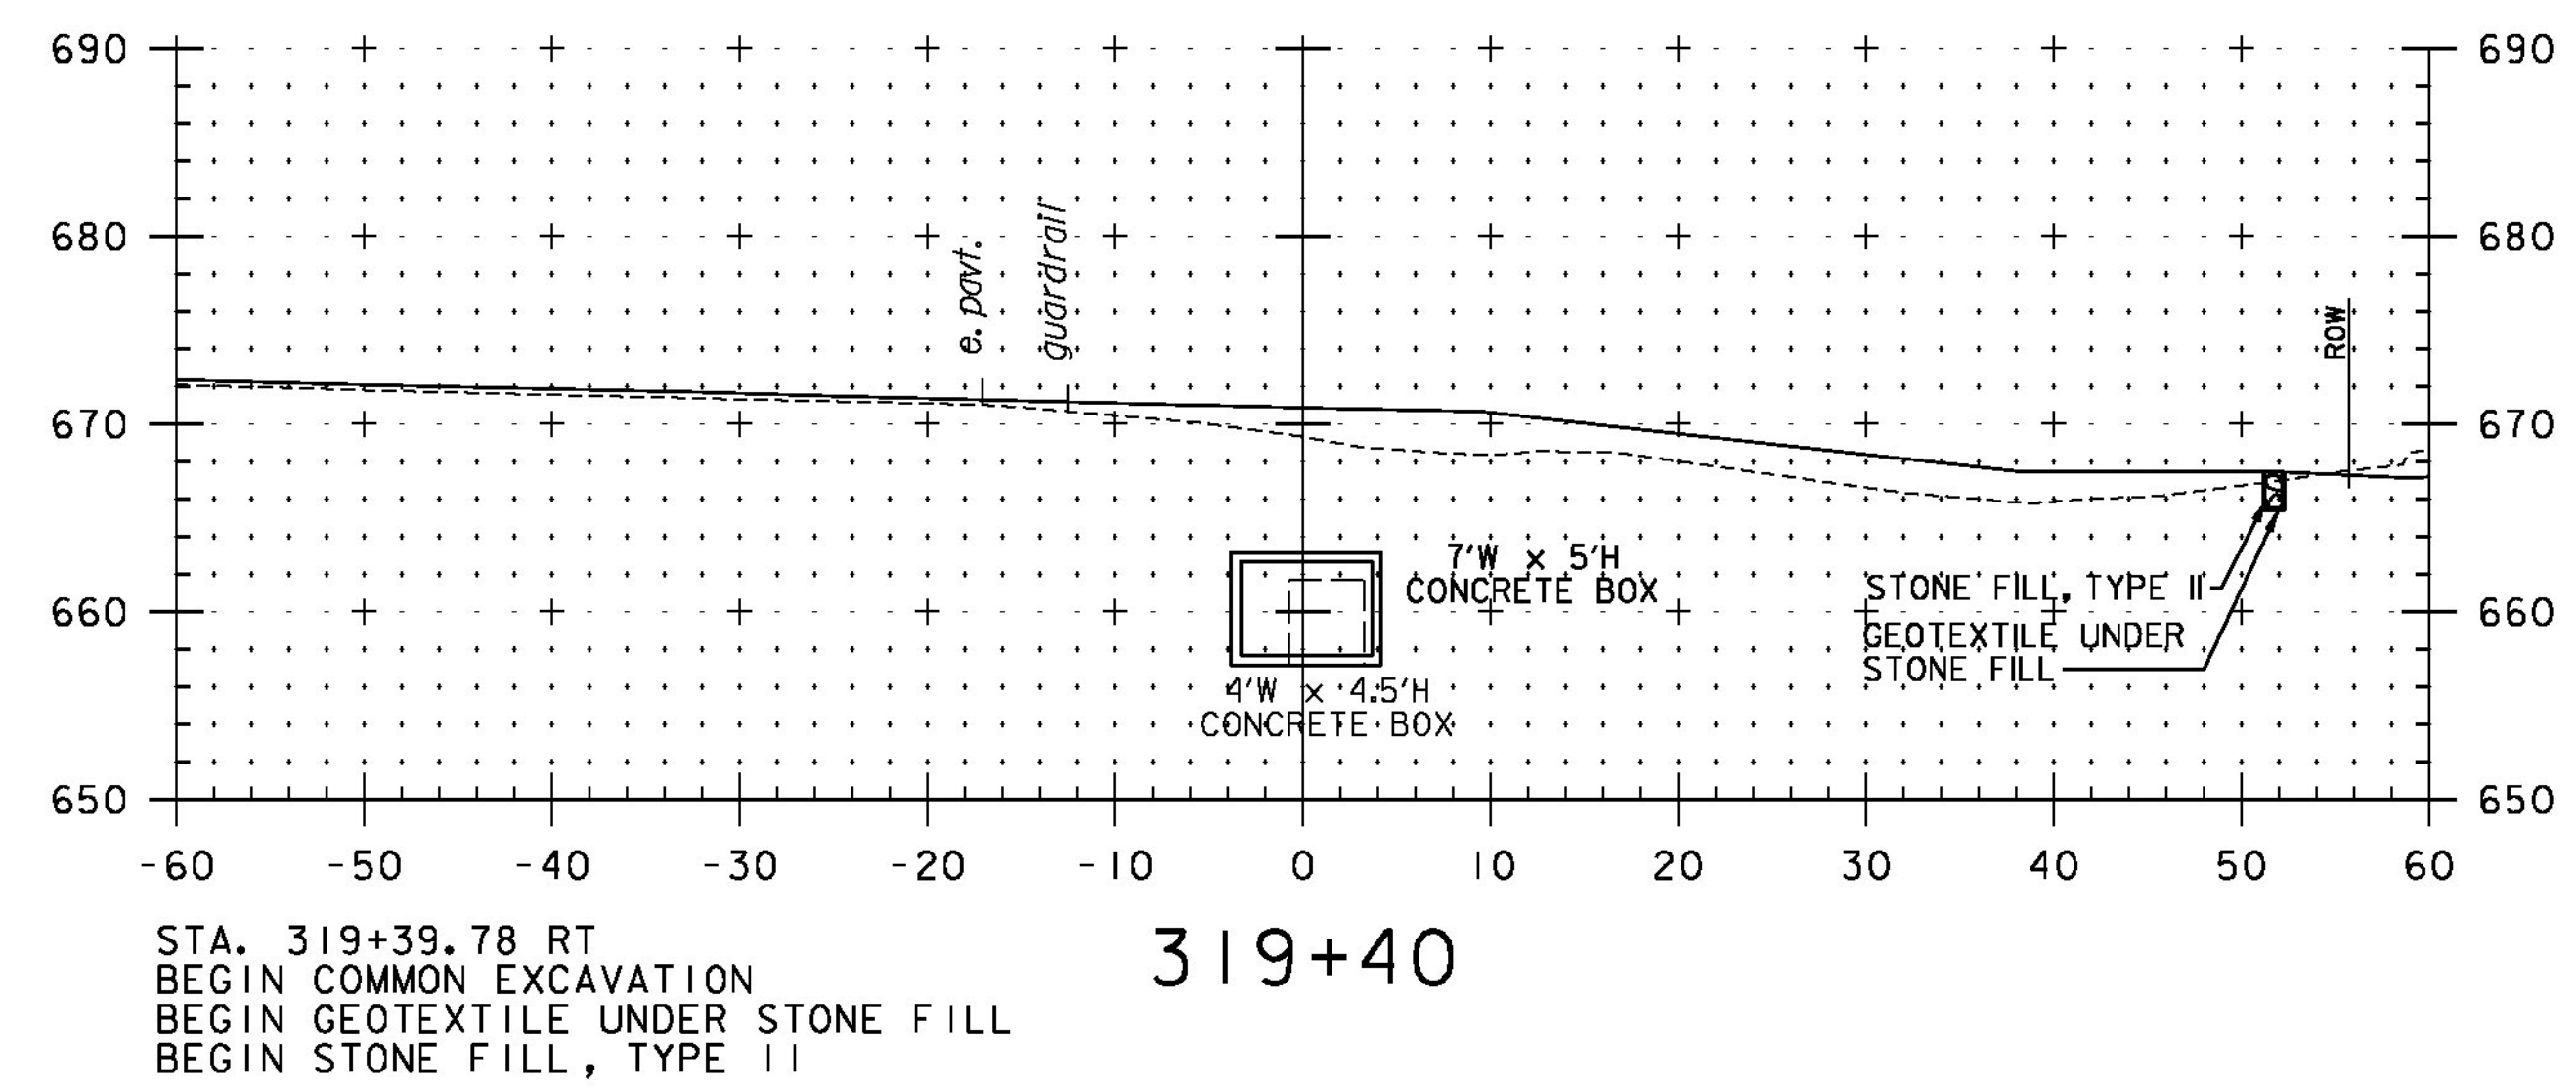
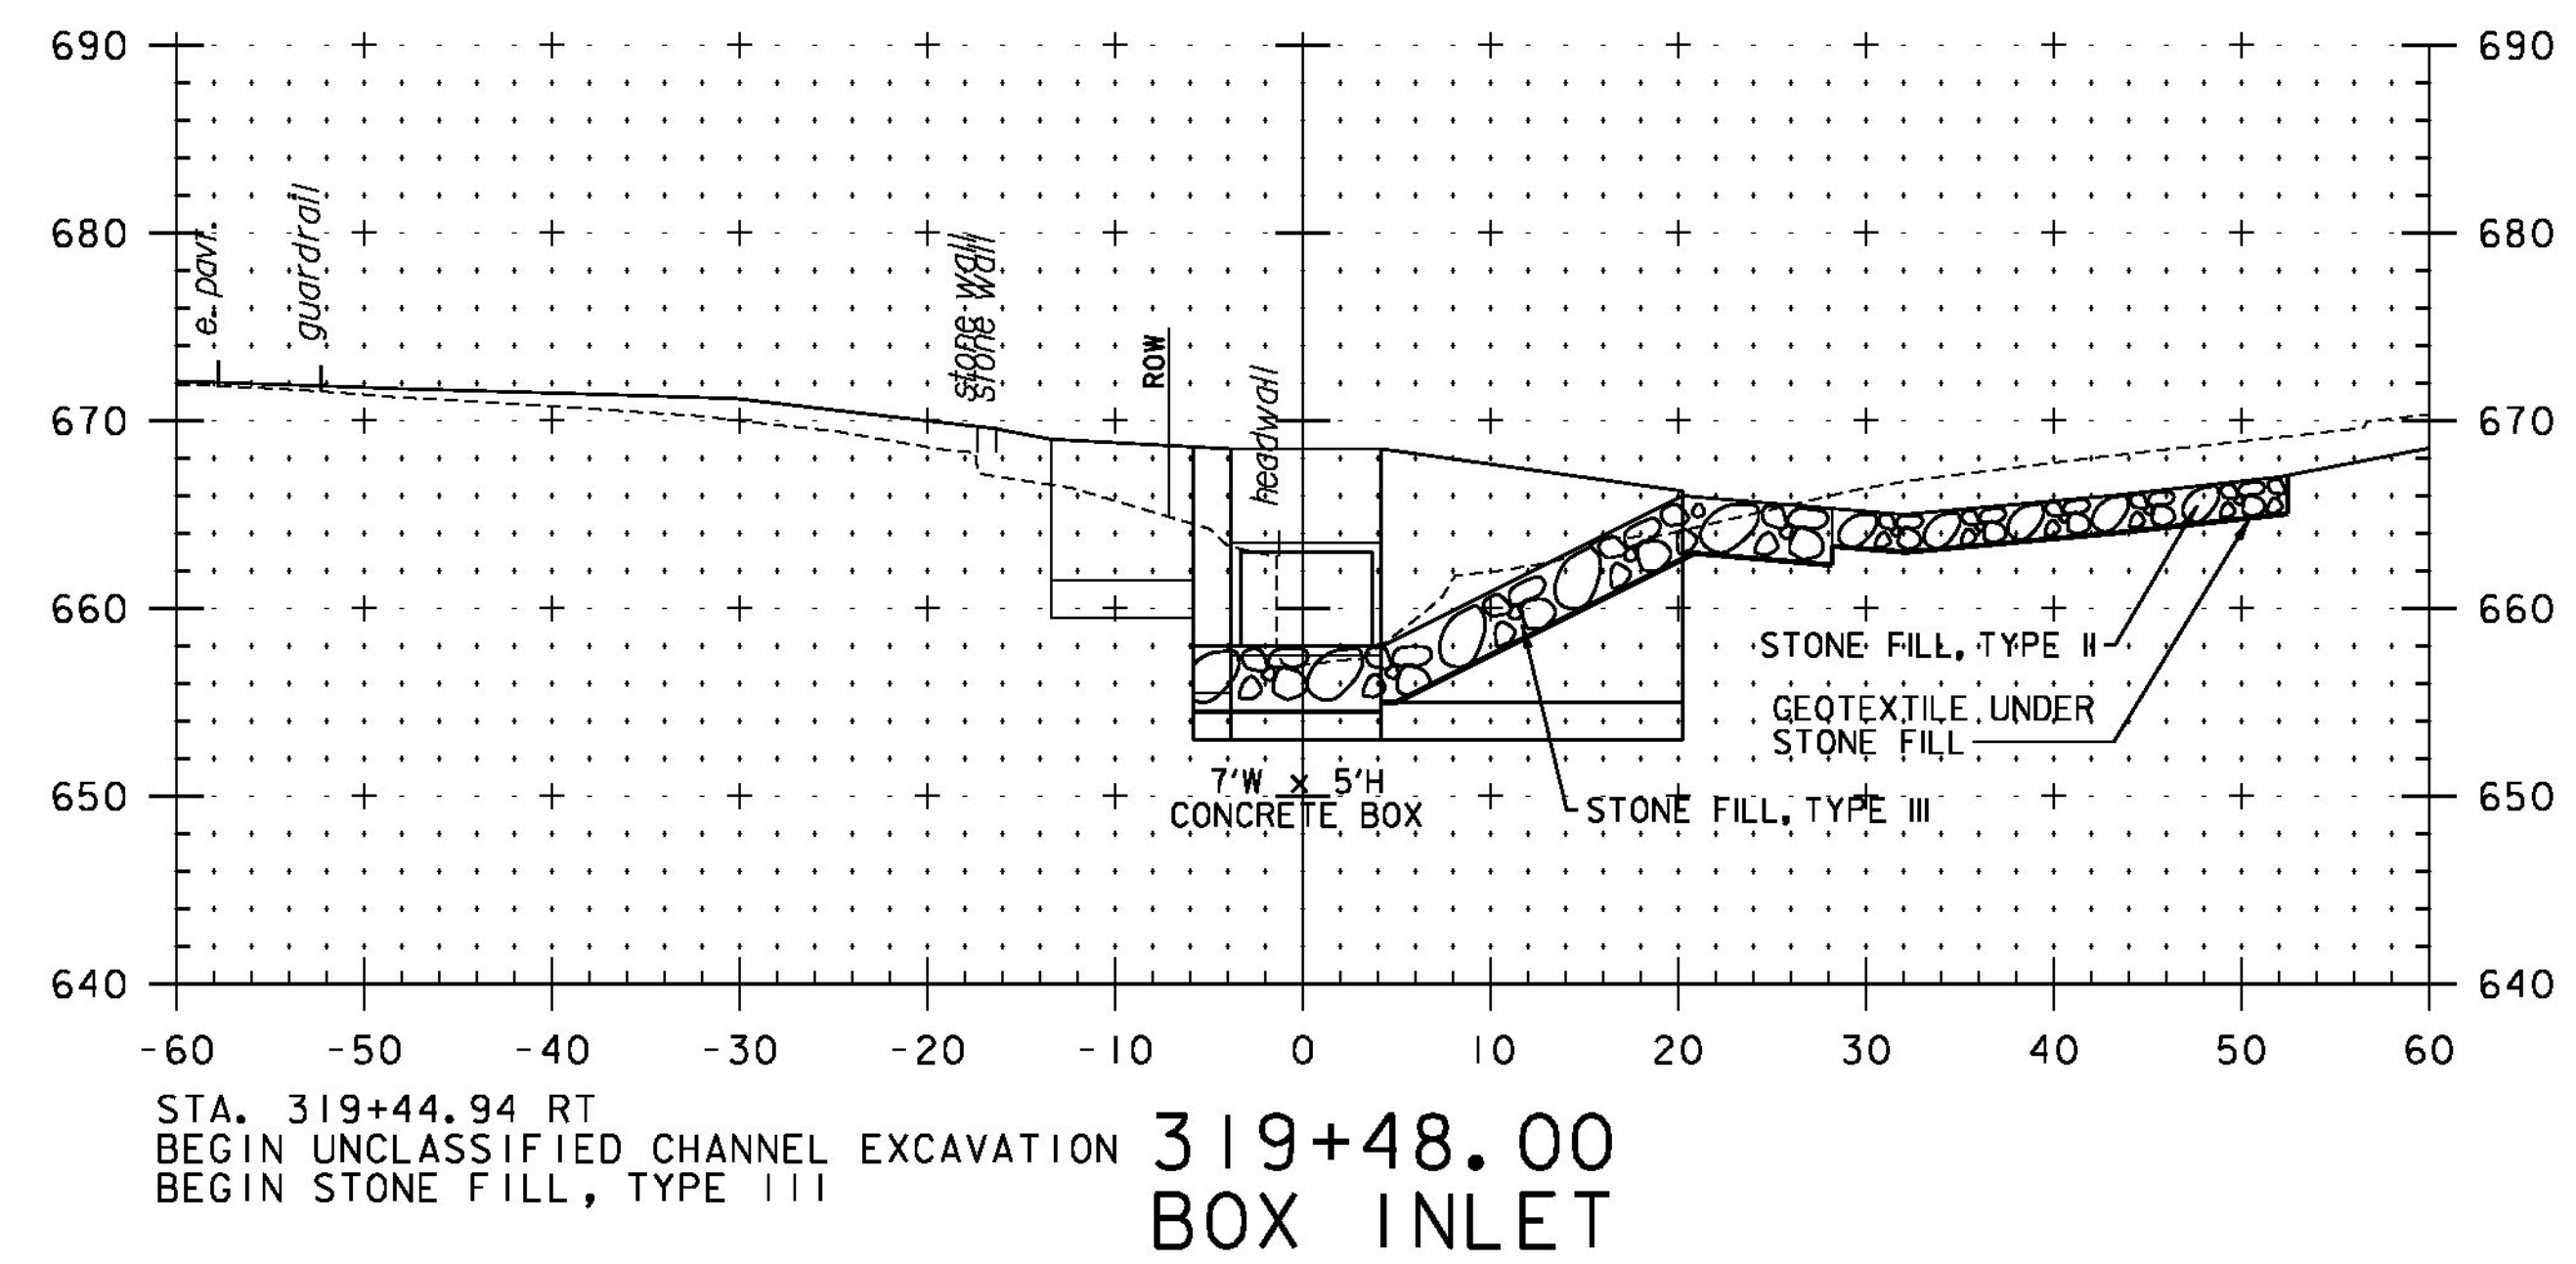
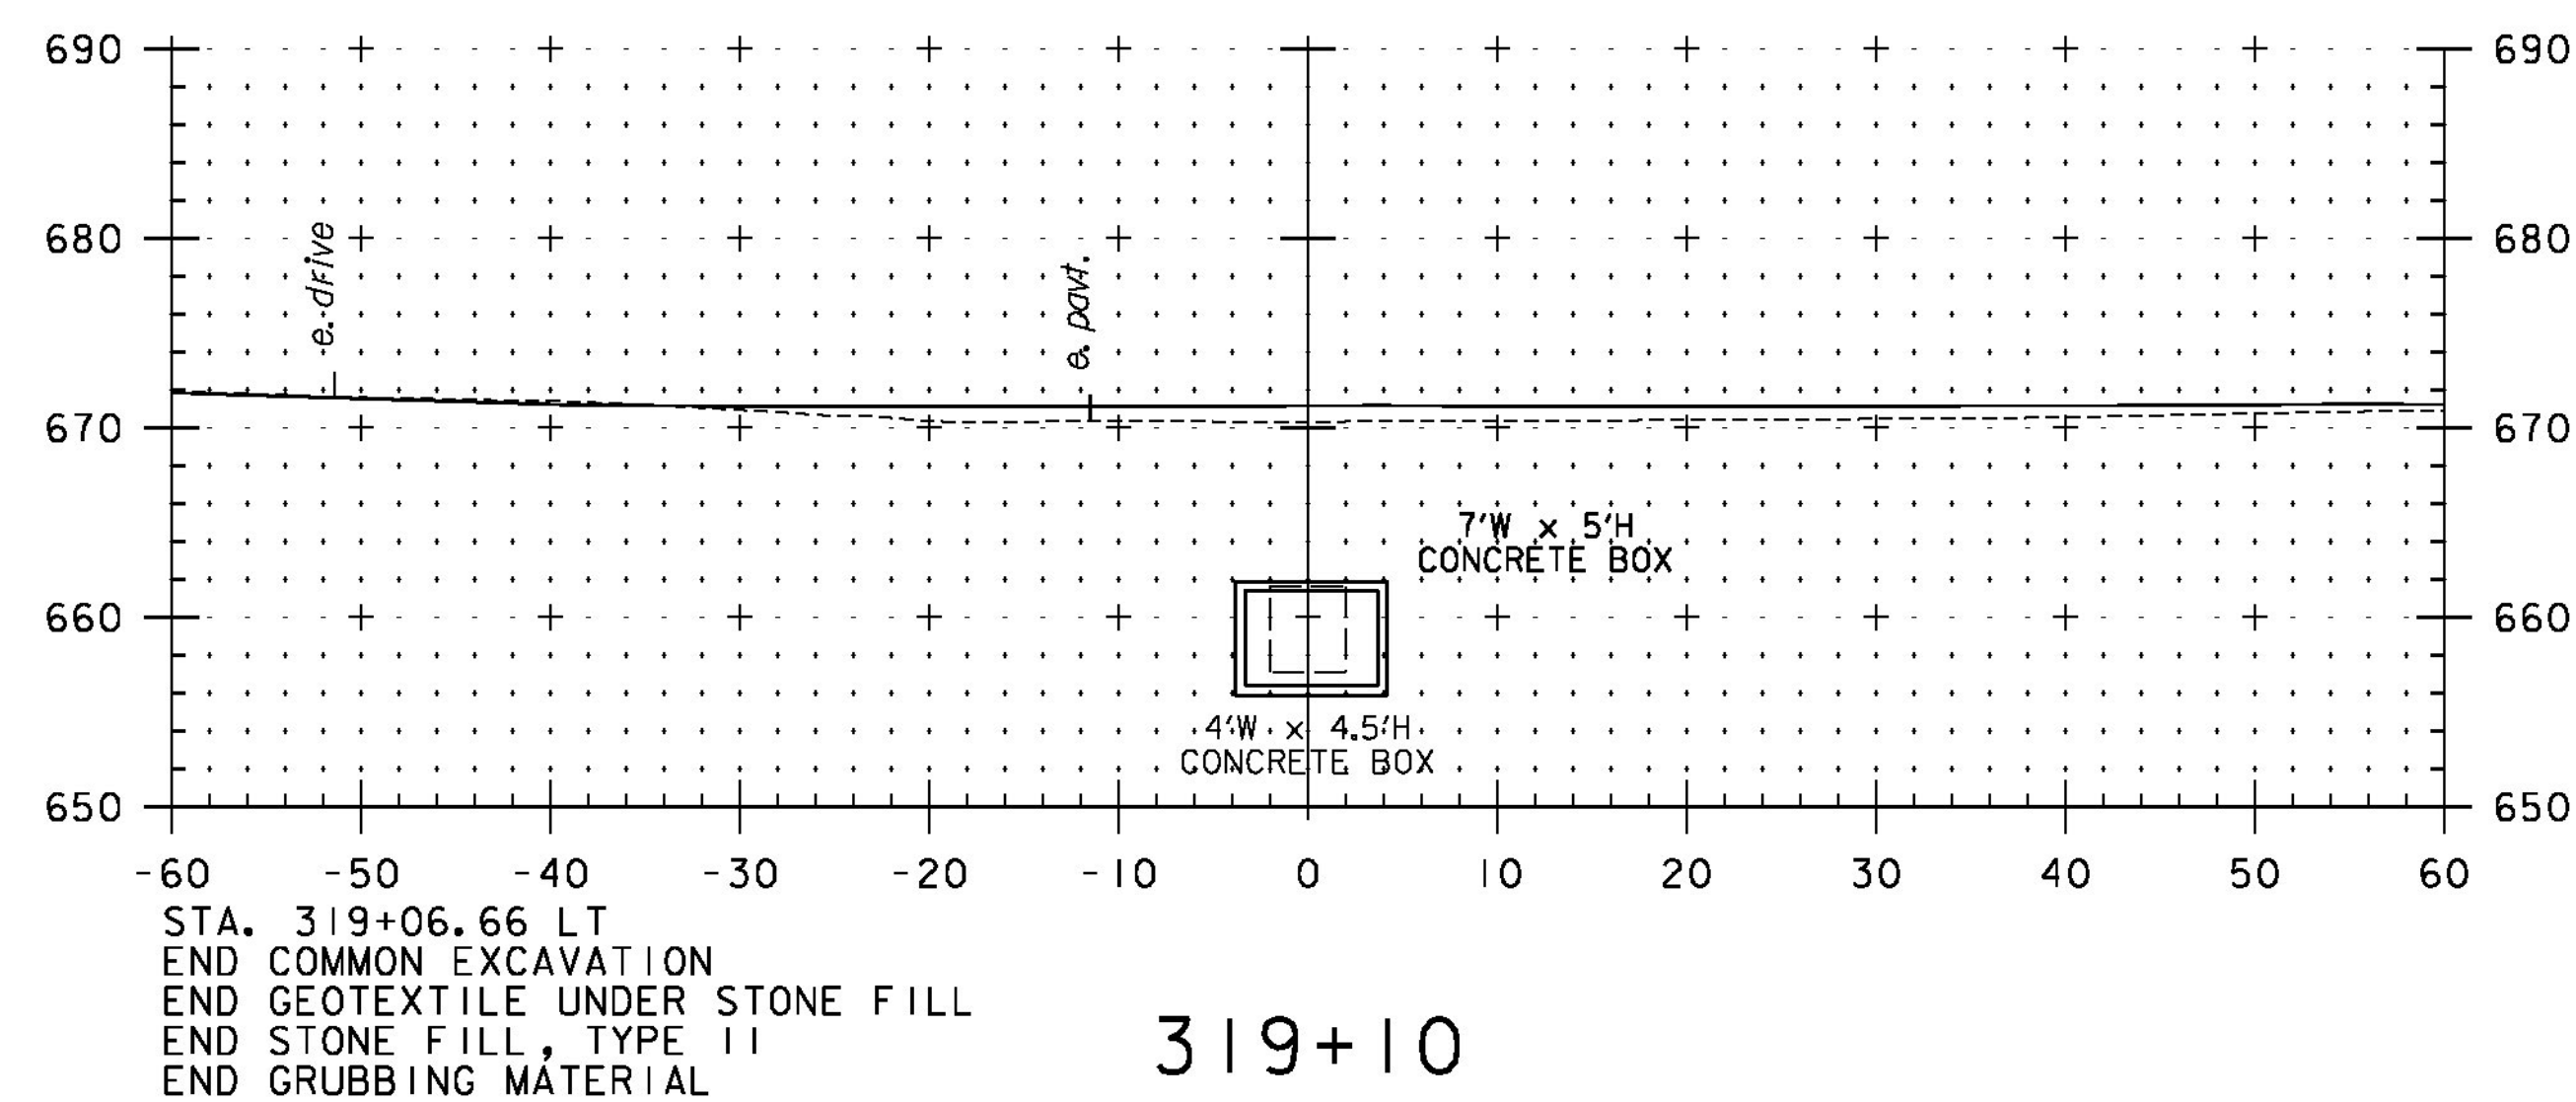
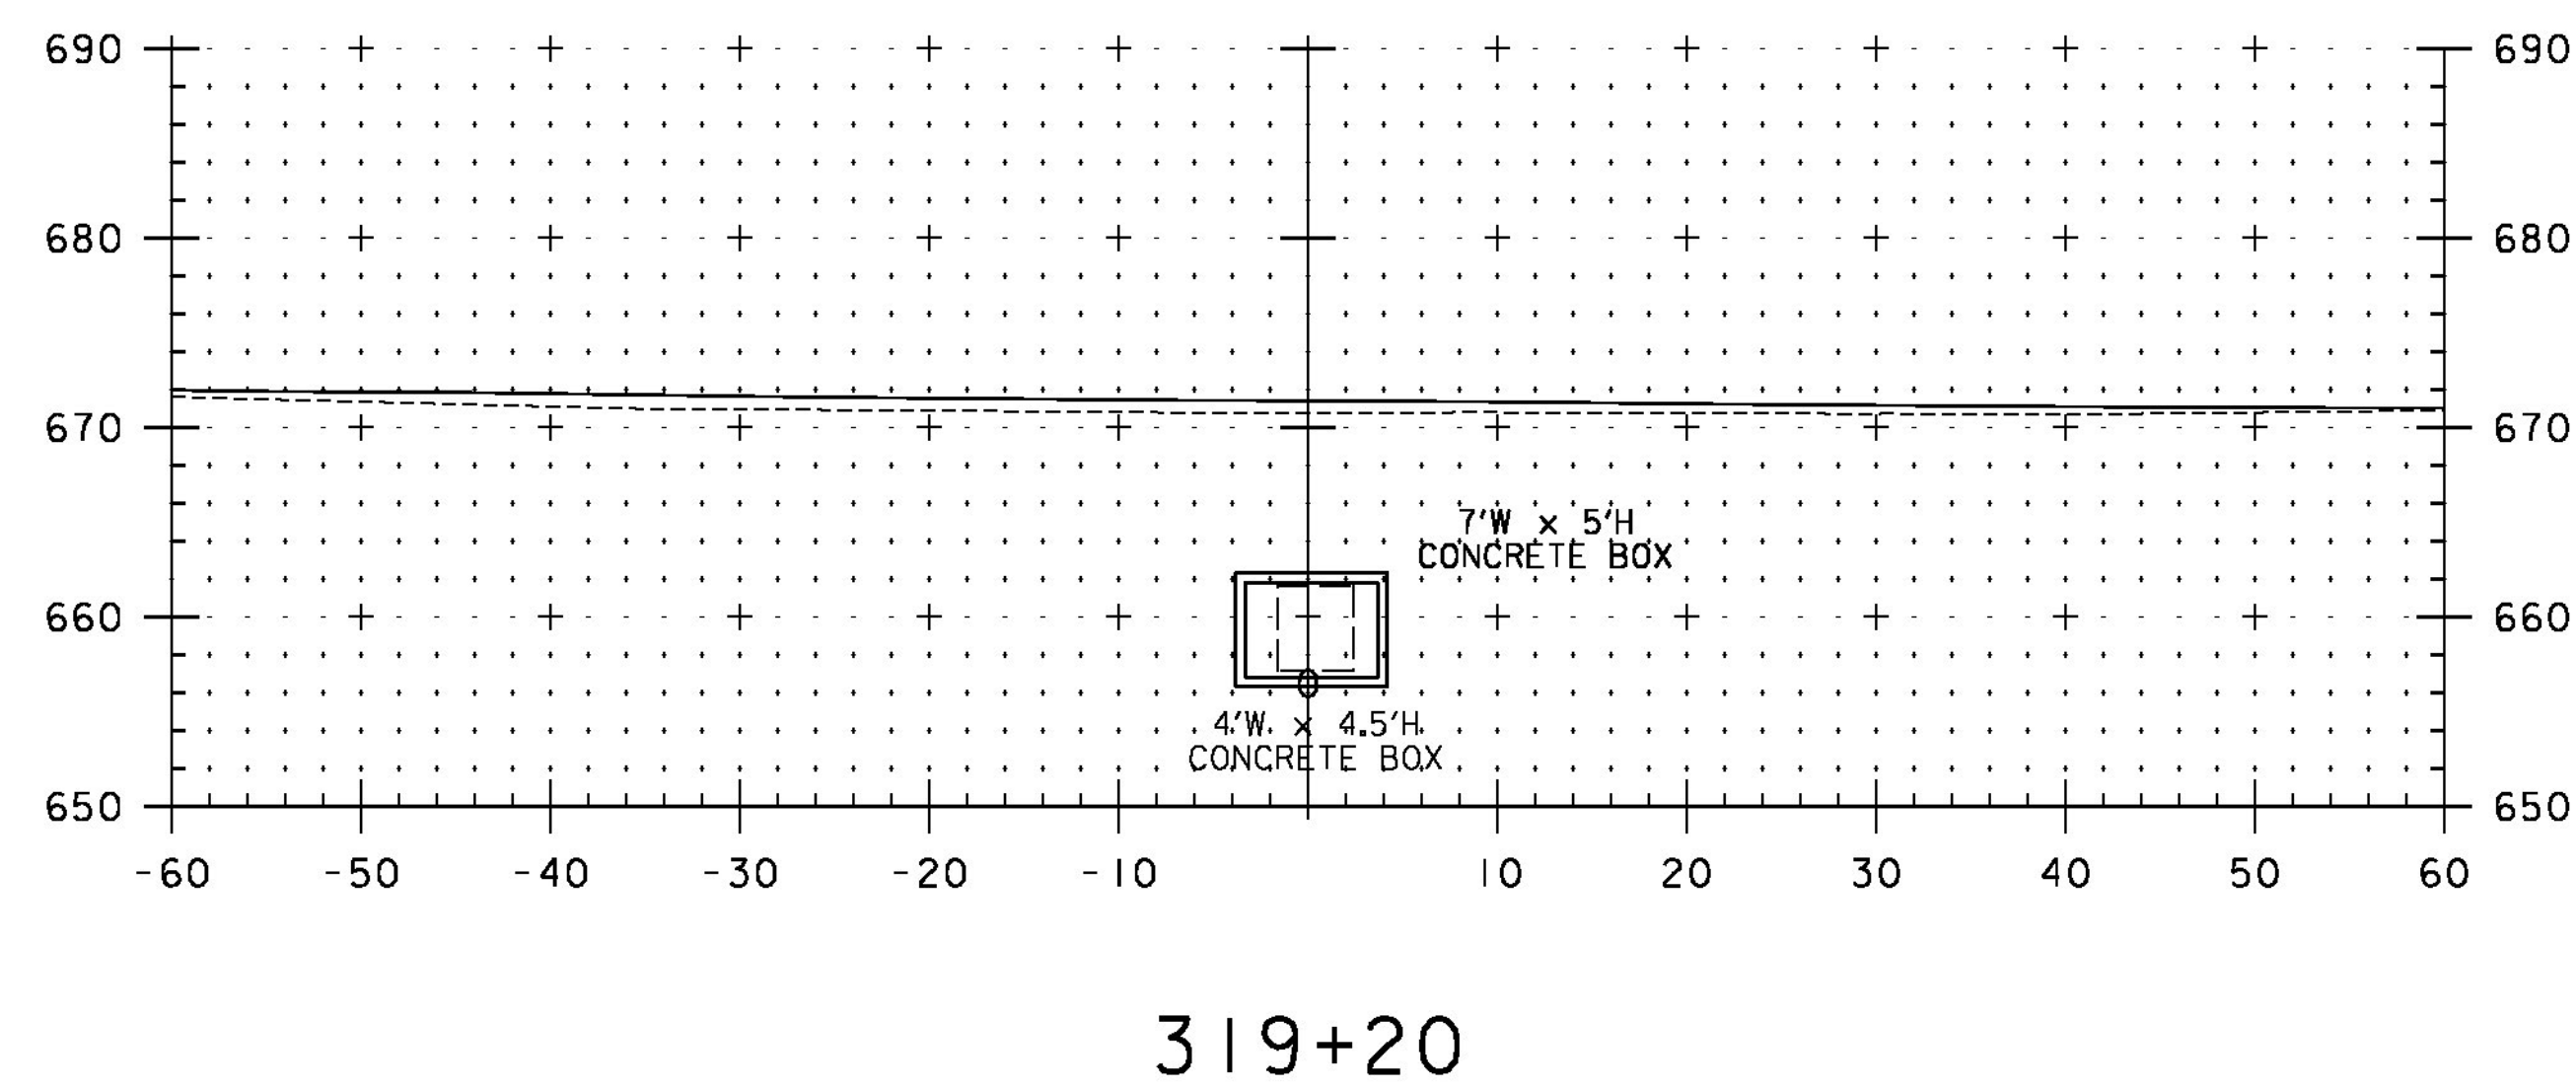


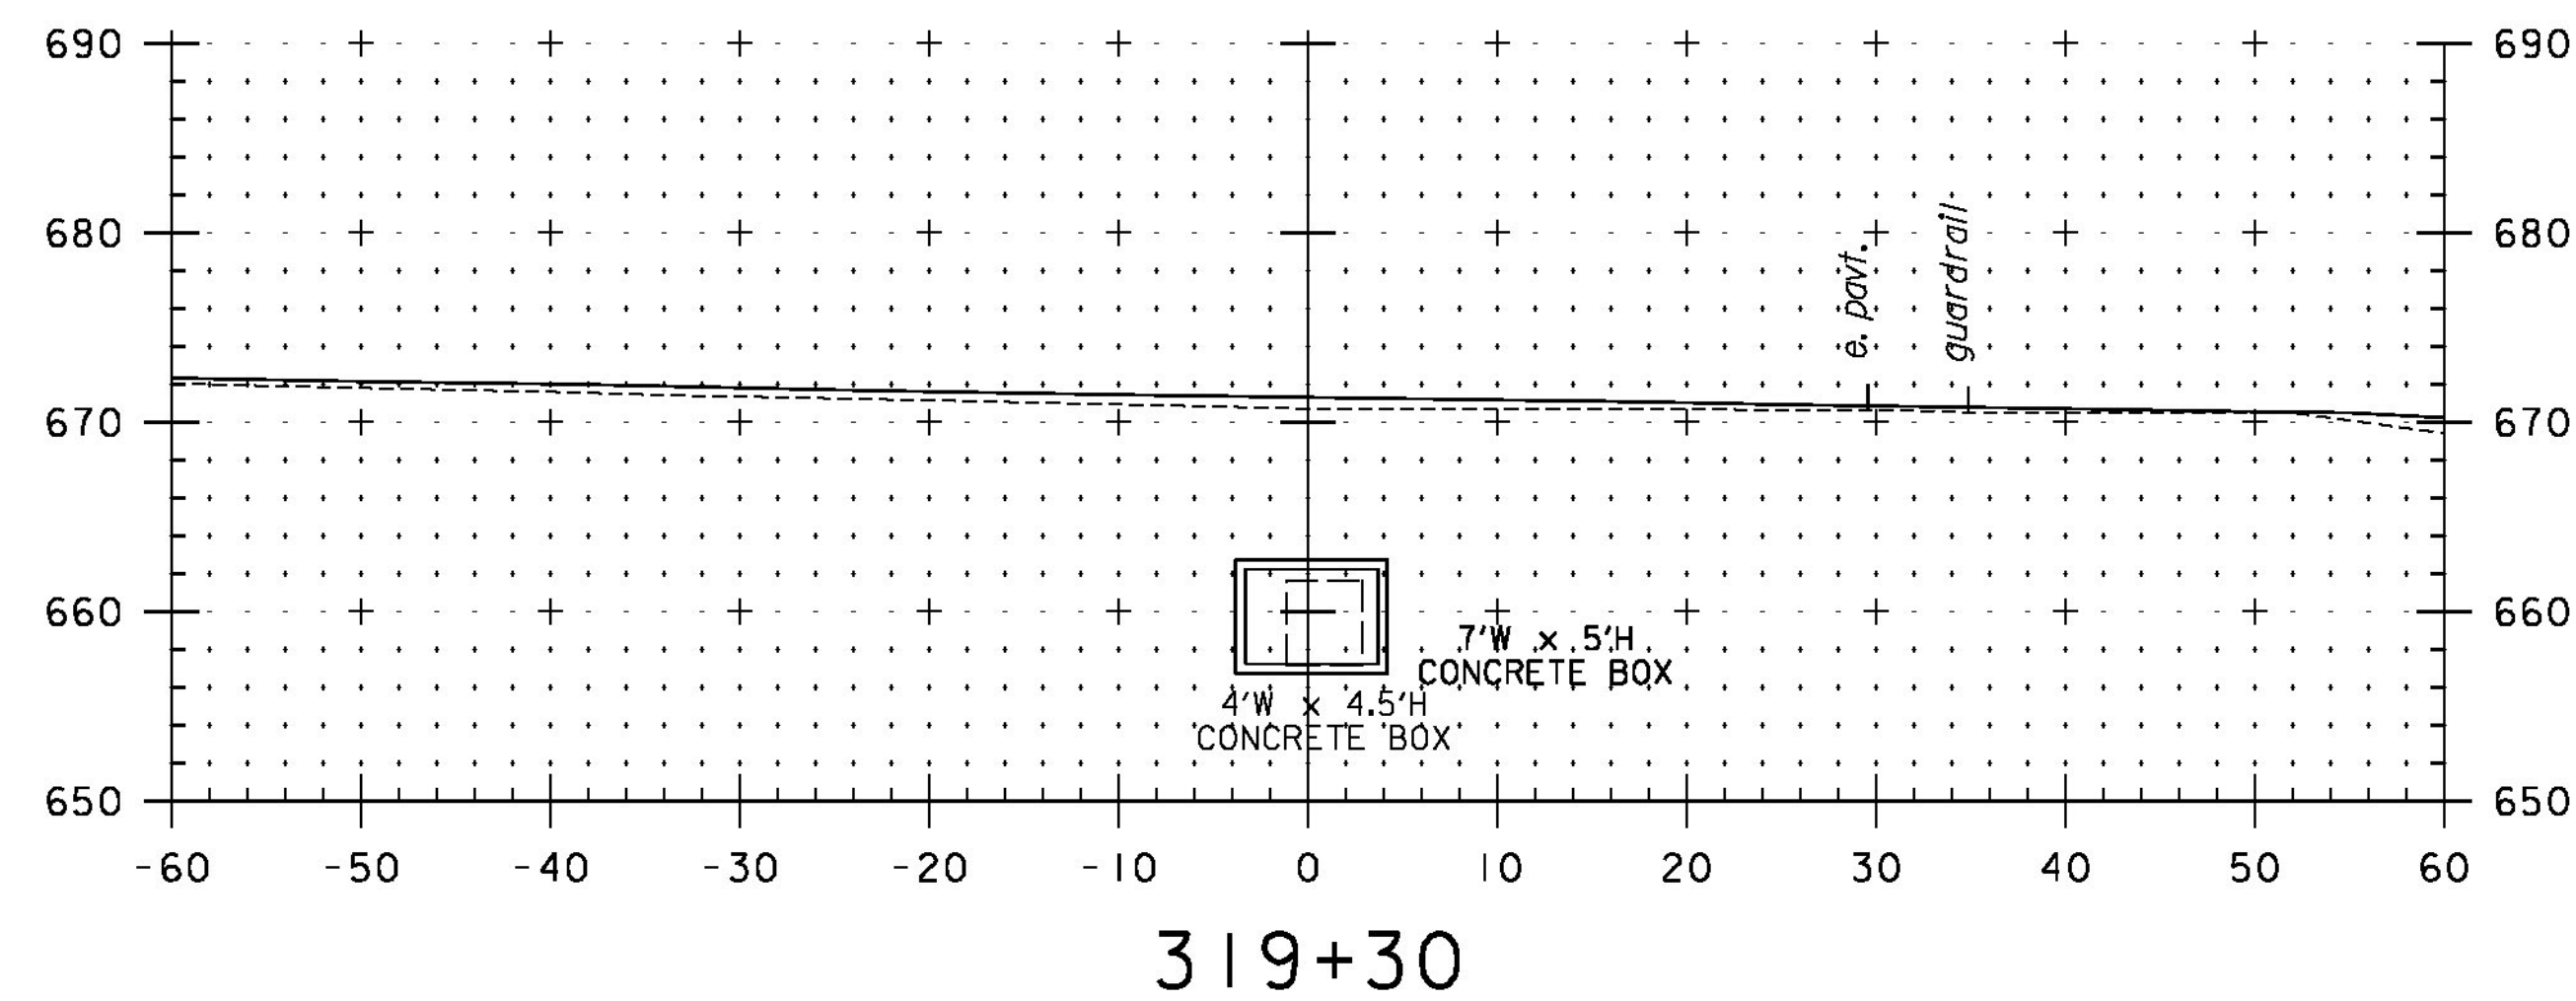

SCALE IN FEET
10 0 10

STA. 319+10 TO STA. 319+48.00

PROJECT NAME: BARRE TOWN	
PROJECT NUMBER: STP SCRP(10)	
FILE NAME: z10d202xsl_Channel.dgn	PLOT DATE: 2/13/2014
PROJECT LEADER: K. UPMAL	DRAWN BY: M. SMITH
DESIGNED BY: S. BEAUMONT	CHECKED BY: J. BYATT
CHANNEL CROSS SECTION SHEET 3	SHEET 35 OF 43