




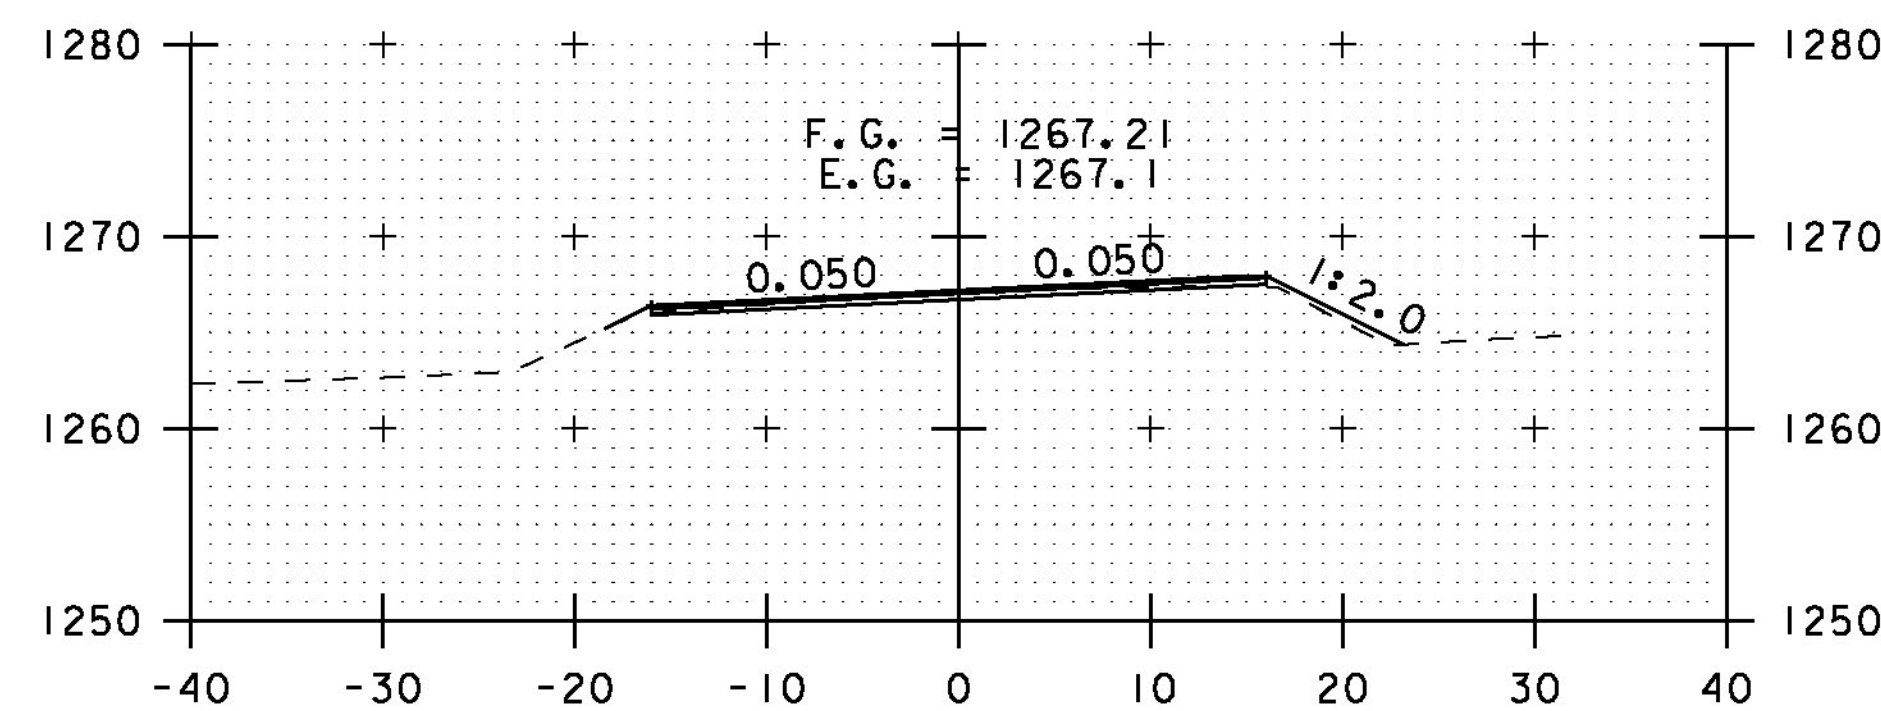


270+50

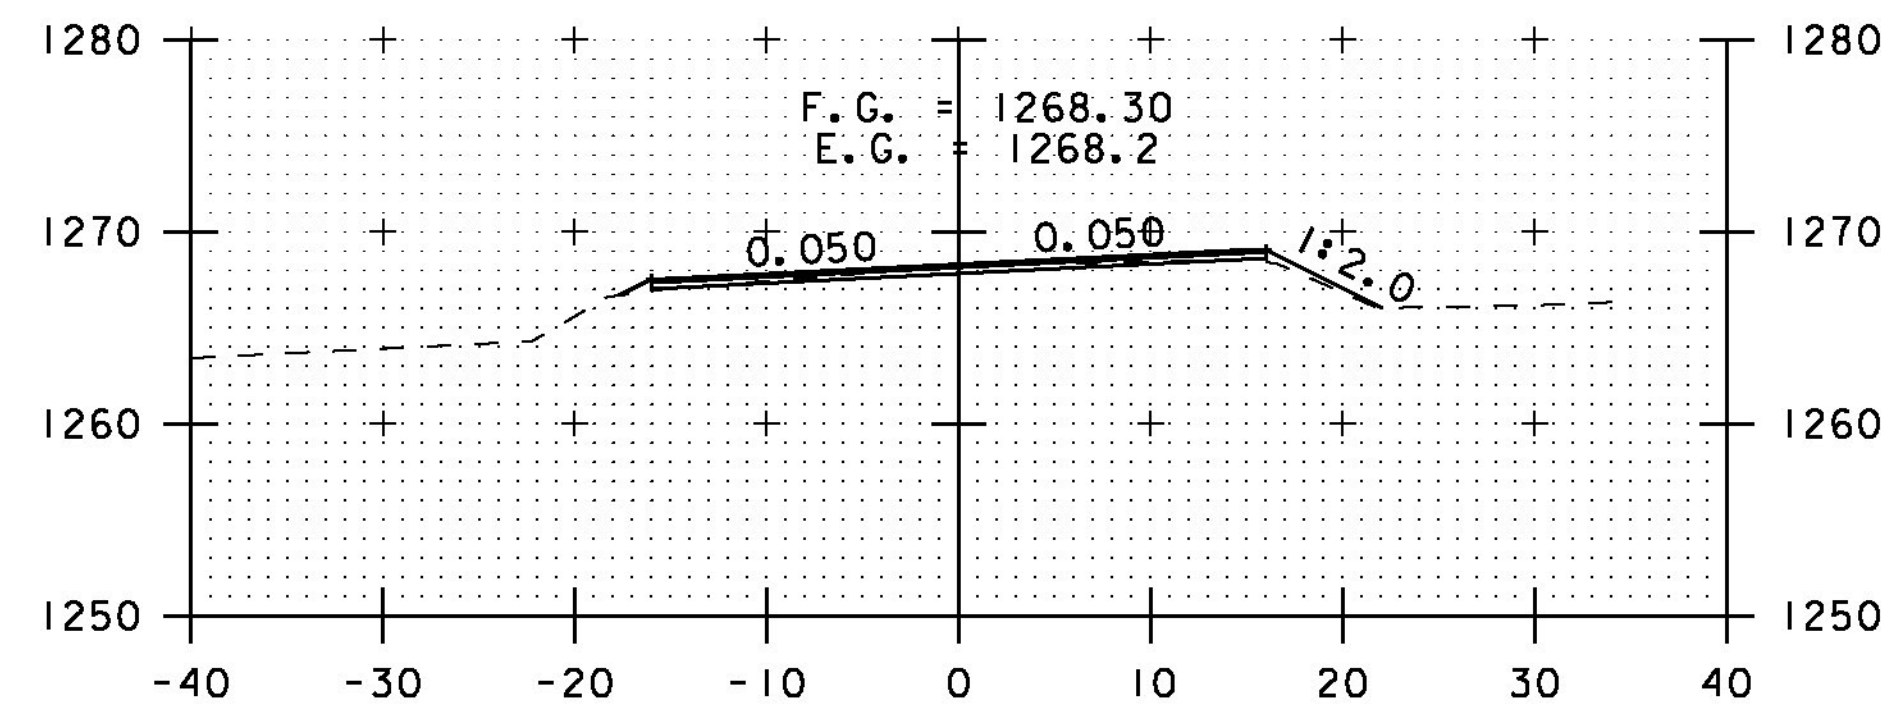


270+00

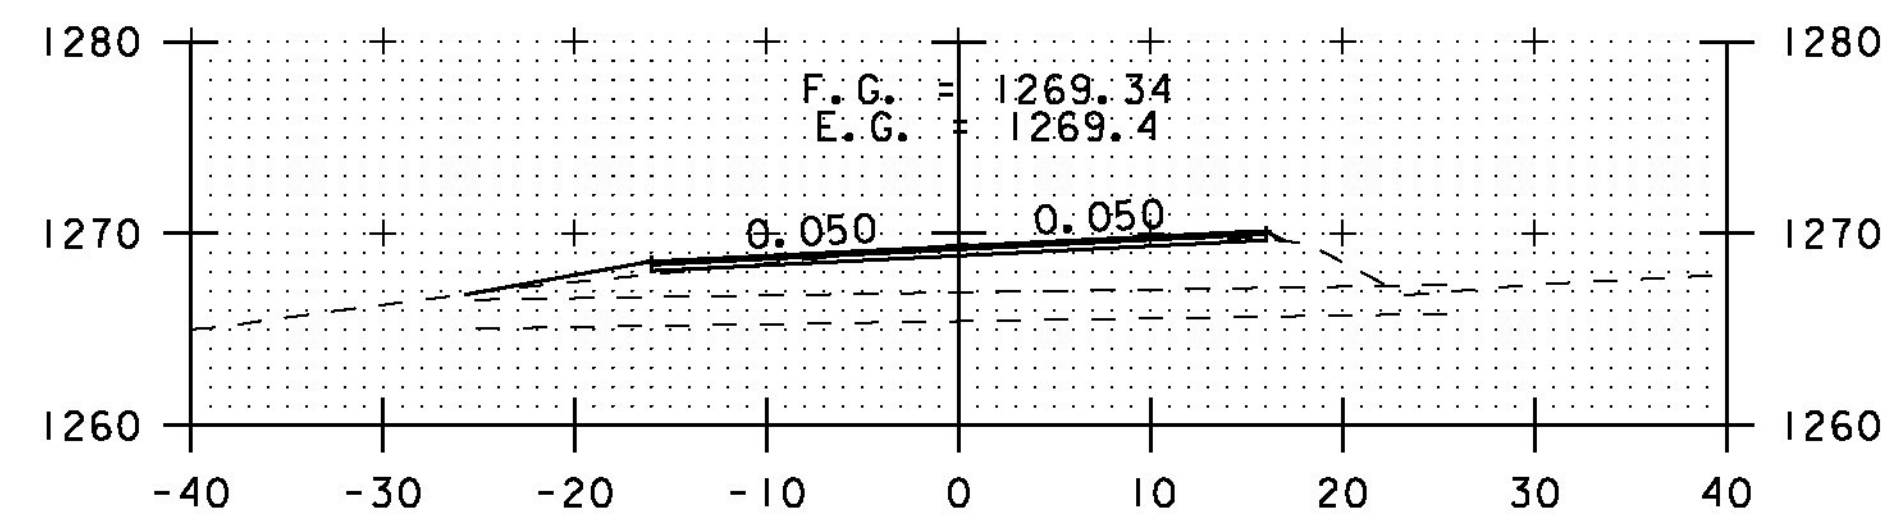


DRIVE LT
269+50

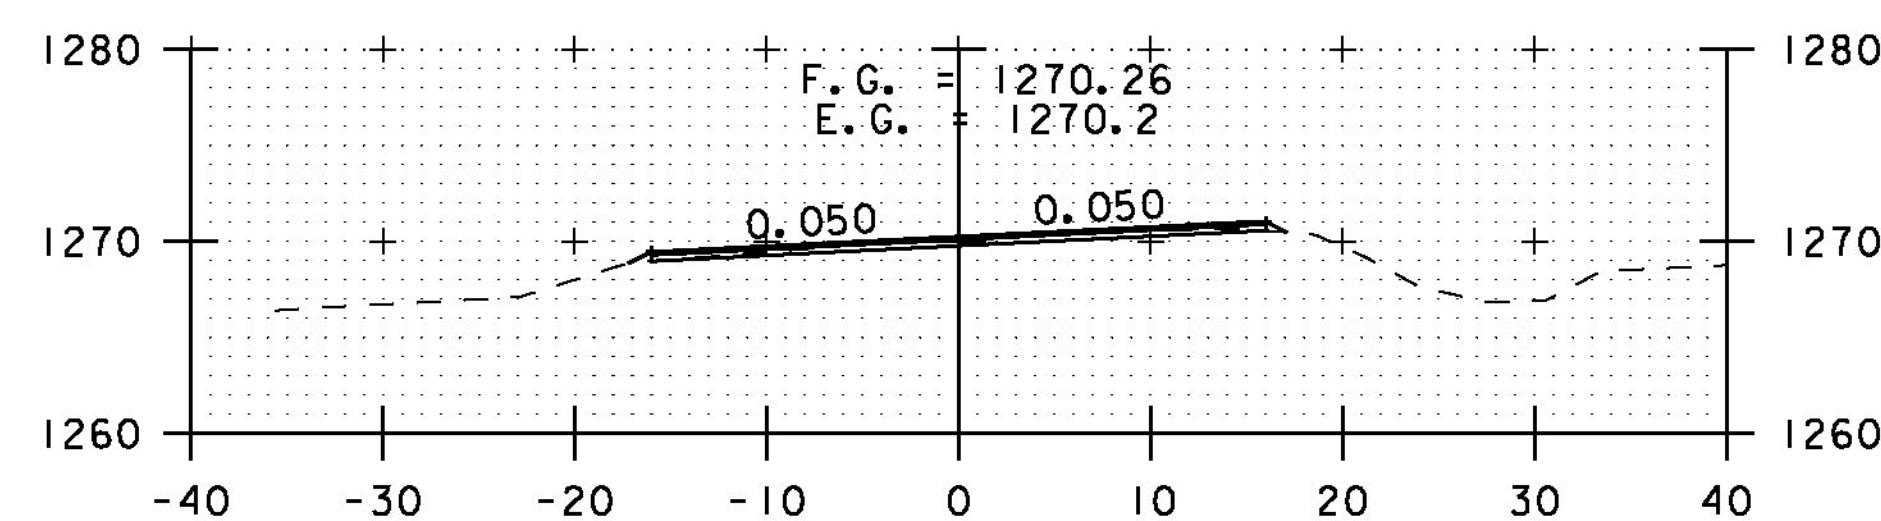


269+00

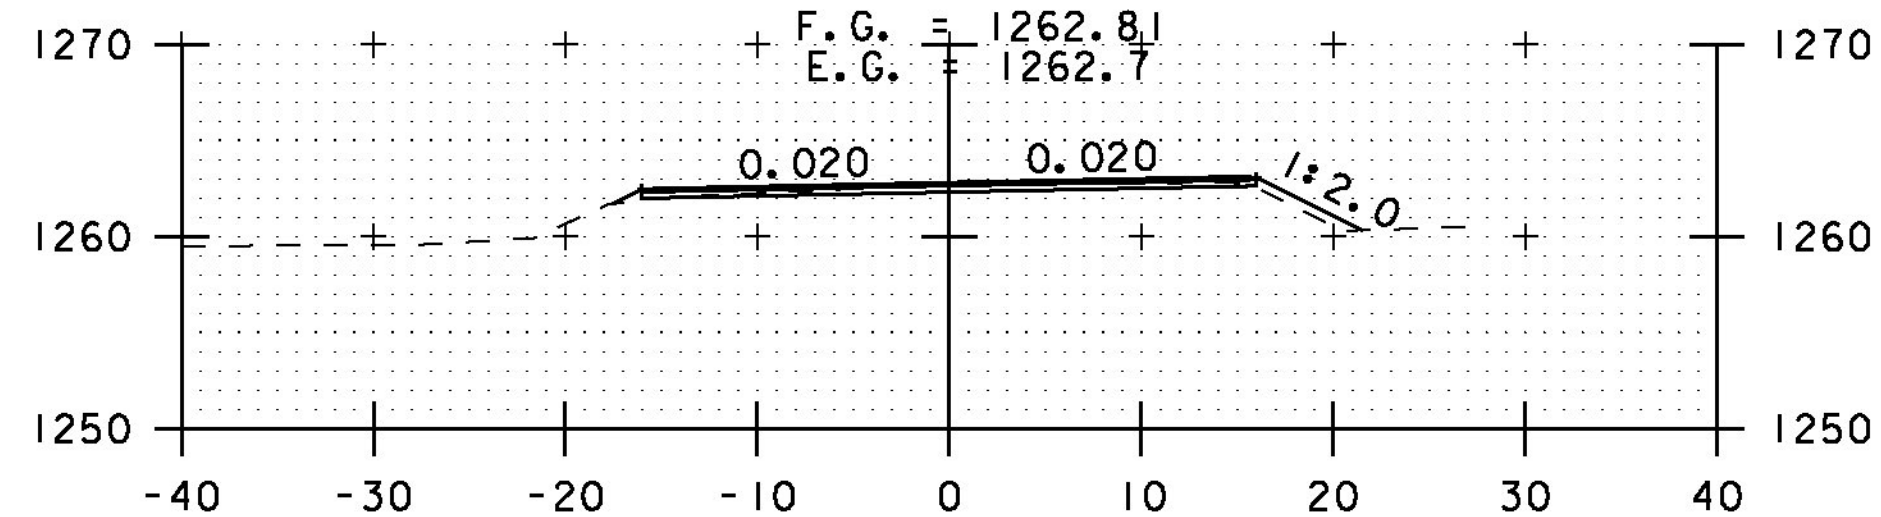


272+50

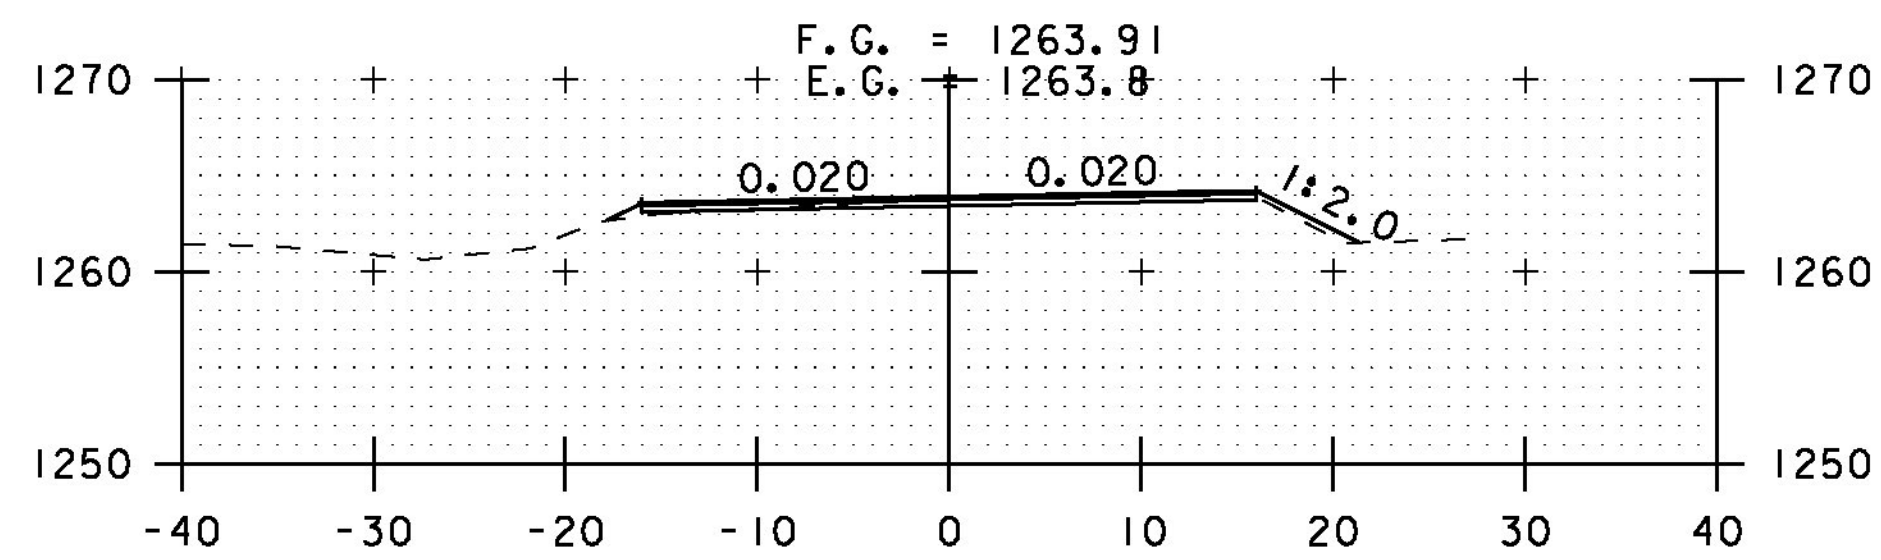


272+00

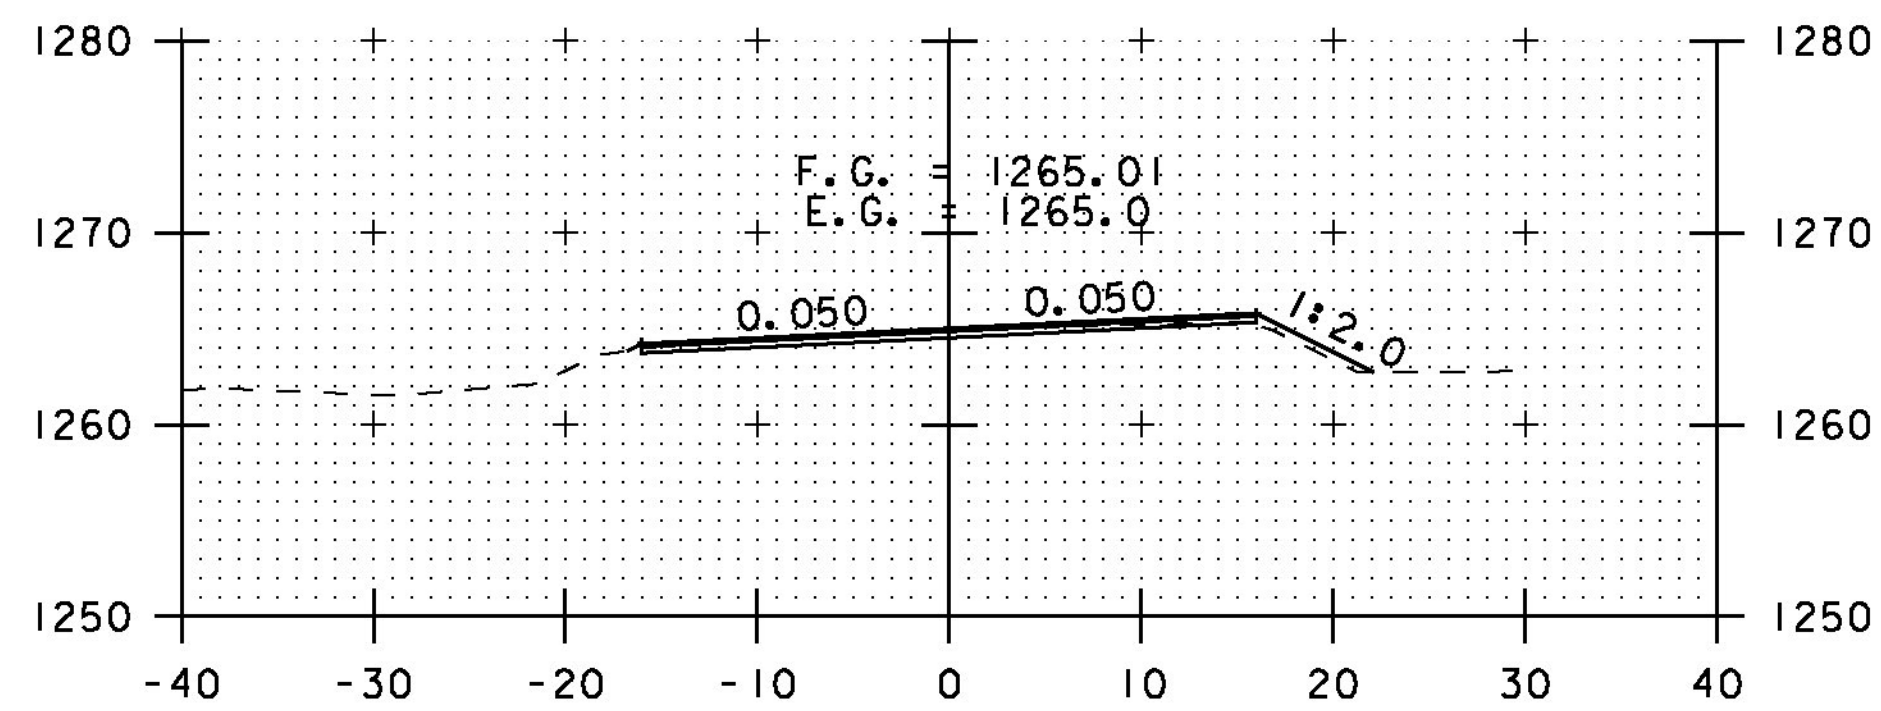


271+50

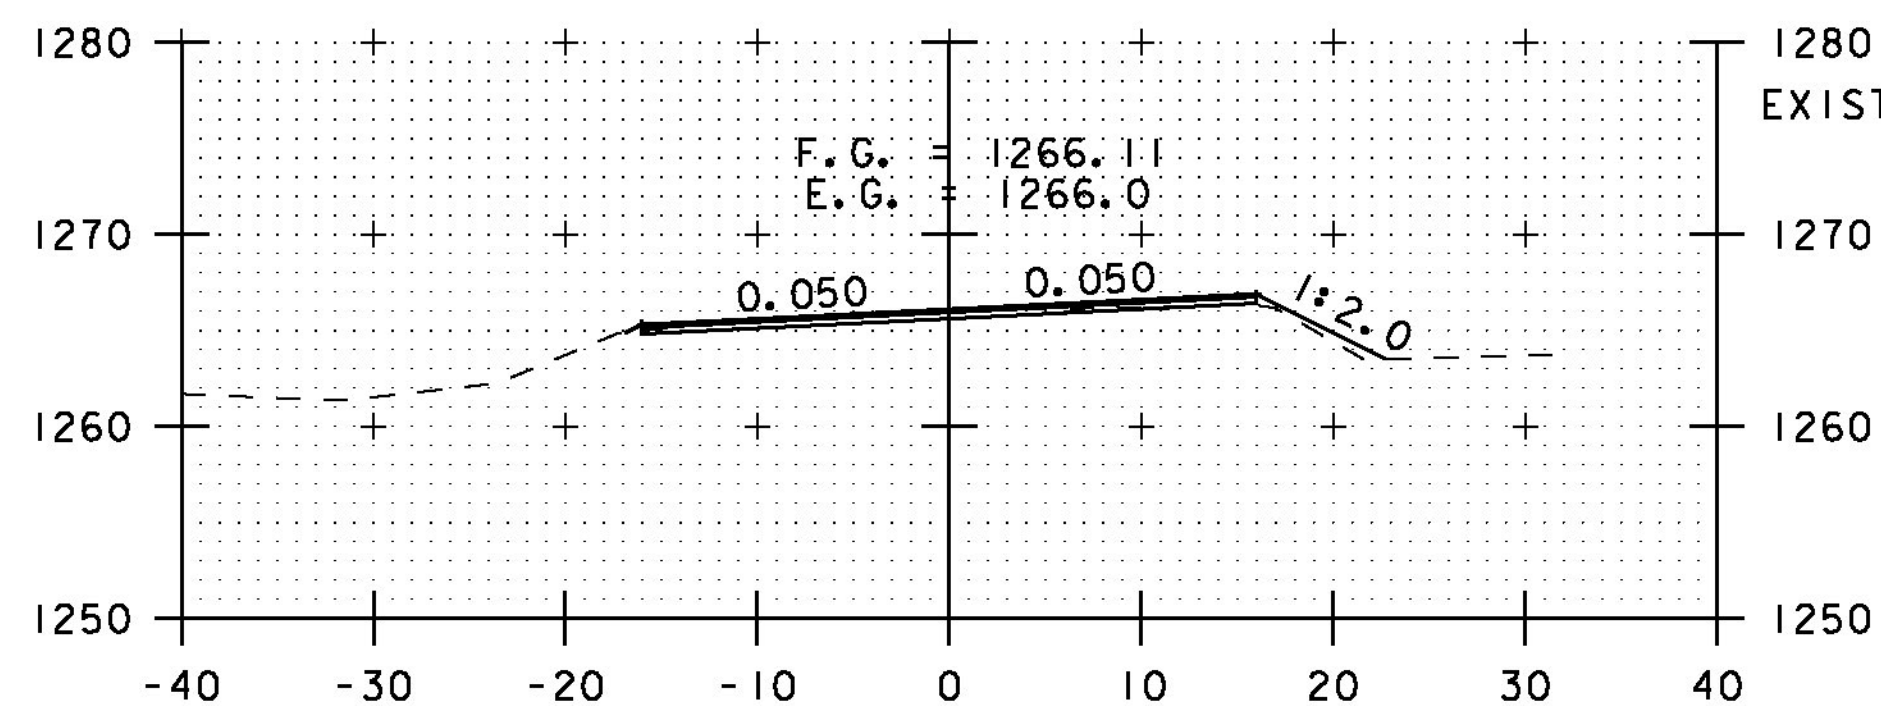


271+00

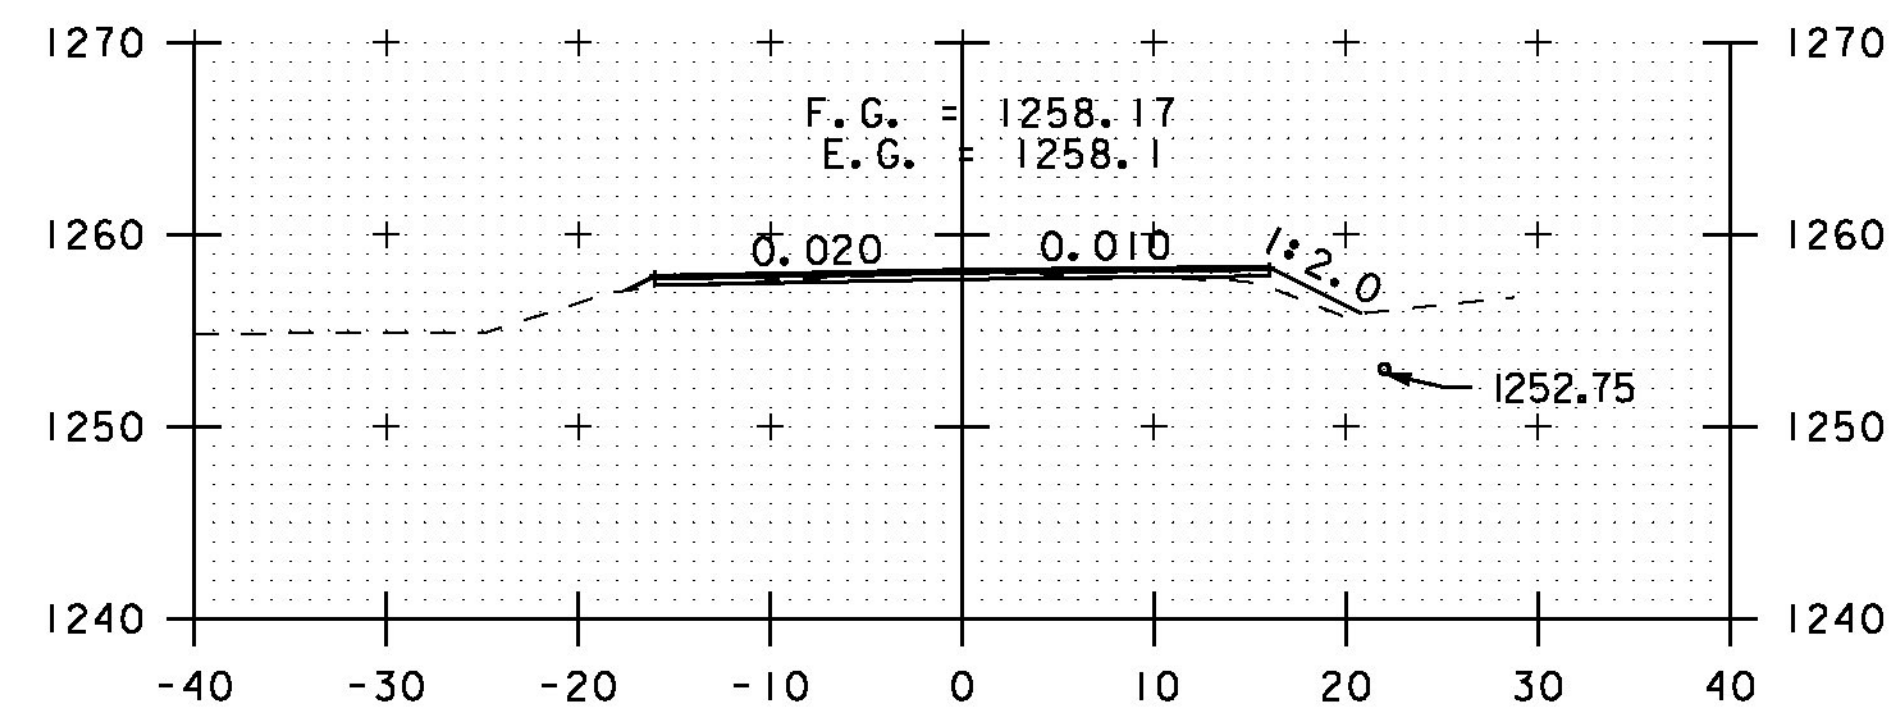


274+50

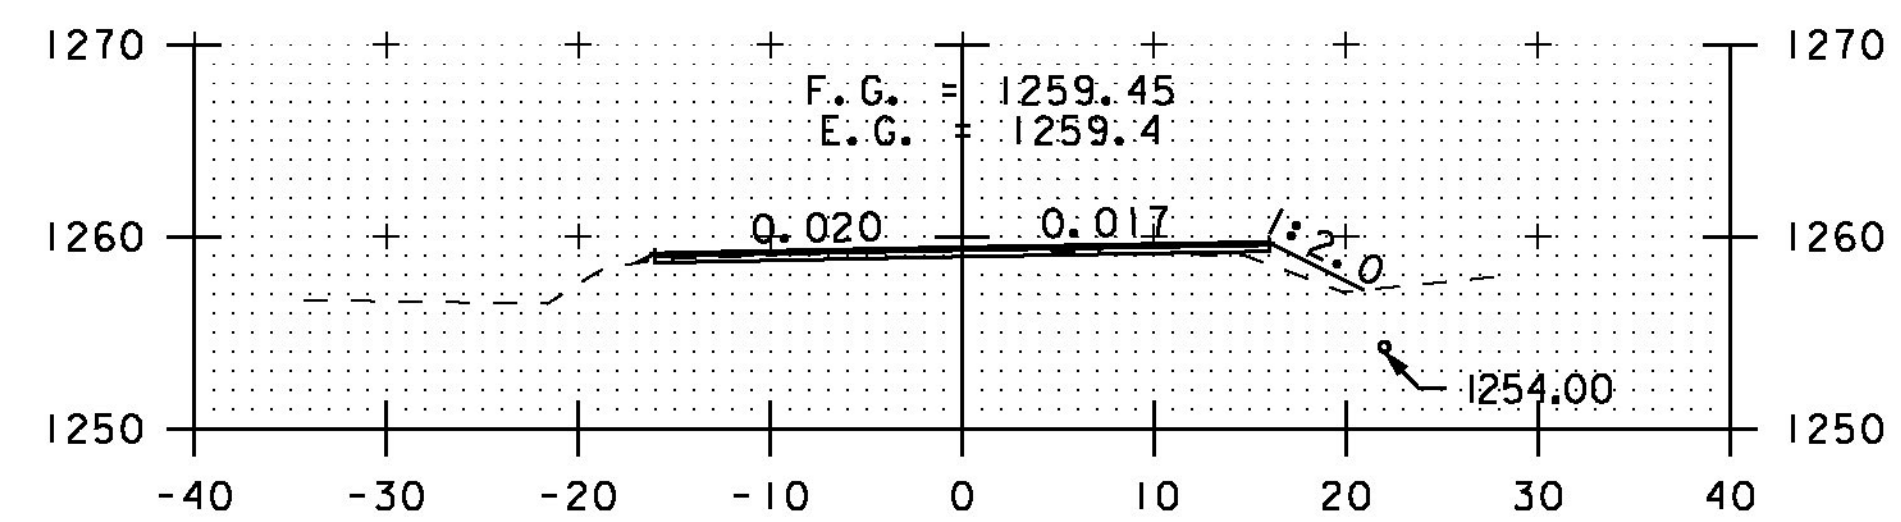

274+00

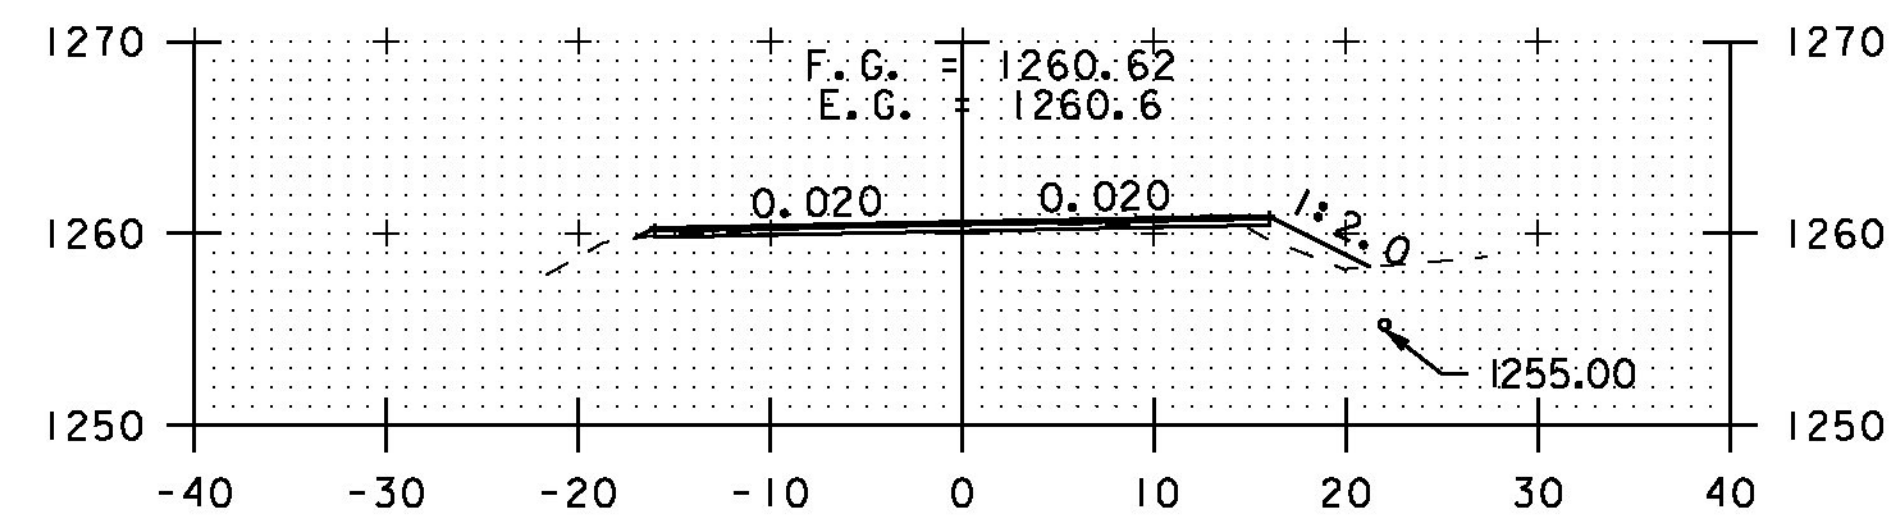

273+50

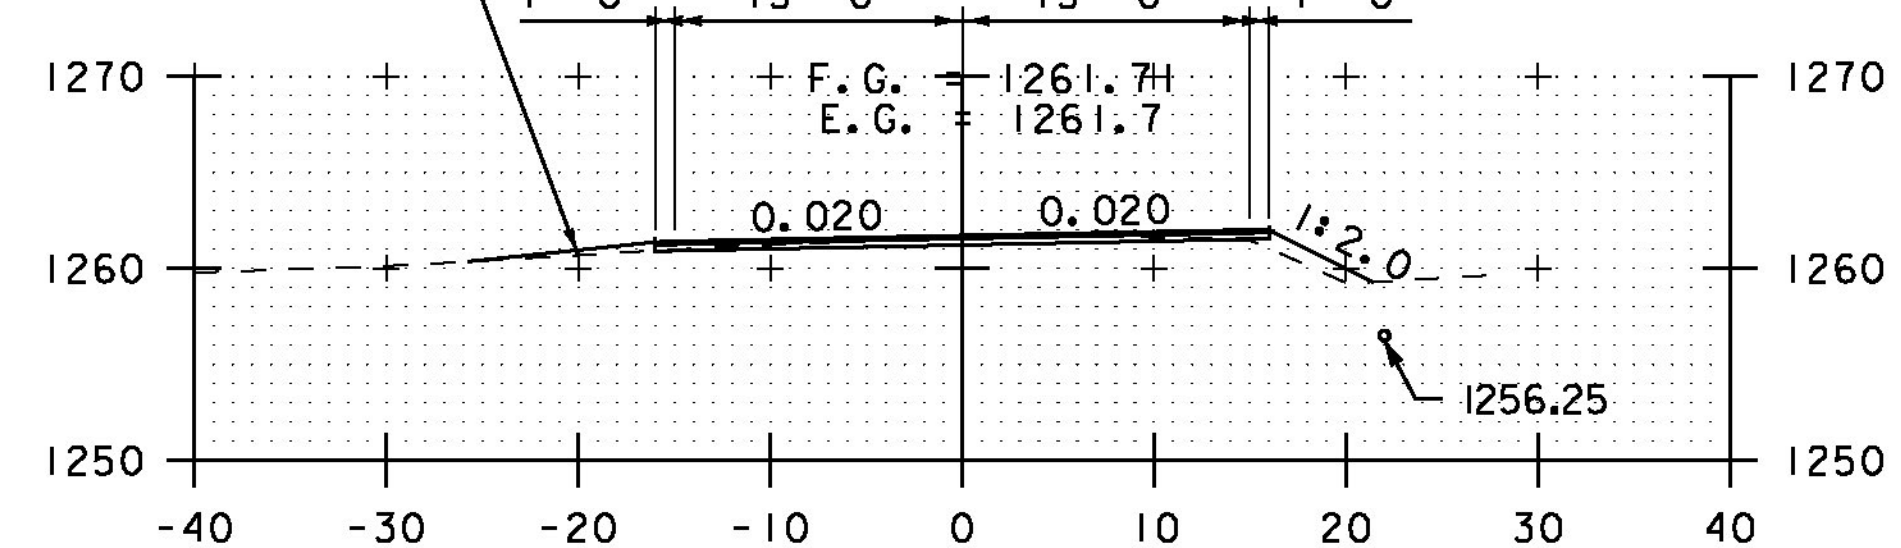

273+00 DRIVE LT

SCALE 1" = 10'-0"

STA. 269+00 TO STA. 274+50

**CROSS
SECTION
SHEET 16**

PROJECT NAME: ELMORE-MORRISTOWN

PROJECT NUMBER: STP 2937 (1)

FILE NAME: z11c310.dgn

PROJECT LEADER: C. LATHROP

DESIGNED BY: S. LAMPHERE

PLOT FILE: z11c310_144.i

PLOT DATE: 3/3/14

DRAWN BY: B. MARTIN

CHECKED BY: C. LATHROP

SHEET 144 OF 194