




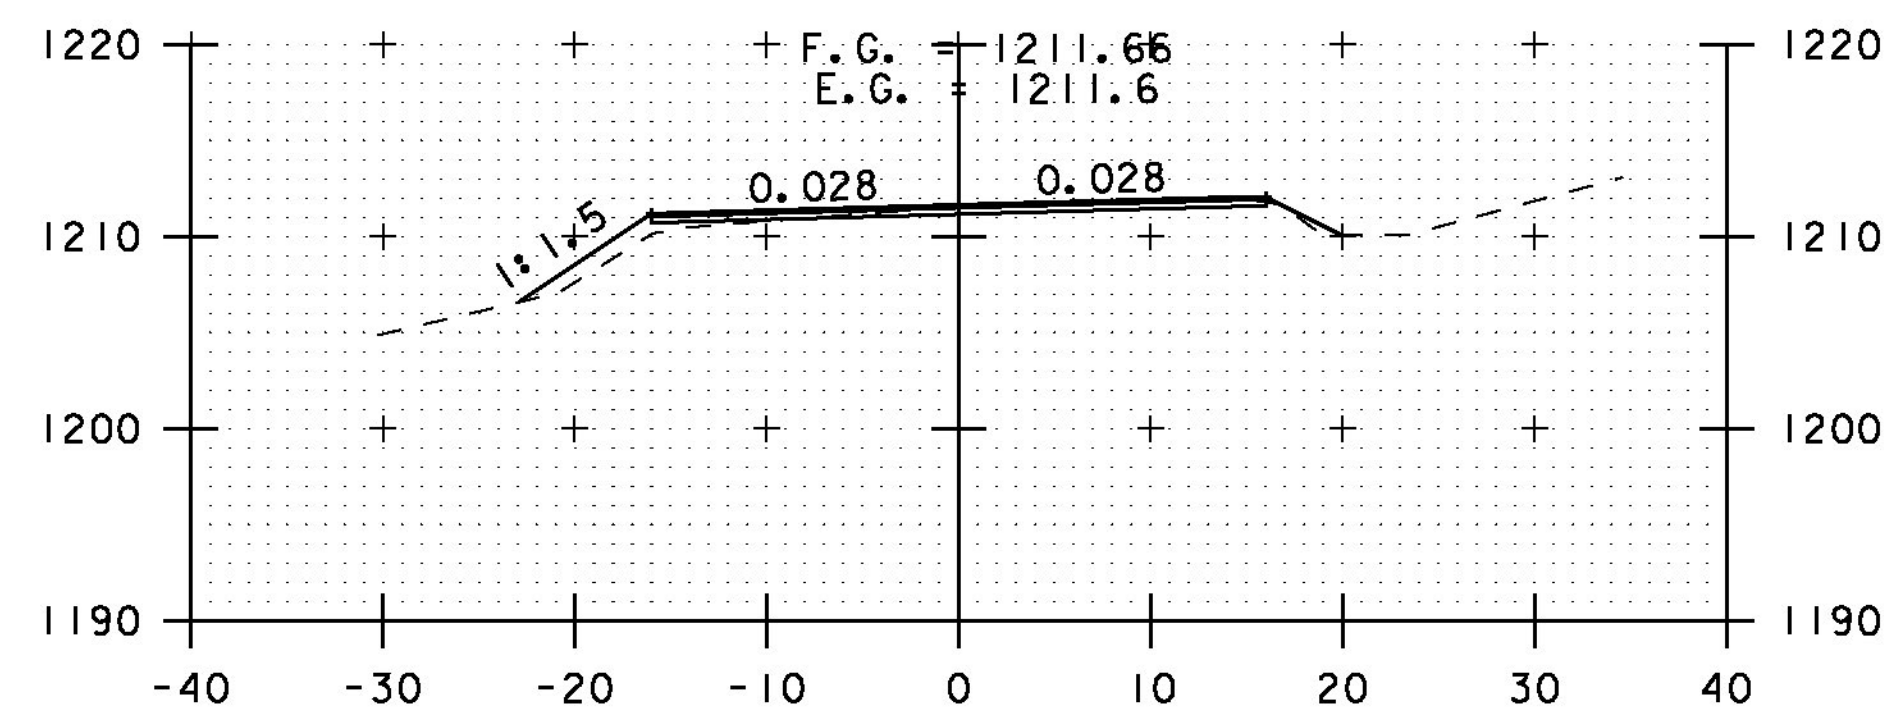

323+50

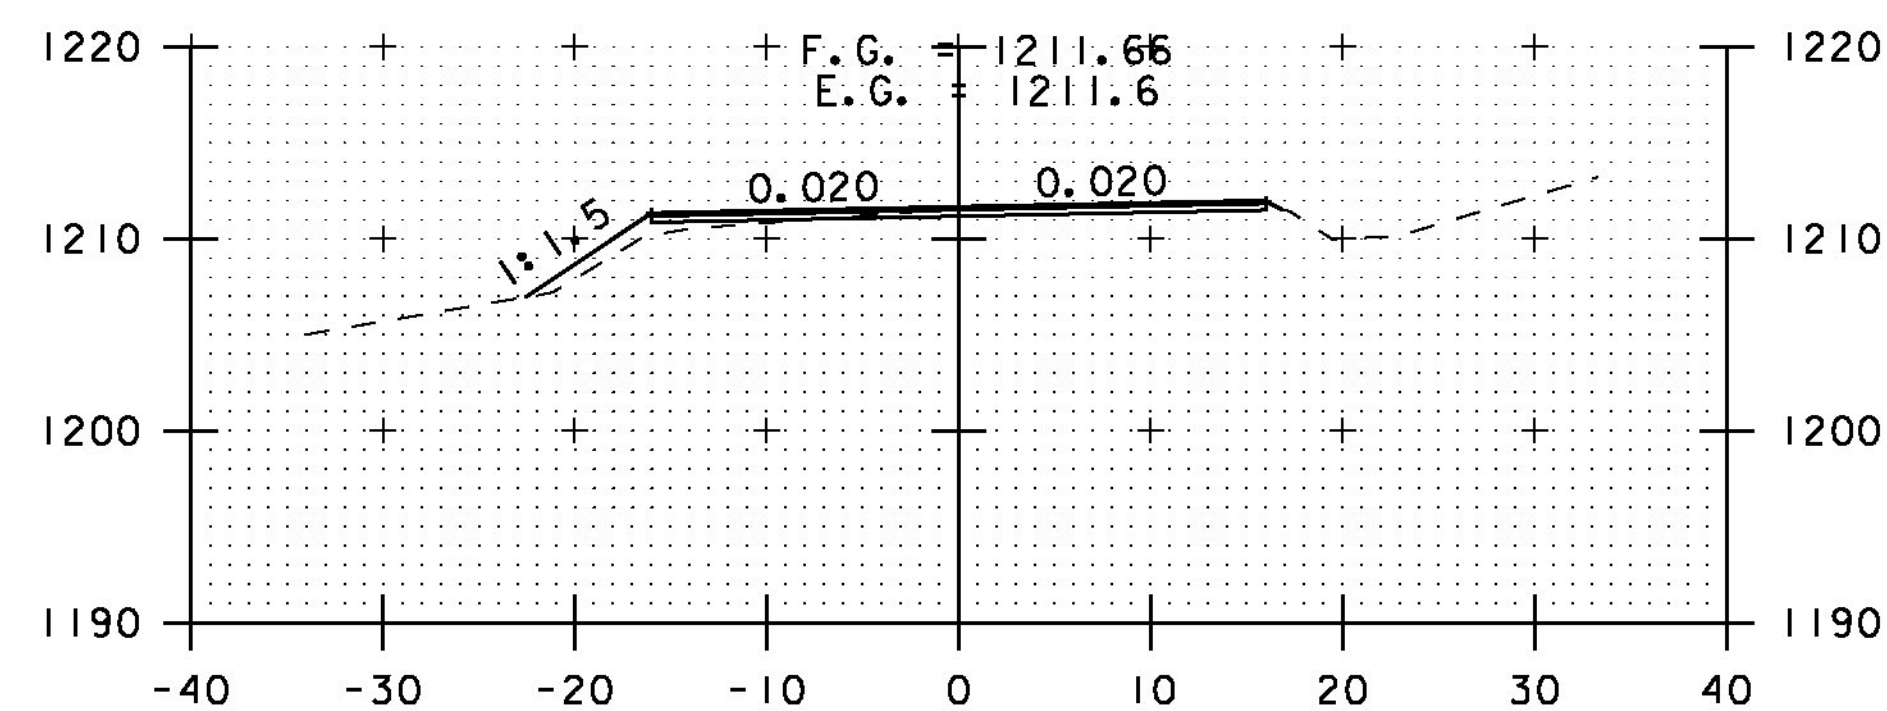


323+00

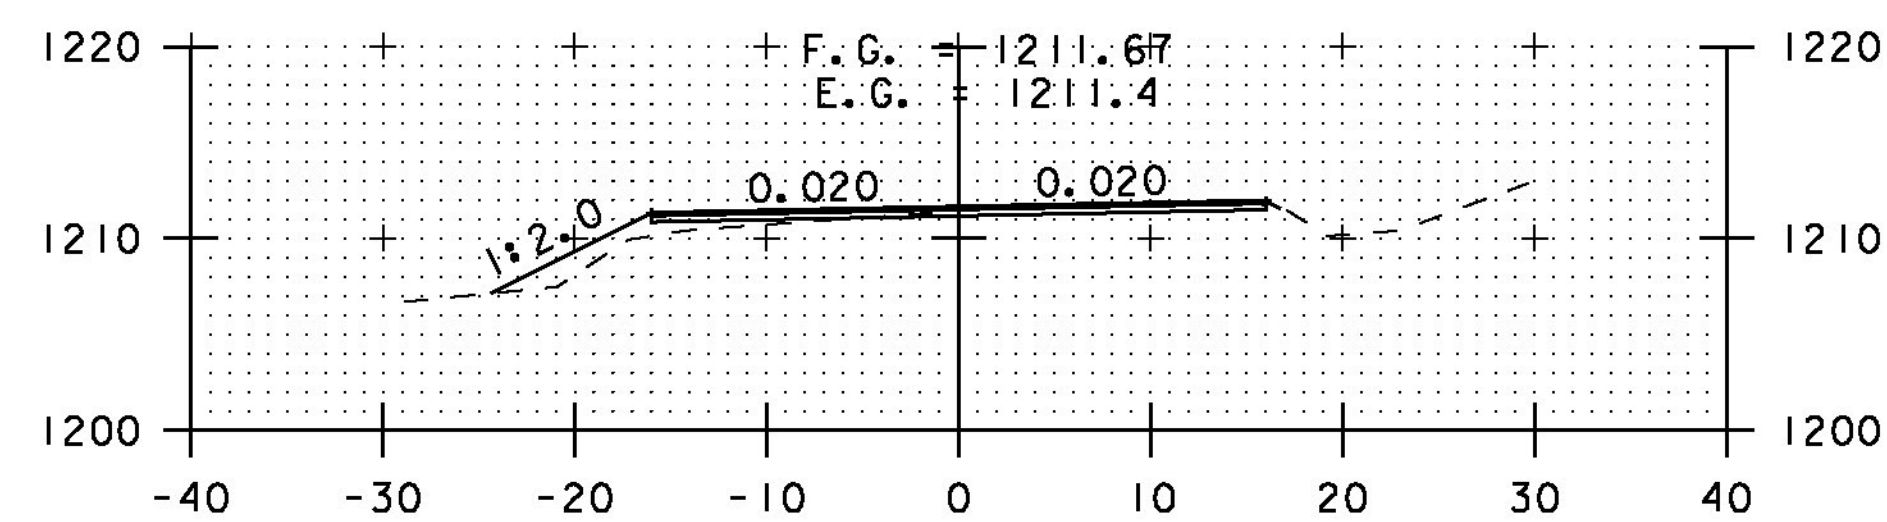


322+50


12" STONE FILL, TYPE I (TYP.)
6" GRUBBING MATERIAL (TYP.)
GEOTEXTILE UNDER STONE FILL (TYP.)

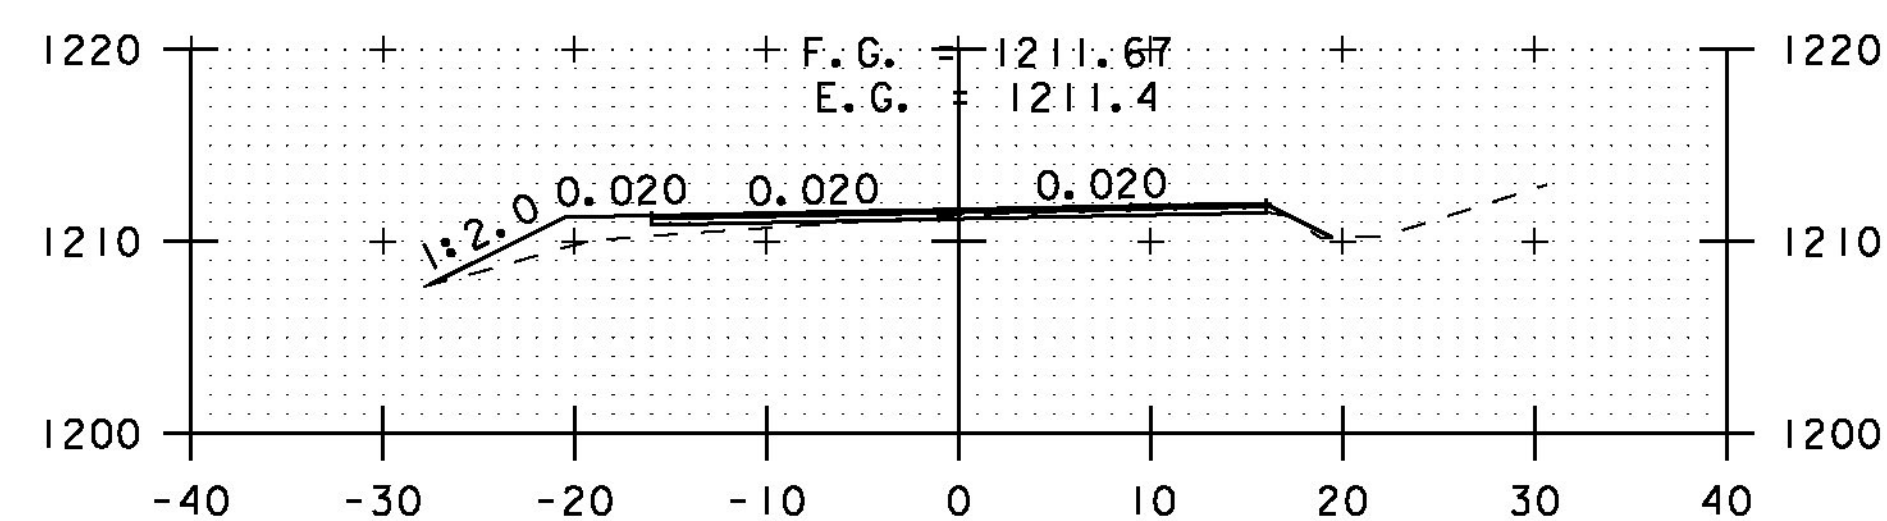


DRIVE LT
322+00

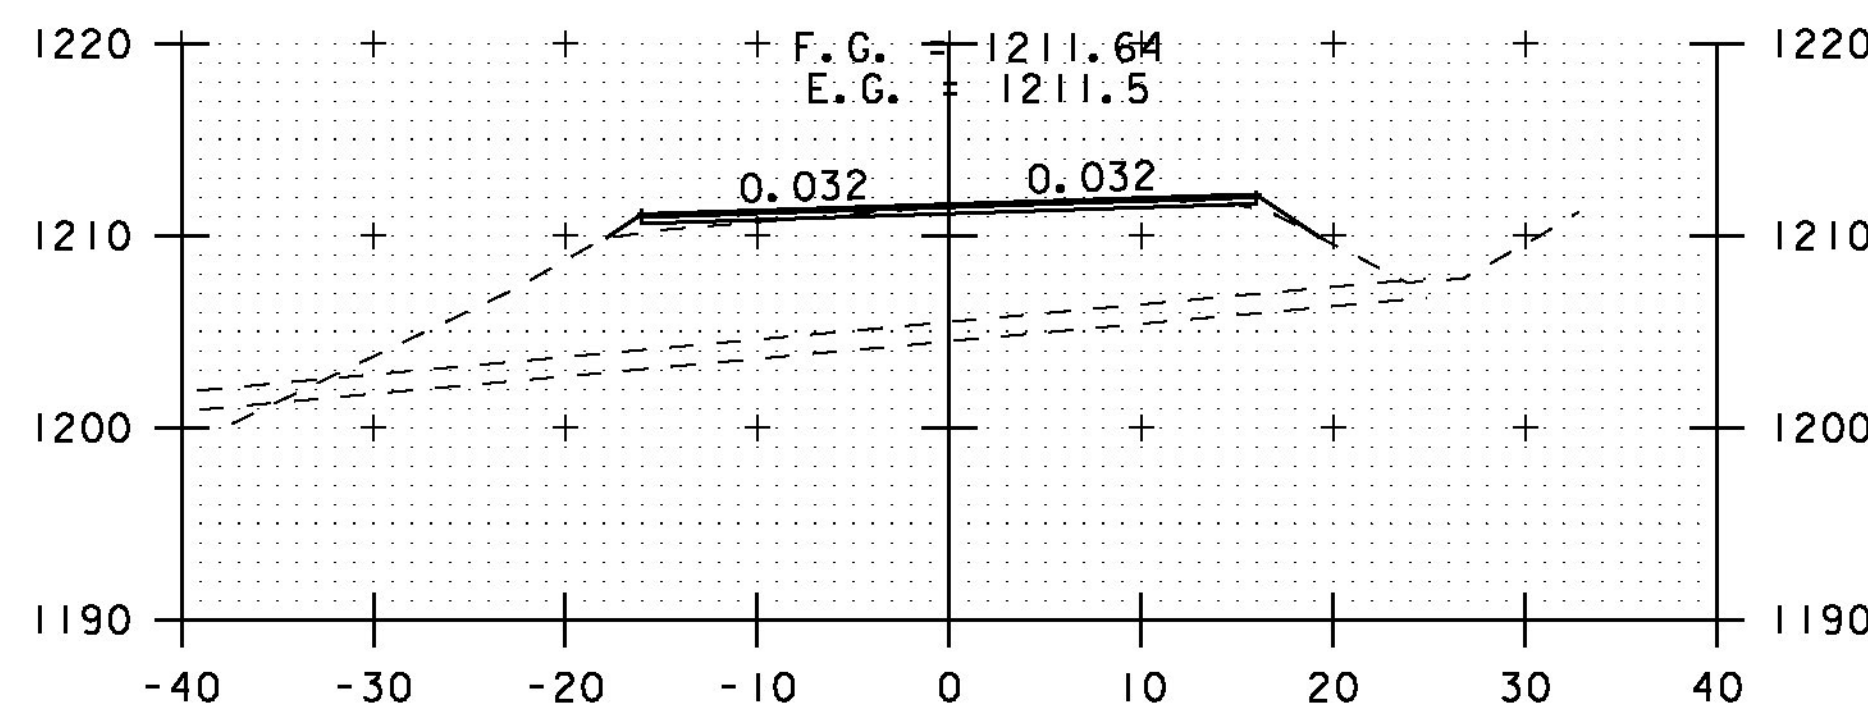


325+00

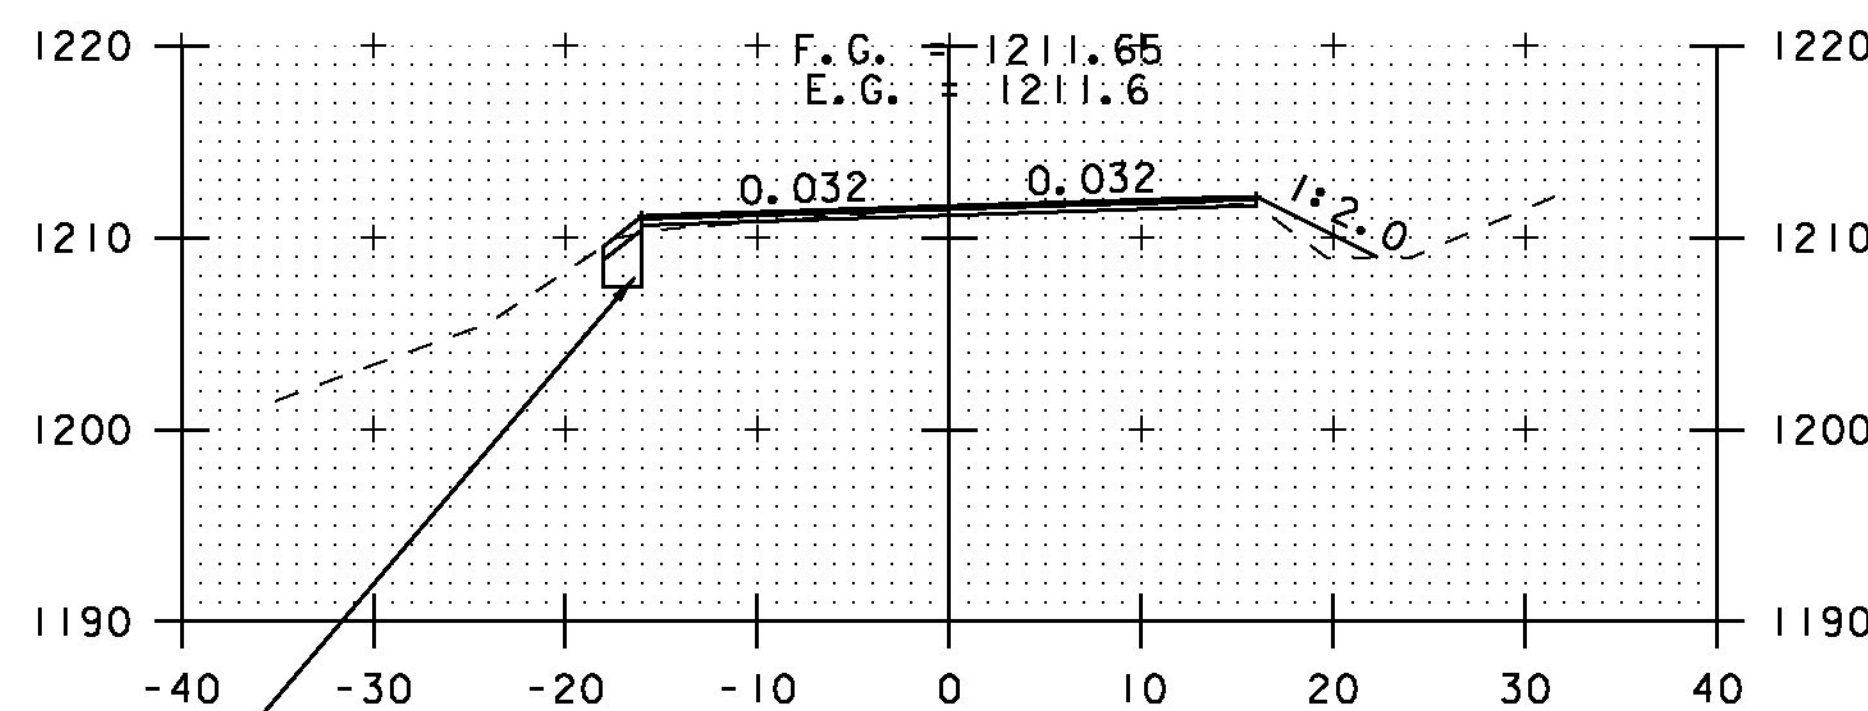


324+50

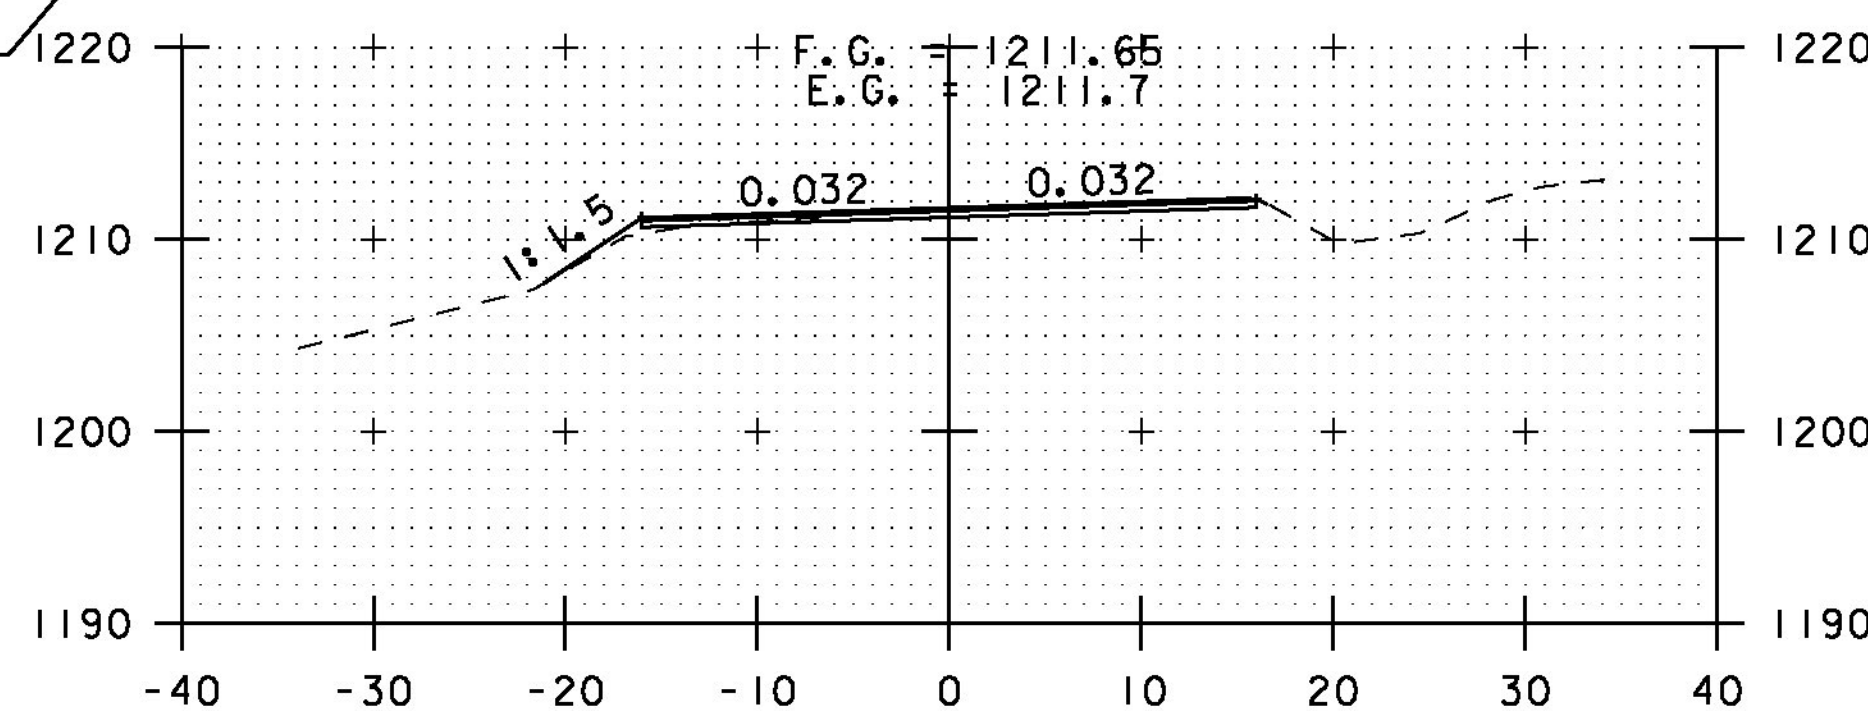


324+00

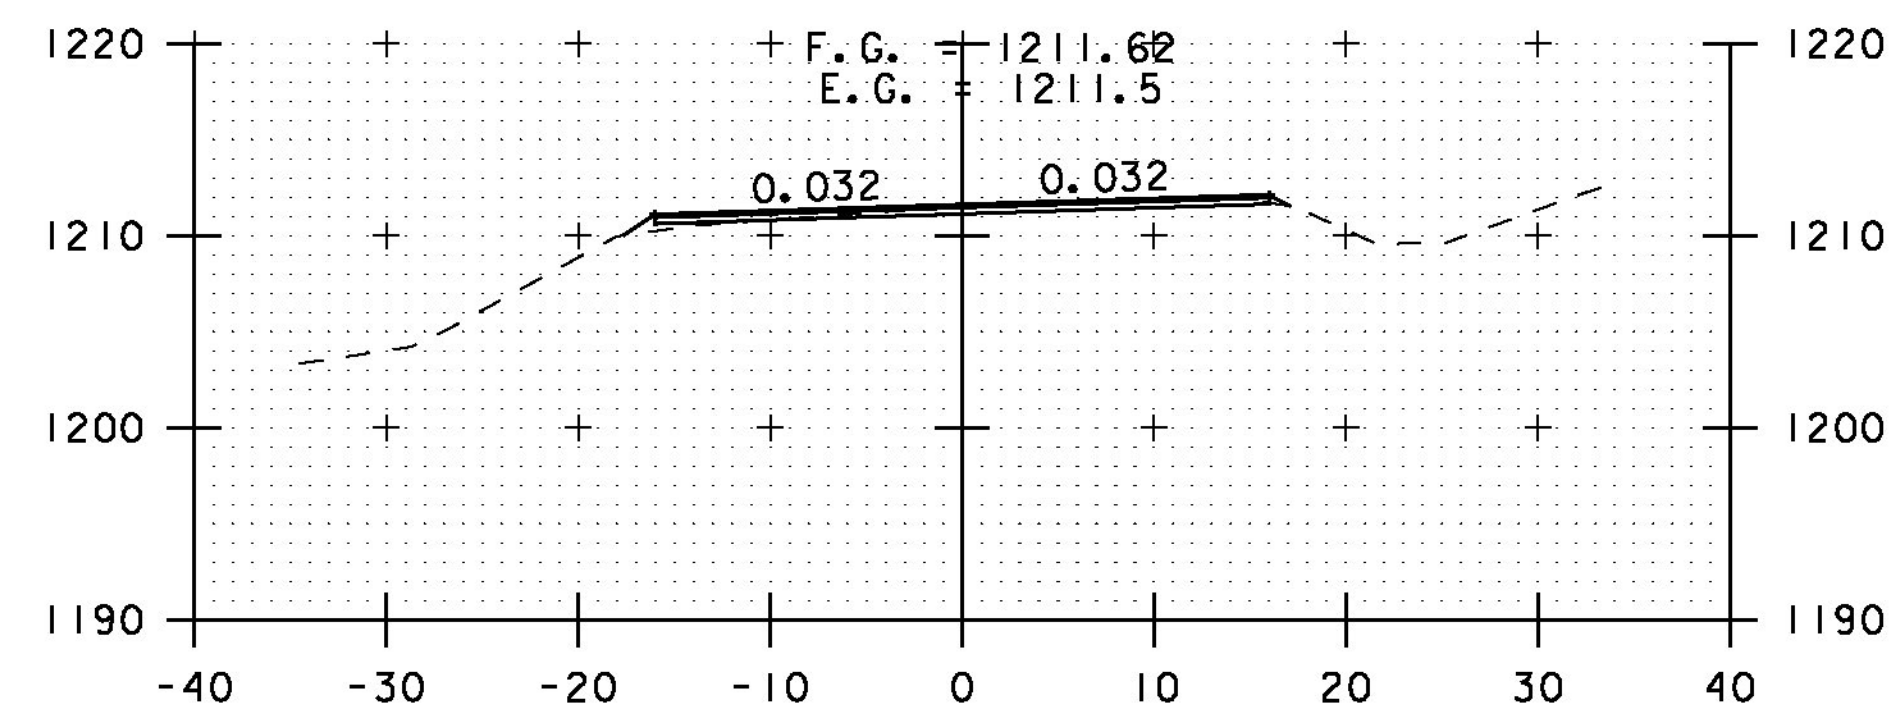

326+50

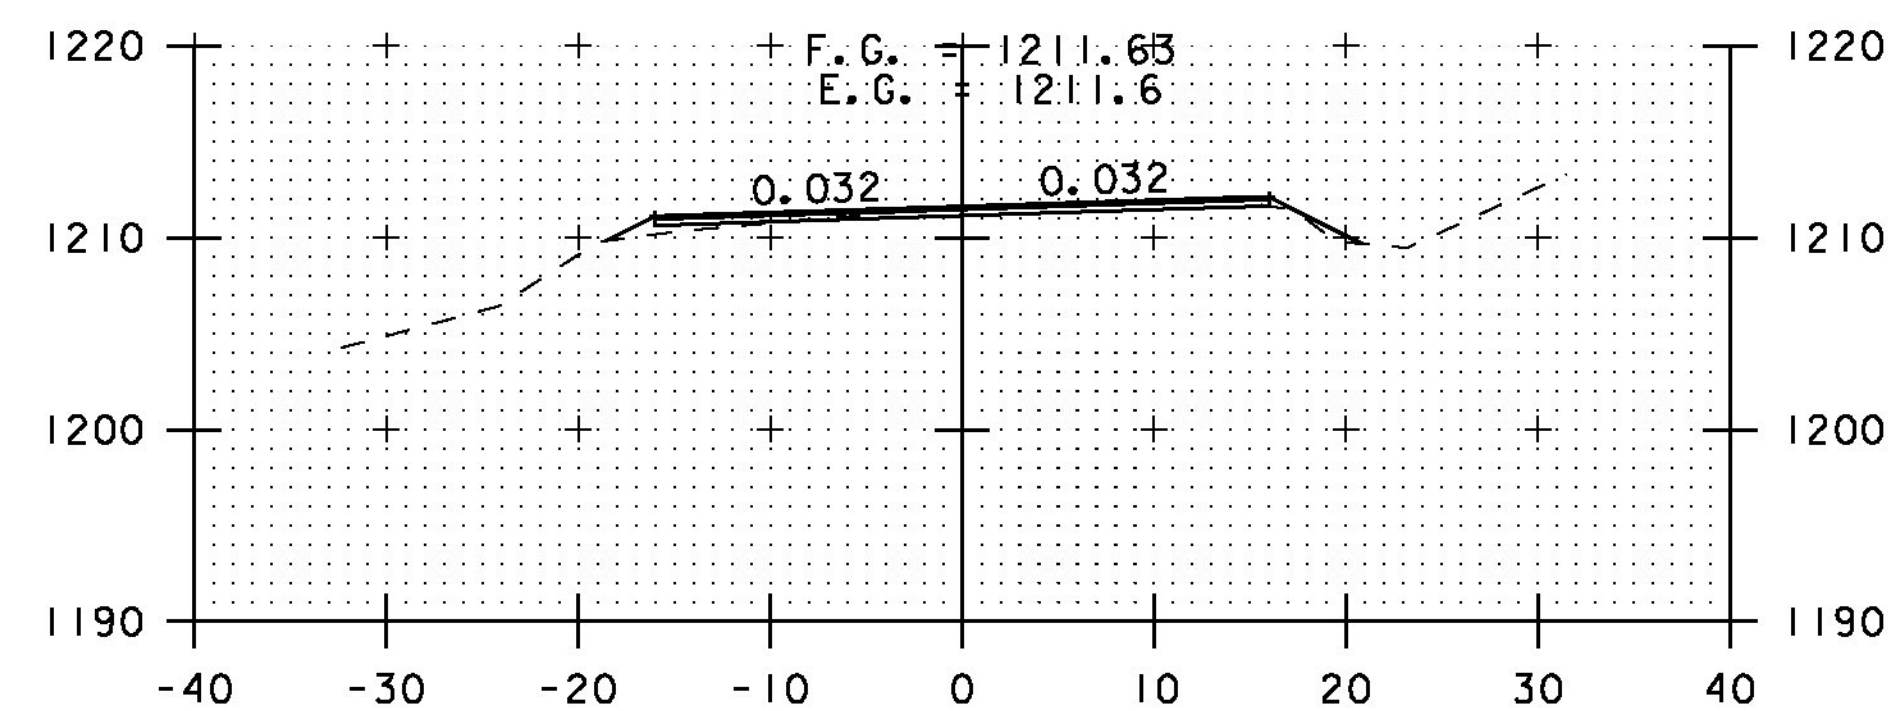

326+00

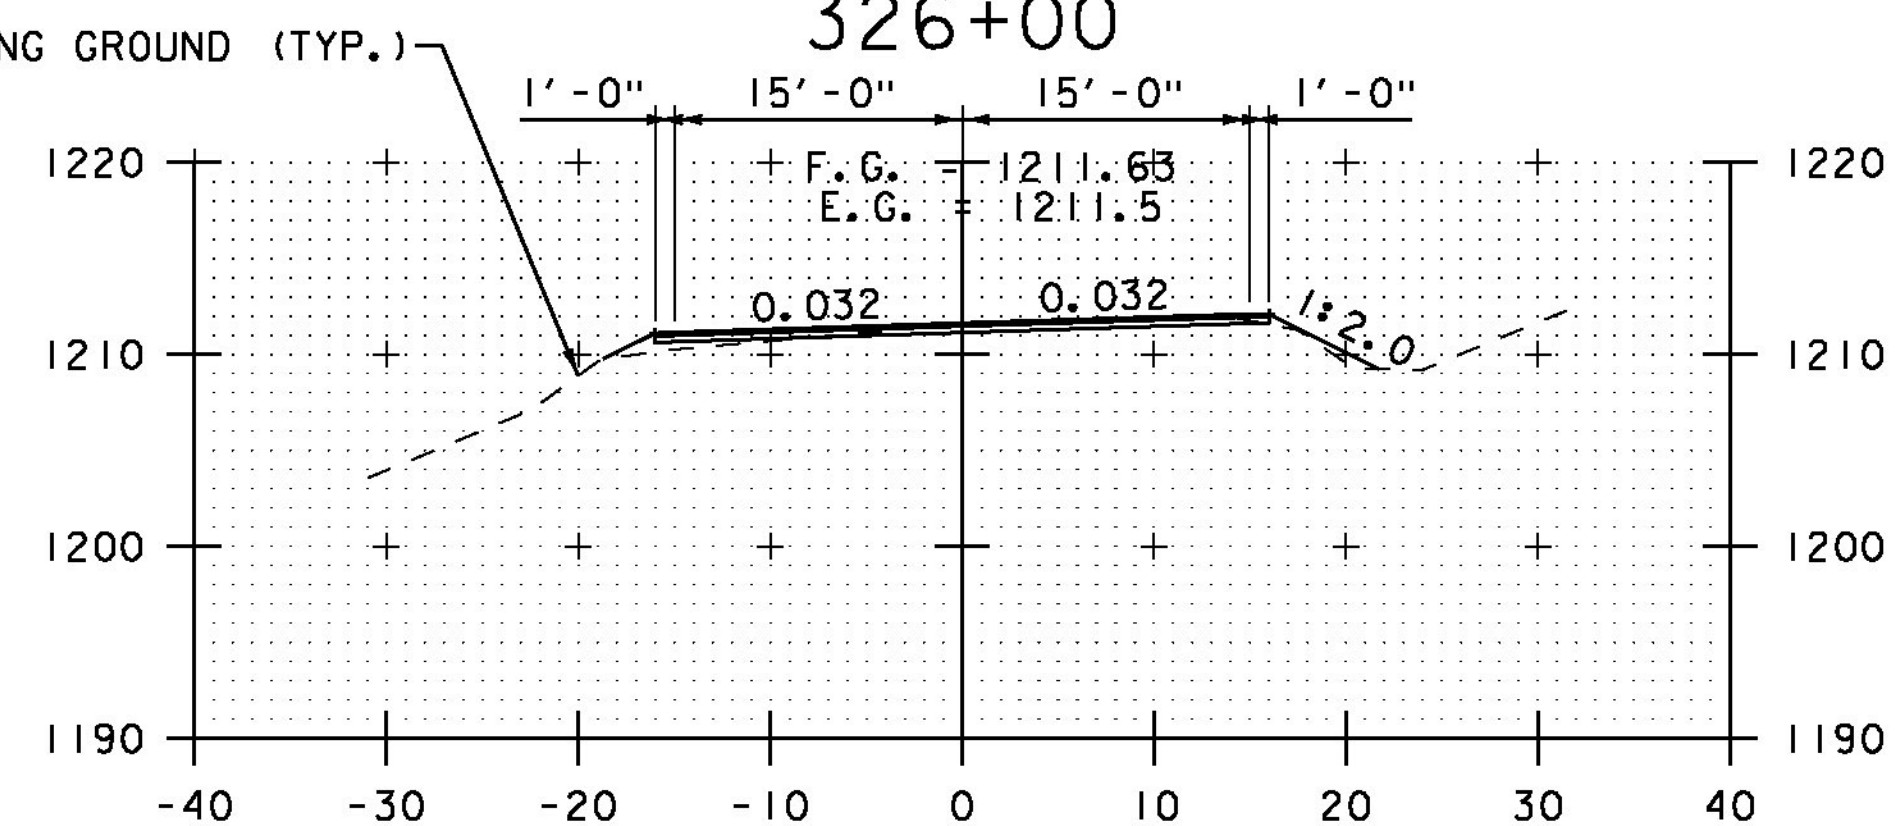

325+50

SCALE 1" = 10'-0"
10 0 10

STA. 322+00 TO STA. 326+50

**CROSS
SECTION
SHEET 25**

PROJECT NAME: ELMORE-MORRISTOWN
PROJECT NUMBER: STP 2937 (1)

FILE NAME: z11c310.dgn
PROJECT LEADER: C. LATHROP
DESIGNED BY: S. LAMPHERE
PLOT FILE: z11c310_153.i

PLOT DATE: 3/3/14
DRAWN BY: B. MARTIN
CHECKED BY: C. LATHROP
SHEET 153 OF 194