
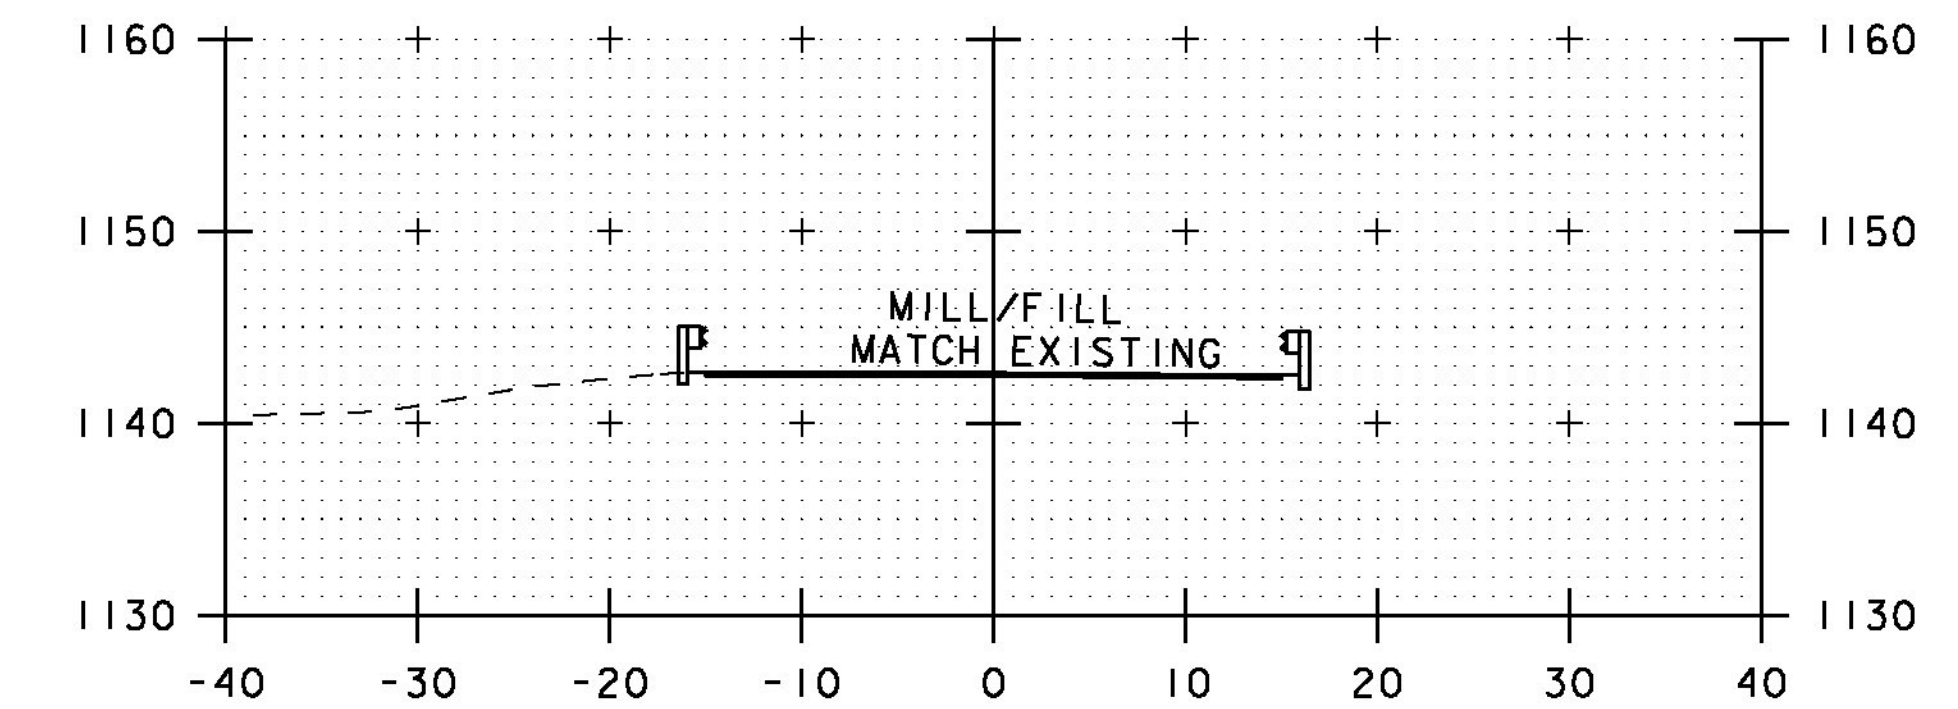
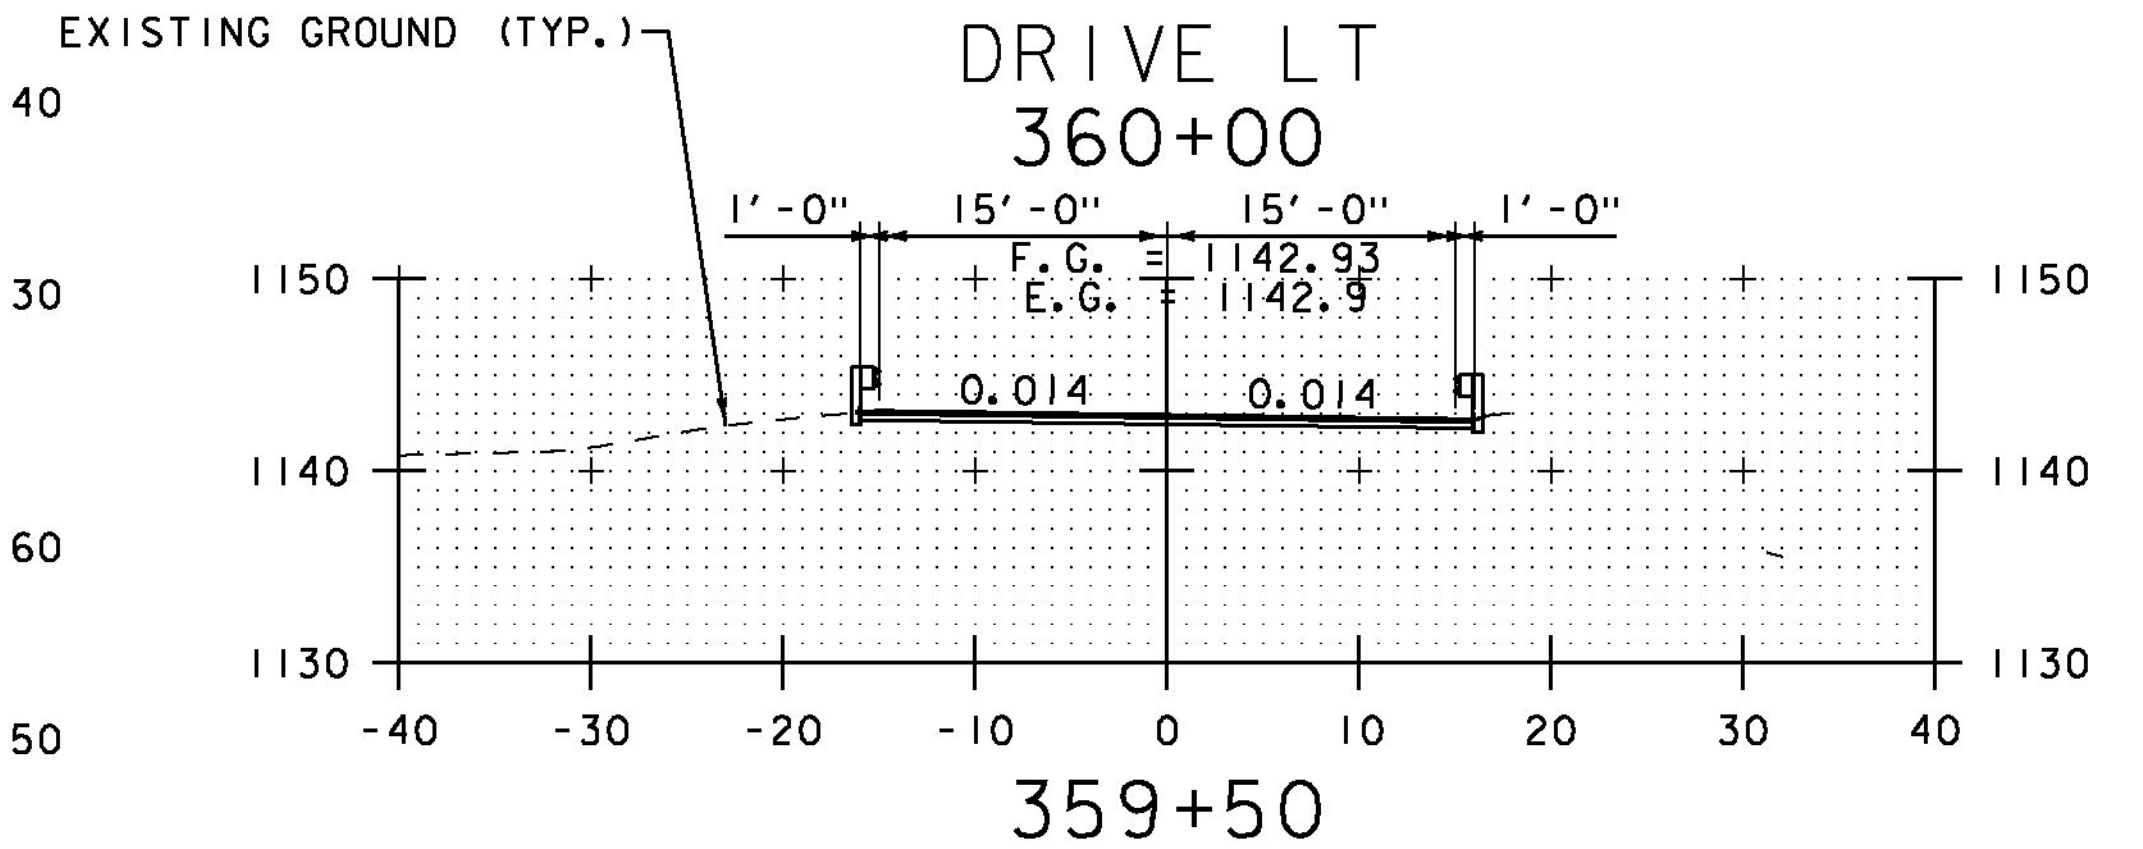
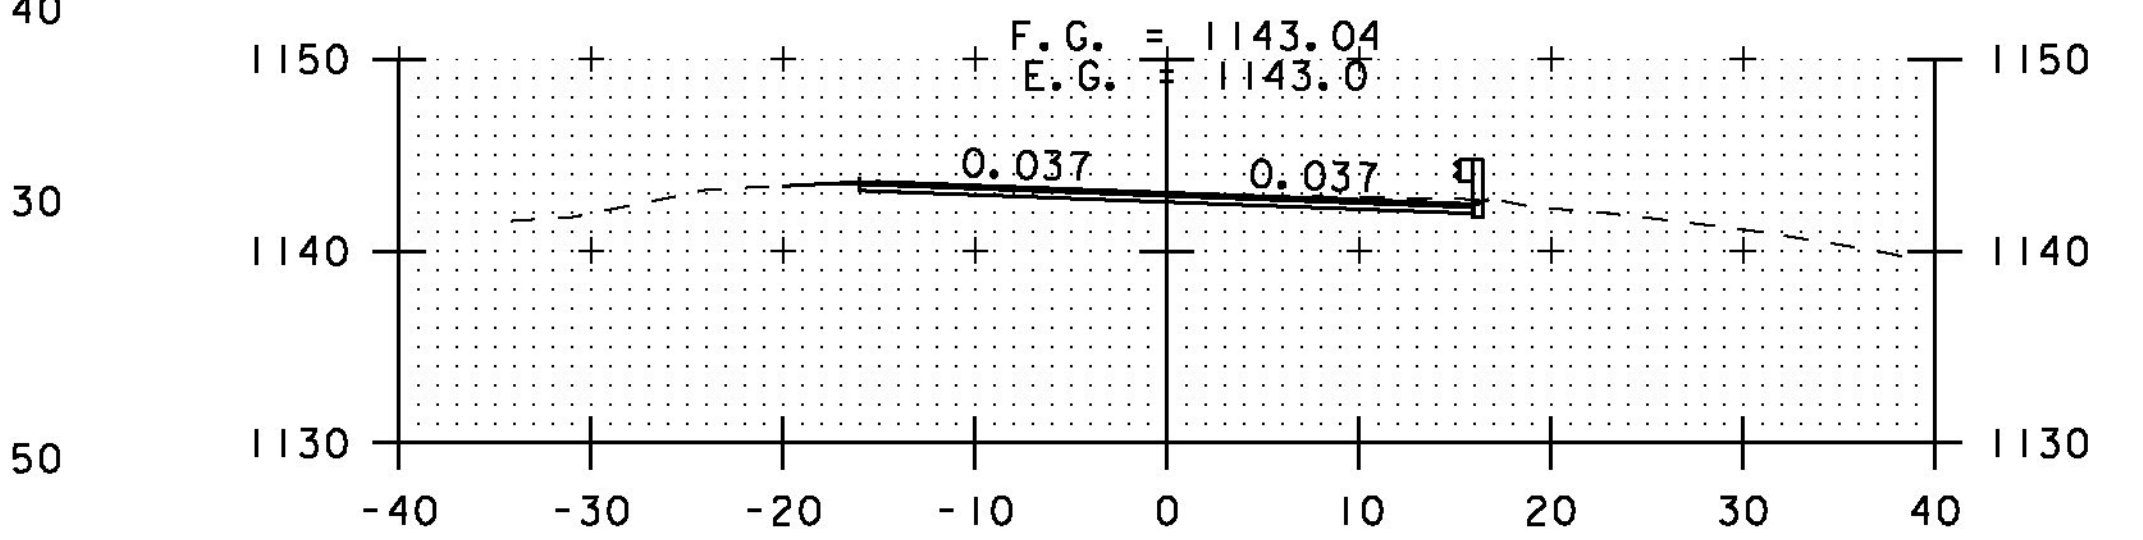
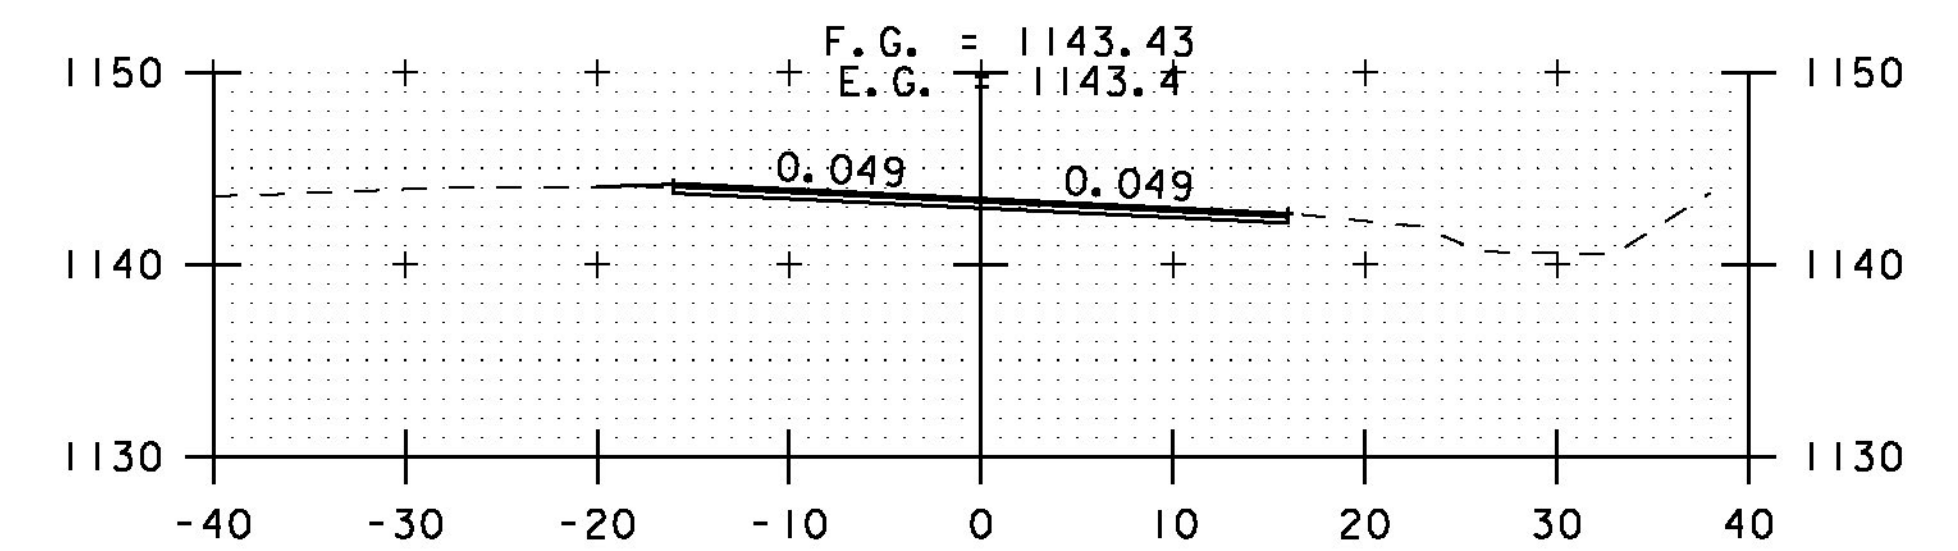
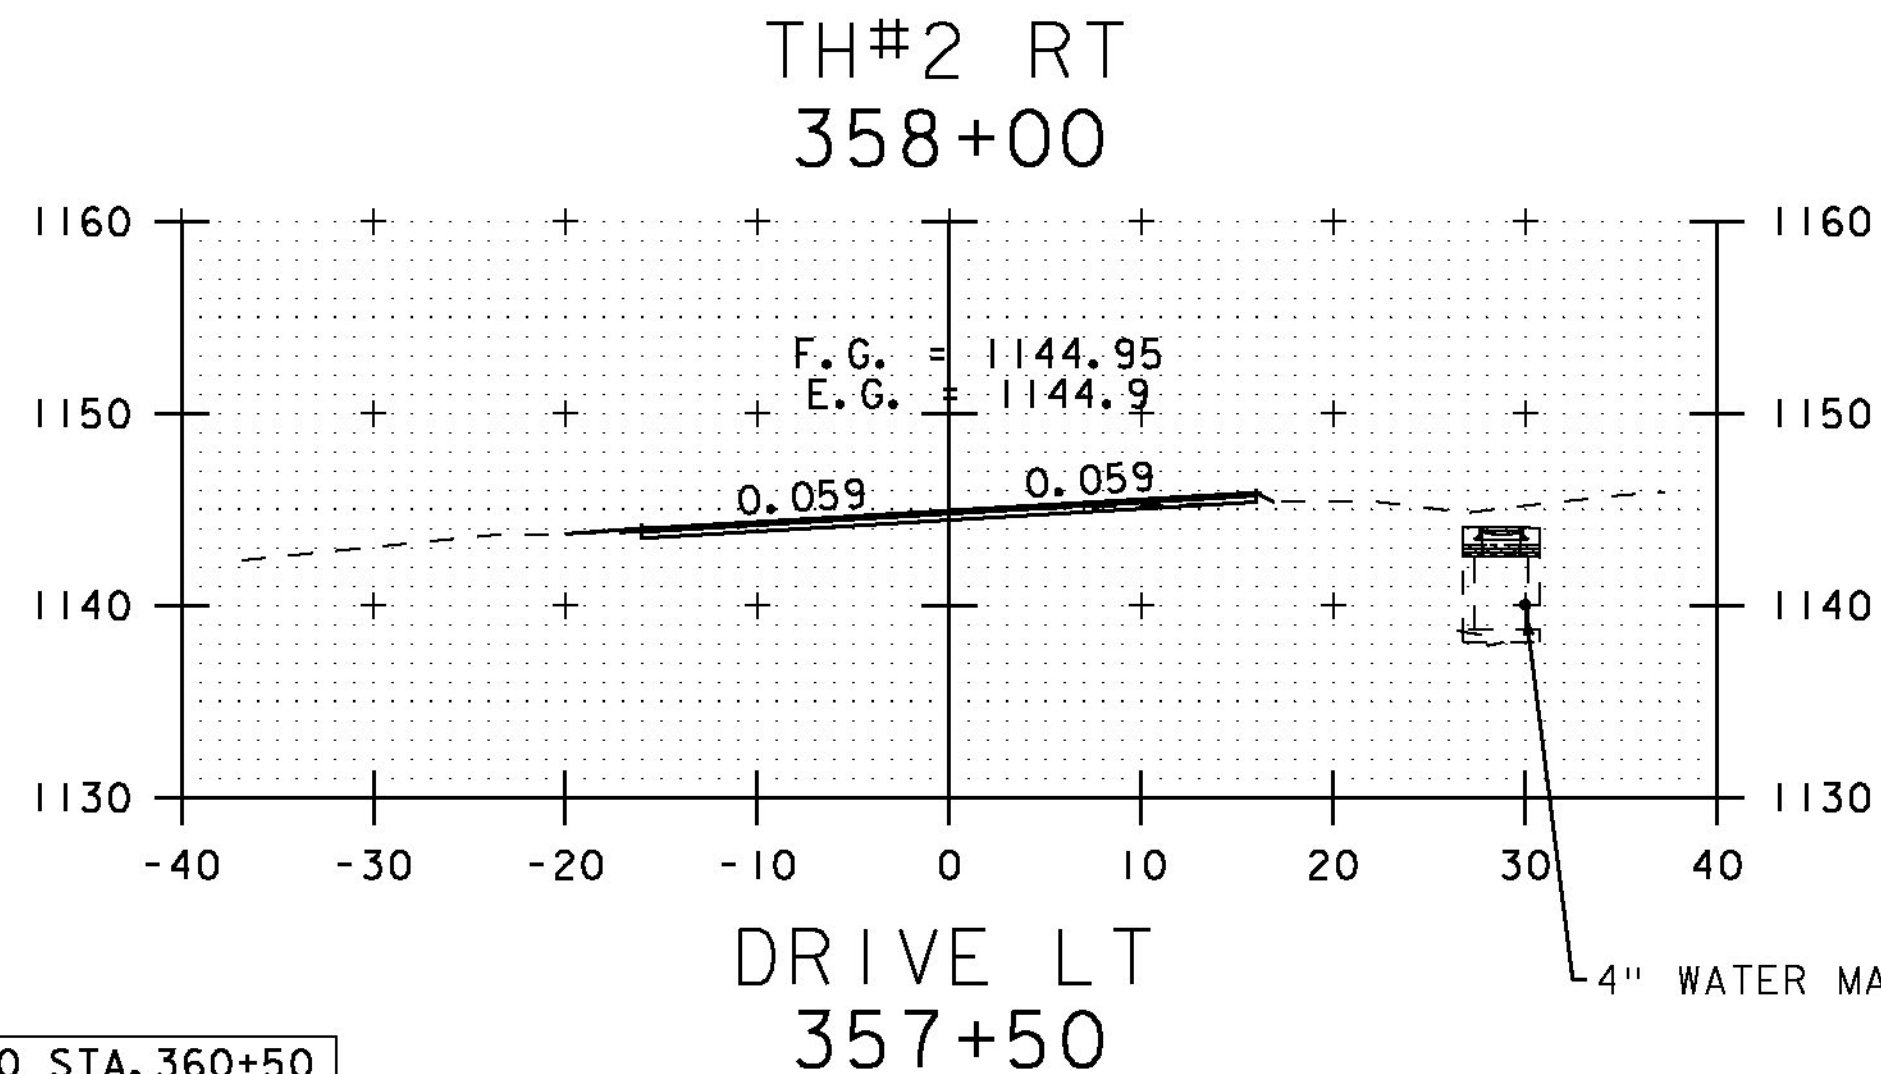
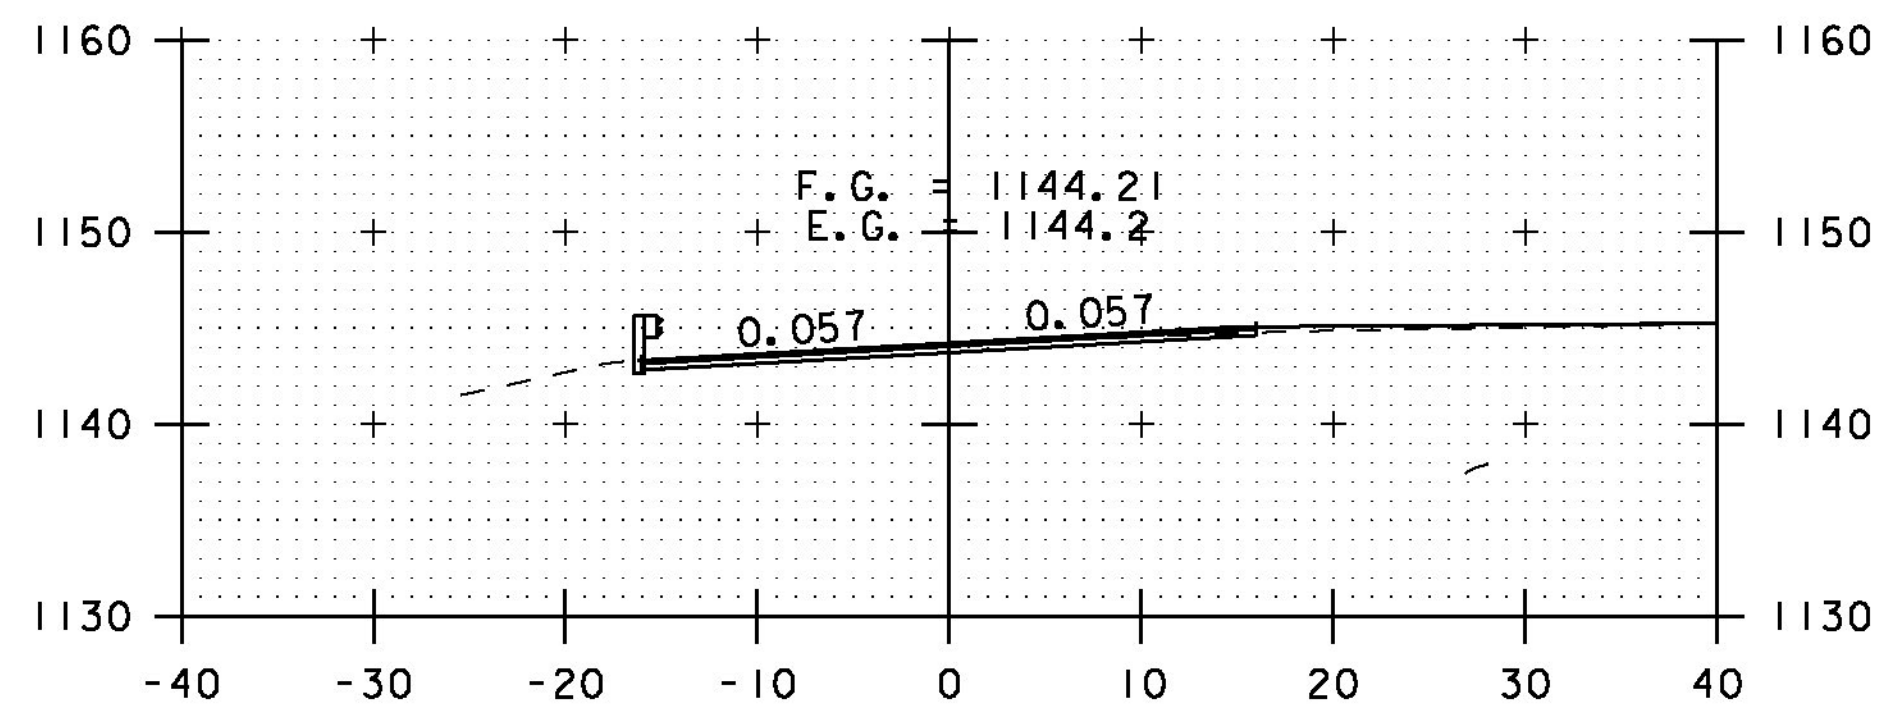
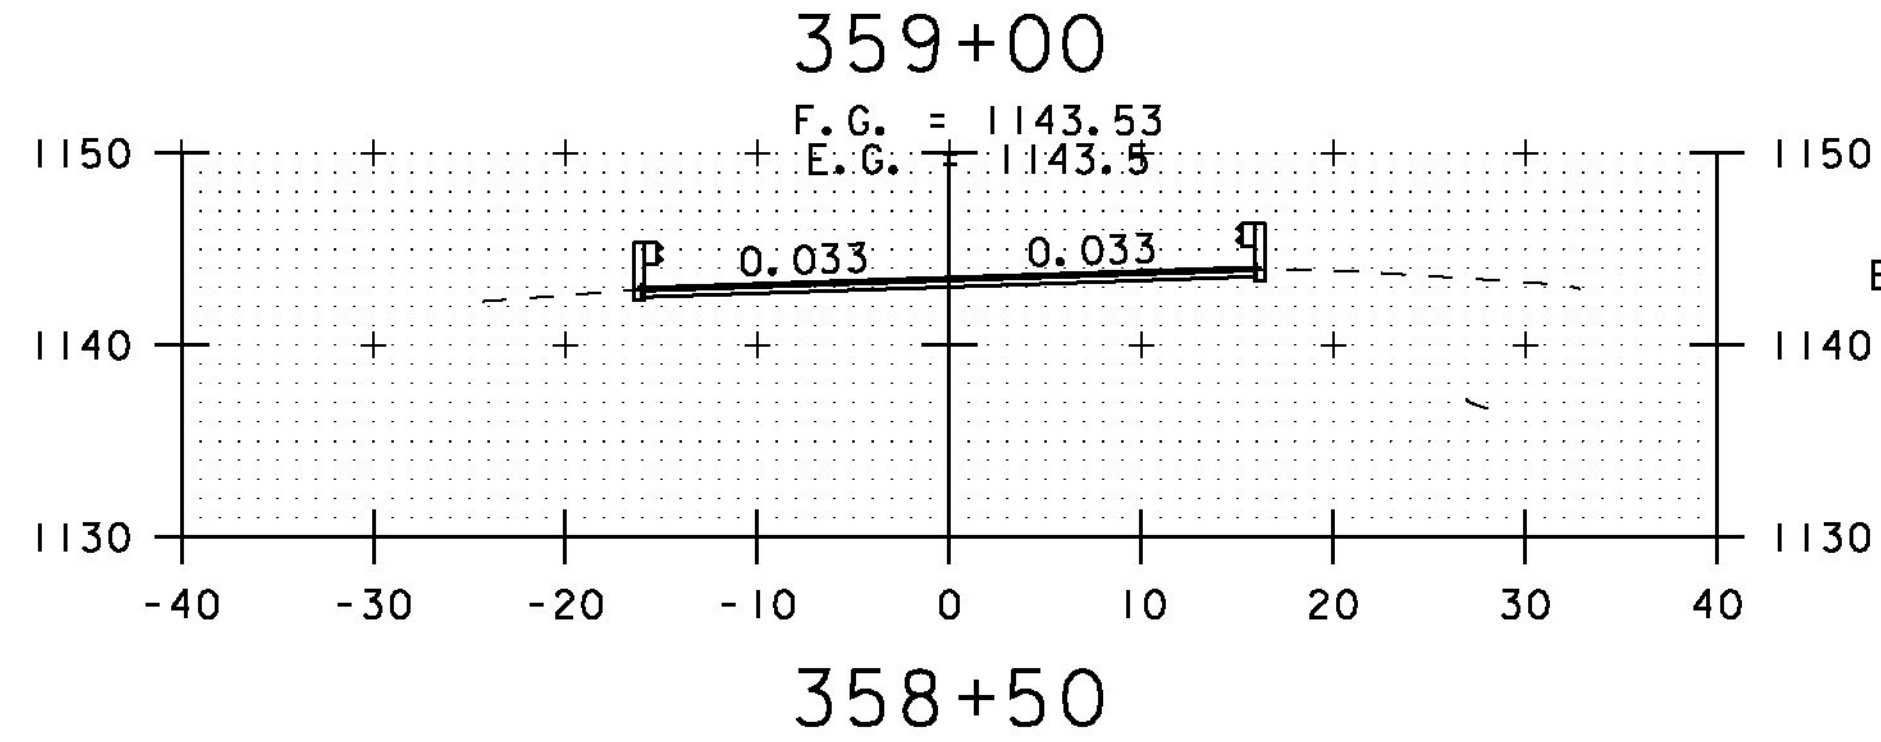
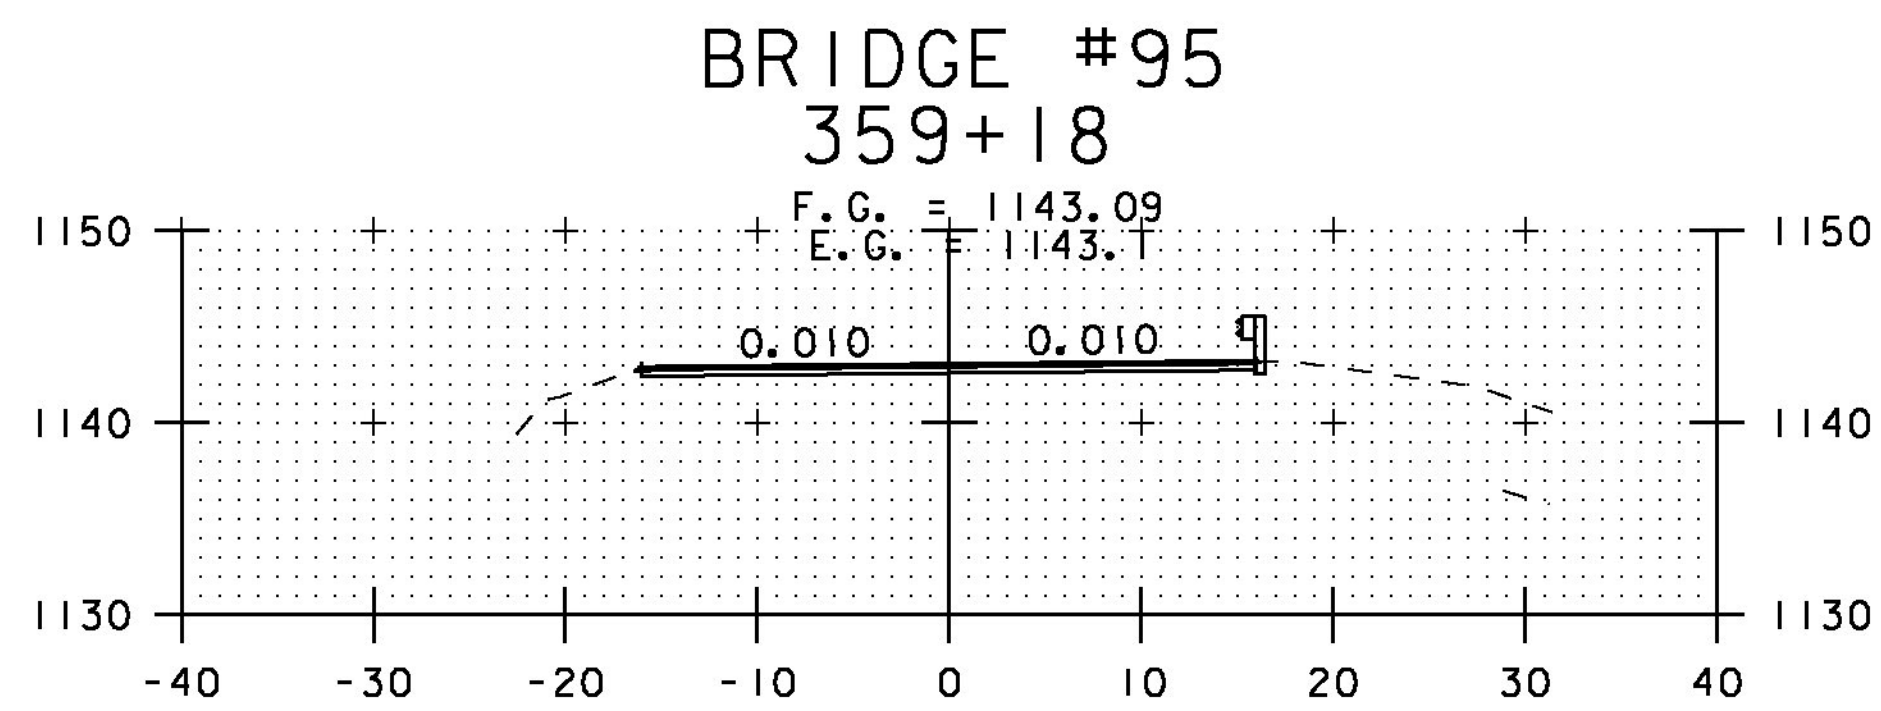
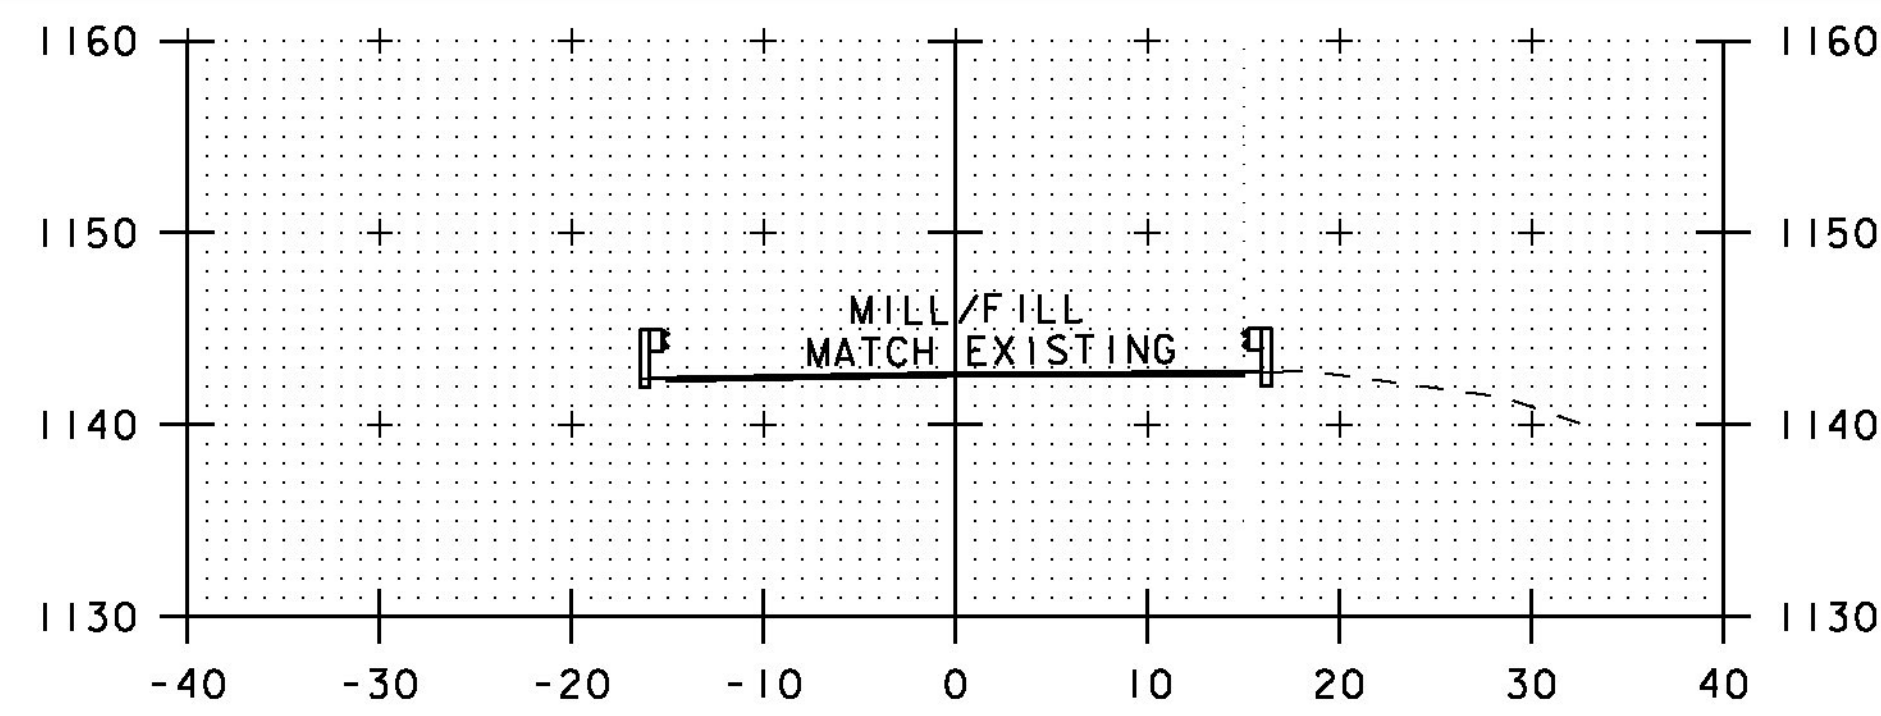
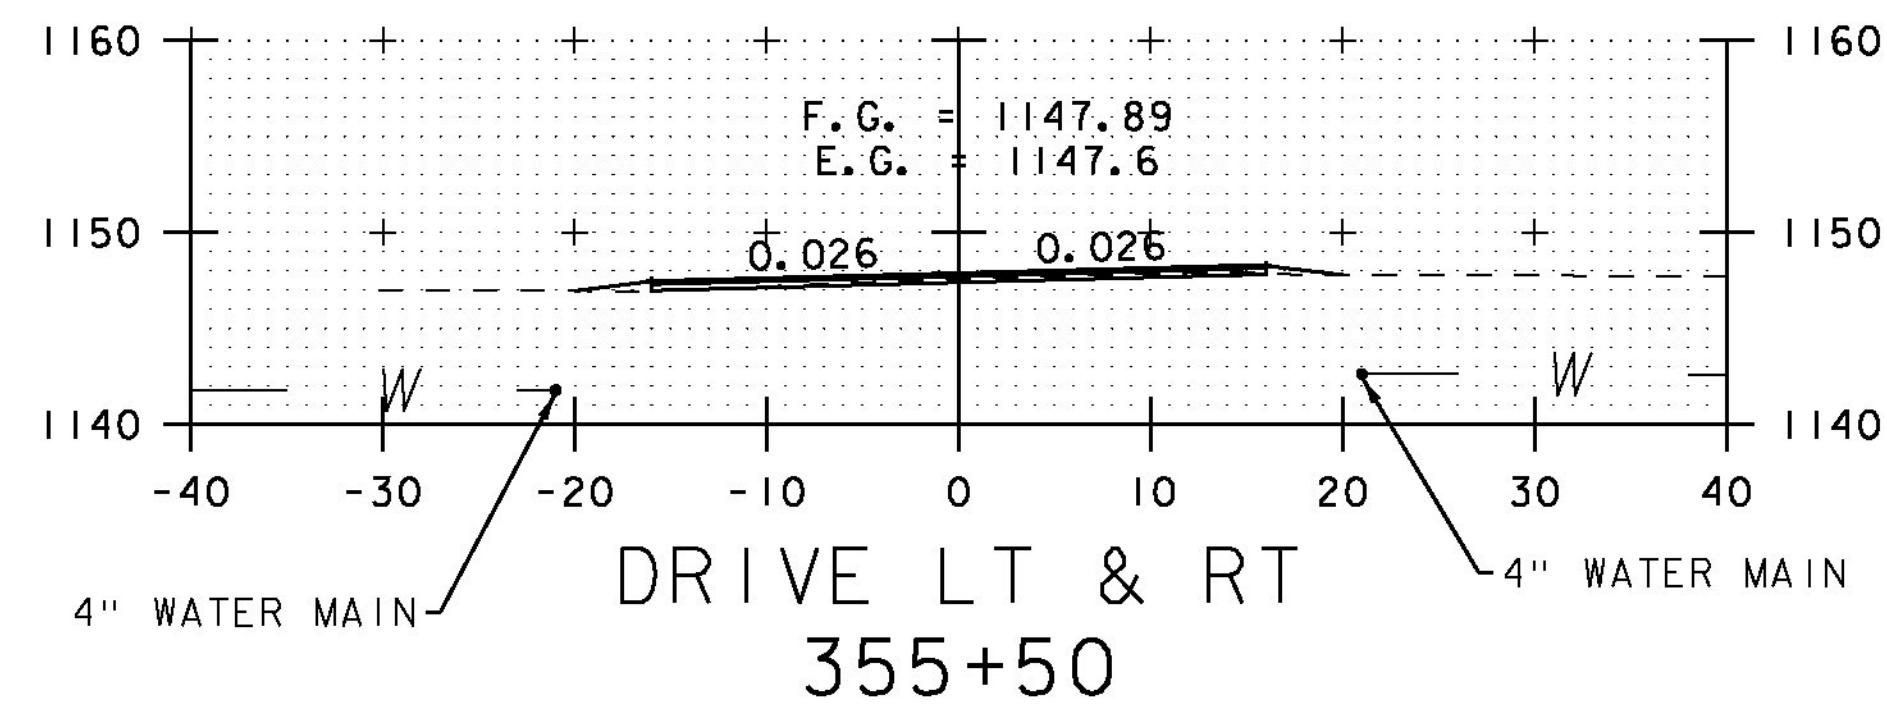
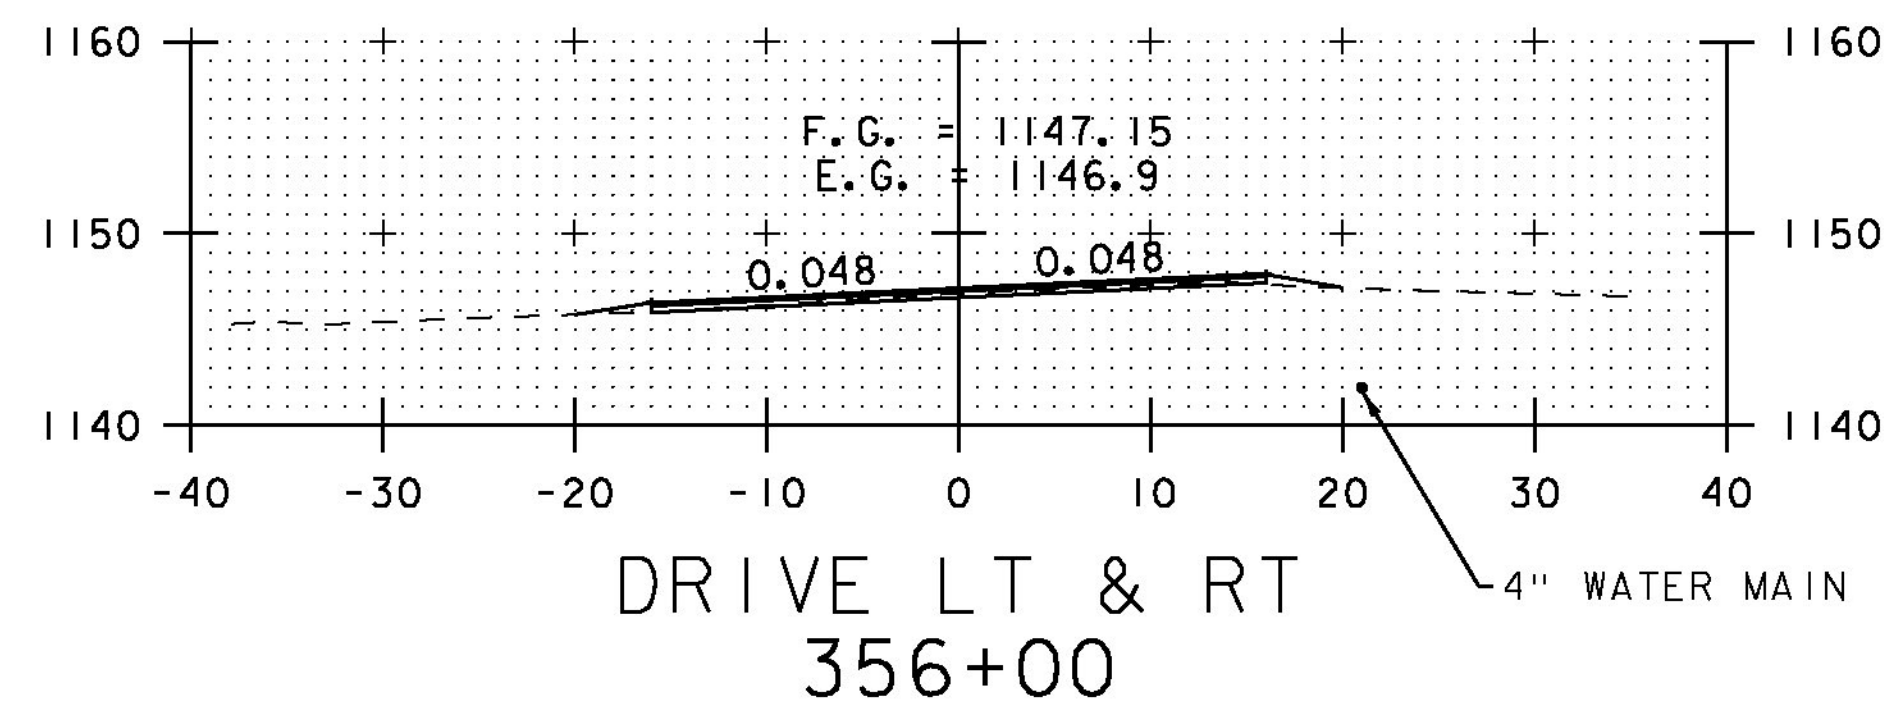
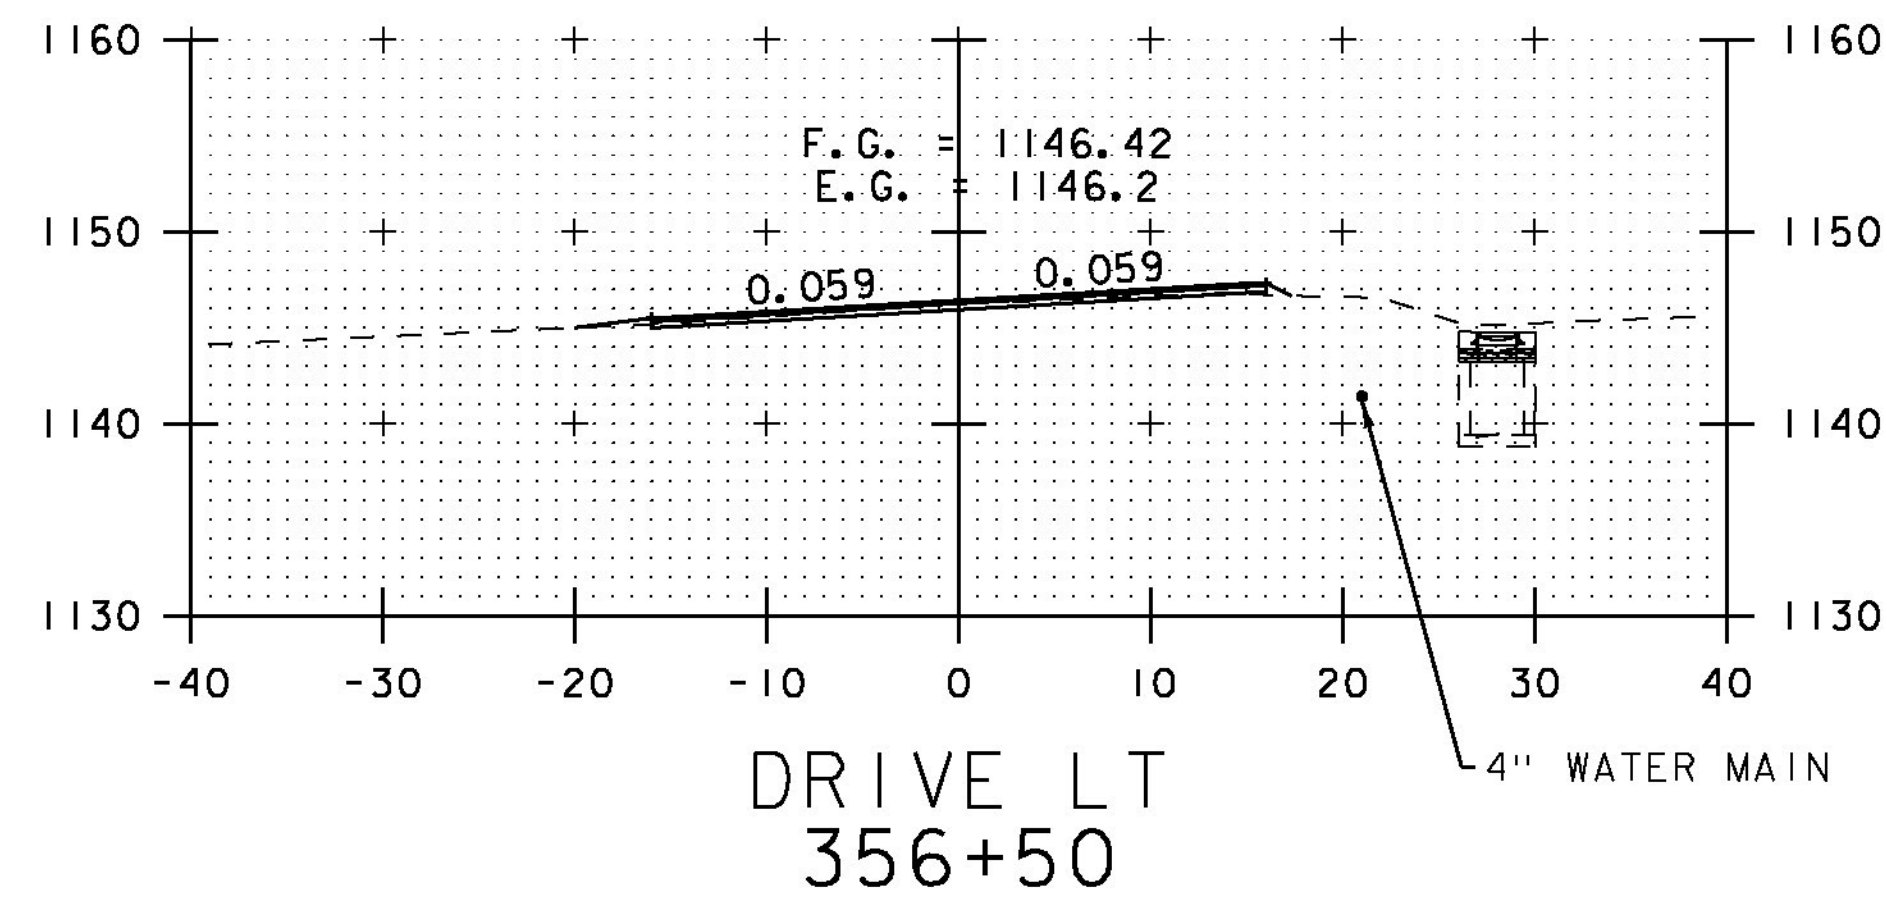


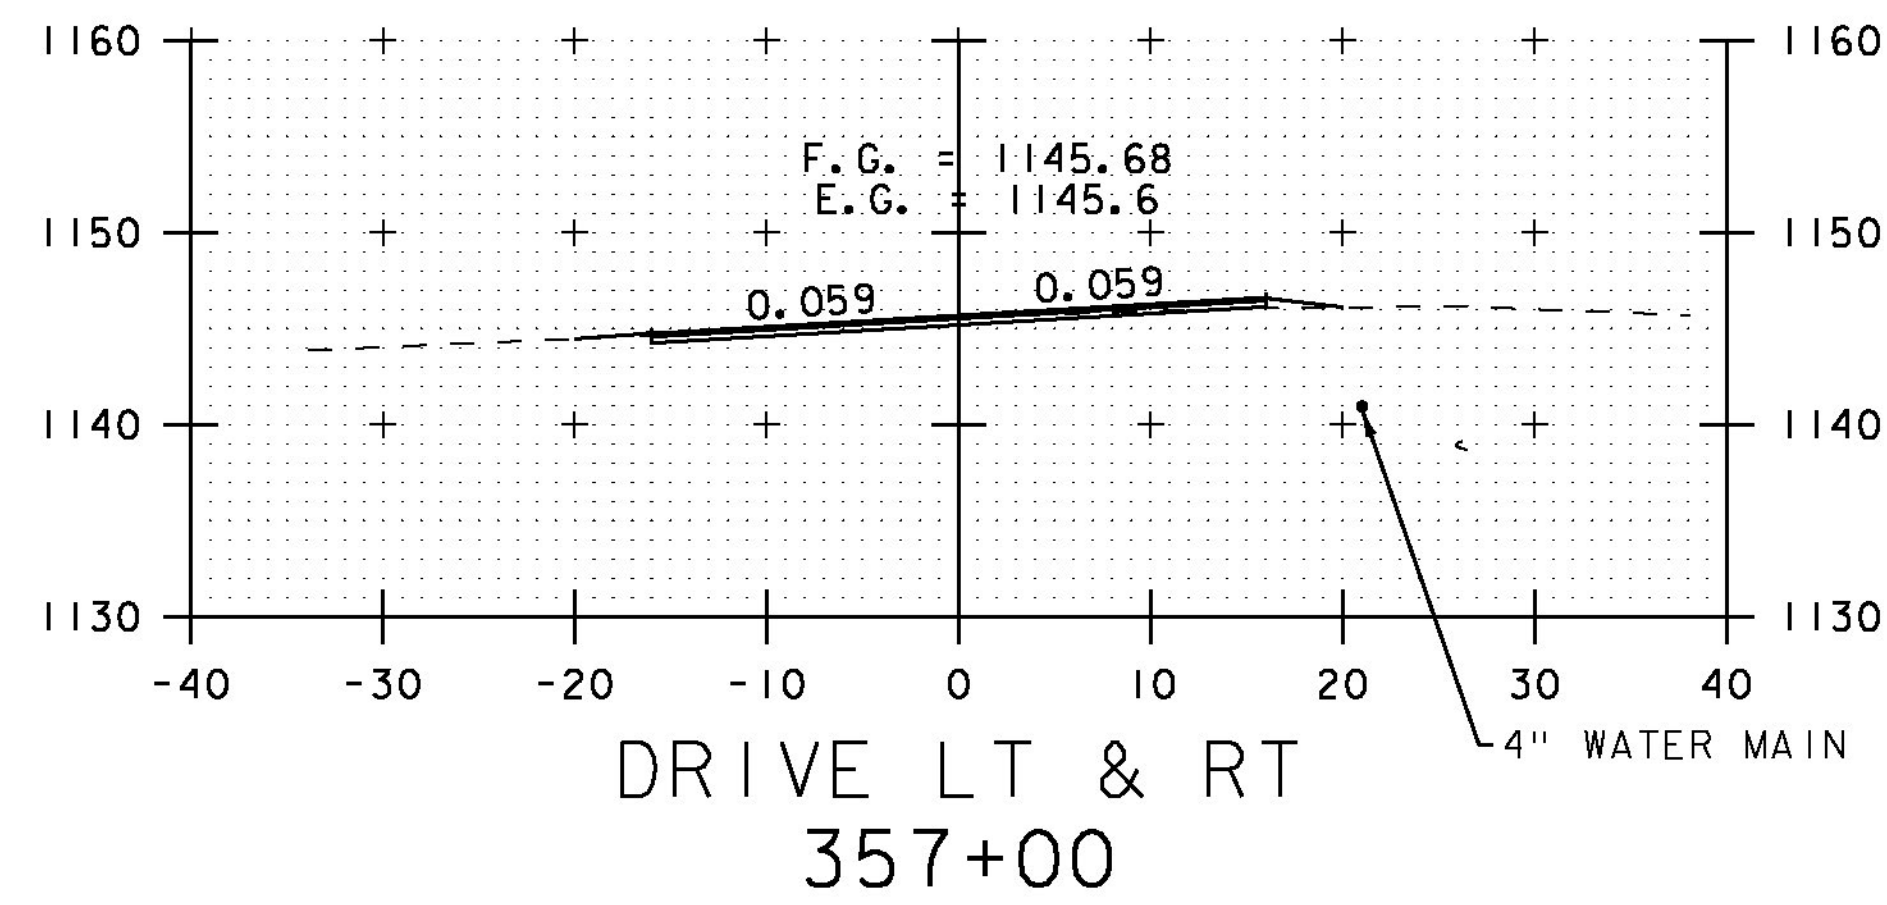

SCALE 1" = 10'-0"

STA. 355+50 TO STA. 360+50

**CROSS
SECTION
SHEET 31**

PROJECT NAME: ELMORE-MORRISTOWN

PROJECT NUMBER: STP 2937 (1)

FILE NAME: z11c310.dgn

PROJECT LEADER: C. LATHROP

DESIGNED BY: S. LAMPHERE

PLOT FILE: z11c310_159.i

PLOT DATE: 3/3/14

DRAWN BY: B. MARTIN

CHECKED BY: C. LATHROP

SHEET 159 OF 194