

STATE OF VERMONT
AGENCY OF TRANSPORTATION






PROPOSED IMPROVEMENT
TOWN OF POULTNEY
COUNTY OF RUTLAND
VT ROUTE 30 (MINOR ARTERIAL)

BEGINNING IN THE TOWN OF POULTNEY ON VERMONT ROUTE 30 AT STATION 278+00.00 (MM 5.265)
AND EXTENDING NORTHERLY APPROXIMATELY 500.00 FEET (0.095 MILE) TO STATION 283+00.00 (MM 5.359).

WORK TO BE PERFORMED UNDER THIS PROJECT INCLUDES ROADWAY RECONSTRUCTION, SLOPE STABILIZATION,
LEDGE REMOVAL, DRAINAGE AND OTHER HIGHWAY RELATED ITEMS.

LENGTH OF PROJECT: ROADWAY 500.00 FEET = 0.095 MILES

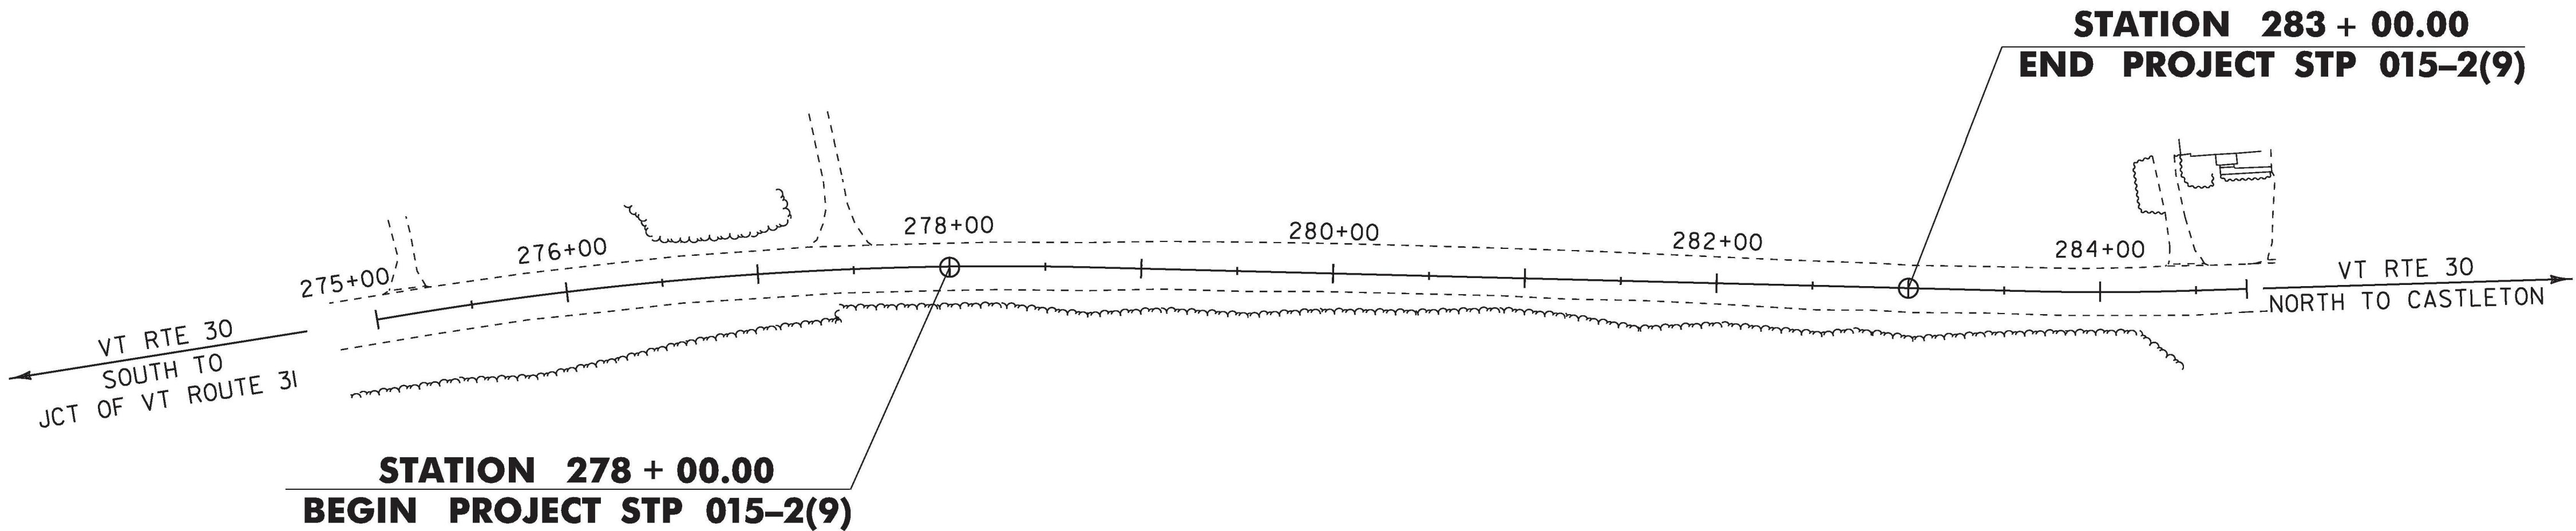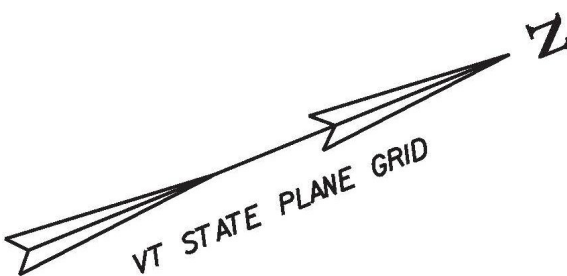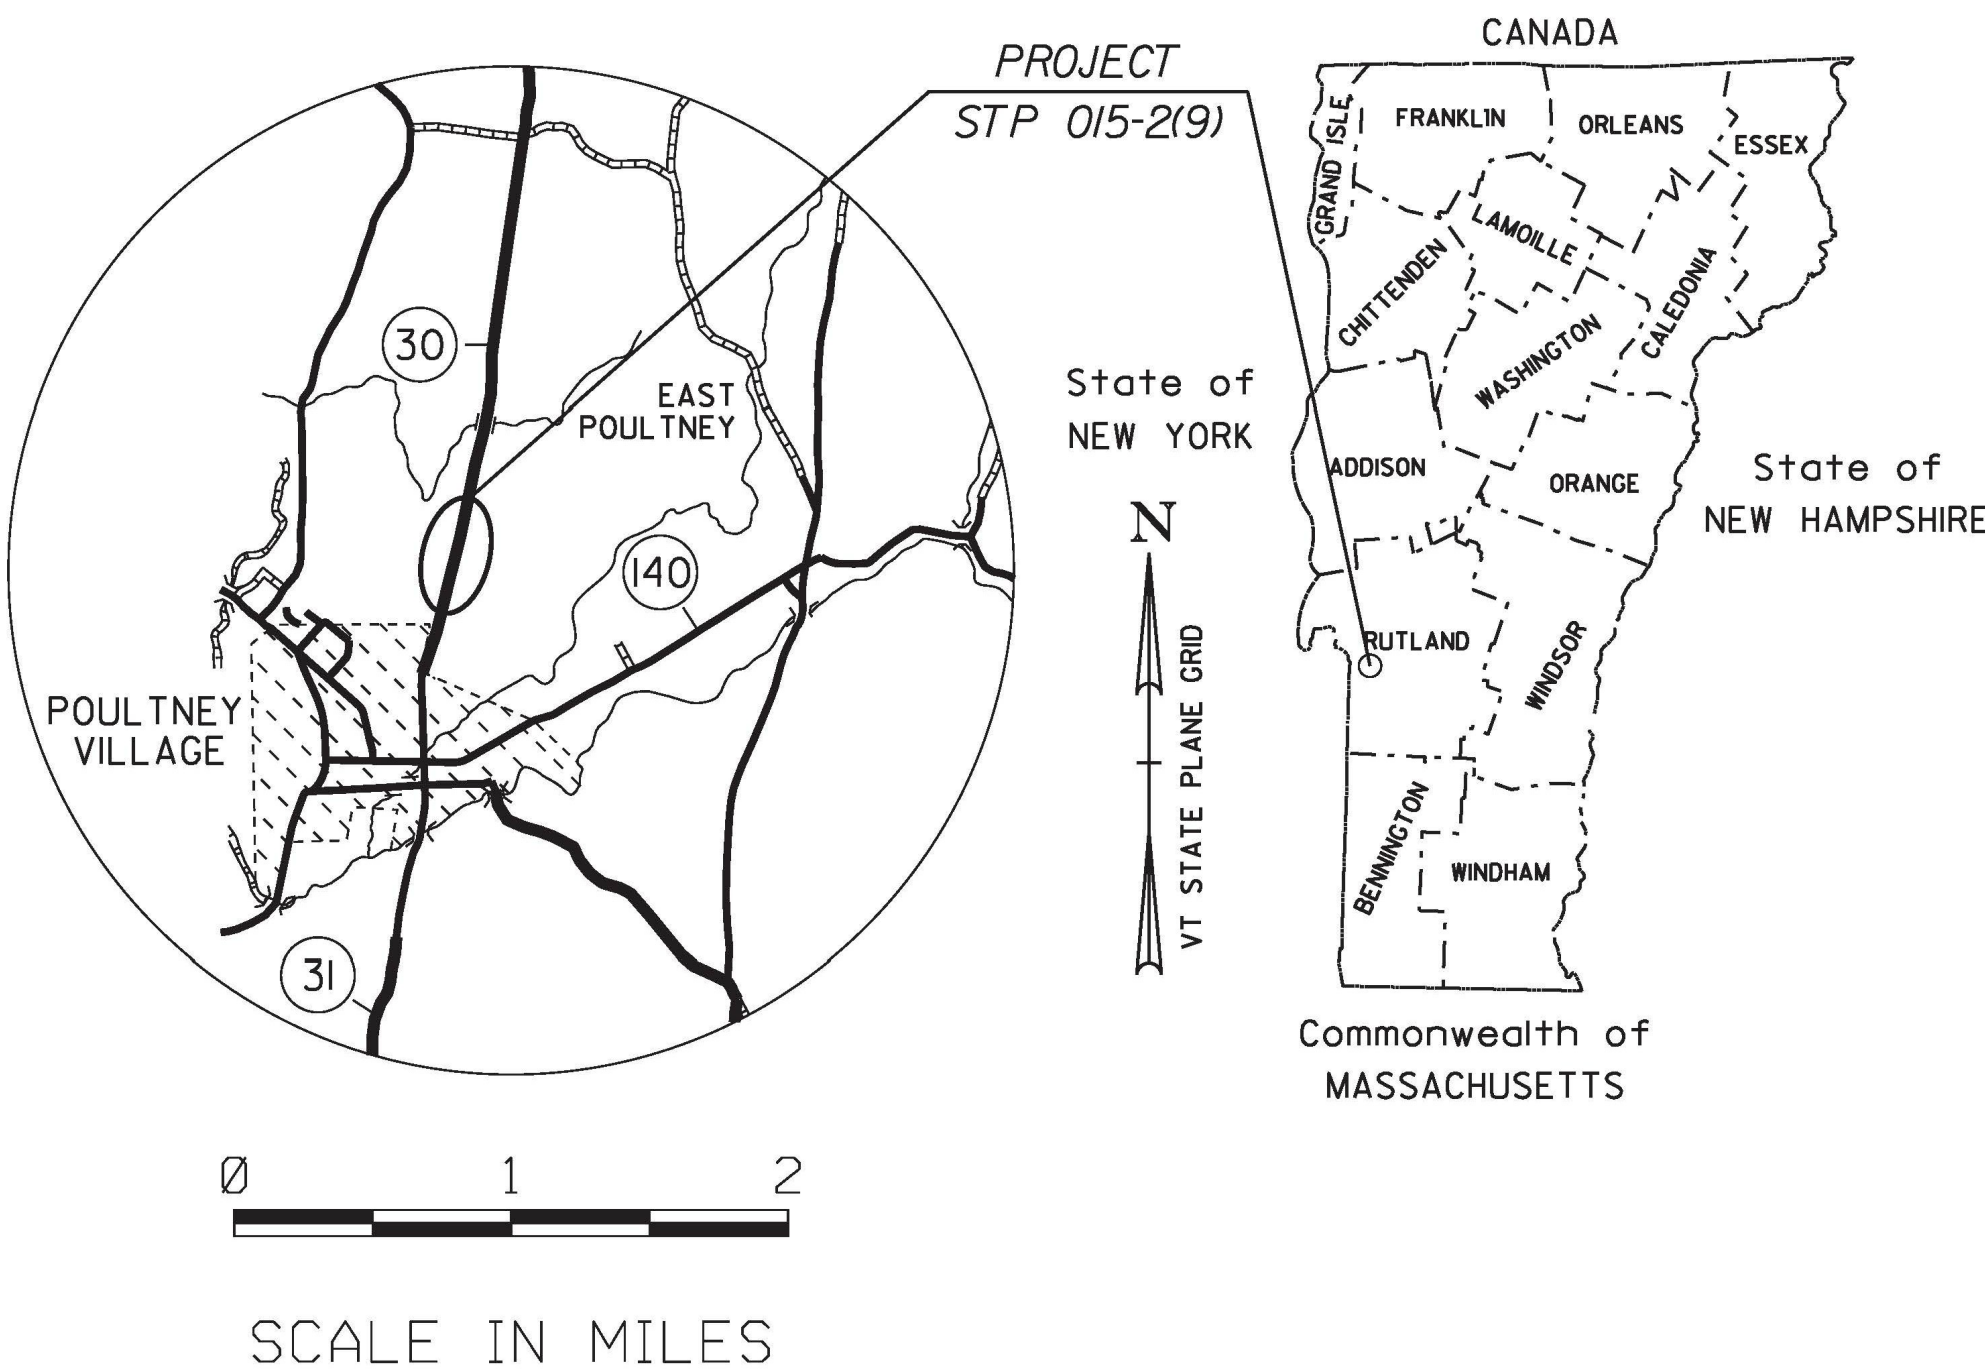


CONSTRUCTION IS TO BE CARRIED ON IN ACCORDANCE
WITH THESE PLANS AND THE STANDARD SPECIFICATIONS
FOR CONSTRUCTION DATED 2011, AS APPROVED BY THE
FEDERAL HIGHWAY ADMINISTRATION ON JULY 20, 2011
FOR USE ON THIS PROJECT, INCLUDING ALL SUBSEQUENT
REVISIONS AND SUCH REVISED SPECIFICATIONS AND
SPECIAL PROVISIONS AS ARE INCORPORATED IN THESE
PLANS.

QUALITY ASSURANCE PROGRAM : LEVEL 2	
SURVEYED BY :	VTRANS
SURVEYED DATE :	2011
DATUM	
VERTICAL	NAVD88
HORIZONTAL	NAD83(92)

TRAFFIC DATA
VERMONT ROUTE 30

	2015	2035	2055
AADT	3200	3400	-
DHV	360	380	-
ADTT	230	390	-
% T	5.3	8.4	-
% D	64	64	-
FLEXIBLE ESAL	-	2015-2035 1,245,000	2015-2055 2,848,000

POSTED SPEED LIMIT = 50 MPH

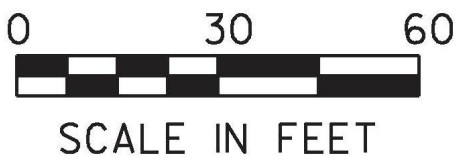

Record Plans
Contractor: B.U.R. CONSTRUCTION, LLC
Resident Engineer: JACE CURTIS
Construction Began: APRIL 10, 2019
Construction Complete: SEPTEMBER 30, 2019
Record Plans By: JUDY GILMORE

I hereby certify that all construction required by this set of drawings has been
accomplished as indicated herein.

E-SIGNED by Jace Curtis
on 2021-01-11 18:10:49 GMT Resident Engineer

Date: January 11, 2021

NOTE: Any further information concerning final quantities, amounts or other
details relative to this project may be found at Central Files in the electronic
archives.

DIRECTOR OF PROJECT DELIVERY	
APPROVED	<u>Wayne Symonds, PE</u> DATE <u>Aug 23, 2018</u>
PROJECT MANAGER : KEN UPMAL, P.E.	
PROJECT NAME :	POULTNEY
PROJECT NUMBER :	STP 015-2(9)
SHEET 1 OF 48 SHEETS	