



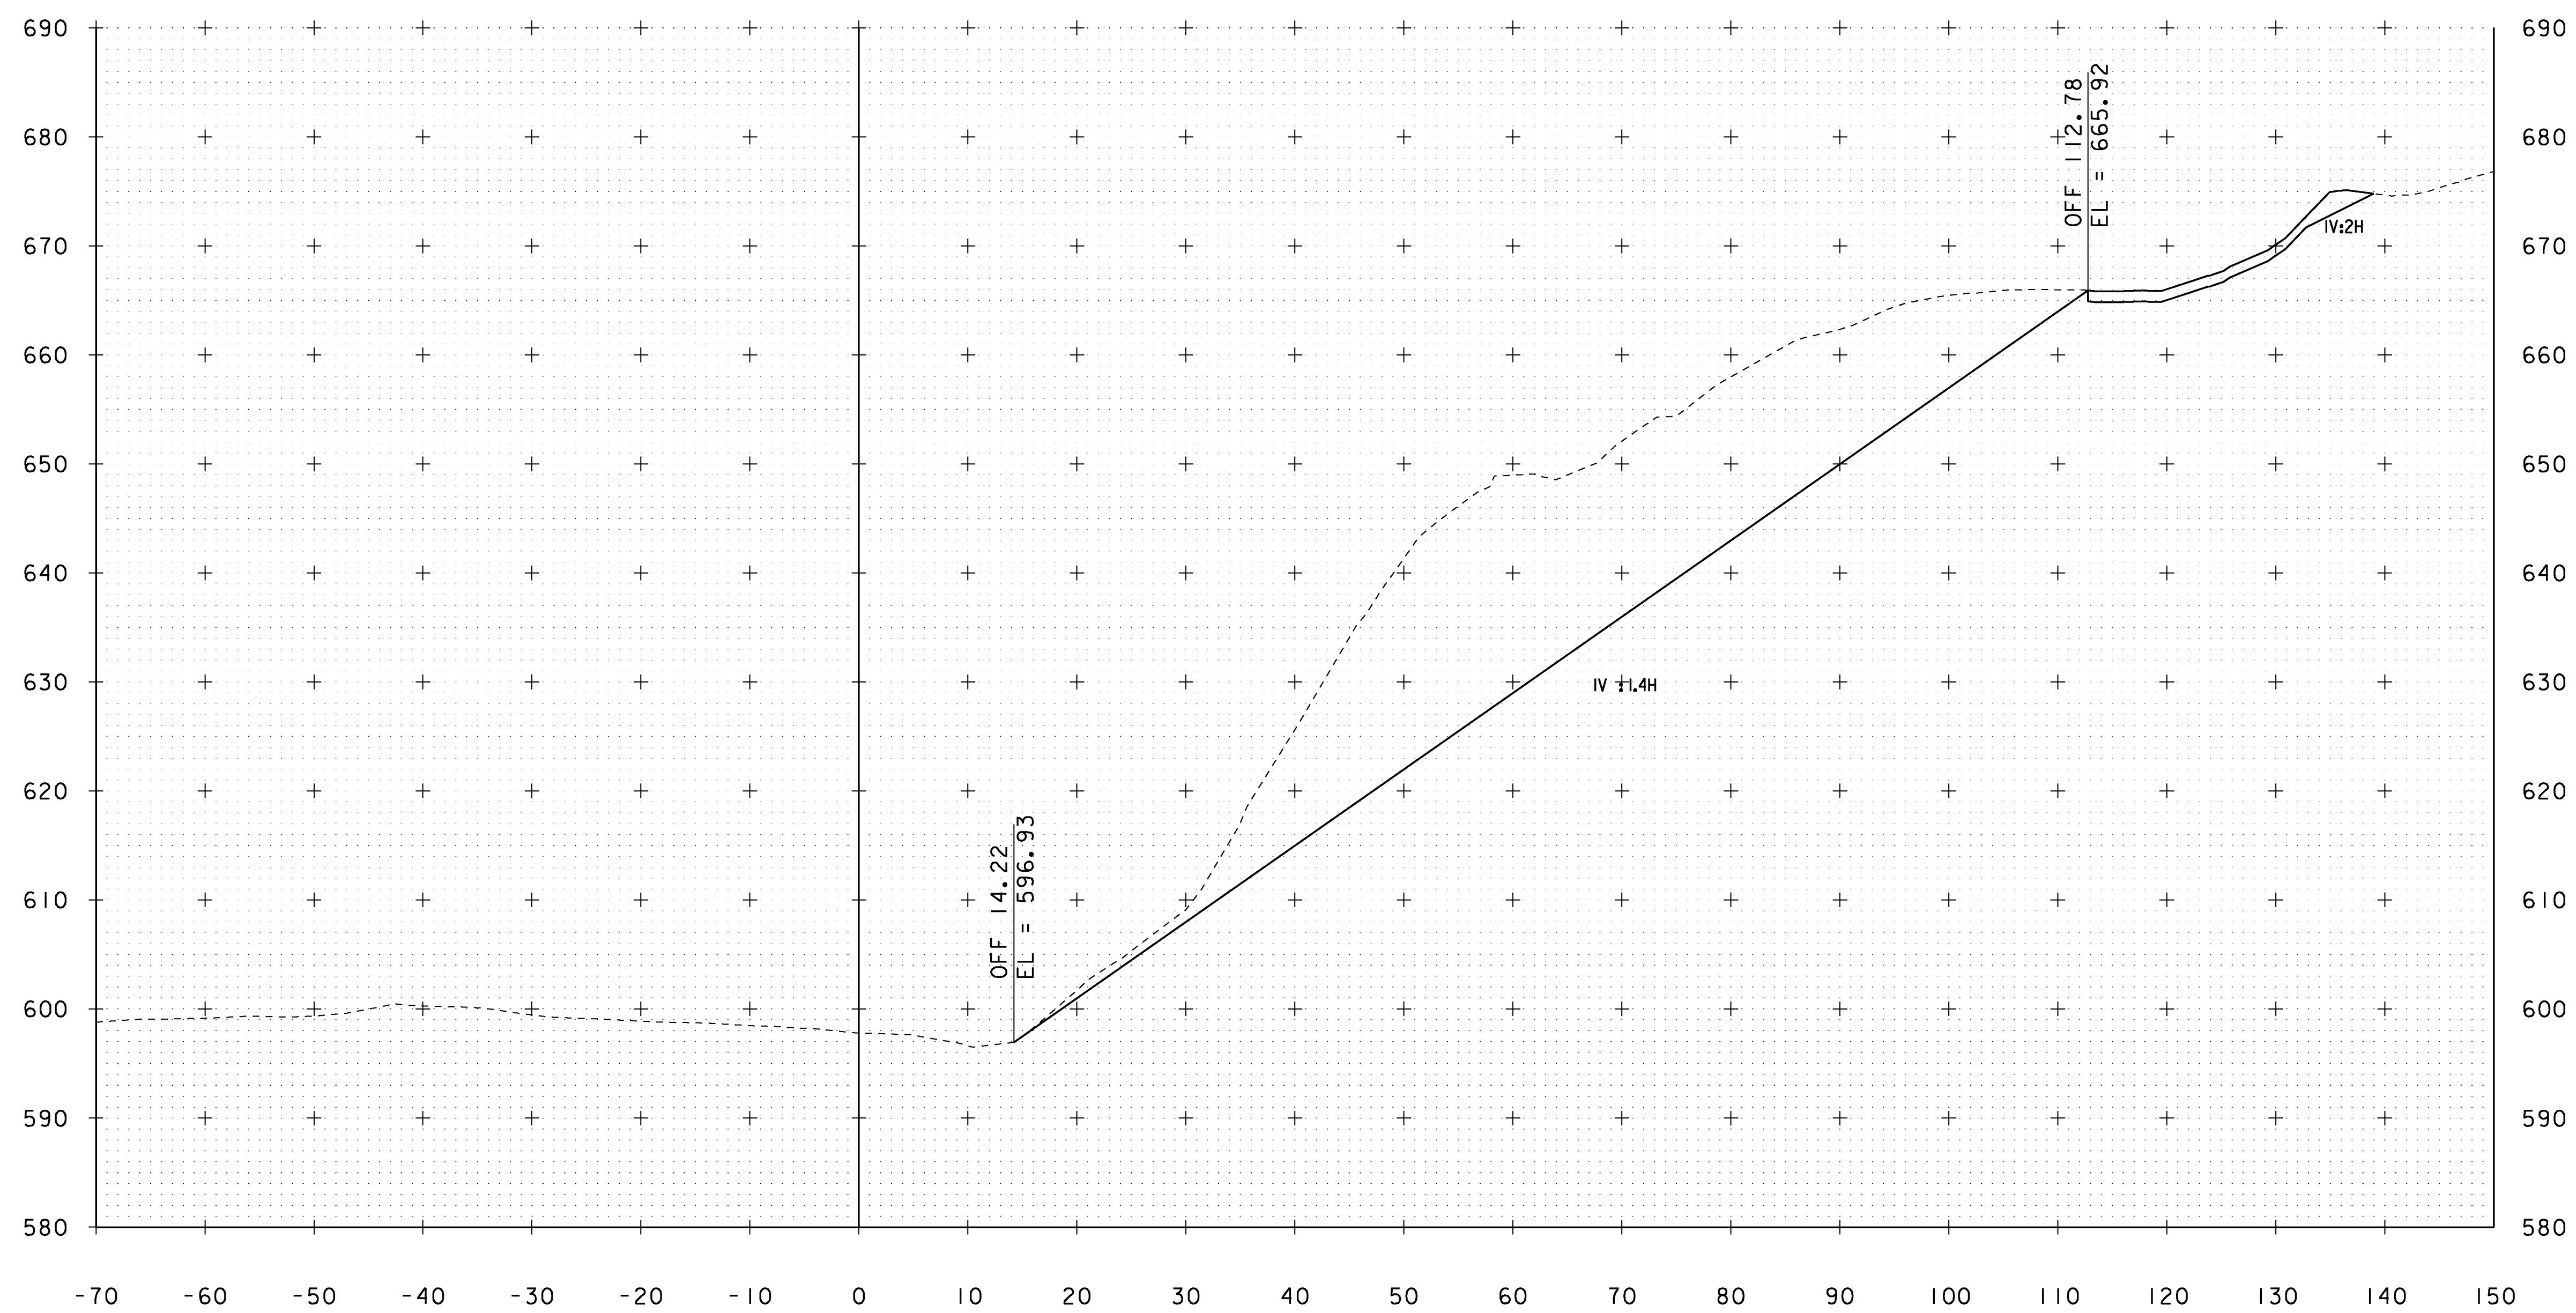

314+00
BEGIN SOLID ROCK EXCAVATION
312+00
RESUME PROJECT

RAMP B

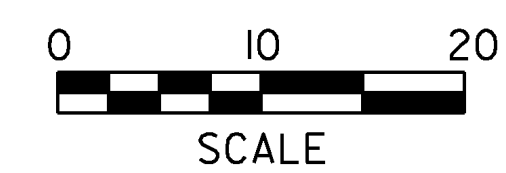

STA. 314+00

PROJECT NAME: MONTPELIER	
PROJECT NUMBER: NH 028-2(9)	
FILE NAME: I:\b066\Design\dlb066xs.dgn	PLOT DATE: 24-MAY-2013
PROJECT LEADER: P. PELOQUIN	DRAWN BY: P. PELOQUIN
DESIGNED BY: P. PELOQUIN	CHECKED BY: A. BOMBARDIER
CROSS SECTION SHEET 9	SHEET 27 OF 62