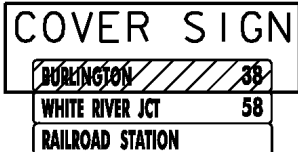


TRAFFIC SIGN SUMMARY SHEET 1

MILEMARKER, STATION, OR SIGN NUMBER	SIGN LEGEND	SIGN DIMENSIONS			NEW & SALVAGED SIGNS				EXIST POST RETAIN	S SALVAGE	NO. OF POSTS	NEW SIGN POSTS												REMARKS	SIGN DETAIL																																																																																																																																																																																																																																																																																																																																																																																																																																																																																																																																																																																																																												
												FLANGED CHANNEL			SQUARE STEEL (in)			TUBULAR ALUMINUM Ø (in)			TUBULAR STEEL Ø (in)				W-SHAPE STEEL				DETAIL ON SHEET NUMBER	STD. SHEET NUMBER																																																																																																																																																																																																																																																																																																																																																																																																																																																																																																																																																																																																																							
		EA	WIDTH (in)	HEIGHT (in)	"A"	"B"	SALV SIGN	SALV TIS				lb/ft			2.0 2.0 2.5		ANCHOR	SLEEVE	3.0 4.0 4.0 MOD			FOUND- ATION	3.0 3.5 4.0 5.0				FTG. SIZE				WEIGHT	POST SIZE																																																																																																																																																																																																																																																																																																																																																																																																																																																																																																																																																																																																																					
												1.12	2.0	3.0	2.16	2.42			3.35	1.3	1.7		1.7		7.6	9.0	10.8	14.6					24"	30"																																																																																																																																																																																																																																																																																																																																																																																																																																																																																																																																																																																																																			
												OPTION ITEMS																																																																																																																																																																																																																																																																																																																																																																																																																																																																																																																																																																																																																																									
①		1	24.0	12.0	2.00																												M4-8	SHSM																																																																																																																																																																																																																																																																																																																																																																																																																																																																																																																																																																																																																			
		1	24.0	12.0	2.00																												M3-1 (INTERSTATE)	SHSM																																																																																																																																																																																																																																																																																																																																																																																																																																																																																																																																																																																																																			
		1	24.0	24.0	4.00																												M1-1	SHSM																																																																																																																																																																																																																																																																																																																																																																																																																																																																																																																																																																																																																			
		1	21.0	15.0	2.19																												M6-1 (INTERSTATE)	SHSM																																																																																																																																																																																																																																																																																																																																																																																																																																																																																																																																																																																																																			
②		1	24.0	12.0	2.00																												M4-8	SHSM																																																																																																																																																																																																																																																																																																																																																																																																																																																																																																																																																																																																																			
		1	24.0	12.0	2.00																												M3-1 (INTERSTATE)	SHSM																																																																																																																																																																																																																																																																																																																																																																																																																																																																																																																																																																																																																			
		1	24.0	24.0	4.00																												M1-1	SHSM																																																																																																																																																																																																																																																																																																																																																																																																																																																																																																																																																																																																																			
		1	21.0	15.0	2.19																												M5-1 (INTERSTATE)	SHSM																																																																																																																																																																																																																																																																																																																																																																																																																																																																																																																																																																																																																			
③		1	24.0	12.0	2.00																												M3-3 (INTERSTATE)	SHSM																																																																																																																																																																																																																																																																																																																																																																																																																																																																																																																																																																																																																			
④		1	24.0	12.0	2.00																												M4-8	SHSM																																																																																																																																																																																																																																																																																																																																																																																																																																																																																																																																																																																																																			
		1	24.0	12.0	2.00																												M3-1 (INTERSTATE)	SHSM																																																																																																																																																																																																																																																																																																																																																																																																																																																																																																																																																																																																																			
		1	24.0	24.0	4.00																												M1-1	SHSM																																																																																																																																																																																																																																																																																																																																																																																																																																																																																																																																																																																																																			
		1	21.0	15.0	2.19																												M6-1 (INTERSTATE)	SHSM																																																																																																																																																																																																																																																																																																																																																																																																																																																																																																																																																																																																																			
		1	24.0	12.0	2.00																												M4-5	SHSM																																																																																																																																																																																																																																																																																																																																																																																																																																																																																																																																																																																																																			
		1	24.0	12.0	2.00																												M3-3 (INTERSTATE)	SHSM																																																																																																																																																																																																																																																																																																																																																																																																																																																																																																																																																																																																																			
		1	24.0	24.0	4.00																												M1-1	SHSM																																																																																																																																																																																																																																																																																																																																																																																																																																																																																																																																																																																																																			
		1	21.0	15.0	2.19																												M6-1 (INTERSTATE)	SHSM																																																																																																																																																																																																																																																																																																																																																																																																																																																																																																																																																																																																																			
⑤																																	COVER OR REMOVE SIGN: VD2-1 BURLINGTON 28																																																																																																																																																																																																																																																																																																																																																																																																																																																																																																																																																																																																																				
⑥		1	24.0	12.0	2.00																											M3-3 (INTERSTATE)	SHSM																																																																																																																																																																																																																																																																																																																																																																																																																																																																																																																																																																																																																				
SHSM = 2004 FHWA STANDARD HIGHWAY SIGNS & MARKINGS & 2012 SUPP. FYG = FLUORESCENT YELLOW GREEN												FT	FT	FT		FT	FT	FT		EA		LB	LB	LB			LB	LB	LB	LB																																																																																																																																																																																																																																																																																																																																																																																																																																																																																																																																																																																																																							