



STATE OF VERMONT AGENCY OF TRANSPORTATION

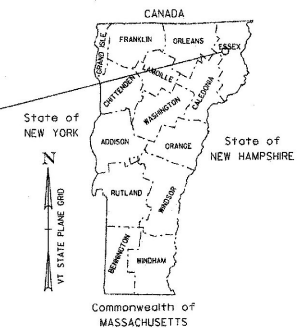

PROPOSED IMPROVEMENT BRIDGE PROJECT

TOWN OF BRIGHTON, ESSEX COUNTY
ROUTE NO : VT 105 (MINOR ARTERIAL) BRIDGE 84

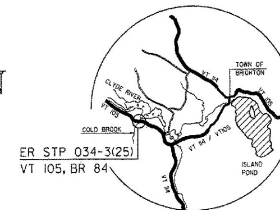


RECORD PLANS	
CONTRACTOR:	J.A. McDONALD INC. - LYNDON CENTER, VT
RESIDENT ENGINEER:	DOUG BUMPS
CONSTRUCTION BEGAN:	JUNE 28, 2013
CONSTRUCTION COMPLETE:	NOVEMBER 11, 2013
RECORD PLANS BY:	DOUG BUMPS & CRAIG PIERCE
I HEREBY CERTIFY THAT ALL THE CONSTRUCTION REQUIRED BY THIS SET OF DRAWINGS HAS BEEN ACCOMPLISHED AS INDICATED HEREIN.	
BY	RESIDENT ENGINEER
DATE	
NOTE: Any further information concerning final quantities, amounts or other details relative to this project may be found at Central Files in the electronic archives.	

PROJECT LOCATION: BEGINNING AT A POINT ON VT. ROUTE 105 APPROXIMATELY 1.058 MILES SOUTH EASTERLY OF THE CHARLESTON / BRIGHTON TOWN LINE AND EXTENDING EASTERLY 0.031 MILES.

PROJECT DESCRIPTION: REPLACEMENT OF BRIDGE 84 WITH A NEW CONCRETE STRUCTURE ON NEW ABUTMENTS, INCLUDING RELATED APPROACH AND CHANNEL WORK.

LENGTH OF STRUCTURE : 72.66 FEET
LENGTH OF ROADWAY : 97.34 FEET
LENGTH OF PROJECT : 170.00 FEET

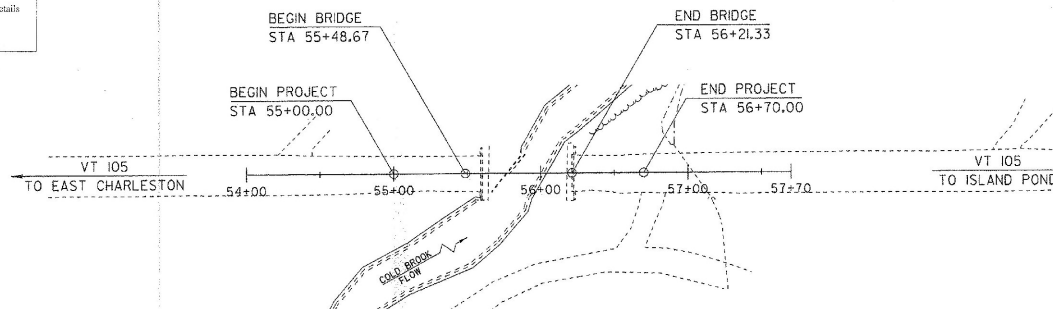

QUALITY ASSURANCE PROGRAM: LEVEL 2

CONVENTIONAL SYMBOLS

COUNTY LINE	
TOWN LINE	
LIMITS OF ACCESS	
POINT OF ACCESS	
FENCE LINE	
STONE WALL	
TRAVELED WAY	
GUARD RAIL	
RAILROAD	
SURVEY LINE	
CULVERT	
POWER POLE	
TELEPHONE POLE	
TREES	
CONTROL OF ACCESS	
PROPERTY LINE	
R.O.W. TAKING LINE	
SLOPE RIGHTS	
TOP OF CUT	
TOE OF SLOPE	

SURVEYED BY : R. GILMAN
SURVEYED DATE : 10/14/11

DATUM
VERTICAL NAVD 88
HORIZONTAL NAD 83 (07)

SCALE 1" = 40'-0"

THESE PLANS ARE SUBJECT TO SUCH ENGINEERING CHANGES AS MAY BE REQUIRED BY THE FEDERAL HIGHWAY ADMINISTRATION OR THE DIRECTOR OF PROGRAM DEVELOPMENT.

CONSTRUCTION IS TO BE CARRIED ON IN ACCORDANCE WITH THESE PLANS AND THE STANDARD SPECIFICATIONS FOR CONSTRUCTION DATED 2011, AS APPROVED BY THE FEDERAL HIGHWAY ADMINISTRATION ON JULY 20, 2011 FOR USE ON THIS PROJECT, INCLUDING ALL SUBSEQUENT REVISIONS AND SUCH REVISED SPECIFICATIONS AND SPECIAL PROVISIONS AS ARE INCORPORATED IN THESE PLANS.

DIRECTOR OF PROGRAM DEVELOPMENT	
APPROVED: <i>Richard P. Hignite</i>	DATE: 9/20/13
PROJECT MANAGER : K. HIGGINS	
PROJECT NAME : BRIGHTON	
PROJECT NUMBER : ER STP 034-3(25)	
SHEET 1 OF 36 SHEETS	

PRELIMINARY INFORMATION SHEET (BRIDGE)

Version: 11.28.15

LRFD

INDEX OF SHEETS					FINAL HYDRAULIC REPORT				
PLAN SHEETS					STANDARDS LIST				
1	TITLE SHEET				E-101	CONSTRUCTION APPROACH SIGNS	01-02-2004		
2	PRELIMINARY INFORMATION SHEET				E-101	CONSTRUCTION SIGN DETAILS	05-30-2003		
3	GENERAL NOTES				E-102	CONSTRUCTION SIGN DETAILS	06-30-2003		
4 - 5	QUANTITY SHEETS 1-2				E-102A	CONSTRUCTION SIGN DETAILS	05-01-2004		
6 - 7	TYPICAL SECTIONS 1-2				E-106	CONSTRUCTION ZONE LONGITUDINAL DROP OFFS	05-06-2009		
8	TIE SHEET				E-104	BRIDGE NUMBER PLACQUE	08-06-1995		
9	LAYOUT SHEET				E-164	SQUARE STEEL SIGN POST	06-08-2009		
10	MAINLINE PROFILE				E-193	PAVEMENT MARKING DETAILS	05-18-1995		
11	RAIL LAYOUT SHEET				G-101	BOX BEAM GUARDRAIL	06-01-1994		
12	BORING LAYOUT SHEET				S-364A	BRIDGE RAILING - GALVANIZED 3 RAIL BOX BEAM	04-23-2012		
13 - 14	BORING LOGS				S-364B	GUARDRAIL APPROACH SECTION, GALVANIZED 3 RAIL BOX BEAM	04-23-2012		
15	FRAMING PLAN				S-364C	GUARDRAIL APPROACH SECTION, GALVANIZED 3 RAIL BOX BEAM	04-23-2012		
16	NEXT BEAM TYPICAL SECTION				S-364D	GUARDRAIL APPROACH SECTION, GALVANIZED 3 RAIL BOX BEAM	04-23-2012		
17	BEARING DETAILS								
18	APPROACH SLAB DETAILS								
19	ABUTMENT PLAN								
20	ABUTMENT REINFORCING								
21	DECK CLOSURE POUR DETAILS								
22	WINDWARD DETAILS				SD-501.02	CONCRETE DETAILS AND NOTES	05-07-2010		
23 - 24	DETOUR PLAN 1-2				SD-502.00	CONCRETE DETAILS AND NOTES	06-04-2010		
25	EPSC NARRATIVE				SD-516.10	BRIDGE JOINT ASPHALTIC FILL	05-07-2010		
26	EPSC PLAN								
27 - 28	EPSC DETAILS								
29 - 30	MAINLINE SECTIONS								
34 - 36	CHANNEL SECTIONS								
					STRUCTURES DETAILS				
					HYDROLOGIC DATA Date: March 2012				
					DRAINAGE AREA: 5.0 sq. mi.				
					CHARACTER OF TERRAIN: Hilly to mountainous, mostly forested land cover				
					STREAM CHARACTERISTICS: Sinuous, alluvial bend coming into the bridge				
					NATURE OF STREAMBED: Sand, gravel and cobbles				
					PEAK FLOW DATA				
					Q 2.33 = 180 cfs Q 50 = 675 cfs				
					Q 10 = 420 cfs Q 100 = 825 cfs				
					Q 25 = 560 cfs Q 500 = 1150 cfs				
					DATE OF FLOOD OF RECORD: Unknown				
					ESTIMATED DISCHARGE: Unknown				
					WATER SURFACE ELEV.: Unknown				
					NATURAL STREAM VELOCITY: @ Q50 = 9.4 fps				
					ICE CONDITIONS: Moderate				
					DEBRIS: Moderate				
					DOES THE STREAM REACH MAXIMUM HIGH-WATER ELEV. RAPIDLY? Yes				
					IS ORDINARY RISE RAPID? Yes				
					IS STAGE AFFECTED BY UPSTREAM OR DOWNSTREAM CONDITIONS? No				
					FLOOD, DESCRIBE: _____				
					WATERSHED STORAGE: 2% HEADWATERS: X				
					UNIFORM: _____				
					IMMEDIATELY ABOVE SITE: _____				
					EXISTING STRUCTURE INFORMATION				
					STRUCTURE TYPE: Single span concrete slab bridge				
					YEAR BUILT: Built 1926, reconstructed 1972				
					CLEAR SPAN (NORMAL TO STREAM): Approximately 20'				
					VERTICAL CLEARANCE ABOVE STREAMBED: Approximately 3.5'				
					WATERWAY OF FULL OPENING: Unknown *				
					DISPOSITION OF STRUCTURE: It has already been removed.				
					TYPE OF MATERIAL UNDER SUBSTRUCTURE: See boring logs				
					WATER SURFACE ELEVATIONS AT:				
					Q2.33 = " " VELOCITY = " "				
					Q10 = " " " "				
					Q25 = " " " "				
					Q50 = " " " "				
					Q100 = " " " "				
					LONG TERM STREAMBED CHANGES: Unknown				
					IS THE ROADWAY OVERTOPPED BELOW Q100: *				
					FREQUENCY: 1173.5'				
					RELIEF ELEVATION: 1173.5'				
					DISCHARGE OVER ROAD @Q100: *				
					UPSTREAM STRUCTURE				
					TOWN: None DISTANCE: _____				
					HIGHWAY #: _____ STRUCTURE #: _____				
					CLEAR SPAN: _____ CLEAR HEIGHT: _____				
					YEAR BUILT: _____ FULL WATERWAY: _____				
					STRUCTURE TYPE: _____				
					DOWNSTREAM STRUCTURE				
					TOWN: N.A. - confluence with Clyde River DISTANCE: _____				
					HIGHWAY #: _____ STRUCTURE #: _____				
					CLEAR SPAN: _____ CLEAR HEIGHT: _____				
					YEAR BUILT: _____ FULL WATERWAY: _____				
					STRUCTURE TYPE: _____				
					LRFD LOAD RATING FACTORS				
					LOADING LEVELS				
					H40 H40 H40 352 6 AXLE 24 STR. 44.6' N. 5A BEAM				
					INVENTORY 4.51 1.14				
					POSTING 5.85 1.48 3.19 2.14 2.73 2.45 2.68				
					OPERATING 5.85 1.48 3.19 2.14 2.73 2.45 2.68				
					COMMENTS: _____				
					TRAFFIC DATA				
					YEAR ADT DHV % D % T ADTT				
					2013 1600 180 56 12.7 250				
					2033 1700 190 58 16.2 380				
					20 year ESAL for flexible pavement from 2013 to 2033 : 2053000				
					40 year ESAL for flexible pavement from 2013 to 2053 : 4873000				
					Design Speed : 50 mph				
					TRAFFIC MAINTENANCE NOTES				
					1. MAINTAIN TRAFFIC ON AN OFF SITE DETOUR.				
					2. TRAFFIC SIGNALS ARE NOT NECESSARY.				
					3. SIDEWALKS ARE NOT NECESSARY.				
					DESIGN VALUES				
					1. DESIGN LIVE LOAD HL-93				
					2. FUTURE PAVEMENT dp: 3.0 INCH				
					3. DESIGN SPAN L: 70.05 FT				
					4. MIN. MID-SPAN POS. CAMBER @ RELEASE (PRESTRESSED UNITS) A: 3.88 INCH				
					5. PRESTRESSING STRAND (0.60 INCH DIAMETER - LOW RELAX) f _{ps} : 270 KSI				
					6. PRESTRESSED CONCRETE STRENGTH f' _c : 10.0 KSI				
					7. PRESTRESSED CONCRETE RELEASE STRENGTH f' _{cr} : 8.0 KSI				
					8. CONCRETE, HIGH PERFORMANCE CLASS A f' _c : ---				
					9. CONCRETE, HIGH PERFORMANCE CLASS A f' _c : ---				
					10. CONCRETE, HIGH PERFORMANCE CLASS B f' _c : ---				
					11. CONCRETE, CLASS C f' _c : ---				
					12. REINFORCING STEEL f _y : 80 KSI				
					13. STRUCTURAL STEEL AASHTO M270 f _y : ---				
					14. SOIL UNIT WEIGHT γ: 0.140 KCF				
					15. NOMINAL BEARING RESISTANCE OF SOIL q _n : 4.0 KSF				
					16. SOIL BEARING RESISTANCE FACTOR (REFER TO AASHTO LRFD) φ: ---				
					17. NOMINAL BEARING RESISTANCE OF ROCK q _n : 10.0 KSF				
					18. ROCK BEARING RESISTANCE FACTOR (REFER TO AASHTO LRFD) φ: ---				
					19. NOMINAL AXIAL PILE RESISTANCE q _n : ---				
					20. PILE YIELD STRENGTH ASTM A572 f _y : 50 KSI				
					21. PILE SIZE HP 12X53				
					22. EST. PILE LENGTH L _p : 80 FT				
					23. PILE RESISTANCE FACTOR φ: ---				
					24. LATERAL PILE DEFLECTION δ: ---				
					25. BASIC WIND SPEED v ₅₀ : ---				
					26. MINIMUM GROUNDING SNOW LOAD p _s : ---				
					27. SEISMIC DATA PGA: --- S ₁ : --- S ₂ : ---				
					PROJECT NAME: BRIGHTON				
					PROJECT NUMBER: ER STP 034-3(25)				
					FILE NAME: s11b208pl.xls				
					PROJECT LEADER: K. HIGGINS				
					DESIGNED BY: W. LAMMER				
					PRELIMINARY INFORMATION SHEET 1				
					FILE NAME: s11b208pl.xls				
					PROJECT LEADER: K. HIGGINS				
					DESIGNED BY: W. LAMMER				
					PRELIMINARY INFORMATION SHEET 1				
					FILE NAME: s11b208pl.xls				
					PROJECT LEADER:				

GENERAL

1. ALL MATERIALS AND CONSTRUCTION SHALL CONFORM TO THE VERMONT AGENCY OF TRANSPORTATION 2011 STANDARD SPECIFICATIONS FOR CONSTRUCTION, THE 2007 AASHTO LRFD BRIDGE DESIGN SPECIFICATIONS, AND THEIR LATEST REVISIONS.
2. ALL PRECAST CONCRETE ELEMENTS TO BE FABRICATED TO THE SPECIFIED DIMENSIONS WITHIN THE TOLERANCES DICTATED IN THE PRECAST/PRESTRESSED CONCRETE INSTITUTE TOLERANCE MANUAL FOR PRECAST AND PRESTRESSED CONCRETE CONSTRUCTION, MNL 135-00, AND ITS LATEST REVISIONS.
3. ALL DIMENSIONS ARE HORIZONTAL OR VERTICAL, AND ARE GIVEN AT 68 DEGREES FAHRENHEIT, UNLESS NOTED OTHERWISE.
4. NO ADJUSTMENTS TO THE BITUMINOUS WEARING SURFACE ON THE BRIDGE SHALL BE MADE TO ACCOUNT FOR THE DIFFERENCE BETWEEN BEAM CAMBER AND THE THEORETICAL ROADWAY PROFILE. THE WEARING SURFACES SHALL BE SHIMMED TRANSVERSELY AS NECESSARY TO ACCOUNT FOR POTENTIAL DIFFERENTIAL CAMBER OF THE ADJACENT BEAMS.
5. THERE ARE AERIAL ELECTRIC AND TELEPHONE LINES THAT RUN PARALLEL TO VT 105 ON THE NORTH SIDE OF THE PROJECT. NO PROVISION HAS BEEN MADE TO RELOCATE THESE LINES. THE CONTRACTOR SHALL WORK AROUND AND PROTECT THESE LINES. SEE UTILITY SPECIAL PROVISIONS FOR ADDITIONAL INFORMATION AND REQUIREMENTS.
6. NO SUBSTITUTION FOR PRECAST CONCRETE WILL BE PERMITTED.

TRAFFIC CONTROL

7. THE CONTRACTOR SHALL BE RESPONSIBLE FOR SUPPLYING THE LOCAL TRAFFIC CONTROL PACKAGE IDENTIFYING THE CONSTRUCTION PROJECT BEFORE, DURING, AND AFTER THE BRIDGE CLOSURE PERIOD. THE CONTRACTOR SHALL SUBMIT A DETAILED TRAFFIC CONTROL PLAN TO THE RESIDENT ENGINEER FOR ALL STAGES OF CONSTRUCTION, FOR APPROVAL PER SUBSECTION 105.03. ALL COSTS SHALL BE INCLUDED IN ITEM 800.645 SPECIAL PROVISION (TRAFFIC CONTROL, ALL-INCLUSIVE). SEE SPECIAL PROVISIONS.
8. ALL SIGNING SHALL BE IN ACCORDANCE WITH THE LATEST EDITION OF THE MUTCD. WHERE CONFLICTS EXIST, THE MUTCD SHALL GOVERN. FOR ADDITIONAL SIGNING INSTRUCTIONS SEE THE E SERIES OF THE STANDARDS.
9. ALL ITEMS REQUIRED TO IMPLEMENT THE CONTRACTOR'S TRAFFIC CONTROL PLAN WILL NOT BE PAID FOR DIRECTLY BUT WILL BE CONSIDERED INCLUDED IN THE BID PRICE FOR ITEM 800.645 SPECIAL PROVISION (TRAFFIC CONTROL, ALL-INCLUSIVE).

EARTHWORK

10. REMOVAL OF THE EXISTING, FAILED STRUCTURE SHALL BE UNDER ITEM 529.20, "PARTIAL REMOVAL OF STRUCTURE". THIS WORK SHALL INCLUDE REMOVAL OF ANY PORTIONS OF THE EXISTING ABUTMENTS THAT FALL OUTSIDE THE LIMITS OF STRUCTURE EXCAVATION OR UNCLASSIFIED CHANNEL EXCAVATION.
11. EXCAVATION OF SOILS TO THE LIMITS SHOWN ON THE TYPICAL ABUTMENT SECTION SHALL BE PAID FOR UNDER ITEM 204.25, "STRUCTURE EXCAVATION". ALL NECESSARY EXCAVATION OUTSIDE OF THESE LIMITS SHALL BE PAID FOR UNDER ITEM 203.27, "UNCLASSIFIED CHANNEL EXCAVATION".
12. THE "STONE FILL, TYPE II" UNDER THE BRIDGE AS SHOWN IN THE PLANS SHALL BE PLACED BEFORE THE NEW BEAMS ARE SET.

CONCRETE

13. ITEM 514.10, "WATER REPELLENT, SLANE", SHALL BE APPLIED TO ALL EXPOSED CONCRETE ON THE BRIDGE SUPERSTRUCTURE AND SUBSTRUCTURE, WITH THE EXCEPTION OF THE BOTTOM OF THE PRECAST NEXT BEAMS BETWEEN THE DRIP NOTCHES.
14. ALL CONCRETE PLACED INTEGRALLY WITH THE SUPERSTRUCTURE SHALL BE ITEM 900.608, "SPECIAL PROVISION (HIGH PERFORMANCE CONCRETE, RAPID SET)". ALL PRECAST SUBSTRUCTURE AND APPROACH SLAB CONCRETE SHALL MEET THE REQUIREMENTS OF SECTION 510 - PRECAST CONCRETE.
15. ALL REINFORCING STEEL SHALL BE DETAILED AND FABRICATED USING PROCEDURES AND TOLERANCES IN ACCORDANCE WITH APPLICABLE PUBLICATIONS OF THE "CONCRETE REINFORCING STEEL INSTITUTE".
16. ALL REINFORCING STEEL SHALL MEET THE REQUIREMENTS FOR REINFORCING STEEL LEVEL 1, EPOXY COATED.

PRECAST ABUTMENTS AND POST-TENSIONING

17. IF VERTICAL CONSTRUCTION JOINTS ARE REQUIRED BY THE CONTRACTOR FOR SHIPMENT OF THE ABUTMENTS, THEN THE SECTIONS SHALL BE KEYED AND MATCH CAST. A JOINT DETAIL SHALL BE SHOWN ON THE FABRICATION DRAWINGS.
18. POST-TENSIONING AND ASSOCIATED ITEMS ARE ONLY REQUIRED IF THE PILE CAP IS CONSTRUCTED OF MORE THAN ONE UNIT. ANY POST-TENSIONING STRANDS AND CONDUIT SHALL ADHERE TO THE REQUIREMENTS OF SECTION 510 - PRESTRESSED CONCRETE. GALVANIZED ANCHOR ASSEMBLIES, CONDUIT, AND POST-TENSIONING STRANDS SHALL BE INCLUDED UNDER ITEM 540.10, "PRECAST CONCRETE STRUCTURE (ABUTMENT #1) AND/OR 'PRECAST CONCRETE STRUCTURE (ABUTMENT #2)' AS APPROPRIATE. POST-TENSIONING STRANDS SHALL BE COVERED WITH SEAMLESS POLYPROPYLENE SHEATH (WITH CORROSION INHIBITOR GREASE BETWEEN SHEATH AND STRAND) FOR THE LENGTH OF THE STRAND, EXCEPT AT ANCHORAGE LOCATIONS.
19. GALVANIZE ANCHOR ASSEMBLIES AFTER FABRICATION ACCORDING TO AASHTO M232M/232.
20. DESIGN VALUES
 - a. CONCRETE COMPRESSIVE STRENGTH: $f_c = 5000$ PSI.
 - b. POST-TENSIONING STRANDS: 0.5 INCH DIAMETER, 270 KSI, LOW RELAXATION 7-WIRE STRANDS.
 - c. ASSUMED MODULUS OF ELASTICITY IS 28,500 KSI.
 - d. THERE SHALL BE 2 STRANDS PER CONDUIT.
 - e. THE JACKING FORCE PER STRAND = 32 KIPS
21. THE CONCRETE FOR THE ABUTMENT #1 AND ABUTMENT #2 PILE CAVITIES SHALL MEET THE REQUIREMENTS OF ITEM 900.608, "SPECIAL PROVISION (HIGH PERFORMANCE CONCRETE, RAPID SET)".
22. THE CORRUGATED STEEL PIPE SHALL MEET THE REQUIREMENTS OF SUBSECTION 711.01. ALL COSTS ASSOCIATED WITH PLACING THE CORRUGATED STEEL PIPE SHALL BE INCLUDED IN THE BID PRICE FOR ITEM 540.10, "PRECAST CONCRETE STRUCTURE (ABUTMENT #1)" AND ITEM 540.10, "PRECAST CONCRETE STRUCTURE (ABUTMENT #2)".
23. PROPOSED SEQUENCE OF CONSTRUCTION:
 - a. PREPARE AND GRADE FOUNDATION TO REQUIRED ELEVATION.
 - b. DRIVE PILES.
 - c. PLACE PRECAST ABUTMENTS AND INSTALL TRANSVERSE STRANDS (IF MORE THAN ONE UNIT).
 - d. APPLY EPOXY TO MATCH CAST FACES OF VERTICAL CONSTRUCTION JOINT.
 - e. USE A CALIBRATED JACK TO TENSION TO 3 KIPS TO REMOVE SAG IN STRANDS.
 - f. CHECK ALIGNMENT OF PILE CAP ELEMENTS.
 - g. STRESS POST-TENSIONING STRANDS USING A CALIBRATED JACK OPERATED BY QUALIFIED PERSONNEL WHO HAVE PREVIOUS EXPERIENCE IN POST-TENSIONING.
 - h. FILL PILE CAVITIES WITH ITEM 900.608, "SPECIAL PROVISION (HIGH PERFORMANCE CONCRETE, RAPID SET)".
 - i. PLACE PRECAST WINGWALLS AND GROUT SPLICE CONNECTORS.
 - j. BACKFILL MAY BE COMPLETED AFTER SPLICE CONNECTOR GROUT HAS REACHED 85% OF 5,000 PSI.
24. ALTERNATE SEQUENCE OF CONSTRUCTION MAY BE SUBMITTED FOR APPROVAL BY THE PROJECT MANAGER.

NEXT D BEAMS

25. NEXT D BEAMS ARE A NON-PROPRIETARY SHAPE DEVELOPED BY PCINORTHEAST (PCINE). STANDARDIZED SECTION PROPERTIES AND DETAILS MAY BE FOUND AT <http://www.pcine.org>
26. DESIGN VALUES
 - a. CONCRETE COMPRESSIVE STRENGTH: $f_c = 10,000$ PSI.
 - b. CONCRETE COMPRESSIVE STRENGTH AT RELEASE: $f_{cr} = 8,000$ PSI
 - c. PRESTRESSING STRANDS: 0.6 INCH DIAMETER, 270 KSI, LOW-RELAXATION 7-WIRE STRANDS
 - d. ASSUMED MODULUS OF ELASTICITY = 28,500 KSI.
 - e. THE JACKING FORCE PER STRAND = 47 KIPS
 - f. SERVICE LOADS

MEMBER MOMENT	857 K-FT
SUPERIMPOSED DEAD LOAD MOMENT	341 K-FT
LIVE LOAD AND IMPACT MOMENT	1,320 K-FT
DEAD LOAD REACTION	72 KIPS
LIVE LOAD AND IMPACT REACTION	98 KIPS
TOTAL REACTION	170 KIPS
FINAL CAMBER	1/16 INCHES
27. ENDS OF FLANGES IN CONTACT WITH GROUT SHALL BE SANDBLASTED PRIOR TO DELIVERY AND POWER WASHED WITH WATER PRIOR TO ERECTION OF THE BEAMS.
28. FILL FLANGE CONNECTION WITH TYPE IV MORTAR ACCORDING TO SECTION 510. MORTAR SHALL HAVE A MINIMUM 28 DAY COMPRESSIVE STRENGTH OF 7000 PSI AND SHALL BE EXTENDED WITH AGGREGATE. ALL OTHER MATERIAL PROPERTIES SHALL REMAIN IN ACCORDANCE WITH SUBSECTION 707.03(c). GROUTING SHALL BE PAID FOR UNDER ITEM 510.24, "GROUTING SHEAR KEYS". THE CONTRACTOR SHALL SUBMIT A MIX DESIGN FOR THIS ITEM FOR APPROVAL BY THE PROJECT MANAGER.

29. METHOD OF FORMING FLANGE CONNECTION SHALL BE DETERMINED BY THE CONTRACTOR. THE FORMS SHALL BE REMOVABLE AND ABLE TO ACCOMMODATE DIFFERENTIAL CAMBER. FORM SUPPORTS SHALL NOT PENETRATE THROUGH THE TOP OF POUR UNLESS APPROVED BY THE ENGINEER.
30. THE FABRICATOR MAY ALTER THE DESIGN AS DETAILED IN THESE PLANS TO ACCOMMODATE THEIR SPECIFIC OPERATION. THIS ALTERATION MUST BE DESIGNED BY A PROFESSIONAL ENGINEER AND MEET THE ABOVE CRITERIA AND SHALL BE APPROVED BY THE PROJECT MANAGER.
31. PROPOSED SEQUENCE OF CONSTRUCTION
 - a. LAY OUT WORKING LINES THE ENTIRE WIDTH OF THE BRIDGE ALONG CENTERLINE OF BEARINGS, MEASURED FROM A SINGLE WORKING POINT. THE WORKING LINES SHALL BE BASED ON THE NOMINAL BEAM WIDTHS.
 - b. VERIFY THE BEAM SEAT ELEVATIONS AND TAKE CORRECTIVE ACTION IF NECESSARY.
 - c. INSTALL BEARINGS.
 - d. ERECT THE BEAMS TO FIT WITHIN THE WORKING LINES.
 - e. ADJUST FASCIA BEAM TO FIT SNUG AGAINST 1/2" CORK ON INTERIOR OF CHEEK WALL.
 - f. CONSTRUCT FORMS FOR THE FLANGE AND CURTAIN WALL CONNECTION POURS.
 - g. GROUT CONNECTIONS BETWEEN BEAM FLANGES AND CURTAIN WALL.
 - h. BACKFILL AND PREPARE GRADE FOR APPROACH SLABS.
 - i. COMPLETE BEAM-END CLOSURE POUR TO BOTTOM OF DECK ALLOWING FOR APPROACH SLAB BRACKET.
 - j. COMPLETE PLACEMENT OF BACKFILL AND PLACE APPROACH SLAB.
 - k. GROUT REBAR DOWELS IN APPROACH SLAB.
 - l. COMPLETE LONGITUDINAL CLOSURE POURS OF APPROACH SLAB.
 - m. COMPLETE BEAM-END CLOSURE POUR TO TOP OF DECK AND APPROACH SLABS.
32. ALTERNATE SEQUENCE OF CONSTRUCTION MAY BE SUBMITTED FOR APPROVAL BY THE PROJECT MANAGER.

H-PILES

33. TO PREVENT DAMAGE TO THE PILES, PILE SHOES ARE REQUIRED AND SHALL CONFORM TO SUBSECTION 505.04 (f).
34. THE PILE SHALL BE DRIVEN TO A NOMINAL PILE DRIVING RESISTANCE (R_{nd}) OF 286 KIPS, PROVIDED A MINIMUM PENETRATION OF 25 FEET BELOW THE BOTTOM OF PILE CAP HAS BEEN ACHIEVED.
35. A MINIMUM OF THREE DYNAMIC TESTS ARE REQUIRED DURING PILE INSTALLATION. NO LESS THAN ONE DYNAMIC PILE TEST SHALL BE CONDUCTED AT EACH ABUTMENT. PAYMENT IS ITEM 505.45, "DYNAMIC PILE LOADING TEST".
36. THE TOPS OF THE PILES AFTER DRIVING SHALL NOT VARY FROM THE POSITION SHOWN ON THE PLANS BY MORE THAN 3 INCHES. THE PILE ORIENTATION SHALL NOT VARY BY MORE THAN 5 DEGREES. THE CONTRACTOR SHALL DEMONSTRATE TO THE SATISFACTION OF THE ENGINEER HOW THE TOLERANCES WILL BE MET. THESE MEASURES SHALL BE DEMONSTRATED IN A SUBMITTAL TO BE ACCEPTED BEFORE PILE DRIVING COMMENCES.
37. FOR ESTIMATING PURPOSES, THE PILE TIP ELEVATIONS WERE ASSUMED AS SHOWN ON THE BORING LOGS. THE ACTUAL IN PLACE LENGTHS MAY VARY.

MISCELLANEOUS

38. ITEM 520.10, "MEMBRANE WATERPROOFING, SPRAY APPLIED" SHALL BE APPLIED TO THE BRIDGE DECK AS PER THE MANUFACTURER'S INSTRUCTIONS AND EXTEND ONTO THE APPROACH SLABS TWO FEET BEYOND THE BEGIN BRIDGE/END OF BRIDGE.
39. A TEMPORARY BRIDGE IS IN PLACE OVER THE EXISTING, FAILED STRUCTURE. REMOVAL OF THIS TEMPORARY BRIDGE SHALL BE PAID FOR UNDER ITEM 800.645, "SPECIAL PROVISION (REMOVAL OF TEMPORARY BRIDGE AND APPROACHES)". THE TEMPORARY BRIDGE IS THE PROPERTY OF VTTRANS AND SHALL BE RETURNED TO THE VTTRANS MAINTENANCE FACILITY IN MIDDLESEX, VT. CONTACT BILL SARGENT AT (802) 828-2699 TO MAKE NECESSARY ARRANGEMENTS AS PER THE SPECIAL PROVISIONS.

△ REVISED 10-12-12

- REVISED NOTE 16

PROJECT NAME:	BRIGHTON	
PROJECT NUMBER:	ER STP 034-3(25)	
FILE NAME:	slb208gen.dgn	PLOT DATE: 12-OCT-2012
PROJECT LEADER:	K. HIGGINS	DRAWN BY: W. LAMMER
DESIGNED BY:	W. LAMMER	CHECKED BY: J. SALVATORI
GENERAL NOTES		SHEET 3 OF 36

QUANTITY SHEET 1

SUMMARY OF ESTIMATED QUANTITIES										TOTALS		DESCRIPTIONS				DETAILED SUMMARY OF QUANTITIES			
						ROADWAY	EROSION CONTROL	BRIDGE	FULL C.E. ITEMS	GRAND TOTAL	FINAL	UNIT	ITEMS	ITEM NUMBER	ROUND	QUANTITIES	UNIT	ITEMS	
						1				1		LS	CLEARING AND GRUBBING, INCLUDING INDIVIDUAL TREES AND STUMPS	201.10					
						470				470		CY	COMMON EXCAVATION	203.15					
								430		430		CY	UNCLASSIFIED CHANNEL EXCAVATION	203.27					
						1				1		CY	TRENCH EXCAVATION OF EARTH, EXPLORATORY (N.A.B.1)	204.22					
								410		410		CY	STRUCTURE EXCAVATION	204.25					
								270		270		CY	GRANULAR BACKFILL FOR STRUCTURES	204.30					
						305				305		SY	COLD PLANING, BITUMINOUS PAVEMENT	210.10					
													BEGIN OPTION AA						
						435				435		CY	SUBBASE OF GRAVEL	301.15					
						435				435		CY	SUBBASE OF CRUSHED GRAVEL, COARSE GRADED	301.25					
						435				435		CY	SUBBASE OF DENSE GRADED CRUSHED STONE	301.35					
													END OPTION AA						
						25				25		CY	AGGREGATE SHOULDERS, IN PLACE	402.10					
						6				6		CWT	EMULSIFIED ASPHALT	404.65					
						1				1		LU	PRICE ADJUSTMENT, ASPHALT CEMENT (N.A.B.1)	406.50					
								1		1		LS	FURNISHING EQUIPMENT FOR DRIVING PILING	504.10					
								800		800		LF	STEEL PILING, HP 12 X 53	505.15					
										3		EACH	DYNAMIC PILE LOADING TEST	505.45					
								2100		2100		LB	REINFORCING STEEL, LEVEL 1	507.11					
								210		210		LF	GROUTING SHEAR KEYS	513.24					
								15		15		GAL	WATER REPELLENT, SILANE	514.10					
								60		60		LF	BRIDGE EXPANSION JOINT, ASPHALTIC PLUG	518.10					
								255.53		255.53		SY	SHEET MEMBRANE WATERPROOFING, SPRAY APPLIED	523.10					
								153.32		153.32		LF	BRIDGE RAILING, GALVANIZED 3 RAIL BOX BEAM	525.335					
								1		1		EACH	PARTIAL REMOVAL OF STRUCTURE	529.20					
								16		16		EACH	BEARING DEVICE ASSEMBLY, STEEL REINFORCED ELASTOMERIC PAD	531.17					
								1		1		LS	PRECAST CONCRETE STRUCTURE (ABUTMENT #1)	540.10					
								1		1		LS	PRECAST CONCRETE STRUCTURE (ABUTMENT #2)	540.10					
								1		1		LS	PRECAST CONCRETE STRUCTURE (APPROACH SLAB #1)	540.10					
								1		1		LS	PRECAST CONCRETE STRUCTURE (APPROACH SLAB #2)	540.10					
								1		1		MGAL	DUST CONTROL WITH WATER	609.10					
								470		470		CY	STONE FILL, TYPE II	613.12					
						149				149		LF	BOX BEAM GUARDRAIL	621.30					
						3				3		EACH	MANUFACTURED TERMINAL SECTION, TANGENT	621.51					
						4				4		EACH	GUARDRAIL APPROACH SECTION, GALVANIZED 3 RAIL BOX BEAM	621.725					
						400				400		HR	FLAGGERS	630.15					
										1		LS	FIELD OFFICE, ENGINEERS	631.10					
										1		LS	TESTING EQUIPMENT, CONCRETE	631.16					
										1		LS	TESTING EQUIPMENT, BITUMINOUS	631.17					
										3000		DL	FIELD OFFICE TELEPHONE (N.A.B.1)	631.26					




REVISED 10-12-12

- REMOVED ITEM 507.12
- ADDED ITEM 507.11PROJECT NAME: BRIGHTON
PROJECT NUMBER: ER STP 034-3(25)FILE NAME: sllc208qs.dgn
PROJECT LEADER: K. HIGGINS
DESIGNED BY: W. LAMMER
QUANTITY SHEET 1PLOT DATE: 12-OCT-2012
DRAWN BY: W. LAMMER
CHECKED BY: J. SALVATORI
SHEET 4 OF 36

QUANTITY SHEET 2

PROJECT NAME: BRIGHTON	
PROJECT NUMBER: ER STP 034-3(25)	
FILE NAME: slib208qs.dgn	PLOT DATE: 18-SEP-2012
PROJECT LEADER: K. HIGGINS	DRAWN BY: W. LAMMER
DESIGNED BY: W. LAMMER	CHECKED BY: J. SALVATORI
QUANTITY SHEET 2	SHEET 5 OF 36

* 1 1/2" SUPERPAVE BITUMINOUS CONCRETE PAVEMENT, TYPE IVS
 1 1/2" SUPERPAVE BITUMINOUS CONCRETE PAVEMENT, TYPE IVS
 3" SUPERPAVE BITUMINOUS CONCRETE PAVEMENT, TYPE IIS
 VARIES SUBBASE OPTION

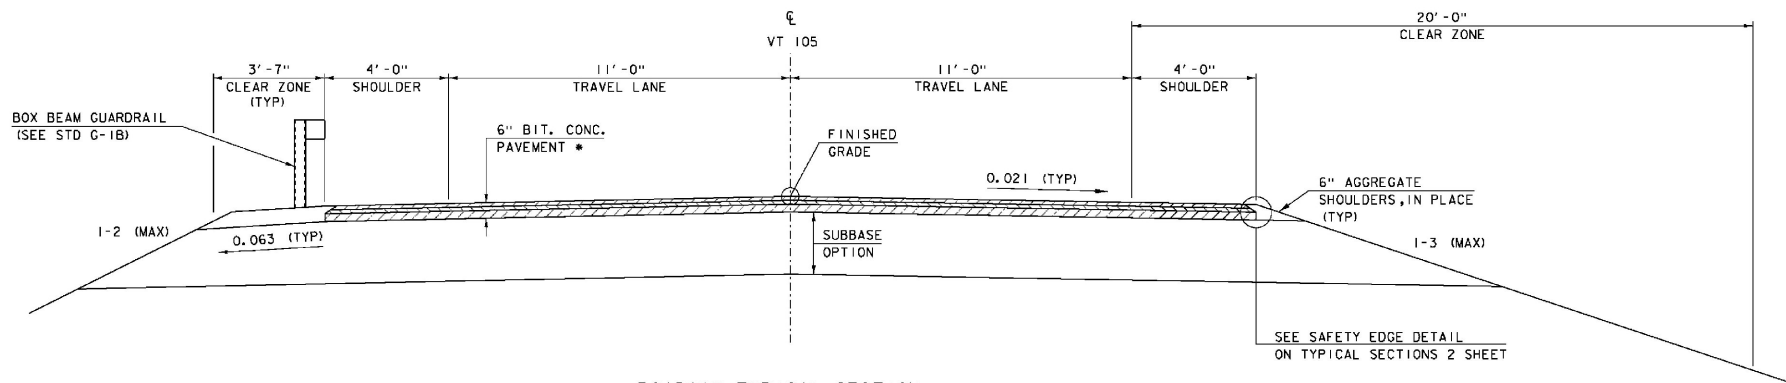


ROADWAY TYPICAL SECTION

SCALE 1/2" = 1'-0"

MATERIAL TOLERANCES

(IF USED ON PROJECT)

SURFACE	
- PAVEMENT (TOTAL THICKNESS)	+/- 1/4"
- AGGREGATE SURFACE COURSE	+/- 1/2"
SUBBASE	
	+/- 1"
SAND BORROW	
	+/- 1"

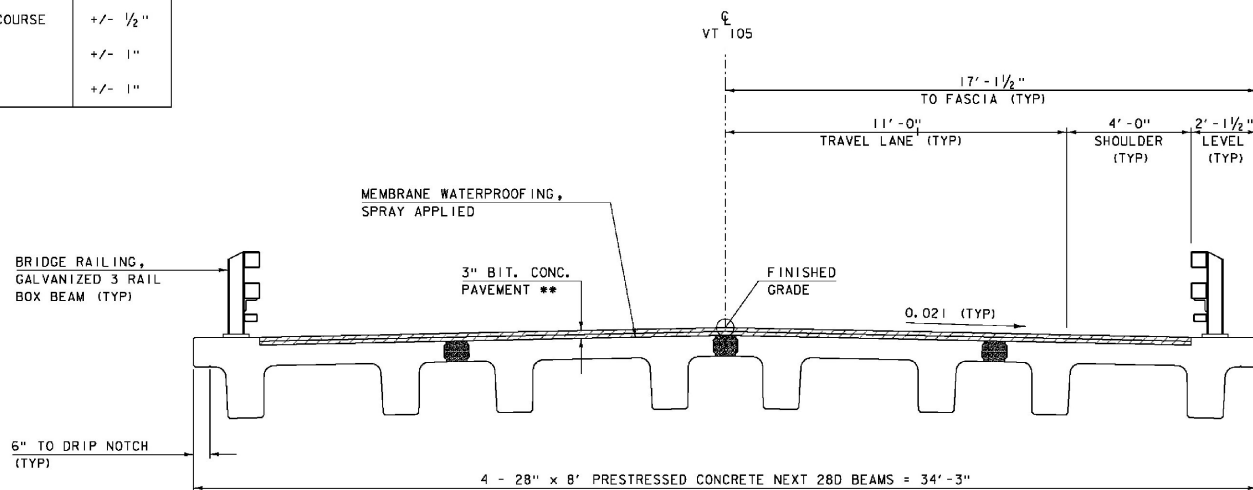

BRIDGE TYPICAL SECTION


SCALE 1/2" = 1'-0"

** 1 1/2" SUPERPAVE BITUMINOUS CONCRETE PAVEMENT, TYPE IVS
 1 1/2" SUPERPAVE BITUMINOUS CONCRETE PAVEMENT, TYPE IVS

PROJECT NAME: BRIGHTON
 PROJECT NUMBER: ER STP 034-3(25)


FILE NAME: s11b208typ.dgn
 PROJECT LEADER: K.HIGGINS
 DESIGNED BY: J. SALVATORI
 TYPICAL SECTIONS 1

PLOT DATE: 12-SEP-2012
 DRAWN BY: J. SALVATORI
 CHECKED BY: W. LAMMER
 SHEET 6 OF 36

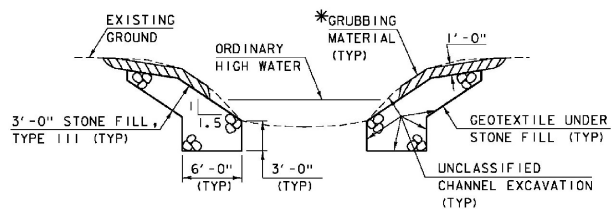

TYPICAL CHANNEL SECTION
(NOT TO SCALE)


*GRUBBING MATERIAL SHALL NOT BE PLACED ON THE STONE FILL IN THE AREA UNDER THE BRIDGE. WHENEVER CHANNEL SLOPE INTERSECTS ROADWAY SUBBASE, GRUBBING MATERIAL SHALL BEGIN AT THE BOTTOM OF SUBBASE.

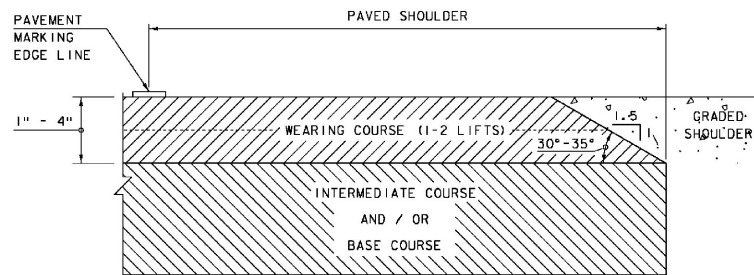

SAFETY EDGE DETAIL

NOT TO SCALE

NOTE: LEVELING COURSE MAY INCLUDE THE "SAFETY EDGE" AT THE CONTRACTOR'S CHOICE.

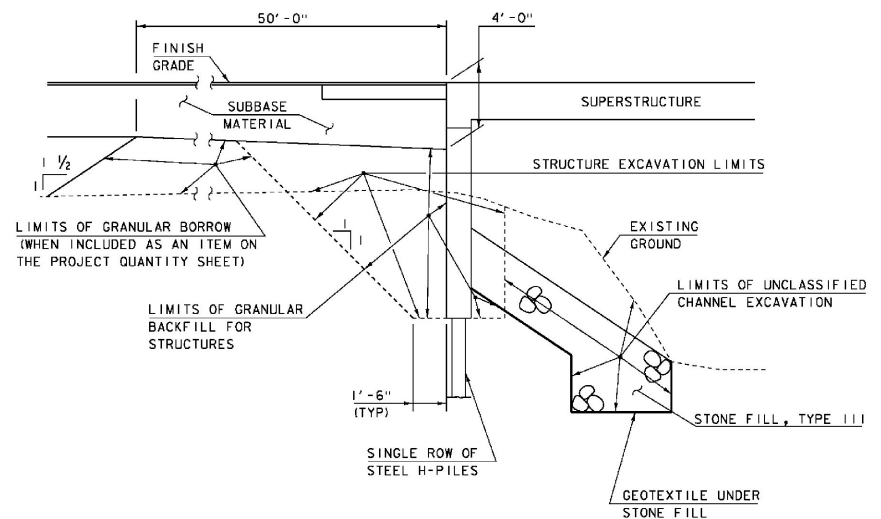

TYPICAL INTEGRAL ABUTMENT SECTION
NOT TO SCALE

ACTUAL LIMITS OF STRUCTURE EXCAVATION SHALL BE DETERMINED BY THE CONTRACTOR. HOWEVER, ONLY EXCAVATION BETWEEN THE LIMITS SHOWN WILL BE PAID FOR UNDER ITEM 204.25 "STRUCTURE EXCAVATION". EXCAVATION BY THE CONTRACTOR OUTSIDE OF THESE LIMITS WILL BE AT THE EXPENSE OF THE CONTRACTOR.

PROJECT NAME:	BRIGHTON	FILE NAME:	slb208typ.dgn	PLOT DATE:	12-SEP-2012
PROJECT NUMBER:	ER STP 034-3(25)	PROJECT LEADER:	K.HIGGINS	DRAWN BY:	J. SALVATORI
		DESIGNED BY:	J. SALVATORI	CHECKED BY:	W. LAMMER
		TYPICAL SECTIONS:	2	SHEET:	7 OF 36

GPS CONTROL POINTS

HVCTRL #1

PORTER AZ MK
NORTH = 839791.546
EAST = 1791829.618
ELEV. = 1189.855

TO REACH FROM THE INTERSECTION OF VT 114 SOUTH AND VT 105, GO NORTHWEST ALONG VT 105 FOR 0.4 MI TO THE SITE OF THE MARK ON THE LEFT.
THE MARK IS SET 4" BELOW GROUND SURFACE IN THE TOP OF A 12" DIAMETER CONCRETE MONUMENT.
IT IS 22.3' WEST-SOUTHWEST OF AND 3.3' LOWER THE CENTERLINE OF VT 105, 110'
NORTH-NORTHWEST OF THE CENTERLINE OF A GRAVEL DRIVE LEADING TO THE GOODHILL RESIDENCE,
41.7' SOUTH OF A METAL ROAD SIGN, 87.6' EAST-NORTHEAST OF A 16" PINE, 154.5' NORTHEAST OF
THE NORTH CORNER OF A 2 BAY GARAGE, 12' NORTH OF A LILAC BUSH, 88.6' EAST OF A METAL POST
FOR A SATELLITE DISH, AND 1' EAST-NORTHEAST OF A FIBERGLASS WITNESS POST.

HVCTRL #2


PORTER
NORTH = 840414.211
EAST = 1790457.251
ELEV. = 1200.817

TO REACH FROM THE INTERSECTION OF VT 114 SOUTH AND VT 105, GO NORTHWEST ALONG VT 105 FOR 0.8 MI TO THE SITE OF THE MARK ON THE LEFT.
THE MARK IS SET 2" BELOW GROUND SURFACE IN THE TOP OF A 12" DIAMETER CONCRETE MONUMENT.
IT IS 27.6' SOUTHWEST OF AND ABOUT 2.6' HIGHER THAN THE CENTERLINE OF VT 105, 89.2'
WEST-NORTHWEST OF THE NORTH CORNER OF A SMALL WOODEN STORAGE BUILDING, 115'
EAST-SOUTHEAST OF A 20" ELM, 74.5' WEST-SOUTHWEST OF AND ACROSS THE ROAD FROM THE SOUTH
CORNER OF THE PORTER FARM BARN, 75.5' SOUTH-SOUTHEAST OF AND ACROSS THE ROAD FROM THE
SOUTH CORNER OF THE ENCLOSED PORCH OF A 2 STORY HOUSE, 21' WEST OF THE CENTERLINE OF A
FARM DRIVE, AND 1' NORTH-NORTHEAST OF A FIBERGLASS WITNESS POST.

TRAVERSE TIES

HVCTRL #3


NORTH = 840980.242
EAST = 1789686.907
ELEV. = 1171.735

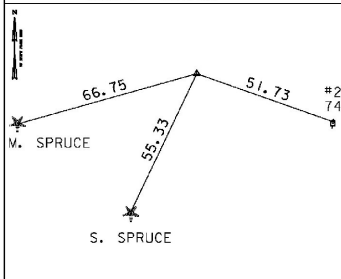

*TRAVERSE COMPLETED 10/14/2011 BY R. GILMAN P.C. & P. WINTERS


HVCTRL #4

NORTH = 841133.516
EAST = 1789029.141
ELEV. = 1173.970

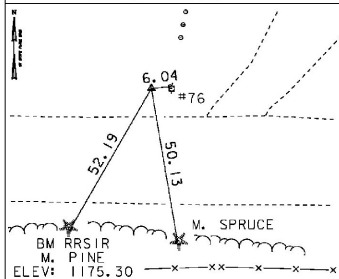

HVCTRL #5

NORTH = 841102.677
EAST = 1788297.305
ELEV. = 1178.211

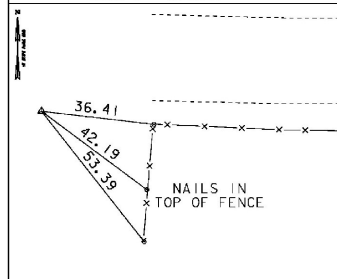

ALIGNMENT TIES

NORTH =
EAST =
ELEV. =

NORTH =
EAST =
ELEV. =

DATUM
VERTICAL NAVD 88
HORIZONTAL NAD 83 (07)
ADJUSTMENT COMPASS

PROJECT NAME: BRIGHTON
PROJECT NUMBER: ER STP 034-3(25)


FILE NAME: s1lb208t1.dgn
PROJECT LEADER: K. HIGGINS
DESIGNED BY: W. LAMMER
TIE SHEET
PLOT DATE: 12-SEP-2012
DRAWN BY: W. LAMMER
CHECKED BY: J. SALVATORI
SHEET 8 OF 36

MILEMARKER, STATION, OR SIGN NUMBER	SIGN LEGEND	SIGN DIMENSIONS		NEW SIGN	EXIST. POST	NEW SIGN POSTS						REMARKS	SIGN DETAIL		
		WIDTH (in)	HEIGHT (in)			"A"	NO. OF POSTS	SQUARE STEEL (in)			ANCHOR RODS (in)		S T E E L	DETAIL ON SHEET NUMBER	STD. SHEET NUMBER
								1.75	2.0	2.5					
55+39.00 RT		6	8	0.33		1	8				X		VD-701	E-134	
56+31.00 LT		6	8	0.33		1	8				X		VD-701	E-134	
FINAL POST LENGTHS ARE TO BE DETERMINED IN THE FIELD. POST SIZES ARE COMPUTED BASED ON INFORMATION FURNISHED ON THE STANDARD SHEETS AND THE VTRANS "SIGN POST DESIGN GUIDELINE."															
					SF	FT			EA						
TOTALS					0.66	16									
SHS = STANDARD HIGHWAY SIGNS (MUTCD)															

SIGN LEGEND
N = NEW
R = RETAIN

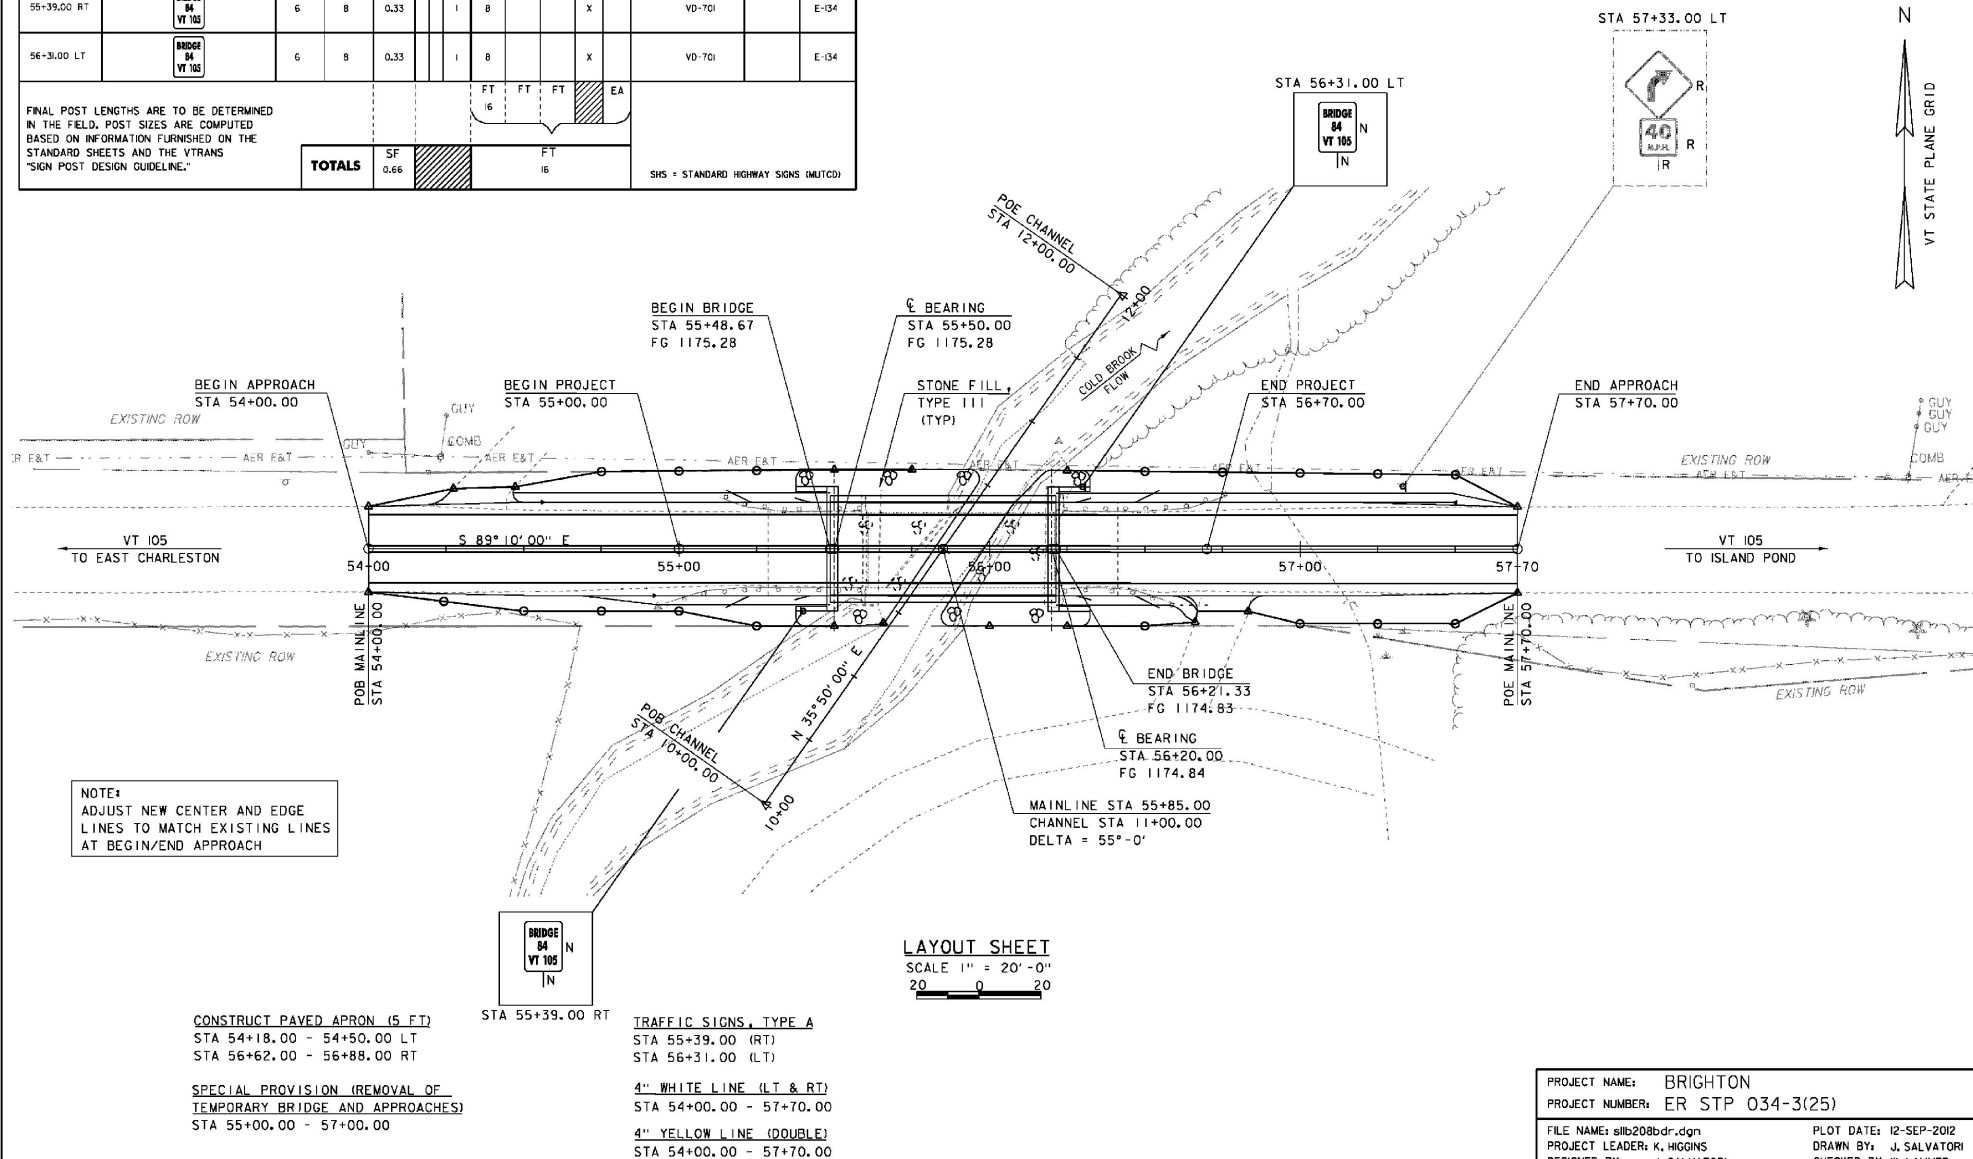


PROJECT NAME:	BRIGHTON	PLOT DATE:	12-SEP-2012
PROJECT NUMBER:	ER STP 034-3(25)	DRAWN BY:	J. SALVATORI
FILE NAME:	slb208bdr.dgn	DESIGNED BY:	J. SALVATORI
PROJECT LEADER:	K. HIGGINS	CHECKED BY:	W. LAMMER
LAYOUT SHEET		SHEET	9 OF 36

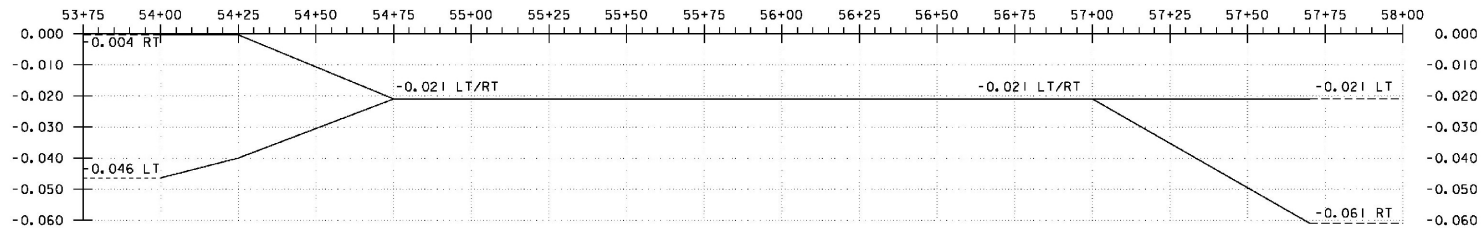


BANKING DIAGRAM

HORIZONTAL SCALE 1" = 20'-0"
VERTICAL SCALE 1" = 10'-0"

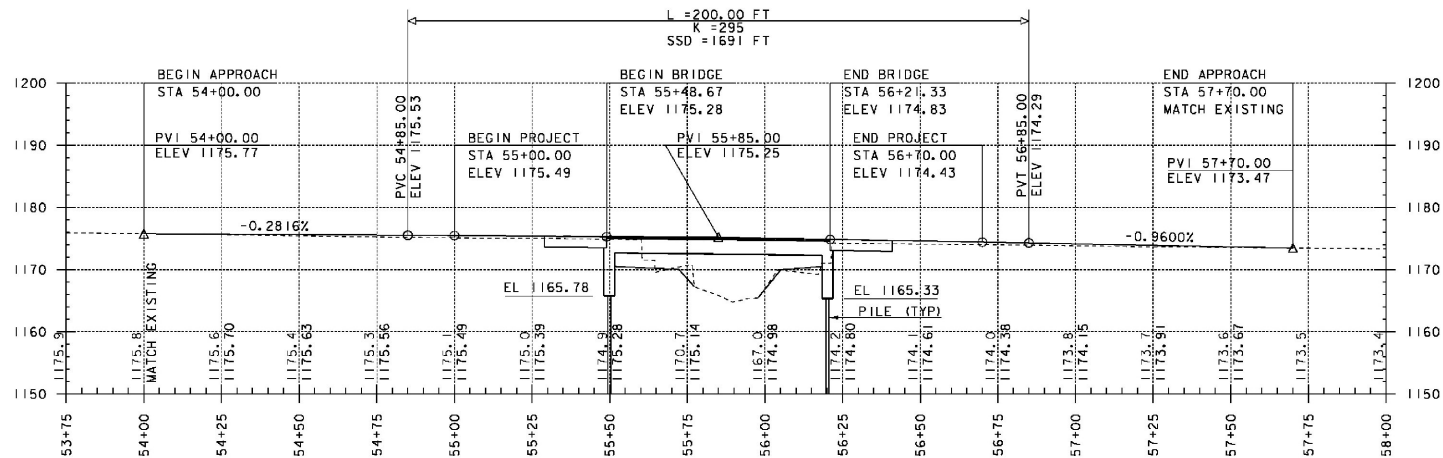

MAINLINE PROFILE

HORIZONTAL SCALE 1" = 20'-0"
VERTICAL SCALE 1" = 10'-0"

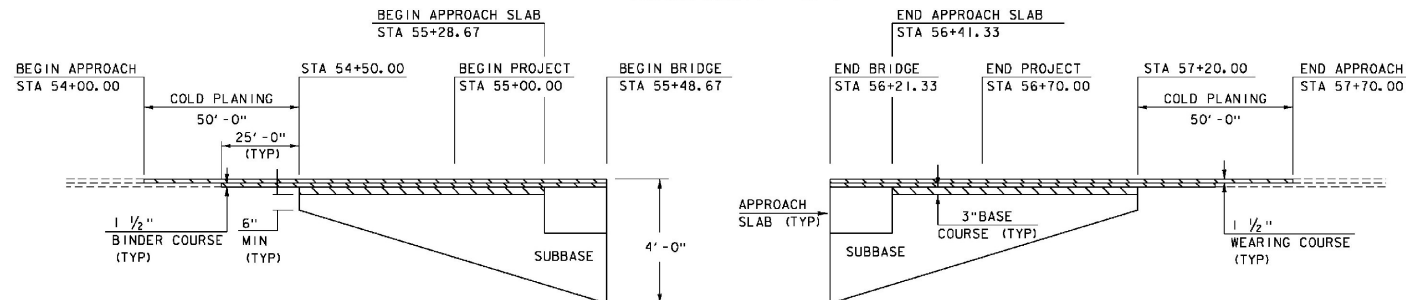

MATERIAL TRANSITION

HORIZONTAL SCALE 1" = 20'-0"
VERTICAL SCALE 1/2" = 1'-0"

PROJECT NAME: BRIGHTON
PROJECT NUMBER: ER STP 034-3(25)

FILE NAME: s11b208pro.dgn
PROJECT LEADER: K. HIGGINS
DESIGNED BY: J. SALVATORI
MAINLINE PROFILE


PLOT DATE: 12-SEP-2012
DRAWN BY: J. SALVATORI
CHECKED BY: W. LAMMER
SHEET 10 OF 36

BOX BEAM GUARDRAIL
 STA 54+69.67 - 55+14.67 LT
 STA 55+05.66 - 55+14.67 RT
 STA 56+55.33 - 57+36.34 LT
 STA 56+55.33 - 56+67.05 RT

MANUFACTURED TERMINAL SECTION, TANGENT
 STA 54+55.66 - 54+69.67 LT
 STA 54+91.65 - 55+05.66 RT
 STA 57+36.34 - 57+50.35 LT

BRIDGE RAILING, GALVANIZED
3 RAIL BOX BEAM
 STA 55+48.67 - 56+21.33 LT/RT

GUARDRAIL APPROACH SECTION,
GALVANIZED 3 RAIL BOX BEAM
 STA 55+14.67 - 55+48.67 LT/RT
 STA 56+21.33 - 56+55.33 LT/RT

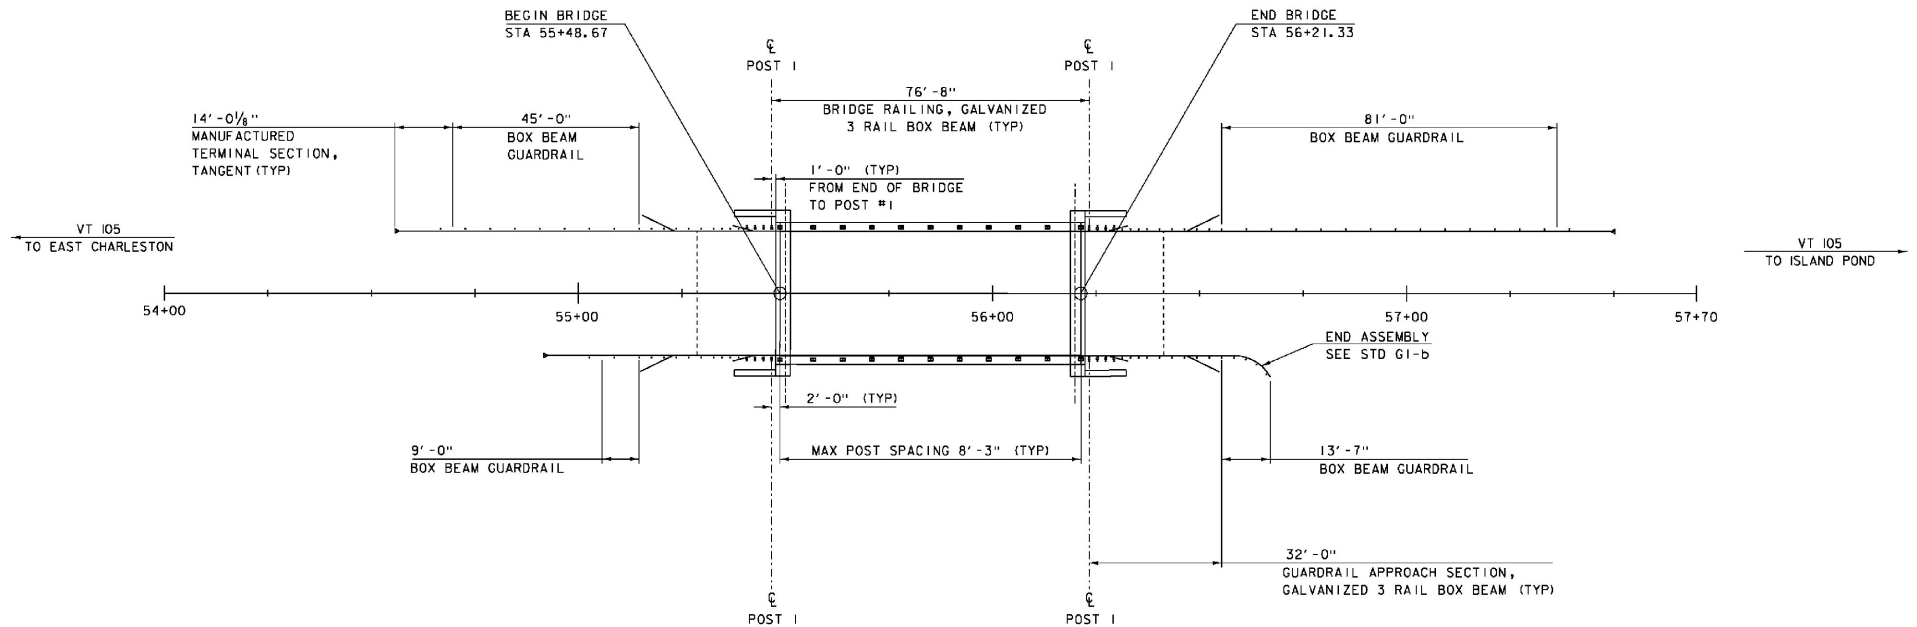

RAIL LAYOUT SHEET
 SCALE 1" = 15'-0"

PROJECT NAME: BRIGHTON	
PROJECT NUMBER: ER STP 034-3(25)	
FILE NAME: s1lb208rail.dgn	PLOT DATE: 12-SEP-2012
PROJECT LEADER: K. HIGGINS	DRAWN BY: J. SALVATORI
DESIGNED BY: J. SALVATORI	CHECKED BY: W. LAMMER
RAIL LAYOUT SHEET	SHEET 11 OF 36

SOIL CLASSIFICATION

AASHTO

A1	Gravel and Sand
A2	Fine Sand
A2	Silty or Clayey Gravel and Sand
A4	Silty Soil - Low Compressibility
A5	Silty Soil - Highly Compressible
A6	Clayey Soil - Low Compressibility
A7	Clayey Soil - Highly Compressible

ROCK QUALITY DESIGNATION

R.Q.D. (%)	ROCK DESCRIPTION
<25	Very Poor
25 to 50	Poor
51 to 75	Fair
76 to 90	Good
>90	Excellent

SHEAR STRENGTH

UNDRAINED SHEAR STRENGTH IN P.S.F.	CONSISTENCY
<250	Very Soft
250-500	Soft
500-1000	Med. Stiff
1000-2000	Stiff
2000-4000	Very Stiff
>4000	Hard


CORRELATION GUIDE OF "N" TO DENSITY/CONSISTENCY

DENSITY (GRANULAR SOILS)	CONSISTENCY (COHESIVE SOILS)
DESCRIPTIVE TERM	DESCRIPTIVE TERM
<5 Very Loose	2-4 Very Soft
5-10 Loose	4-8 Soft
11-24 Med. Dense	8-15 Med. Stiff
25-50 Dense	15-30 Stiff
>50 Very Dense	31-60 Very Stiff
	>60 Hard

COMMONLY USED SYMBOLS

▼	Water Elevation
⊕	Standard Penetration Boring
⊙	Auger Boring
⊙	Rod Sounding
S	Sample
N	Standard Penetration Test
	Blow Count Per Foot For:
	2" O.D. Sampler
	1 3/4" I.D. Sampler
	Hammer Weight Of 140 Lbs.
	Hammer Fall Of 30"
VS	Field Vane Shear Test
US	Undisturbed Soil Sample
B	Blast
DC	Diamond Core
MD	Mud Drill
WA	Wash Ahead
HSA	Hollow Stem Auger
AX	Core Size 1 1/4"
BX	Core Size 1 1/2"
NX	Core Size 2 1/8"
M	Double Tube Core Barrel Used
LL	Liquid Limit
PL	Plastic Limit
PI	Plasticity Index
NP	Non Plastic
w	Moisture Content (Dry Wgt. Basis)
D	Dry
M	Moist
MTW	Moist To Wet
W	Wet
Sat	Saturated
Bo	Boulder
Gr	Gravel
Sa	Sand
Sl	Silt
Cl	Clay
HP	Hardpan
Le	Ledge
NLTD	No Ledge To Depth
CNPF	Can Not Penetrate Further
TLOB	Top of Ledge Or Boulder
NR	No Recovery
Rec.	Recovery
%Rec.	Percent Recovery
RQD	Rock Quality Designation
CBR	California Bearing Ratio
<	Less Than
>	Greater Than
R	Refusal (N > 100)
VTSPG	NAD83 - See Note 7

COLOR	
blk	Black
bl	Blue
brn	Brown
dk	Dark
gry	Gray
gn	Green
lt	Light
or	Orange
pnk	Pink
pu	Purple
rd	Red
tn	Tan
wh	White
yl	Yellow
mlc	Multicolored

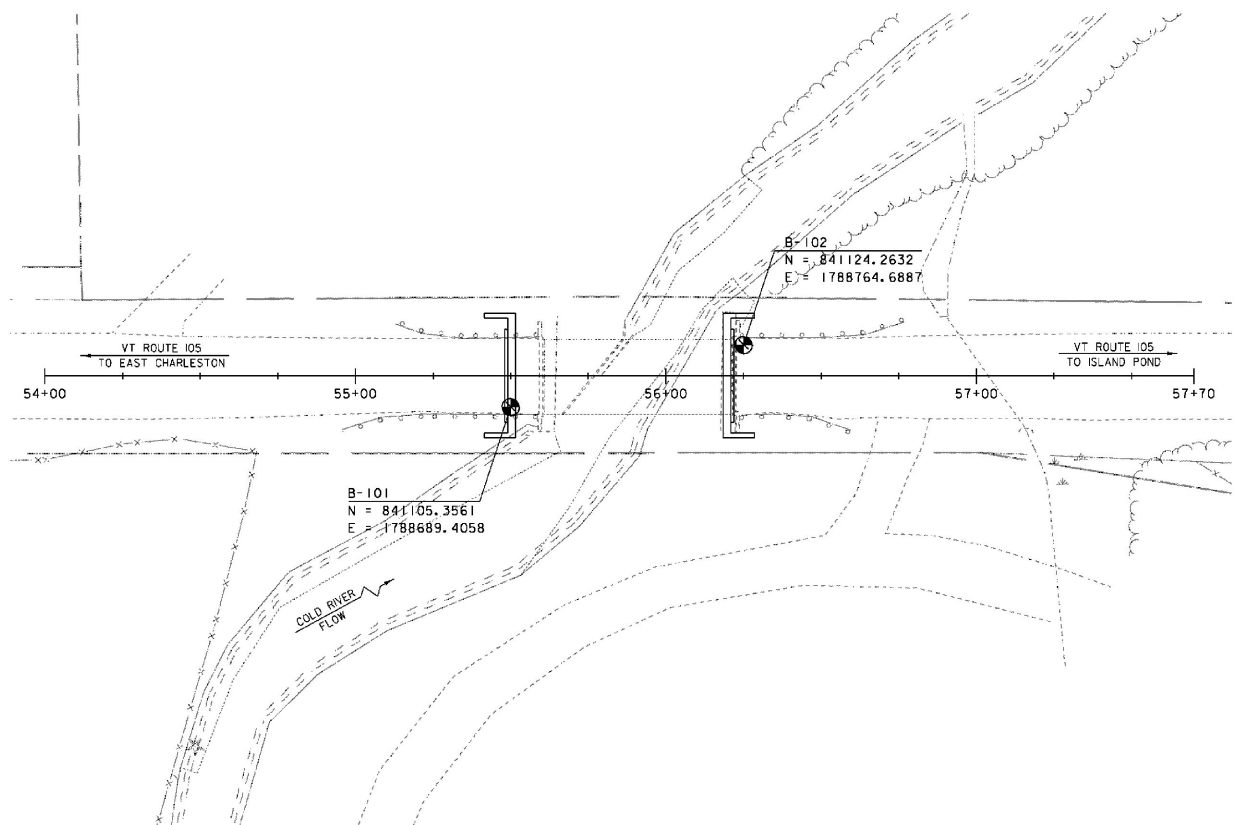

BORING LAYOUT

SCALE 1" = 20' - 0"

20 0 20

BORING CHART

HOLE NO.	SURV. STATION	OFFSET	GROUND ELEV.
B-101	55+50	10' RT	1174.85
B-102	56+25	10' LT	1174.26

DEFINITIONS (AASHTO)

BEDROCK (LEDGE) - Rock in its native location of indefinite thickness.
BOULDER - A rock fragment with an average dimension > 12 inches.
CORBLE - Rock fragments with an average dimension between 3 and 12 inches.
GRAVEL - Rounded particles of rock < 3" and > 0.075" (#20 sieve).
SAND - Particles of rock < 0.075" (#20 sieve) and > 0.0025" (#60 sieve).
SILT - Soil < 0.0025" (#60 sieve), non or slightly plastic and exhibits no strength when air-dried.
CLAY - Fine grained soil, exhibits plasticity when moist and considerable strength when air-dried.

VARVED - Alternate layers of silt and clay.
HARDPAN - Extremely dense soil, cemented layer, not softened when wet.
MUCK - Soft organic soil (containing > 10% organic material).
MOISTURE CONTENT - Weight of water divided by dry weight of soil.
FLOWING SAND - Granular soil so saturated (loose) that it flows into drill casing during extraction of wash rod.
STRIKE - Angle from magnetic north to line of intersection of bed with a horizontal plane.
DIP - Inclination of bed with a horizontal plane.

The subsurface explorations shown herein were made between 04/05/12 and 04/20/12 by the Agency.

Soil and rock classifications, properties and descriptions are based on engineering interpretation from available subsurface information by the Agency and may not necessarily reflect actual variations in subsurface conditions that may be encountered between individual boring or sample locations.

Observed water levels and/or conditions indicated are as recorded at the time of exploration and may vary according to the prevailing rainfall, methods of exploration and other factors.

GENERAL NOTES

4. Engineering judgment was exercised in preparing the subsurface information presented herein. Analysis and interpretation of subsurface data was performed and interpreted for Agency design and estimating purposes. Presentation of the information in the Contract is intended to provide the Contractor access to the same data available to the Agency. The subsurface information is presented in good faith and is not intended as a substitute for personal investigation, independent interpretation, independent analysis or judgment by the Contractor.

5. Pictorial structure details shown on the boring plan layout or soils profile are for illustrative purposes only and may not accurately portray final contract details.

6. Terminology used on boring logs to describe the hardness, degree of weathering, and spacing of fractures, joints and other discontinuities in the bedrock is defined in the AASHTO Manual Subsurface Investigations, 1988.

7. Northing and Easting coordinates are shown in Vermont State Plane Grid North American Datum 1983 in meters and survey feet.

PROJECT NAME: BRIGHTON
 PROJECT NUMBER: ER STP 034-3(25)

FILE NAME: silb208bor.dgn
 PROJECT LEADER: K. HIGGINS
 DESIGNED BY: J. SALVATORI
 BORING LAYOUT SHEET

PLOT DATE: 12-SEP-2012
 DRAWN BY: J. SALVATORI
 CHECKED BY: W. LAMMER
 SHEET 12 OF 36

ABUTMENT I
BOT OF PILE CAP
EL 1165.78

VTTrans		STATE OF VERMONT AGENCY OF TRANSPORTATION MATERIALS & RESEARCH SECTION SUBSURFACE INFORMATION		BORING LOG		Boring No.: 8-101				
				BRIGHTON STP 034-3(25) VT-105 BR-84		Page No.: 1 of 2 Pin No.: 119208 Checked By: CCB				
Boring Crew: PORTER, DAVISON, HOLT				Casing: WB		Sampler: SS				
Date Started: 4/05/12 Date Finished: 4/16/12				Type: I.D.: 4 in		Groundwater Observations				
VTSPG NAD83: N 841105.36 ft E 1788689.41 ft				Hammer Wt: N.A. 140 lb.		Date: 04/16/12				
Station: 55+50 Offset: 10.00				Hammer Fall: N.A. 30 in		Depth (ft): 8.5				
Ground Elevation: 1174.85 ft				Hammer/Rod Type: Auto/AWJ		Notes: AM				
				Rig: CME 45C SKID		CE = 1.33				
Depth (ft)	Strike (°)	CLASSIFICATION OF MATERIALS (Description)	Run (log deg.)	Core (log deg.)	Drill Rate (min/ft)	Flow (ft/min)	Moisture Content %	Gravel %	Sand %	Fine %
0		Asphalt Pavement, 0.0 ft - 0.5 ft								
5		Visual Description: SSs with one piece of granite, brn. Moist, Rec. = 0.2 ft, Stone in end of sampler. Insufficient sample for testing.				8-6-8-11 (12)				
10		A-1-a, SaGr, brn, Moist, Rec. = 0.8 ft				8-8-8-5 (16)	17.0	54.2	36.9	8.9
15		Field Note: No Recovery. Trace of silt in sampler				4-1-1-1 (2)				
20		A-2-4, Sa, gry, Moist, Rec. = 1.0 ft				15-12-11-13 (23)	19.0	15.8	72.9	11.3
25		A-1-b, Sa, brn, Moist, Rec. = 1.5 ft				5-6-8-9 (14)	19.2	7.9	86.1	8.0
30		A-2-4, Sa, brn, Moist, Rec. = 1.2 ft, Granite chips were within sample.				7-10-14-15 (24)	15.2	18.1	70.4	11.5
35		A-1-b, GrSa, brn, Moist, Rec. = 1.0 ft, Granite chips and broken rock were within sample.				17-17-21-24 (38)	13.7	40.7	44.9	14.4
40		A-1-b, GrSa, brn, Moist, Rec. = 0.8 ft, Granite chips and broken rock were within sample.				22-20-14-11 (34)	12.9	38.0	52.8	9.2
45		A-1-b, GrSa, brn, Moist, Rec. = 0.7 ft, Granite chips and broken rock were within sample.				14-12-16-15 (28)	12.6	40.2	50.5	9.3
50		A-1-b, GrSa, gry-brn, Moist, Rec. = 1.1 ft, Granite chips were within sample.				8-11-18-8 (29)	15.6	38.2	53.8	8.0

Notes:
1. Stratification lines represent approximate boundary between material types. Transition may be gradual.
2. All values have not been corrected for hammer energy. CE is the hammer energy corrected factor.
3. Water level readings have been made at times and under conditions stated. Fluctuations of groundwater may occur due to other factors than those present at the time measurements were made.

VTTrans		STATE OF VERMONT AGENCY OF TRANSPORTATION MATERIALS & RESEARCH SECTION SUBSURFACE INFORMATION		BORING LOG		Boring No.: 8-101				
				BRIGHTON STP 034-3(25) VT-105 BR-84		Page No.: 2 of 2 Pin No.: 119208 Checked By: CCB				
Boring Crew: PORTER, DAVISON, HOLT				Casing: WB		Sampler: SS				
Date Started: 4/05/12 Date Finished: 4/16/12				Type: I.D.: 4 in		Groundwater Observations				
VTSPG NAD83: N 841105.36 ft E 1788689.41 ft				Hammer Wt: N.A. 140 lb.		Date: 04/16/12				
Station: 55+50 Offset: 10.00				Hammer Fall: N.A. 30 in		Depth (ft): 8.5				
Ground Elevation: 1174.85 ft				Hammer/Rod Type: Auto/AWJ		Notes: AM				
				Rig: CME 45C SKID		CE = 1.33				
Depth (ft)	Strike (°)	CLASSIFICATION OF MATERIALS (Description)	Run (log deg.)	Core (log deg.)	Drill Rate (min/ft)	Flow (ft/min)	Moisture Content %	Gravel %	Sand %	Fine %
55		A-1-b, GrSa, gry-brn, Moist, Rec. = 1.0 ft, Small Granite chips within size.				6-5-8-9 (13)	18.9	32.5	62.6	4.9
60		A-1-b, GrSa, gry-brn, Moist, Rec. = 1.1 ft				6-8-9-18 (17)	17.2	28.9	57.5	13.6
65		A-1-b, Sa, gry-brn, Moist, Rec. = 1.0 ft				9-10-21-32 (51)	18.3	17.3	78.6	4.1
70		A-4, Si, brn, Moist, Rec. = 0.6 ft					28.2	0.5	3.4	96.1
75		A-4, Si, gry, Moist, Rec. = 1.3 ft				19-31-35-43 (66)	20.0	0.1	11.8	88.1
80		A-2-4, GrSa, gry, Moist, Rec. = 1.2 ft				22-25-35-37 (60)	11.6	22.3	58.6	19.1
85		Field Note: Cored ahead								
90		Field Note: Cobbles								
95		A-2-4, GrSiSa (HP), gry, Moist, Rec. = 0.2 ft				61-R02.5"	7.1	24.7	45.3	30.0
100		Field Note: Advanced casing to 87 feet. Cleaned out casing. 1.8 feet of rock inside bottom of casing.								
105		87.0 ft - 92.0 ft, Light gray, With dark green splotches Diorite, Hard, Unweathered, Very good rock, BQMD, RMR = 92	1 (7)	92 (90)	7					
110		92.0 ft - 97.0 ft, Light gray, With dark green splotches Diorite, Hard, Unweathered, Very good rock, BQMD, Healed near vertical fracture from 95.0-97.0 feet. RMR = 92	2 (7)	100 (94)	5					
115										
120										
ABUTMENT 2
BOT OF PILE CAP
EL 1165.33

		STATE OF VERMONT AGENCY OF TRANSPORTATION MATERIALS & RESEARCH SECTION SUBSURFACE INFORMATION			BORING LOG BRIGHTON STP 034-3(25) VT-105 BR-84			Boring No.: B-102 Page No.: 1 of 2 Pin No.: 118208 Checked By: CCB			
Boring Crew: PORTER, DAVISON				Type:	Casing I.D.: WB	Sampler SS	Groundwater Observations				
Date Started: 4/17/12 Date Finished: 4/20/12					4 in 1.5 in		Date	Depth (ft)	Notes		
VTSPO NAD83: N 841124.26 ft E 1788764.69 ft				Hammer Wt:	N.A. 140 lb.		04/20/12	9.5	AM		
Station: 56+25 Offset: -10.00				Hammer Fall:	N.A. 30 in.						
Ground Elevation: 1174.26 ft				Hammer/Rod Type:	Auto/AWJ						
				Rig:	CME ASC SKID CE = 1.33						
Depth (ft)	Strata (t)	CLASSIFICATION OF MATERIALS (Description)					Blow/ft (N Value)	Moisture Content %	Gravel %	Sand %	Fines %
		Asphalt Pavement, 0.0 ft - 0.5 ft									
		A-1-b, GrSa, brn, Moist, Rec. = 1.0 ft					7-7-8-7 (15)	9.9	35.5	48.3	15.2
		A-1-a, SoGr, brn, Moist, Rec. = 0.9 ft					4-4-8-9 (12)	12.1	53.0	39.2	7.8
10		A-1-b, GrSa, brn, Moist, Rec. = 0.6 ft					2-2-3-2 (5)	18.4	30.5	58.6	10.8
		A-1-a, SoGr, brn-gry, Moist, Rec. = 0.8 ft					14-14-15-20 (32)	12.0	52.5	37.5	10.0
20		A-2-4, Sa, brn, Moist, Rec. = 1.0 ft					6-6-8-8 (14)	20.6	9.7	76.5	13.8
		A-3, Sa, brn, Moist, Rec. = 0.8 ft					6-6-7-7 (13)	16.9	9.0	81.5	9.5
30		A-1-b, GrSa, brn, Moist, Rec. = 0.8 ft					7-16-17-17 (33)	16.7	42.4	53.9	3.7
		A-1-b, GrSa, brn, Moist, Rec. = 0.7 ft					8-7-6-7 (13)	16.4	30.9	61.1	8.0
40		Field Note: No Recovery. Trace of sand					8-11-11-19 (22)				
		Visual Description: Broken Granite pieces with silty sand, brn, Moist, Rec. = 0.3 ft, Insufficient sample for testing.					27-25-17-15 (42)	17.7			
50		A-3, Sa, brn, Moist, Rec. = 0.7 ft					5-9-13-19 (22)	6.7	0.5	91.3	8.2
Notes: 1. Stratification lines represent approximate boundary between material types. Transition may be gradual. 2. N Values have not been corrected for hammer energy. CE is the hammer energy correction factor. 3. Moisture and readings have been made at three and under conditions stated. Fluctuations of groundwater may occur due to other factors than those present at the time measurements were made.											

STATE OF VERMONT
AGENCY OF TRANSPORTATION
MATERIALS & RESEARCH SECTION
SUBSURFACE INFORMATION

BORING LOG

BRIGHTON
STP 034-3(25)
VT-105 BR-84

Boring No.: B-102

Page No.: 2 of 2

Pin No.: 118208

Checked By: CCB

Boring Crew: PORTER, DAVISON

Date Started: 4/17/12 Date Finished: 4/20/12

VTSPO NAD83: N 841124.26 ft E 1788764.69 ft

Station: 56+25 Offset: -10.00

Ground Elevation: 1174.26 ft

Type:

Casing WB
Sampler SS

I.D.:

4 in 1.5 in

Hammer Wt:

N.A. 140 lb.

Hammer Fall:

N.A. 30 in.

Hammer/Rod Type:

Auto/AWJ

Rig: CME 45C SKID CE = 1.33

Groundwater Observations

Date	Depth (ft)	Notes
04/20/12	9.5	AM

CLASSIFICATION OF MATERIALS
(Description)

Depth (ft)	Strata (t)	Blow/ft (N Value)	Moisture Content %	Gravel %	Sand %	Fines %
60		9-11-12-12 (23)	22.5	10.5	82.5	7.0
		14-16-15-20 (34)	22.0	0.5	17.3	82.2
70		15-13-27-46 (40)	12.2	29.6	52.7	17.7
		(N)				
80		R06.0"	11.9	15.0	39.8	45.2
		R02.5"	7.3			
		R02.5"				
90		R05.0"	8.1	38.7	43.6	17.7
100						


Hole stopped @ 109.0 ft

Notes: 1. Stratification lines represent approximate boundary between material types. Transition may be gradual.
2. N Values have not been corrected for hammer energy. CE is the hammer energy correction factor.
3. Moisture and readings have been made at three and under conditions stated. Fluctuations of groundwater may occur due to other factors than those present at the time measurements were made.


STATE OF VERMONT, STP 034-3(25)01, VTRANS 4/20/12, 3/21/12

ABUTMENT 2
PILE TIP
EL 1087.33

PROJECT NAME: BRIGHTON		PLOT DATE: 12-SEP-2012	
PROJECT NUMBER: ER STP 034-3(25)		DRAWN BY: J. SALVATORI	
FILE NAME: silb208bor.dgn		CHECKED BY: W. LAMMER	
DESIGNED BY: W. LAMMER		SHEET 14 OF 36	
BORING LOG 2			

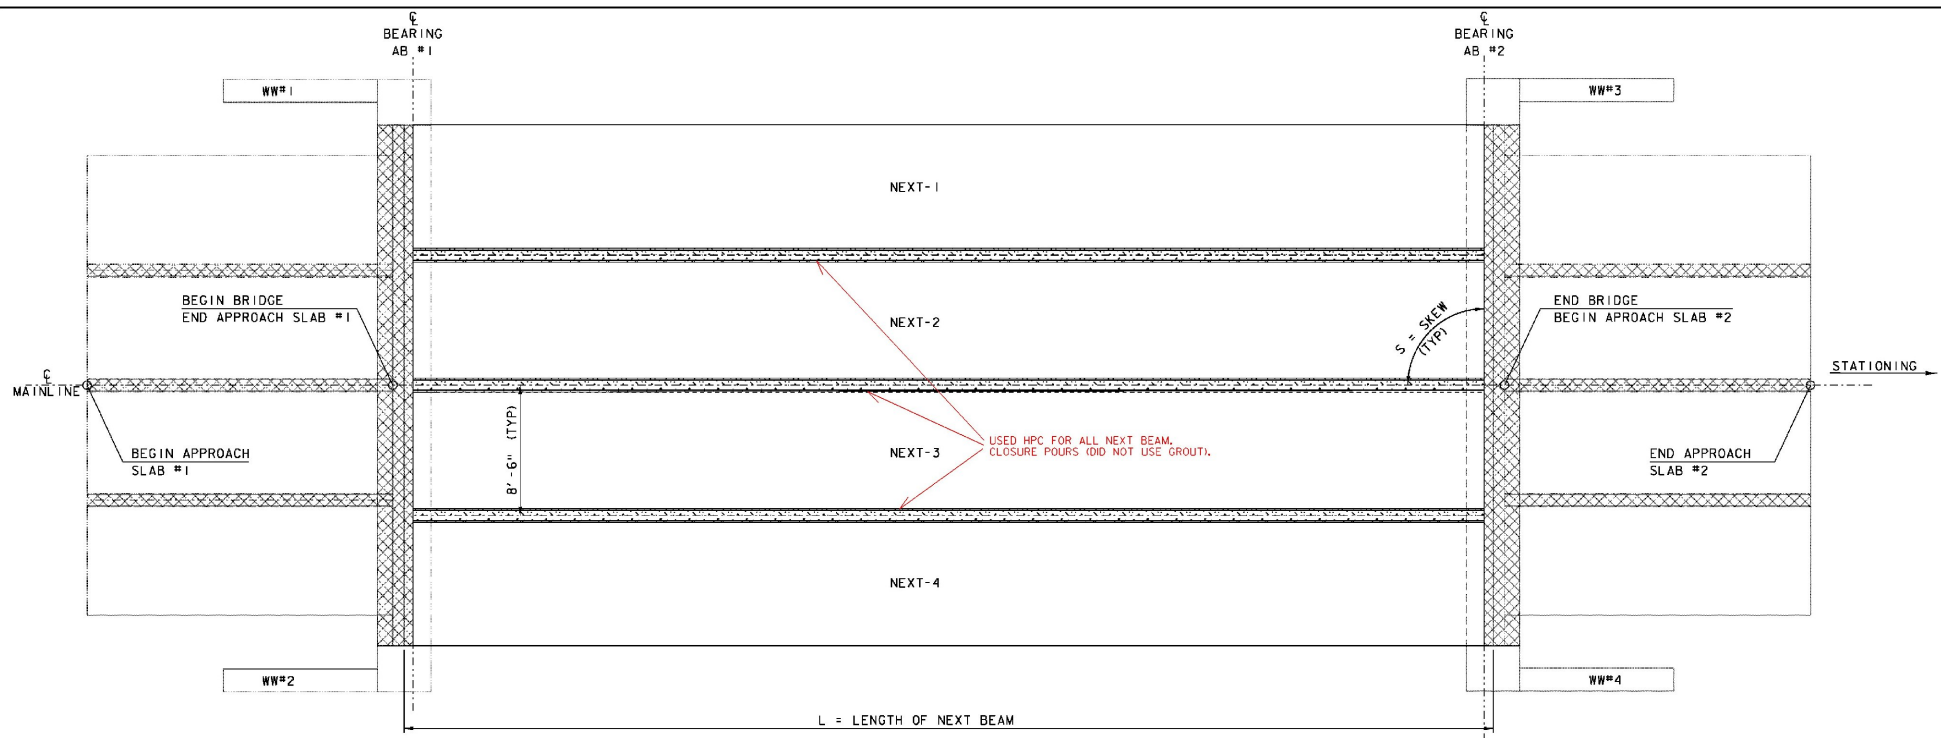

DECK PLAN
SCALE $\frac{1}{4}" = 1'-0"$

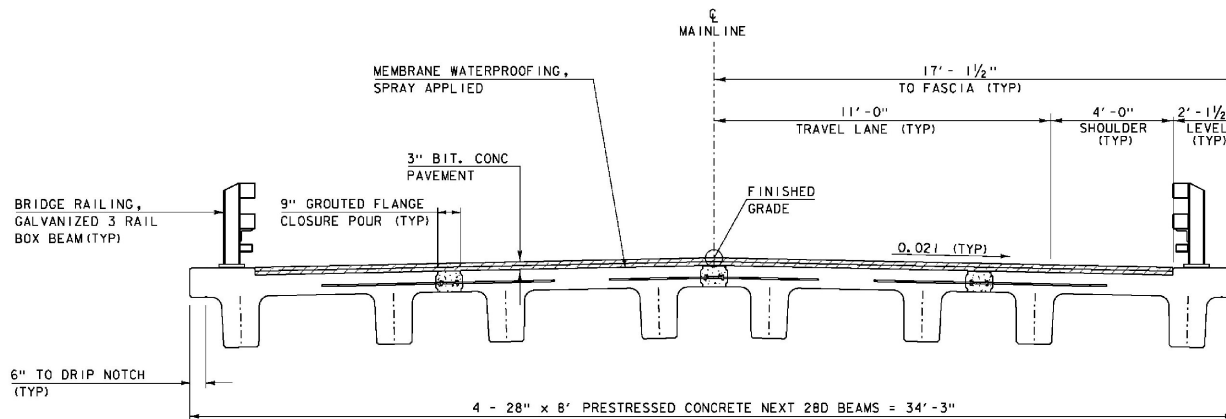

BRIDGE TYPICAL SECTION
SCALE $\frac{1}{2}" = 1'-0"$

S	90°
L	71'-0"


LEGEND

- SPECIAL PROVISION (BITUMINOUS CONCRETE PAVEMENT, SMALL QUANTITY)
- HPC = SPECIAL PROVISION (HIGH PERFORMANCE CONCRETE, RAPID SET)
- GROUTING SHEAR KEYS

PROJECT NAME: BRIGHTON
PROJECT NUMBER: ER STP 034-3(25)


FILE NAME: s1lb208sup.dgn
PROJECT LEADER: K. HIGGINS
DESIGNED BY: W. LAMMER
FRAMING PLAN

PLOT DATE: 12-SEP-2012
DRAWN BY: J. SALVATORI
CHECKED BY: W. LAMMER
SHEET 15 OF 36

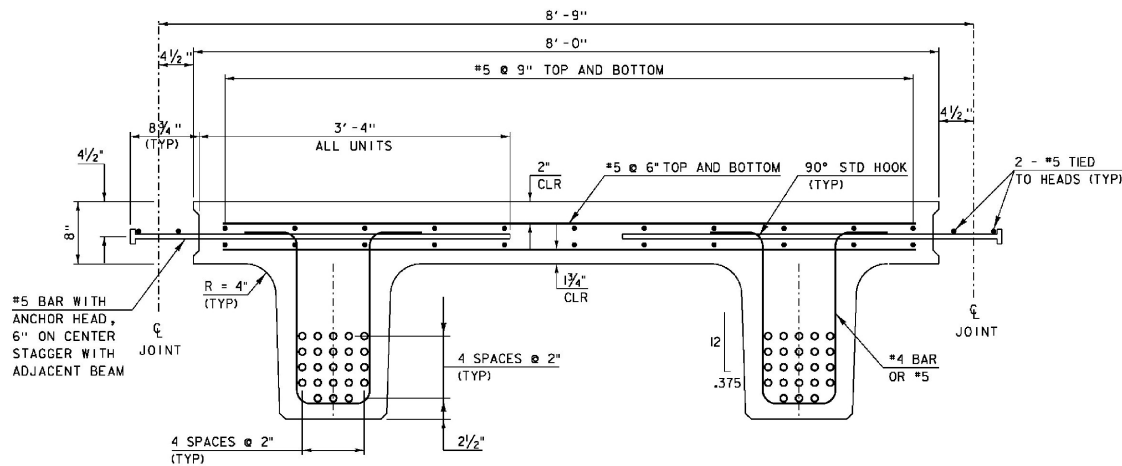


UNITS 2 & 3

SCALE: 1 1/2" = 1'-0"

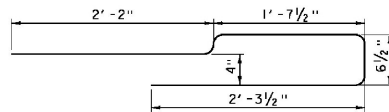


CURB BAR

SCALE: 1 1/2" = 1'-0"

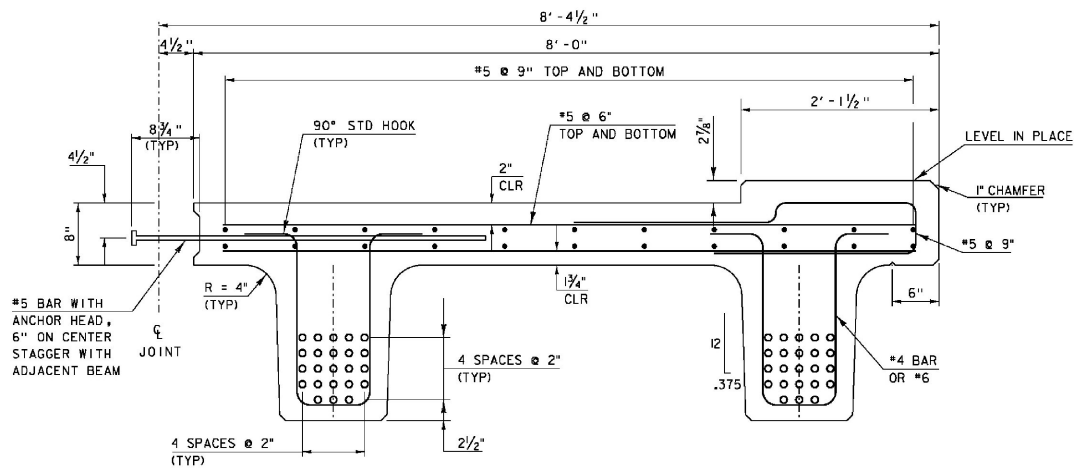


UNITS 1 & 4

SCALE: 1 1/2" = 1'-0"

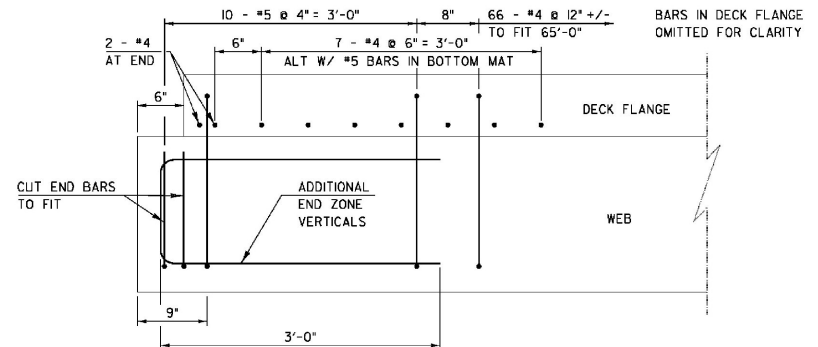


ADDITIONAL END BEAM REINFORCING LONGITUDINAL SECTION

SCALE: 1 1/2" = 1'-0"

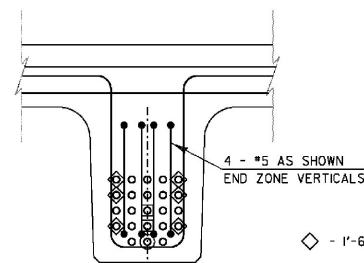

BEAM SECTION

SCALE: 1 1/2" = 1'-0"

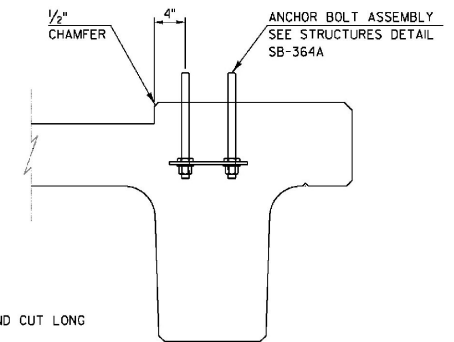

END SECTION

SCALE: 1 1/2" = 1'-0"

$L_{NEXT} = 71 \text{ FT.}$
SKEW = 90°

NOTES:

1. LEAVE SIX STRANDS 1'-6" LONG AS INDICATED. TIE STRANDS TO HORIZONTAL #5 REINFORCING IN DECK CLOSURE POUR.


△ REVISED 10-12-12

- REMOVED NOTE 2

PROJECT NAME: BRIGHTON
PROJECT NUMBER: ER STP 034-3(25)

FILE NAME: silb208sup.dgn
PROJECT LEADER: K. HIGGINS
DESIGNED BY: W. LAMMER
NEXT BEAM TYPICAL SECTIONS

PLOT DATE: 12-OCT-2012
DRAWN BY: J. SALVATORI
CHECKED BY: W. LAMMER
SHEET 16 OF 36

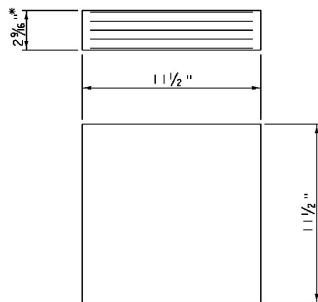


ELASTOMERIC BEARING DETAIL

SCALE 3" = 1'-0"

- * 2 - 1/8" EXTERIOR LAYERS OF ELASTOMER
- 4 - 1/2" INTERIOR LAYERS OF ELASTOMER
- 5- 1/16" STEEL REINFORCING PLATES

BEARING NOTES

1. BEARINGS SHALL CONFORM TO THE APPLICABLE SUBSECTIONS OF SECTIONS 531 AND 731.
2. ALL REINFORCEMENT BETWEEN LAYERS OF ELASTOMER SHALL BE STEEL MEETING THE REQUIREMENTS OF SUBSECTION 714.02. ALL INTERNAL STEEL PLATES SHALL BE SAND BLASTED AND FREE OF COATINGS, RUST AND MILL SCALE. THE PLATES SHALL BE FREE OF SHARP EDGES AND BURRS.
3. STEEL REINFORCED ELASTOMERIC BEARINGS SHALL HAVE A MINIMUM 1/8" EDGE SEAL OF ELASTOMER INTEGRAL WITH BEARING OVER ALL INTERNAL PLATES.
4. THE ELASTOMER WAS DESIGNED WITH A SHEAR MODULUS OF 100 PSI +/- 15%
5. THE CONCRETE UNDER THE BEARING DEVICE SHALL BE LEVEL.
6. THE CONTRACTOR IS ADVISED TO HAVE A MINIMUM OF 16 - 1/4"x12 1/2"x12 1/2" GALVANIZED STEEL SHIMS AVAILABLE FOR USE FOR ELEVATION ADJUSTMENTS UPON THE SETTING OF THE SUPERSTRUCTURE UNITS. THE SHIMS SHALL BE FABRICATED ACCORDING TO SECTION 531 AND SHALL BE INCLUDED UNDER ITEM 531.17, "BEARING DEVICE ASSEMBLY, STEEL REINFORCED ELASTOMERIC PAD".

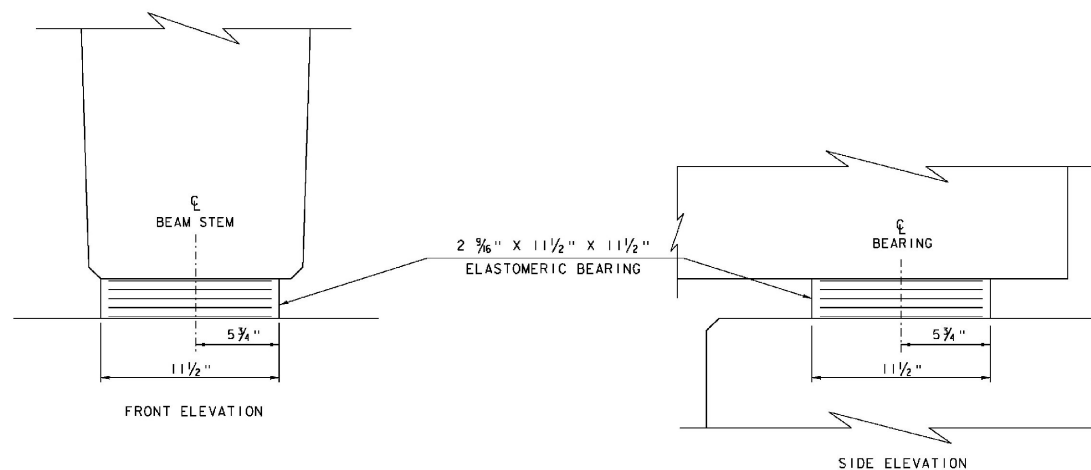


ELASTOMERIC BEARING DETAILS

SCALE 3" = 1'-0"


PROJECT NAME:	BRIGHTON	PLOT DATE:	12-SEP-2012
PROJECT NUMBER:	ER STP 034-3(25)	DRAWN BY:	J. SALVATORI
FILE NAME:	slb208brg.dgn	DESIGNED BY:	W. LAMMER
PROJECT LEADER:	K. HIGGINS	CHECKED BY:	W. LAMMER
BEARING DETAILS		SHEET	17 OF 36

PLOT DATE: 12-SEP-2012
DRAWN BY: J. SALVATORI
CHECKED BY: W. LAMMER
SHEET 18 OF 36

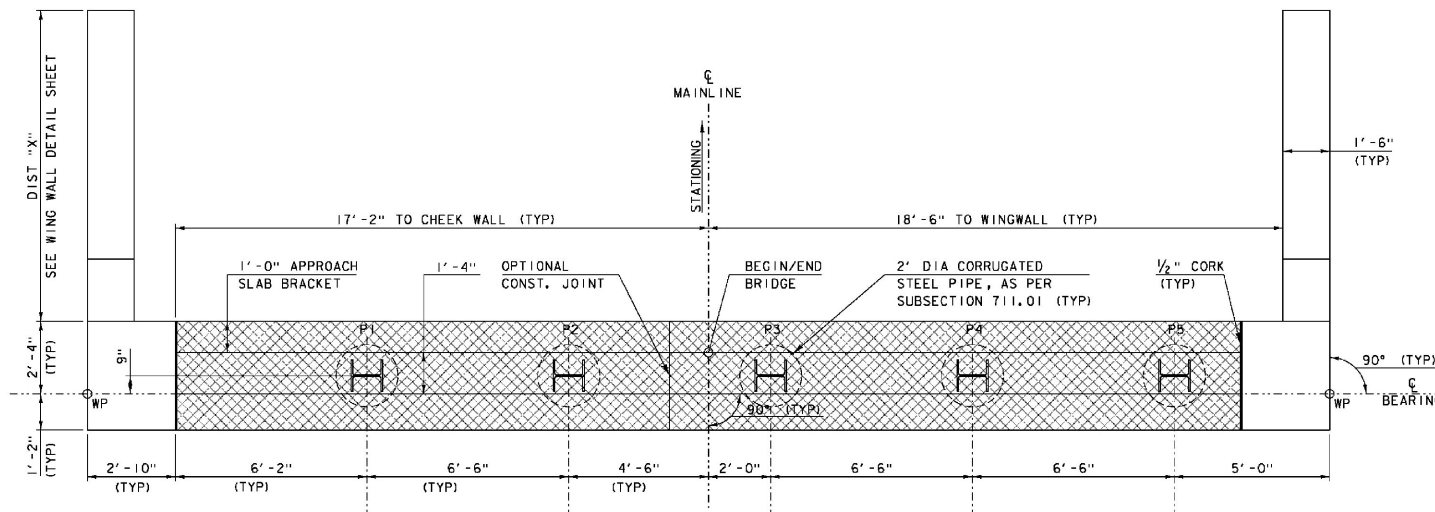

PCU I PLAN

SCALE 1/2" = 1'-0"

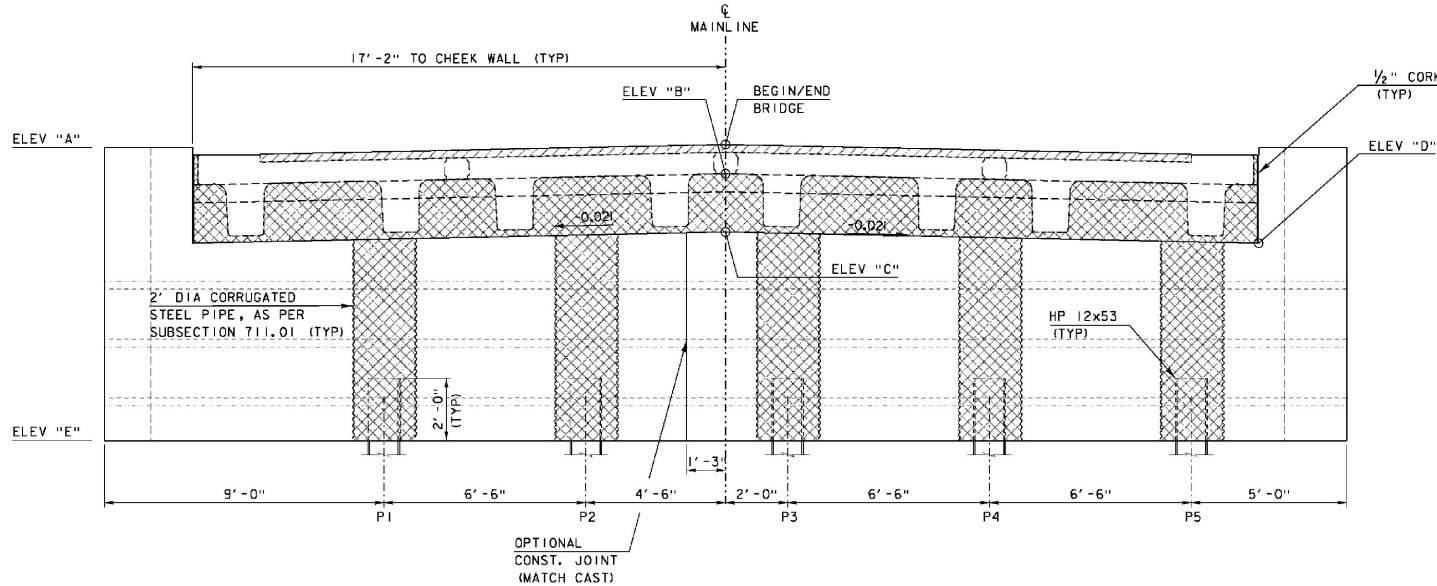


PCU I ELEVATION

SCALE 1/2" = 1'-0"

PCU I ELEVATIONS

	AB1	AB2
ELEV "A"	1175.25	1174.75
ELEV "B"	1174.36	1173.91
ELEV "C"	1172.49	1172.04
ELEV "D"	1172.13	1171.68
ELEV "E"	1165.78	1165.33

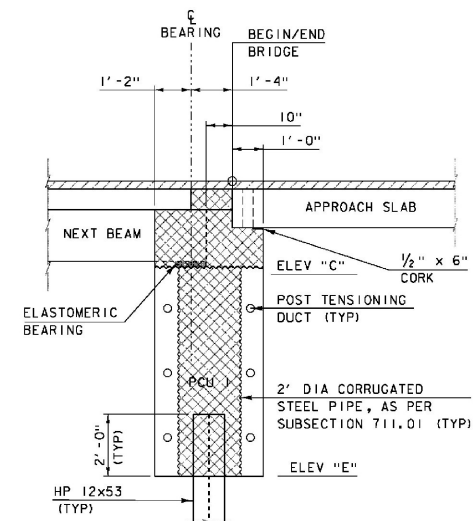

PCU I TYPICAL


SCALE 1/2" = 1'-0"

NOTE: POST-TENSIONING AND ASSOCIATED ITEMS ONLY REQUIRED IF PILE CAP IS CONSTRUCTED OF MORE THAN ONE UNIT.


PROJECT NAME: BRIGHTON
PROJECT NUMBER: ER STP 034-3(25)

FILE NAME: s11b208sub.dgn
PROJECT LEADER: K. HIGGINS
DESIGNED BY: W. LAMMER
ABUTMENT PLAN


PLOT DATE: 12-SEP-2012
DRAWN BY: J. SALVATORI
CHECKED BY: W. LAMMER
SHEET 19 OF 36

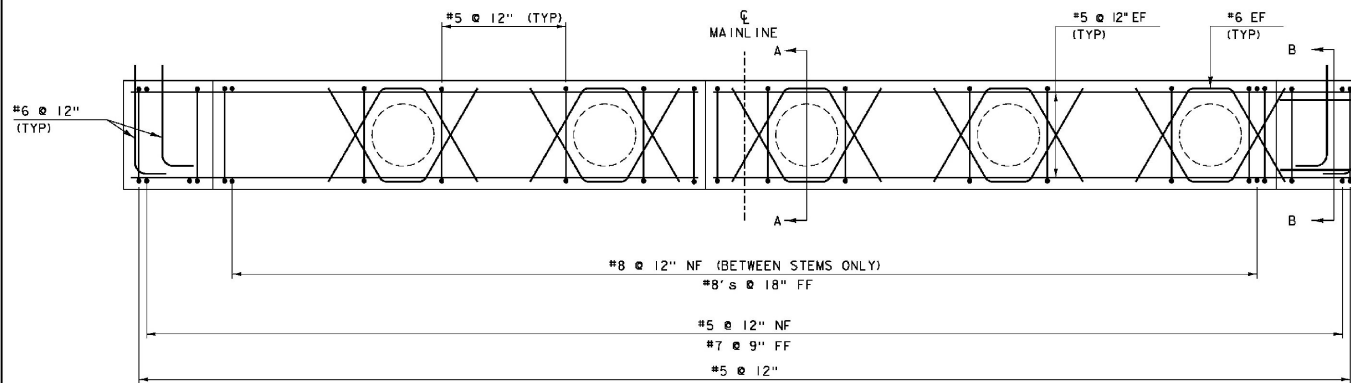


PCU I REINFORCING PLAN
SCALE 1/2" = 1'-0"

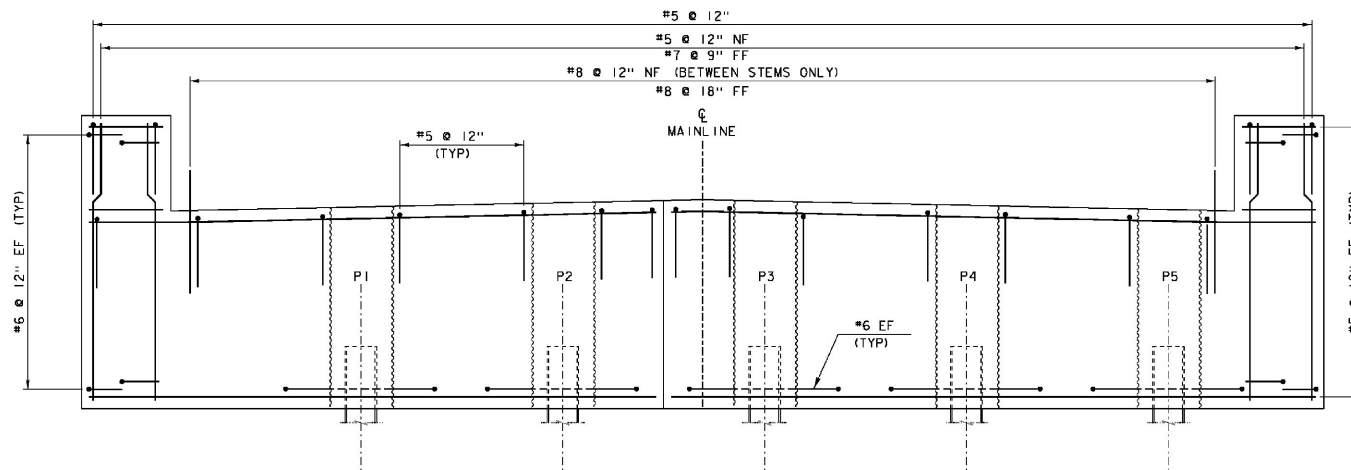

PCU I REINFORCING ELEVATION
SCALE 1/2" = 1'-0"

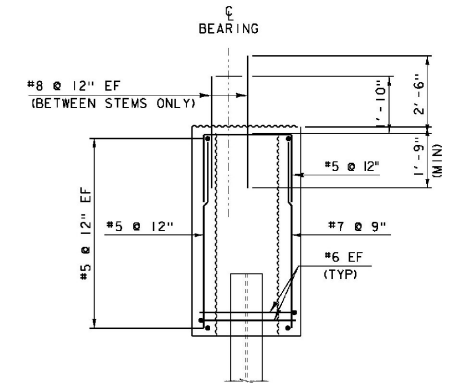

SECTION A-A
SCALE 1/2" = 1'-0"

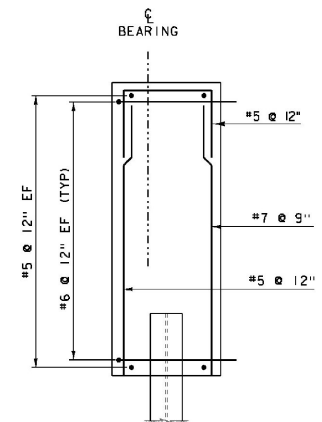

SECTION B-B
SCALE 1/2" = 1'-0"


NOTE:

NF = NEAR FACE
FF = FAR FACE
EF = EACH FACE
▲ = CUT TO FIT IN FIELD
3" CLEAR, UNLESS OTHERWISE
SPECIFIED ON THE PLANS.
2'-2" BAR LAP UNLESS OTHERWISE
SPECIFIED ON THE PLANS.


PROJECT NAME: BRIGHTON
PROJECT NUMBER: ER STP 034-3(25)

FILE NAME: s11b208sub.dgn
PROJECT LEADER: K. HIGGINS
DESIGNED BY: W. LAMMER
ABUTMENT REINFORCING


PLOT DATE: 12-SEP-2012
DRAWN BY: J. SALVATORI
CHECKED BY: W. LAMMER
SHEET 20 OF 36

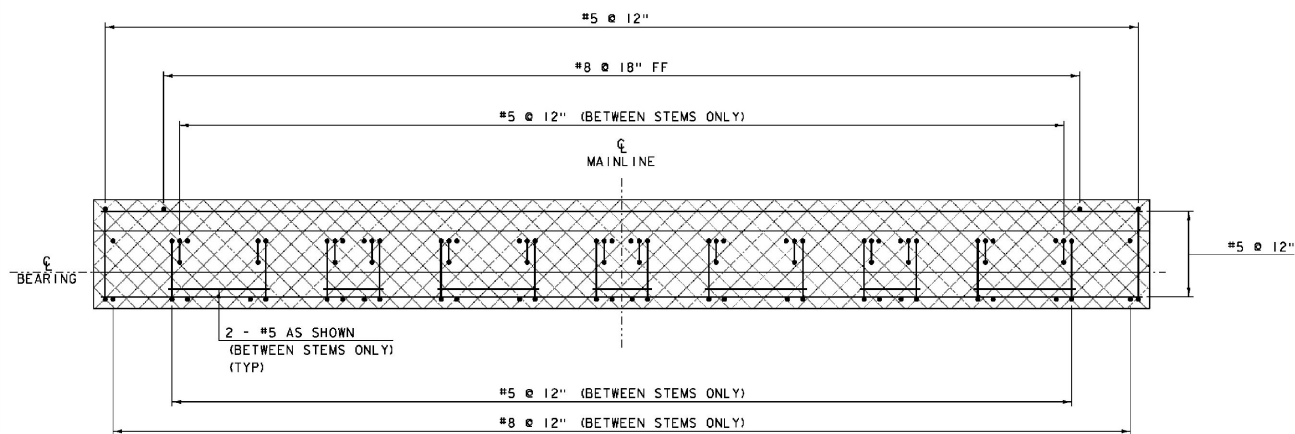

DECK CLOSURE POUR
REINFORCING PLAN
SCALE 1/2" = 1'-0"

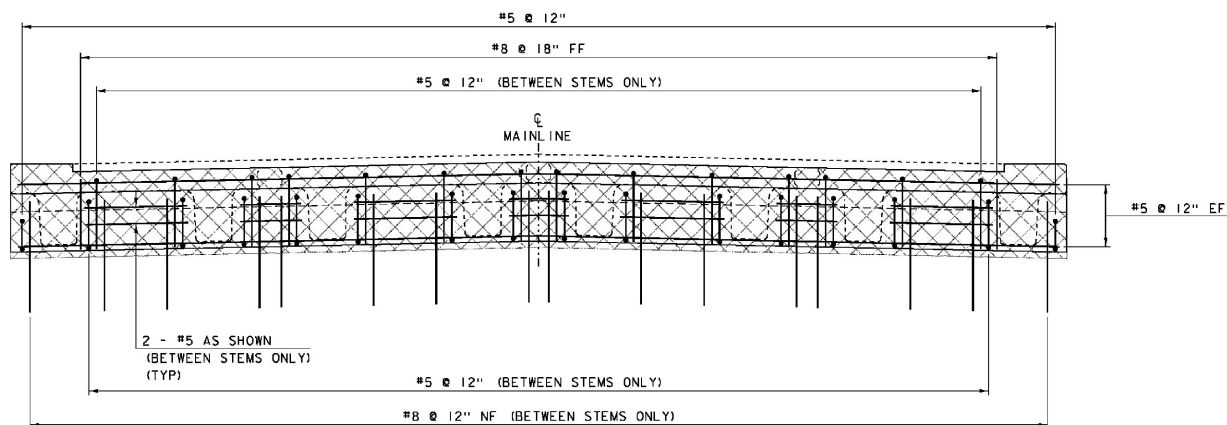

DECK CLOSURE POUR
REINFORCING ELEVATION
SCALE 1/2" = 1'-0"

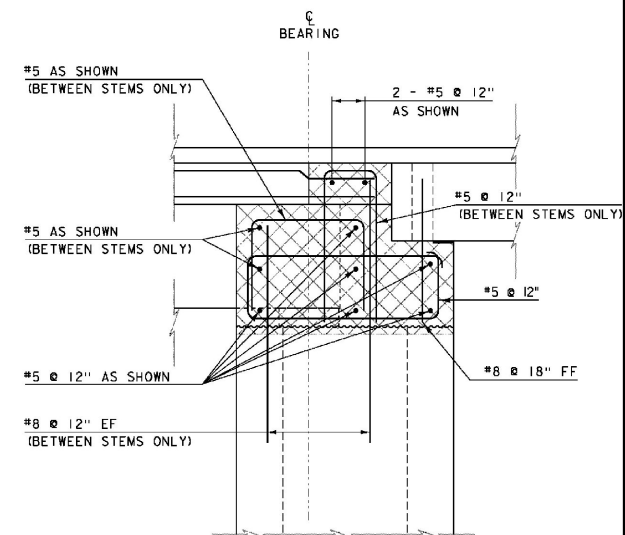

REINFORCING TYPICAL
SCALE 1" = 1'-0"


NOTE:

NF = NEAR FACE
FF = FAR FACE
EF = EACH FACE
▲ = CUT TO FIT IN FIELD
3" CLEAR, UNLESS OTHERWISE
SPECIFIED ON THE PLANS.
2' - 2" BAR LAP UNLESS OTHERWISE
SPECIFIED ON THE PLANS.

PROJECT NAME: BRIGHTON
PROJECT NUMBER: ER STP 034-3(25)

FILE NAME: s11b208sub.dgn
PROJECT LEADER: K. HIGGINS
DESIGNED BY: W. LAMMER
DECK CLOSURE POUR DETAILS


PLOT DATE: 12-SEP-2012
DRAWN BY: J. SALVATORI
CHECKED BY: W. LAMMER
SHEET 21 OF 36

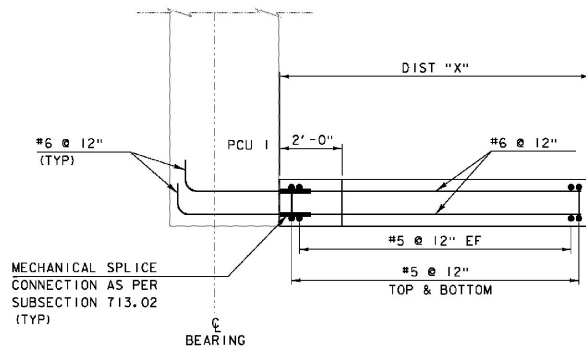


PCU 2 PLAN
SCALE 1" = 1'-0"

PCU 2 ELEVATIONS

	WW1	WW2	WW3	WW4
ELEV "A"	1175.25	1175.25	1174.75	1174.75
ELEV "B"	1175.25	1175.25	1174.75	1174.75
ELEV "E"	1165.78	1165.78	1165.33	1165.33
DIST "X"	10'-0"	10'-0"	10'-0"	10'-0"

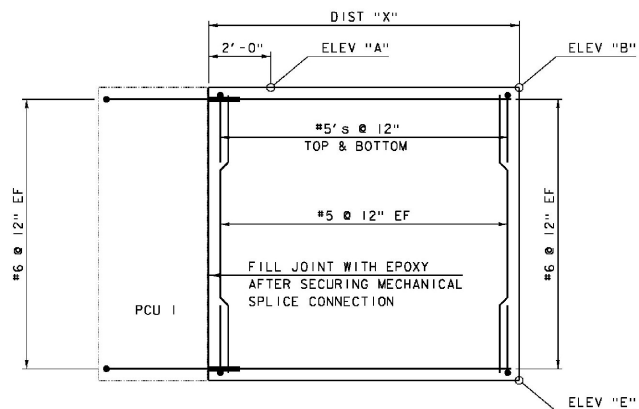

PCU 2 ELEVATION
SCALE 1/2" = 1'-0"

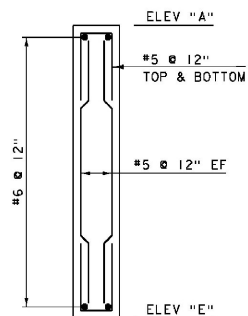

PCU 2 TYPICAL
SCALE 1/2" = 1'-0"

NOTE:

NF = NEAR FACE
FF = FAR FACE
EF = EACH FACE
▲ = CUT TO FIT IN FIELD
3" CLEAR, UNLESS OTHERWISE
SPECIFIED ON THE PLANS.
2'-2" BAR LAP UNLESS OTHERWISE
SPECIFIED ON THE PLANS.

NOTES:

- EPOXY SHALL BE INCIDENTAL TO THE PRECAST CONCRETE STRUCTURE.

PROJECT NAME: BRIGHTON
PROJECT NUMBER: ER STP 034-3(25)

FILE NAME: s11b208sub.dgn
PROJECT LEADER: K. HIGGINS
DESIGNED BY: W. LAMMER
WINGWALL DETAILS

PLOT DATE: 12-SEP-2012
DRAWN BY: J. SALVATORI
CHECKED BY: W. LAMMER
SHEET 22 OF 36

V	T	1	0	5		
C	L	O	S	E		

PORTABLE CHANGABLE SIGN - PHASE 1

W	E	S	T		O	F
I	S	L	A	N	D	
P	O	N	D			

PORTABLE CHANGABLE SIGN - PHASE 2

*	M	M	M		D	D	-
*	M	M	M		D	D	

PORTABLE CHANGABLE SIGN - PHASE 3

* M=MONTH
D=DAY

(S)

NOTES:

1. THE PORTABLE CHANGABLE MESSAGE SIGNS SHALL BE FULLY OPERATIONAL A MINIMUM OF TWO WEEKS PRIOR TO THE CLOSURE OF VT 105.
2. DURING ACTUAL CLOSURE, ELIMINATE PHASE 3 ONLY.
3. DETOUR SIGNS SHALL BE LOCATED ADJACENT TO EXISTING INTERSECTION ROUTE MARKER ASSEMBLIES WHERE APPLICABLE.
4. DETOUR SIGNING IS THE RESPONSIBILITY OF THE CONTRACTOR. PAYMENT FOR ALL TEMPORARY TRAFFIC CONTROL DEVICES FOR IMPLEMENTING THE DETOUR, INCLUDING BUT NOT LIMITED TO SIGNS, BARRICADES AND MESSAGE BOARDS, WILL BE INCLUDED IN THE UNIT PRICE BID FOR CONTRACT ITEM 900.645 SPECIAL PROVISION (TRAFFIC CONTROL, ALL-INCLUSIVE).
5. THIS DETOUR PLAN IS AN OUTLINE ONLY AND THE CONTRACTOR SHALL SUBMIT A DETAILED PLAN OF EACH INTERSECTION SHOWING DETOUR SIGN LOCATIONS IN RELATION TO EXISTING SIGNS.



SIGN MOUNTING ON
TYPE III BARRICADE
(MODIFIED)


(A)



SIGN MOUNTING ON
TYPE III BARRICADE
(MODIFIED)


(B)

**E= EAST
OR
W= WEST

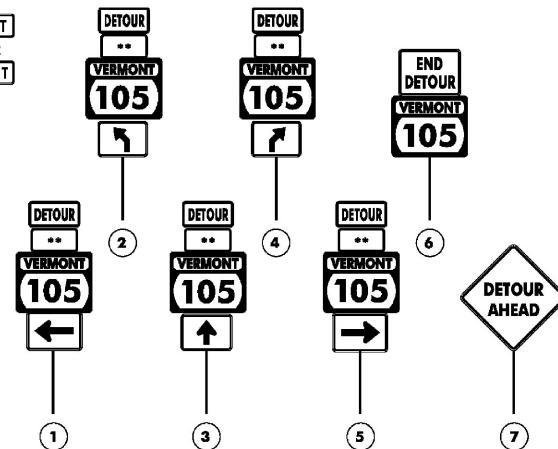

ROAD CLOSED
XX MILES AHEAD
LOCAL TRAFFIC ONLY

(10)

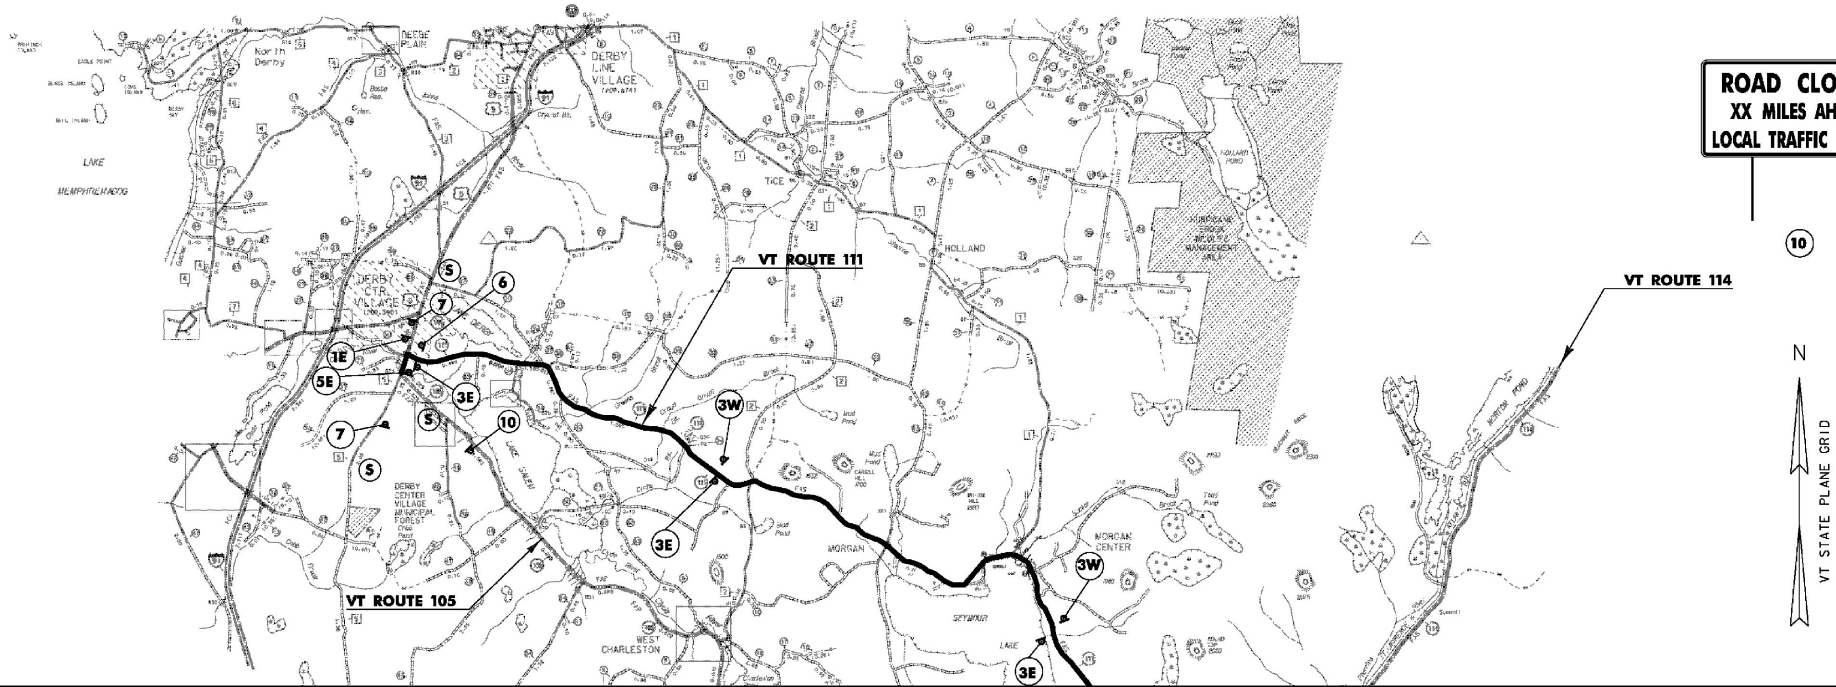

MATCHLINE

DETOUR PLAN - I

NOT TO SCALE

PROJECT NAME:	BRIGHTON	PLOT DATE:	12-SEP-2012
PROJECT NUMBER:	ER STP 034-3 (25)	DRAWN BY:	K. FRIEDLAND
FILE NAME:	slb208detour.dgn	DESIGNED BY:	J. SALVATORI
		CHECKED BY:	W. LAMMER
		SHEET	23 OF 36

EPSC NARRATIVE

1.1 PROJECT DESCRIPTION

THIS PROJECT INVOLVES THE REPLACEMENT OF BRIDGE 84 AND RELATED APPROACH AND CHANNEL WORK.

THE BRIDGE IS APPROXIMATELY 1.668 MILES SOUTH EASTERLY OF THE CHARLESTON/BRIGHTON TOWN LINE ALONG VT 105.

NOTE: AREA OF DISTURBANCE INCLUDES LIMITS OF EARTH DISTURBANCE WITHIN THE PROJECT AREA, AS WELL AS WASTE, BORROW AND STAGING AREAS, AND OTHER EARTH DISTURBING ACTIVITIES WITHIN OR DIRECTLY ADJACENT TO THE PROJECT LIMITS AS SHOWN ON THE ATTACHED EPSC PLAN.

TOTAL AREA OF DISTURBANCE AS SHOWN ON THE ATTACHED EPSC PLAN IS APPROXIMATELY 0.39 ACRES.

IT IS ANTICIPATED THAT THIS PROJECT WILL LAST ONE CONSTRUCTION SEASON.

1.2 SITE INVENTORY

1.2.1 TOPOGRAPHY

THE TOPOGRAPHY OF THE PROJECT AREA IS RELATIVELY FLAT, WITH THE ROADWAY RAISED SLIGHTLY FROM THE SURROUNDING TERRAIN.

1.2.2 DRAINAGE, WATERWAYS, BODIES OF WATER, AND PROXIMITY TO NATURAL OR MAN-MADE WATER FEATURES

THE COLD RIVER IS THE ONLY WATER SOURCE ON THE PROJECT SITE. THE RIVER IS CLASSIFIED AS SINUOUS, ALLUVIAL, WITH A BEND COMING IN TO THE BRIDGE. THE STREAM BED CONSISTS OF SAND, GRAVEL AND COBBLES. THERE IS AN EXISTING CULVERT AT STATION 57+00 THAT WILL NOT BE IMPACTED AS PART OF THIS PROJECT.

1.2.3 VEGETATION

THE VEGETATION IN THE PROJECT AREA CONSISTS MOSTLY FORESTED LAND COVER. THE IMPACT TO VEGETATION WILL BE LIMITED TO THAT WHICH IS DIRECTLY AFFECTED BY REPLACEMENT OF THE EXISTING CULVERT. UPON PROJECT COMPLETION, THE CHANNEL WILL BE ARMORED WITH STONE FILL TYPE III AS SPECIFIED ON THE PLANS. DISTURBED VEGETATION WILL BE REESTABLISHED WITH STANDARD SEED AND MULCH PRACTICES.

1.2.4 SOILS

ALL SOIL DATA CAME FROM THE U.S. DEPARTMENT OF AGRICULTURE SOIL CONSERVATION SERVICE FOR THE COUNTY OF ESSEX, VERMONT.

SOILS ON THE PROJECT SITE ARE:

3A – CHARLES SILTY LOAM, 0% TO 2% SLOPES, "K FACTOR" = 0.32. THE SOIL IS CONSIDERED FREQUENTLY FLOODED.

6B – ADAMS LOAMY FINE SAND, 3% TO 8% SLOPES, "K FACTOR" = 0.17

NOTE: K-VALUES GENERALLY INDICATE THE FOLLOWING:
0.0-0.23 = LOW EROSION POTENTIAL
0.24-0.38 = MODERATE EROSION POTENTIAL
0.37 AND HIGHER = HIGH EROSION POTENTIAL

1.2.5 SENSITIVE RESOURCE AREAS

CRITICAL HABITATS: NO
HISTORICAL OR ARCHEOLOGICAL AREAS: NO
PRIME AGRICULTURAL LAND: NO
THREATENED AND ENDANGERED SPECIES: NO
WATER RESOURCE: COLD RIVER
WETLANDS: NO

1.3 RISK EVALUATION

THIS PROJECT DOES NOT FALL UNDER THE JURISDICTION OF GENERAL PERMIT 3-9020 FOR STORMWATER RUNOFF FROM CONSTRUCTION SITES. SHOULD CHANGES PRIOR TO OR DURING CONSTRUCTION RESULT IN ONE OR MORE ACRES OF EARTH DISTURBANCE OR SHOULD THE PROJECT BECOME PART OF A LARGER PLAN OF DEVELOPMENT, THE CONTRACTOR WILL BE RESPONSIBLE FOR ANY ADDITIONAL PERMITTING.

1.4 EROSION PREVENTION AND SEDIMENT CONTROL

THE EROSION CONTROL PLANS ARE MEANT AS A GUIDELINE FOR PREVENTING EROSION AND CONTROLLING SEDIMENT TRANSPORT. THE PRINCIPLES OUTLINED IN THIS NARRATIVE CONSIST OF APPLYING MEASURES THROUGHOUT CONSTRUCTION OF THE PROJECT IN ORDER TO MINIMIZE SEDIMENT TRANSPORT TO THE RECEIVING WATERS. THE MEASURES INCLUDE STABILIZATION AND STRUCTURAL PRACTICES, STORM WATER CONTROLS AND OTHER POLLUTION PREVENTION PRACTICES. THEY HAVE BEEN PROPOSED BY THE DESIGNER AS A BASIS FOR PROTECTING RESOURCES AND WILL NEED TO BE BUILT UPON BASED ON THE SPECIFIC MEANS AND METHODS OF THE CONTRACTOR. REFER TO THE LOW RISK SITE HANDBOOK AND APPROPRIATE DETAIL SHEETS FOR SPECIFIC GUIDANCE AND CONSTRUCTION DETAILING.

ALL MEASURES SHALL BE REGULARLY MAINTAINED AND SHALL BE CHECKED FOR SEDIMENT BUILD-UP. SEDIMENT SHALL BE DISPOSED OF AT AN APPROVED SITE WHERE IT WILL NOT BE SUBJECT TO EROSION.

1.4.1 MARK SITE BOUNDARIES

SITE BOUNDARIES AND AREAS CONSTRUCTION EQUIPMENT CAN ACCESS SHALL BE DELINEATED.

PROJECT DEMARCATION FENCING (PDF) SHALL BE USED TO PHYSICALLY MARK SITE BOUNDARIES AS SHOWN ON THE PLANS.

1.4.2 LIMIT DISTURBANCE AREA

PREVENTING INITIAL SOIL EROSION BY MINIMIZING THE EXPOSED AREA IS MUCH MORE EFFECTIVE THAN TREATING ERODED SEDIMENT. EARTH DISTURBANCE CAN BE MINIMIZED THROUGH CONSTRUCTION PHASING BY ONLY OPENING UP EARTH AS NECESSARY. THIS CAN LIMIT THE AREA THAT WILL BE DISTURBED AND EXPOSED TO EROSION. EMPLOY TEMPORARY CONSTRUCTION STABILIZATION PRACTICES IN INCREMENTAL STAGES AS PHASES CHANGE. FOR PROJECTS WHICH FALL UNDER THE CONSTRUCTION GENERAL PERMIT, ONLY THE ACREAGE LISTED ON THE PERMIT AUTHORIZATION MAY BE EXPOSED AT ANY GIVEN TIME.

MAINTAINING VEGETATED BUFFERS ALONG STREAM BANKS, WETLANDS OR OTHER SENSITIVE AREAS IS A CRUCIAL EROSION AND SEDIMENT CONTROL MEASURE THAT SHOULD BE ESTABLISHED WHEREVER POSSIBLE.

1.4.3 SITE ENTRANCE/EXIT STABILIZATION

TRACKING OF SEDIMENT ONTO PUBLIC HIGHWAYS SHALL BE MINIMIZED TO REDUCE THE POTENTIAL FOR RUNOFF ENTERING RECEIVING WATERS. INSTALLATION SHALL COINCIDE WITH THE CONTRACTORS PROGRESS SCHEDULE.

STABILIZED CONSTRUCTION ENTRANCES SHALL BE INSTALLED AS SHOWN ON THE PLANS AND ANYWHERE EQUIPMENT WILL BE GOING FROM AREAS OF EXPOSED SOILS TO PAVED SURFACES.

1.4.4 INSTALL SEDIMENT BARRIERS

SEDIMENT BARRIERS SHALL BE UTILIZED TO INTERCEPT RUNOFF AND ALLOW SUSPENDED SEDIMENT TO SETTLE OUT. THEY SHALL BE INSTALLED PRIOR TO ANY UP SLOPE WORK.

SILT FENCE WILL BE INSTALLED AS PROPOSED ON THE EPSC PLAN.

FILTER CURTAIN WILL BE INSTALLED AS PROPOSED ON THE EPSC PLAN.

1.4.5 DIVERT UPLAND RUNOFF

DIVERSIONARY MEASURES SHALL BE USED TO INTERCEPT RUNOFF FROM ABOVE THE CONSTRUCTION AND DIRECT IT AROUND THE DISTURBED AREA SO THAT CLEAN WATER DOES NOT BECOME MUDDIED WHILE TRAVELING OVER EXPOSED SOILS ON THE CONSTRUCTION SITE.

THE PROJECT AREA IS RELATIVELY FLAT. THEREFORE IT IS NOT ANTICIPATED THAT DIVERSION MEASURES WILL BE NECESSARY.

1.4.6 SLOW DOWN CHANNELIZED RUNOFF

CHECK STRUCTURES SHALL BE UTILIZED TO REDUCE THE VELOCITY, AND THUS THE EROSION POTENTIAL, OF CONCENTRATED FLOW IN CHANNELS.

IT IS NOT ANTICIPATED THAT STONE CHECK DAMS WILL BE NECESSARY.

1.4.7 CONSTRUCT PERMANENT CONTROLS

PERMANENT STORMWATER TREATMENT DEVICES SHALL BE INSTALLED AS SHOWN ON THE PLANS AND IN ACCORDANCE WITH PERMIT CONDITIONS.

THERE ARE NO PERMANENT STORMWATER TREATMENT DEVICES ANTICIPATED ON THIS PROJECT.

1.4.8 STABILIZE EXPOSED SOILS DURING CONSTRUCTION

ALL AREAS OF DISTURBANCE MUST HAVE TEMPORARY STABILIZATION IN PLACE WITHIN 48 HOURS OF DISTURBANCE OR IN ACCORDANCE WITH THE CONSTRUCTION GENERAL PERMIT 3-9020 AUTHORIZATION.

SURFACE ROUGHENING OF ALL EXPOSED SLOPES, COMBINED WITH TEMPORARY MULCHING, SHALL BE UTILIZED ON A REGULAR BASIS.

BIODEGRADABLE EROSION CONTROL MATTING OR AN EQUIVALENT SHALL BE USED TO STABILIZE ALL SLOPES STEEPER THAN 1:3.

THE FORECAST OF RAINFALL EVENTS SHALL TRIGGER IMMEDIATE PROTECTION OF EXPOSED SOILS.

1.4.9 WINTER STABILIZATION

VARIOUS MEASURES SPECIFIC TO WINTER MAY BE NECESSARY SHOULD THE PROJECT EXTEND INTO WINTER (OCTOBER 15 THROUGH APRIL 15). REFER TO THE LOW RISK SITE HANDBOOK FOR GUIDANCE.

1.4.10 STABILIZE SOIL AT FINAL GRADE

EXPOSED SOIL MUST BE STABILIZED WITHIN 48 HOURS OF REACHING FINAL GRADE.

SEED, MULCH, FERTILIZER AND LIME SHALL BE USED TO ESTABLISH PERMANENT VEGETATION FOR SLOPES STEEPER THAN 1:3. BIODEGRADABLE EROSION CONTROL MATTING OR AN EQUIVALENT SHALL BE USED INSTEAD OF MULCH.

1.4.11 DE-WATERING ACTIVITIES

DISCHARGE FROM DEWATERING ACTIVITIES THAT FLOWS OFF OF THE CONSTRUCTION SITE MUST NOT CAUSE OR CONTRIBUTE TO A VIOLATION OF THE VERMONT WATER QUALITY STANDARDS.

IT IS NOT ANTICIPATED THAT DEWATERING WILL BE NECESSARY.

1.4.12 INSPECT YOUR SITE

INSPECT THE PROJECT SITE BASED ON SPECIAL PROVISION REQUIREMENTS OR CONSTRUCTION GENERAL PERMIT AUTHORIZATION STIPULATIONS.

1.5 SEQUENCE AND STAGING

THIS SECTION WILL BE DEVELOPED BY THE CONTRACTOR USING THE GUIDANCE OUTLINED IN THE VTRANS EPSC PLAN CONTRACTOR CHECKLIST.

1.5.1 CONSTRUCTION SEQUENCE

1.5.2 OFF-SITE ACTIVITIES

IN ADDITION TO THE CONTRACTOR CHECKLIST ANY ACTIVITIES OUTSIDE THE CONSTRUCTION LIMITS SHALL FOLLOW SUBSECTIONS 105.25- 105.29.

PROJECT NAME: BRIGHTON
PROJECT NUMBER: ER STP 034-3(25)

FILE NAME: slb208epsc_nor.dgn
PROJECT LEADER: K. HIGGINS
DESIGNED BY: J. SALVATORI
EPSC NARRATIVE
PLOT DATE: 12-SEP-2012
DRAWN BY: J. SALVATORI
CHECKED BY: W. LAMMER
SHEET 25 OF 36

	CUT/FILL LIMITS
	PROJECT DEMARCATION FENCE
	ROLLED EROSION CONTROL PRODUCT (RECP)
	ROCK OUTLET PROTECTION
	SOIL GROUP LINE
	SILT FENCE
	STABILIZED CONSTRUCTION ENTRANCE
	TURBIDITY CURTAIN

GEOTEXTILE FOR SILT FENCE
 STA 54+00.00 - 54+25.00 LT
 STA 54+00.00 - 55+60.00 RT
 STA 54+50.00 - 55+75.00 LT
 STA 56+00.00 - 56+65.00 RT
 STA 56+25.00 - 57+70.00 LT
 STA 56+85.00 - 57+70.00 RT

PROJECT DEMARCATION FENCE
 STA 54+00.00 - 54+25.00 LT
 STA 54+00.00 - 55+60.00 RT
 STA 54+50.00 - 55+75.00 LT
 STA 56+00.00 - 56+65.00 RT
 STA 56+25.00 - 57+70.00 LT
 STA 56+85.00 - 57+70.00 RT

3A CHARLES SILT LOAM
 0% TO 2% SLOPES
 FREQUENTLY FLOODED
 "K" FACTOR = 0.32

6B ADAMS LOAMY FINE SAND
 3% TO 8% SLOPES
 "K" FACTOR = 0.17

3A CHARLES SILT LOAM
 0% TO 2% SLOPES
 FREQUENTLY FLOODED
 "K" FACTOR = 0.32

NOTES:

- EXISTING CONTOURS SHOWN. SEE CROSS SECTIONS FOR FINAL CONDITIONS.
- FOR CLARITY, AREAS TO BE SEEDED AND MULCHED HAVE NOT BEEN INDICATED. ALL DISTURBED AREAS SHALL BE SEEDED AND MULCHED AS APPLICABLE.


EPSC PLAN
 SCALE 1" = 20' - 0"
 20 0 20

PROJECT NAME: BRIGHTON
 PROJECT NUMBER: ER STP 034-3(25)

FILE NAME: slb208epsc.dgn
 PROJECT LEADER: K. HIGGINS
 DESIGNED BY: J. SALVATORI
 EPSC PLAN

PLOT DATE: 12-SEP-2012
 DRAWN BY: J. SALVATORI
 CHECKED BY: W. LAMMER
 SHEET 26 OF 36



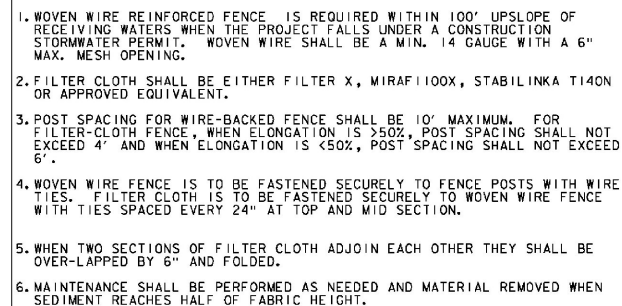

SILT FENCE

REVISIONS	
MARCH 21, 2008	WHF
DECEMBER 11, 2008	WHF
JANUARY 13, 2009	WHF

The drawing consists of two parts: a plan view labeled "SECTION A-A" and a detail view of the anchor system.

SECTION A-A (Plan View): This view shows a curved filter curtain (represented by a line with circles) installed in a waterway. Key features include:

- ANCHOR:** A horizontal line representing the anchor system, with a vertical dimension of "10' MIN" indicated.
- EXISTING HIGHWAY:** A horizontal line representing the existing highway structure.
- CONSTRUCTION GRADING LIMIT:** A dashed line indicating the limit of construction grading.
- FLOW:** An arrow pointing left, labeled "FLOW", indicating the direction of water movement.
- 100' MAX LENGTH B/T ANCHORS:** A dimension line indicating the maximum length between anchors.
- ANCHORS:** Small circles along the curved filter curtain.

Detail View (Top Right): This view shows a cross-section of the filter curtain installation. Key features include:

- BRIDGE ABUTMENT:** A vertical structure representing the bridge abutment.
- WATERWAY BOTTOM:** A line representing the bottom of the waterway.
- WEIGHTED ANCHOR SYSTEM:** A line with circles representing the weighted anchor system.
- FLOATING SILT BARRIER:** A line with circles representing the floating silt barrier.
- RIPRAP TYPICAL:** A line with circles representing the typical riprap.
- SYMBOL:** A symbol consisting of a vertical line with a circle at the top and a circle at the bottom, labeled "SYMBOL".
- NOT TO SCALE:** A note indicating that the drawing is not to scale.

A note in the center of the drawing states: "NOTE: THIS DRAWING IS A DEPICTION OF A TYPICAL INSTALLATION OF FILTER CURTAIN, IT IN NO WAY DEFINES THE TYPE OR USE OF COFFERDAM IF USED."

1. FILTER CURTAIN SHALL NOT BE PLACED ACROSS A FLOWING WATERWAY, OR IN A WATERWAY WITH STREAM VELOCITIES GREATER THAN 1.5 FEET/SECOND.
2. MAXIMUM 100' LENGTH BETWEEN ANCHORS.
3. LAST SECTION SHALL TERMINATE A MINIMUM OF 10' BEYOND LIMIT OF DISTURBANCE.
4. THE WEIGHTED ANCHOR SYSTEM SHALL BE A TYPE WHICH ALLOWS THE CURTAIN TO CONFORM TO THE BOTTOM OF THE WATERWAY.
5. THE CURTAIN SHALL BE REMOVED BY SLOWLY PULLING TOWARD THE SHORE MINIMIZING THE ESCAPE OF SEDIMENTS INTO WATERWAY.

FILTER CURTAIN

REVISIONS	
APRIL 1, 2008	WHF
JANUARY 13, 2009	WHF
SEPTEMBER 4, 2009	WHF

The image contains several technical drawings for erosion control matting installation:

- DETAIL 1 TERMINAL FOLD:** Shows two circular cross-sections. The left one shows a "JUTE MESH" with a "4\" MIN" dimension and a "STAPLE". The right one shows an "EXCELSIOR BLANKET EROSION CONTROL MATTING" with a "3\" MIN" dimension and a "STAPLE". Above them is a "TAMP SOIL FIRMLY" instruction. A vertical dimension of "6\"-12\"" is shown between the two sections.
- DETAIL 2 JUNCTION SLOT:** Shows two circular cross-sections. The left one shows "JUTE MESH" with "12\"" and "6\"" dimensions and "STAPLES". The right one shows "EXCELSIOR BLANKET EROSION CONTROL MATTING" with "12\"" and "6\"" dimensions and "STAPLES".
- DETAIL 3 ANCHOR SLOT:** Shows a circular cross-section with "12\"" and "6\"-12\"" dimensions, "STAPLES", and a "TAMP SOIL FIRMLY" instruction.
- DETAIL 4 LAP JOINT:** Shows a circular cross-section with a "4\" MIN" dimension and a "STAPLE". Below it is the text "JUTE MESH EROSION CONTROL MATTING EXCELSIOR BLANKET SHOULD BE BUTTED TOGETHER".
- STAPLE DETAIL:** A side view of a staple with a "1\" MIN" dimension.
- SYMBOL:** A circle with a dot in the center, labeled "SYMBOL" and "NOT TO SCALE".
- 3D PERSPECTIVE:** A perspective view of a matting installation on a slope, showing a "V" shaped slot and dimensions "H" and "V". It is numbered 1, 2, 3, and 4.



1. APPLY TO SLOPES GREATER THAN 3H:1V OR WHERE NECESSARY TO AID IN ESTABLISHING VEGETATION.
2. APPLY FERTILIZER, LIME SEED PRIOR TO PLACING MATTING.
3. STAPLES ARE TO BE PLACED ALTERNATELY, IN COLUMNS APPROXIMATELY 2' APART AND IN ROWS APPROXIMATELY 3' APART. APPROXIMATELY 175 STAPLES ARE REQUIRED PER 4' X 225' ROLL OF MATERIAL AND 125 STAPLES ARE REQUIRED PER 4' X 150' ROLL OF MATERIAL.
4. DISTURBED AREAS SHALL BE SMOOTHLY GRADED. EROSION CONTROL MATERIAL SHALL BE PLACED LOOSELY OVER GROUND SURFACE. DO NOT STRETCH.
5. ALL TERMINAL ENDS AND TRANSVERSE LAPS SHALL BE STAPLED AT APPROXIMATELY 12" INTERVALS.

ROLLED EROSION
CONTROL PRODUCT
(RECP) SIDE SLOPE

REVISIONS	
APRIL 16, 2007	JMF
JANUARY 13, 2009	WHF

THIS WORK SHALL BE PERFORMED IN ACCORDANCE WITH SECTION 653 AND AS SHOWN IN THE PLANS FOR TEMPORARY EROSION MATTING (PAY ITEM 653.20) OR PERMANENT EROSION MATTING (PAY ITEM 653.21).

PLOT DATE: 12-SEP-2012
DRAWN BY: J. SALVATORI
CHECKED BY: W. LAMMER
SHEET 27 OF 36

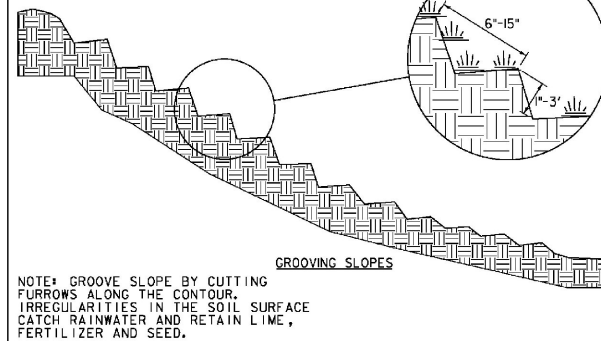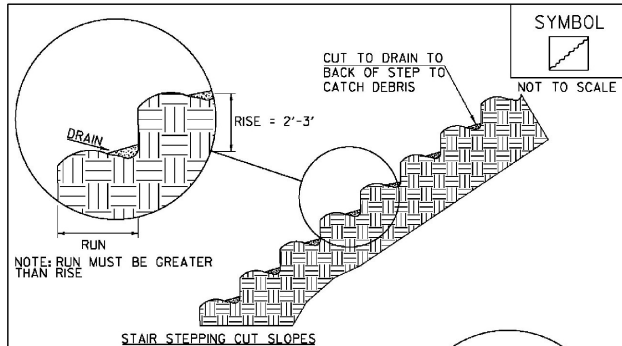


ADAPTED FROM DETAILS PROVIDED BY: NEW YORK STATE DEC
ORIGINALLY DEVELOPED BY: USDA-NRCS
VERMONT DEPARTMENT OF ENVIRONMENTAL CONSERVATION

SURFACE ROUGHENING

NOTES:
REFER TO "THE VERMONT STANDARDS & SPECIFICATIONS FOR
EROSION PREVENTION & SEDIMENT CONTROL -2006- "FROM
THE VT AGENCY OF NATURAL RESOURCES FOR ADDITIONAL
GUIDANCE.

THIS WORK SHALL BE CONSIDERED INCIDENTAL TO THE
CONTRACT

REVISIONS
APRIL 1, 2008 WHF
JANUARY 13, 2009 WHF

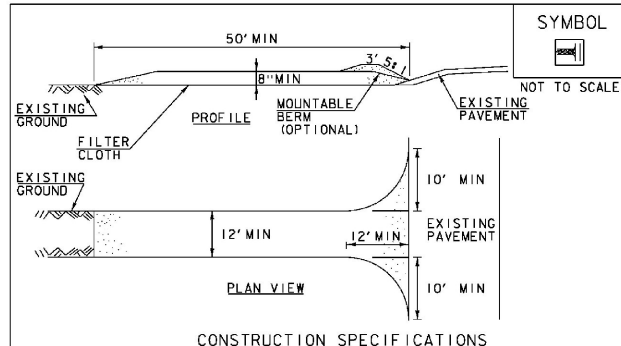

CONSTRUCTION SPECIFICATIONS

1. STONE SIZE- USE 1-4" STONE, RECLAIMED OR RECYCLED CONCRETE EQUIVALENT.
2. LENGTH- NOT LESS THAN 50' (EXCEPT ON A SINGLE RESIDENCE LOT WHERE A 30' MINIMUM LENGTH APPLIES).
3. THICKNESS- NOT LESS THAN 8".
4. WIDTH- 12' MINIMUM, BUT NOT LESS THAN THE FULL WIDTH AT POINTS WHERE INGRESS OR EGRESS OCCURS. 24" IF SINGLE ENTRANCE TO SITE.
5. GEOTEXTILE MUST BE PLACED OVER THE ENTIRE AREA PRIOR TO PLACING STONE.
6. SURFACE WATER- ALL SURFACE WATER FLOWING OR DIVERTED TOWARD CONSTRUCTION ENTRANCES SHALL BE PIPED BENEATH THE ENTRANCE. IF PIPING IS IMPRACTICAL, A MOUNTABLE BERM WITH 5:1 SLOPES WILL BE PERMITTED.
7. MAINTENANCE- THE ENTRANCE SHALL BE MAINTAINED IN A CONDITION WHICH WILL PREVENT TRACKING OR FLOWING OF SEDIMENT ONTO PUBLIC RIGHTS-OF-WAY, ALL SEDIMENT SPILLED, DROPPED, WASHED OR TRACKED ONTO PUBLIC RIGHTS-OF-WAY MUST BE REMOVED IMMEDIATELY.
8. WHEN WASHING IS REQUIRED, IT SHALL BE DONE ON AN AREA STABILIZED WITH STONE AND WHICH DRAINS INTO AN APPROVED SEDIMENT TRAPPING DEVICE.
9. PERIODIC INSPECTION AND NEEDED MAINTENANCE SHALL BE PROVIDED ACCORDING TO PERMIT REQUIREMENTS.

ADAPTED FROM DETAILS PROVIDED BY: NEW YORK STATE DEC
ORIGINALLY DEVELOPED BY: USDA-NRCS
VERMONT DEPARTMENT OF ENVIRONMENTAL CONSERVATION

STABILIZED CONSTRUCTION ENTRANCE

NOTES:
REFER TO "THE VERMONT STANDARDS & SPECIFICATIONS FOR
EROSION PREVENTION & SEDIMENT CONTROL -2006- "FROM
THE VT AGENCY OF NATURAL RESOURCES FOR ADDITIONAL
GUIDANCE.

THIS WORK SHALL BE PERFORMED IN ACCORDANCE WITH
SECTION 653 FOR VEHICLE TRACKING PAD (PAY ITEM 653.35)
OR AS SPECIFIED IN THE CONTRACT.

REVISIONS
MARCH 24, 2008 WHF
JANUARY 13, 2009 WHF

VAOT RURAL AREA MIX					
% WEIGHT	BROADCAST	HYDROSEED	NAME	GERM %	PURITY %
37.5%	22.5	45	CREEPING RED FESCUE	85%	98%
37.5%	22.5	45	TALL FESCUE	90%	95%
5.0%	3	6	RED TOP	90%	95%
15.0%	9	18	BIRDSFOOT TREFOIL	85%	98%
5.0%	3	6	ANNUAL RYE GRASS	85%	95%
100%	60	120			

VAOT URBAN AREA MIX					
% WEIGHT	BROADCAST	HYDROSEED	NAME	GERM %	PURITY %
42.5%	34	68	CREEPING RED FESCUE	85%	98%
10.0%	8	16	PERENNIAL RYE GRASS	90%	95%
42.5%	34	68	KENTUCKY BLUE GRASS	85%	85%
5.0%	4	8	ANNUAL RYE GRASS	85%	95%
100%	80	160			

SOIL AMENDMENT GUIDANCE			
FERTILIZER		LIME	
BROADCAST	HYDROSEED	BROADCAST	HYDROSEED
10-20-10	FOLLOW	PELLETIZED	FOLLOW
500 LBS/AC	MANUFACTURER	2 TONS/AC	MANUFACTURER

CONSTRUCTION GUIDANCE

1. RURAL SEED MIX: USE AS INDICATED IN THE PLANS AND/OR FOR ALL ESTABLISHED UPLAND (NON WETLAND) AREAS DISTURBED BY THE CONTRACTOR.
2. URBAN SEED MIX: USE AS INDICATED IN THE PLANS AND/OR FOR ALL ESTABLISHED LAWN AREAS DISTURBED BY THE CONTRACTOR.
3. ALL SEED MIXTURES: SHALL NOT HAVE A WEED CONTENT EXCEEDING 0.40% BY WEIGHT AND SHALL BE FREE OF ALL NOXIOUS SEED.
4. FERTILIZER AND LIMESTONE: SHALL FOLLOW RATES SHOWN ON PLAN OR AS DIRECTED BY THE ENGINEER.
5. HAY MULCH: TO BE PLACED ON EARTH SLOPES AT THE RATE OF 2 TONS/ACRE, ACHIEVE 90% GROUND COVER OR AS DIRECTED BY THE ENGINEER.
6. TOPSOIL: TO BE USED WITH SEED AS INDICATED ON THE PLANS, OR AS DIRECTED BY THE ENGINEER.
7. HYDROSEEDING: ALTHOUGH GUIDANCE IS GIVEN ABOVE THE SITE CONDITIONS AND THE TYPE OF HYDROSEED WILL ULTIMATELY DICTATE THE AMOUNTS AND TYPES OF SOIL AMENDMENTS TO BE APPLIED.
8. TURF ESTABLISHMENT: PLACING SEED, FERTILIZER, LIME AND MULCH PRIOR TO SEPTEMBER 15 AND AFTER APRIL 15 CAN BETTER ENSURE A VIGOROUS GROWTH OF GRASS.

ADAPTED FROM VTRANS TECHNICAL LANDSCAPE MANUAL FOR
ROADWAYS AND TRANSPORTATION FACILITIES





TURF ESTABLISHMENT

REVISIONS
JUNE 23, 2009 WHF
JANUARY 15, 2010 WHF
FEBRUARY 16, 2011 WHF

PROJECT NAME: BRIGHTON
PROJECT NUMBER: ER STP 034-3(25)


FILE NAME: slb208epsc.def.dgn
PROJECT LEADER: K. HIGGINS
DESIGNED BY: J. SALVATORI
EPSC DETAILS SHEET 2

PLOT DATE: 12-SEP-2012
DRAWN BY: J. SALVATORI
CHECKED BY: W. LAMMER
SHEET 28 OF 36

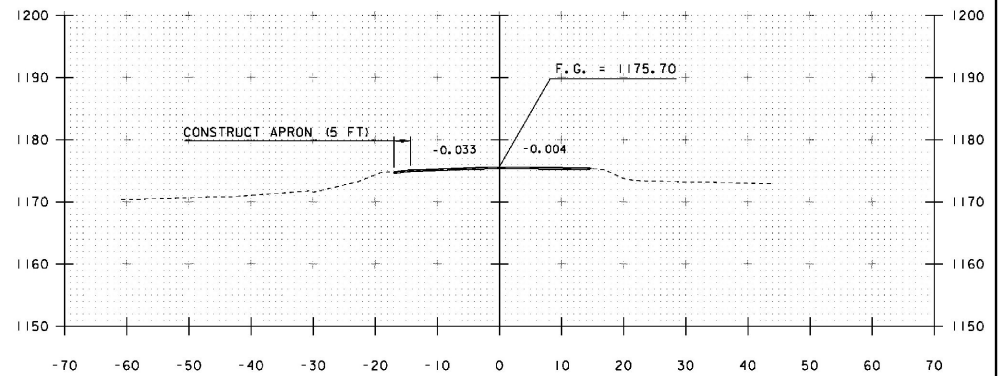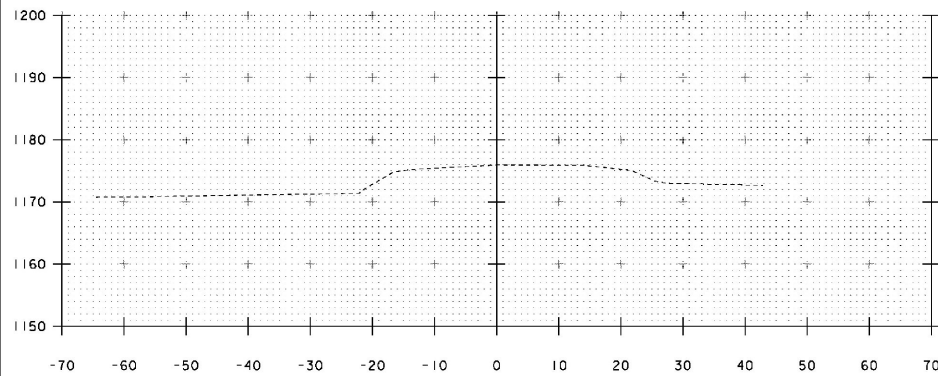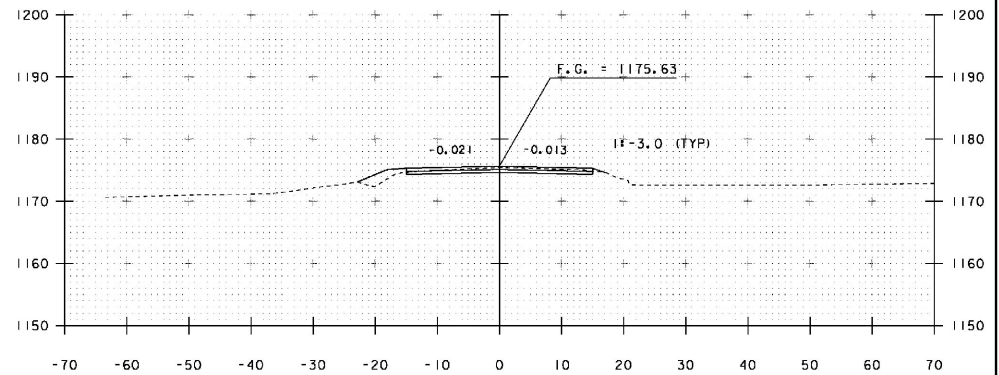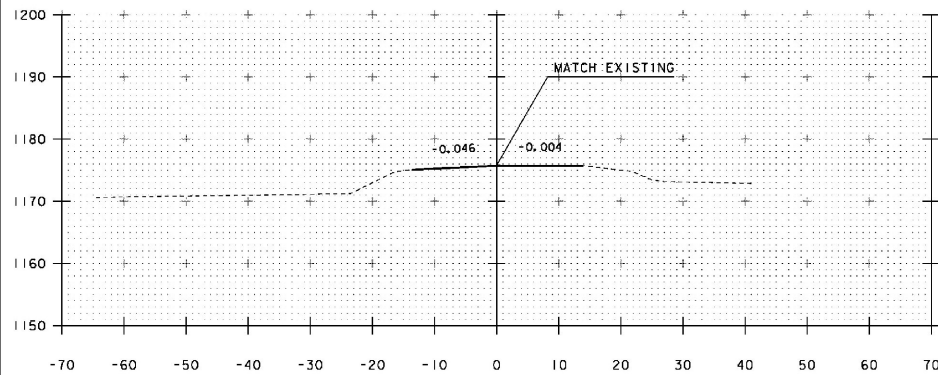


STA. 53+75 TO STA. 54+50


PROJECT NAME:	BRIGHTON	FILE NAME:	slb208xs.dgn	PLOT DATE:	12-SEP-2012
PROJECT NUMBER:	ER STP 034-3(25)	PROJECT LEADER:	K. HIGGINS	DRAWN BY:	J. SALVATORI
		DESIGNED BY:	J. SALVATORI	CHECKED BY:	W. LAMMER
		MAINLINE SECTIONS		SHEET	29 OF 36

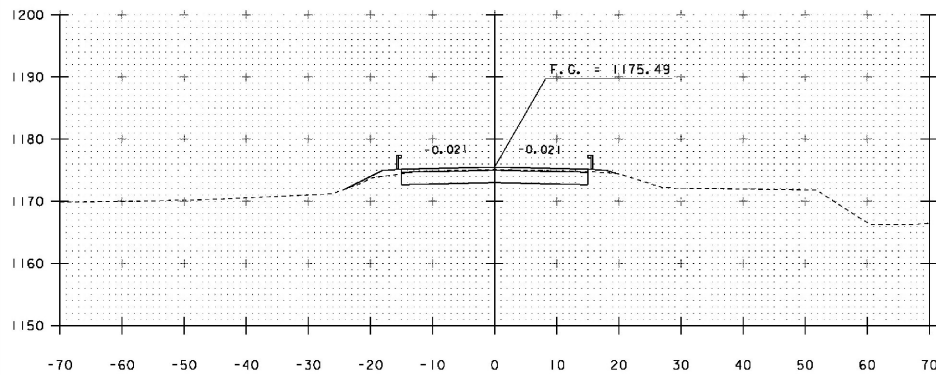


55+00
BEGIN PROJECT
END APPROACH

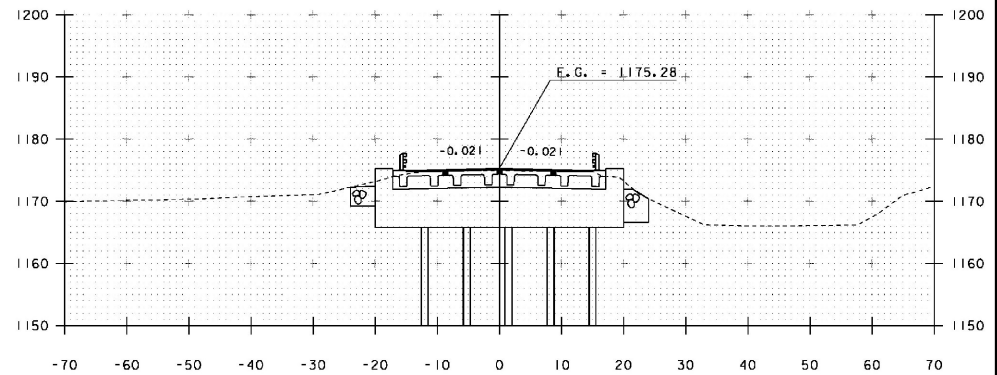

55+50
BEGIN BRIDGE STA 55+48.67

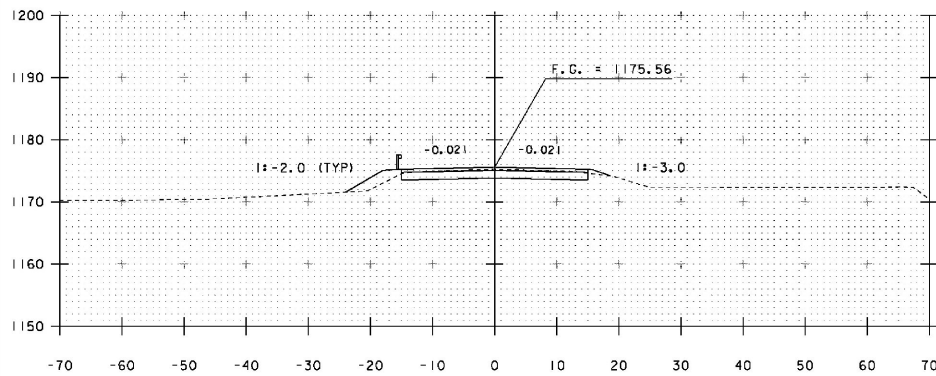


54+75

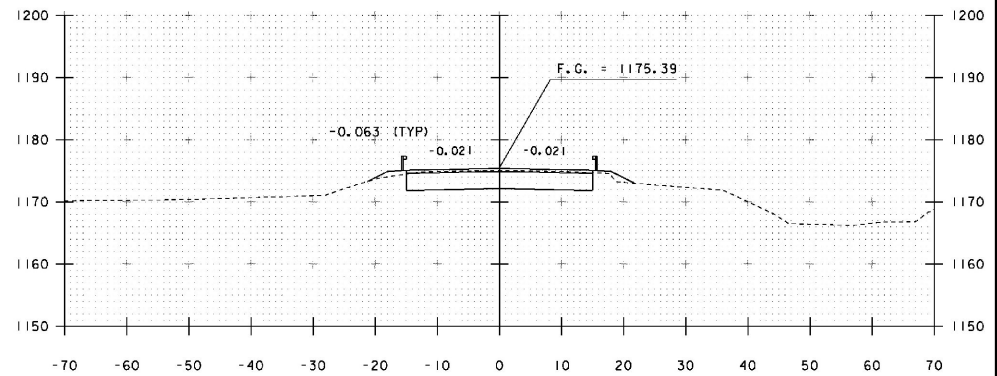


55+25

STA. 54+75 TO STA. 55+50


PROJECT NAME:	BRIGHTON	PLOT DATE:	12-SEP-2012
PROJECT NUMBER:	ER STP 034-3(25)	DRAWN BY:	J. SALVATORI
FILE NAME:	sib208xs.dgn	DESIGNED BY:	J. SALVATORI
PROJECT LEADER:	K. HIGGINS	CHECKED BY:	W. LAMMER
MAINLINE SECTIONS			SHEET 30 OF 36

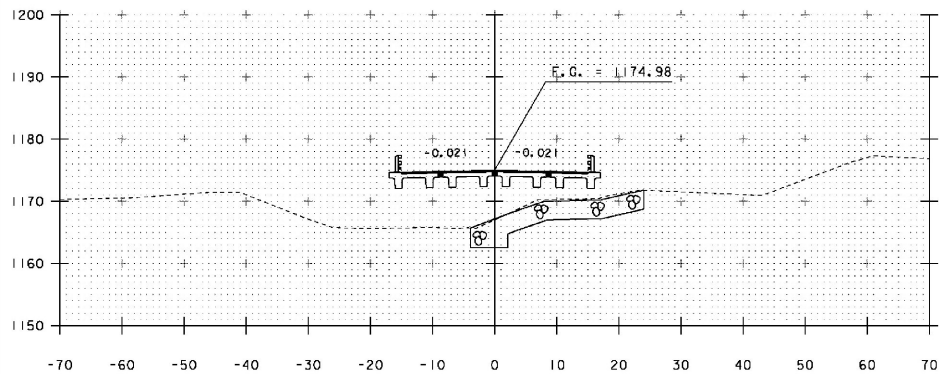


56+00

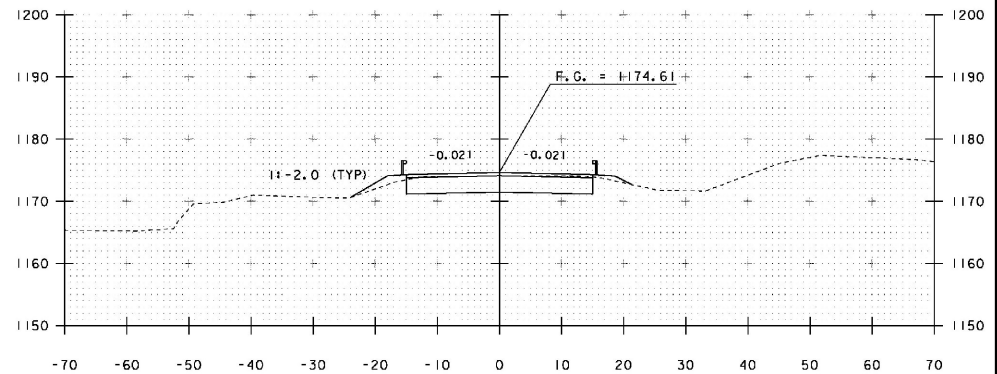

56+50

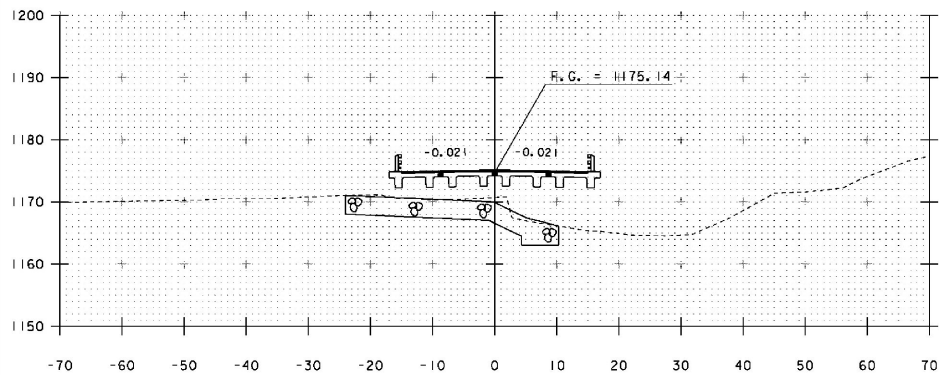

55+75

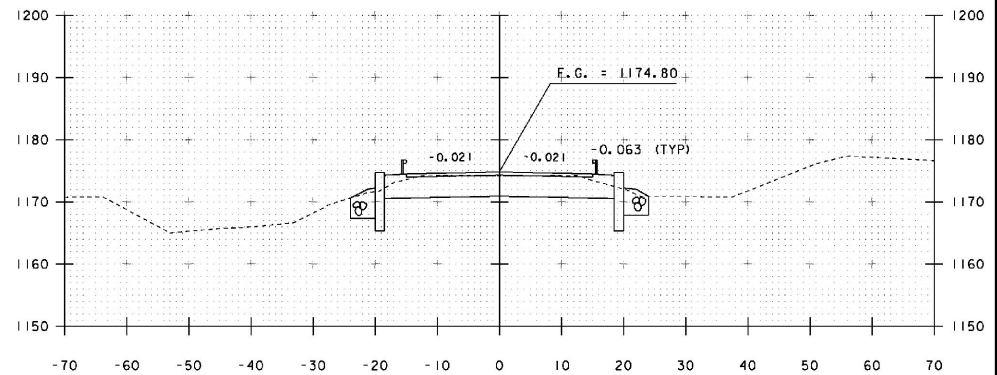


56+25


END BRIDGE STA 56+21.33

STA. 55+75 TO STA. 56+50


PROJECT NAME:	BRIGHTON	FILE NAME:	slb208xs.dgn	PLOT DATE:	12-SEP-2012
PROJECT NUMBER:	ER STP 034-3(25)	PROJECT LEADER:	K. HIGGINS	DRAWN BY:	J. SALVATORI
		DESIGNED BY:	J. SALVATORI	CHECKED BY:	W. LAMMER
		MAINLINE SECTIONS		SHEET	31 OF 36

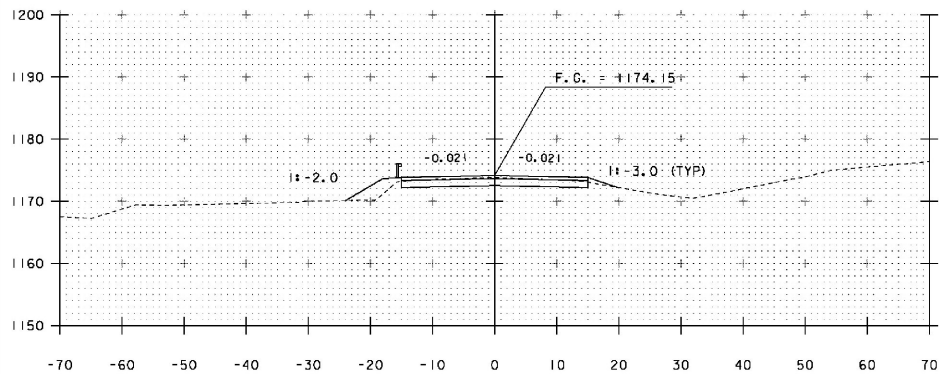

57+00

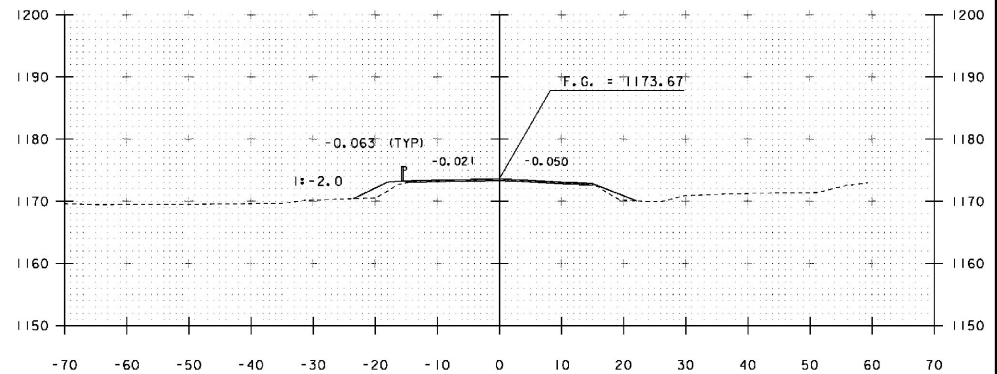


57+50

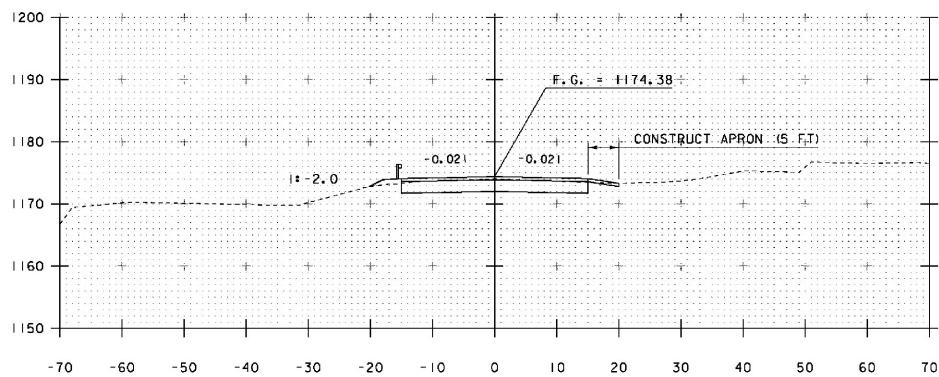

56+75



END PROJECT 56+70
BEGIN APPROACH

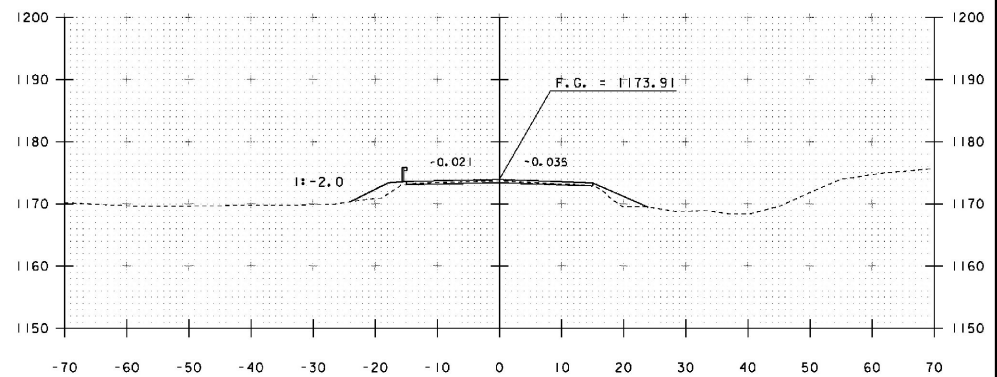

57+25

STA. 56+75 TO STA. 57+50


PROJECT NAME: BRIGHTON	
PROJECT NUMBER: ER STP 034-3(25)	
FILE NAME: s11b208xs.dgn	PLOT DATE: 12-SEP-2012
PROJECT LEADER: K. HIGGINS	DRAWN BY: J. SALVATORI
DESIGNED BY: J. SALVATORI	CHECKED BY: W. LAMMER
MAINLINE SECTIONS	SHEET 32 OF 36

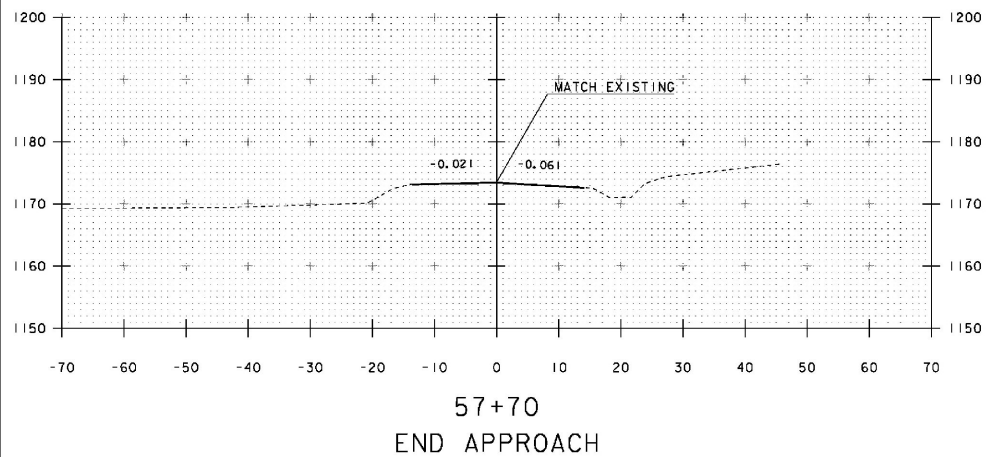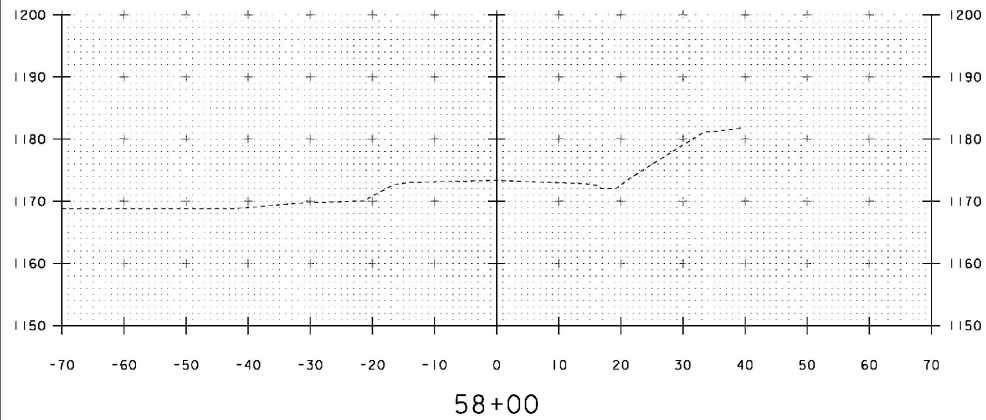

STA. 57+75 TO STA. 58+00


PROJECT NAME:	BRIGHTON	FILE NAME:	slb208xs.dgn	PLOT DATE:	12-SEP-2012
PROJECT NUMBER:	ER STP 034-3(25)	PROJECT LEADER:	K. HIGGINS	DRAWN BY:	J. SALVATORI
		DESIGNED BY:	J. SALVATORI	CHECKED BY:	W. LAMMER
		MAINLINE SECTIONS		SHEET	33 OF 36

STA 10+56 LT
 BEGIN CHANNEL EXCAVATION
 BEGIN GEOTEXTILE FABRIC UNDER STONE FILL
 BEGIN STONE FILL, TYPE III
 BEGIN GRUBBING MATERIAL

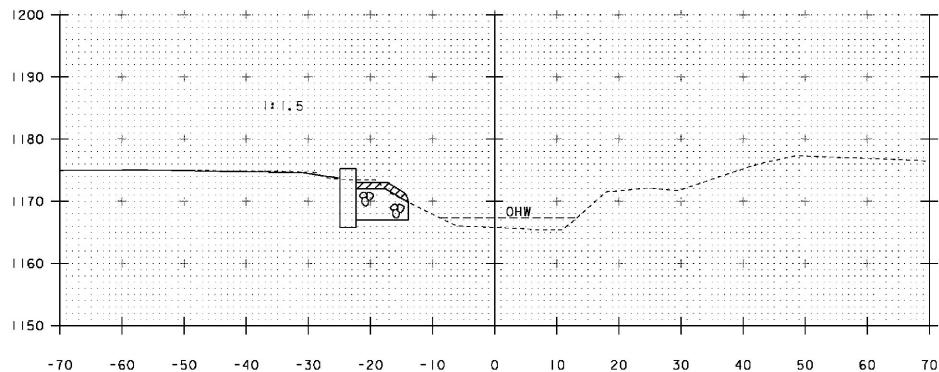


10+60

STA 10+81 RT
 BEGIN CHANNEL EXCAVATION
 BEGIN GEOTEXTILE FABRIC UNDER STONE FILL
 BEGIN STONE FILL, TYPE III
 BEGIN GRUBBING MATERIAL

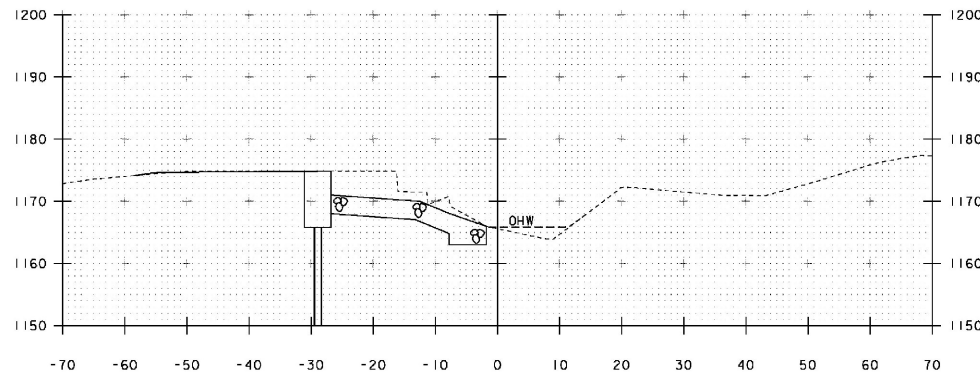


10+80

STA 10+74 LT
 END GRUBBING MATERIAL

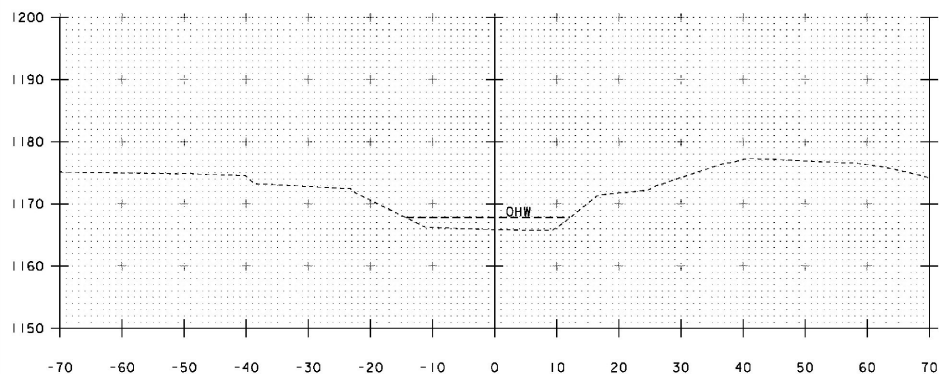

10+50

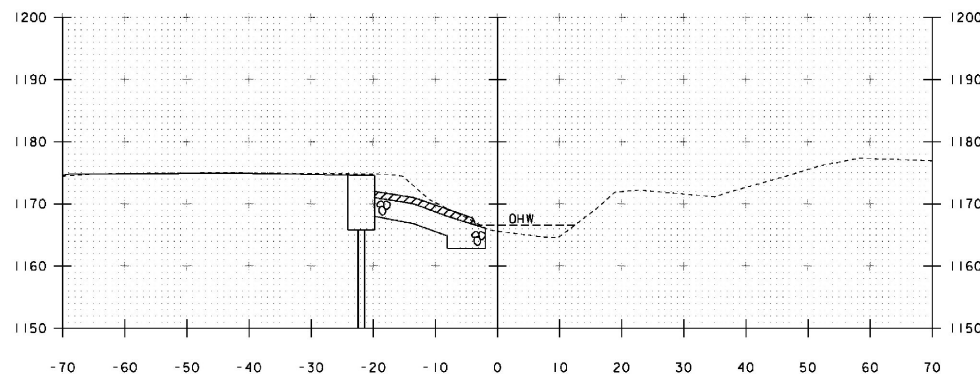


10+70

STA. 10+50 TO STA. 10+80


PROJECT NAME: BRIGHTON
 PROJECT NUMBER: ER STP 034-3(25)

FILE NAME: s11b208xs.dgn
 PROJECT LEADER: K. HIGGINS
 DESIGNED BY: J. SALVATORI
 CHANNEL SECTIONS


PLOT DATE: 12-SEP-2012
 DRAWN BY: J. SALVATORI
 CHECKED BY: W. LAMMER
 SHEET 34 OF 36

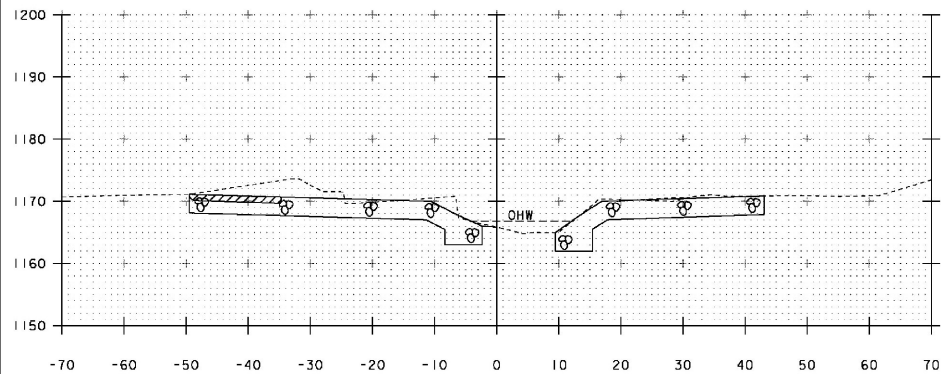


11+00

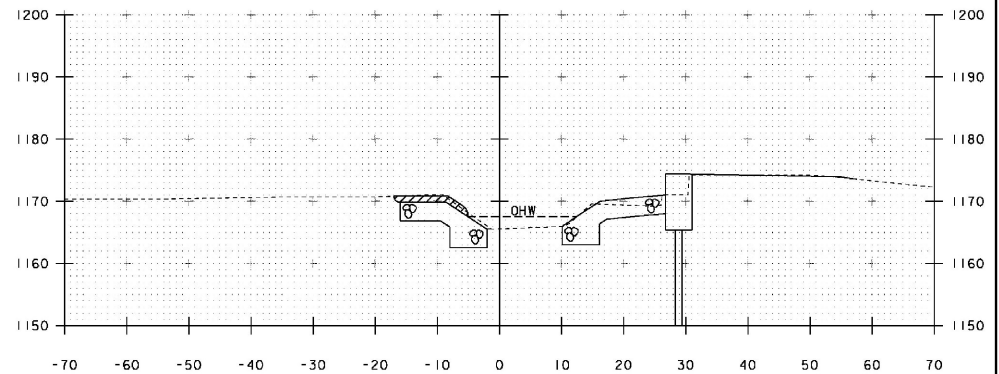

11+20

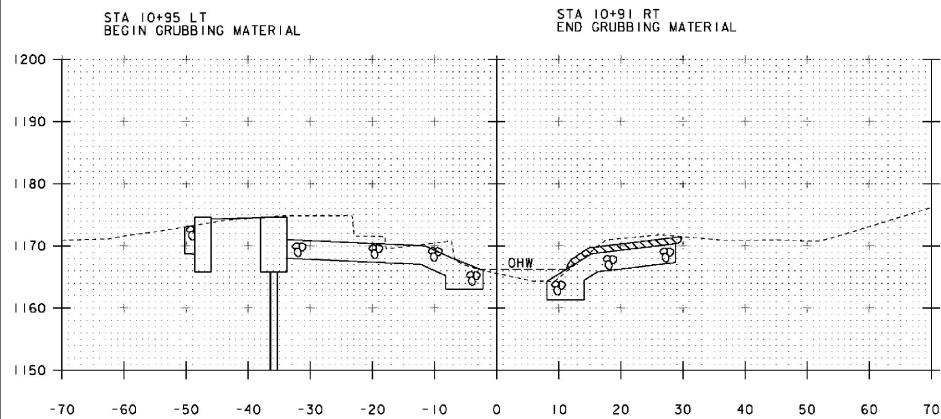

10+90

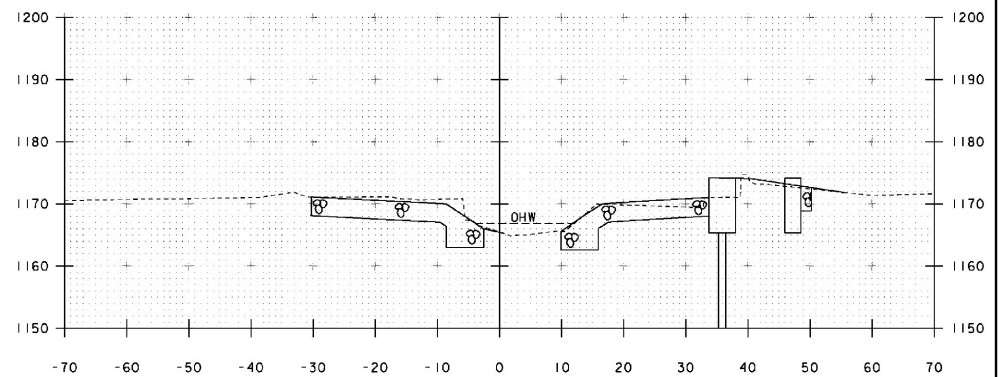


11+10

STA. 10+90 TO STA. 11+20

PROJECT NAME:	BRIGHTON	FILE NAME:	slb208xs.dgn	PLOT DATE:	13-SEP-2012
PROJECT NUMBER:	ER STP 034-3(25)	PROJECT LEADER:	K. HIGGINS	DRAWN BY:	J. SALVATORI
		DESIGNED BY:	J. SALVATORI	CHECKED BY:	W. LAMMER
		CHANNEL SECTIONS			SHEET 35 OF 36


STA 11+44 RT
 END CHANNEL EXCAVATION
 END GEOTEXTILE FABRIC UNDER STONE FILL
 END STONE FILL, TYPE III
 END GRUBBING MATERIAL

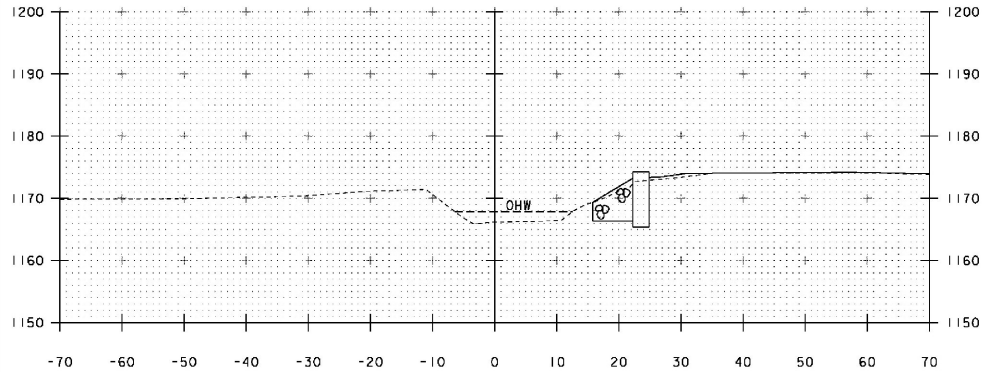


11+40

STA 11+27 LT
 END CHANNEL EXCAVATION
 END GEOTEXTILE FABRIC UNDER STONE FILL
 END STONE FILL, TYPE III
 END GRUBBING MATERIAL

STA 11+28 RT
 BEGIN GRUBBING MATERIAL

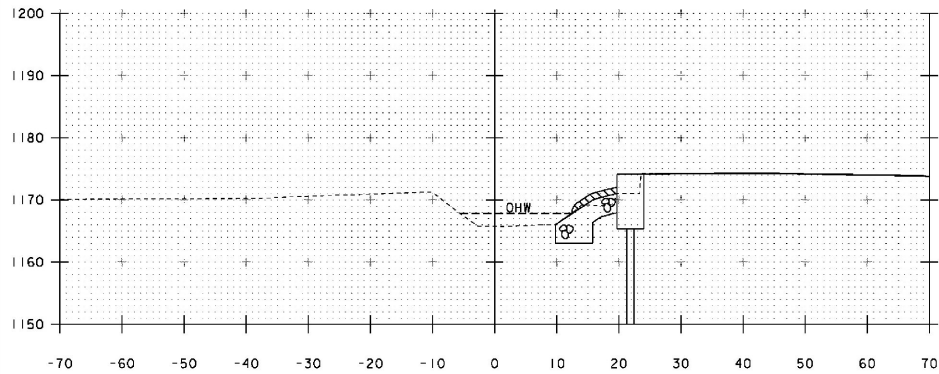

11+30

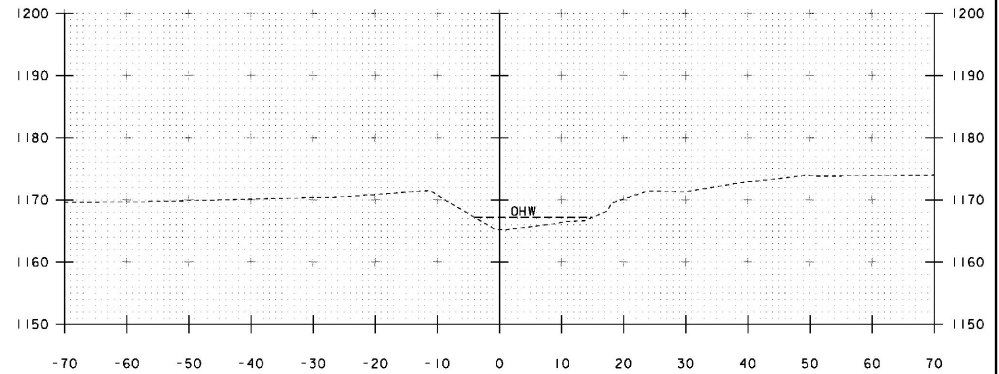

11+50

STA. 11+30 TO STA. 11+50

PROJECT NAME: BRIGHTON	
PROJECT NUMBER: ER STP 034-3(25)	
FILE NAME: s11b208xs.dgn	PLOT DATE: 12-SEP-2012
PROJECT LEADER: K. HIGGINS	DRAWN BY: J. SALVATORI
DESIGNED BY: J. SALVATORI	CHECKED BY: W. LAMMER
CHANNEL SECTIONS	SHEET 36 OF 36

WELDING PROCEDURE SPECIFICATION

Material Specification	A500 GR B		
Welding Process	FCAW		
Manual or Machine	SEMAUTOMATIC		
Position of Welding	FLAT		
Filler Metal Specification	A5.20 - 95		
Filler Metal Classification	E71T-1H8 E71T-9H8 LINCOLN ULTRACORE		
Flux	N/A		
Shielding Gas	CO 2	Dew Point	-40DEG F Flow Rate 50CFH
Single or Multiple Pass	SINGLE		
Single or Multiple Arc	SINGLE		
Welding Current	DC		
Polarity	REVERSE ELECTRODE POSITIVE		
Welding Progression	STRINGER		
Root Treatment	CLEAN AS PER SECTION 603 OF THE NYSSCM		
Preheat and Interpass Temperature	PREHEAT AS PER TABLE 708 OF THE NYSSCM		
Postheat Temperature	NONE		
Heat Input	Min		Max

WELDING PROCEDURE

Pass no.	Electrode size	Welding Current		Travel speed	Joint detail
		Amperes	Volts		
1	1/16	300	26	14	
Variable	LIMITS	270	24	12.6	
		TO	TO	TO	
		330	28	15.4	

Vermont Agency of Transportation
 RECEIVED
 CK'D BY RMK OK'D BY JWC
January 4th, 2013
 RESUBMIT X
 BY KMH DATE 1-8-13


This procedure may vary due to fabrication sequence, fit-up, pass size, etc., within the limitation of variables given in Section 5.

Procedure No. <u>3007</u>	Contractor <u>Elderlee, Inc.</u>
Revision No. _____	Authorized By <u>RANDY SCOTT</u>
	Date <u>3/23/2011</u>

WELDING PROCEDURE SPECIFICATION

Material Specification	A572 GRD. 50 /A992-06a		
Welding Process	FCAW		
Manual or Machine	SEMAUTOMATIC		
Position of Welding	FLAT		
Filler Metal Specification	A5.20		
Filler Metal Classification	E70 LINCOLN OUTERSHEILD		
Flux	N/A		
Shielding Gas	CO 2	Dew Point	-40DEG F Flow Rate 50 CFM
Single or Multiple Pass	SINGLE		(45 TO 63 CFM)
Single or Multiple Arc	N/A		
Welding Current	DC		
Polarity	DCEP		
Welding Progression	STRINGER		
Root Treatment	CLEAN AS PER SECTION 603 OF THE NYSSCM		
Preheat and Interpass Temperature	PREHEAT AS PER TABLE 708 OF THE NYSSCM		
Postheat Temperature	NONE		
Heat Input	Min		Max

WELDING PROCEDURE.

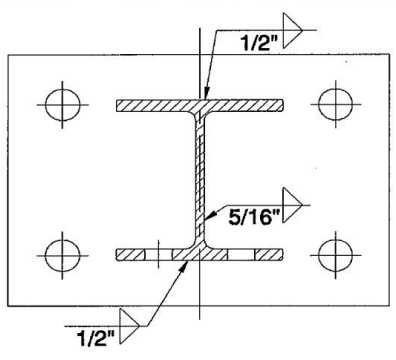Pass no.	Electrode size	Welding Current		Travel speed	Joint detail
		Amperes	Volts		
1	3/32	390	27	12	
Variable	LIMITS	351 TO 429	25 TO 29	11 TO 13	

Vermont Agency of Transportation

RECEIVED

CK'D BY RMK OK'D BY JWC

January 4th, 2013

RESUBMIT X
BY KMH DATE 1-8-13

This procedure may vary due to fabrication sequence, fit-up, pass size, etc., within the limitation of variables given in Section 5.

Procedure No. 3008
Revision No. _____

Contractor Elderlee, Inc.
Authorized By RANDY SCOTT
Date 10/18/2011

WELDING PROCEDURE SPECIFICATION

Material Specification A709 TO A500 GR B
Welding Process FCAW
Manual or Machine SEMAUTOMATIC
Position of Welding FLAT
Filler Metal Specification A5.20 - 95
Filler Metal Classification E71T-1H8 E71T-9H8 LINCOLN ULTRACORE
Flux N/A
Shielding Gas CO 2 Dew Point -40DEG F Flow Rate 50CFH
Single or Multiple Pass SINGLE
Single or Multiple Arc SINGLE
Welding Current DC
Polarity REVERSE ELECTRODE POSITIVE
Welding Progression STRINGER
Root Treatment CLEAN AS PER SECTION 603 OF THE NYSSCM
Preheat and Interpass Temperature PREHEAT AS PER TABLE 708 OF THE NYSSCM
Postheat Temperature NONE
Heat Input Min _____ Max _____

WELDING PROCEDURE

Pass no.	Electrode size	Welding Current		Travel speed	Joint detail
		Amperes	Volts		
1	1/16	300	26	14	
Variable	LIMITS	270 TO 330	24 TO 28	12.6 TO 15.4	
Vermont Agency of Transportation RECEIVED CK'D BY <u>RMK</u> OK'D BY <u>JWC</u> January 4th, 2013 RESUBMIT <u>X</u> BY <u>KMH</u> DATE <u>1-8-13</u>					

This procedure may vary due to fabrication sequence, fit-up, pass size, etc., within the limitation of variables given in Section 5.

Procedure No. 3009 Contractor Elderlee, Inc.
Revision No. _____ Authorized By RANDY SCOTT
Date 10/18/2011

WELDING PROCEDURE SPECIFICATION

Material Specification ASTM-A36 A709 GR 36 CVN
Welding Process FCAW
Manual or Machine SEMAUTOMATIC
Position of Welding FLAT
Filler Metal Specification A5.20- 95
Filler Metal Classification E71T-1H8 E71T-9H8 LINCOLN ULTRACORE
Flux N/A
Shielding Gas CO 2 Dew Point -40DEG F Flow Rate 50CFH
Single or Multiple Pass SINGLE
Single or Multiple Arc SINGLE
Welding Current DC
Polarity REVERSE
Welding Progression STRINGER
Root Treatment PER D1.5
Preheat and Interpass Temperature PER D1.5
Postheat Temperature NONE
Heat Input Min _____ Max _____

WELDING PROCEDURE

Pass no.	Electrode size	Welding Current		Travel speed	Joint detail
		Amperes	Volts		
1	1/16	300	26	14	
Variable	LIMITS	270	24	12.6	
		TO 330	TO 28	TO 15.4	

Vermont Agency of Transportation
RECEIVED
CK'D BY RMK OK'D BY JWC
January 4th, 2013
RESUBMIT X APPROVED BY
BY KMH DATE 1-8-13


This procedure may vary due to fabrication sequence, fit-up, pass size, etc., within the limitation of variables given in Section 5.

Procedure No. 3016 Contractor Elderlee, Inc.
Revision No. _____ Authorized By RANDY SCOTT
Date 1/3/2013

WELDING PROCEDURE SPECIFICATION

Material Specification	ASTM A572 GR. 50 CVN	A500 GR B
Welding Process	FCAW	
Manual or Machine	SEMAUTOMATIC	
Position of Welding	FLAT	
Filler Metal Specification	A5.20 - 95	
Filler Metal Classification	E71T-1H8 E71T-9H8 LINCOLN ULTRACORE	
Flux	N/A	
Shielding Gas	CO 2	Dew Point -40DEG F Flow Rate
Single or Multiple Pass	SINGLE	
Single or Multiple Arc	SINGLE	
Welding Current	DC	
Polarity	REVERSE ELECTRODE POSITIVE	
Welding Progression	STRINGER	
Root Treatment	PER D1.5	
Preheat and Interpass Temperature	PER D1.5	
Postheat Temperature	NONE	
Heat Input	Min	Max

WELDING PROCEDURE

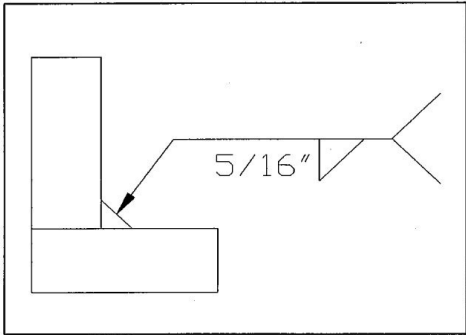Pass no.	Electrode size	Welding Current		Travel speed	Joint detail
		Amperes	Volts		
1	1/16	300	26	14	
Variable	LIMITS	270	24	12.6	
		TO	TO	TO	
		330	28	15.4	

RECEIVED

CK'D BY RMK OK'D BY JWC

January 4th, 2013

RESUBMIT X APPROVED

BY KMH DATE 1-8-13

This procedure may vary due to fabrication sequence, fit-up, pass size, etc., within the limitation of variables given in Section 5.

Procedure No. <u>3037</u>	Contractor <u>Elderlee, Inc.</u>
Revision No. _____	Authorized By <u>RANDY SCOTT</u>
	Date <u>12/20/2011</u>

WELDING PROCEDURE SPECIFICATION

Material Specification	A36		
Welding Process	GMAW		
Manual or Machine	SEMAUTOMATIC		
Position of Welding	FLAT		
Filler Metal Specification	A5.18		
Filler Metal Classification	L-50 .052 LINCOLN		
Flux	N/A		
Shielding Gas	90% ARGON /10% CO2	Dew Point	-40DEG F Flow Rate 50 CFM
Single or Multiple Pass	SINGLE		
Single or Multiple Arc	SINGLE		
Welding Current	DC		
Polarity	REVERSE		
Welding Progression	STRINGER		
Root Treatment	PER D1.5		
Preheat and Interpass Temperature	PER D1.5		
Postheat Temperature	NONE		
Heat Input	Min		Max

WELDING PROCEDURE

Pass no.	Electrode size	Welding Current		Travel speed	Joint detail
		Amperes	Volts		
	.052	430	32	13	
Variable	LIMITS	387	29	12	
		TO	TO	TO	
		473	34	14	

Vermont Agency of Transportation

RECEIVED



CK'D BY RMK OK'D BY JWC

January 4th, 2013



RESUBMIT APPROVED X
BY KMH DATE 1-8-13

This procedure may vary due to fabrication sequence, fit-up, pass size, etc., within the limitation of variables given in Section 5.

Procedure No. <u>3040</u>	Contractor <u>Elderlee, Inc.</u>
Revision No. _____	Authorized By <u>RANDY SCOTT</u>
	Date <u>12/20/2011</u>

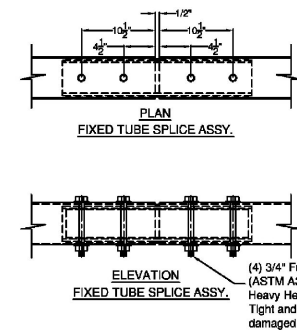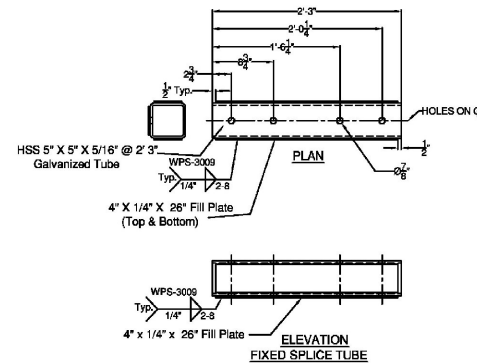

BRIDGE POST DETAIL

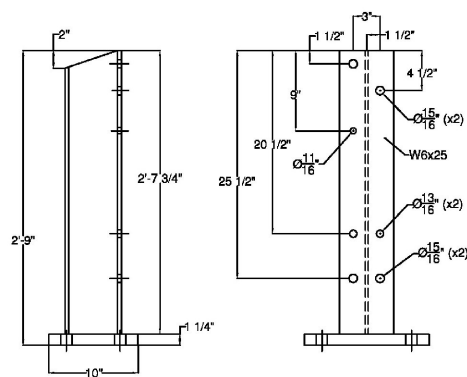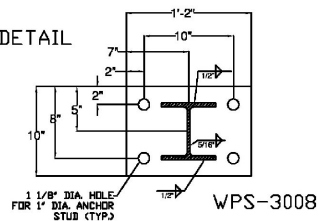

SHEET 2 OF 2

RECEIVED

February 14, 2013

F.R. LAFAYETTE, P.O. 27399


BRIDGE RAIL DETAILS SHEET

PROJECT: BRIGHTON, PROJECT # ER STP 034-3(25), MINOR ARTERIAL, BRIDGE # 84
TOWN OF BRIGHTON, ESSEX COUNTY, VT.

R	N.O.	DATE	DESCRIPTION	REVISION	EMAIL	R	N.O.	DATE	DESCRIPTION	REVISION	EMAIL
E	1	12/26/13	REVISED PER 12/26/12	12/26/12	EMAIL, E	R	3	1/29/13	DRAWN E.P. 1	1/29/13	EMAIL, E
V	2	1/9/13	REVISED PER 1/9/13	1/9/13	EMAIL, E	V					

	ELDERLEE, INC. OAKS CORNERS, NEW YORK 14578 E-Mail: elderlee@elderlee.com Tel: 515-788-8870, Fax: 515-788-8815	 CERTIFIED PROFESSIONAL
---	---	---

DRAWN	E.P.	12/03/12
CHECKED	D.L.	12/03/12
APPROVED		
SCALE	SCHEMATIC	
DRAWING NO. F.R. LAFAYETTE BRIGHTON		

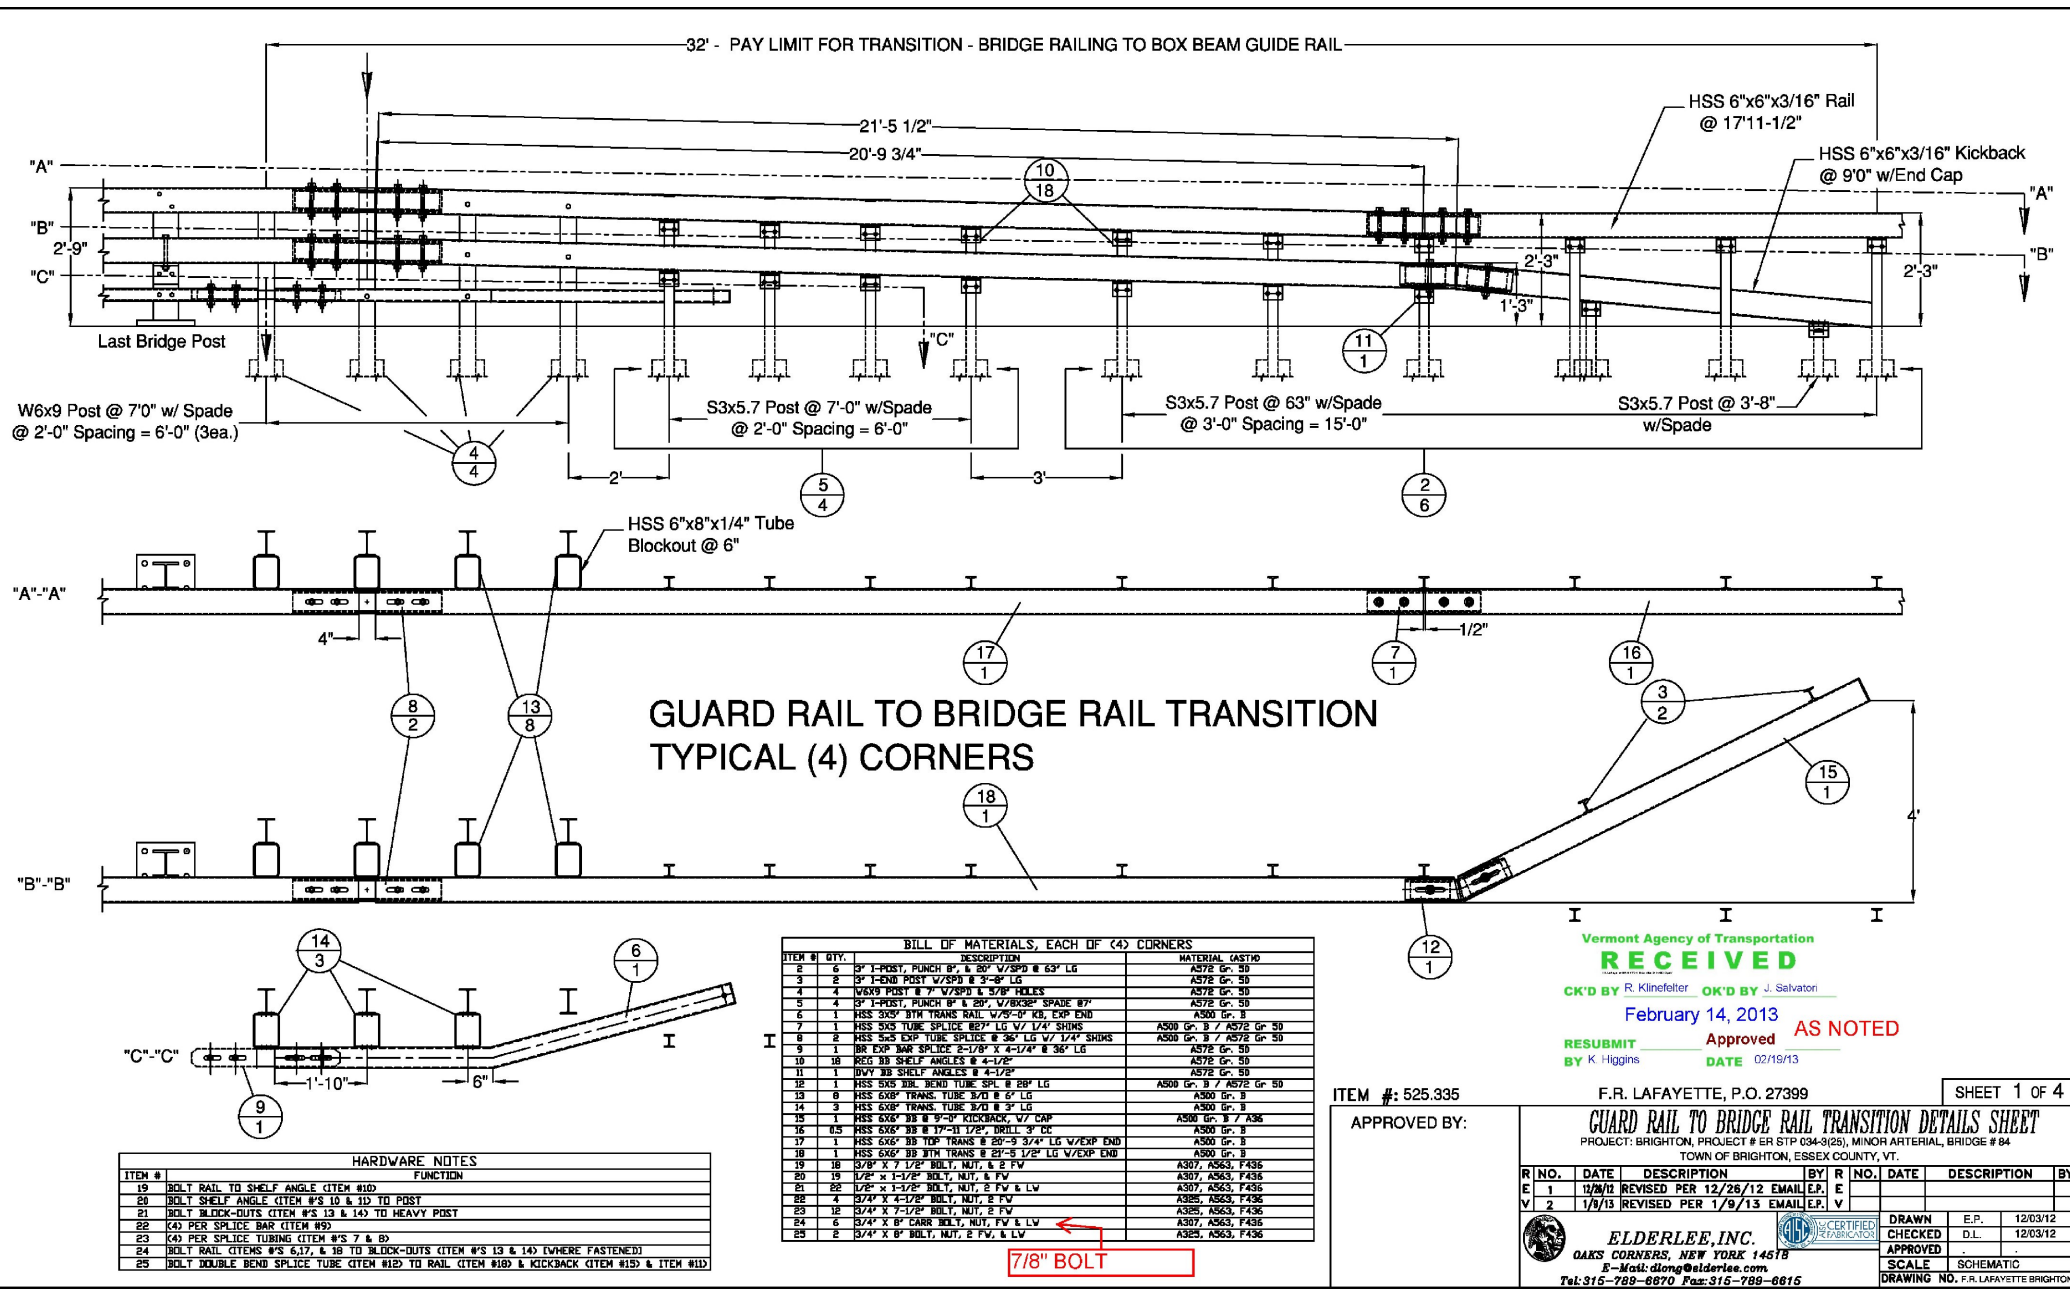

HARDWARE NOTES	
ITEM #	FUNCTION
19	BOLT RAIL TO SHELF ANGLE (ITEM #10)
20	BOLT SHELF ANGLE (ITEM #10 & 11) TO POST
21	BOLT BLOCK-OUTS (ITEM #13 & 14) TO HEAVY POST
22	C40 PER SPlice BAR (ITEM #9)
23	C40 PER SPlice TUBING (ITEM #13 & 14)
24	BOLT RAIL (ITEMS #13, 14 & 15) TO BLOCK-OUTS (ITEM #13 & 14) (WHERE FASTENED)
25	BOLT DOUBLE BEND SPlice TUBE (ITEM #12) TO RAIL (ITEM #10) & KICKBACK (ITEM #15) & ITEM #11

BILL OF MATERIALS, EACH OF (4) CORNERS		
ITEM #	QTY.	DESCRIPTION
1	6	3" I-POST, PUNCH B" & 20" V/SPD @ 63" LG
2	2	3" I-END POST W/SPD @ 3'-8" LG
4	4	W6x9 POST @ 7' V/SPD @ 3/8" HOLES
5	4	3" I-POST, PUNCH B" & 20" V/SPD @ 63" LG
6	1	HSS 3x5.7 BTH TRANS RAIL W/SPD @ 63" LG, EXP END
7	1	HSS 3x5.7 TUBE SPlice @ 63" LG W/ 1/4" SHIMS
8	2	HSS 3x5.7 TUBE SPlice @ 36" LG W/ 1/4" SHIMS
9	1	40" EXP BAR SPlice @ 2'-10" LG W/ 1/4" SHIMS
10	18	REG 3/8 SHELF ANGLES @ 4'-1/2"
11	1	DUVY 3/8 SHELF ANGLES @ 4'-1/2"
12	1	HSS 6x8 TRANS. TUBE @ 63" LG
13	6	HSS 6x8 TRANS. TUBE @ 63" LG
14	3	HSS 6x8 TRANS. TUBE @ 63" LG
15	1	HSS 6x8 @ 3'-8" KICKBACK, W/ CAP
16	0.5	HSS 6x8 @ 3'-8" KICKBACK, W/ CAP
17	1	HSS 6x8 @ 3'-8" KICKBACK, W/ CAP
18	1	HSS 6x8 @ 3'-8" KICKBACK, W/ CAP
19	18	3/8" X 7' 1/2" BOLT, NUT, & 2 F/W
20	18	1/2" X 1'-10" BOLT, NUT, & 2 F/W
21	22	1/2" X 1'-10" BOLT, NUT, & 2 F/W & LV
22	4	3/4" X 4'-1/2" BOLT, NUT, & 2 F/W
23	18	3/4" X 7'-1/2" BOLT, NUT, & 2 F/W
24	6	3/4" X 6" CARR BOLT, NUT, F/W & LV
25	2	3/4" X 6" BOLT, NUT, & 2 F/W & LV

7/8" BOLT

Vermont Agency of Transportation
RECEIVED
CK'D BY R. Klinefelter OK'D BY J. Salvario
February 14, 2013
RESUBMIT Approved AS NOTED
BY K Higgins DATE 02/19/13







ITEM #: 525.335
APPROVED BY:

F.R. LAFAYETTE, P.O. 27399
GUARD RAIL TO BRIDGE RAIL TRANSITION DETAILS SHEET
PROJECT: BRIGHTON, PROJECT # ER STP 034-3(25), MINOR ARTERIAL, BRIDGE # 84
TOWN OF BRIGHTON, ESSEX COUNTY, VT.

R. NO.	DATE	DESCRIPTION	BY	R. NO.	DATE	DESCRIPTION	BY
1	12/18/12	REVISED PER 12/28/12 EMAIL	E.P.	1	12/03/12		
2	1/9/13	REVISED PER 1/9/13 EMAIL	E.P.	2	12/03/12		

DRAWN	CHECKED	E.P.	12/03/12
APPROVED	D.L.		
SCALE			
DRAWING NO.			

ELDERLEE, INC.
OAKS CORNERS, NEW YORK 14618
E-Mail: dlong@elderlee.com
Tel: 315-789-8870 Fax: 315-789-8815

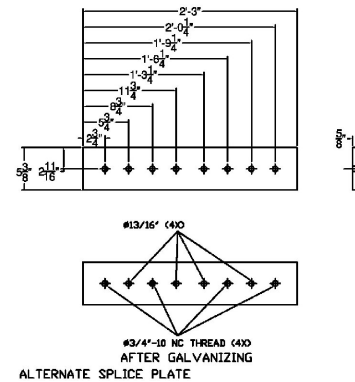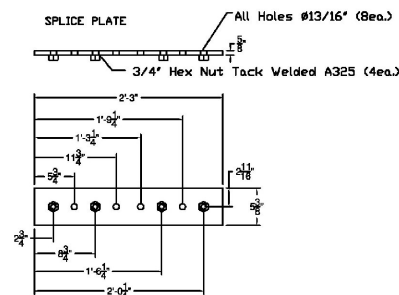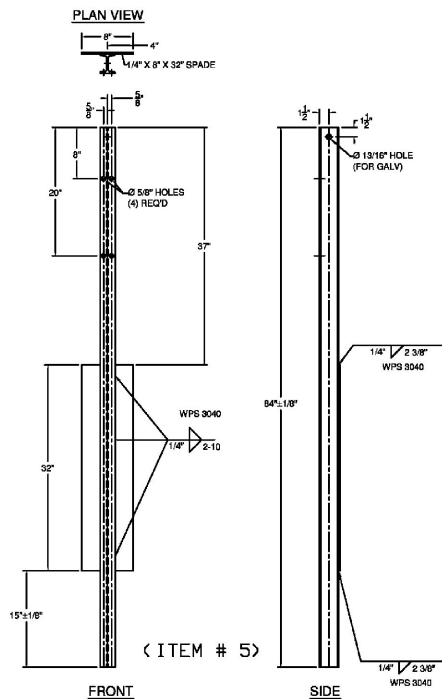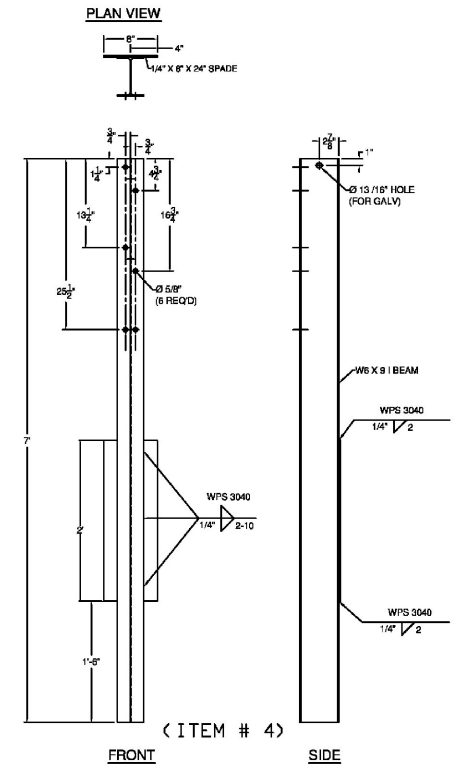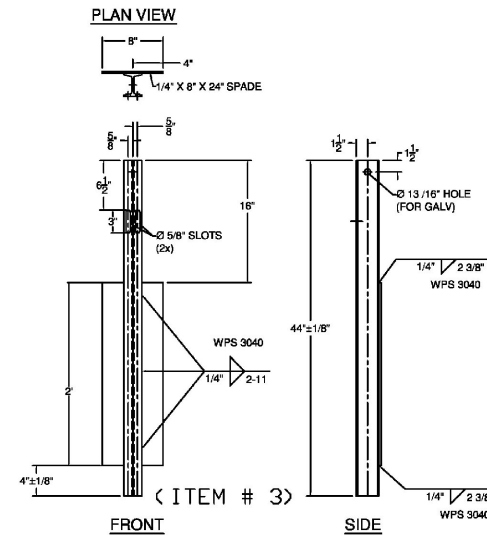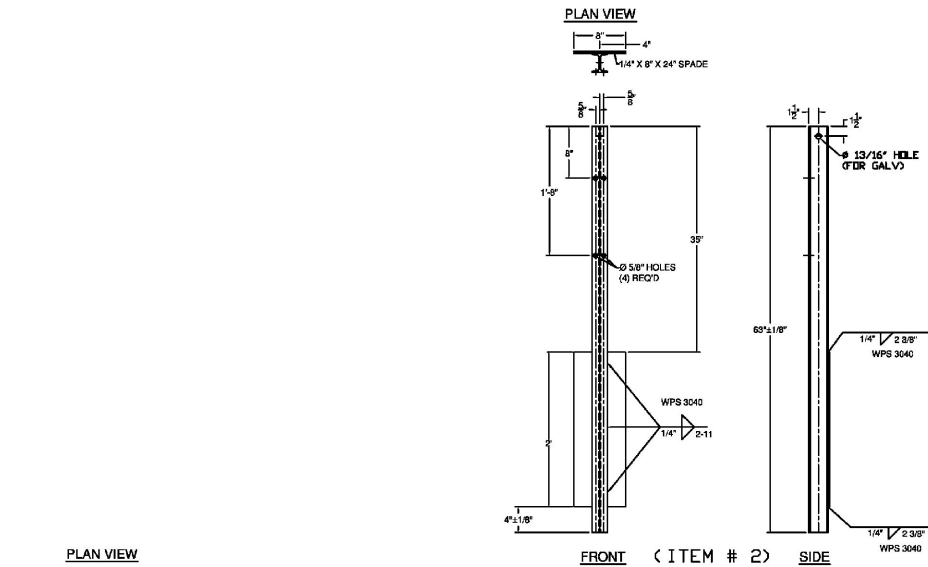

ITEM #: 525.335

F.R. LAFAYETTE, P.O. 27399

SHEET 2 OF 4

Vermont Agency of Transportation

RECEIVED

CK'D BY R. Klinefelter OK'D BY J. Salvatori







February 14, 2013

RESUBMIT Approved X
BY K. Higgins DATE 02/19/13

GUARD RAIL TO BRIDGE RAIL TRANSITION DETAILS SHEET
PROJECT: BRIGHTON, PROJECT # ER STP 034-3(25), MINOR ARTERIAL, BRIDGE # 84
TOWN OF BRIGHTON, ESSEX COUNTY, VT.

R NO.	DATE	DESCRIPTION	BY	R NO.	DATE	DESCRIPTION	BY
E 1	12/26/11	REVISED PER 12/26/12 EMAIL	E.P.				
V 2	1/9/13	REVISED PER 1/9/13 EMAIL	E.P.				

	ELDERLEE, INC. OAKS CORNERS, NEW YORK 14578 E-Mail: clong@elderlee.com Tel: 315-789-6870 Fax: 315-789-6815		DRAWN 12/03/12	E.P. 12/03/12
			CHECKED 12/03/12	D.L. 12/03/12
			APPROVED	
			SCALE	SCHEMATIC
			DRAWING NO.	F.R. LAFAYETTE BRIGHTON

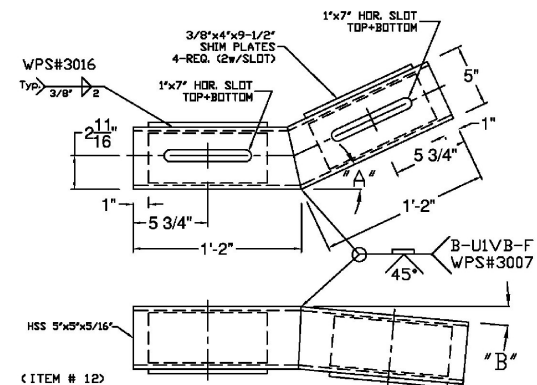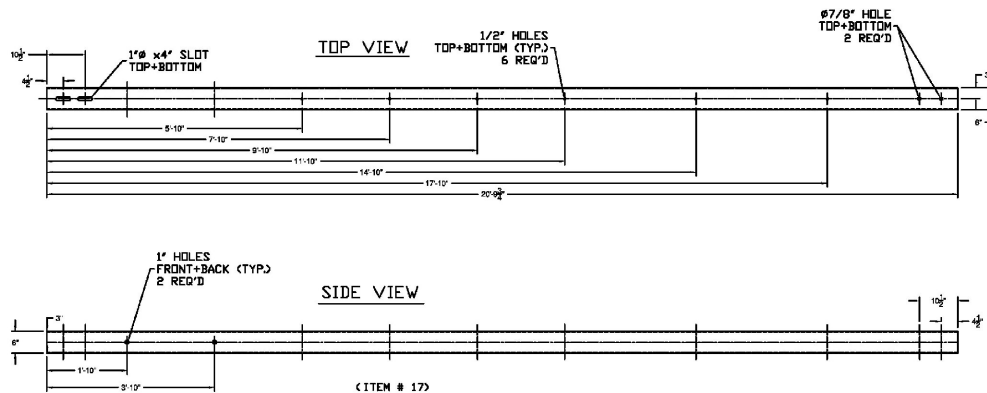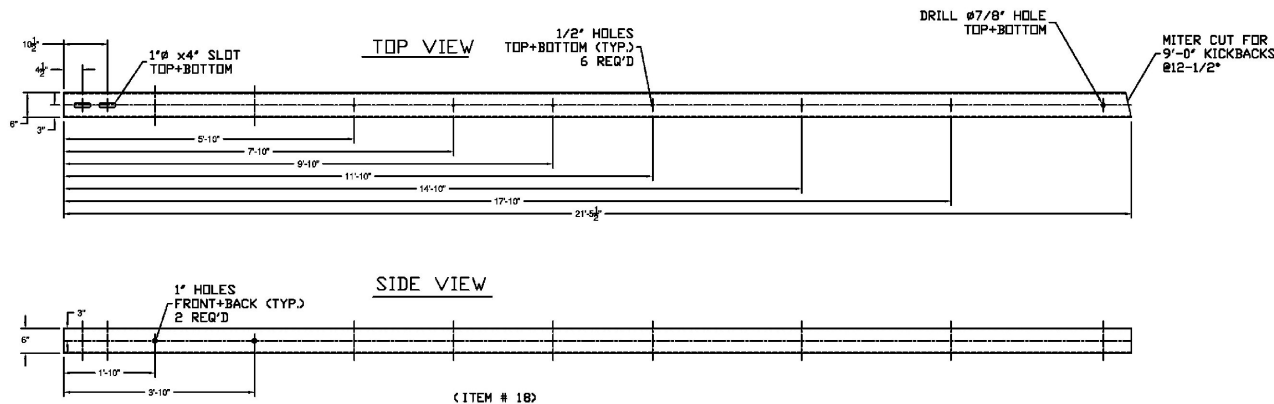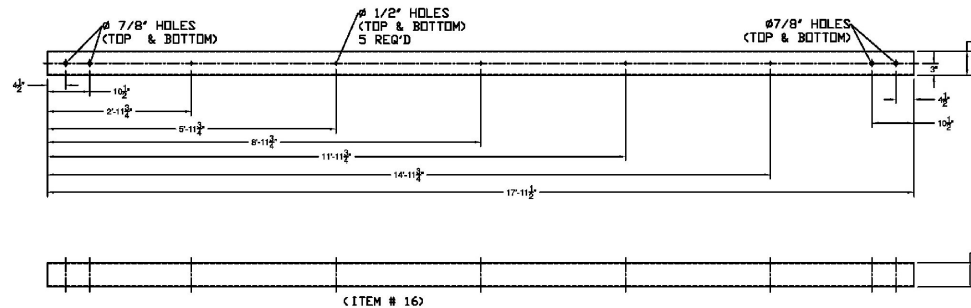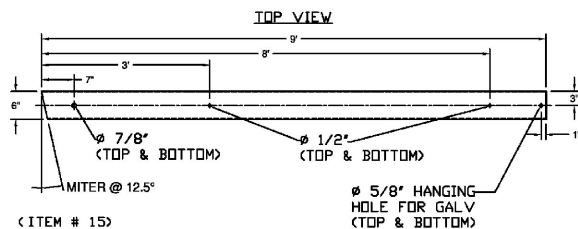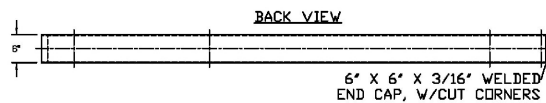

'A' - SEE PLAN FOR TURN BACK DISTANCE, SET ANGLE
ACCORDINGLY.
'B' - TURN DOWN ANGLE SET BY THE 9° MEASUREMENT
AT THE END OF THE BOX BEAM.

GENERAL NOTES:

- 1) ALL RAILING IS TO BE FABRICATED AND ERECTED ACCORDING TO SECTION 525 OF THE STANDARD SPECIFICATIONS.
- 2) BOLTS SHALL BE TORQUED SNUG TIGHT (APPROXIMATELY 100 FT-LB).
- 3) PROTRUSIONS CAUSED BY WELDING OR GALVANIZING ARE NOT PERMITTED ON THE ADJOINING SURFACES OF THE BOX BEAM RAILS, SPICE TUBES AND FILL PLATES.
- 4) BOX BEAM TUBE AND STEEL POST MATERIALS, DIMENSION SIZES AND NOTES SHALL BE THE SAME AS THOSE OF THE BRIDGE RAIL, UNLESS OTHERWISE NOTED.

ITEM #: 525.335
APPROVED BY:

F.R. LAFAYETTE, P.O. 27399

SHEET 3 OF 4

Vermont Agency of Transportation

RECEIVED

CK'D BY R. Klinefelter OK'D BY J. Salvatore

February 14, 2013

RESUBMIT Approved X
BY K. Higgins DATE 02/19/13

GUARD RAIL TO BRIDGE RAIL TRANSITION DETAILS SHEET
PROJECT: BRIGHTON, PROJECT # ER STP 054-02(S), MINOR ARTERIAL, BRIDGE #84
TOWN OF BRIGHTON, ESSEX COUNTY, VT.

R NO.	DATE	DESCRIPTION	BY	R NO.	DATE	DESCRIPTION	BY
1	12/8/11	REVISED PER 12/26/12 EMAIL	E	1	12/8/11	REVISED PER 12/26/12 EMAIL	E
2	1/9/13	REVISED PER 1/9/13 EMAIL	V	2	1/9/13	REVISED PER 1/9/13 EMAIL	V


DRAWN	E.P.	12/03/12
CHECKED	D.L.	12/03/12
APPROVED		
SCALE	SCHMATIC	
DRAWING NO.	F.R. LAFAYETTE BRIGHTON	




ELDERLEE, INC.
OAKS CORNERS, NEW YORK 14518
E-Mail: elderlee@elderlee.com
Tel: 315-789-6870 Fax: 315-789-6615



SPLICE BAR - EXPANSION

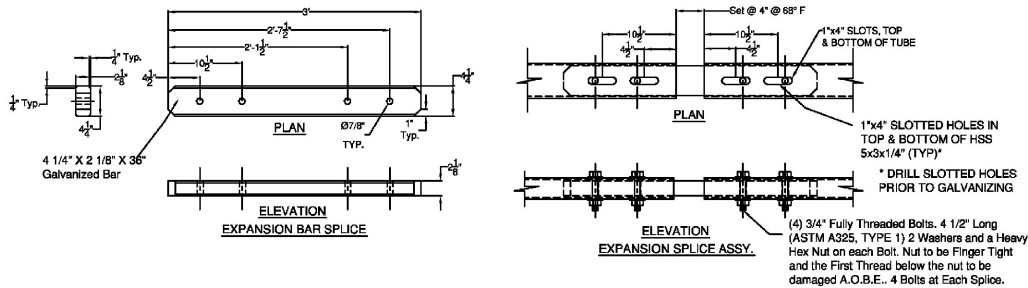


(ITEM # 9)

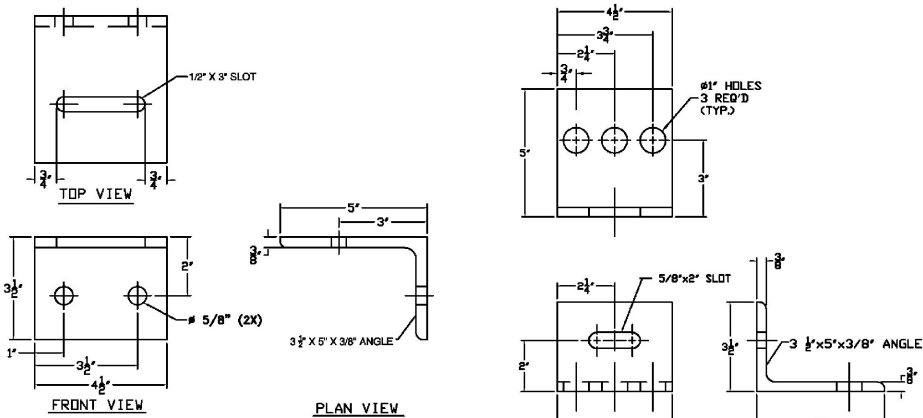




(ITEM # 10)

(ITEM # 11)

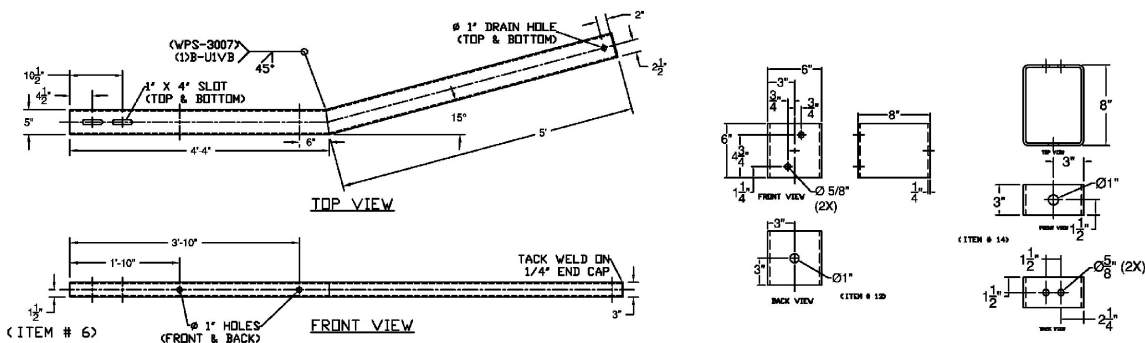


(ITEM # 6)

(ITEM # 12)

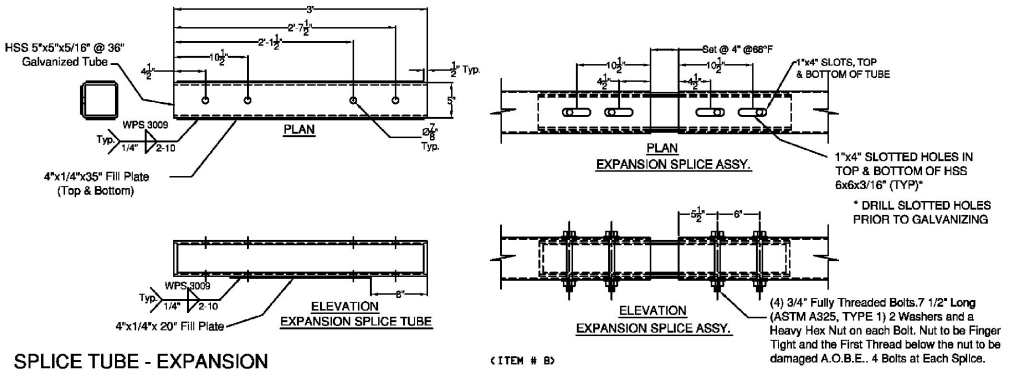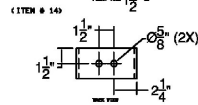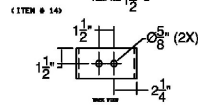


(ITEM # 8)

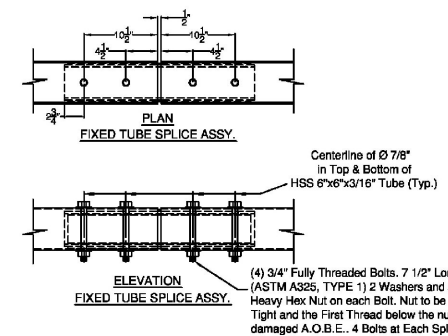

(ITEM # 7)

SPLICE TUBE - FIXED

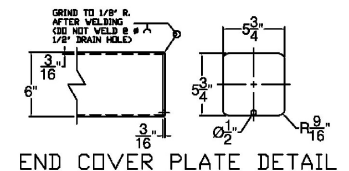

END COVER PLATE DETAIL

ITEM #: 525.335

F.R. LAFAYETTE, P.O. 27399

SHEET 4 OF 4

Vermont Agency of Transportation
RECEIVED

CK'D BY R. Klinefelter OK'D BY J. Salvatore

February 14, 2013

RESUBMIT

Approved X



BY K. Higgins

DATE 02/19/13

GUARD RAIL TO BRIDGE RAIL TRANSITION DETAILS SHEET
PROJECT: BRIGHTON, PROJECT # FR STP 034-325, MINOR ARTERIAL, BRIDGE # 84
TOWN OF BRIGHTON, ESSEX COUNTY, VT.

R NO.	DATE	DESCRIPTION	BY	R NO.	DATE	DESCRIPTION	BY
E 1	12/8/11	REVISED PER 12/26/12 EMAIL	E				
V 2	1/9/13	REVISED PER 1/9/13 EMAIL	V				

	ELDERLEE, INC. OAKS CORNERS, NEW YORK 14578 E-Mail: clong@elderlee.com Tel: 315-789-6870 Fax: 315-789-6815		SCALE SCHEMATIC
DRAWN	CHECKED	E.P.	12/03/12
APPROVED	DATE	12/03/12	
DRAWING NO. F.R. LAFAYETTE BRIGHTON			

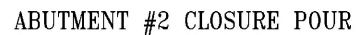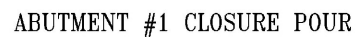

1		APPROVAL PRINT		01/14/13	
No.		Description		Date	
Revisions and Issue Record					
The full intent and purpose of this drawing is the placing of reinforcing steel bars ONLY. It is NOT to be used as a means of communication between the Architect, Engineer, Contractor or any other Sub-trades.					
THIS DRAWING IS NOT TO BE SCALED.					
		DETAILED AT: CANAAN NEW HAMPSHIRE			
		BARKER STEEL LLC a Harris Steel company			
Project: BRIGHTON ER STP 034--(2) BRIGHTON VT 05451					
Drawing: POUR CLOSURES REINFORCEMENT					
Customer: J.A. MCDONALD					
Engineer:					
Refer to Release:					
Date	Drawn	Chkd.	JOB No.	Dwg. No.	
01/14/13	CPS		10049037	R01	

Vermont Agency of Transportation
RECEIVED
NOV 20 2013
CK'D BY WDL OK'D BY GML
January 17, 2013
RESUBMIT NO Approved AsNoted
BY KMH DATE 01/22/13

W:\esample\projects\004003\p1ecine Drawings\DWG\T0.dwg

REINFORCED ELASTOMERIC BEARING FABRICATION SHEET 1103- Page #: 1

Project #: 38760-1103-1 (16 OF 16) Customer: JA McDONALD (PO #101912)

County: ESSEX State: VT Structure: BRIDGE 84

Pad I.D./Loc.: ABUTMENTS Quantity (Including Full Size Sample(s) - If Req'd): 16

Certifications Are Required: ☐ YES, see below ☒ NO, random in-house only
 Testing Req'd: ☒ YES - (If not full size, create another sheet) ☒ NO
 Sample Req'd: ☒ YES - (If not full size, create another sheet) ☒ NO


State D.O.T. Spec. Number (If Specified): SEC 631-731 Project # (req'd for cert.s): ER STP 034-3(25)

Special Notes: _____

Shim Steel Spec. (Circle One): A709 GR.36(250) A1011 GR.36(250)-Type 1 Other: _____

Durometer Requirement (Circle One): 50±5 60±5 Other: _____ Shear Modulus Requirement: 100 PSI ±15%

Neoprene Grade (Circle One): 3 (4) Other Grade or Natural Rubber: NATURAL RUBBER

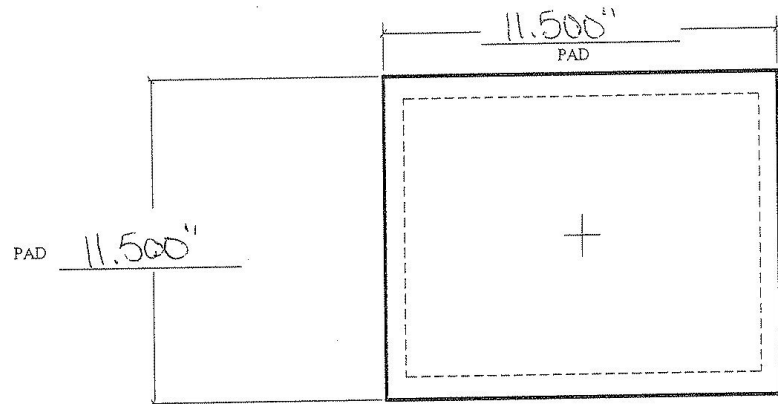


Vermont Agency of Transportation
RECEIVED
 CK'D BY JTS OK'D BY WDL
 December 6, 2012
 RESUBMIT _____ APPROVED _____ AS NOTED
 BY KMH 12-20-12

(A) PLAN

NOT TO SCALE

Please verify the use of 14 GA SHIMS IN LIEU OF 16 GA SHIMS.

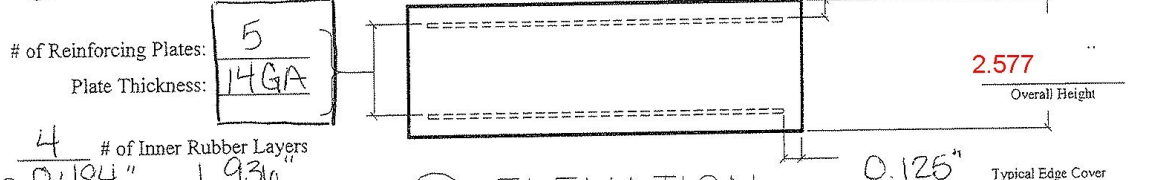

of Reinforcing Plates: 5
 Plate Thickness: 14 GA
4 # of Inner Rubber Layers
 @ 0.484" = 1.936"

(B) ELEVATION

NOT TO SCALE

Name: Marcus Davis Date: 12-5-12

This shop drawing was prepared in accordance with the contract plans and specifications. The D.S. Brown Company does not accept liability for the design of the products detailed in the shop drawings.

1103 - Page #: 2

County: ESSEX State: VT Structure: BRIDGE 84

Pad I.D./Loc.: _____ Quantity (Including Full Size Sample(s) - If Req'd): 16

☐ YES, see below
 ☐ YES - (If not full size, create another sheet)


Certifications Are Required
 Testing Req'd: ☒ NO, random in-house only
 Sample Req'd: ☒ NO

State D.O.T. Spec. Number (If Specified): _____ Project # (req'd for cert.s) ER STP 034-3(25)

Special Notes: _____

General Product Name: ADJUSTMENT SHIMS


Product Specification: A709 GR 36, A123-HDG

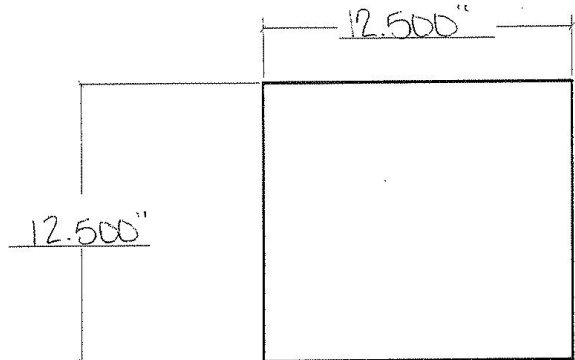

A PLAN

NOT TO SCALE

Vermont Agency of Transportation
RECEIVED
CK'D BY JTS OK'D BY WDL
December 6, 2012
RESUBMIT APPROVED X
BY KMH DATE 12-20-12

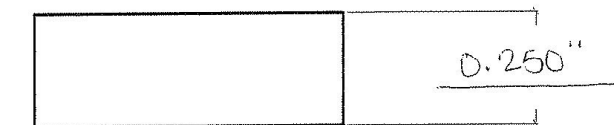

B ELEVATION
NOT TO SCALE

Name: Natasha Oriss Date: 12-5-12

ABUTMENT & WING WALL GENERAL NOTES

1. MIN. CONCRETE STRENGTH AT 28 DAYS SHALL BE 5,000 PSI.
2. MIN. CONCRETE STRENGTH AT STRESS TRANSFER SHALL BE 3,500 PSI.
3. REINFORCING STEEL SHALL BE GR-40, ASTM A-615 (AASHTO M51) EPOXY COATED.
4. THE TOP OF ABUTMENTS SHALL RECEIVE A RAKE FINISH ROUGHENED TO 1/4" AMPLITUDE (UNLESS NOTED OTHERWISE).
5. THE TOP OF WING WALLS SHALL RECEIVE A SMOOTH FLOAT FINISH (UNLESS NOTED OTHERWISE).
6. SHEAR KEY SURFACES SHALL BE BLASTED CLEAN.
7. PRECAST CONCRETE UNITS SHALL BE HANDLED AND ERECTED USING THE LIFTING INSERTS ONLY. THE MINIMUM SLING ANGLE FROM THE HORIZONTAL SHALL BE 60°. NON-PRESTRESSED UNITS SHALL BE STORED & TRANSPORTED WITH TYBER SUPPORTS AT 6" SPACING, UNLESS APPROVED BY J.P. CARRARA & SONS, INC.
8. MATERIAL SPECIFICATION AND MIX DESIGN SHALL CONFORM TO VDOT SPEC. PG.022 AND PG.026 RESPECTIVELY.
DESIGN USE:
KING WALLS: J.P.C. BRIDGE MIX 44201 NO DGI
APPROACH SLABS: J.P.C. BRIDGE MIX 44201 NO DGI
ABUTMENTS: J.P.C. BRIDGE MIX 44201
9. QUALITY CONTROL PROCEDURES ARE IN ACCORDANCE WITH PCI REQUIREMENTS. J.P. CARRARA & SONS, INC. IS A PCI CERTIFIED PLANT.
10. CURING METHOD: AS SOON AS THE TOP OF PRECAST CONCRETE UNITS ARE FINISHED, A COVER OF RIGID INSULATION AND POLY WILL BE PLACED OVER THE UNIT. NATURAL CURE WITH NO EXTERNAL HEAT APPLIED.
11. ABUTMENT POST-TENSIONING SEQUENCE:
A. ERECT PRECAST CONCRETE ABUTMENTS, AND POST-TENSION TENDON TO APPROXIMATELY 5,000 LBS.
B. GROUT SHEAR KEY.
C. ONCE SHEAR KEY GROUT HAS ATTAINED A MINIMUM COMPRESSIVE STRENGTH OF 3,000 PSI, POST-TENSION TENDONS TO 32,000 LBS.

NEXT BEAM GENERAL NOTES

1. MIN. CONCRETE STRENGTH AT 28 DAYS SHALL BE 5,000 PSI.
2. MIN. CONCRETE STRENGTH AT STRESS TRANSFER SHALL BE 3,000 PSI.
3. REINFORCING STEEL SHALL BE GR-40, ASTM A-615 (AASHTO M51) EPOXY COATED.
4. PRESTRESSING STRANDS SHALL CONFORM TO ASTM A-421 (AASHTO M283) AND SHALL CONSIST OF 0.60" x 270 KSI 7-WIRE LOW RELAXATION STRANDS.
5. PRESTRESSING STRANDS SHALL EACH BE PULLED TO HAVE A NET TENSION OF 44.6 K AFTER ACCOUNTING FOR CHUCK SLIPPAGE. TENSION SHALL BE VERIFIED BY MEASURING STRAND ELONGATION. (SEE EXAMPLE ELONGATION CALCULATION AND TENSIONING PROCEDURE, THIS SHEET.)
6. ENDS OF PRESTRESSING STRANDS SHALL BE CUT FLUSH WITH END OF NEXT BEAM STEPS (UNLESS NOTED OTHERWISE) AND EPOXY PAINTED.
7. ALL EXPOSED CORNERS SHALL BE CHAMFERED 3/4".
8. THE TOP OF BEAMS SHALL RECEIVE A SMOOTH FLOAT FINISH (UNLESS NOTED OTHERWISE).
9. SHEAR KEY SURFACES SHALL BE BLASTED CLEAN.
10. BEAMS SHALL BE HANDLED AND ERECTED USING THE LIFTING LOOPS ONLY. RIGGING SHALL BE CONFIGURED SUCH THAT EQUAL FORCES ARE APPLIED TO EACH OF THE TWO LIFTING LOOPS AT EACH END OF THE BEAM. THE PINS OF THE SHACKLES SHALL BE PLACED THROUGH THE LIFTING LOOPS. SEE DETAIL, THIS SHEET. BEAMS SHALL BE STORED AND TRANSPORTED WITH TYBER SUPPORTS WITHIN 2'-0" OF THE BEAM ENDS, UNLESS APPROVED BY J.P. CARRARA & SONS, INC.
11. MATERIAL SPECIFICATION AND MIX DESIGN SHALL CONFORM TO VDOT SPEC. PG.022 AND PG.026 RESPECTIVELY.
DESIGN USE: J.P.C. BRIDGE MIX 44201 (5 GAL/CY DGI)
12. QUALITY CONTROL PROCEDURES ARE IN ACCORDANCE WITH PCI REQUIREMENTS. J.P. CARRARA & SONS, INC. IS A PCI CERTIFIED PLANT.
13. CURING METHOD: AS SOON AS THE TOP OF BEAM IS FINISHED, A COVER OF INSULATED POLY. THE DESIRED CURING TEMPERATURE RANGE SHALL NOT DROP BELOW 70°F. THE TEMPERATURE SHALL BE RECORDED BY AUTOMATIC SENSOR INSTRUMENTS ON GRAPH CHARTS, SPACED NOT MORE THAN 40' APART AND WILL CONTINUE UNTIL RELEASE STRENGTH IS ACHIEVED. EACH CHART SHALL BE MARKED WITH THE CASTING DATED AND LOCATION OF THE RECORDER. IF NECESSARY TO MAINTAIN CASTING BED TEMPERATURE PRIOR TO CONCRETE PLACEMENT OR TO ACCELERATE EARLY AGE STRENGTH GAIN, EXTERNAL RADIANT HEAT MAY BE EMPLOYED VIA HOT WATER DUCTS BENEATH AND WITHIN THE PERIMETER OF THE CASTING BED. MAXIMUM CURING TEMPERATURE SHALL NOT EXCEED PCI SPECIFIED LIMITS.
14. OWNER SHALL PROVIDE APPROPRIATE WATERPROOFING TO GROUTED SHEAR KEYS. J.P. CARRARA & SONS, INC. SHALL NOT BE HELD LIABLE FOR PROBLEMS ASSOCIATED WITH MOISTURE INFILTRATING GROUTED SHEAR KEYS.


EXAMPLE PRESTRESSING STRAND ELONGATION CALC. AND TENSIONING

(NOT TO BE USED FOR CONSTRUCTION)


SIZE & GRADE: 0.60" x 270 KSI
AREA: 0.217 IN²
TENSION: 44,000 LB. EACH STRAND
GRIP-TO-GRIP: 202'-0" = 202.00'
 $E_s = 28,400,000$ PSI (ASSUMED FOR THESE CALCULATIONS; VALUE TO BE OBTAINED FOR STRAND SPEC. ACTUALLY USED)
EXAMPLE:
 $\Delta L = \frac{P_L}{AE} = \frac{(44,000 \times 0.217) \times 202.00 \times 12}{28,400,000 \times 0.217} = 14.97"$
THEREFORE (TOLERANCES ± 5%)
 Δ UPPER LIMIT = $1.08 \times 14.97" = 20.98" \pm 2"$
 Δ LOWER LIMIT = $0.92 \times 14.97" = 13.98" \pm 1"$
EXTRA FORCE REQUIRED TO COMPENSATE FOR 1/2" CHUCK SLIPPAGE:
 $\Delta P = \frac{0.5 \times 48,000}{14.97} = 1,026$ LBS.
TOTAL TENSIONING FORCE = $44,000 \times 1.026 = 45,026$ LBS.

STRAND TENSIONING PROCEDURE:

1. PULL EACH STRAND INITIALLY TO 3,000 LBS. AND MARK STRAND.
2. THEN PULL EACH STRAND TO A TOTAL TENSION OF 45,026 LBS. AND MEASURE ELONGATION AFTER BEATING. IT MUST BE BETWEEN 14" AND 20".
3. NOTE: FORCES READ ON STRESSING JACK GAUGES MUST BE MADE TO CORRESPOND TO ABOVE VALUES BASED ON CALIBRATION DATA FOR SPECIFIC JACK USED.

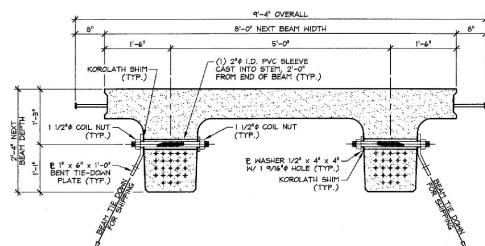


NEXT BEAM 28D HOLD-DOWN DETAIL
FOR SHIPPING
3/4" x 1'-0"

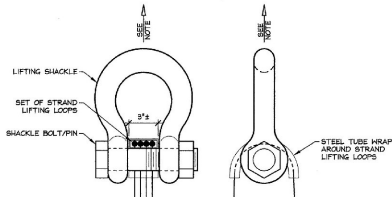

NOTE: BEAMS SHALL BE HANDLED AND ERECTED USING THE LIFTING LOOPS ONLY. RIGGING SHALL BE CONFIGURED SUCH THAT EQUAL FORCES ARE APPLIED TO EACH SET OF LIFTING LOOPS AT EACH END OF THE BEAM. SHACKLE BOLT/PIN SHALL BE PLACED UNDER LIFT LOOPS AS SHOWN. DESIGN AND CONFIGURATION OF RIGGING BY PURCHASER.

LIFTING SHACKLE DETAILS
N.T.S.

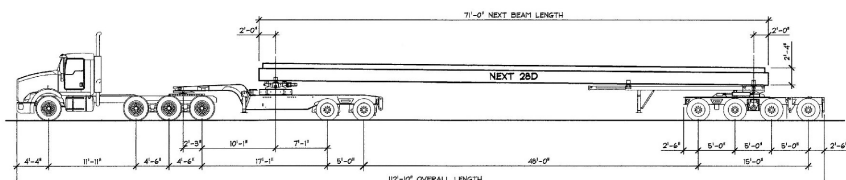

SHIPPING ELEVATION
N.T.S.

Vermont Agency of Transportation

RECEIVED

CK'D BY WDL OK'D BY JTS

January 9th, 2013

RESUBMIT BY KMH DATE 1-10-13

APPROVAL STAMP:

J.P. CARRARA & SONS INC.
Precast & Prestress Manufacturer
244 ONE EPL. RD. WILSON, VT 05353 Phone: (802) 338-4341 Fax: (802) 338-9010

J.A. McDONALD, INC.
CONTRACTOR
LYNDON CENTER, VERMONT


STATE OF VERMONT AGENCY OF TRANSPORTATION
COUNTY OF ESSEX

TOWN OF BRIGHTON
ROUTE NO. VT 105, MINOR ARTERIAL
BRIDGE NO. 184 PROJECT NO. 1 ER STP 034-S(26)


DATE: OCT. 30, 2012
SCALE: NOTED
CHKD: B.C. DFTN: B.L.
JOB NO: 23894-012

COVER SHEET
DWG. NO: C1

SUBMITTED
JAN 9 2013
J.P. CARRARA & SONS, INC.
MONTPELIER, VT 05753

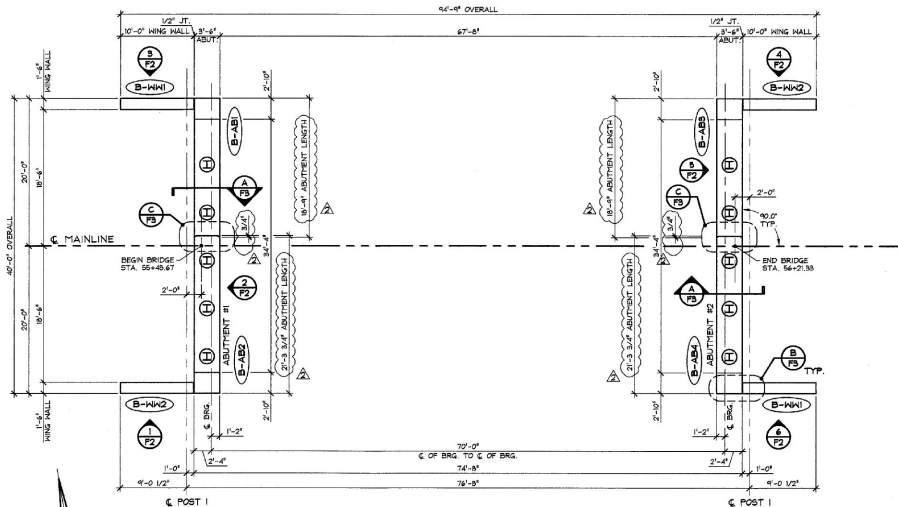







1 PRECAST CONCRETE ABUTMENT & WING WALL LAYOUT
1/8" = 1'-0"

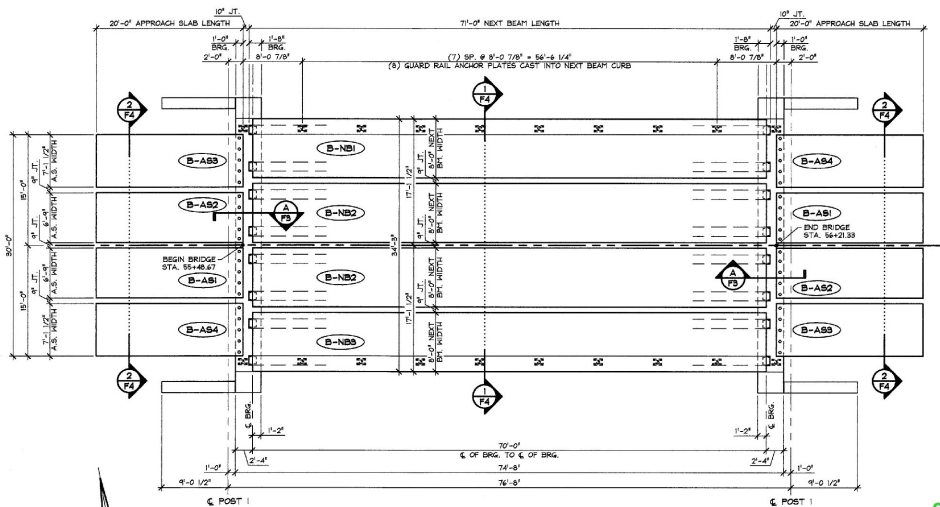

2 PRESTRESSED APPROACH SLAB & NEXT BEAM LAYOUT
1/8" = 1'-0"

Vermont Agency of Transportation
RECEIVED
CK'D BY **WDL** OK'D BY **JTS**
January 9th, 2013
RESUBMIT **APPROVED**
BY **KMH** DATE **1-10-13**

SUBMITTED JAN 9 2013 J.P. CARRARA & SONS, INC. MIDDLEBURY, VT 05753	
J.P. CARRARA & SONS INC. Precast & Prestress Manufacturer 2441 ONE ST., MIDDLEBURY, VERMONT 05753 Phone: (802) 388-5361 Fax: (802) 388-9010	J.A. McDONALD, INC. CONTRACTOR LYNDON CENTER, VERMONT
STATE OF VERMONT AGENCY OF TRANSPORTATION COUNTY OF ESSEX	DATE: OCT. 30, 2012 SCALE: NOTED
TOWN OF BRIGHTON ROUTE NO. VT 105, MINOR ARTERIAL BRIDGE NO. 84 PROJECT NO. ER STP 054-3(25)	CHKD: B.C. DTM: B.L. JOB NO: 23564-012
SUPERSTRUCTURE PLANS	DWG. NO: F1

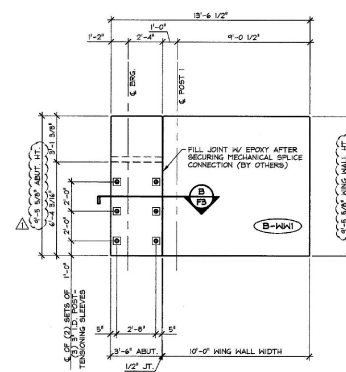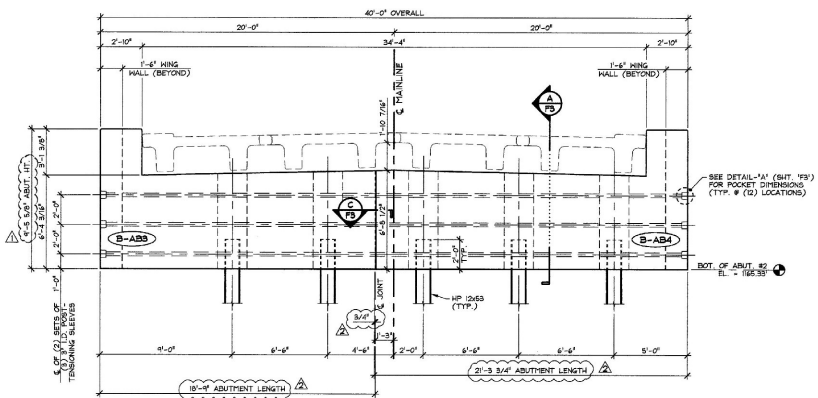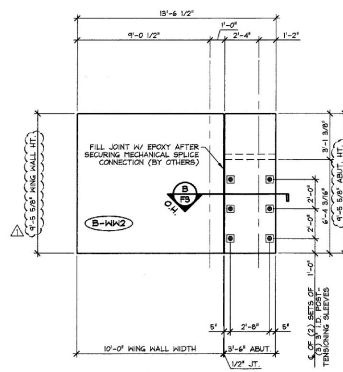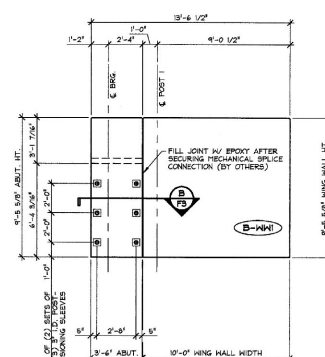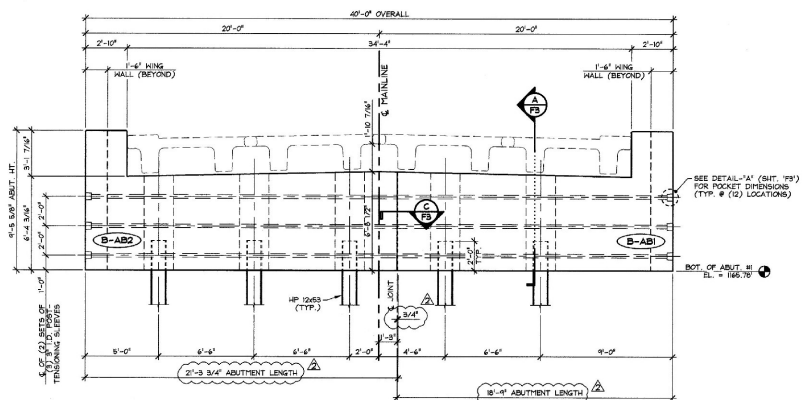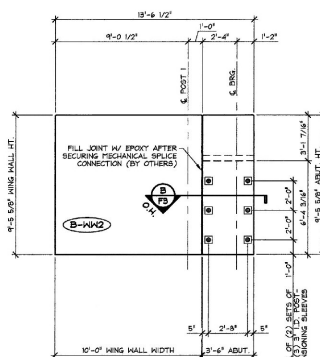

1-3-13 REVISED AS NOTED

12-10-12 REVISE ABUTMENT #1 LAYOUT & ABUTMENT #2 ELEVATIONS

Vermont Agency of Transportation

RECEIVED

CK'D BY WDL OK'D BY JTS

January 9th, 2013

RESUBMIT	APPROVED	X
BY	DATE	1-
KMH		

BY	KMH	DATE	1-10-13
----	-----	------	---------

SUBMITTED

JAN 9 2013

J. P. CARRARA & SONS, INC.
MIDDLEBURY, VT 05753

J.A. McDONALD, INC.
CONTRACTOR
LYNDON CENTER, VERMONT

J.P. CARRARA & SONS INC.

1684 CASE ST., MIDDLEBURY, MONTGOMERY CO. Phone: (802) 388-6361 Fax: (802) 388-6011

STATE OF VERMONT AGENCY OF TRANSPORTATION
COUNTY OF ESSEX

COUNTY OF ESSEX

TOWN OF BRIGHTON
ROUTE NO. VT 105, MINOR ARTERIAL
BRIDGE NO.: 84 PROJECT NO.: ER STP 034-3(25)

ABUTMENT ELEVATIONS

ABUTMENT ELEVATIONS

[illegible]

J.A. McDONALD, INC.
CONTRACTOR
LYNDON CENTER, VERMONT

DATE: OCT 30 2010


DATE: OCT. 30, 2012

SCALE:	NOTED
--------	-------


CHKD: B.C.	DETM: B.L.
------------	------------

CHRD: B.C.	DTM: B.L.
100.10	0000.00


JOB NO:	23384-012
---------	-----------

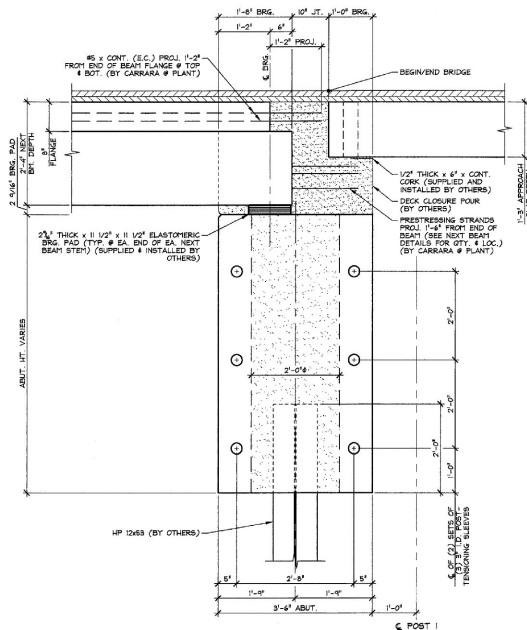


A BEARING SECTION
F3 NEXT BEAM STEM BEARING 3/4" = 1'-0"

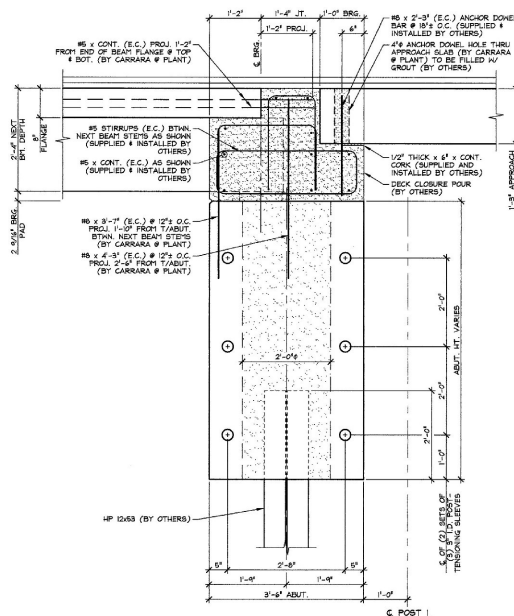


A.1 BEARING SECTION
F3 BETWEEN NEXT BEAM STEM BEARING 3/4" = 1'-0"

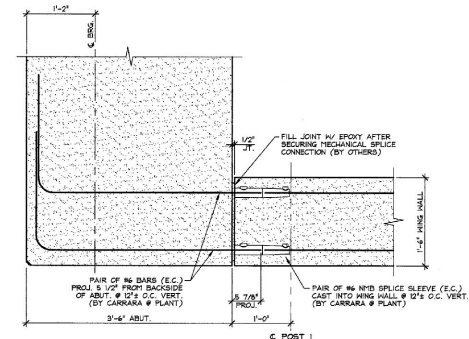


B WING WALL CONNECTION DETAIL
F3 1' = 1'-0"

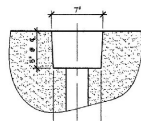


PLAN OF POCKET

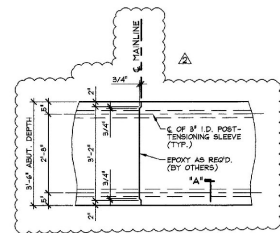

C SHEAR KEY SECTION @
F3 P.T. SLEEVE 1/2" = 1'-0"

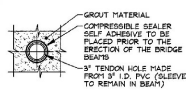

SECTION - "A"
1 1/2" = 1'-0"

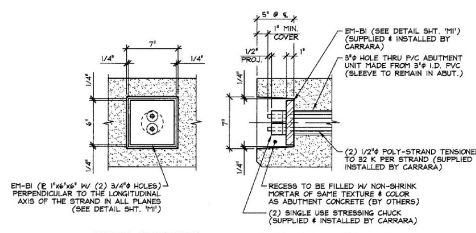

FASCIA ELEVATION

SECTION AT CENTERLINE
1 1/2" = 1'-0"

Vermont Agency of Transportation
RECEIVED

CK'D BY **WDL** OK'D BY **JTS**

January 9th, 2013

RESUBMIT BY **KMH** APPROVED X
DATE **1-10-13**

1-3-B GENERAL REVISIONS

APPROVAL STAMP:

J.P. CARRARA & SONS INC.
Precast & Prestress Manufacturer
244 Old St., Montpelier, Vermont 05602 Phone: (802) 258-0331 Fax: (802) 258-9910

J.A. McDONALD, INC.
CONTRACTOR
LYNDON CENTER, VERMONT

STATE OF VERMONT AGENCY OF TRANSPORTATION
COUNTY OF ESSEX

DATE: OCT. 30, 2012
SCALE: NOTED

TOWN OF BRIGHTON
ROUTE NO. VT 105, MINOR ARTERIAL
BRIDGE NO.: 84 PROJECT NO.: ER STP 034-3(25)


CHKD: B.C. DFTM: B.L.
JOB NO: 23384-012

ABUTMENT DETAILS


DWG. NO: **F3**

SUBMITTED
JAN 9 2013


J.P. CARRARA & SONS, INC.
MONTPELIER, VT 05602

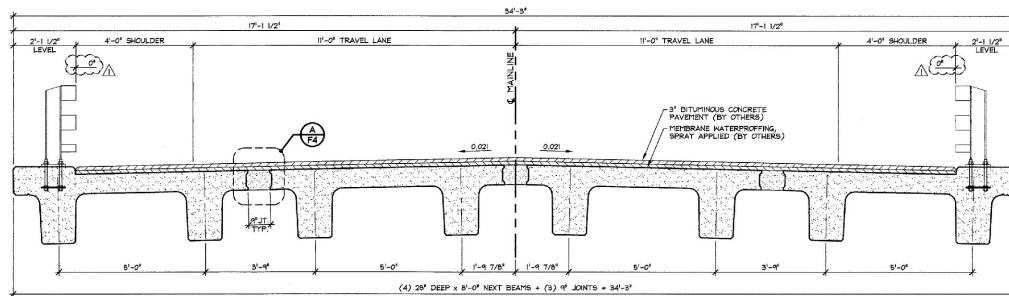


1
F4 NEXT BEAM TRANSVERSE SECTION
1/2" = 1'-0"

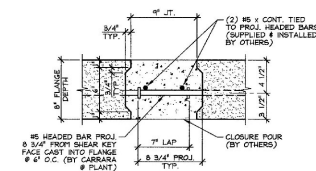

A
F4 NEXT BEAM CLOSURE POUR
1 1/2" = 1'-0"

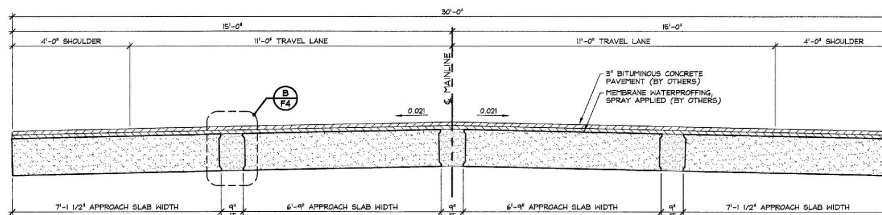

2
F4 APPROACH SLAB TRANSVERSE SECTION
1/2" = 1'-0"

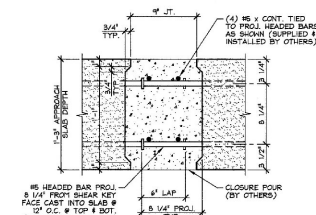

B
F4 APPROACH SLAB CLOSURE POUR
1 1/2" = 1'-0"

Vermont Agency of Transportation

RECEIVED

CK'D BY WDL OK'D BY JTS

January 9th, 2013

RESUBMIT APPROVED X
BY KMH DATE 1-10-13

12-10-12 REVISE GUARD RAIL LOCATIONS

J.P. CARRARA & SONS INC.

Precast & Prestress Manufacturer

200 USE STR. MODULAR CONCR. (B3) Phone: (802) 338-6301 Fax: (802) 338-9010

STATE OF VERMONT AGENCY OF TRANSPORTATION
COUNTY OF ESSEX

TOWN OF BRIGHTON
ROUTE NO. VT 105, MINOR ARTERIAL
BRIDGE NO.: 84 PROJECT NO.: ER STP 034-B(25)

TRANSVERSE SECTIONS & DETAILS

J.A. McDONALD, INC.

CONTRACTOR

LYNDON CENTER, VERMONT

DATE: OCT. 30, 2012

SCALE: NOTED

CHKD: B.C. DFTN: B.L.


JOB NO: 23354-012

DWG. NO: F4


SUBMITTED

JAN 9 2013


J.P. CARRARA & SONS, INC.
MIDDLEBURY, VT 05753

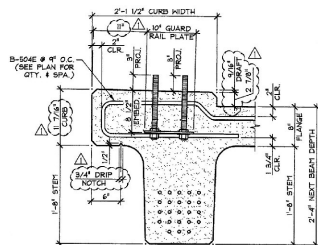


C CURB & GUARD RAIL ANCHOR
NB2 PLATE SECTION 1" = 1'-0"

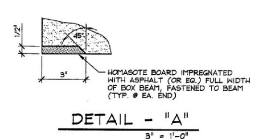


DETAIL - "A"

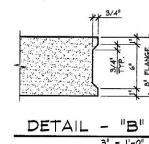

DETAIL - "B"

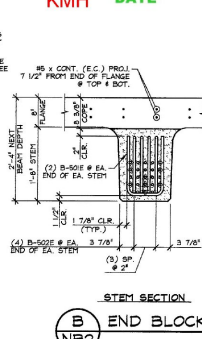


END BLOCK STEM REINFORCING DETAILS

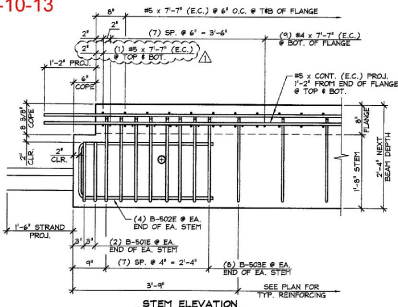


NTS

TOWN OF BRIGHTON ROUTE NO. VT 105, MINOR ARTERIAL BRIDGE NO. 1 84 PROJECT NO. 1 ER STP 054-3(25)	SCALE: NOTED	
	CHKD: B.C.	DFTM: B.L.
	JOB NO: 23364-012	


PRESTRESSED NEXT BEAM DETAILS DWG. NO: NB2

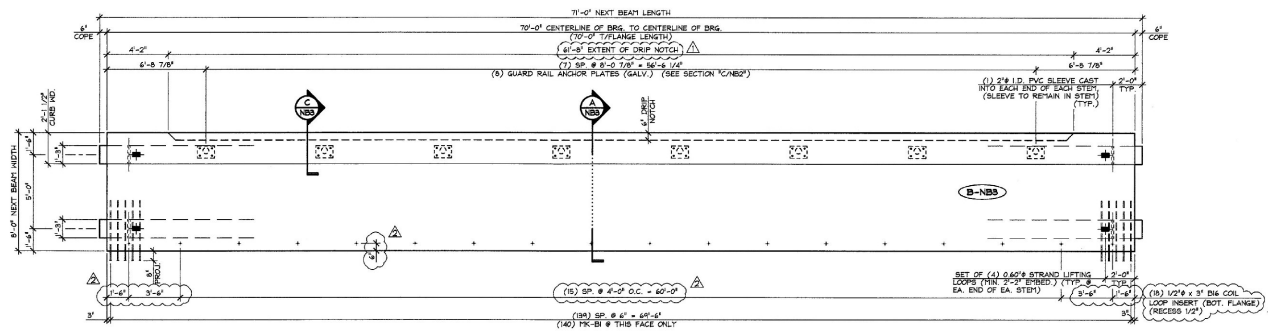



1 DIMENSIONAL PLAN VIEW IN FORM
1/4" = 1'-0"

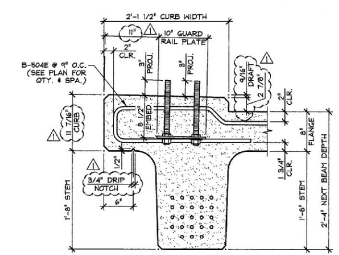


C CURB & GUARD RAIL ANCHOR PLATE SECTION
1" = 1'-0"

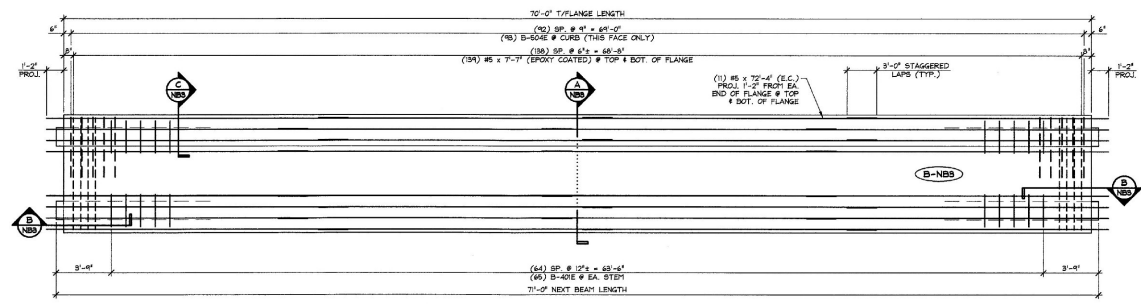


2 REINFORCING PLAN VIEW IN FORM
1/4" = 1'-0"

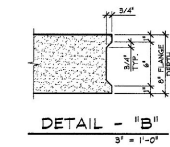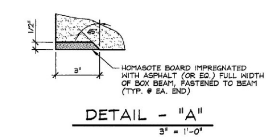

Vermont Agency of Transportation
RECEIVED
CK'D BY WDL OK'D BY JTS
January 9th, 2013
RESUBMIT BY KMH APPROVED DATE 1-10-13

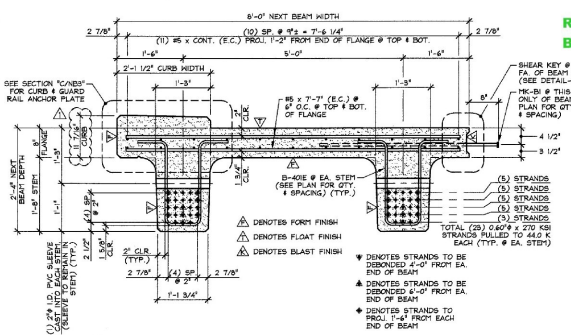

A DIMENSIONAL & REINFORCING SECTION
3/4" = 1'-0"

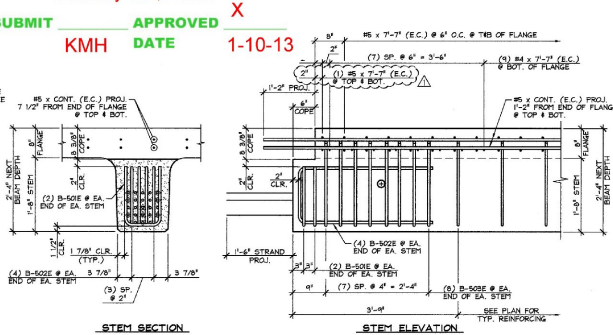

B END BLOCK STEM REINFORCING DETAILS
3/4" = 1'-0"


DETENSIONING SCHEDULE
N.T.S.

1	2	3	4	5	6	7	8	9	10	11	12	13	14	15
1	2	3	4	5	6	7	8	9	10	11	12	13	14	15


MARK: B-NB3	QTY.: 1	WT.: 52.52 T	VOL: 25.94 cy
MATERIAL LIST / BOX BEAM			
ITEM	MARK	DESCRIPTION	QTY.
1	B-40E	#4 BENT BAR (EPOXY COATED)	30
2	B-4	#4 x 7'-7" (EPOXY COATED)	18
3			
4	B-50E	#5 BENT BAR (EPOXY COATED)	8
5	B-50E	#5 BENT BAR (EPOXY COATED)	16
6	B-50E	#5 BENT BAR (EPOXY COATED)	32
7	B-50E	#5 BENT BAR (EPOXY COATED)	48
8	B-5	#5 x 7'-7" (EPOXY COATED)	120
9	B-5	#5 x 72'-4" (4" (3) 3'-0" STAGGERED LAPS) (EPOXY COATED)	22
10			
11	TR-B	#5 x 4'-1" HRC 55S HEADED REBAR (EPOXY COATED)	140
12		2"x4" x 10" DIM SOL LOOP INVERT TELETYPE-PLATED FINISH	30
13		GUARD RAIL ANCHOR PLATE (GALV.)	8
14		SET OF (4) 0.60" x 270 KSI STRAND LIFTING LOOPS	4
15			

1-3-13 REVISED AS NOTED
12-10-12 REVISED AS NOTED


APPROVAL STAMP:	J.P. CARRARA & SONS INC. Precast & Prestress Manufacturer 244 GLE ST., WILKESBARRE, VERMONT 05751 Phone: (802) 288-6381 Fax: (802) 288-6010	J.A. McDONALD, INC. CONTRACTOR LYNDON CENTER, VERMONT
STATE OF VERMONT AGENCY OF TRANSPORTATION COUNTY OF ESSEX	DATE: OCT. 30, 2012 SCALE: NOTED	CHKD: B.C. DTM: B.L. JOB NO: 23364-012
TOWN OF BRIGHTON ROUTE NO. VT 105, MINOR ARTERIAL BRIDGE NO. 84 PROJECT NO. 1, ER STP 054-3(25)	PRESTRESSED NEXT BEAM DETAILS DWG. NO: NB3	

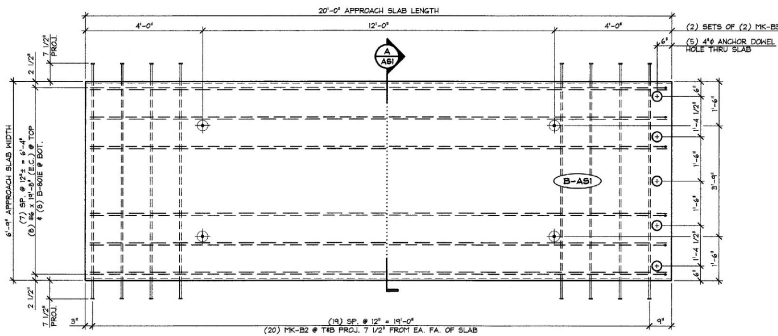


1 PLAN VIEW IN FORM
1/2" = 1'-0"

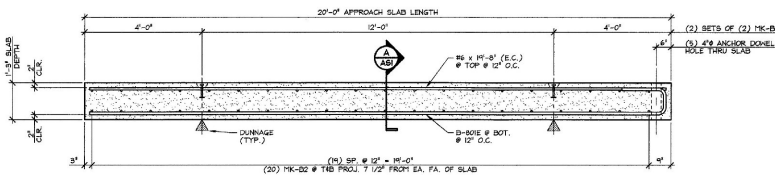


2 ELEVATION
1/2" = 1'-0"

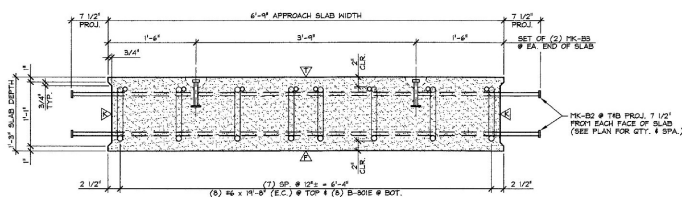

A APPROACH SLAB SECTION
1" = 1'-0"

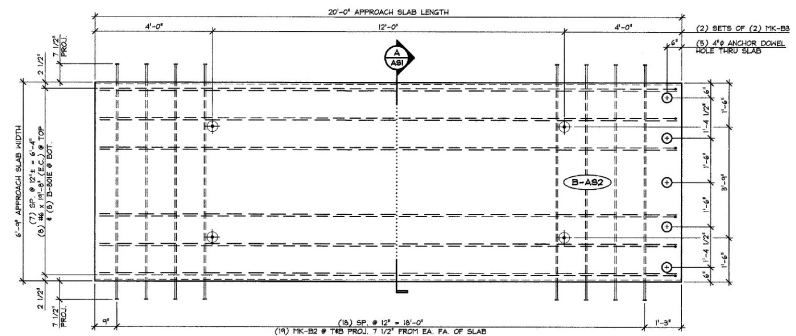

3 PLAN VIEW IN FORM
1/2" = 1'-0"

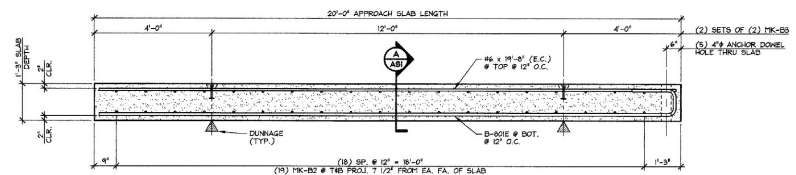






4 ELEVATION
1/2" = 1'-0"

SUBMITTED
JAN 9 2013
J.P. CARRARA & SONS, INC.
MIDDLEBURY, VT 05753

MARK: B-AS1	QTY.: 2	WT.: 12.46 T	VOL.: 6.16 cy
MARK: B-AS2	QTY.: 2	WT.: 12.46 T	VOL.: 6.16 cy
MATERIAL LIST / APPROACH SLAB			
ITEM	MARK	DESCRIPTION	QTY./SLAB
1		#6 x 18'-0" (EPOXY COATED)	5
2			5
3	B-BOE	#8 BENT BAR (EPOXY COATED)	5
4			5
5			5
6			5
7	TK-B2	#6 x 8'-0" HNC 156 DOUBLE-HEADED REBAR (EPOXY COATED)	40
8	TK-B2	47 x 5 1/2" SHFT LIFT LIFTER	4
9			4
10			4

Vermont Agency of Transportation
RECEIVED
CK'D BY WDL OK'D BY JTS
January 9th, 2013
RESUBMIT BY KMH APPROVED DATE 1-10-13


J.P. CARRARA & SONS INC. Precast & Prestress Manufacturer 1000 US ST. WILKESVILLE, VERMONT 05497 Phone: (802) 288-4381 Fax: (802) 288-1010	J.A. McDONALD, INC. CONTRACTOR LYNDON CENTER, VERMONT
STATE OF VERMONT AGENCY OF TRANSPORTATION COUNTY OF ESSEX	DATE: OCT. 30, 2012 SCALE: NOTED
TOWN OF BRIGHTON ROUTE NO. VT 108, MINOR ARTERIAL BRIDGE NO.: 64 PROJECT NO.: ER STP 094-3(25)	CHKD: B.C. DTM: B.L. JOB NO: 23984-012
PRECAST APPROACH SLAB DETAILS	DWG. NO: ASI

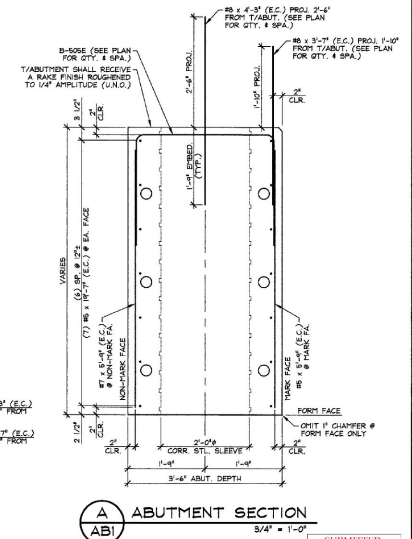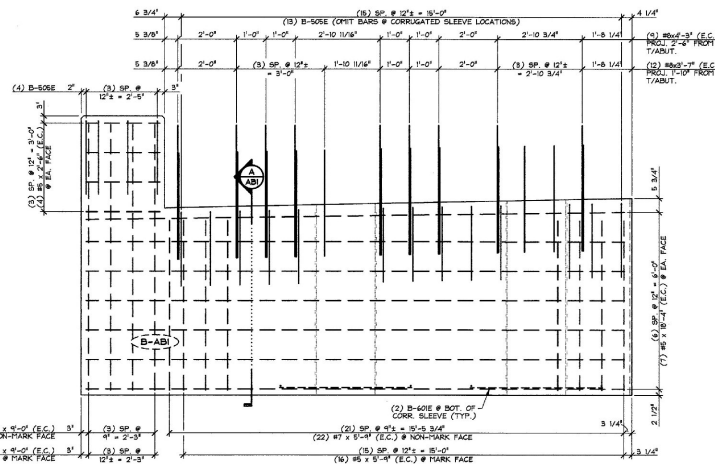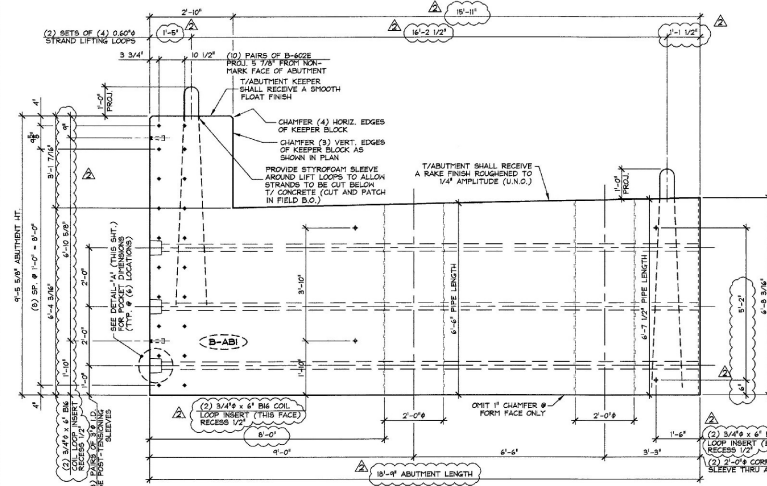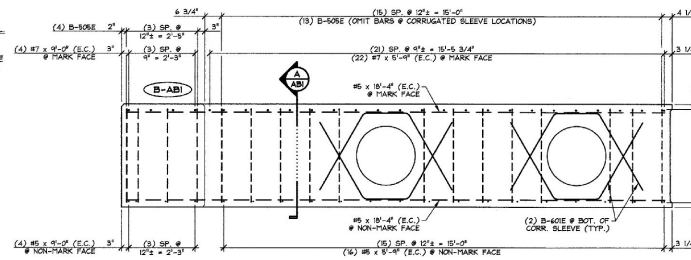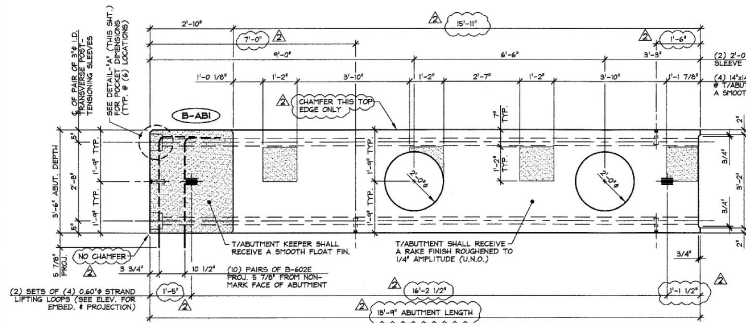

SUBMITTED
JAN 9 2013
J. P. CARRARA & SONS, INC.
MIDDLEBURY, VT 05758

MARK: B-ABI		QTY.: 1	WT.: 31.15 T	VOL.: 15.38 cy
MATERIAL LIST / ABUTMENT				
ITEM	MARK	DESCRIPTION	QTY.	
1	B-506E	H6 BENT BAR (EPOXY COATED)	17	
2		H6 x 2'-4\" (EPOXY COATED)	8	
3		H6 x 6'-4\" (EPOXY COATED)	16	
4		H6 x 4'-0\" (EPOXY COATED)	14	
5		H6 x 10'-4\" (EPOXY COATED)	14	
6				
7	B-601E	H6 BENT BAR (EPOXY COATED)	4	
8	B-602E	H6 BENT BAR (EPOXY COATED)	20	
9				
10		H7 x 9'-4\" (EPOXY COATED)	22	
11		H7 x 9'-0\" (EPOXY COATED)	4	
12				
13		H8 x 3'-7\" (EPOXY COATED)	12	
14		H8 x 4'-3\" (EPOXY COATED)	9	
15		3/4\" x 6\" BIR COIL INSERT (ELECTRO-PLATED FINISH)	8	
16		2'-0\" x 6'-7 1/2\" CORRUGATED STEEL PIPE (GALV.)	1	
17		2'-0\" x 6'-4\" CORRUGATED STEEL PIPE (GALV.)	1	
18		SET OF (4) 640'S x 270 KSI STRAND LIFTING LOOPS	2	
19				
20				







SHOP NOTE:
ALL EDGES OF ABUTMENT SHALL
RECEIVE A 1\" CHAMFER (U.N.O.)

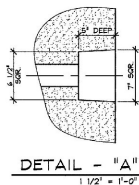

Vermont Agency of Transportation
RECEIVED
CK'D BY WDL OK'D BY JTS
January 9th, 2013
RESUBMIT BY KMH APPROVED DATE 1-10-13

1-3-13 GENERAL REVISIONS
2-10-12 GENERAL REVISIONS

J.P. CARRARA & SONS INC. Precast & Prestress Manufacturer 244 ONE ST., MIDDLEBURY, VERMONT 05758 Phone: (802)388-6381 Fax: (802)388-6910		J.A. McDONALD, INC. CONTRACTOR LYNDEN CENTER, VERMONT	
STATE OF VERMONT AGENCY OF TRANSPORTATION COUNTY OF ESSEX		DATE: OCT. 30, 2012 SCALE: NOTED	
TOWN OF BRIGHTON ROUTE NO. VT 105, MINOR ARTERIAL BRIDGE NO.: 84 PROJECT NO.: ER STP 084-3(25)		CHKD: B.C. DTM: B.L. JOB NO.: 23584-012	
PRECAST ABUTMENT DETAILS		DWG. NO: ABI	

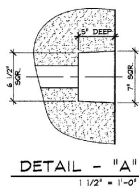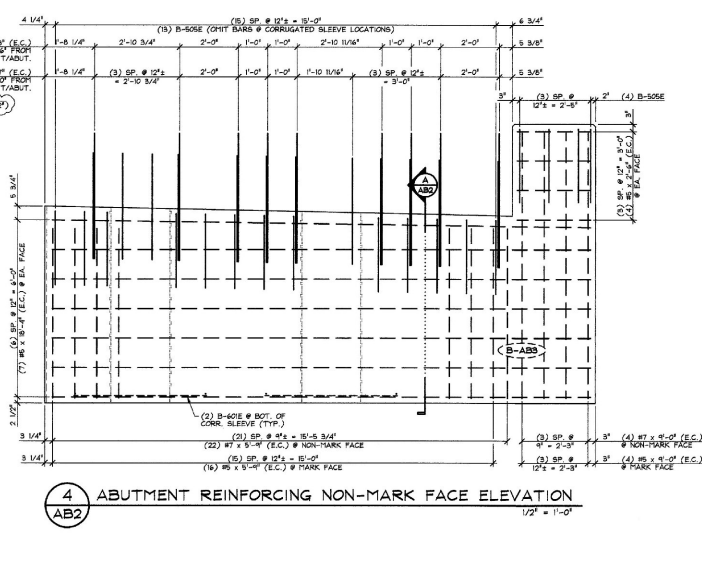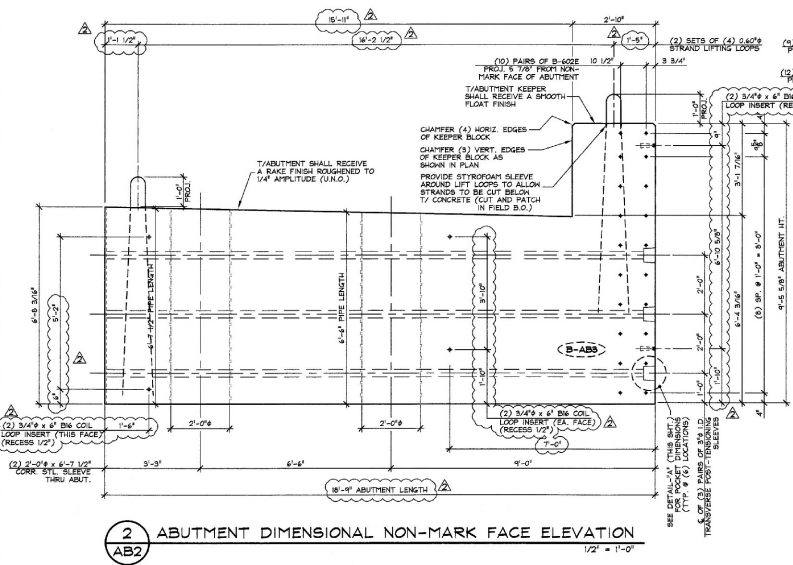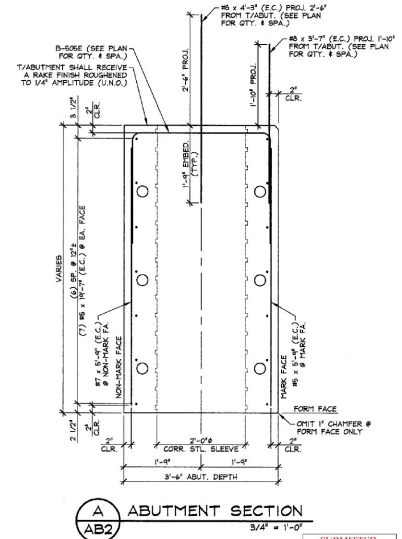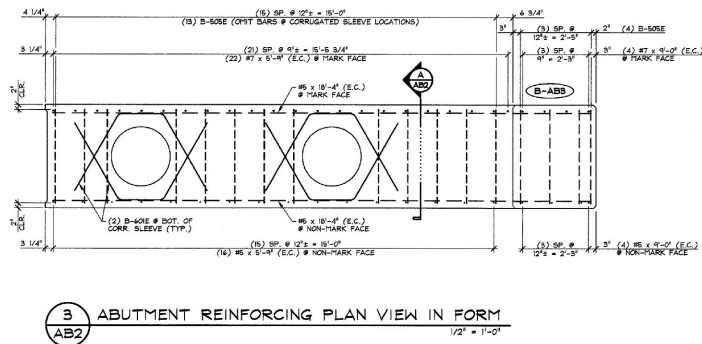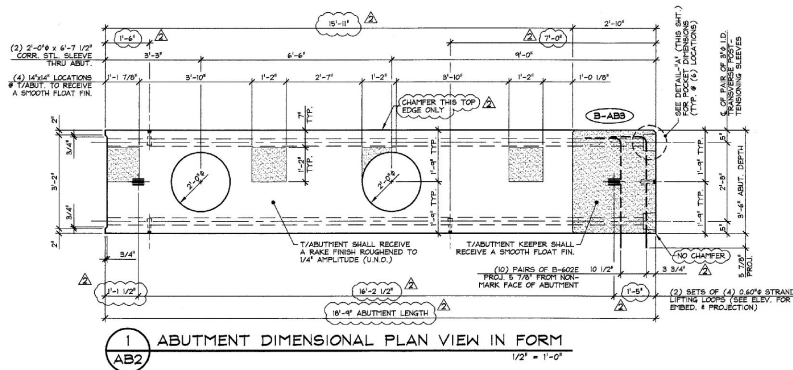

SHOP NOTE:
ALL EDGES OF ABUTMENT SHALL
RECEIVE A 1\"/>

Vermont Agency of Transportation
RECEIVED
CK'D BY WDL OK'D BY JTS
January 9th, 2013
RESUBMIT BY KMH APPROVED X
DATE 1-10-13

J.P. CARRARA & SONS INC. Precast & Prestress Manufacturer 244 ONE ST. WASHINGTON, VERMONT 05759 Phone: (802) 388-6381 Fax: (802) 388-6010		J.A. McDONALD, INC. CONTRACTOR LYNDON CENTER, VERMONT	
STATE OF VERMONT AGENCY OF TRANSPORTATION COUNTY OF ESSEX		DATE: OCT. 30, 2012 SCALE: NOTED	
TOWN OF BRIGHTON ROUTE NO. VT 105, MINOR ARTERIAL BRIDGE NO. 84 PROJECT NO. 1 ER STP 084-3(25)		CHKD: B.C. DTM: B.L. JOB NO: 23384-012	
PRECAST ABUTMENT DETAILS		DWG. NO: AB2	

SUBMITTED


JAN 9 2013

J.P. CARRARA & SONS, INC.
MIDDLEBURY, VT 05753


MARK: B-AB55 QTY.: 1 WT.: 31.15 T VOL.: 15.38 cy

MATERIAL LIST / ABUTMENT


ITEM	MARK	DESCRIPTION	QTY.
1	B-50SE	#5 BENT BAR (EPOXY COATED)	17
2		#5 x 2'-4" (EPOXY COATED)	8
3		#5 x 5'-4" (EPOXY COATED)	16
4		#6 x 4'-0" (EPOXY COATED)	4
5		#5 x 10'-4" (EPOXY COATED)	14
6			
7	B-60SE	#6 BENT BAR (EPOXY COATED)	7
8	B-60SE	#6 BENT BAR (EPOXY COATED)	20
9			
10		#7 x 5'-4" (EPOXY COATED)	22
11		#7 x 4'-0" (EPOXY COATED)	4
12			
13		#6 x 9'-7" (EPOXY COATED)	12
14		#6 x 4'-3" (EPOXY COATED)	4
15		3/4" x 6" B16 GCL INSERT (ELECTRO-PLATED FINISH)	6
16		2'-0" x 6'-1" 1/2" CORRUGATED STEEL PIPE (GALV.)	1
17		2'-0" x 6'-1" CORRUGATED STEEL PIPE (GALV.)	1
18		SET OF (4) 3/64" x 270 KS STRAND LIFTING LOOPS	2
19			
20			

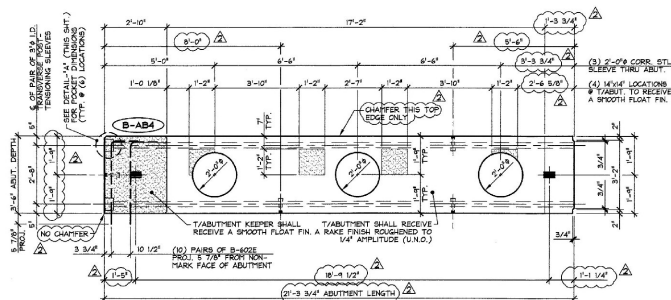

1 ABUTMENT DIMENSIONAL PLAN VIEW IN FORM
3/8" = 1'-0"

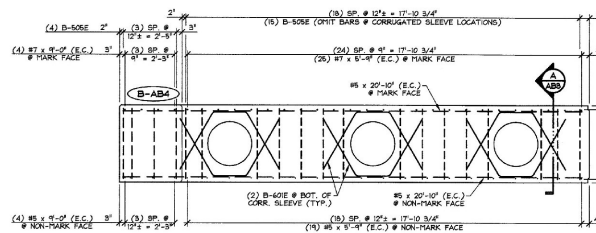


4 ABUTMENT REINFORCING PLAN VIEW IN FORM
3/8" = 1'-0"

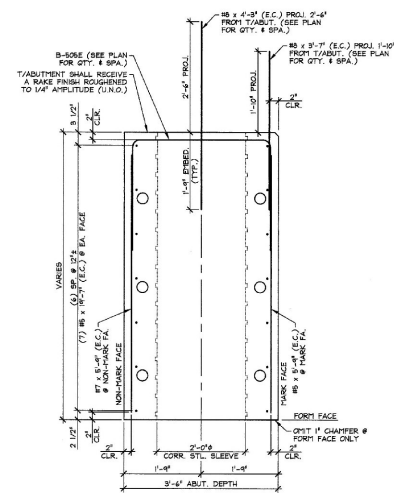

A ABUTMENT SECTION
3/8" = 1'-0"

SUBMITTED
JAN 9 2013
J.P. CARRARA & SONS, INC.
MIDDLEBURY, VT 05753


MATERIAL LIST / ABUTMENT				
ITEM	MARK	DESCRIPTION	QTY.	
1	B-AB4	#6 BENT BAR (EPOXY COATED)	19	
2	B-AB4	#6 x 2'-6" (EPOXY COATED)	8	
3	B-AB4	#6 x 8'-0" (EPOXY COATED)	19	
4	B-AB4	#6 x 4'-0" (EPOXY COATED)	4	
5	B-AB4	#6 x 20'-0" (EPOXY COATED)	14	
6	B-AB4	#6 BENT BAR (EPOXY COATED)	5	
7	B-AB4	#6 BENT BAR (EPOXY COATED)	20	
8	B-AB4	#7 x 4'-0" (EPOXY COATED)	25	
9	B-AB4	#7 x 4'-0" (EPOXY COATED)	4	
10	B-AB4	#7 x 4'-0" (EPOXY COATED)	25	
11	B-AB4	#7 x 4'-0" (EPOXY COATED)	4	
12	B-AB4	#7 x 4'-0" (EPOXY COATED)	25	
13	B-AB4	#7 x 4'-0" (EPOXY COATED)	4	
14	B-AB4	#7 x 4'-0" (EPOXY COATED)	25	
15	B-AB4	#7 x 4'-0" (EPOXY COATED)	4	
16	B-AB4	#7 x 4'-0" (EPOXY COATED)	25	
17	B-AB4	#7 x 4'-0" (EPOXY COATED)	4	
18	B-AB4	#7 x 4'-0" (EPOXY COATED)	25	
19	B-AB4	#7 x 4'-0" (EPOXY COATED)	4	
20	B-AB4	#7 x 4'-0" (EPOXY COATED)	25	
21	B-AB4	#7 x 4'-0" (EPOXY COATED)	4	
22	B-AB4	#7 x 4'-0" (EPOXY COATED)	25	

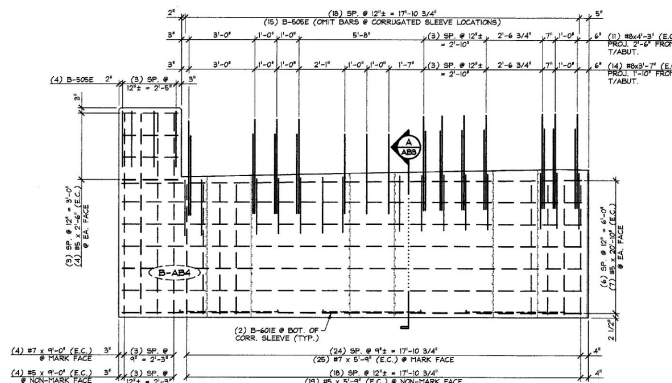

3 ABUTMENT REINFORCING NON-MARK FACE ELEVATION
3/8" = 1'-0"

2 ABUTMENT DIMENSIONAL NON-MARK FACE ELEVATION
3/8" = 1'-0"




SHOP NOTE:
ALL EDGES OF ABUTMENT SHALL
RECEIVE A 1" CHAMFER (U.N.O.)

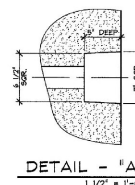

DETAIL - 1/2" = 1'-0"

Vermont Agency of Transportation
RECEIVED
CK'D BY WDL OK'D BY JTS
January 9th, 2013
RESUBMIT BY KMH APPROVED DATE 1-10-13

J.P. CARRARA & SONS, INC.
Precast & Prestress Manufacturer
2040 GLENN ST., MIDDLEBURY, VERMONT 05753 Phone (802) 388-4331 Fax (802) 388-9010
J.A. McDONALD, INC.
CONTRACTOR
LYNDON CENTER, VERMONT
STATE OF VERMONT AGENCY OF TRANSPORTATION
COUNTY OF ESSEX
TOWN OF BRIGHTON
ROUTE NO. VT 105, MINOR ARTERIAL
BRIDGE NO. 84 PROJECT NO. 1 ER STP 034-B(25)
DATE: OCT. 30, 2012
SCALE: NOTED
CHKD: B.C. DFT: B.L.
JOB NO: 23384-012
PRECAST ABUTMENT DETAILS
DWG. NO: AB3

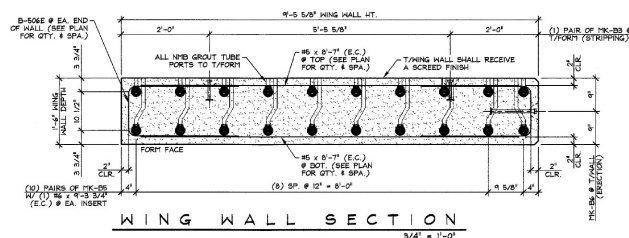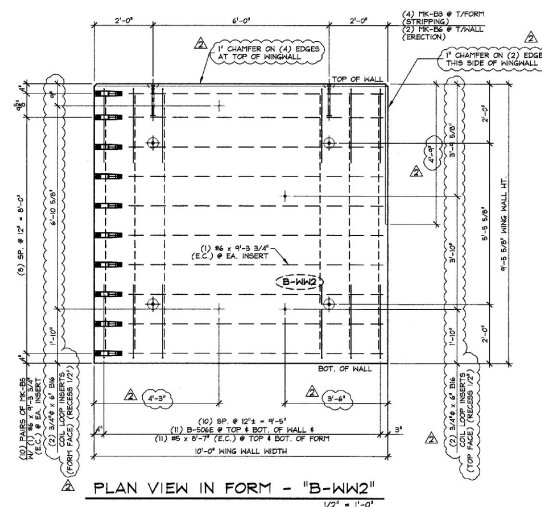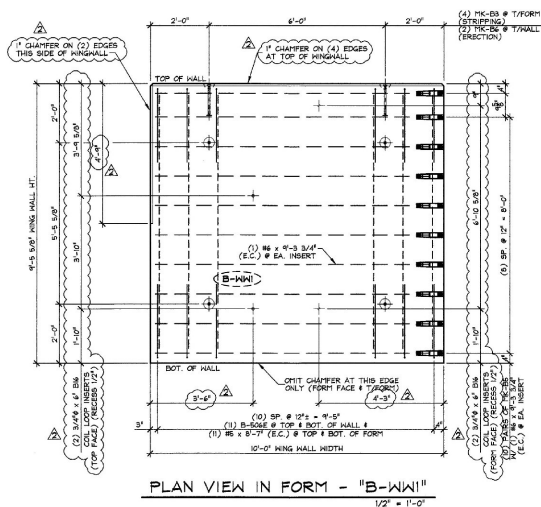

SHOP NOTE:
ALL EDGES OF WING WALLS,
FORM FACE & T/WALL FACE,
SHALL RECEIVE A 1" CHAMFER
(UNLESS NOTED OTHERWISE)

1-3-13 REVISED AS NOTED
2-10-12 REVISED AS NOTED



Vermont Agency of Transportation
RECEIVED
CK'D BY WDL OK'D BY JTS
January 9th, 2013
RESUBMIT APPROVED X
BY KMH DATE 1-10-13

SUBMITTED
JAN 9 2013
J.P. CARRARA & SONS, INC.
MIDDLEBURY, VT 05753

MARK: B-WW1	QTY: 2	WT: 10.65 T	VOL: 5.26 cy
MARK: B-WW2	QTY: 2	WT: 10.65 T	VOL: 5.26 cy
MARK: B-WW3	QTY: 0	WT: -	VOL: -
MARK: B-WW4	QTY: 0	WT: -	VOL: -

MATERIAL LIST / WING WALL			
ITEM	MARK	DESCRIPTION	QTY./WING WALL
1	B-WW1	#6 BENT BAR (EPOXY COATED)	22 22
2		#6 x 8'-0" (EPOXY COATED)	22 22
3		#6 x 8'-0" (EPOXY COATED)	20 20
4		#6 x 9'-3 3/4" (EPOXY COATED)	20 20
5		#6 x 9'-3 3/4" (EPOXY COATED)	20 20
6		#6 x 9'-3 3/4" (EPOXY COATED)	20 20
7		#6 x 9'-3 3/4" (EPOXY COATED)	20 20
8		#6 x 9'-3 3/4" (EPOXY COATED)	20 20
9		#6 x 9'-3 3/4" (EPOXY COATED)	20 20
10		#6 x 9'-3 3/4" (EPOXY COATED)	20 20

J.P. CARRARA & SONS INC. Precast & Prestress Manufacturer 244 ONE ST. WOODBURY, VERMONT 05793 Phone: (802) 388-4381 Fax: (802) 388-4910		J.A. McDONALD, INC. CONTRACTOR LYNDON CENTER, VERMONT	
STATE OF VERMONT AGENCY OF TRANSPORTATION COUNTY OF ESSEX		DATE: OCT. 30, 2012 SCALE: NOTED	
TOWN OF BRIGHTON ROUTE NO. VT 105, MINOR ARTERIAL BRIDGE NO.: 84 PROJECT NO.: ER STP 084-3(25)		CHKD: B.C. DFTW: B.L. JOB NO.: 28384-012	
PRECAST WING WALL DETAILS		DWG. NO: WW1	

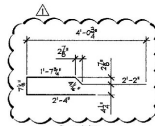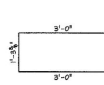

PRESTRESSED NEXT BEAMS




PRECAST APPROACH SLABS



PRECAST ABUTMENTS



PRECAST WING WALLS

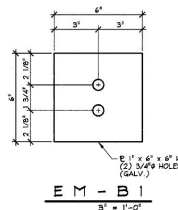

MISCELLANEOUS MATERIALS				
ITEM	MARK	QTY.	DESCRIPTION	REMARKS
1		72	84 x 7-7" (EPOXY COATED)	
2				
3			85 x 7-7" (EPOXY COATED)	
4		80	85 x 72-4" (4" (3) 3'-0" STAGGERED LAPS) (EPOXY COATED)	
5				
6	PK-B1	837	85 x 4'-1" HRC 555 HEADED REBAR	EPOXY COATED
7				
8		18	GUARD RAIL ANCHOR PLATE (GALV.)	SUPPLIED BY OTHERS
9		16	SET OF (4) 0.60" x 270 KSI STRAND LIFTING LOOPS	
10		58	1/2" x 5" 816 COIL INSERTS (ELECTRO-PLATE FINISH)	
11		64	86 x 18-8" (EPOXY COATED)	
12				
13				
14	PK-B2	156	85 x 8'-0" HRC 555 DOUBLE-HEADED REBAR	EPOXY COATED
15	PK-B3	32	47 x 5 1/2" SNIFF LIFT LIFTER	
16	PK-B4	86	85 x 7-7" HRC 555 HEADED REBAR	EPOXY COATED
17				
18				
19				
20				
21		32	85 x 2'-4" (EPOXY COATED)	
22		72	85 x 3'-4" (EPOXY COATED)	
23		16	85 x 9'-0" (EPOXY COATED)	
24		28	85 x 18'-4" (EPOXY COATED)	
25		28	85 x 20'-10" (EPOXY COATED)	
26				
27		94	87 x 5'-8" (EPOXY COATED)	
28		14	87 x 9'-0" (EPOXY COATED)	
29				
30		52	88 x 3'-7" (EPOXY COATED)	
31		40	88 x 4'-3" (EPOXY COATED)	
32				
33		8	SET OF (4) 0.60" x 270 KSI STRAND LIFTING LOOPS	
34				
35		2	2'-0" x 6'-7 1/2" CORRUGATED STEEL PIPE (GALV.)	
36		2	2'-0" x 6'-4" CORRUGATED STEEL PIPE (GALV.)	
37		2	2'-0" x 6'-5" CORRUGATED STEEL PIPE (GALV.)	
38		2	2'-0" x 6'-6 3/4" CORRUGATED STEEL PIPE (GALV.)	
39		2	2'-0" x 6'-8 1/4" CORRUGATED STEEL PIPE (GALV.)	
40				
41	BT-B	24	8" x 8" x 8" W/ (2) 3/4" HOLES (GALV.)	FOR ERECTION SEE DETAIL THIS SHEET
42		24	42-1/4" HIGH PUSH-STRAP	FOR ERECTION
43		48	1/2" SINGLE USE STRESSING CHUCK	FOR ERECTION
44		12	COMPRESSIBLE SEALER GEL ADHESIVE	FOR ERECTION
45		32	3/4" x 6" 516 COIL INSERTS (ELECTRO-PLATE FINISH)	
46		80	85 x 8'-7" (EPOXY COATED)	
47				
48		80	86 x 9'-3 3/4" (EPOXY COATED)	
49				
50	PK-B5	16	47 x 5 1/2" SNIFF LIFT LIFTER	
51	PK-B6	80	NHS SPICE SLURVE 410-X(PC) (EPOXY COATED) W/ GROUT TUBES	GROUT TUBE LENGTH AS REQ'D.
52		8	8" x 10 3/8" SNIFF LIFT LIFTER	
53		8	3/4" x 9" 816 COIL INSERTS (ELECTRO-PLATE FINISH)	
54				
55				

Vermont Agency of Transportation
RECEIVED
CK'D BY WDL OK'D BY JTS
January 9th, 2013
RESUBMIT APPROVED X
BY KMH DATE 1-10-13

1-3-13 REVISED AS NOTED
 12-10-12 REVISED AS NOTED

J.P. CARRARA & SONS INC.
Precast & Prestress Manufacturer
2484 OISE ST., WOODBURY, VERMONT 05753 Phone:(802)388-6361 Fax:(802)388-9010

J.A. McDONALD, INC.
CONTRACTOR
LYNDON CENTER, VERMONT

STATE OF VERMONT AGENCY OF TRANSPORTATION
COUNTY OF ESSEX

IN	DATE: OCT. 30, 2012
	SCALE: NOTED

TOWN OF BRIGHTON
ROUTE NO. VT 105, MINOR ARTERIAL
BRIDGE NO.: 84 PROJECT NO.: ER STP 034-3(25)

CHKD: B.C.	DFTM: B.L.
JOB NO: 23384-012	

MATERIALS LIST

DWG. NO: M1