

GENERAL FABRICATION SHEET

1103 -- Page #: 2

Part of

Project #: 38760-1103-1 (100F16)

customer: JA McDONALD (PD#10912)

County: ESSEX

State: VT

Structure: BRIDGE 84

Pad I.D./Loc.: —

Quantity (Including Full Size Sample(s) - If Req'd): 16

Certifications Are Required

Testing Req'd: ☐ YES, see below ☒ NO, random in-house only

Sample Req'd: ☐ YES - (If not full size, create another sheet) ☒ NO


State D.O.T. Spec. Number (If Specified): —

Project # (req'd for cert.s) ER STP 034-3(25)


Special Notes:

General Product Name: ADJUSTMENT SHIMS

Product Specification: A709 GR 36 A123-HDQ

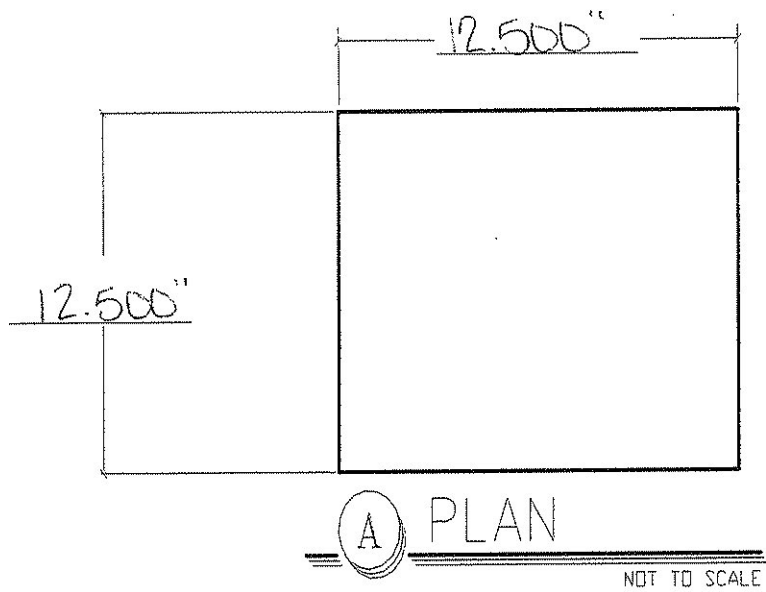

Vermont Agency of Transportation
RECEIVED
CK'D BY JTS OK'D BY WDL
December 6, 2012
RESUBMIT BY KMH APPROVED X DATE 12-20-12

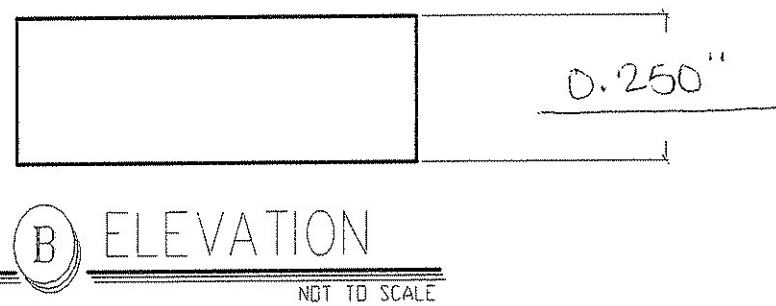

Name: Nathan Davis Date: 12-5-12