



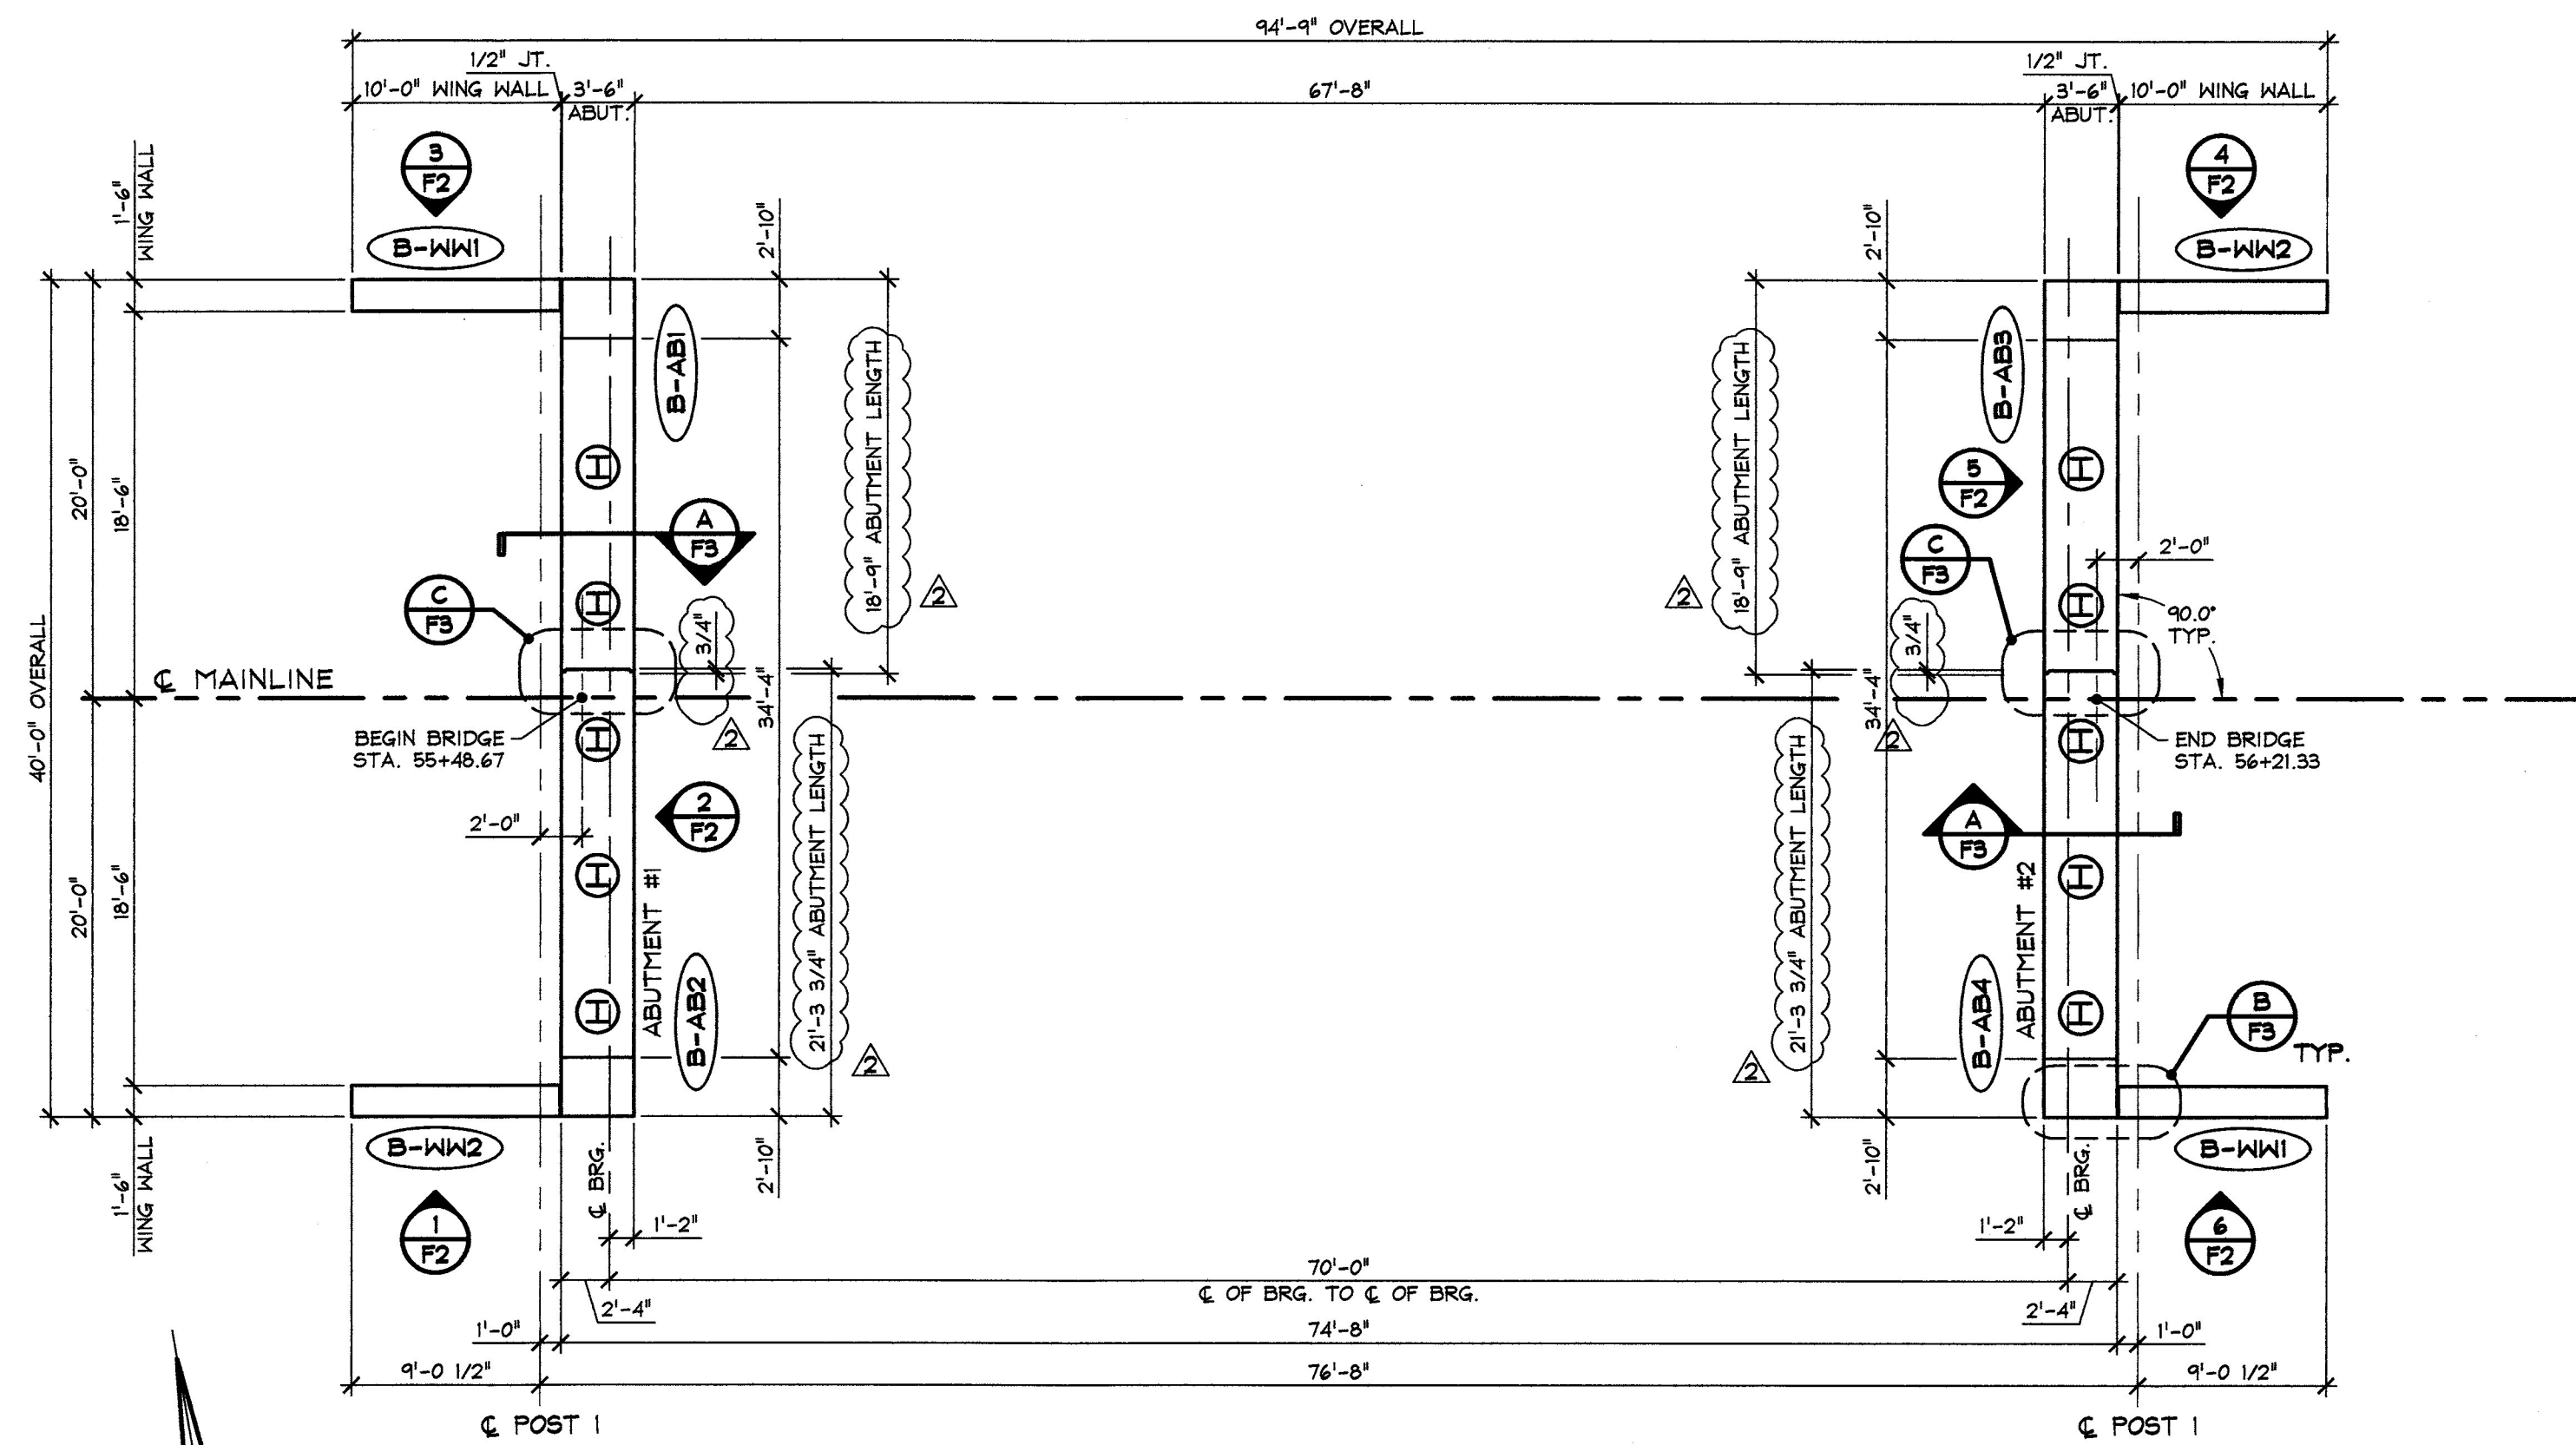

1 PRECAST CONCRETE ABUTMENT & WING WALL LAYOUT
1/8" = 1'-0"

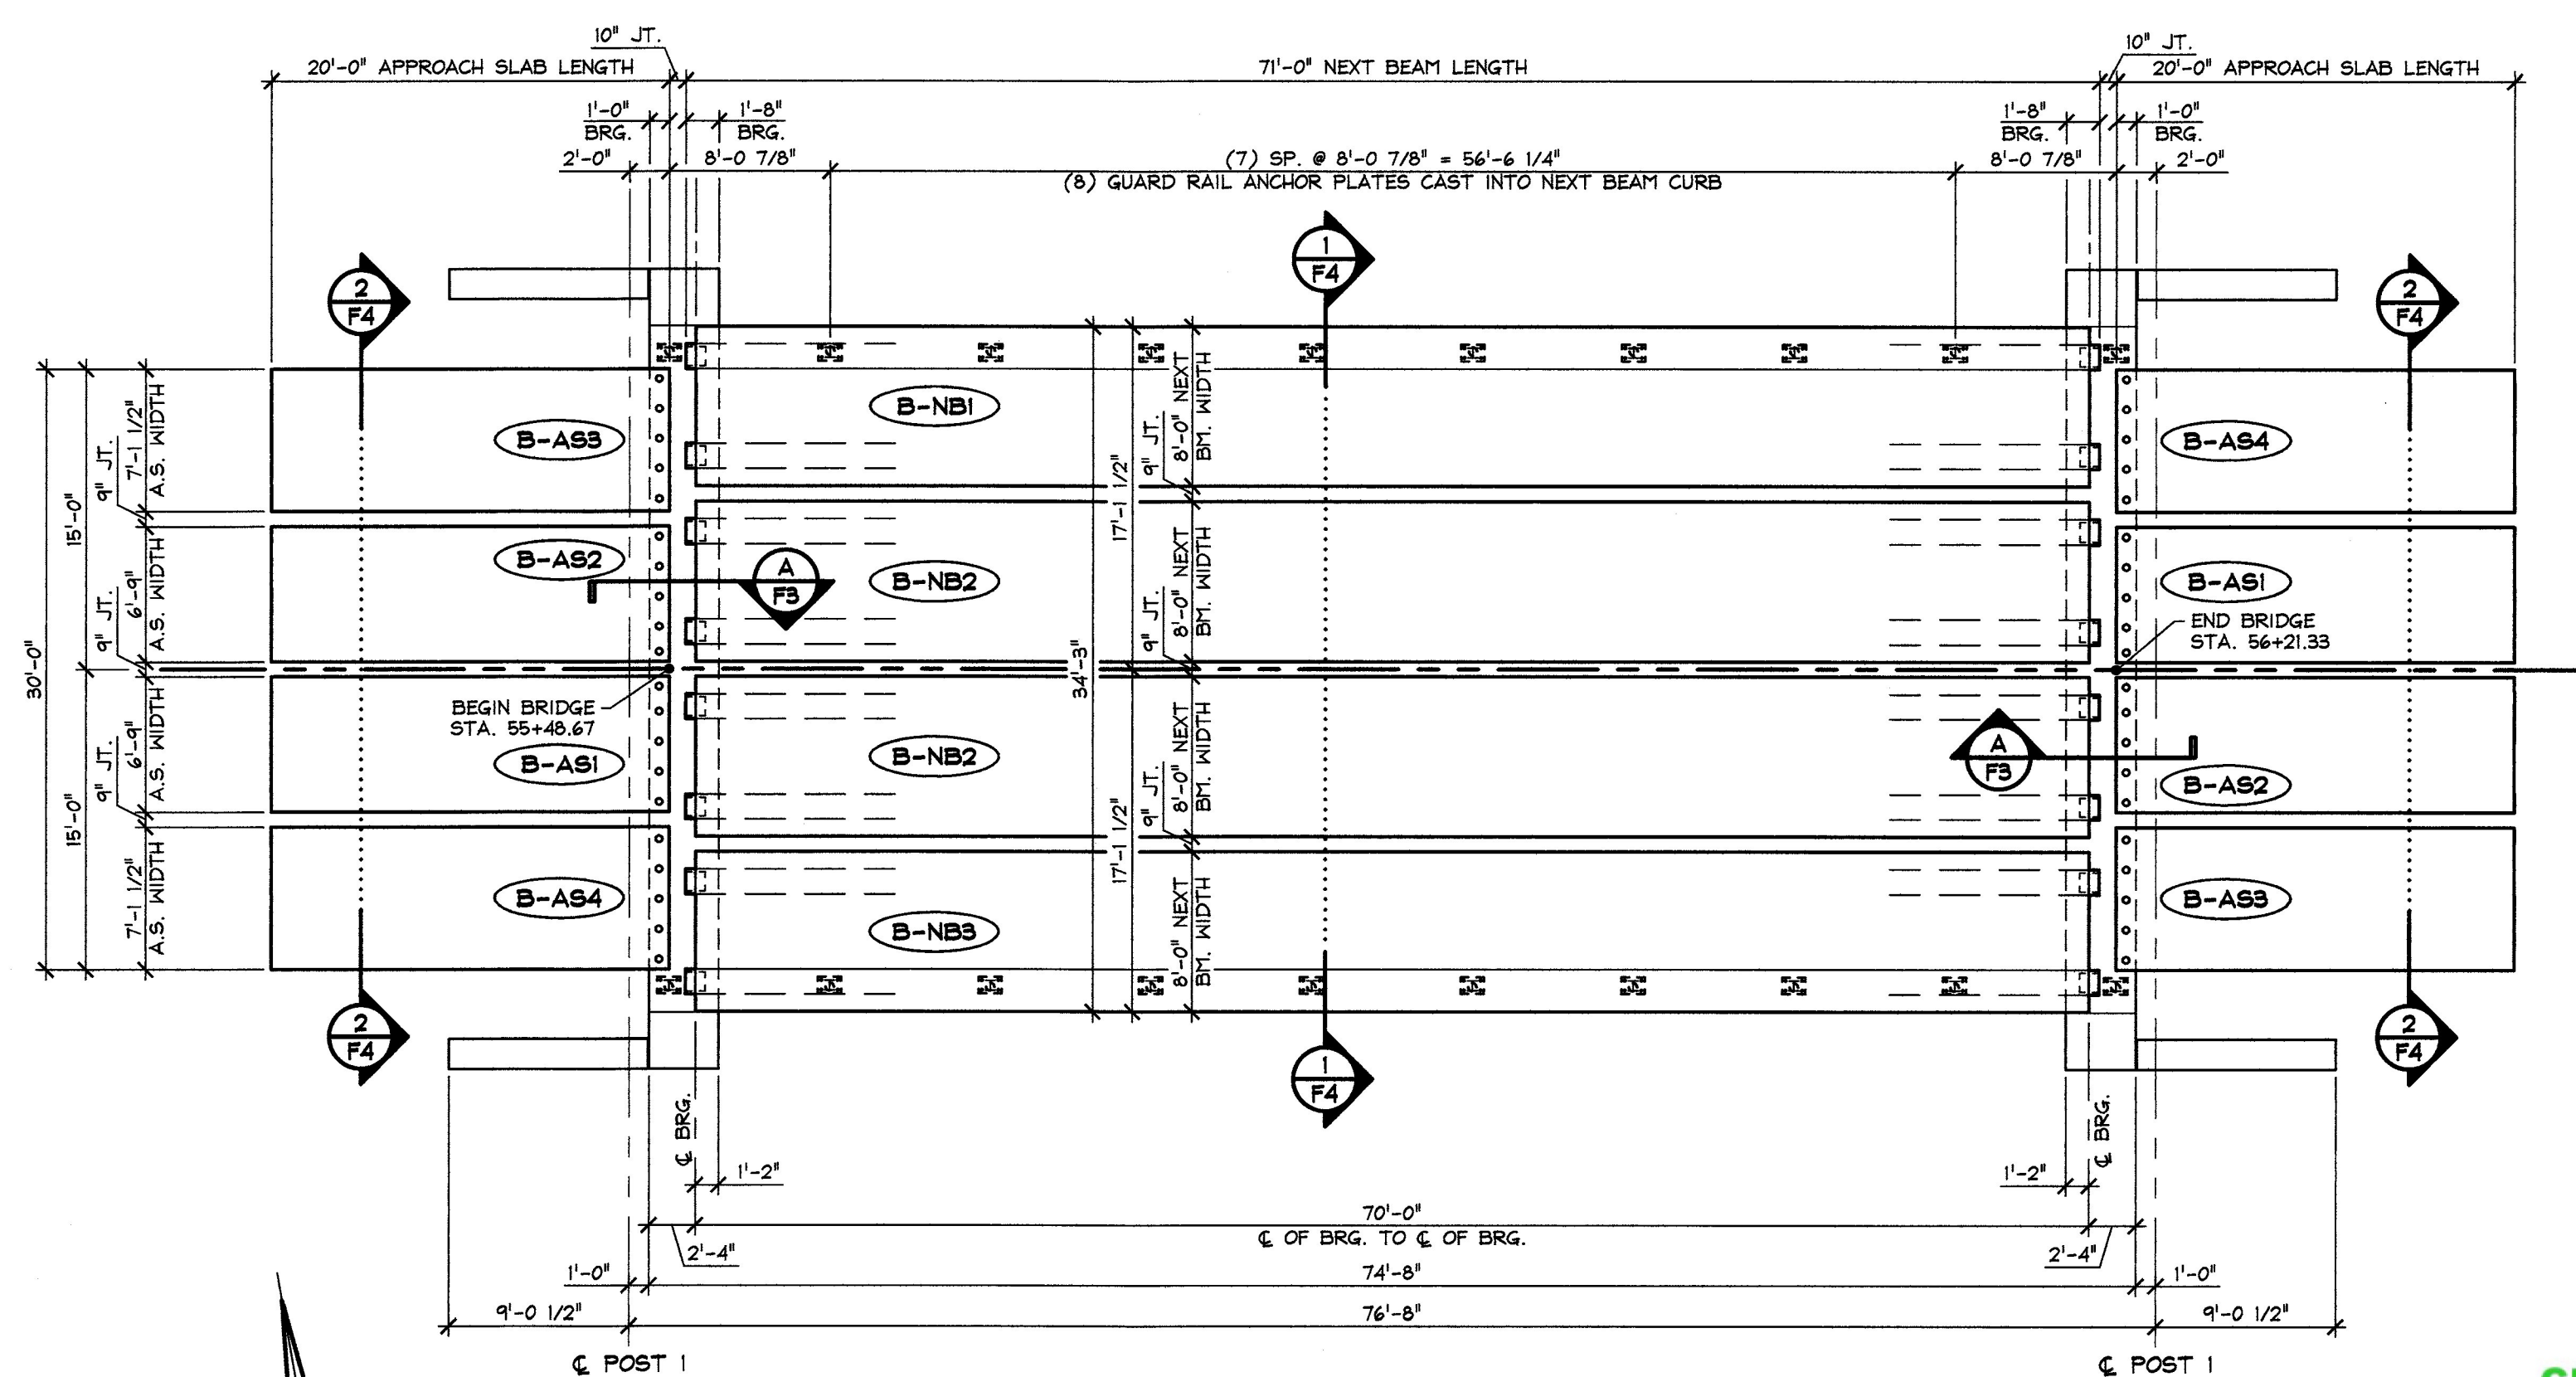

2 PRESTRESSED APPROACH SLAB & NEXT BEAM LAYOUT
1/8" = 1'-0"

1-3-13 REVISED AS NOTED
12-10-12 REVISE ABUTMENT #1 & WING WALL PIECE NUMBERS

Vermont Agency of Transportation
RECEIVED
CK'D BY WDL OK'D BY JTS
January 9th, 2013
RESUBMIT BY KMH APPROVED DATE 1-10-13

J.P. CARRARA & SONS INC. Precast & Prestress Manufacturer 2464 CASE ST., MIDDLEBURY, VERMONT 05753 Phone: (802)388-6361 Fax: (802)388-9010		J.A. McDONALD, INC. CONTRACTOR LYNDON CENTER, VERMONT	
STATE OF VERMONT AGENCY OF TRANSPORTATION COUNTY OF ESSEX		DATE: OCT. 30, 2012 SCALE: NOTED	
TOWN OF BRIGHTON ROUTE NO. VT 105, MINOR ARTERIAL BRIDGE NO.: 84 PROJECT NO.: ER STP 034-3(25)		CHKD: B.C.	DFTM: B.L.
SUPERSTRUCTURE PLANS		JOB NO: 23384-012	DWG. NO: F1

SUBMITTED
JAN 9 2013
J.P. CARRARA & SONS, INC.
MIDDLEBURY, VT 05753