
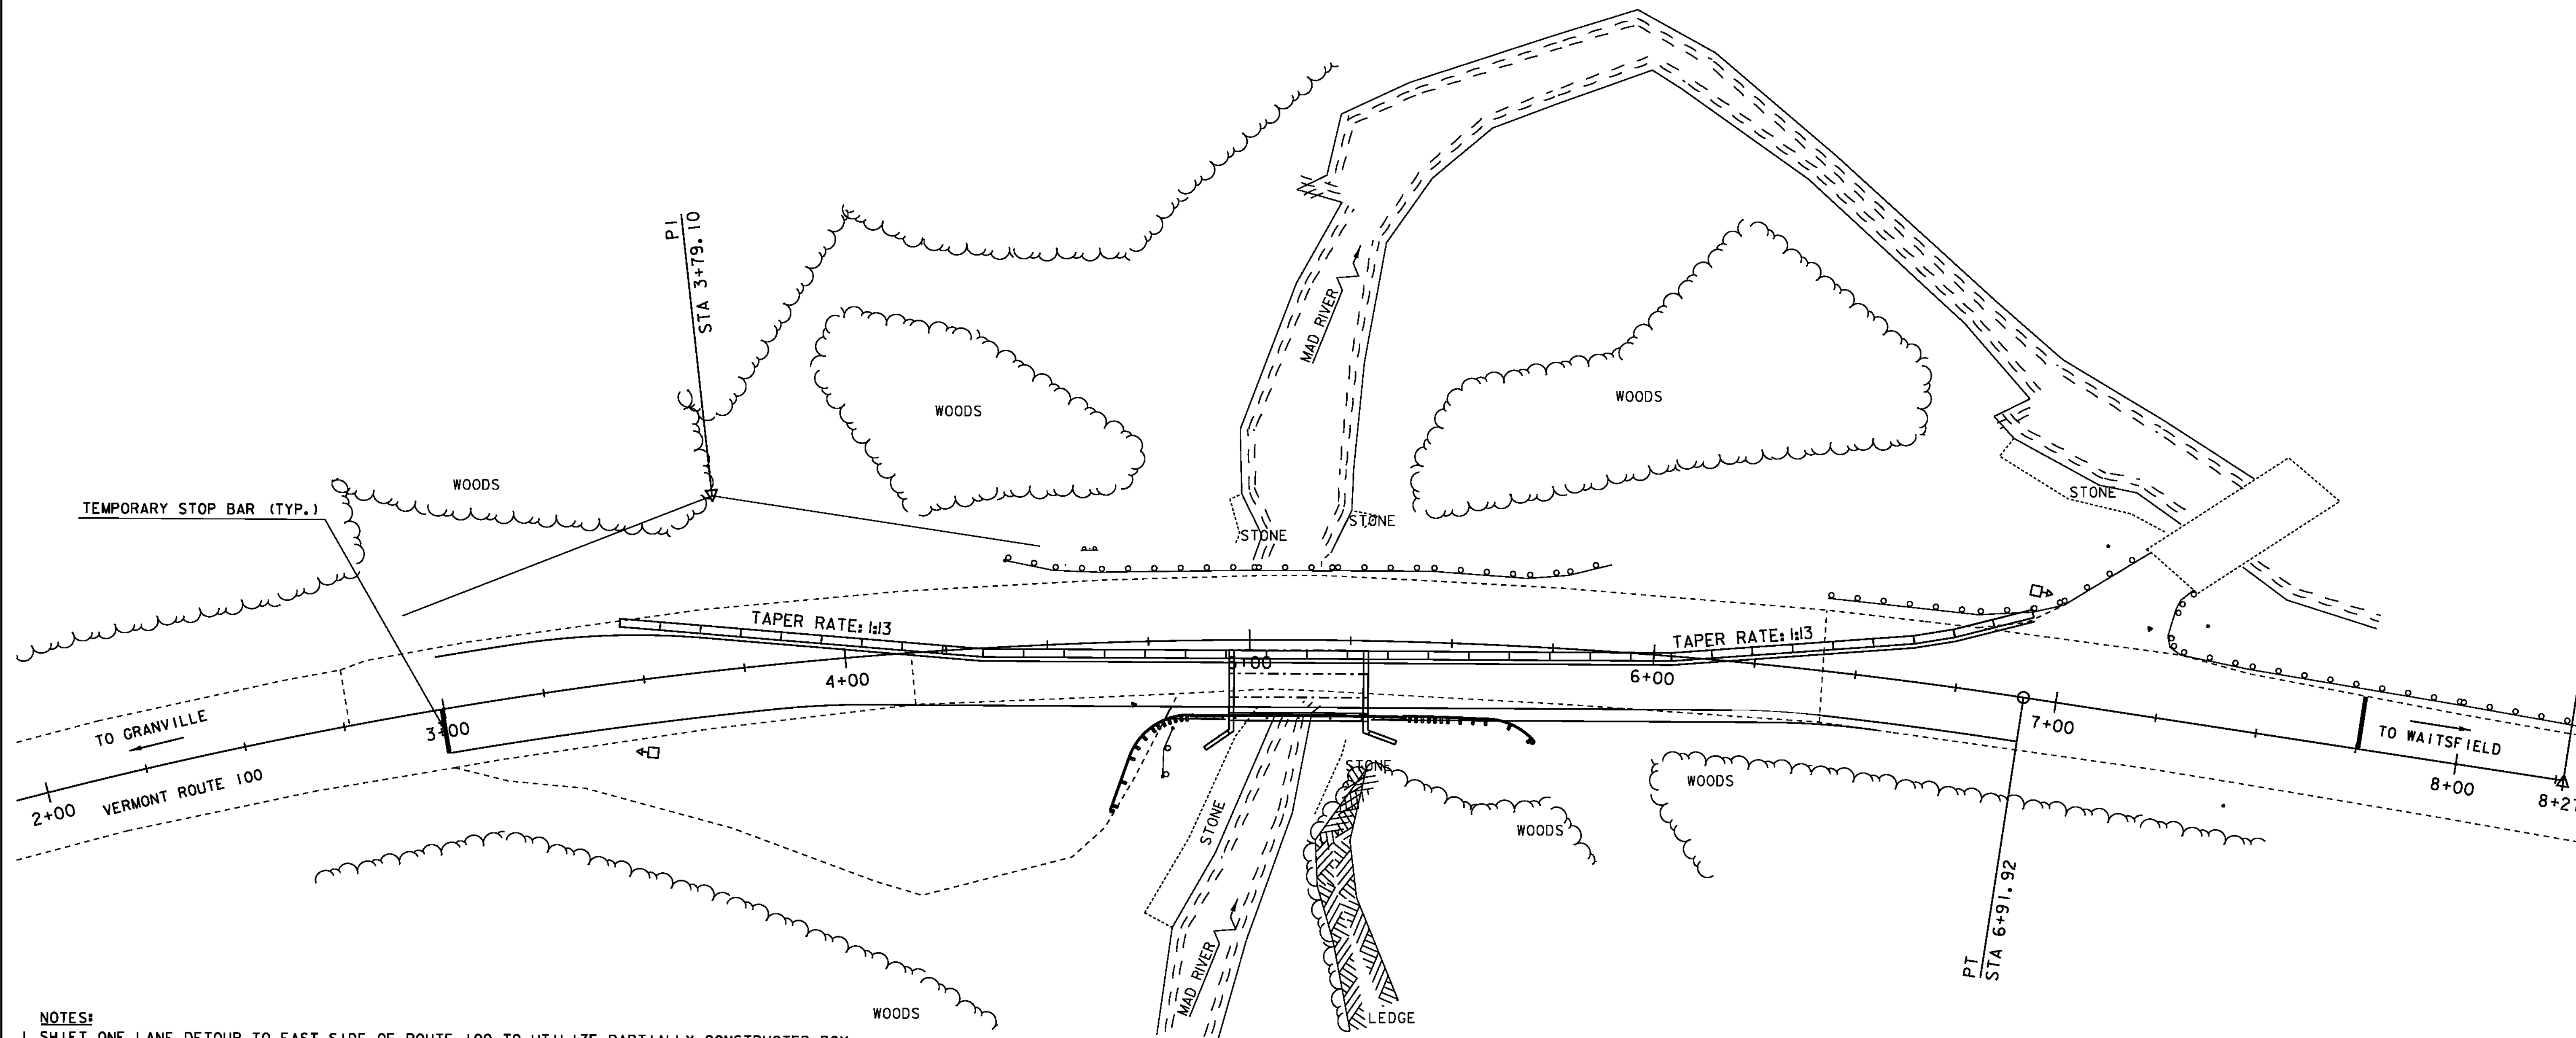


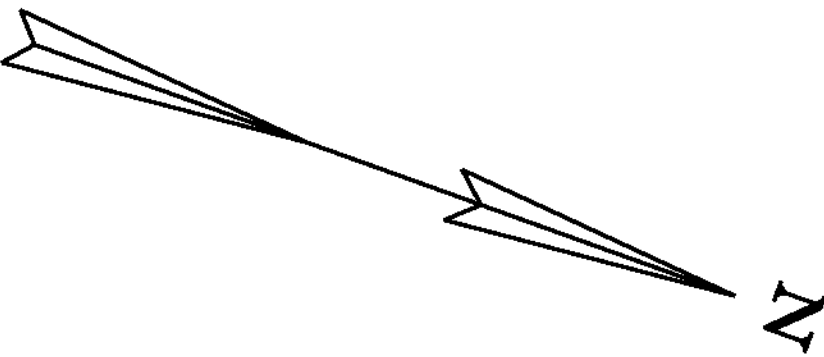

NOTES:

1. SHIFT ONE LANE DETOUR TO EAST SIDE OF ROUTE 100 TO UTILIZE PARTIALLY CONSTRUCTED BOX.
2. INSTALL TEMPORARY SHORING AS REQUIRED TO EXCAVATE AND CONSTRUCT REMAINING FOOTING, STEM, AND RIGID FRAME.
3. CONTRACTOR SHALL INSTALL AND MAINTAIN APPROPRIATE TRAFFIC CONTROL DEVICES IN ACCORDANCE WITH THE 2009 MANUAL ON UNIFORM TRAFFIC CONTROL DEVICES (MUTCD) AND STANDARD E-SERIES DRAWINGS.

LEGEND

- TEMPORARY TRAFFIC BARRIER
- TEMPORARY TRAFFIC SIGNAL

DATUM
VERTICAL ASSUMED
HORIZONTAL ASSUMED

SCALE 1" = 20'-0"
20 0 20

**DuBois
& King**

**PHASE 2
PHASING
PLAN
SHEET**

PROJECT NAME: WARREN
PROJECT NUMBER: ER-STP 013-4 (36)

FILE NAME:
PROJECT LEADER: JWT
DESIGNED BY: RHB
PLOT FILE:

PLOT DATE: 11/7/2011
DRAWN BY: BMB
CHECKED BY: EPD
SHEET 15 OF 19