



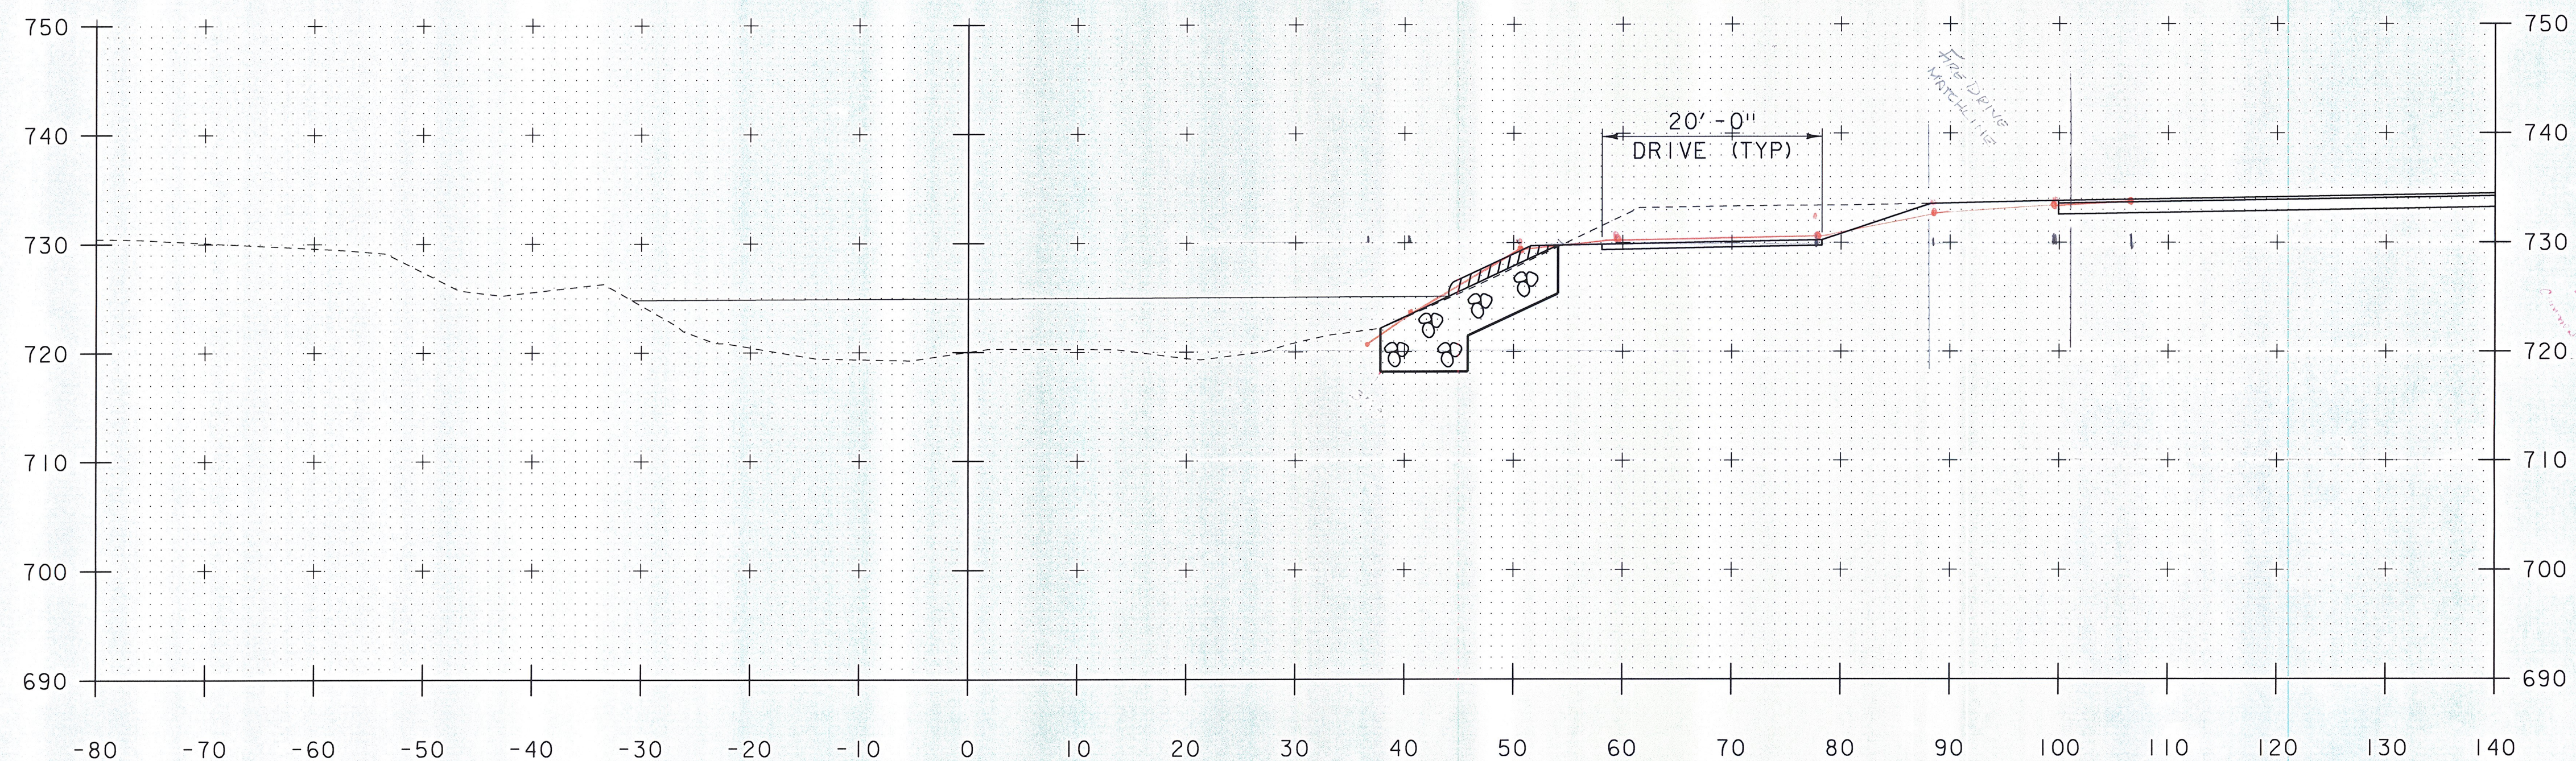

11+75

CSG 3/28/14

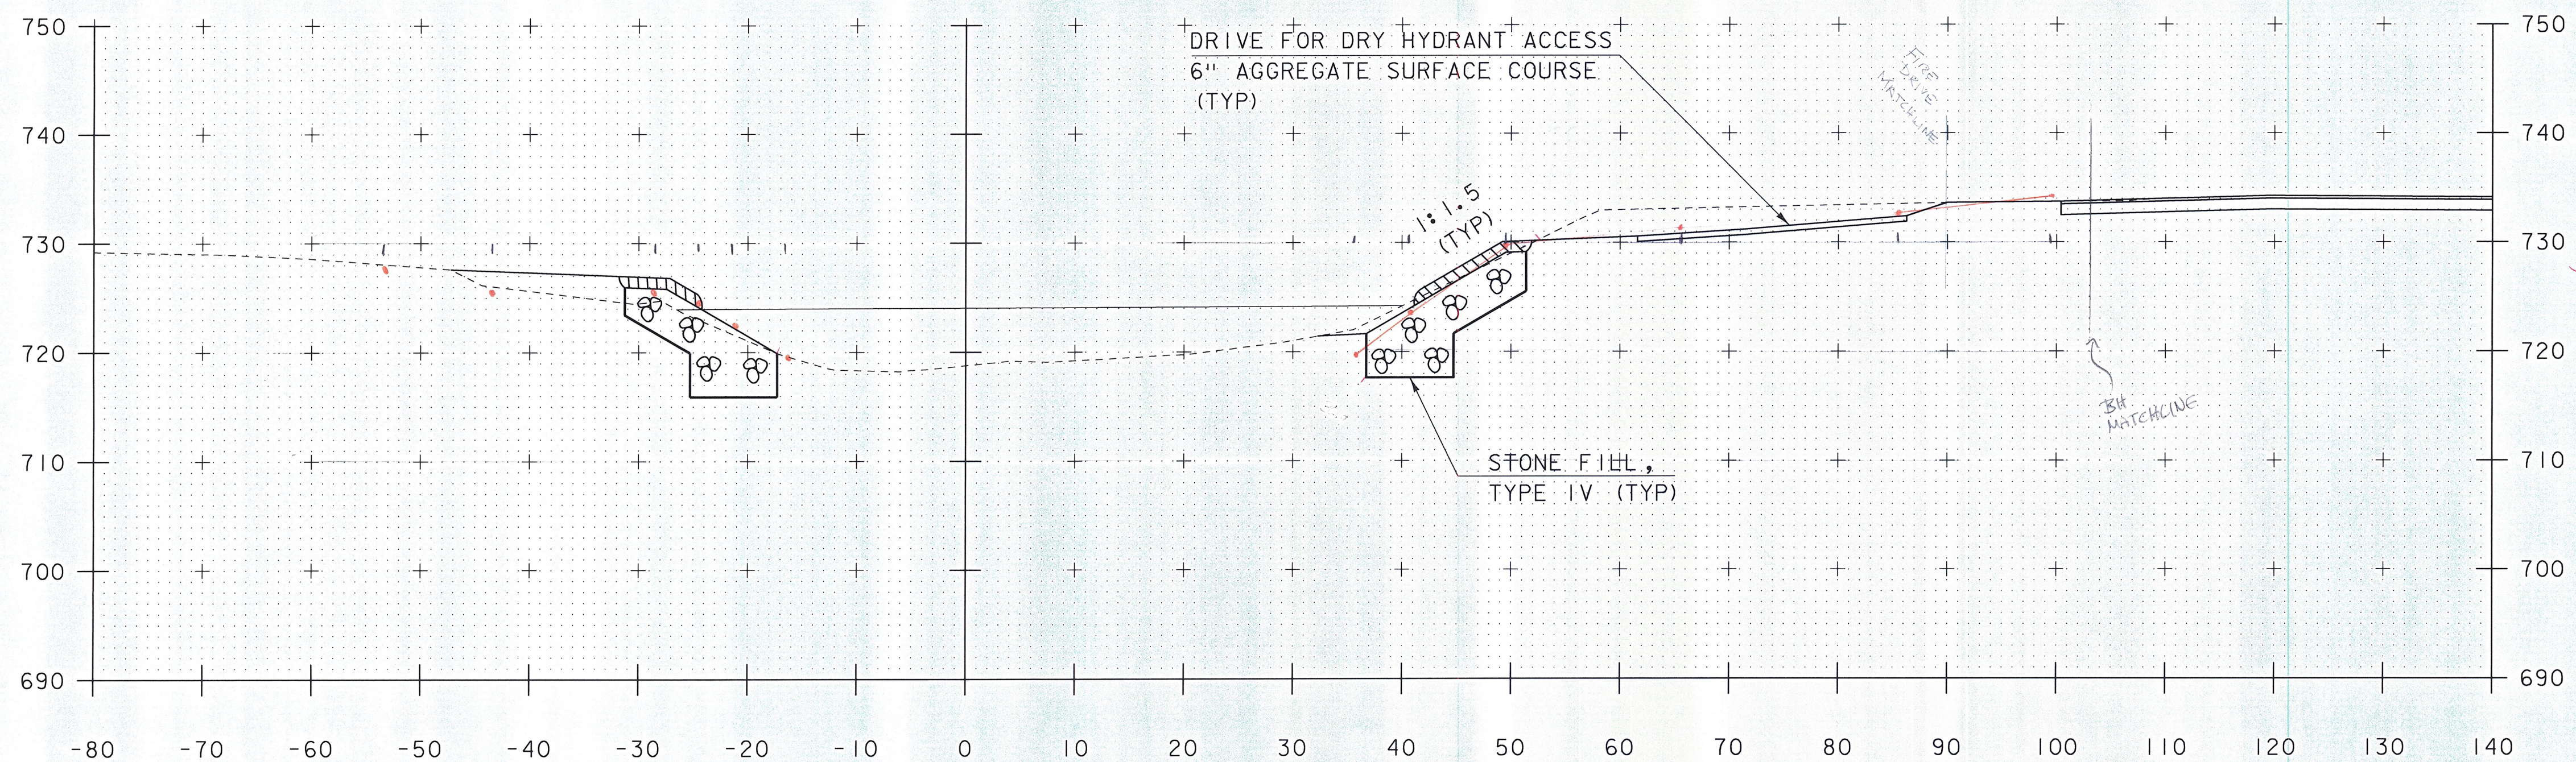

11+50

STA 11+55.00 LT
END UNCLASSIFIED CHANNEL EXCAVATION
END GEOTEXTILE UNDER STONE FILL
END STONE FILL, TYPE IV
END GRUBBING MATERIAL

SCALE 1" = 10'-0"
10 0 10

PROJECT NAME: 11
PROJECT NUMBER (TYP)
FILE NAME: s11b316
PROJECT LEADER:
DESIGNED BY:
CHANNEL SECTION:

STA. 11+50 TO STA. 11+75

PROJECT N
PROJECT N
FILE NAME:
PROJECT L
DESIGNED E
CHANNEL S

STA. 11+50 TO STA. 11+75