


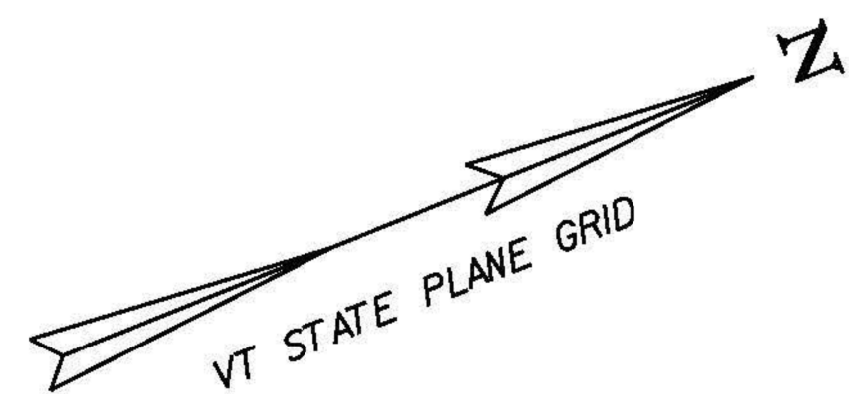

STEEL BEAM GUARDRAIL, GALVANIZED  
STA. 28+85, RT. - STA. 74+53, RT. (225') STA 76+00 RT  
STA. 70+50, LT. - STA. 31+00, LT. (285')

MANUFACTURED TERMINAL SECTION, FLARED  
STA. 28+47, RT. - STA. 28+85, RT.  
STA. 31+00, LT. - STA. 31+38, LT.  
STA 75+75 LT ~ STA 76+12.5 LT

REMOVAL OF EXISTING CURB  
STA. 28+19, LT. - STA. 29+33, RT.

MATCH LINE STA 70+50

MATCH LINE STA 76+00

BERLIN STATE HIGHWAY 95+06.60 =  
VT ROUTE 62 STA. 73+06.60, 24.75 LT.

VT ROUTE 62 STA. 72+95.00 =  
AIRPORT RD./FISHER RD. STA. 30+00.00

MOVED UP STATION 12 LF  
DUE TO DRAINAGE ISSUE  
AND OVERHEAD POWER LINES ISSUE

NOTE:  
REMOVE EXISTING SLOPED GRANITE CURBING  
AND SALVAGE TO DISTRICT 6 GARAGE.  
CONTACT TOM ANDERSON AT 802-828-2687

0 20 40  
SCALE IN FEET

|                 |                |             |            |
|-----------------|----------------|-------------|------------|
| PROJECT NAME:   | BERLIN         | PLOT DATE:  | 10/20/2014 |
| PROJECT NUMBER: | STPG SGNL(40)  | DRAWN BY:   | T. SISSON  |
| FILE NAME:      | t1lb358bdr.dgn | CHECKED BY: | M. LACROIX |
| DESIGNED BY:    | T. SISSON      | SHEET       | 23 OF 123  |
| PLAN SHEET 2    |                |             |            |