



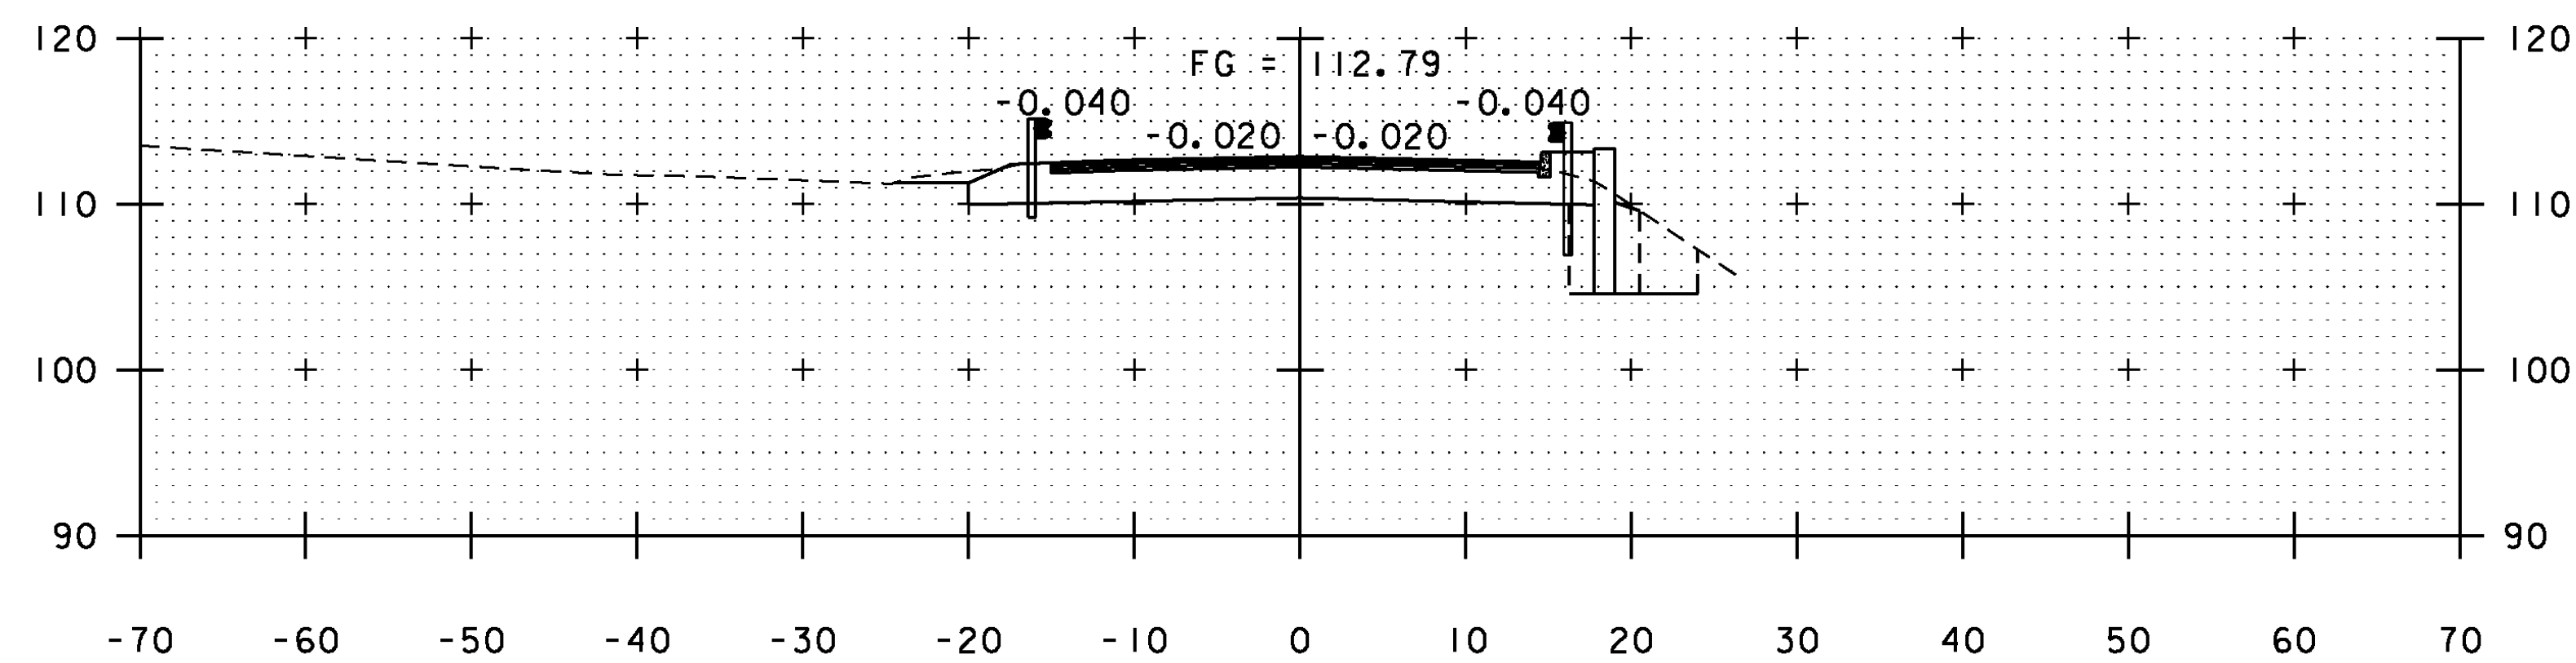


11+60

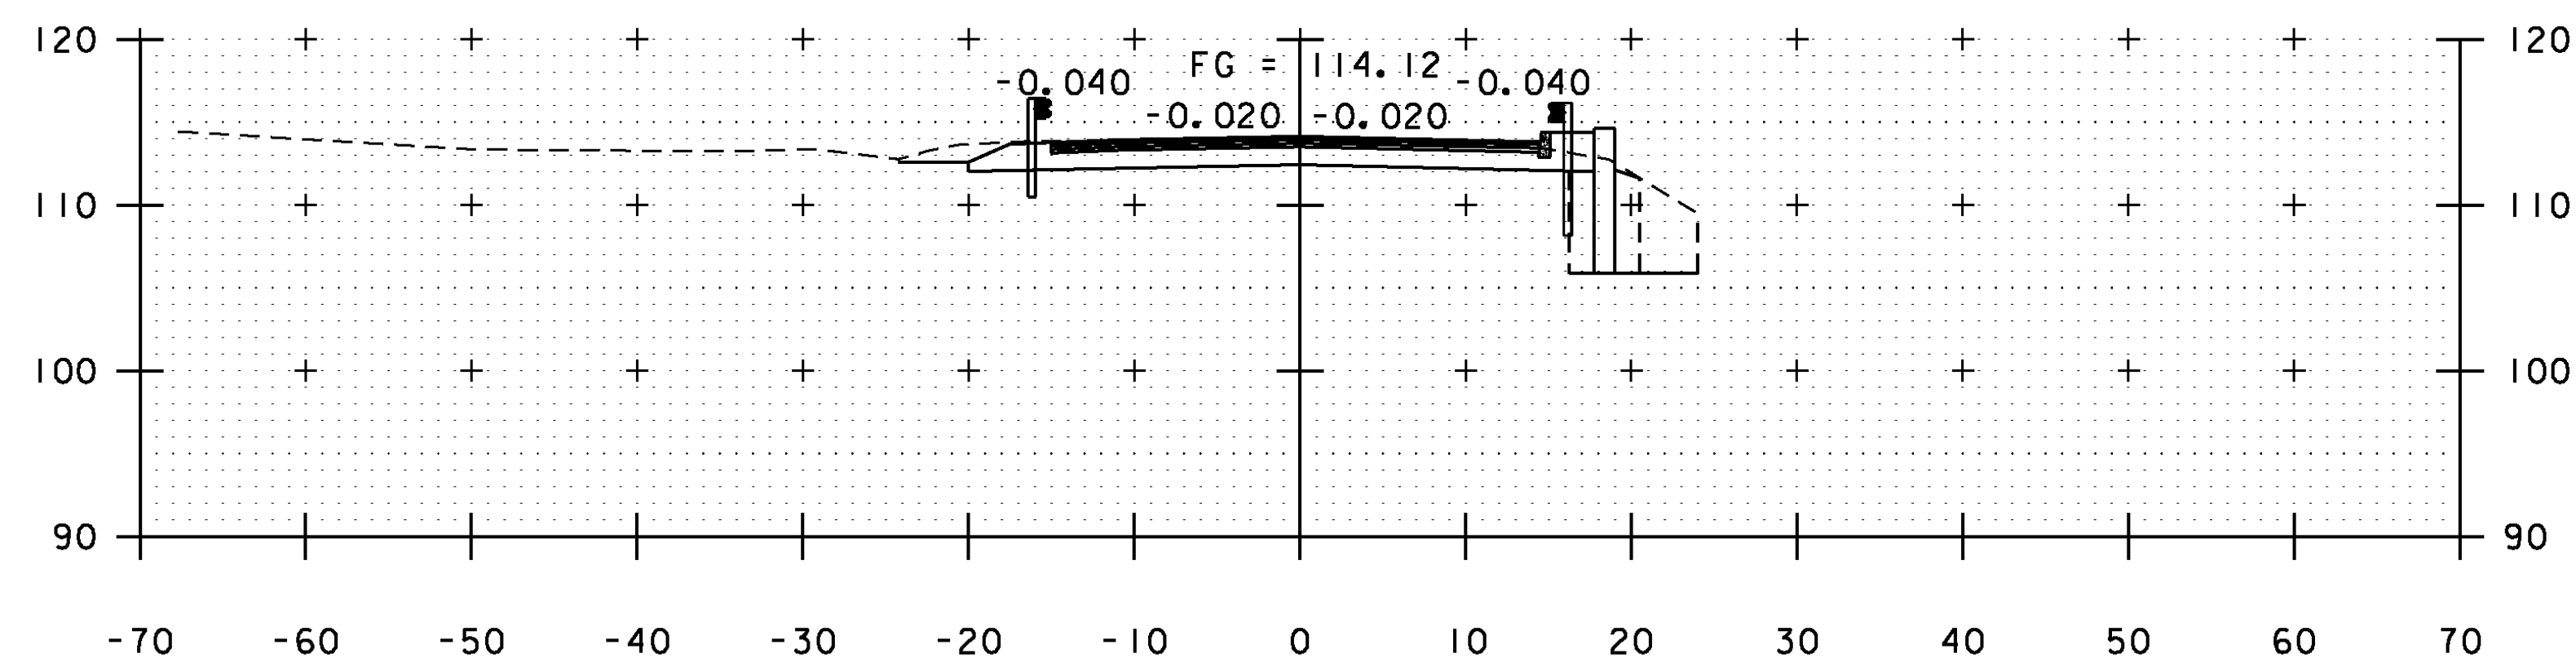


11+40

BEGIN PROJECT
STA. 11+25.00


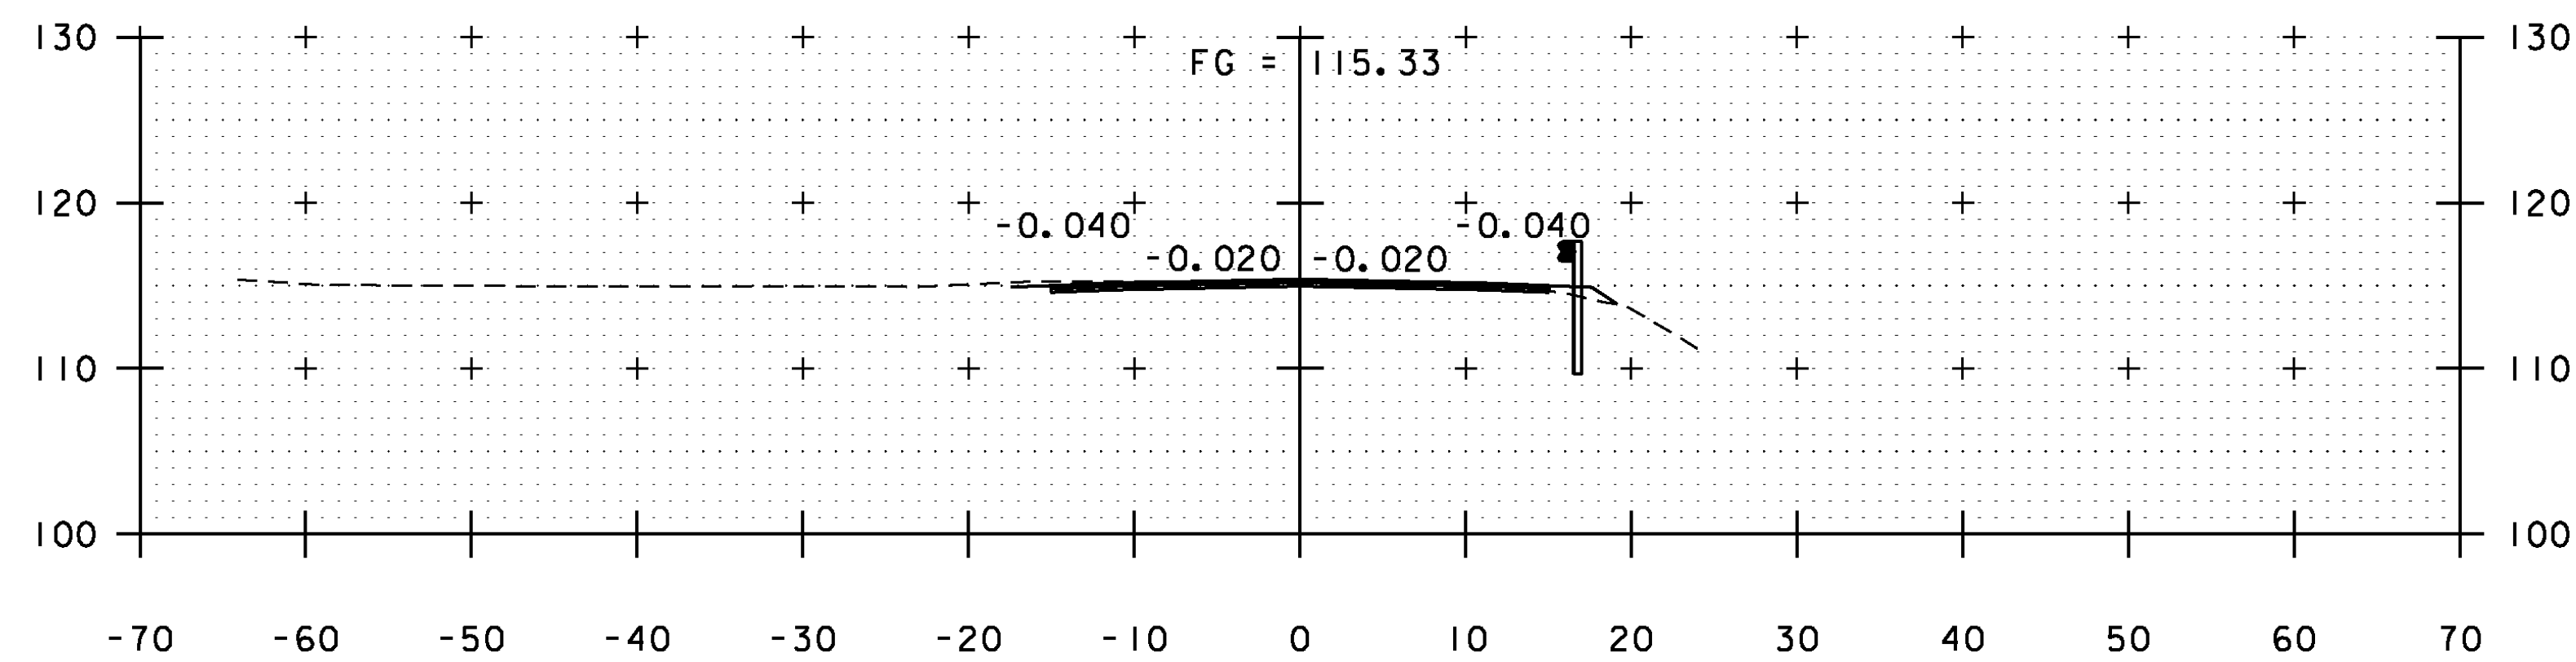


11+20

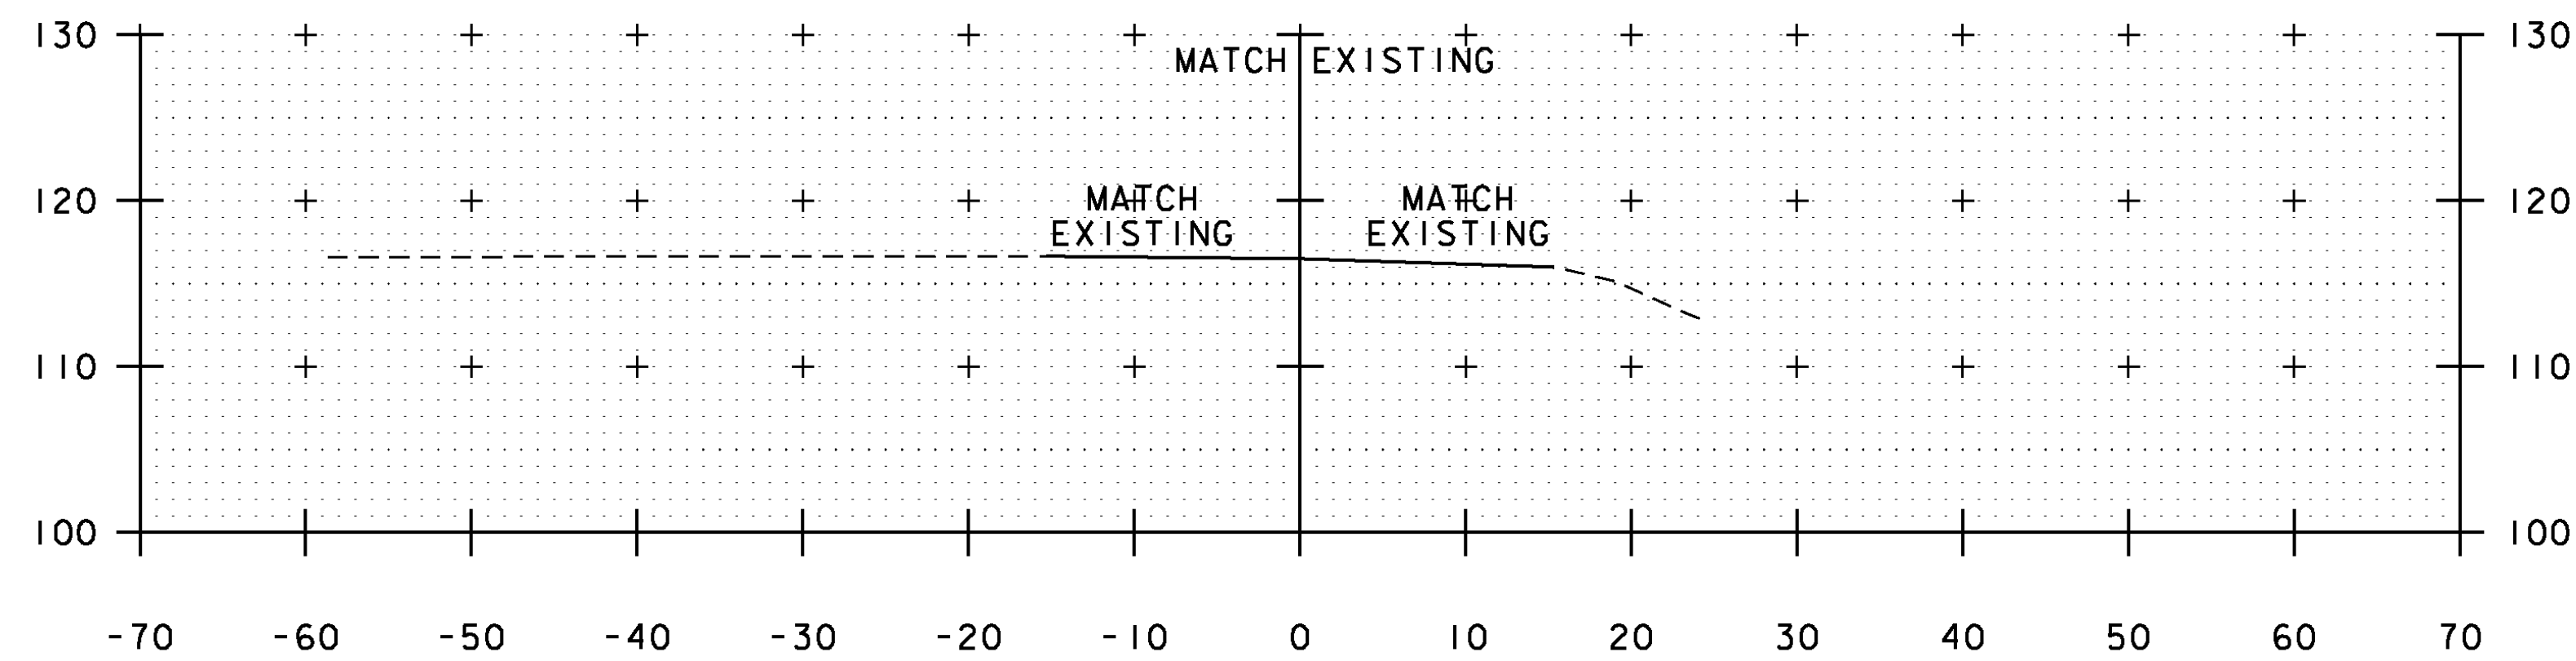


11+00

BEING APPROACH
STA. 11+00.00

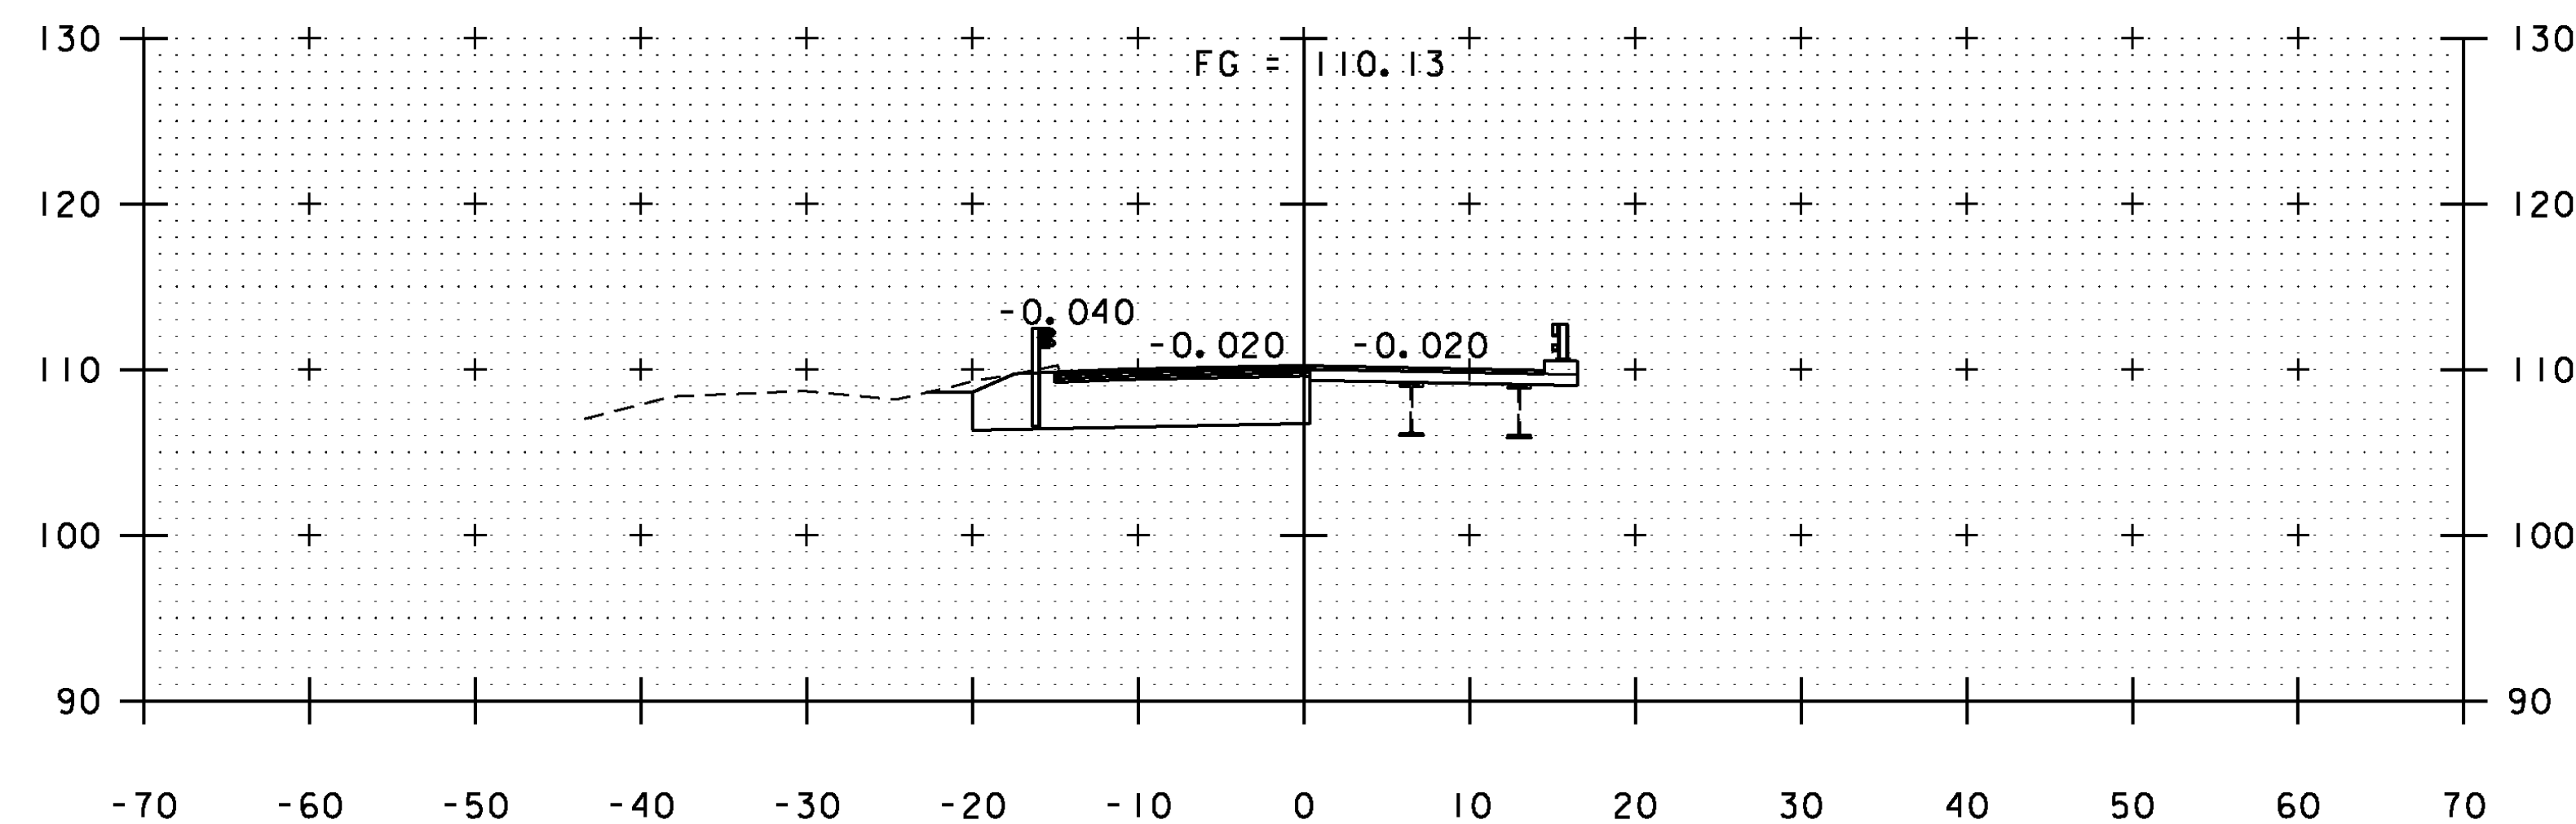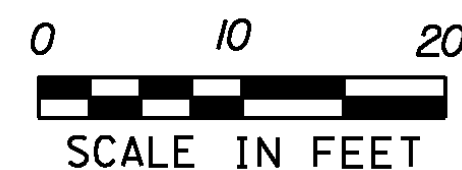


12+00

BEGIN BRIDGE
STA. 12+00.34

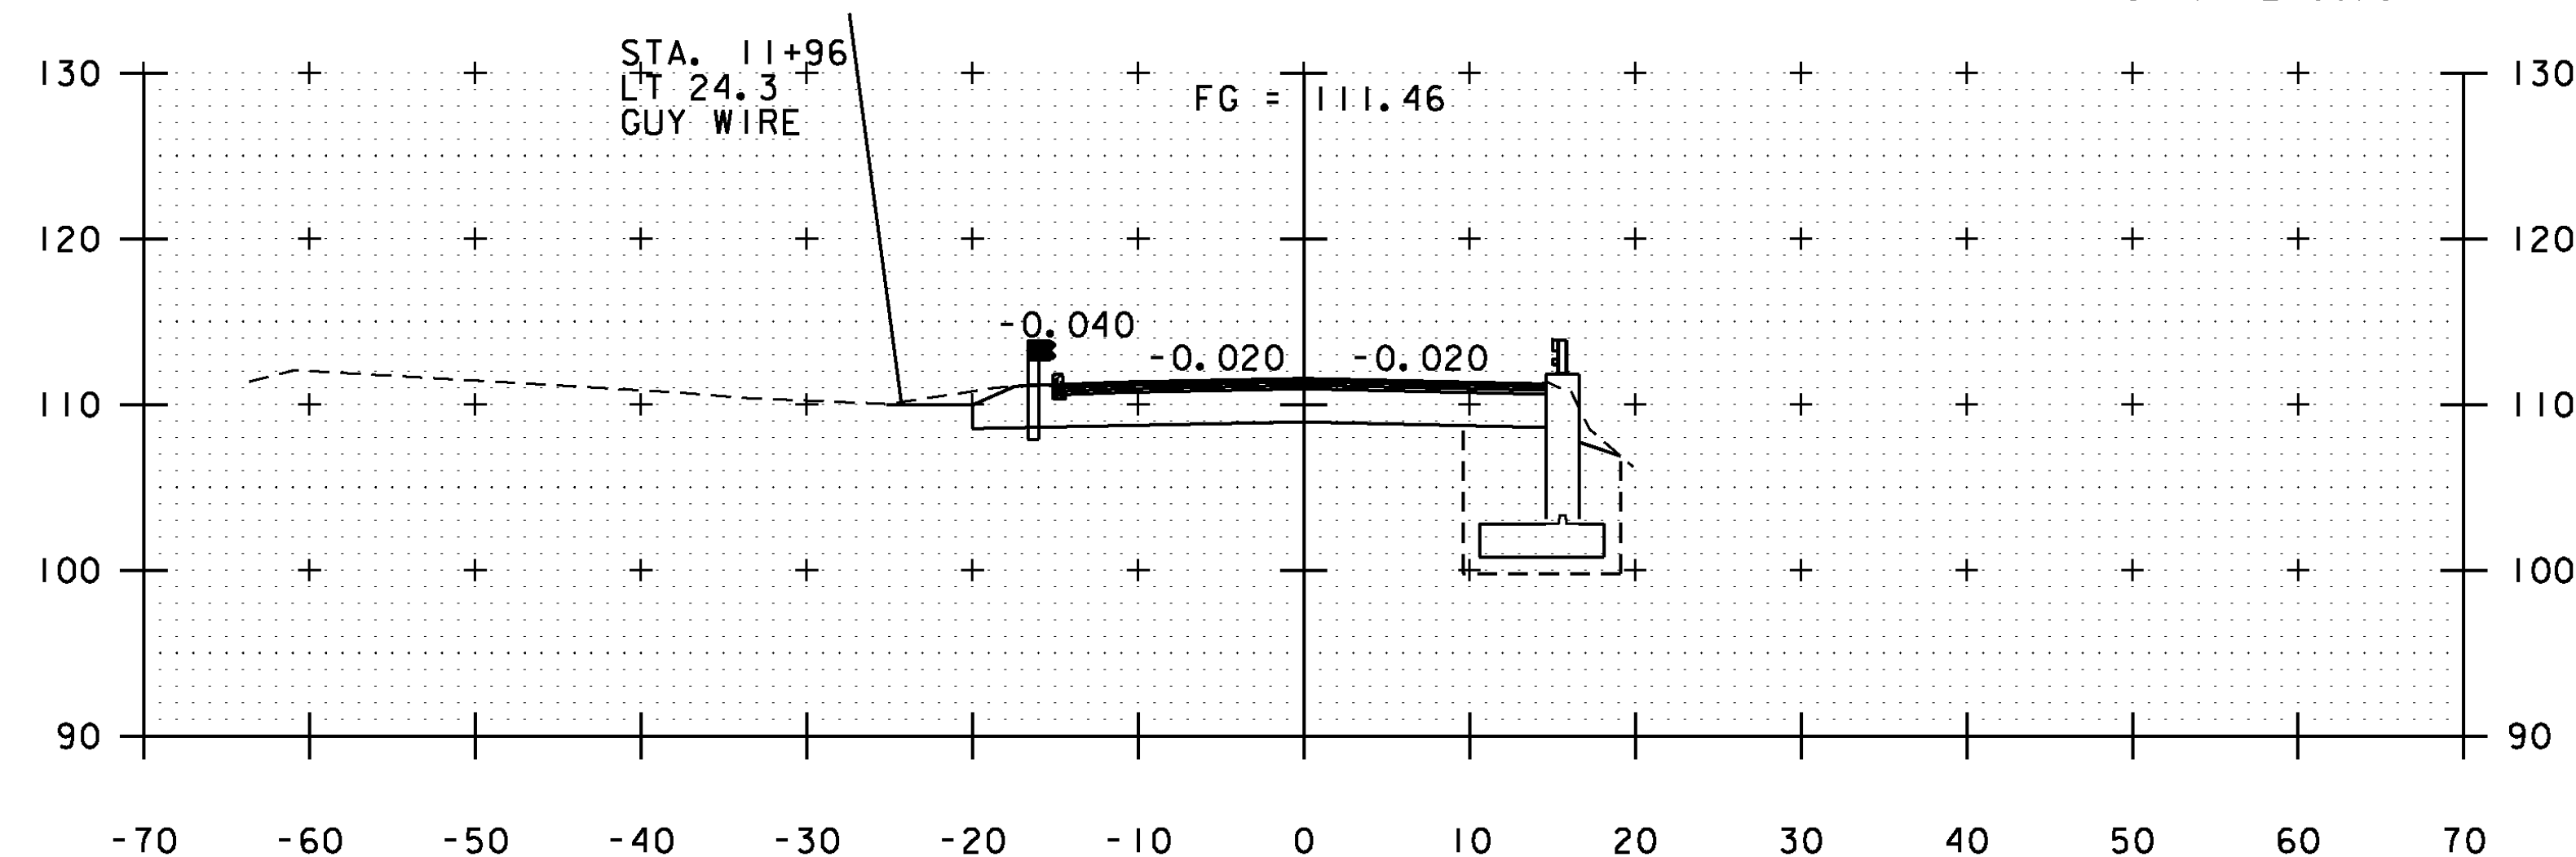

11+80

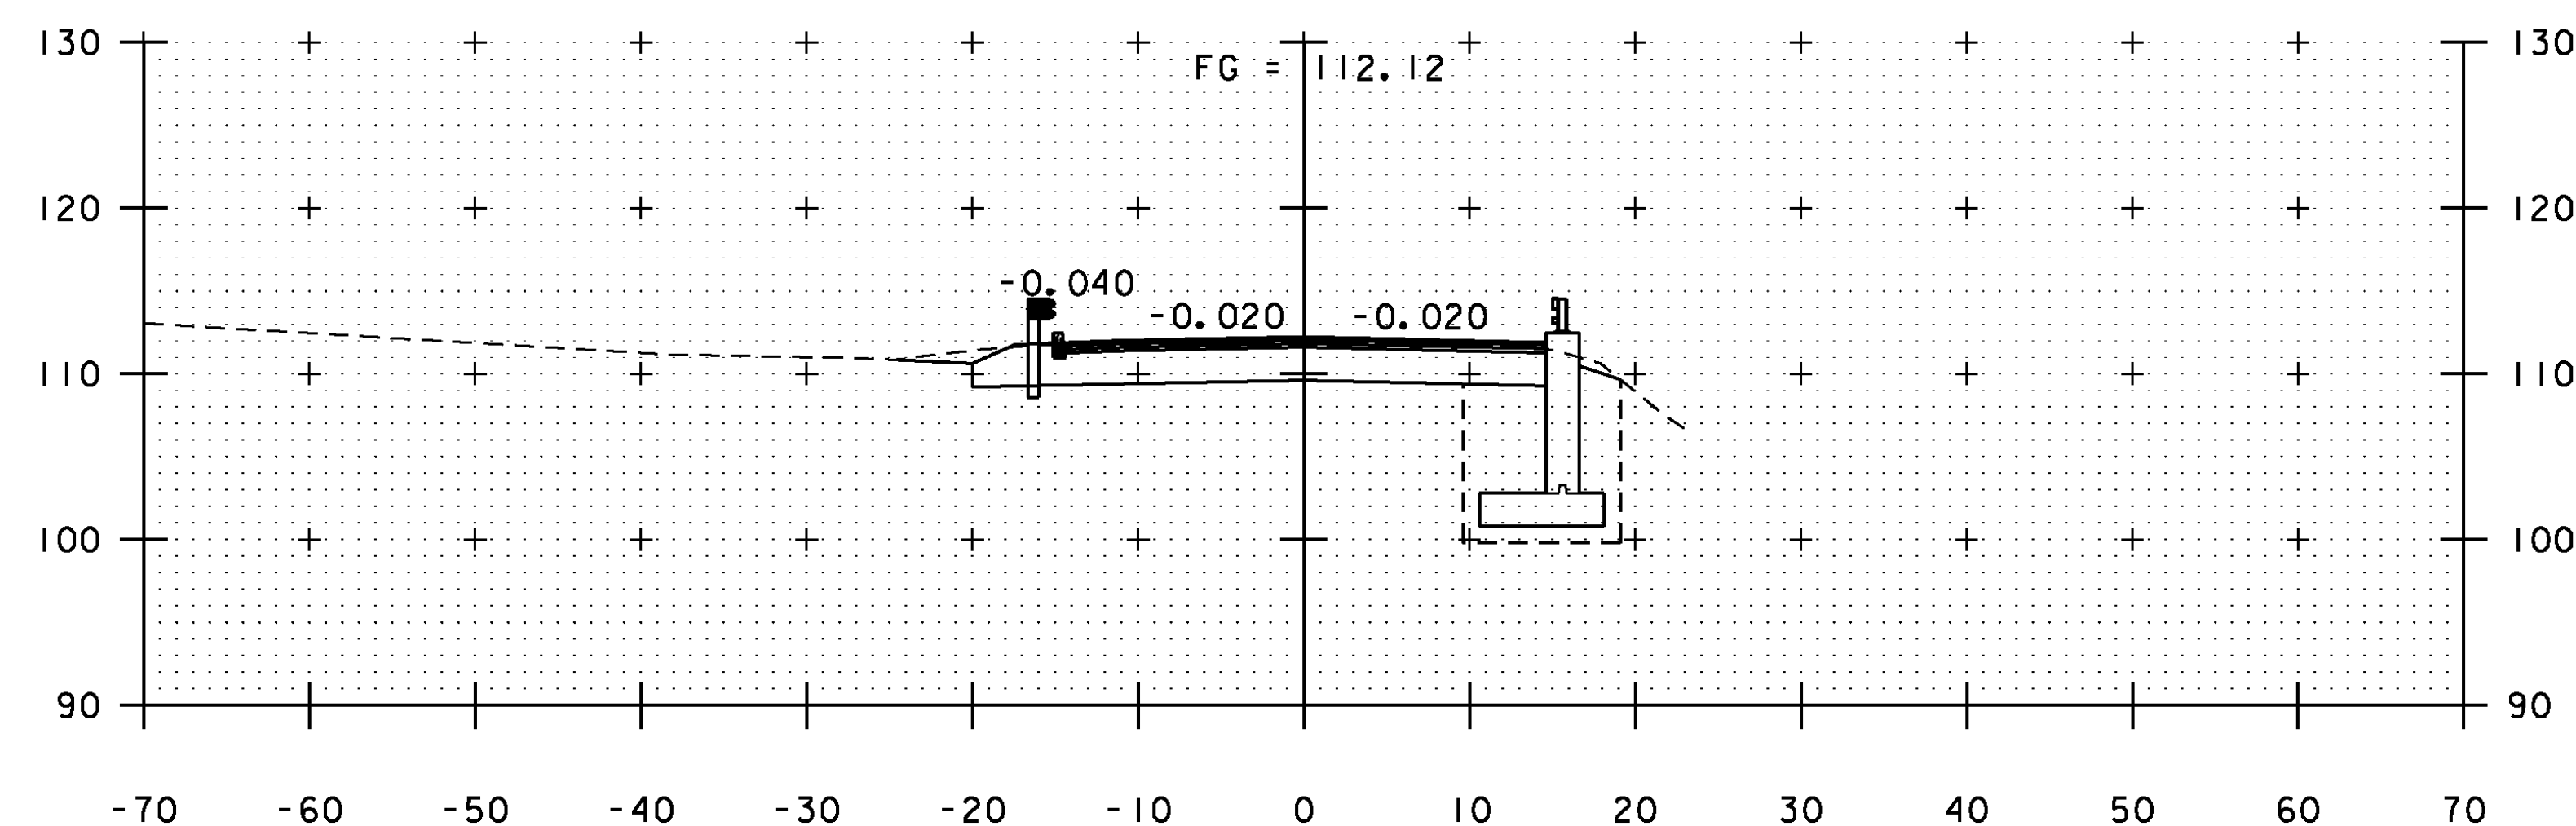

11+70

US RT 5 ROADWAY CROSS SECTIONS
STA. 11+00 THRU STA. 12+00



PROJECT NAME: HARTLAND
PROJECT NUMBER: BHF BPNT(12)

FILE NAME: zllc260xs.dgn
PROJECT LEADER: M.A. COLGAN
DESIGNED BY: S.G. FARNSWORTH
BR 62A US 5 CROSS SECTIONS (10F 3)

PLOT DATE: 12/17/2013
DRAWN BY: A.J. GOUDREAU
CHECKED BY: S.E. BURBANK
SHEET 37 OF 55