

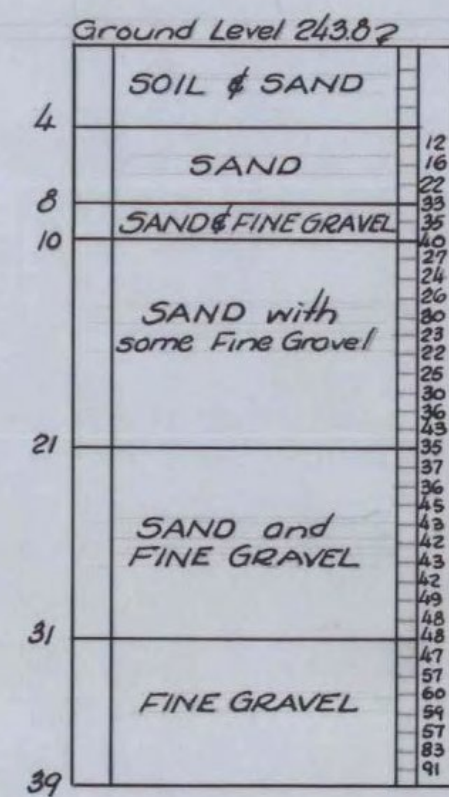



Weight of Hammer 350# - Thickness of Shell 3/8"  
Drop of Hammer 24" - Diameter of Casing 2 1/2"

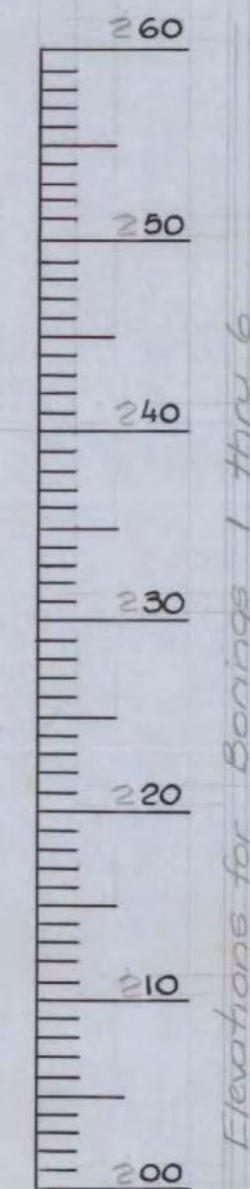


BORING #1

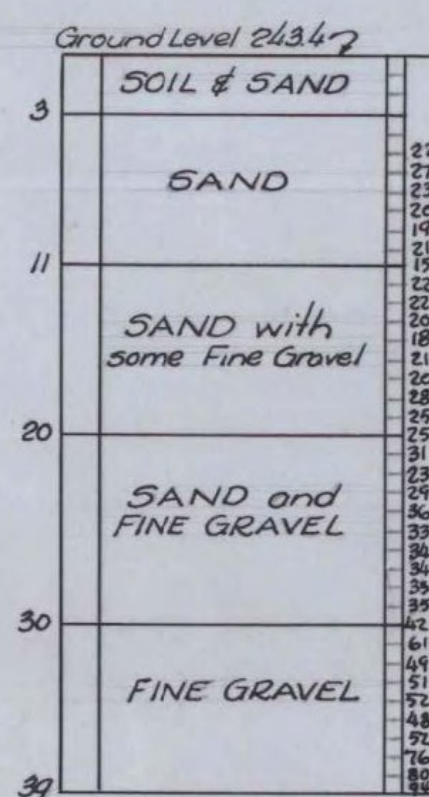


BORING #2

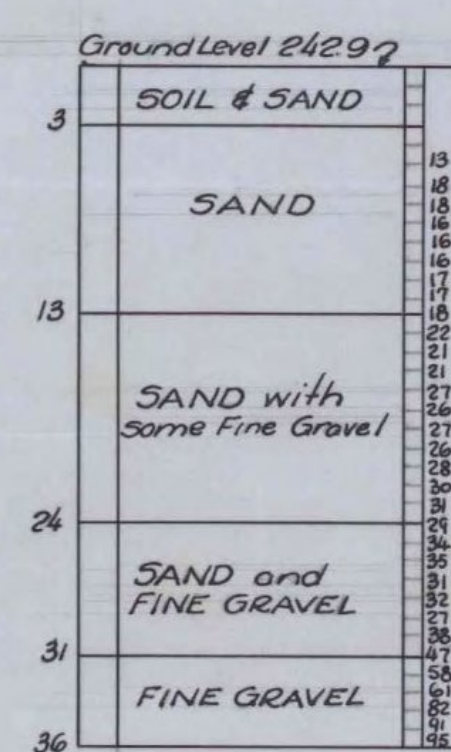


BORING #3

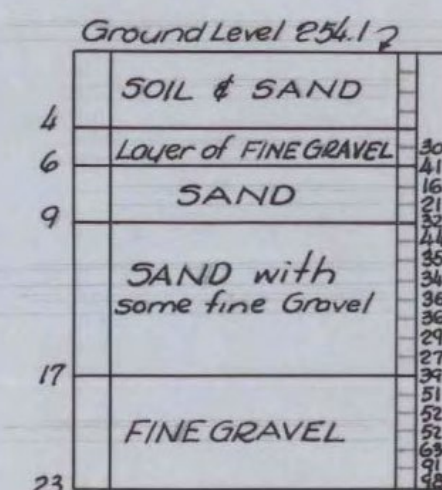



BORING #4

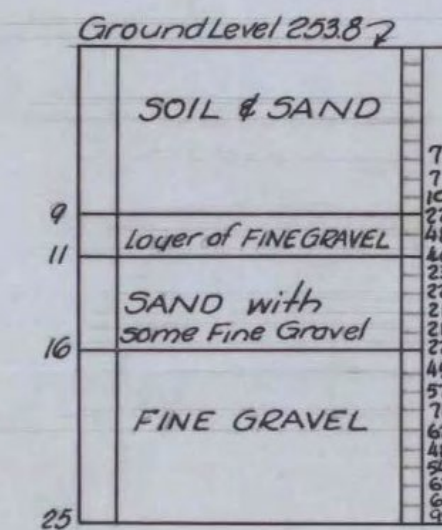


BORING #5

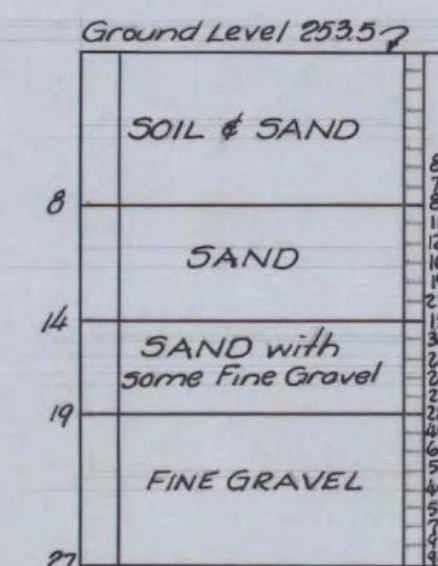

BORING #6

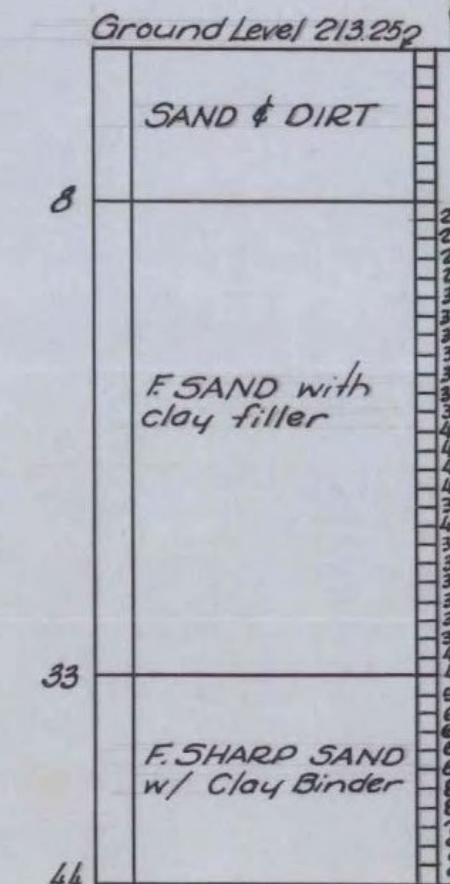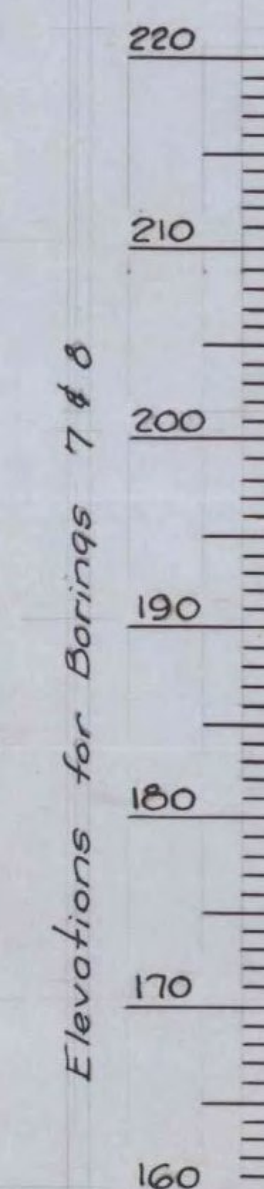

BORING #7

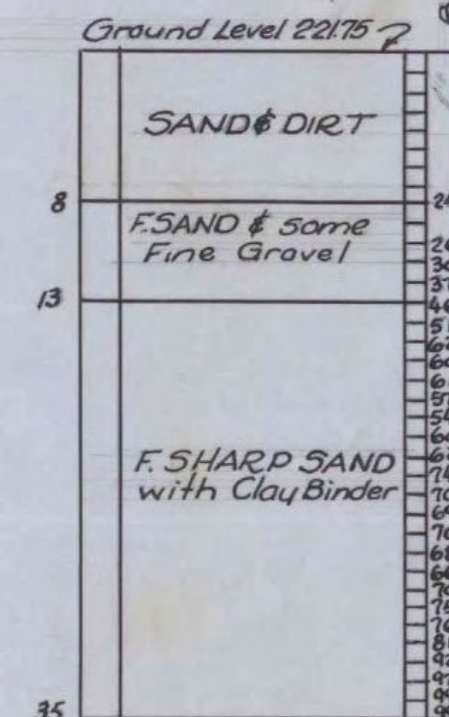

BORING #8

FOR LOCATION OF BORINGS 7 & 8  
SEE SHEET N<sup>o</sup> 11 of 54

BORINGS 1 TO 6 NOT USED

