



STATE OF VERMONT AGENCY OF TRANSPORTATION

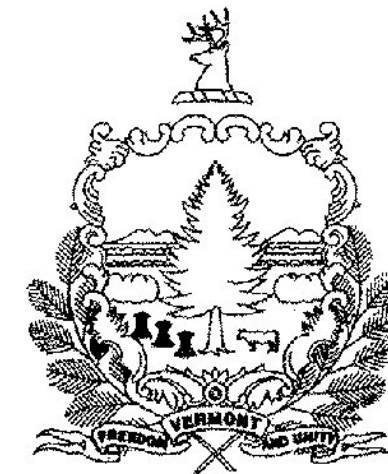

PROPOSED IMPROVEMENT BRIDGE PROJECT TOWN OF IRASBURG COUNTY OF ORLEANS VT ROUTE 58 (MAJOR COLLECTOR) BRIDGE NUMBERS 6 AND 7

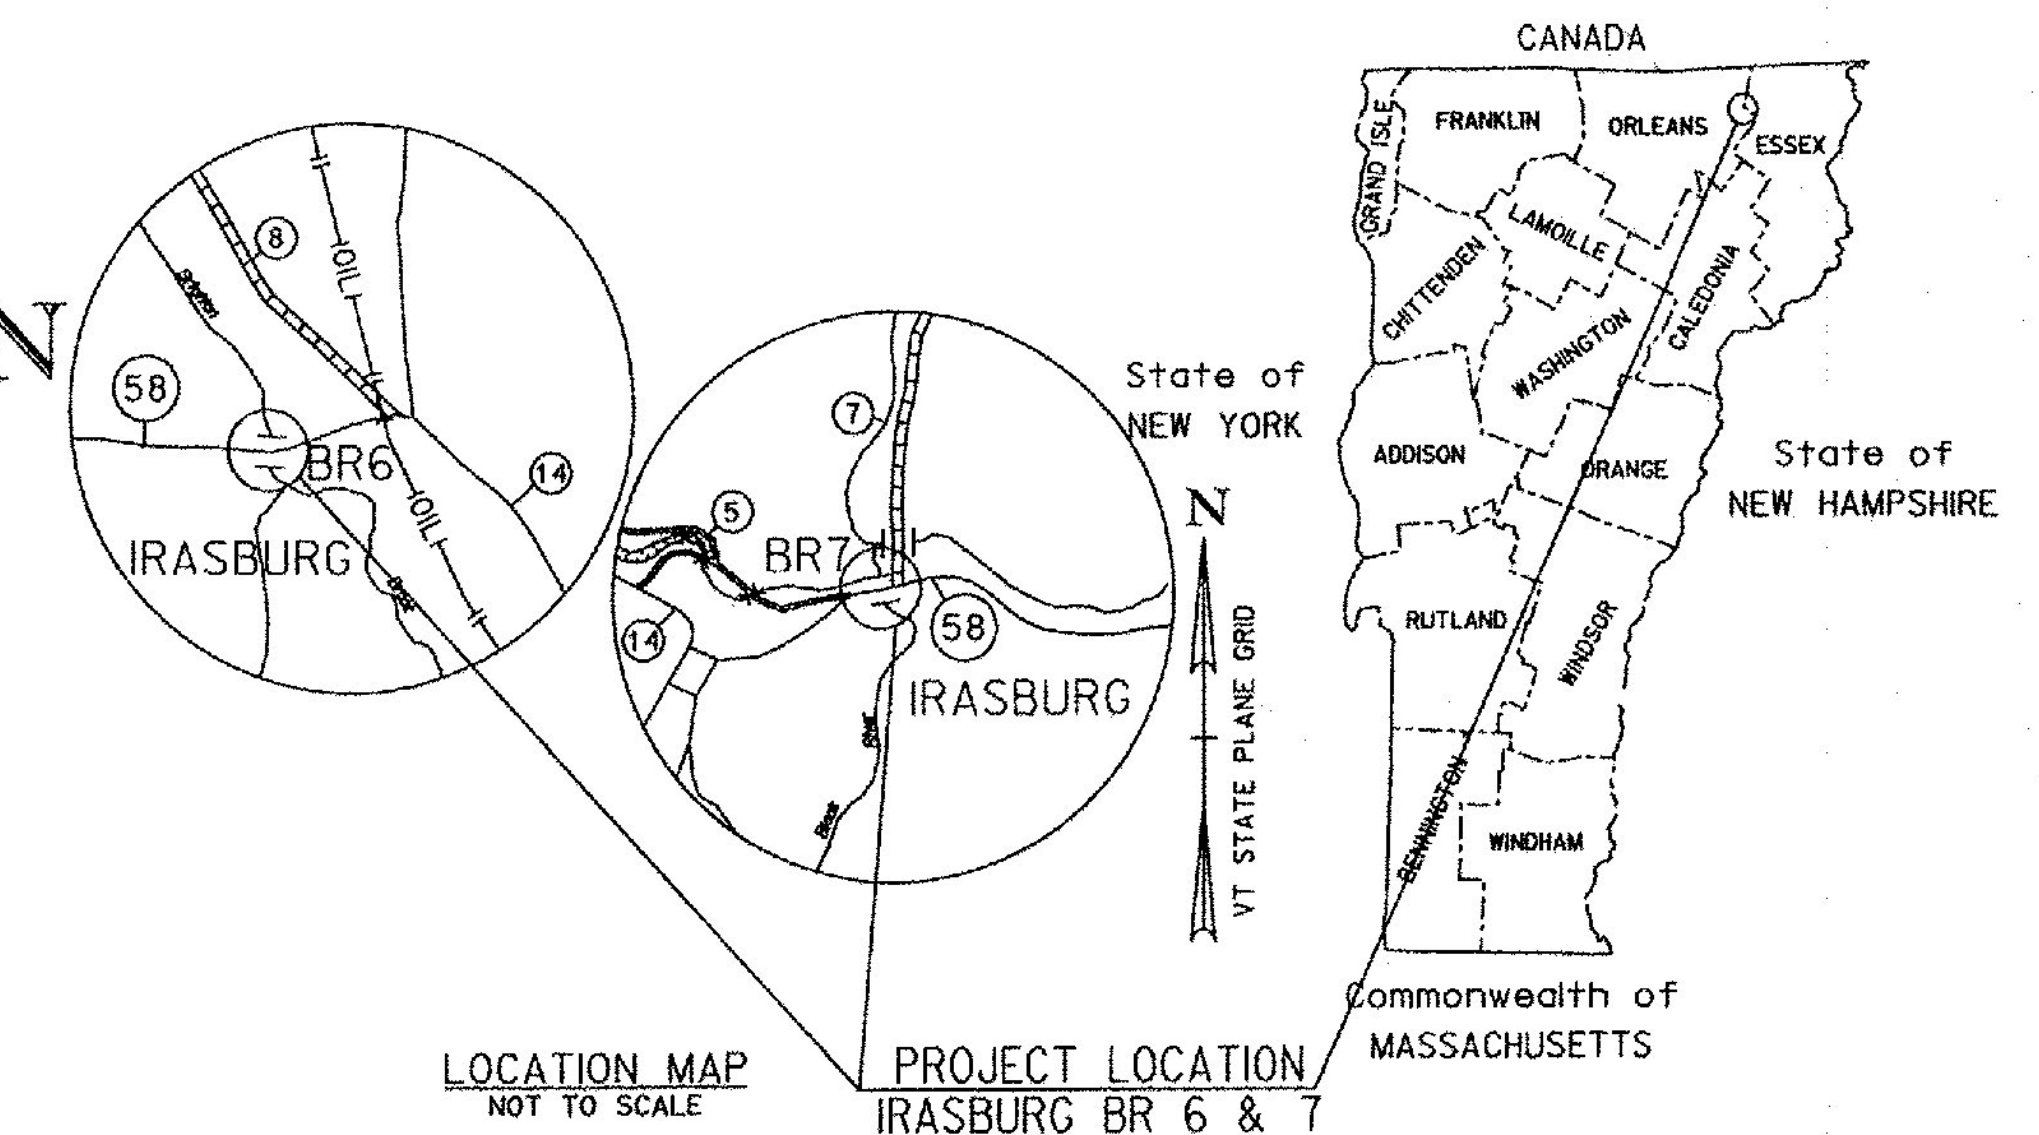

RECORD PLANS	
CONTRACTOR:	J. A. McDONALD INC. - LYNDON CENTER, VT
RESIDENT ENGINEER:	KEVIN MCCLURE
CONSTRUCTION BEGAN:	AUGUST 19, 2015
CONSTRUCTION COMPLETE:	OCTOBER 28, 2015
RECORD PLANS BY:	KEVIN MCCLURE & KEVIN KING
I HEREBY CERTIFY THAT ALL THE CONSTRUCTION REQUIRED BY THIS SET OF DRAWINGS HAS BEEN ACCOMPLISHED AS INDICATED HEREIN.	
BY <u>Kevin McClure</u>	RESIDENT ENGINEER
DATE <u>1-4-17</u>	
NOTE: Any further information concerning final quantities, amounts or other details relative to this project may be found at Central Files in the electronic archives.	



PROJECT LOCATION: BRIDGE NO. 6 IS LOCATED ON VERMONT ROUTE 58, 0.3 MILES WEST OF THE JUNCTION WITH VERMONT ROUTE 14.

BRIDGE NO. 7 IS LOCATED ON VERMONT ROUTE 58, 0.5 MILES EAST OF THE JUNCTION WITH VERMONT ROUTE 14.

PROJECT DESCRIPTION: REPLACEMENT OF EXISTING CORRUGATED STEEL CULVERTS WITH PRECAST CONCRETE STRUCTURES ALONG WITH RELATED ROADWAY AND CHANNEL WORK.

LENGTH OF PROJECT: BRIDGE 6: 116 FEET
BRIDGE 7: 92 FEET

TOTAL PROJECT LENGTH: 208 FEET

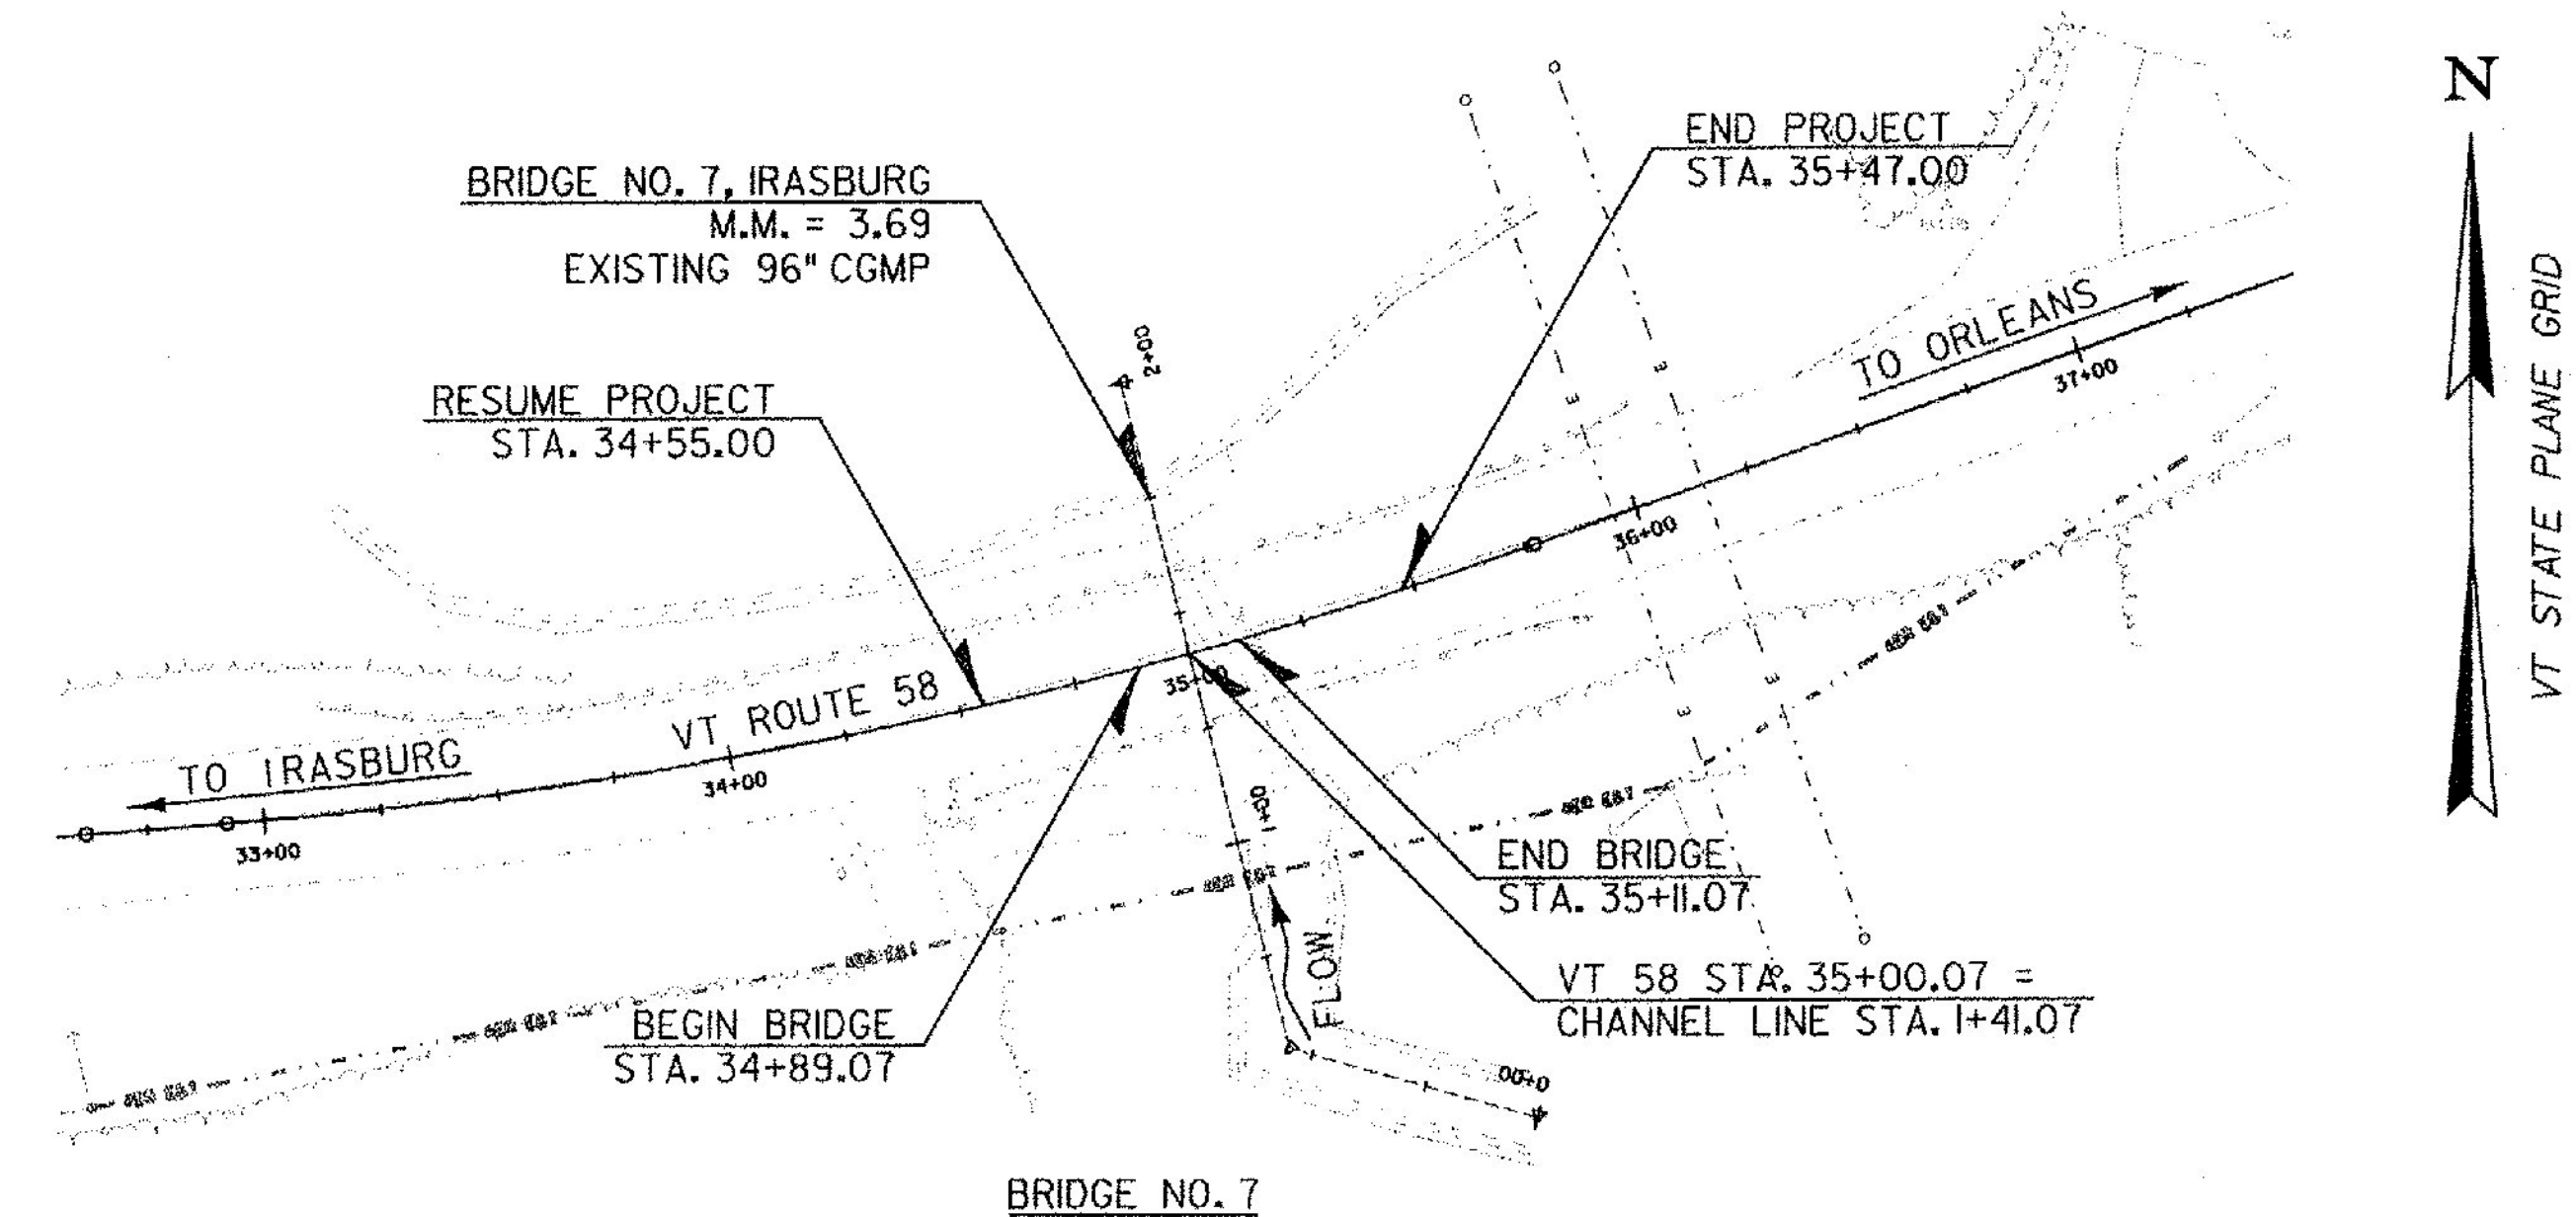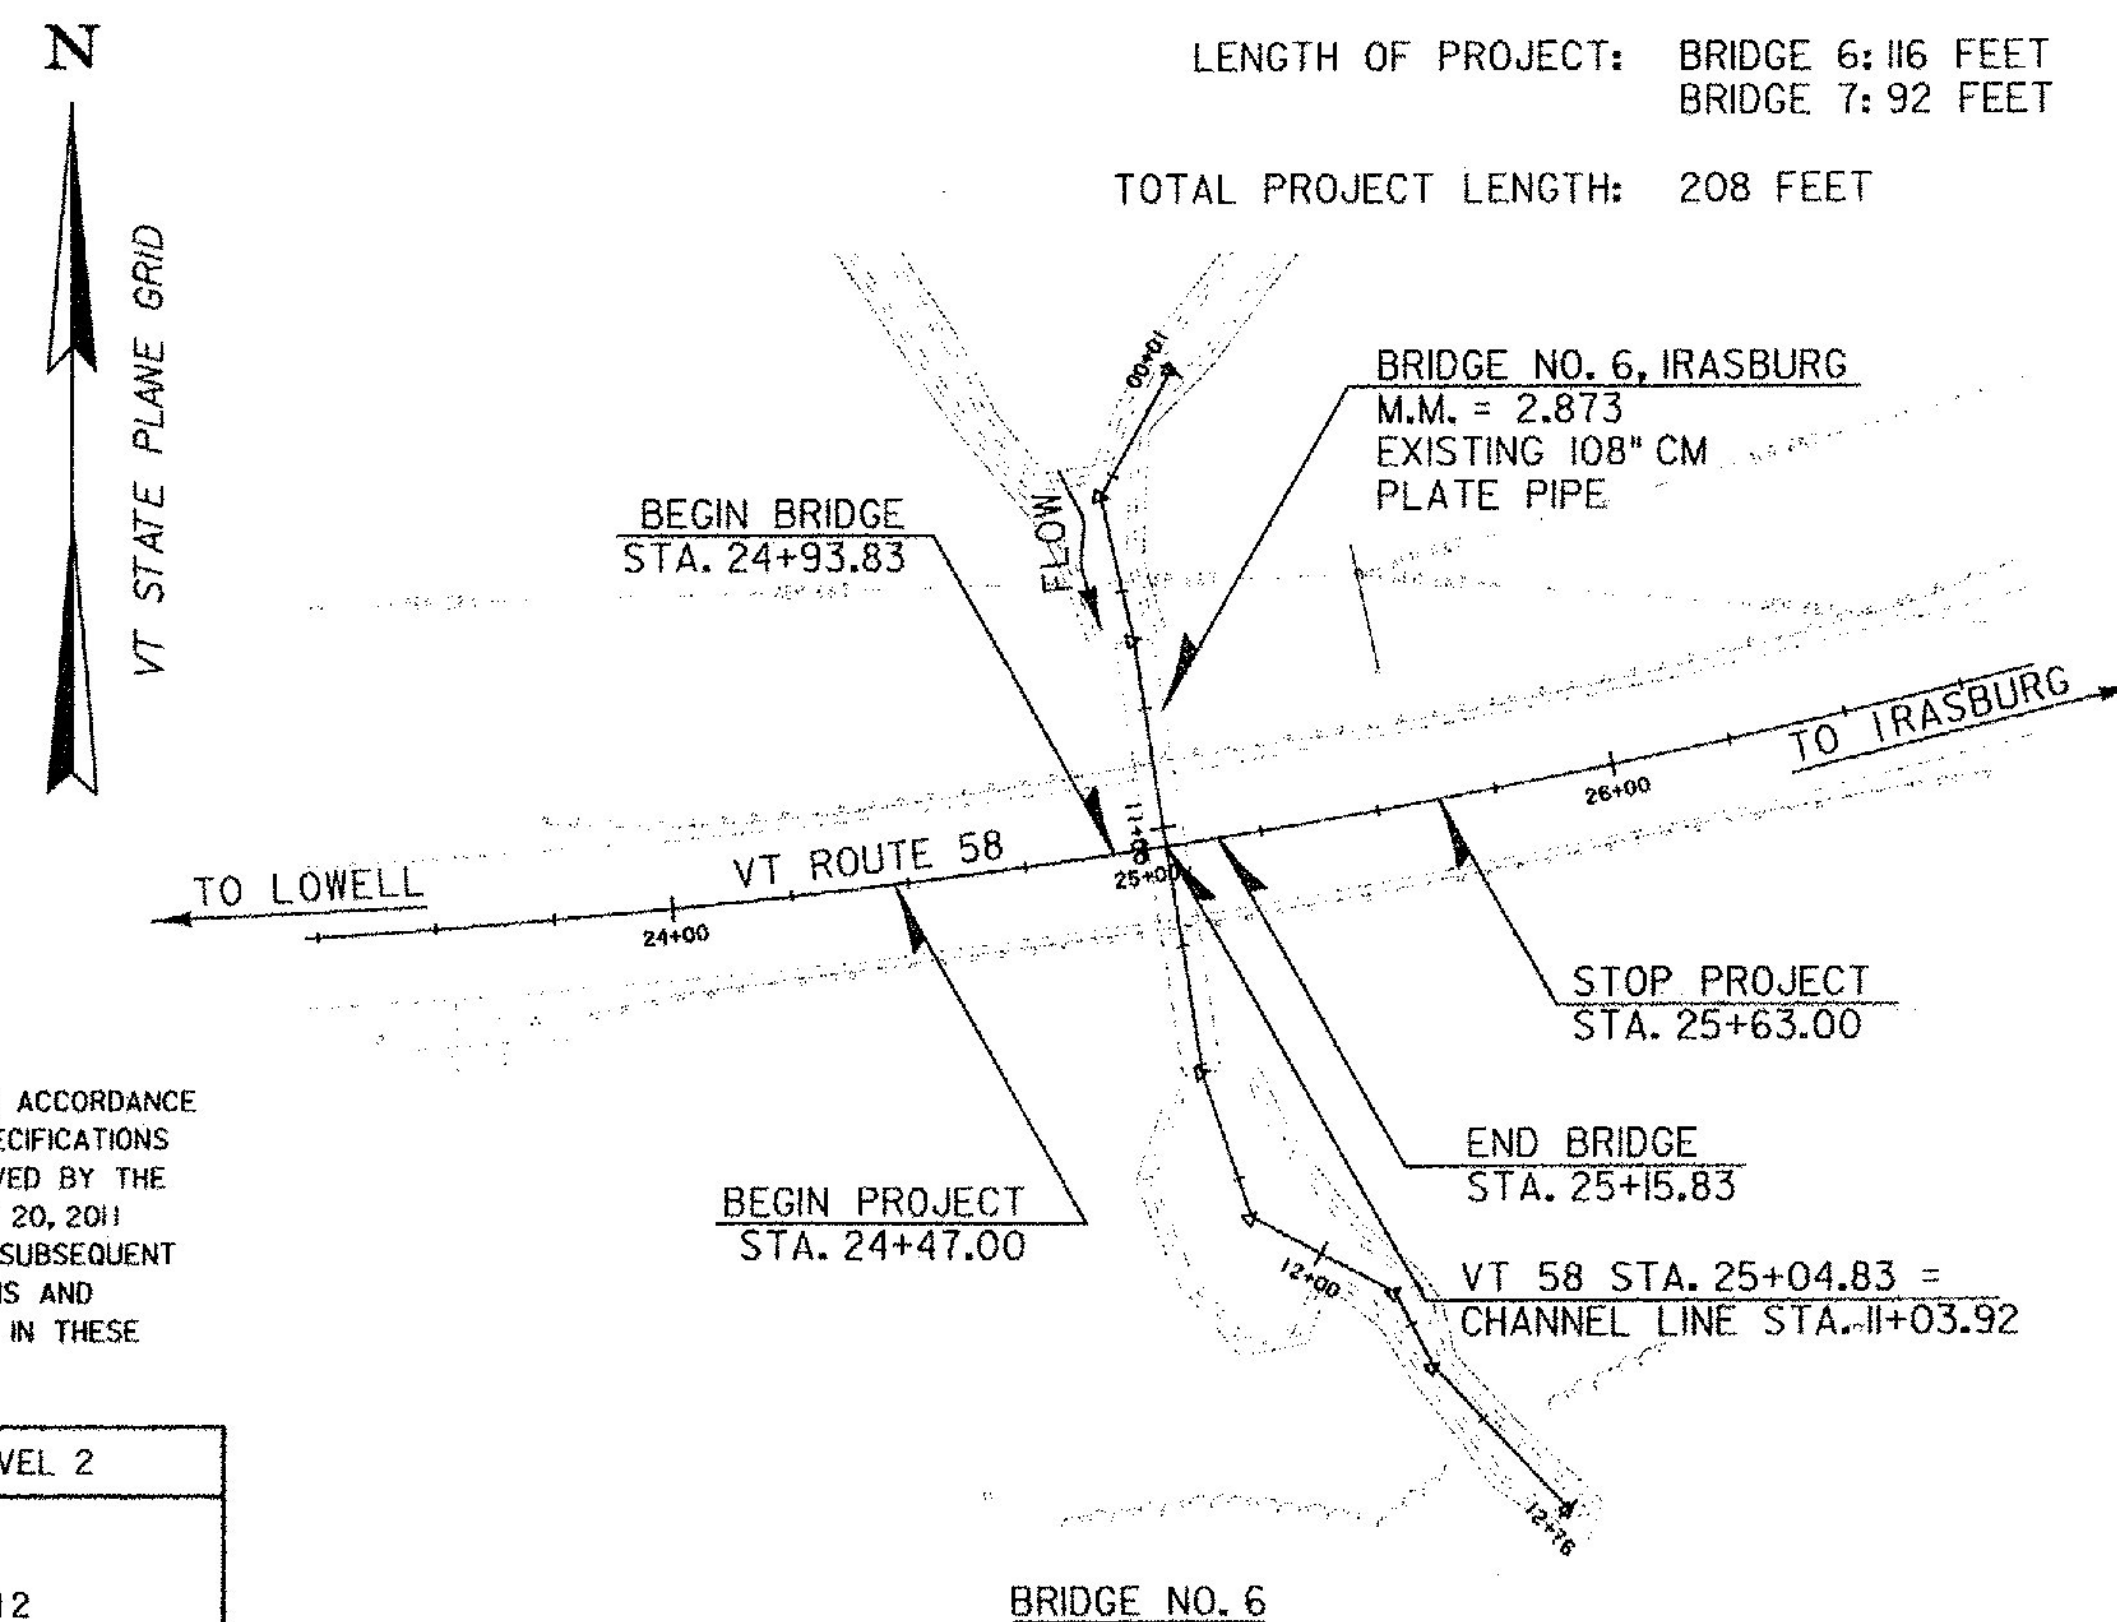

CONSTRUCTION IS TO BE CARRIED ON IN ACCORDANCE WITH THESE PLANS AND THE STANDARD SPECIFICATIONS FOR CONSTRUCTION DATED 2011, AS APPROVED BY THE FEDERAL HIGHWAY ADMINISTRATION ON JULY 20, 2011 FOR USE ON THIS PROJECT, INCLUDING ALL SUBSEQUENT REVISIONS AND SUCH REVISED SPECIFICATIONS AND SPECIAL PROVISIONS AS ARE INCORPORATED IN THESE PLANS.

QUALITY ASSURANCE PROGRAM : LEVEL 2

SURVEYED BY : VTRANS
SURVEYED DATE : FEBRUARY 2012

DATUM
VERTICAL NAVD 88
HORIZONTAL NAD 83 (07)

0 40 80
SCALE IN FEET



Stantec Consulting Services Inc.
55 Green Mountain Drive
South Burlington VT U.S.A. 05403
Phone: (802) 864-0223
Fax: (802) 864-0165
www.stantec.com

DIRECTOR OF PROJECT DELIVERY
APPROVED [Signature] DATE 9/29/2014
PROJECT MANAGER : MARK SARGENT P.E.
PROJECT NAME : IRASBURG
PROJECT NUMBER : STP CULV (30)
SHEET 1 OF 55 SHEETS