



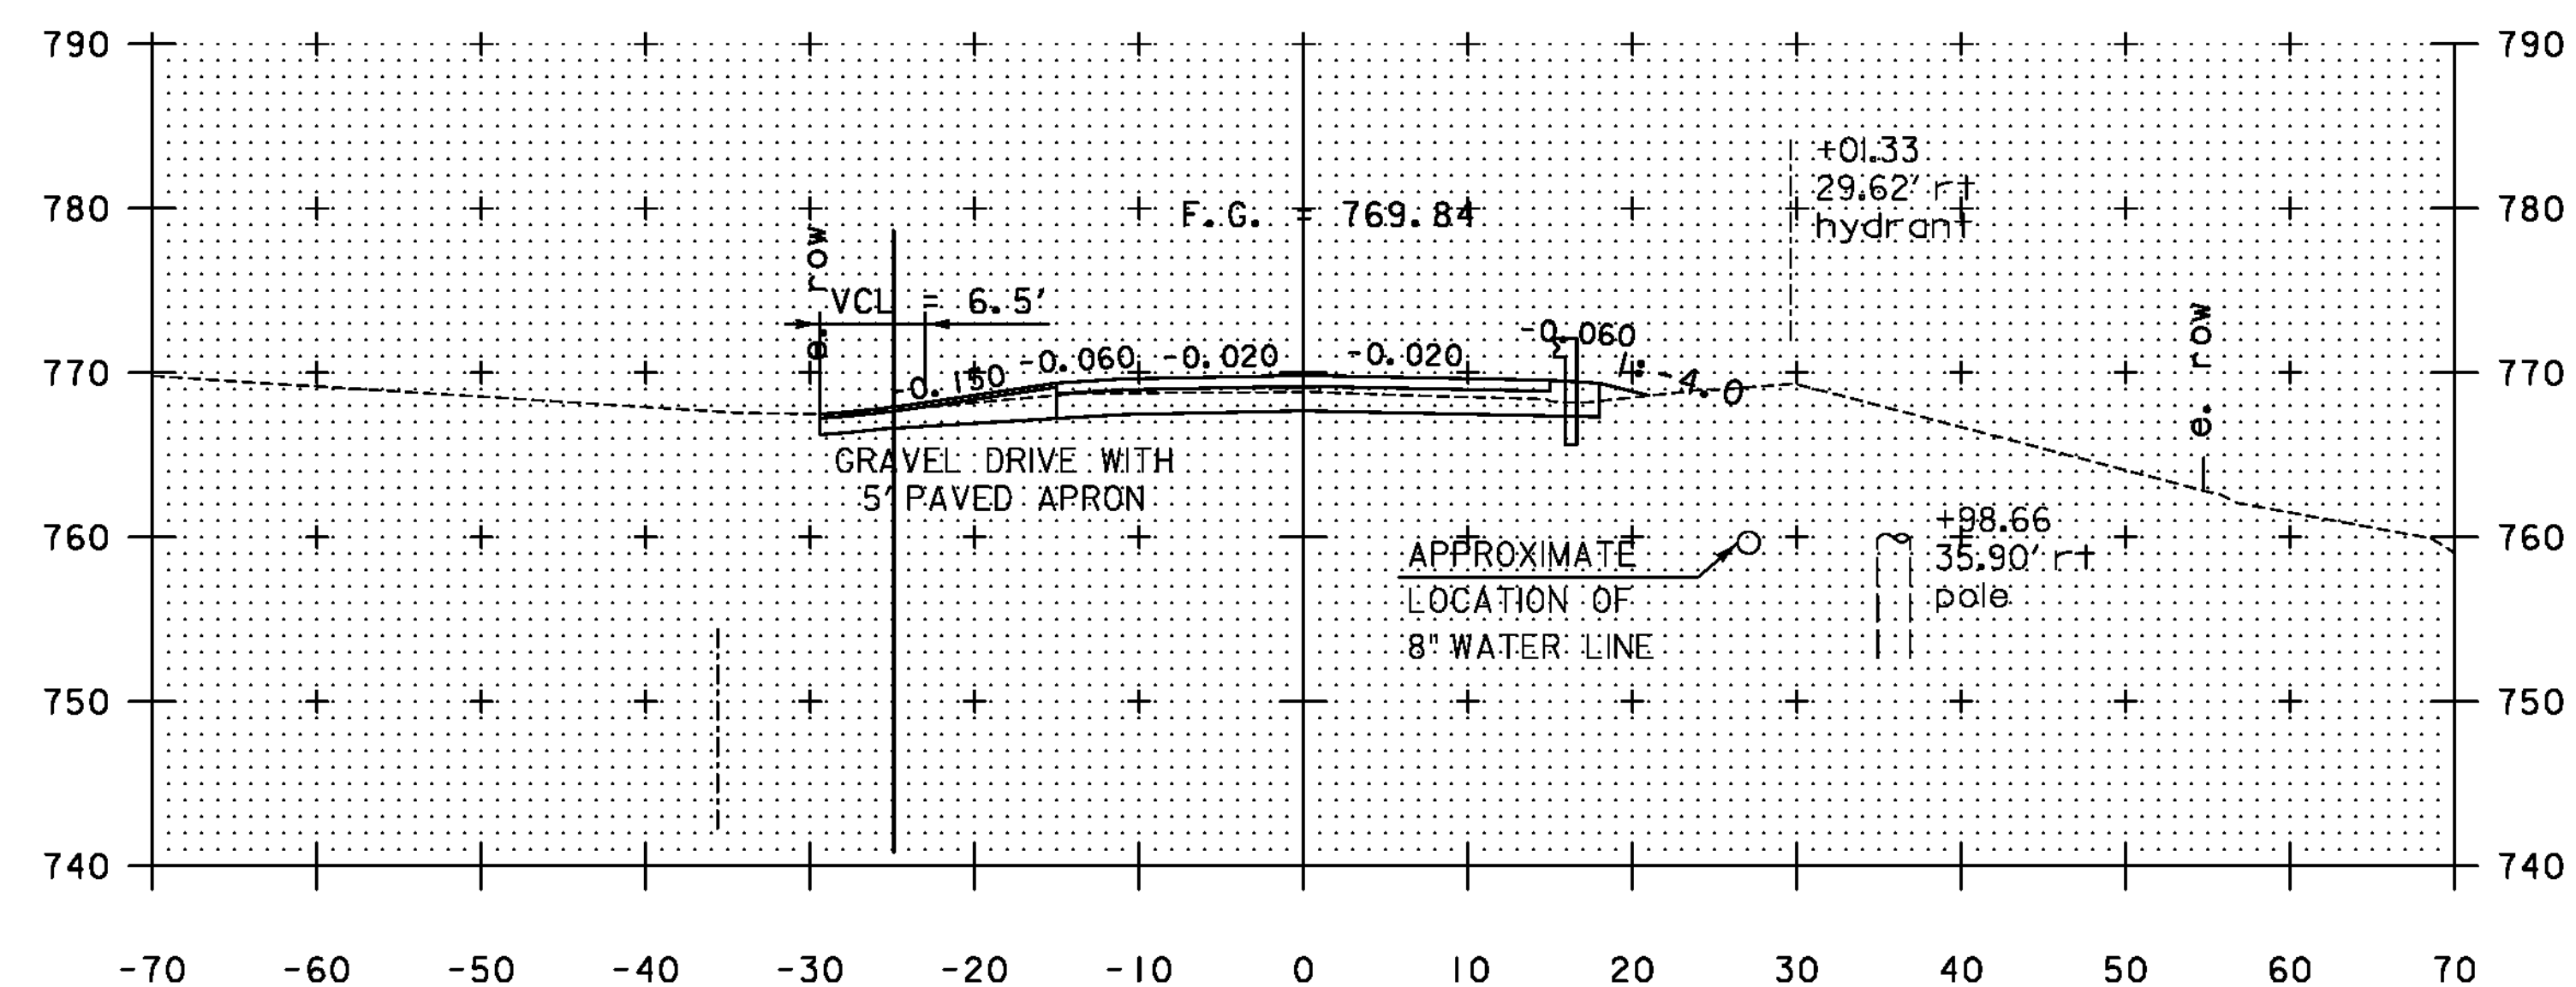


504+00

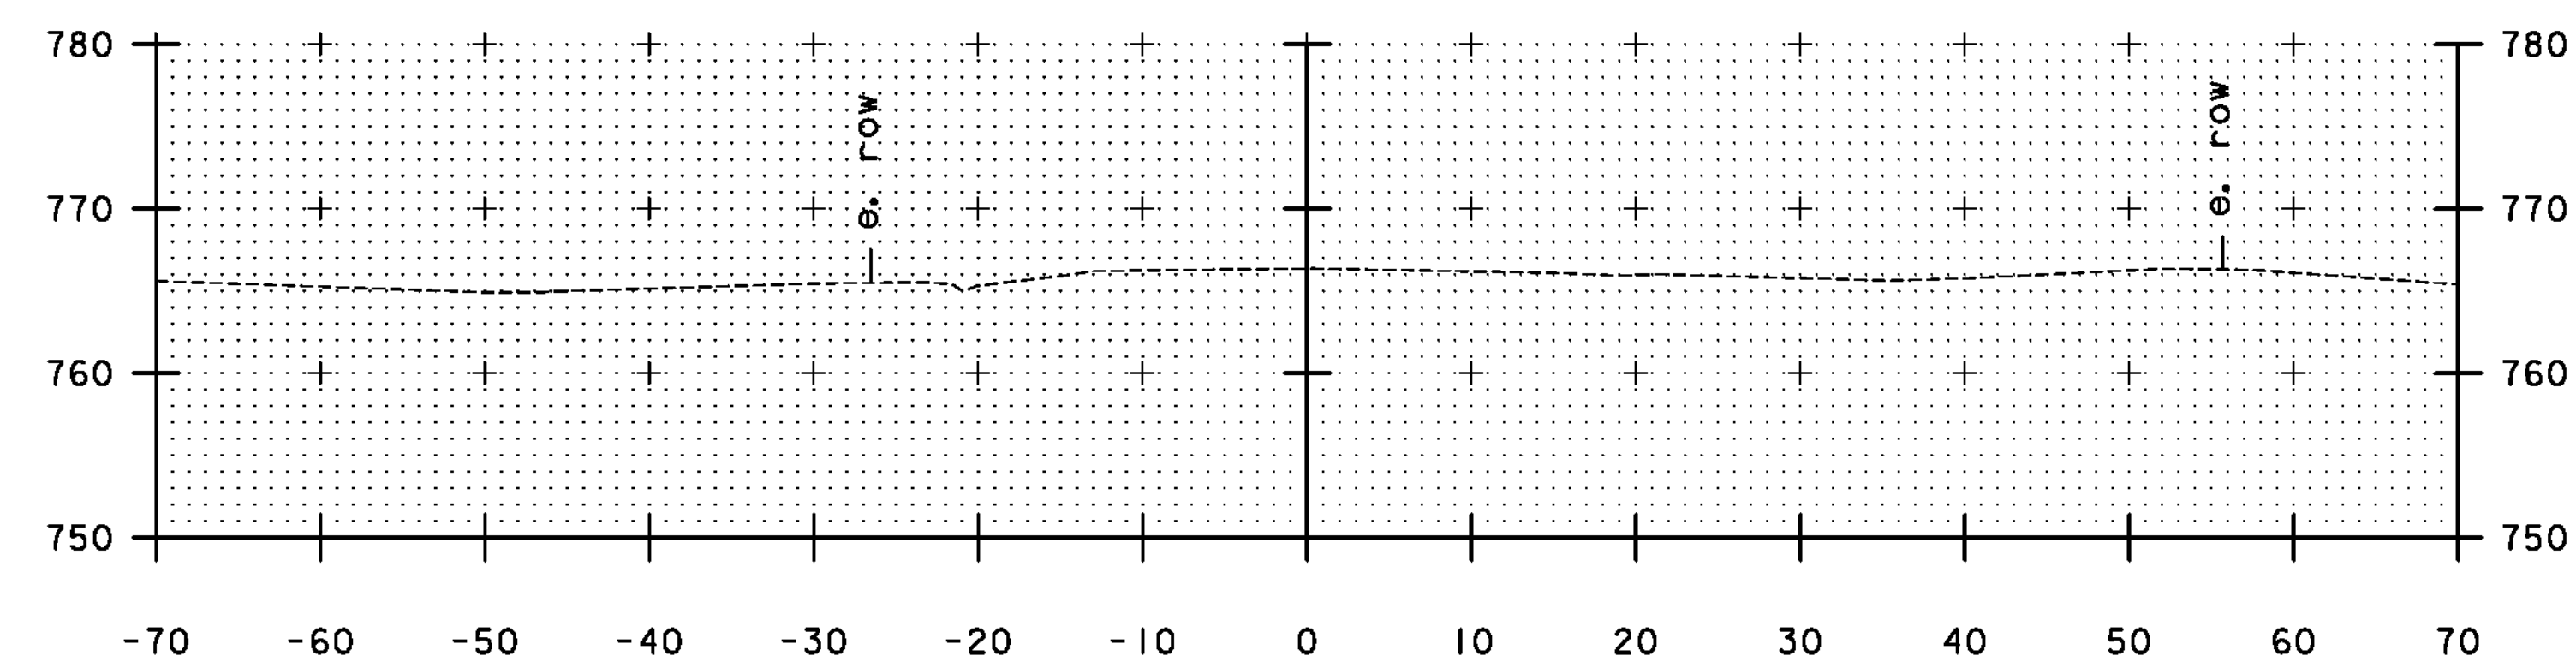


505+00

STA 504+95
END APPROACH
MATCH EXISTING PAVEMENT

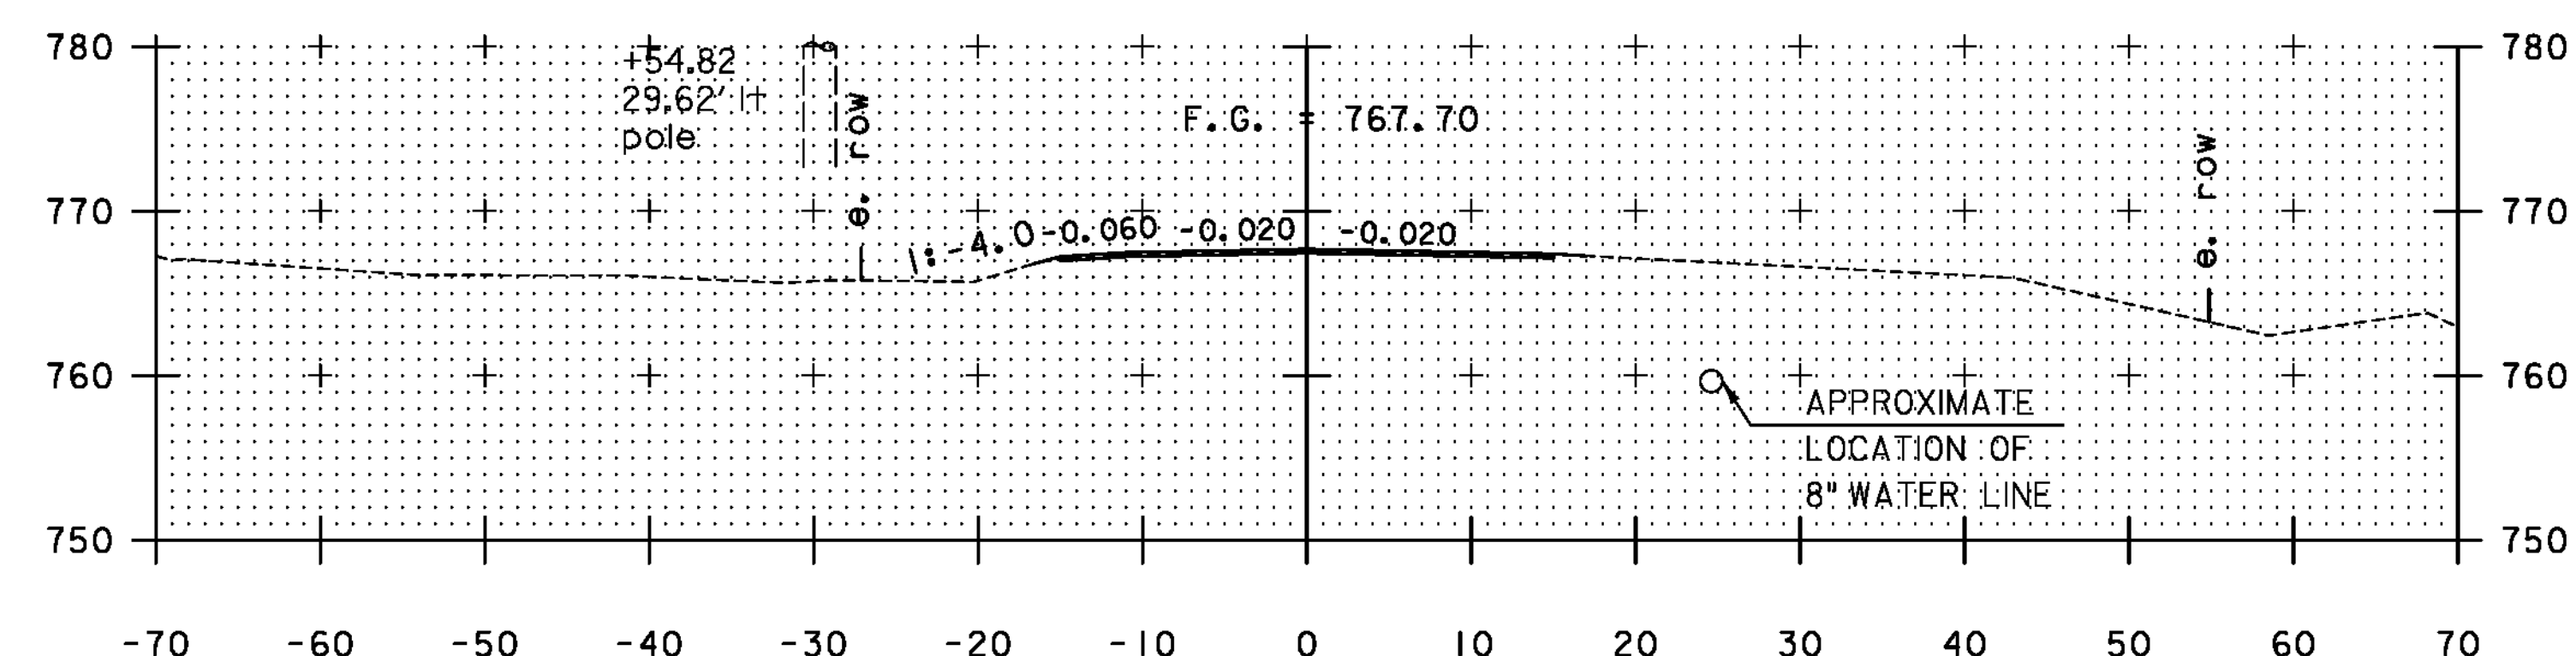

504+50

STA 504+45
END PROJECT
BEGIN APPROACH

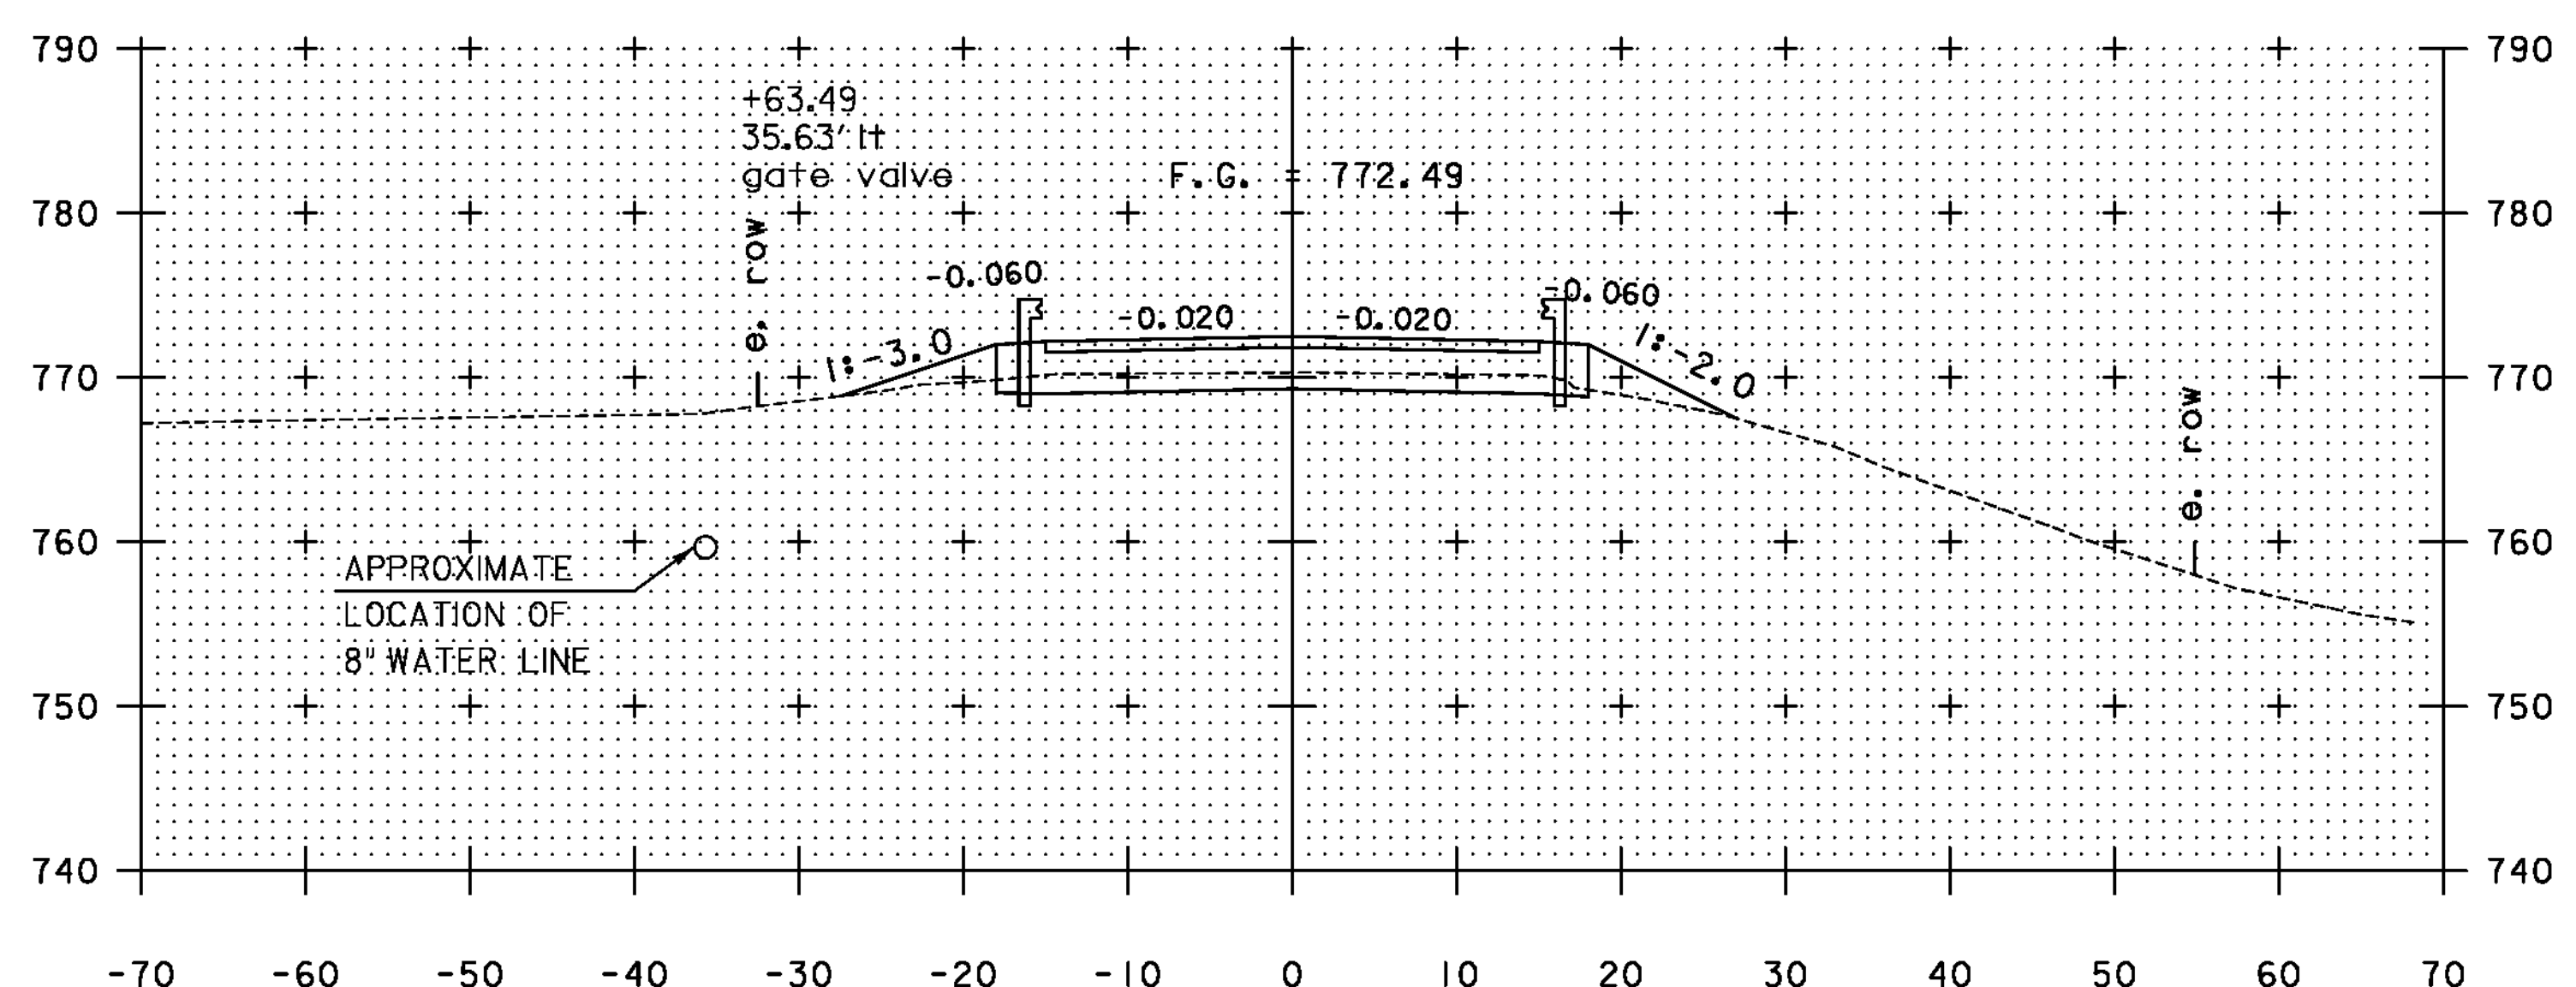

503+50

STA 503+23.06
END BRIDGE

STA. 503+50 TO STA. 505+00

PROJECT NAME: CAVENDISH
PROJECT NUMBER: ER BRF 0146(13)

FILE NAME: zllc3l8bdr_xs.dgn
PROJECT LEADER: J. OLUND
DESIGNED BY: J. HOWE
VT 131 CROSS SECTIONS 2

PLOT DATE: 7/19/2013
DRAWN BY: J. DAVIS
CHECKED BY: D. BRYANT
SHEET 40 OF 49

SCALE 1" = 10'-0"

TYLIN INTERNATIONAL