


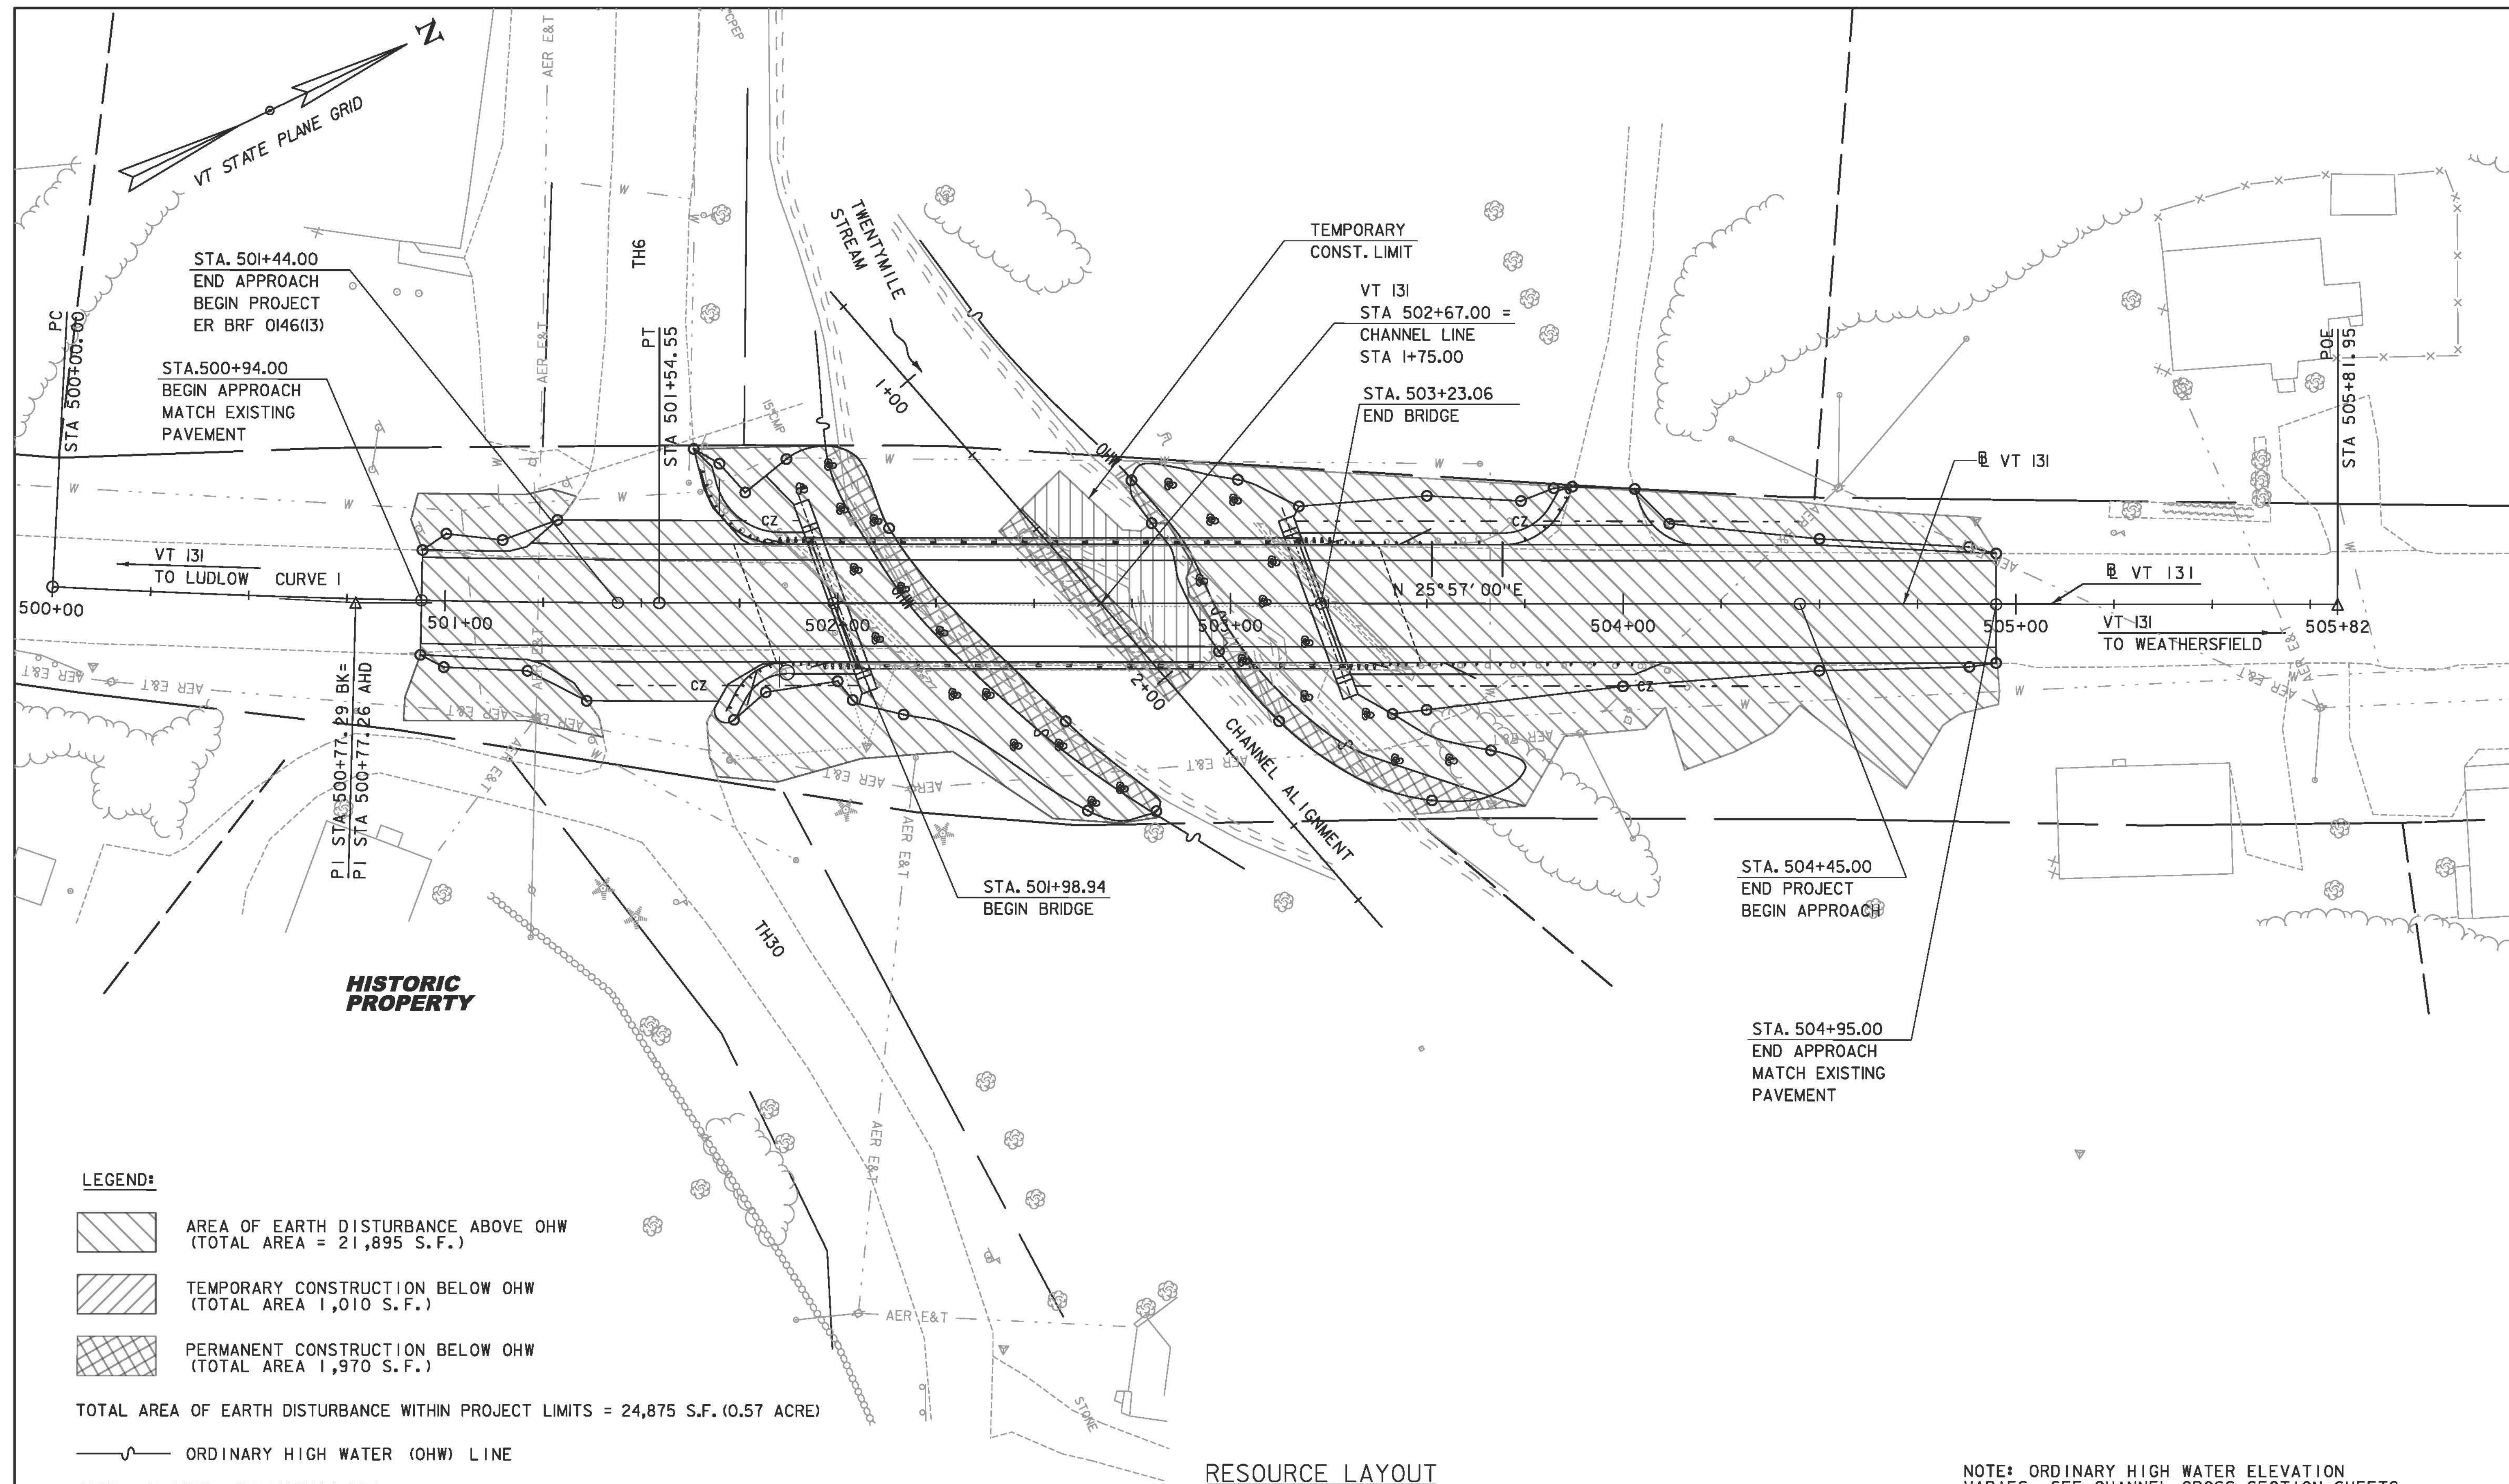

NOTE: ORDINARY HIGH WATER ELEVATION
VARIES, SEE CHANNEL CROSS SECTION SHEETS.

PROJECT NAME: CAVENDISH
PROJECT NUMBER: ER BR 0146(13)

FILE NAME: zllc318bdr_Rldgn
PROJECT LEADER: J. OLUND
DESIGNED BY: D. BURHANS
RESOURCE LAYOUT

PLOT DATE: 7/19/2013
DRAWN BY: D. BURHANS
CHECKED BY: D. BRYANT
SHEET 43 OF 49

SCALE 1" = 20' - 0"
20 0 20

TYLIN INTERNATIONAL