
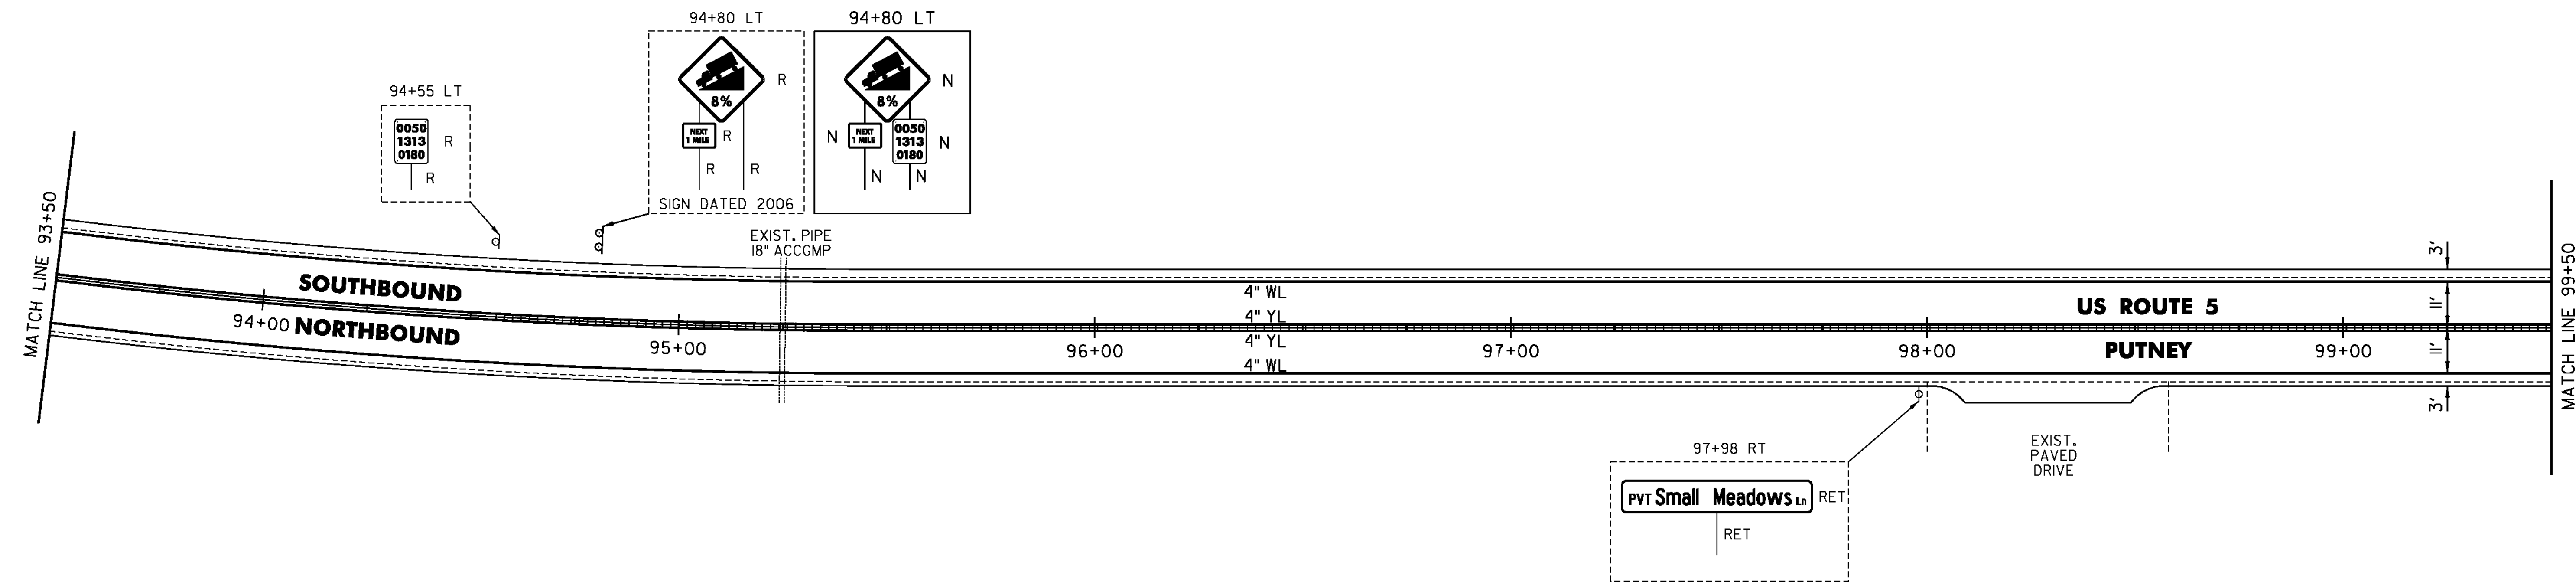


TEMPORARY 4 INCH WHITE LINE, PAINT
DURABLE 4 INCH WHITE LINE (OPTION BID ITEM)
87+50 TO 99+50 SOLID LT & RT

TEMPORARY 4 INCH YELLOW LINE, PAINT
87+50 TO 99+50 SOLID LT & RT
DURABLE 4 INCH YELLOW LINE (OPTION BID ITEM)
87+50 TO 94+56 SOLID LT & RT
DURABLE 4 INCH YELLOW LINE, POLYUREA
94+56 TO 99+50 SOLID LT & RT

MILLED RUMBLE STRIPS
94+56 TO 99+50 CL
REMOVING SIGNS
AS SHOWN - 4

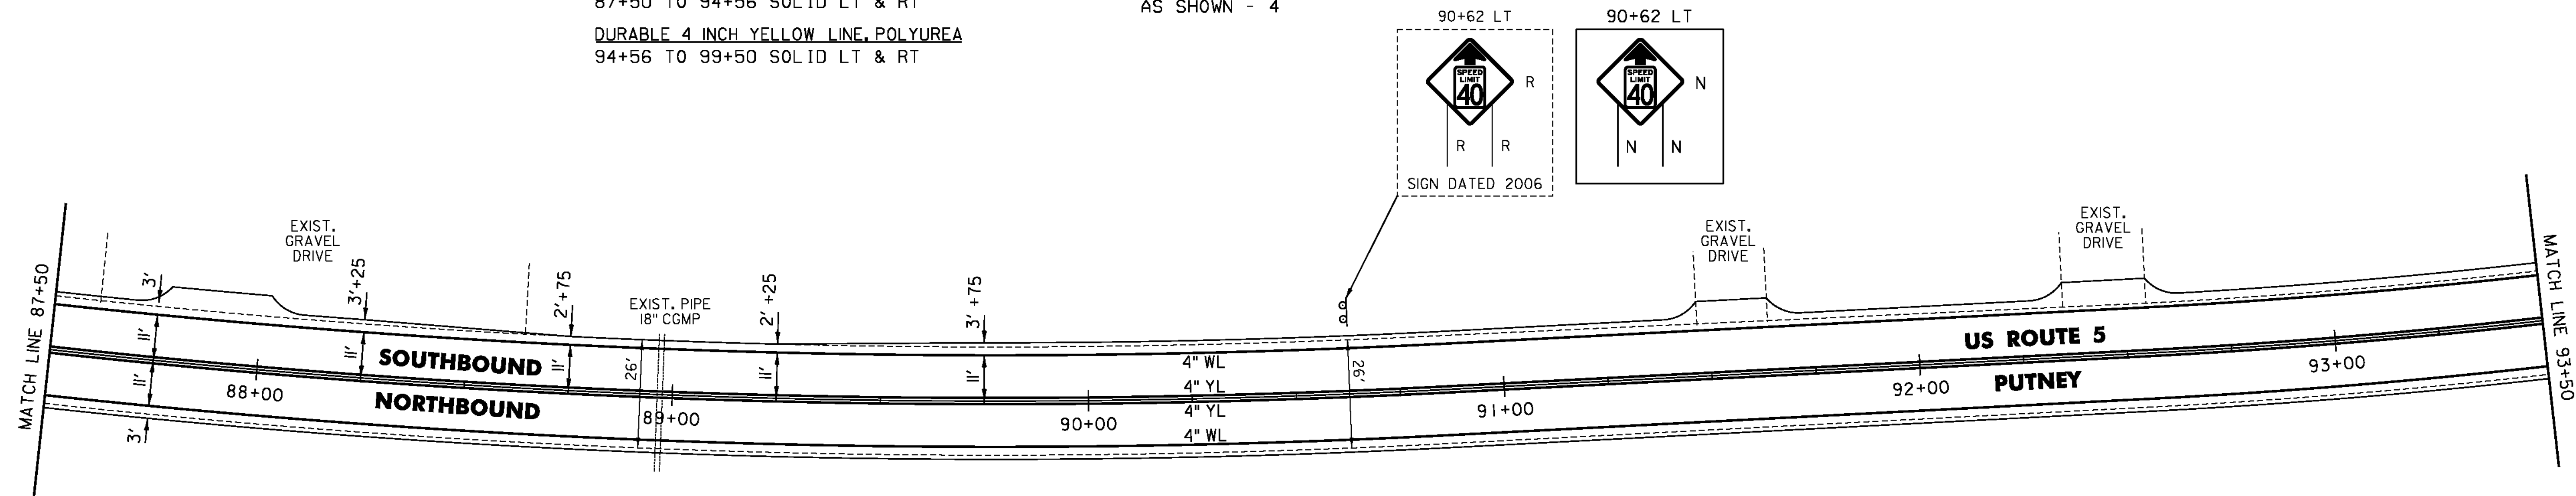

- LEGEND**
- R = REMOVE EXISTING
 - S = SALVAGE
 - R&S = REMOVE AND SALVAGE
 - N = NEW
 - RET = RETAIN
 - B-B = BACK TO BACK
 - = EXISTING GUARDRAIL
 - = PROPOSED GUARDRAIL
 - YL = YELLOW LINE
 - WL = WHITE LINE
 - = DELINEATOR
 - = UTILITY POLE

NOT TO SCALE

PROJECT NAME: PUTNEY-WESTMINSTER
PROJECT NUMBER: STP 2946(I)

FILE NAME: zllc344bdr.dgn
PROJECT LEADER: P. SHEDD
DESIGNED BY: N. LEMAY
ROADWAY LAYOUT 8 US 5

PLOT DATE: 12/10/2013
DRAWN BY: W. GORDON
CHECKED BY: P. SHEDD
SHEET 29 OF 138