

TEMPORARY 4 INCH WHITE LINE, PAINT
DURABLE 4 INCH WHITE LINE (OPTION BID ITEM)
278+50 TO 290+50 SOLID LT & RT

TEMPORARY 4 INCH YELLOW LINE, PAINT
DURABLE 4 INCH YELLOW LINE, POLYUREA
278+50 TO 290+50 SOLID LT & RT


STEEL BEAM GUARDRAIL, GALVANIZED
278+55.5 TO 278+93 RT
279+76.5 TO 280+14 LT

ANCHOR FOR STEEL BEAM RAIL
278+93 RT
280+14 LT

REMOVAL AND DISPOSAL OF GUARDRAIL
278+55.5 TO 278+93 RT
279+76.5 TO 280+14 LT

DELINEATOR WITH STEEL POST
278+93 RT
280+14 LT

MILLED RUMBLE STRIPS
278+50 TO 290+50 CL

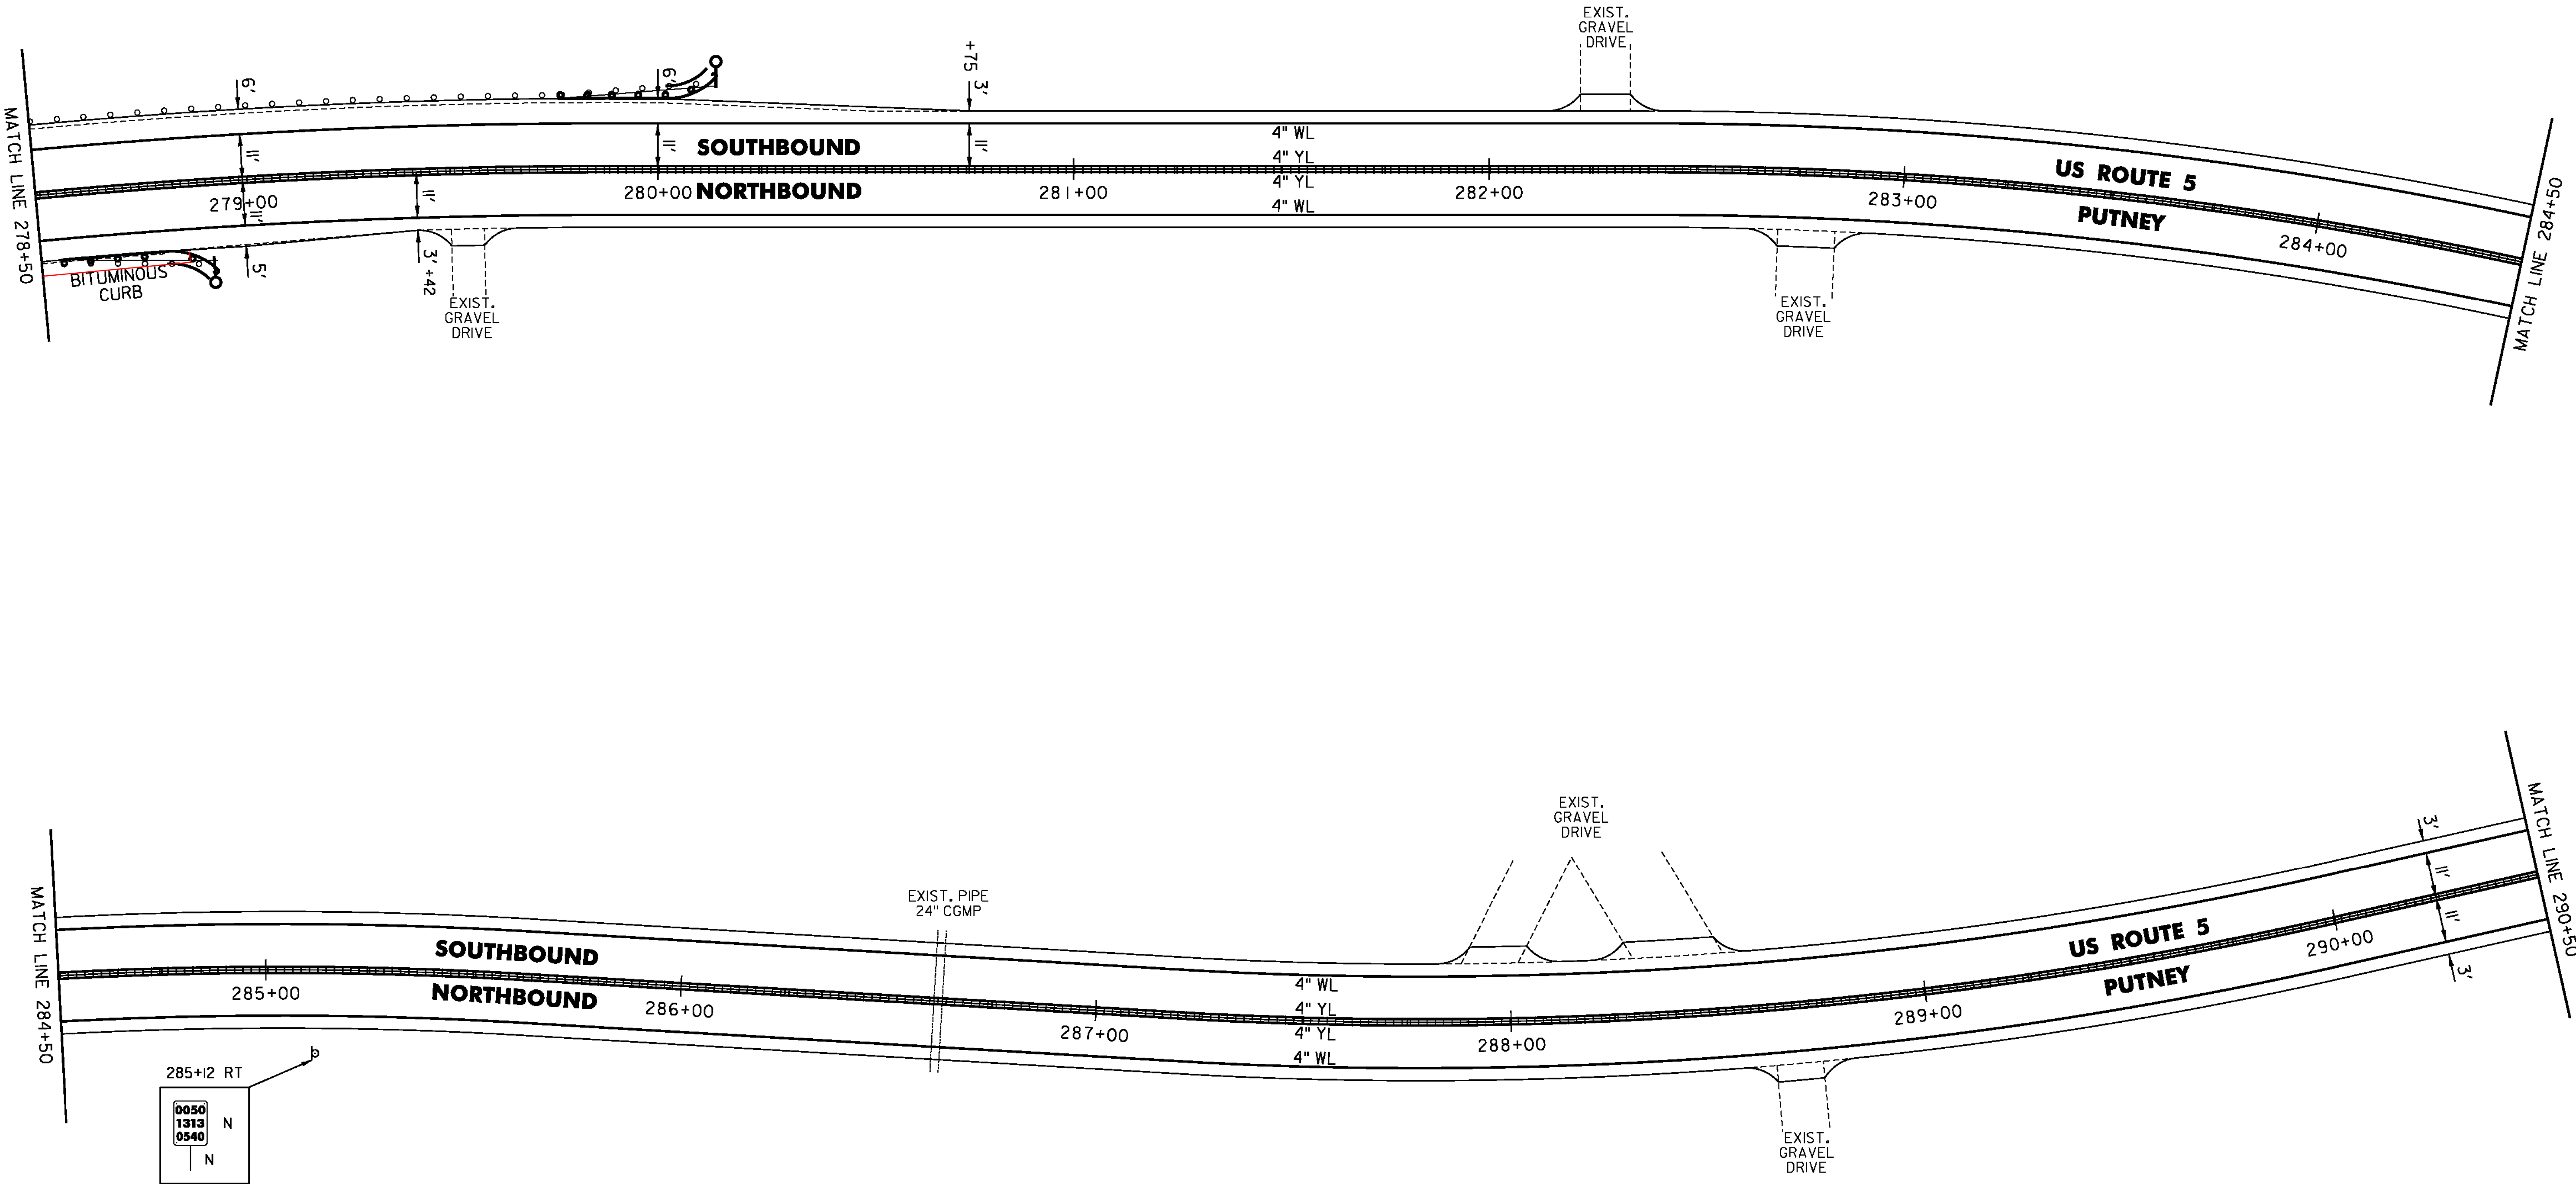

285+12 RT

0050	N
1313	
0540	N

- LEGEND**
- R = REMOVE EXISTING
 - S = SALVAGE
 - R&S = REMOVE AND SALVAGE
 - N = NEW
 - RET = RETAIN
 - B-B = BACK TO BACK
 - EXISTING GUARDRAIL
 - PROPOSED GUARDRAIL
 - YL = YELLOW LINE
 - WL = WHITE LINE
 - DELINEATOR
 - UTILITY POLE

NOT TO SCALE

PROJECT NAME: PUTNEY-WESTMINSTER
PROJECT NUMBER: STP 2946(I)

FILE NAME: zllc344bdr.dgn	PLOT DATE: 12/10/2013
PROJECT LEADER: P. SHEDD	DRAWN BY: W. GORDON
DESIGNED BY: N. LEMAY	CHECKED BY: P. SHEDD
ROADWAY LAYOUT 3I US 5	SHEET 52 OF 138