


TEMPORARY 4 INCH WHITE LINE, PAINT  
DURABLE 4 INCH WHITE LINE (OPTION BID ITEM)  
W303+50 TO W309+50 SOLID LT & RT

TEMPORARY 4 INCH YELLOW LINE, PAINT  
DURABLE 4 INCH YELLOW LINE (OPTION BID ITEM)  
W303+50 TO W309+50 SOLID LT & RT

~~STEEL BEAM GUARDRAIL, GALVANIZED~~  
~~W307+37.5 TO W309+50 LT~~  
~~W307+37.5 TO W309+50 RT~~

~~ANCHOR FOR STEEL BEAM RAIL~~  
~~W307+37.5 LT~~  
~~W307+37.5 RT~~

~~DELINEATOR WITH STEEL POST~~  
~~W307+37.5 LT~~  
~~W307+37.5 RT~~

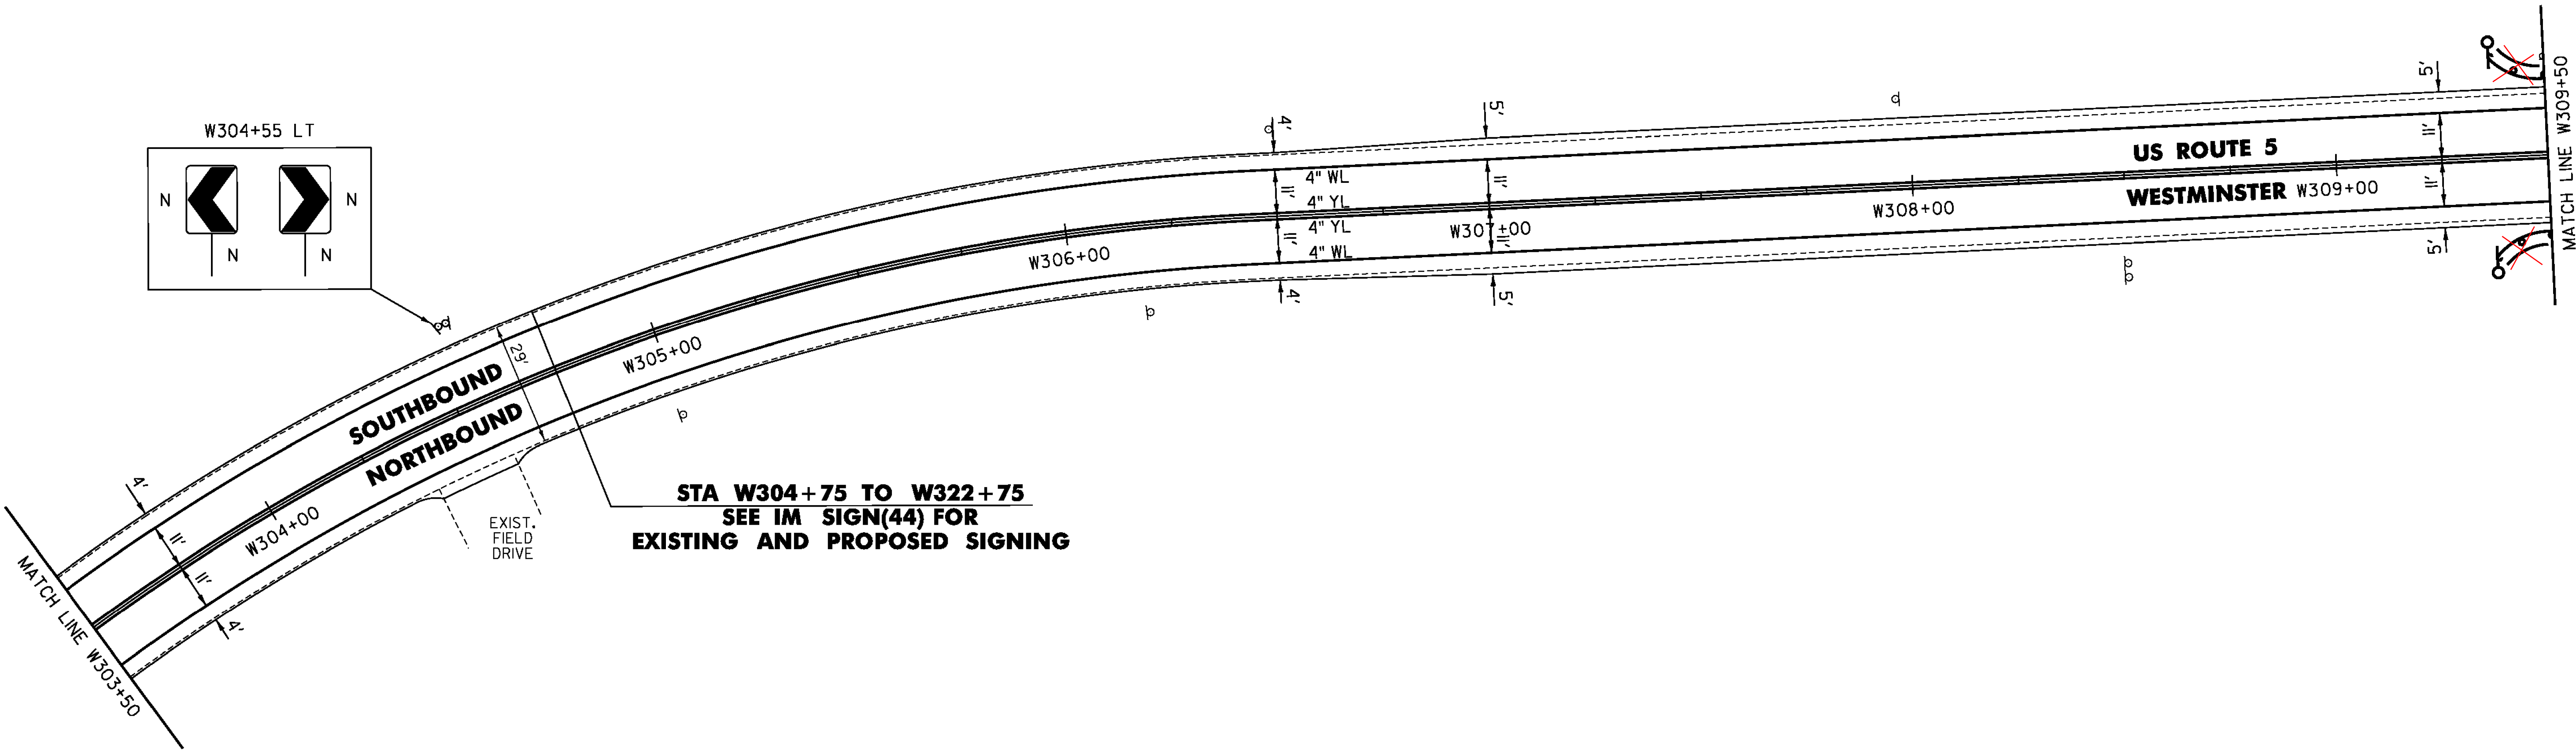

**STA W304+75 TO W322+75  
SEE IM SIGN(44) FOR  
EXISTING AND PROPOSED SIGNING**

- LEGEND**
- R = REMOVE EXISTING
  - S = SALVAGE
  - R&S = REMOVE AND SALVAGE
  - N = NEW
  - RET = RETAIN
  - B-B = BACK TO BACK
  - = EXISTING GUARDRAIL
  - = PROPOSED GUARDRAIL
  - YL = YELLOW LINE
  - WL = WHITE LINE
  - = DELINEATOR
  - = UTILITY POLE

|                                  |                       |
|----------------------------------|-----------------------|
| PROJECT NAME: PUTNEY-WESTMINSTER |                       |
| PROJECT NUMBER: STP 2946(I)      |                       |
| FILE NAME: zllc344bdr.dgn        | PLOT DATE: 12/10/2013 |
| PROJECT LEADER: P. SHEDD         | DRAWN BY: W. GORDON   |
| DESIGNED BY: N. LEMAY            | CHECKED BY: P. SHEDD  |
| ROADWAY LAYOUT 65 US 5           | SHEET 86 OF 138       |

NOT TO SCALE