

TEMPORARY 4 INCH WHITE LINE, PAINT
DURABLE 4 INCH WHITE LINE (OPTION BID ITEM)
W400+50 TO W402+00 SOLID LT
W400+50 TO W406+50 SOLID RT
W403+21 TO W406+50 SOLID LT
W403+48 TO W404+10 SOLID LT (LANE LINE)
W404+10 TO W405+11 DOTTED LT (LANE LINE)


TEMPORARY 4 INCH YELLOW LINE, PAINT
DURABLE 4 INCH YELLOW LINE (OPTION BID ITEM)
W400+50 TO W402+18 SOLID LT & RT
W402+08 TO W402+32 DOUBLE SOLID LT (TH 24)
W402+58 TO W403+86 SOLID LT & RT
W403+26 TO W406+50 SOLID LT & RT
W403+05 LT SINGLE SOLID (SCHOOL ENT.)

TEMPORARY 24" STOP BAR, PAINT
DURABLE 24" STOP BAR (OPTION BID ITEM)
W402+17 TO W402+31 LT (TH 24)
W402+78 TO W403+06 LT

REMOVING SIGNS
AS SHOWN - 3

TEMPORARY LETTER OR SYMBOL, PAINT
W402+22 LT - "STOP" (TH 24)
W403+56 LT - "ONLY"
W404+07 LT - RIGHT TURN ARROW

DURABLE LETTER OR SYMBOL (OPTION BID ITEM)
W402+22 LT - "STOP" (TH 24)
W403+56 LT - "ONLY"
W404+07 LT - RIGHT TURN ARROW

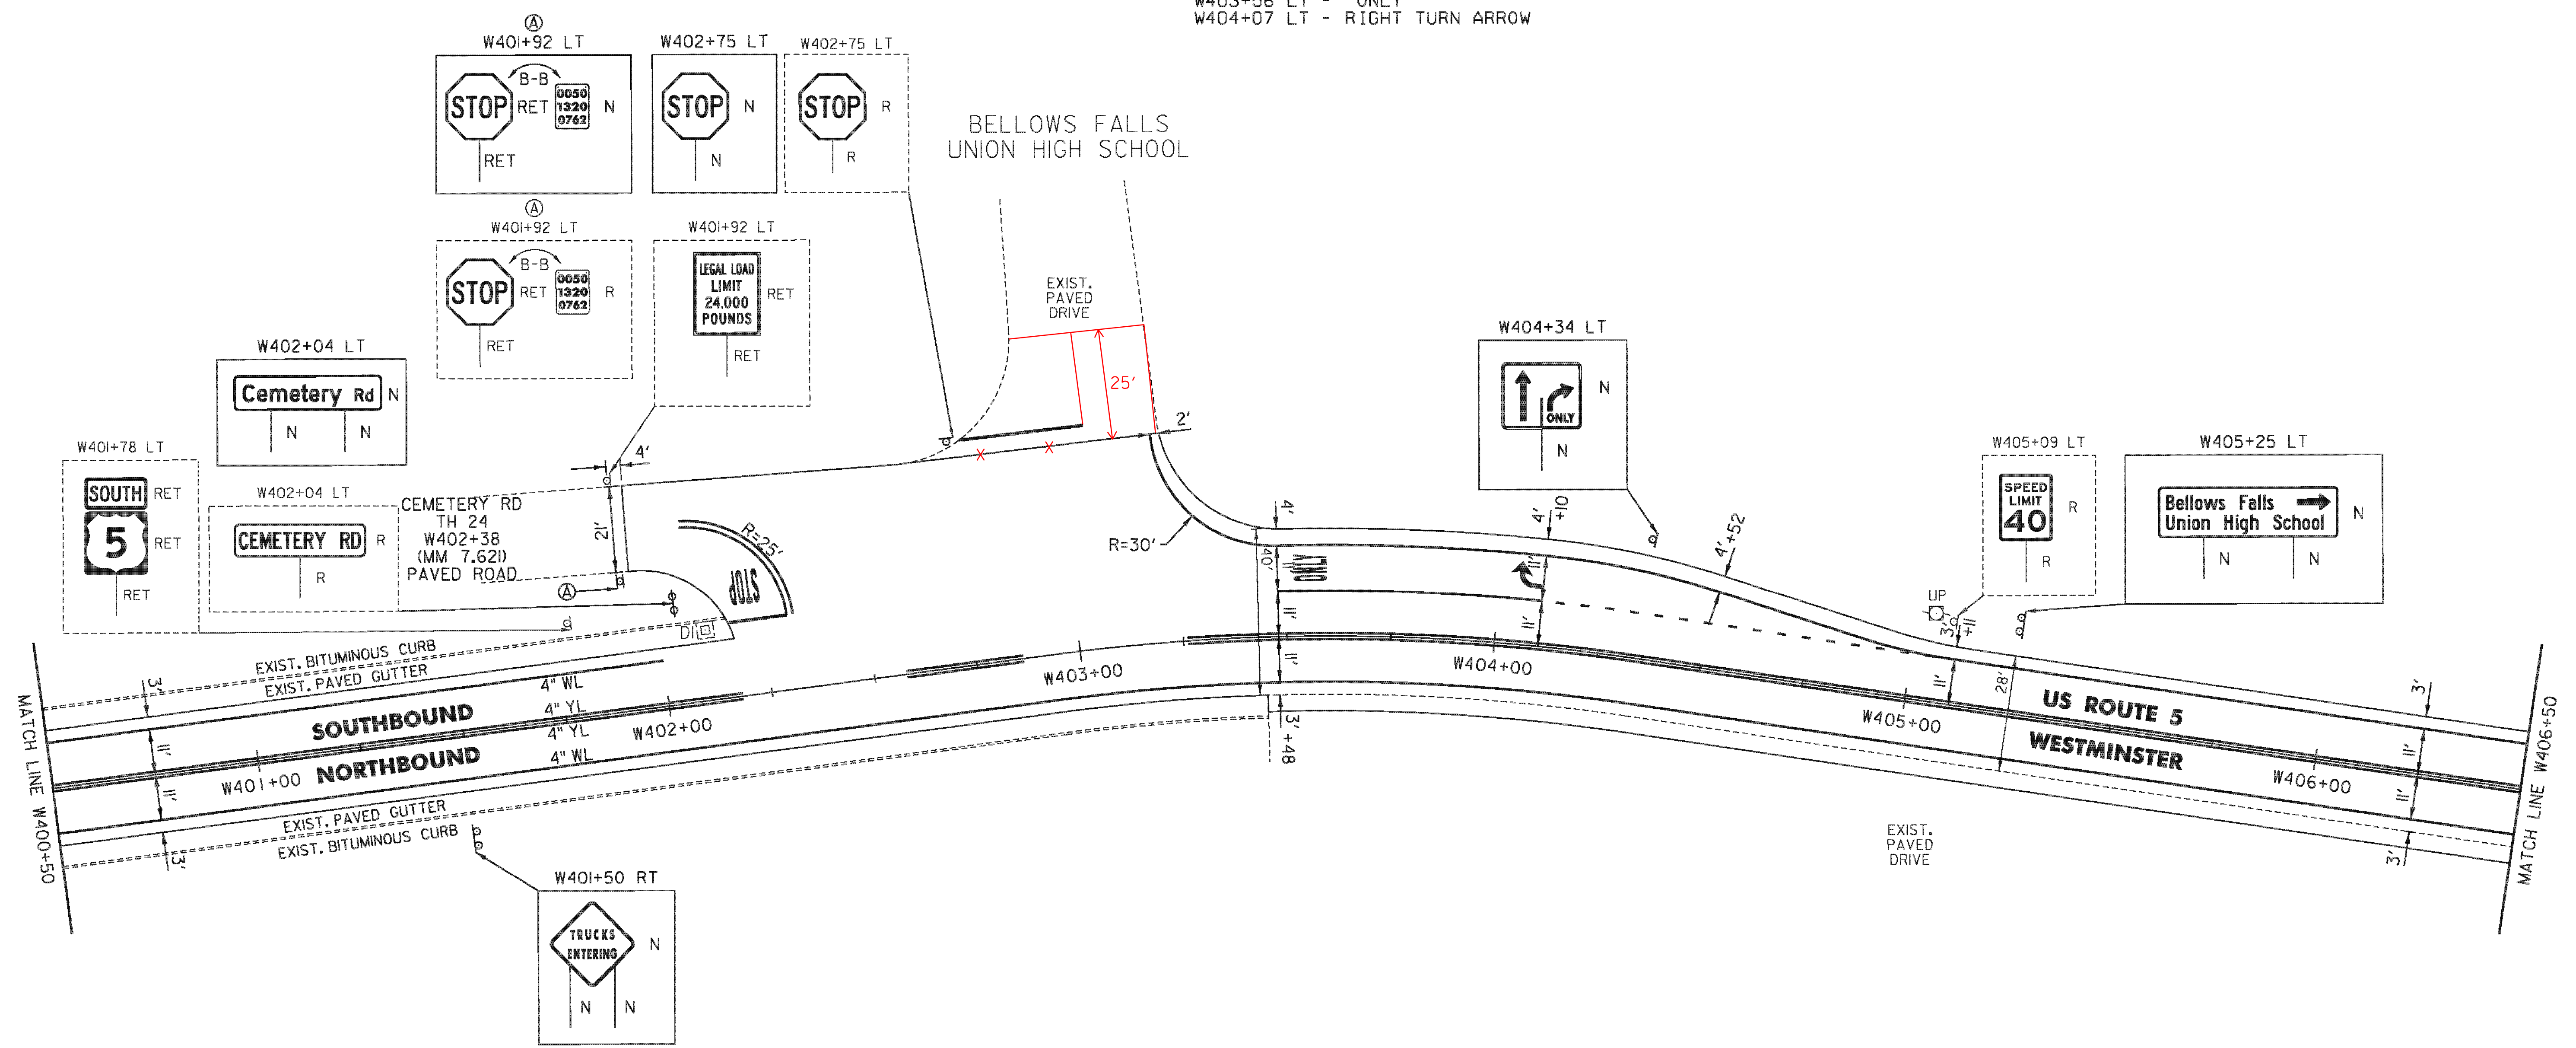

NOT TO SCALE

- LEGEND
- R = REMOVE EXISTING
 - S = SALVAGE
 - R&S = REMOVE AND SALVAGE
 - N = NEW
 - RET = RETAIN
 - B-B = BACK TO BACK
 - EXISTING GUARDRAIL
 - PROPOSED GUARDRAIL
 - YL = YELLOW LINE
 - WL = WHITE LINE
 - DELINEATOR
 - UTILITY POLE

PROJECT NAME: PUTNEY-WESTMINSTER	
PROJECT NUMBER: STP 2946(I)	
FILE NAME: zllc344bdr.dgn	PLOT DATE: 12/10/2013
PROJECT LEADER: P. SHEDD	DRAWN BY: W. GORDON
DESIGNED BY: N. LEMAY	CHECKED BY: P. SHEDD
ROADWAY LAYOUT 75 US 5	SHEET 96 OF 138