

TEMPORARY 4 INCH WHITE LINE, PAINT
DURABLE 4 INCH WHITE LINE (OPTION BID ITEM)
C21+50 TO C33+00 SOLID LT & RT

TEMPORARY 4 INCH YELLOW LINE, PAINT
DURABLE 4 INCH YELLOW LINE (OPTION BID ITEM)
C21+50 TO C26+40 DASHED LT, SOLID RT
C26+40 TO C33+00 SOLID LT & RT

STEEL BEAM GUARDRAIL, GALVANIZED

C21+50 TO C21+58 RT
C25+27.5 TO C25+65 LT
C25+28 TO C25+65.5 RT
C26+94.5 TO C27+32 RT

ANCHOR FOR STEEL BEAM RAIL

C25+27.5 LT
C25+65.5 RT
C26+94.5 RT

REMOVAL AND DISPOSAL OF GUARDRAIL



C21+50 TO C21+58 RT
C25+27.5 TO C25+65 LT
C25+28 TO C25+65.5 RT
C26+94.5 TO C27+32 RT

DELINEATOR WITH STEEL POST

C25+27.5 LT
C25+65.5 RT
C26+94.5 RT

REHAB. DROP INLETS, CATCH BASINS,
OR MANHOLES, CLASS I
C29+75 LT

STA. C0+00 TO C40+86
SEE IM SIGN(44) FOR
EXISTING AND PROPOSED SIGNING

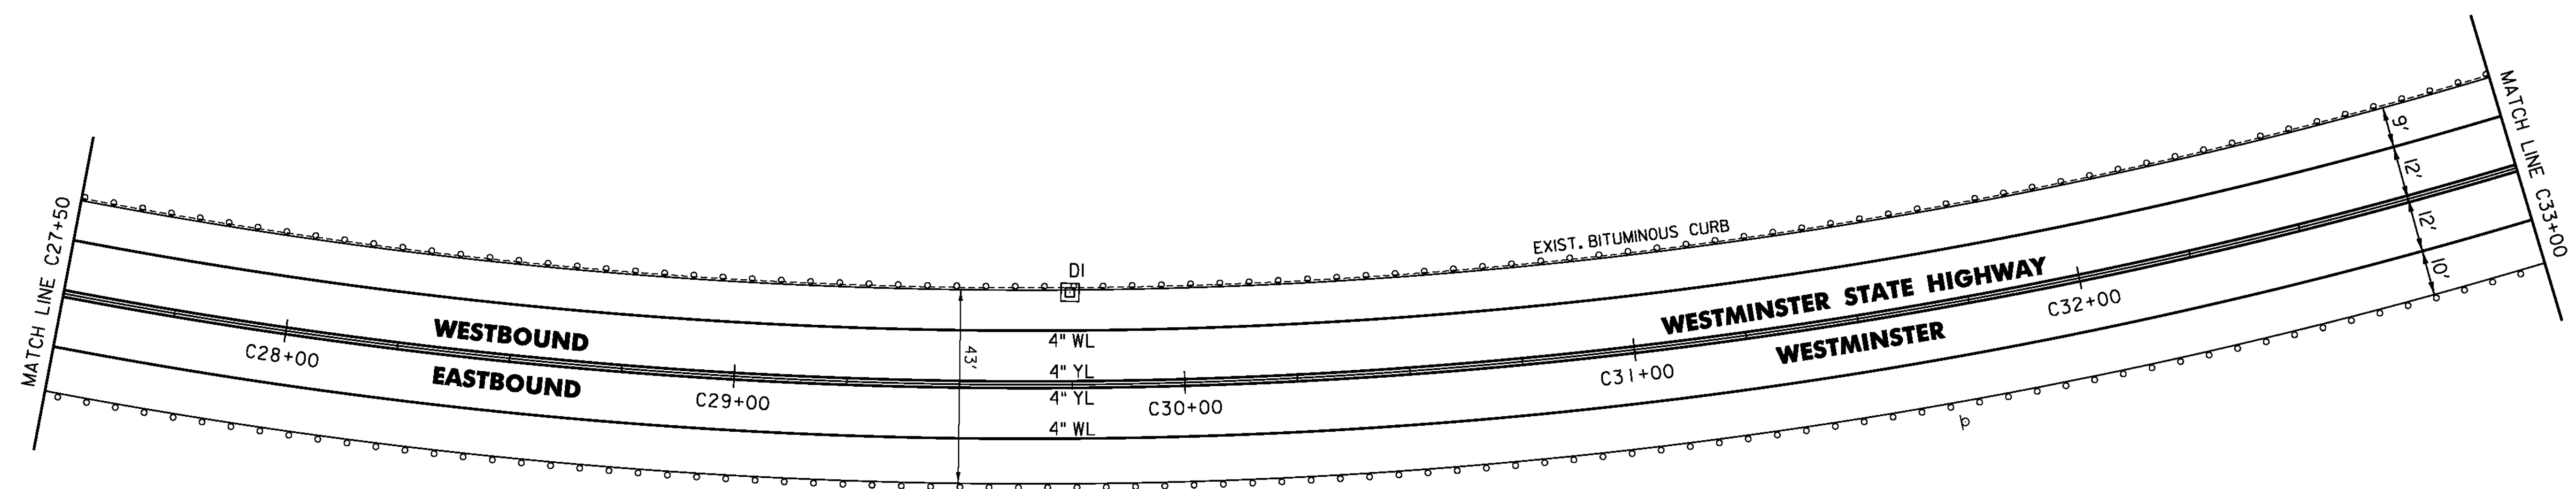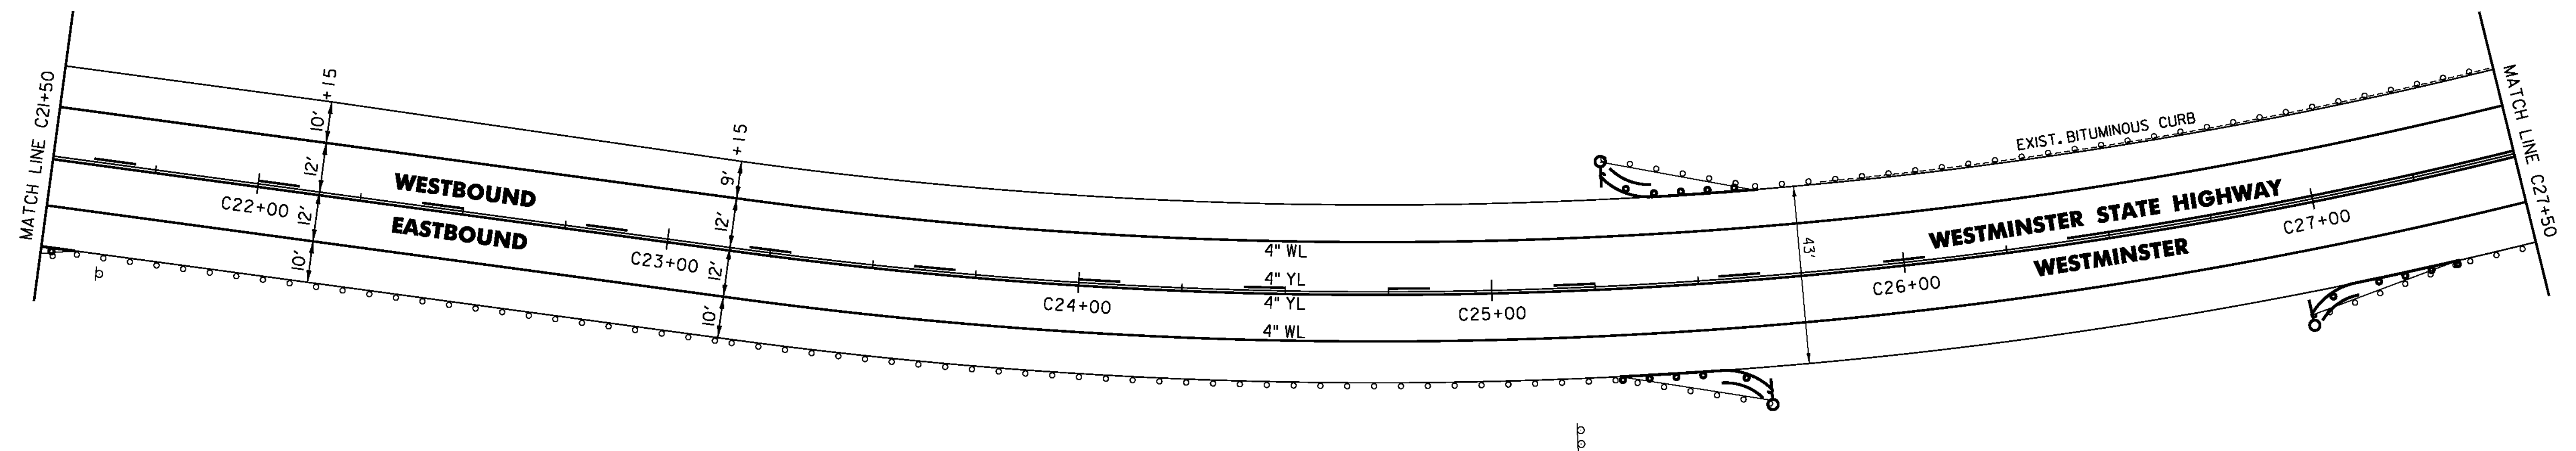

LEGEND

R = REMOVE EXISTING
S = SALVAGE
R&S = REMOVE AND SALVAGE
N = NEW
RET = RETAIN
B-B = BACK TO BACK
— = EXISTING GUARDRAIL
— = PROPOSED GUARDRAIL
YL = YELLOW LINE
WL = WHITE LINE
— = DELINEATOR
— = UTILITY POLE

PROJECT NAME: PUTNEY-WESTMINSTER

PROJECT NUMBER: STP 2946(1)

FILE NAME: zllc344bdr.dgn

PROJECT LEADER: P. SHEDD

DESIGNED BY: N. LEMAY

ROADWAY LAYOUT 85 WSH

PLOT DATE: 12/10/2013

DRAWN BY: W. GORDON

CHECKED BY: P. SHEDD

SHEET 106 OF 138

NOT TO SCALE