




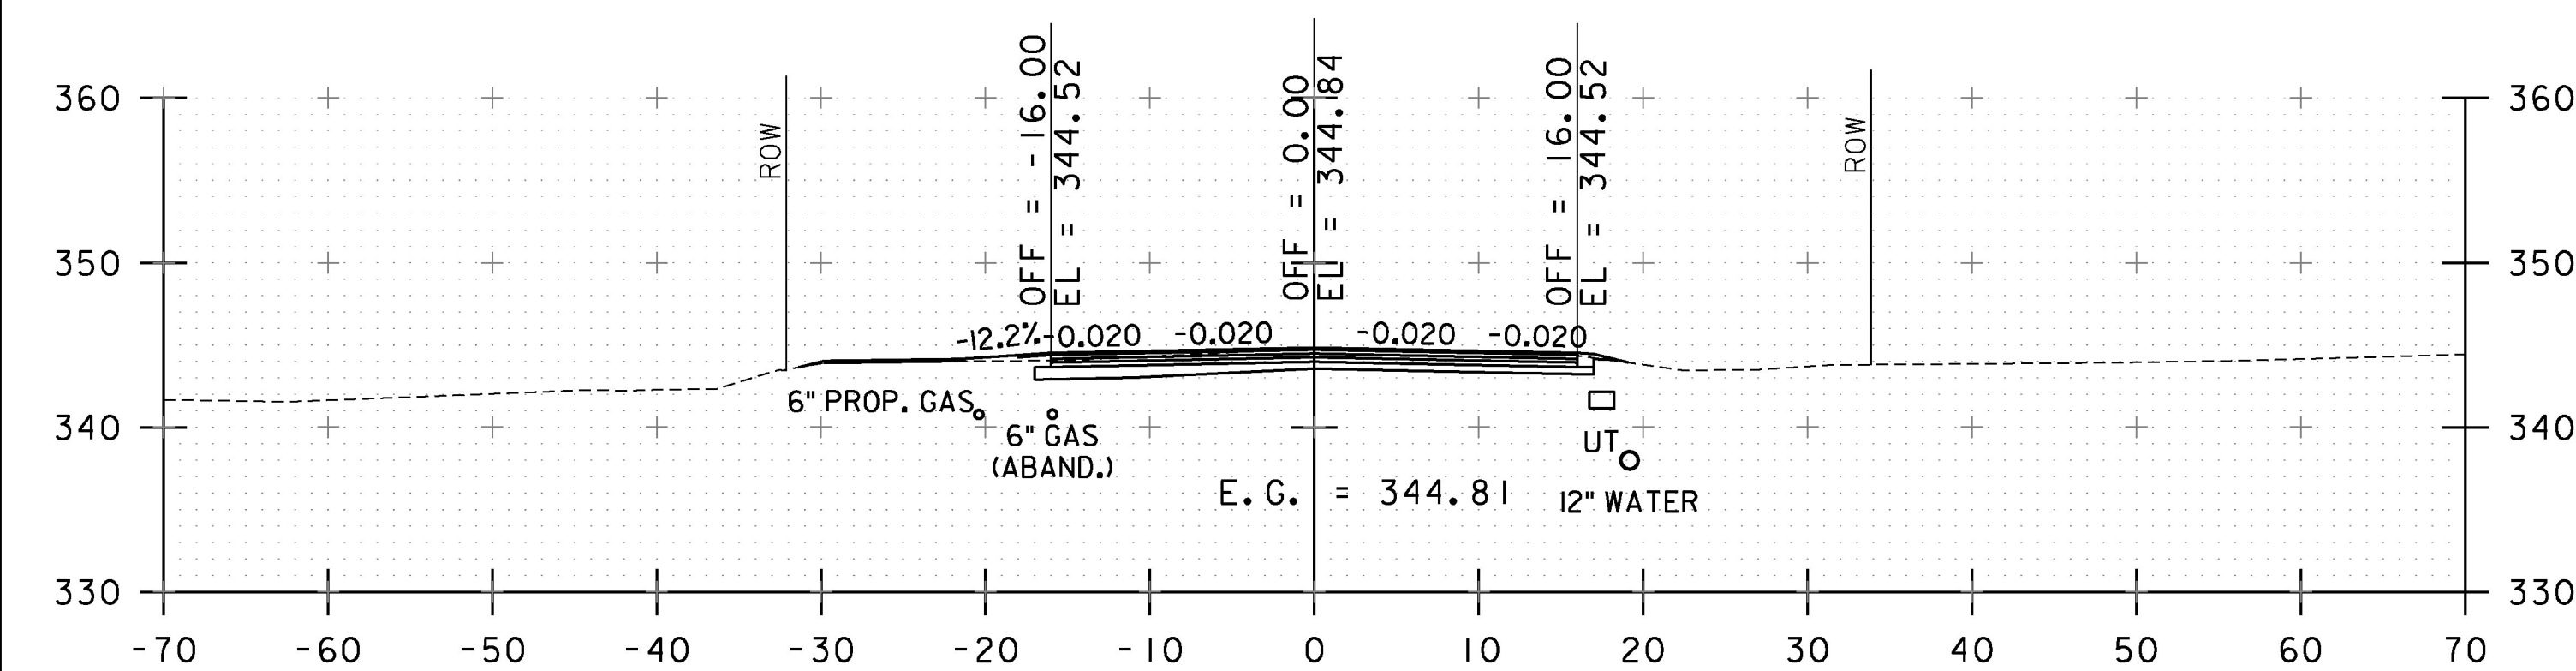


45+25

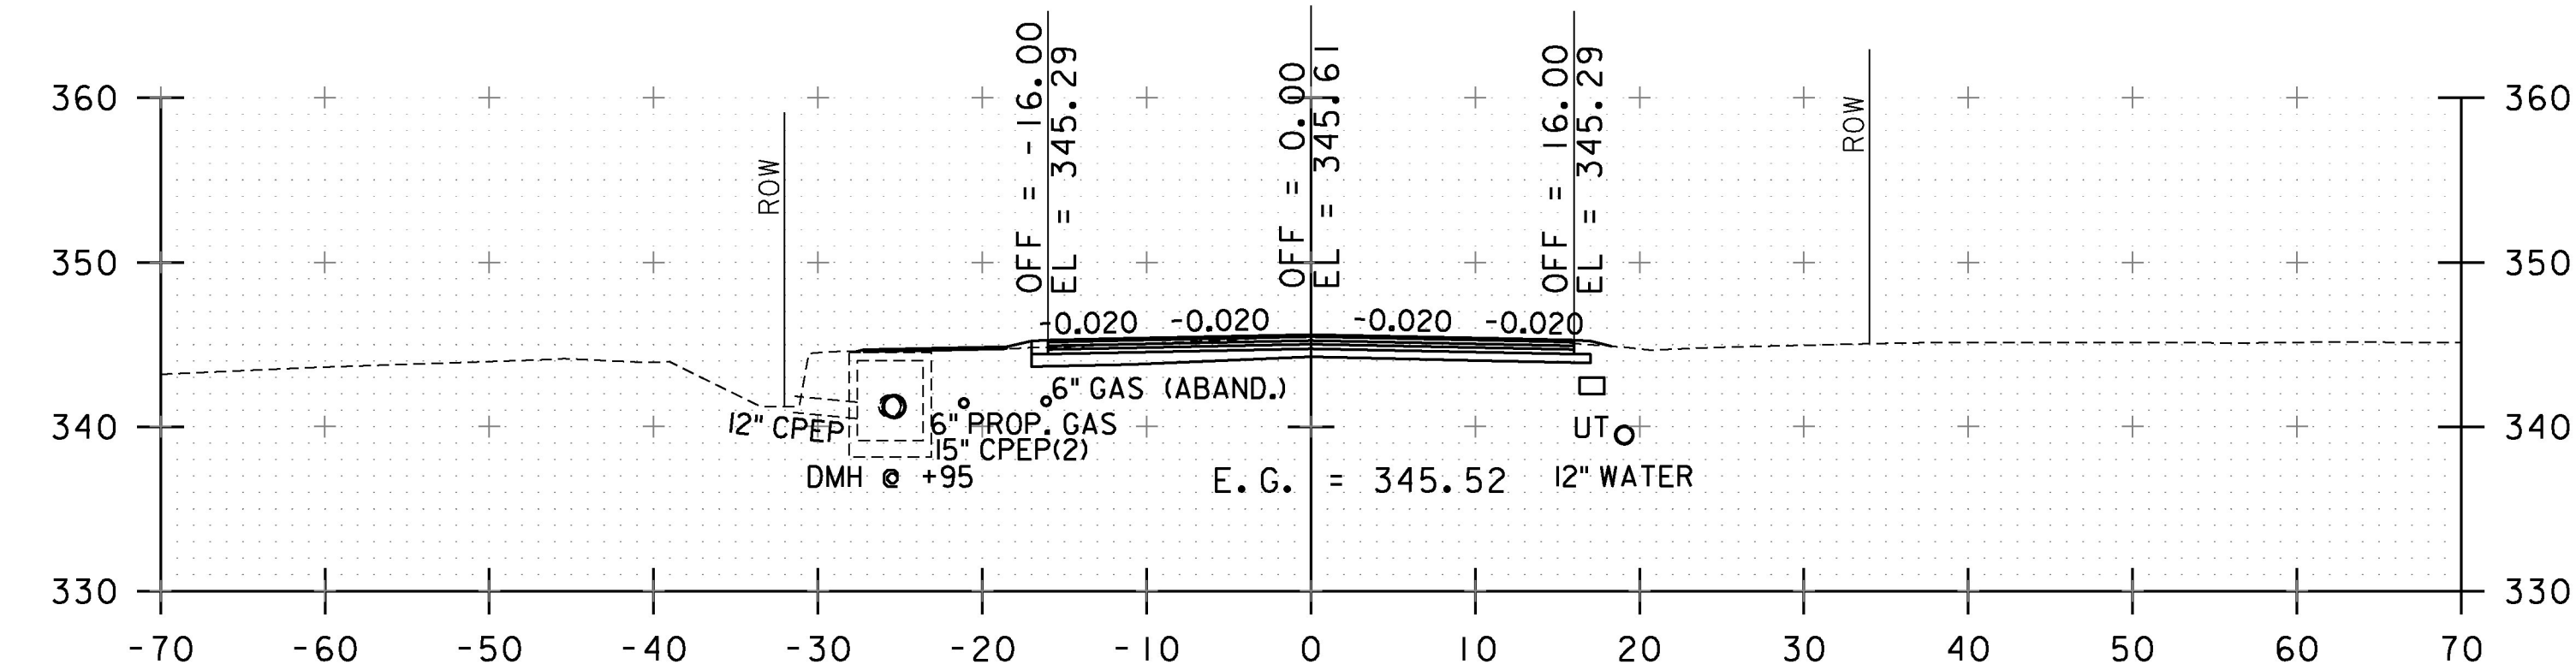


46+00

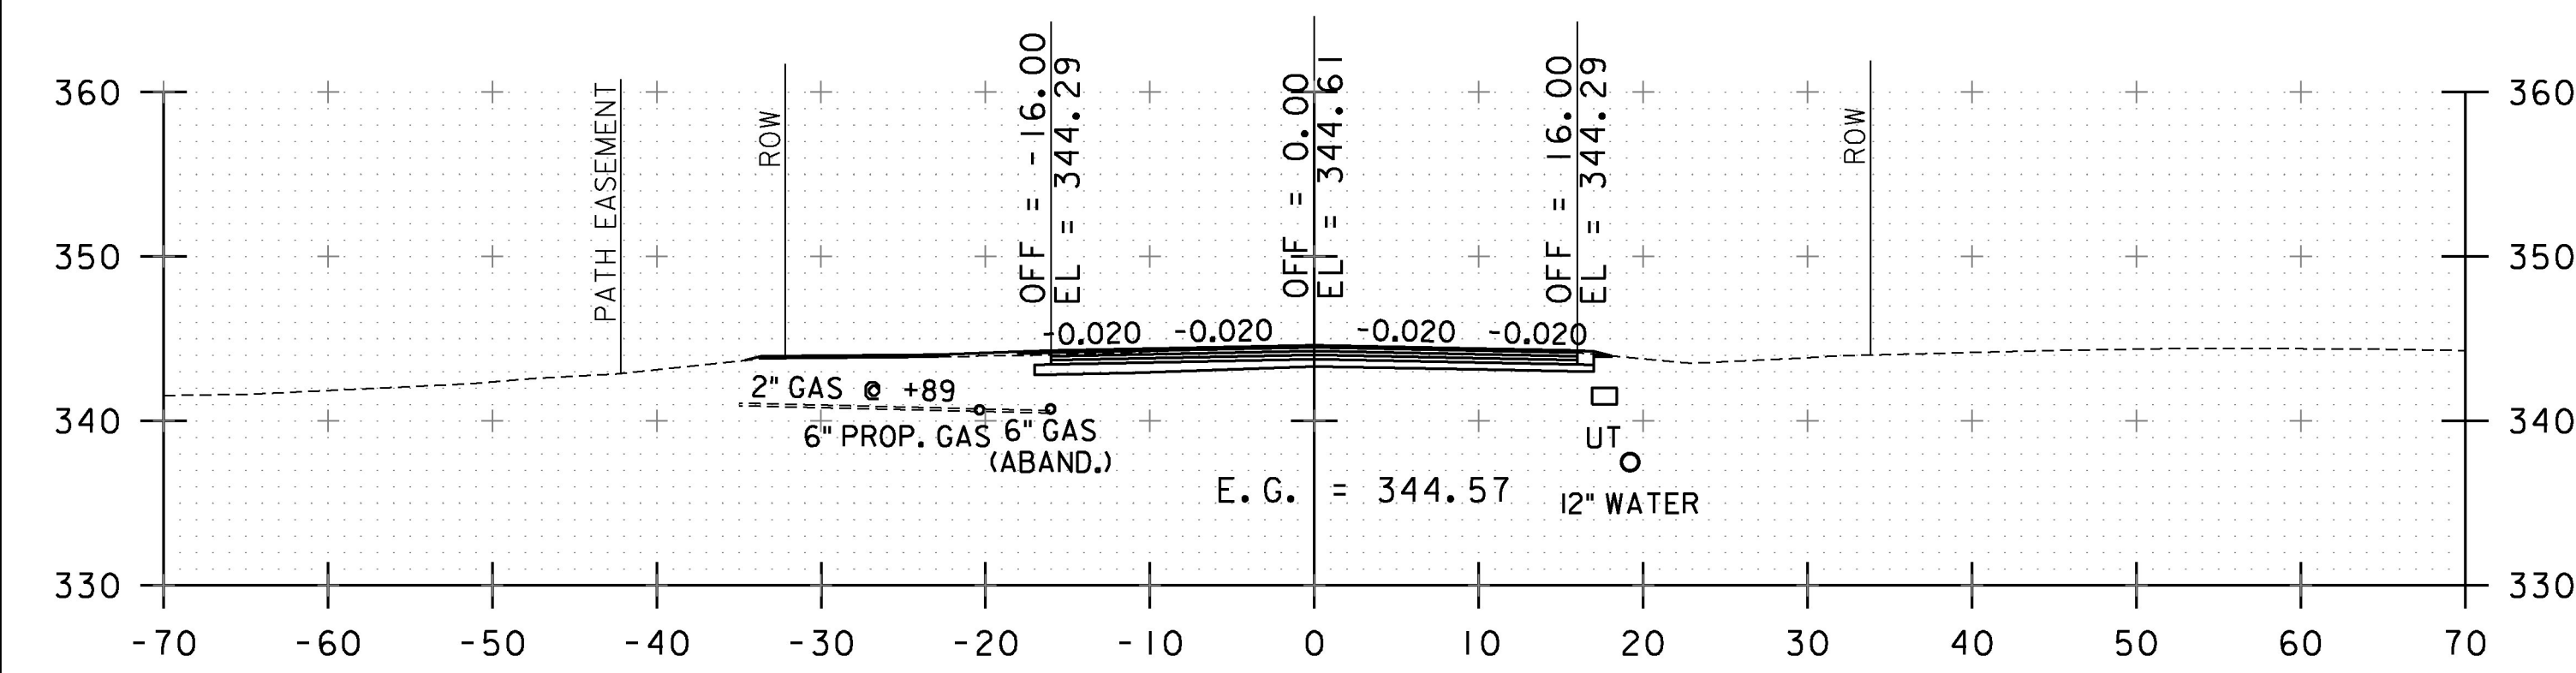


45+00

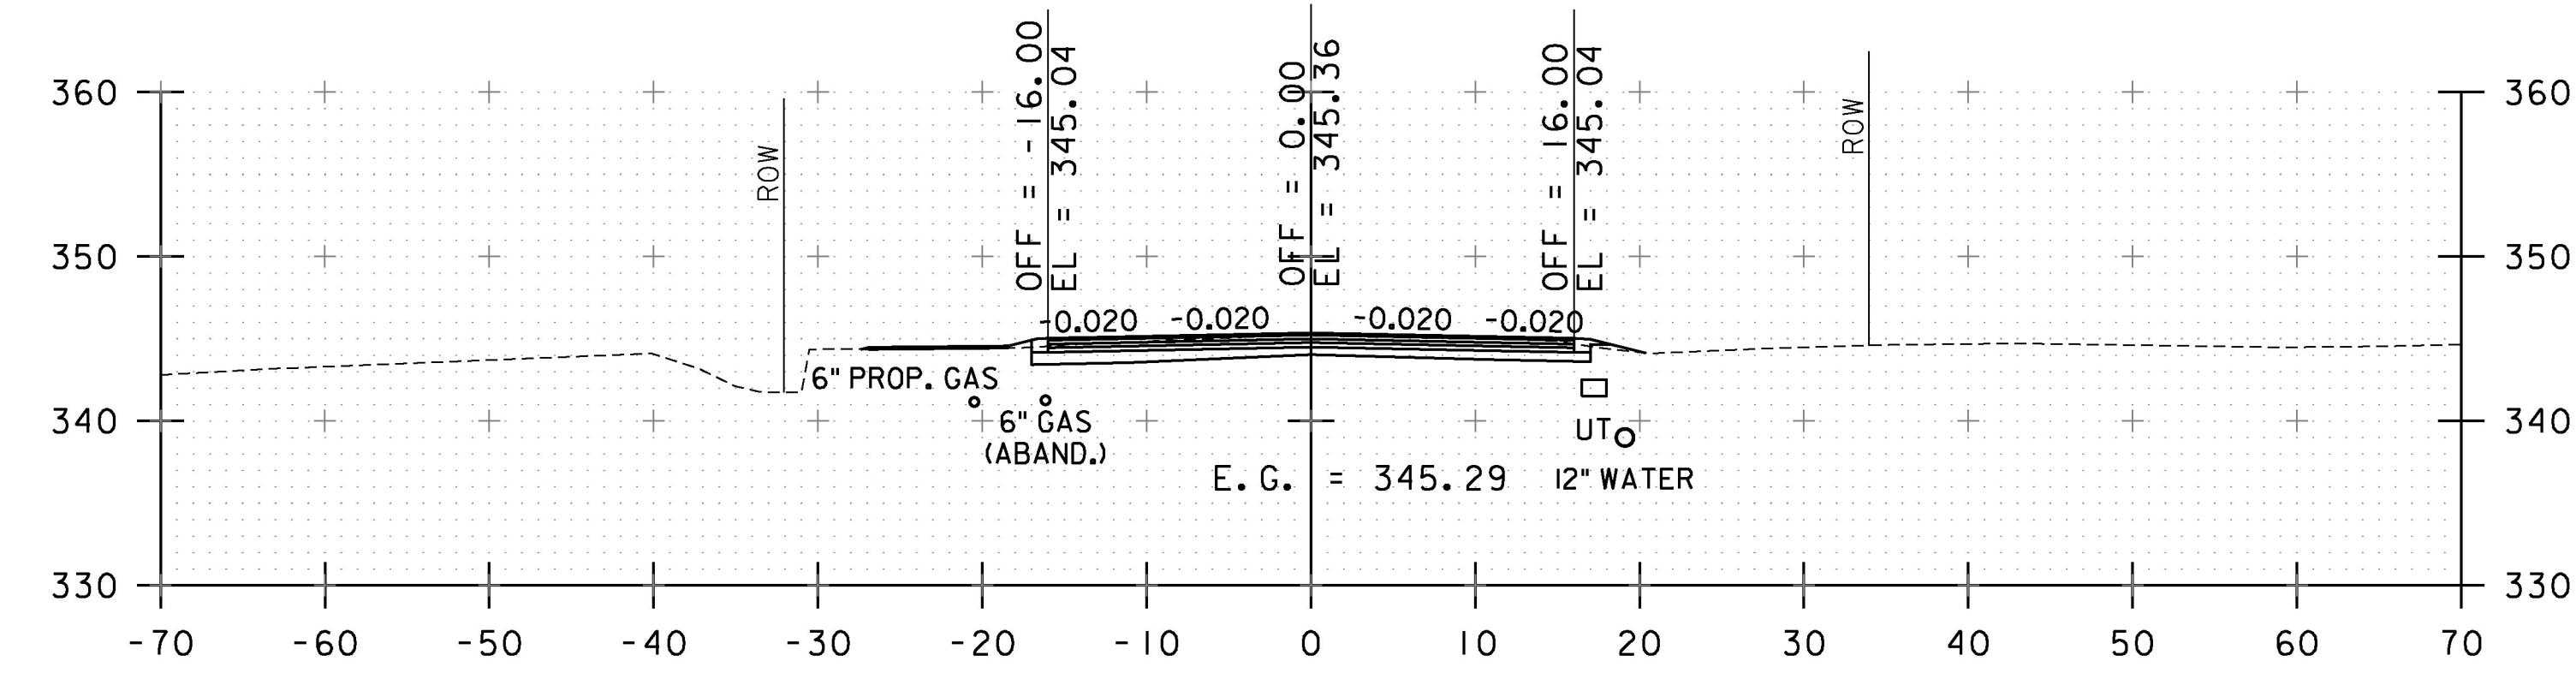


45+75

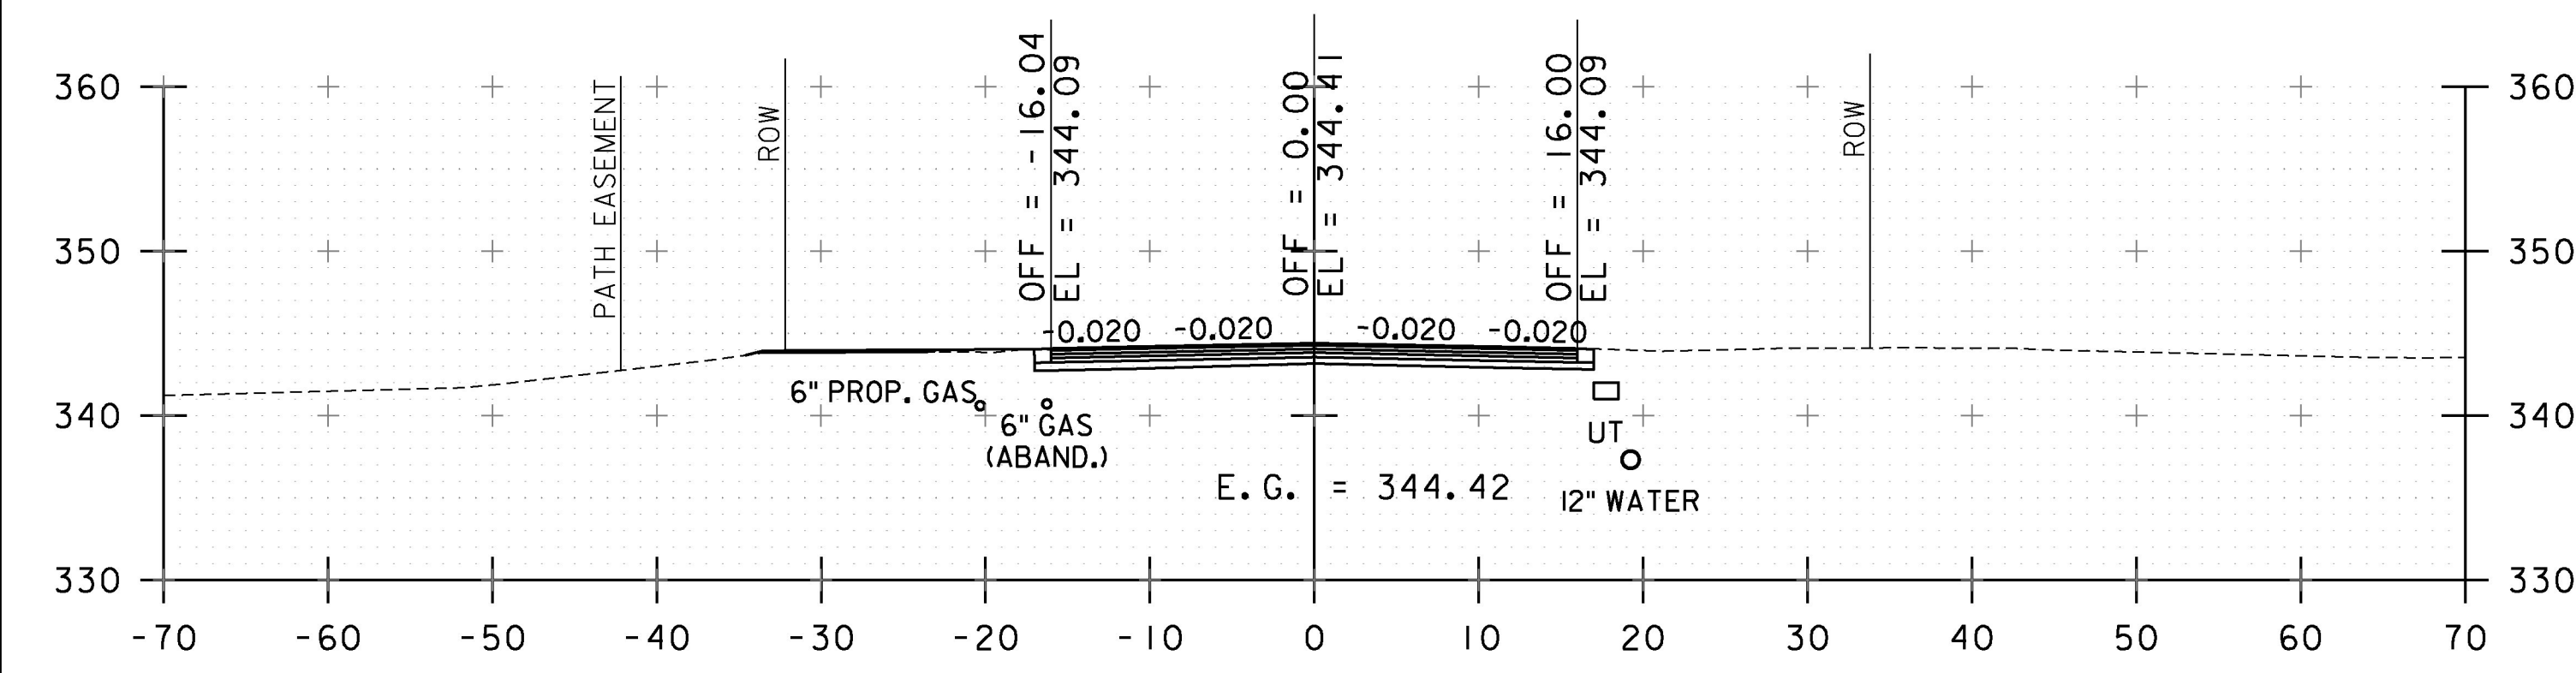

44+75

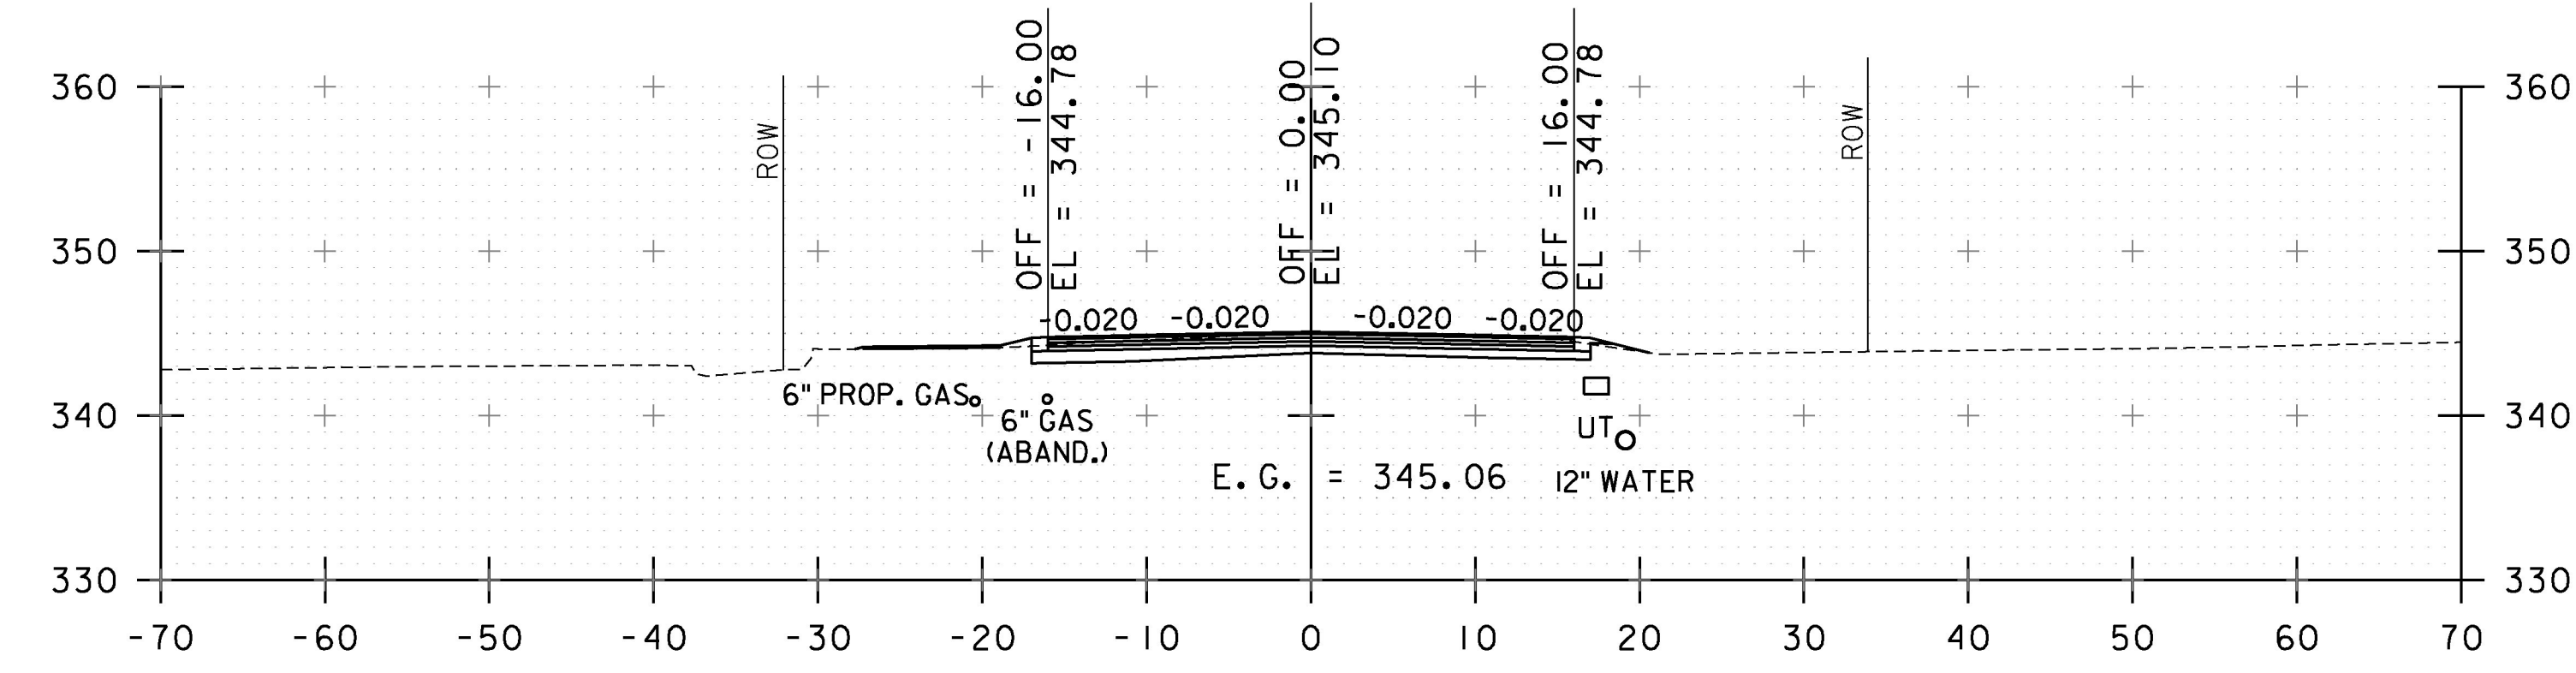

45+50

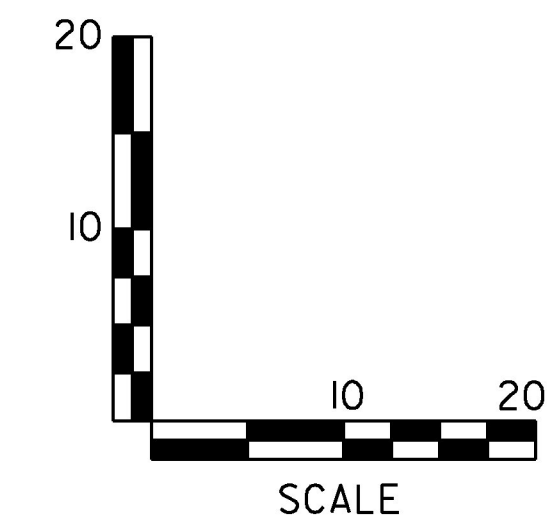

STA. W 44+75 TO STA. W 46+00

PROJECT NAME: SOUTH BURLINGTON-WILLISTON	
PROJECT NUMBER: NH 2944(I)	
FILE NAME: zild340xsl.dgn	PLOT DATE: 2/15/2017
PROJECT LEADER: G. EDWARDS	DRAWN BY: I. MAYNARD
DESIGNED BY: I. MAYNARD	CHECKED BY: J. LITTLE
CROSS SECTION SHEET 46	SHEET 166 OF 249