


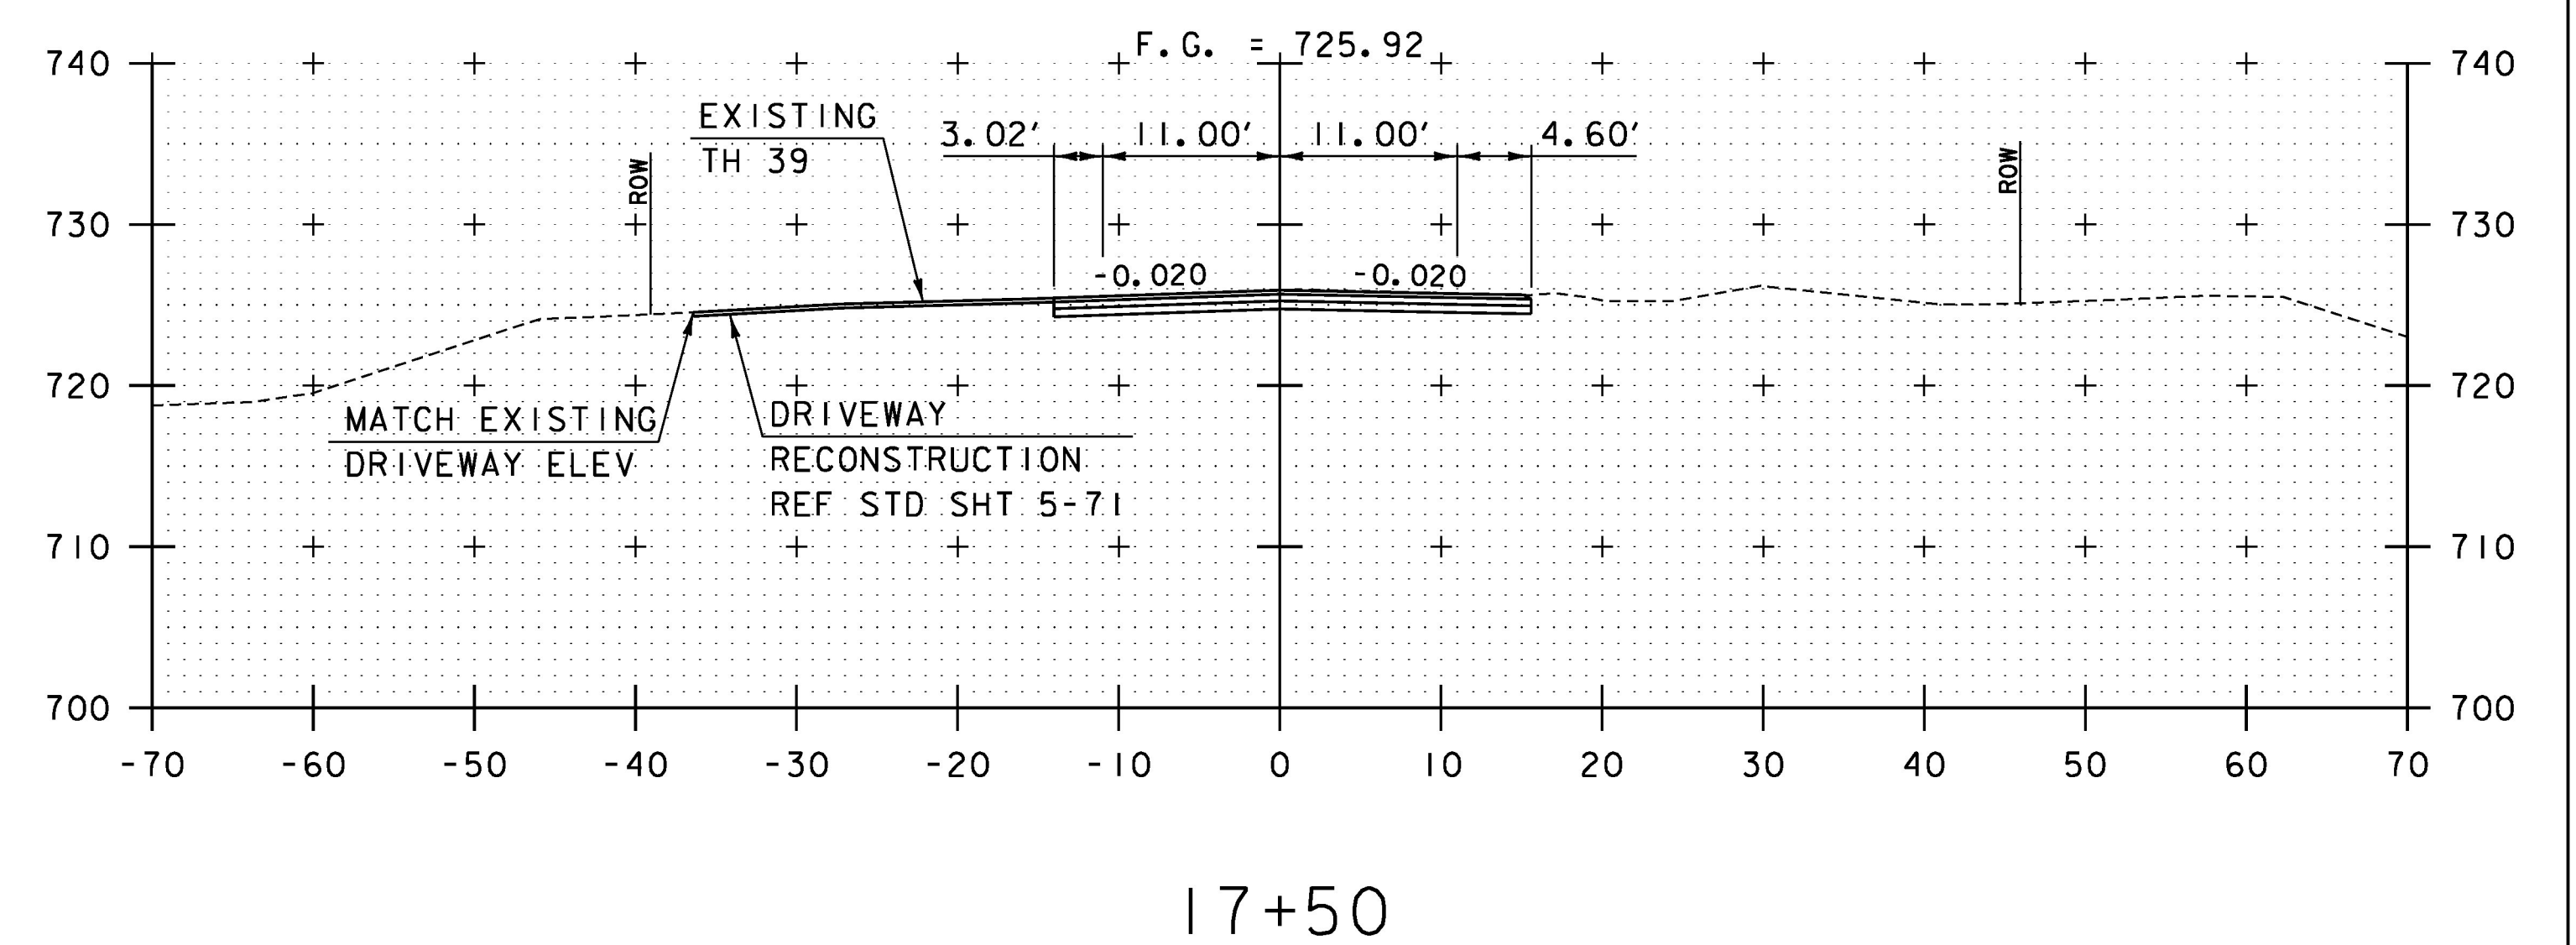
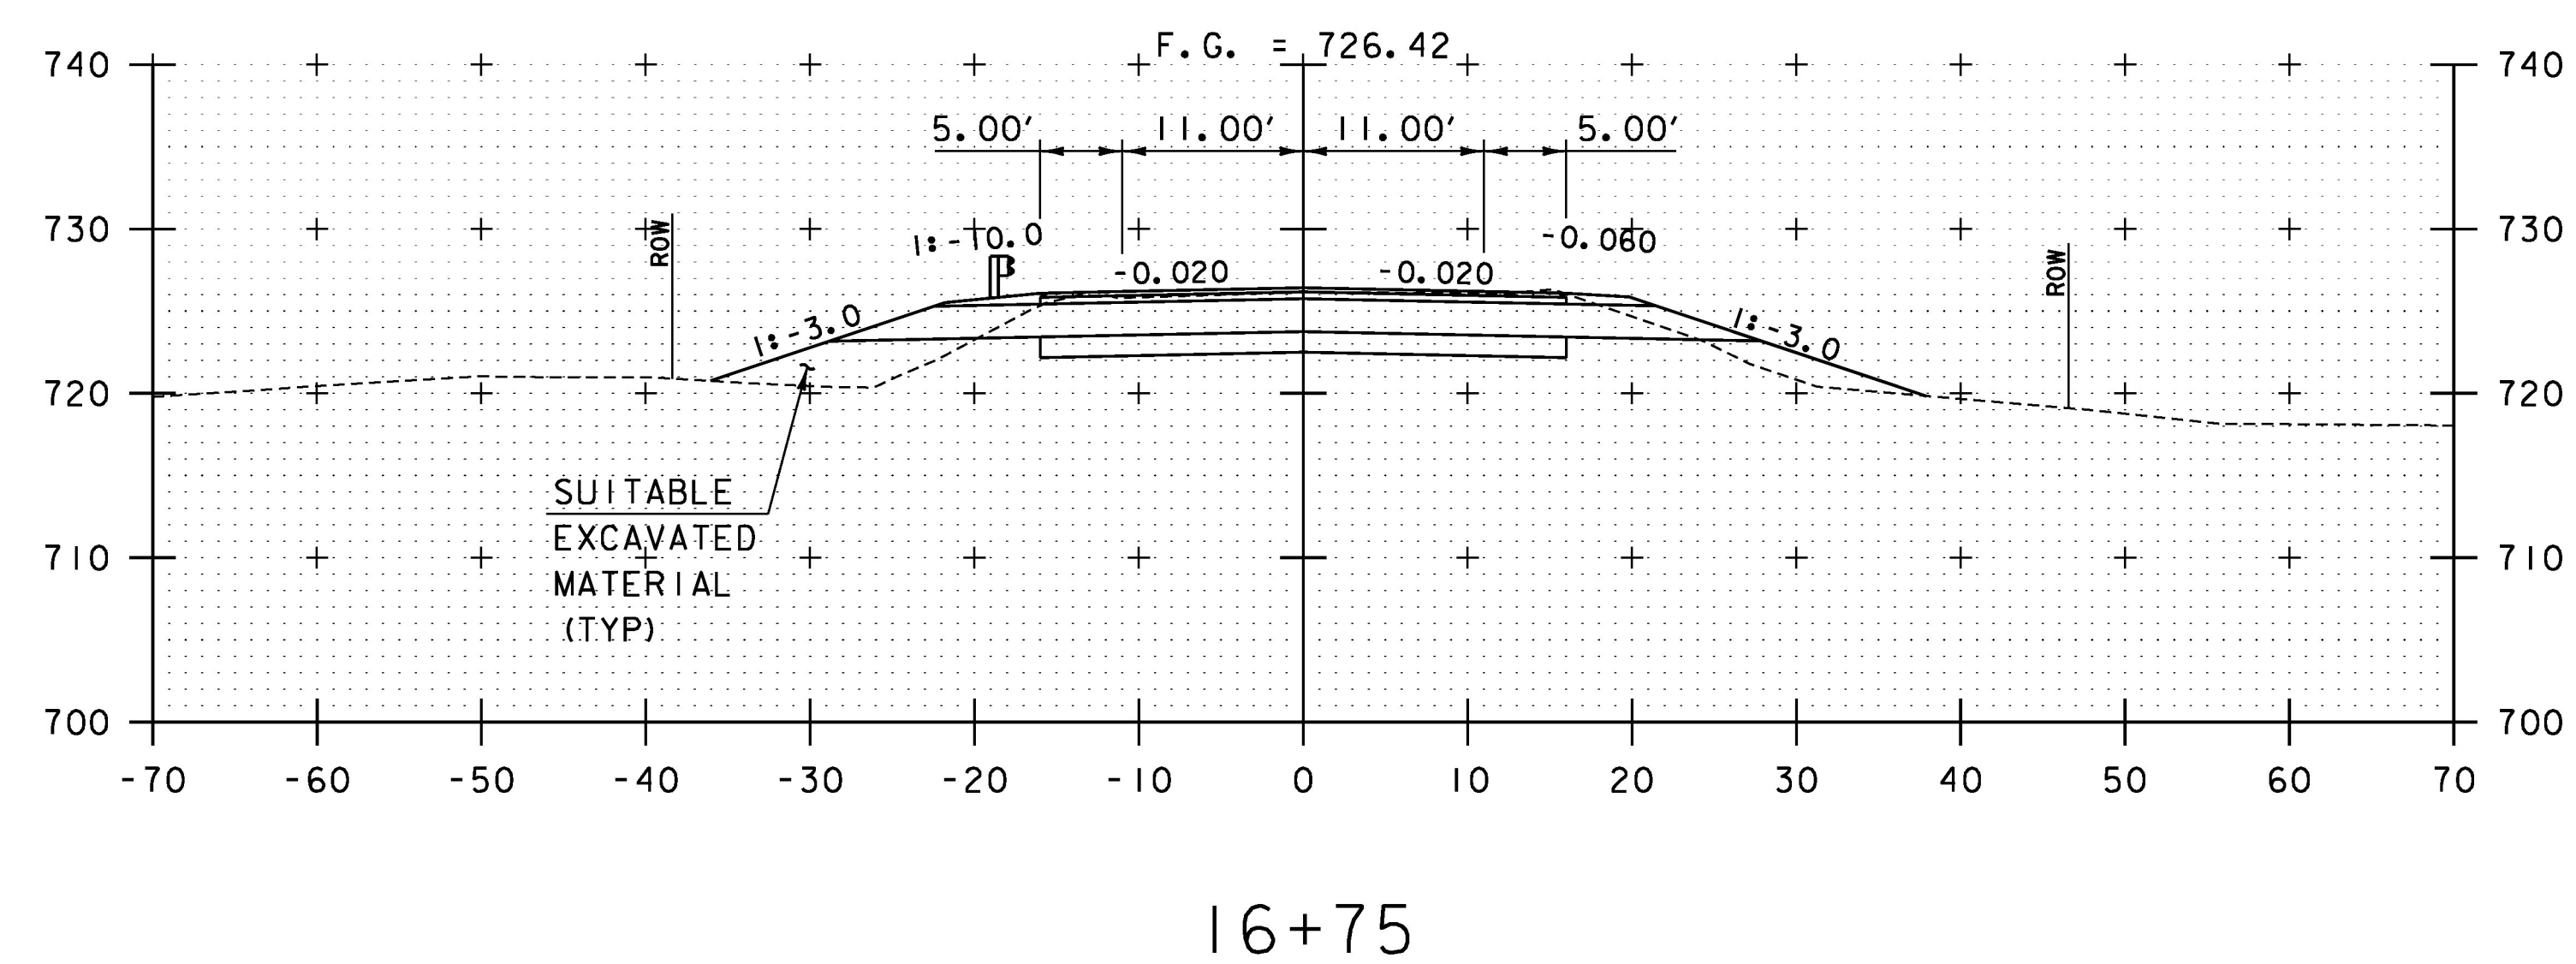
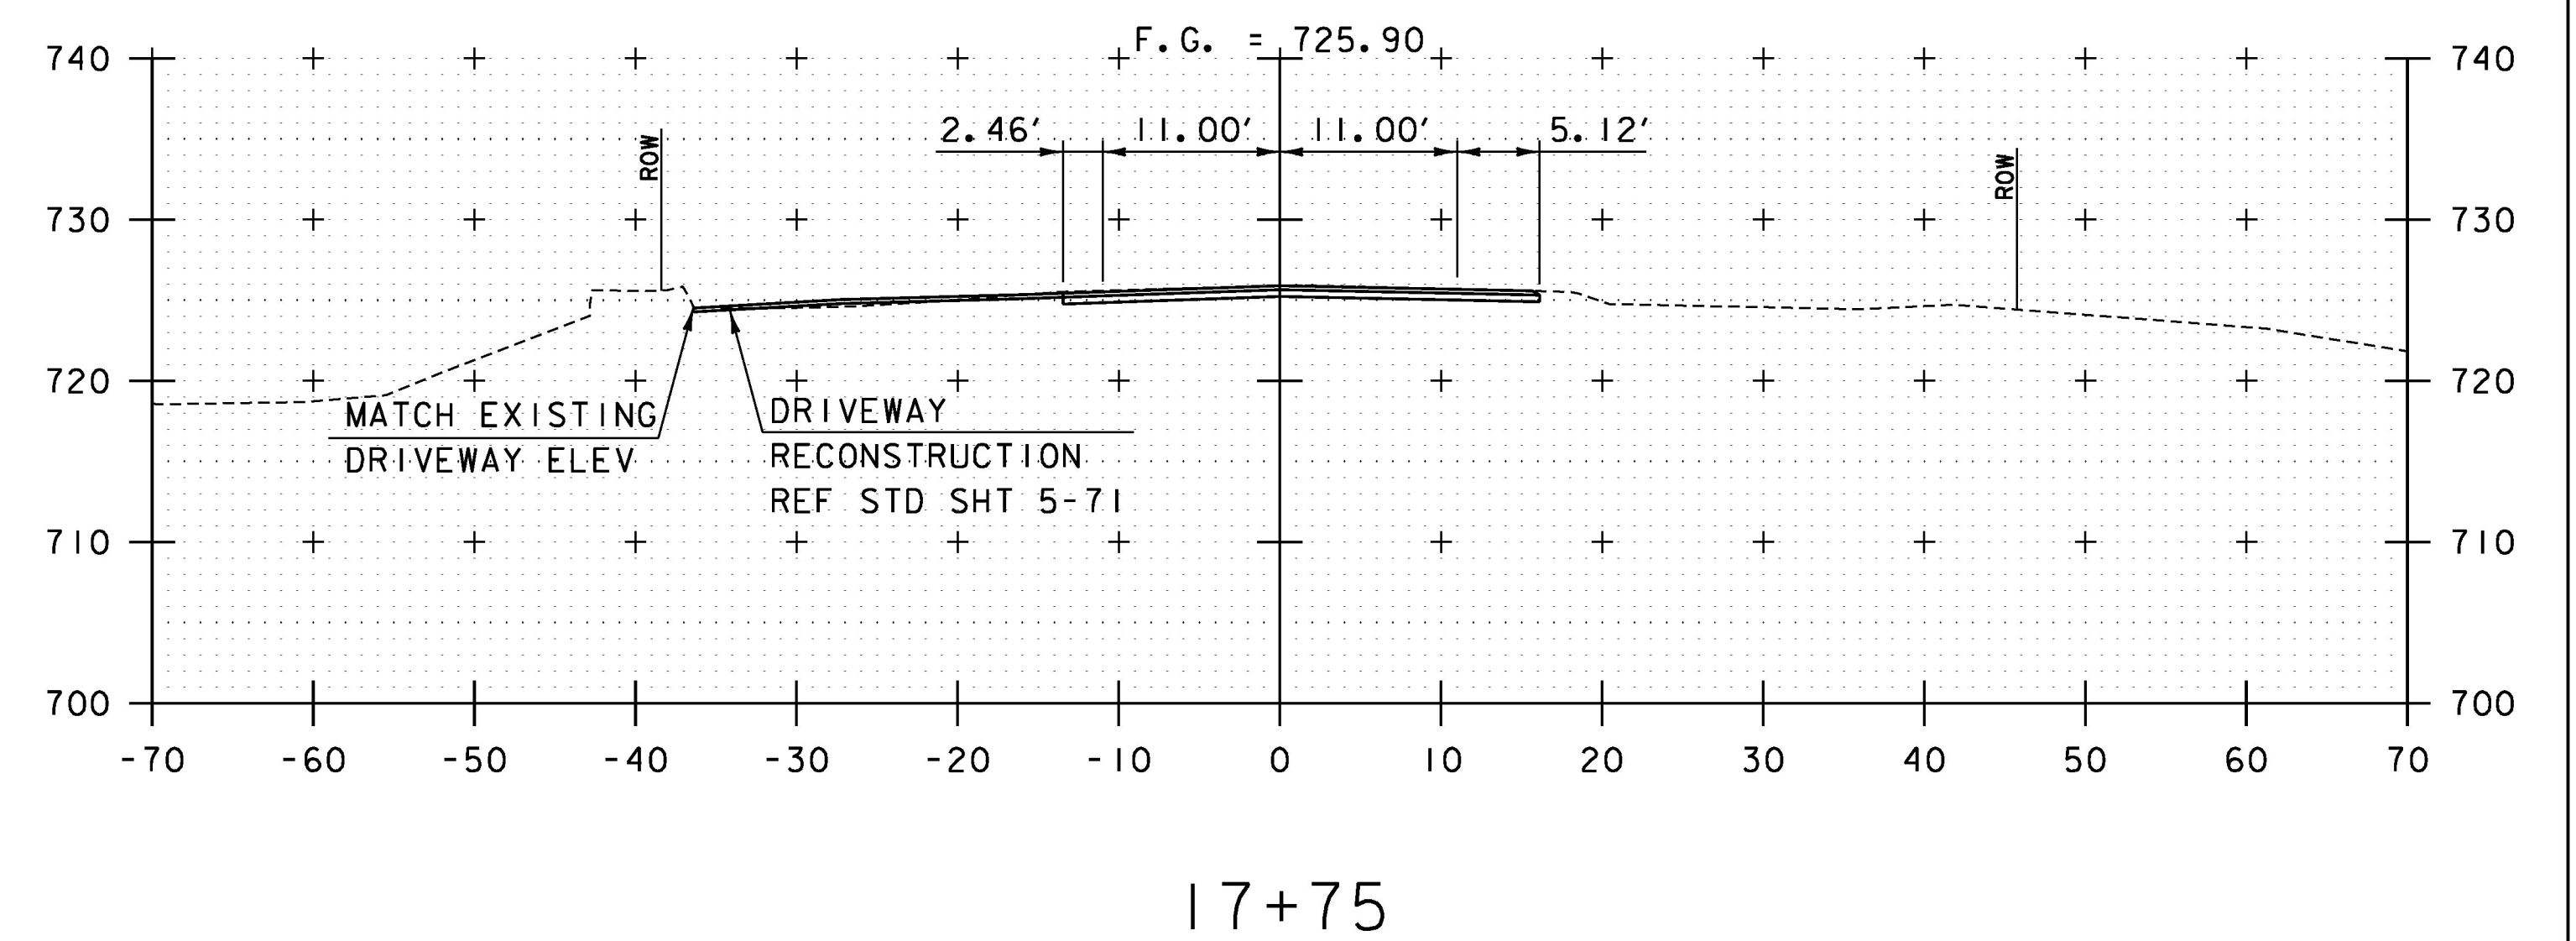


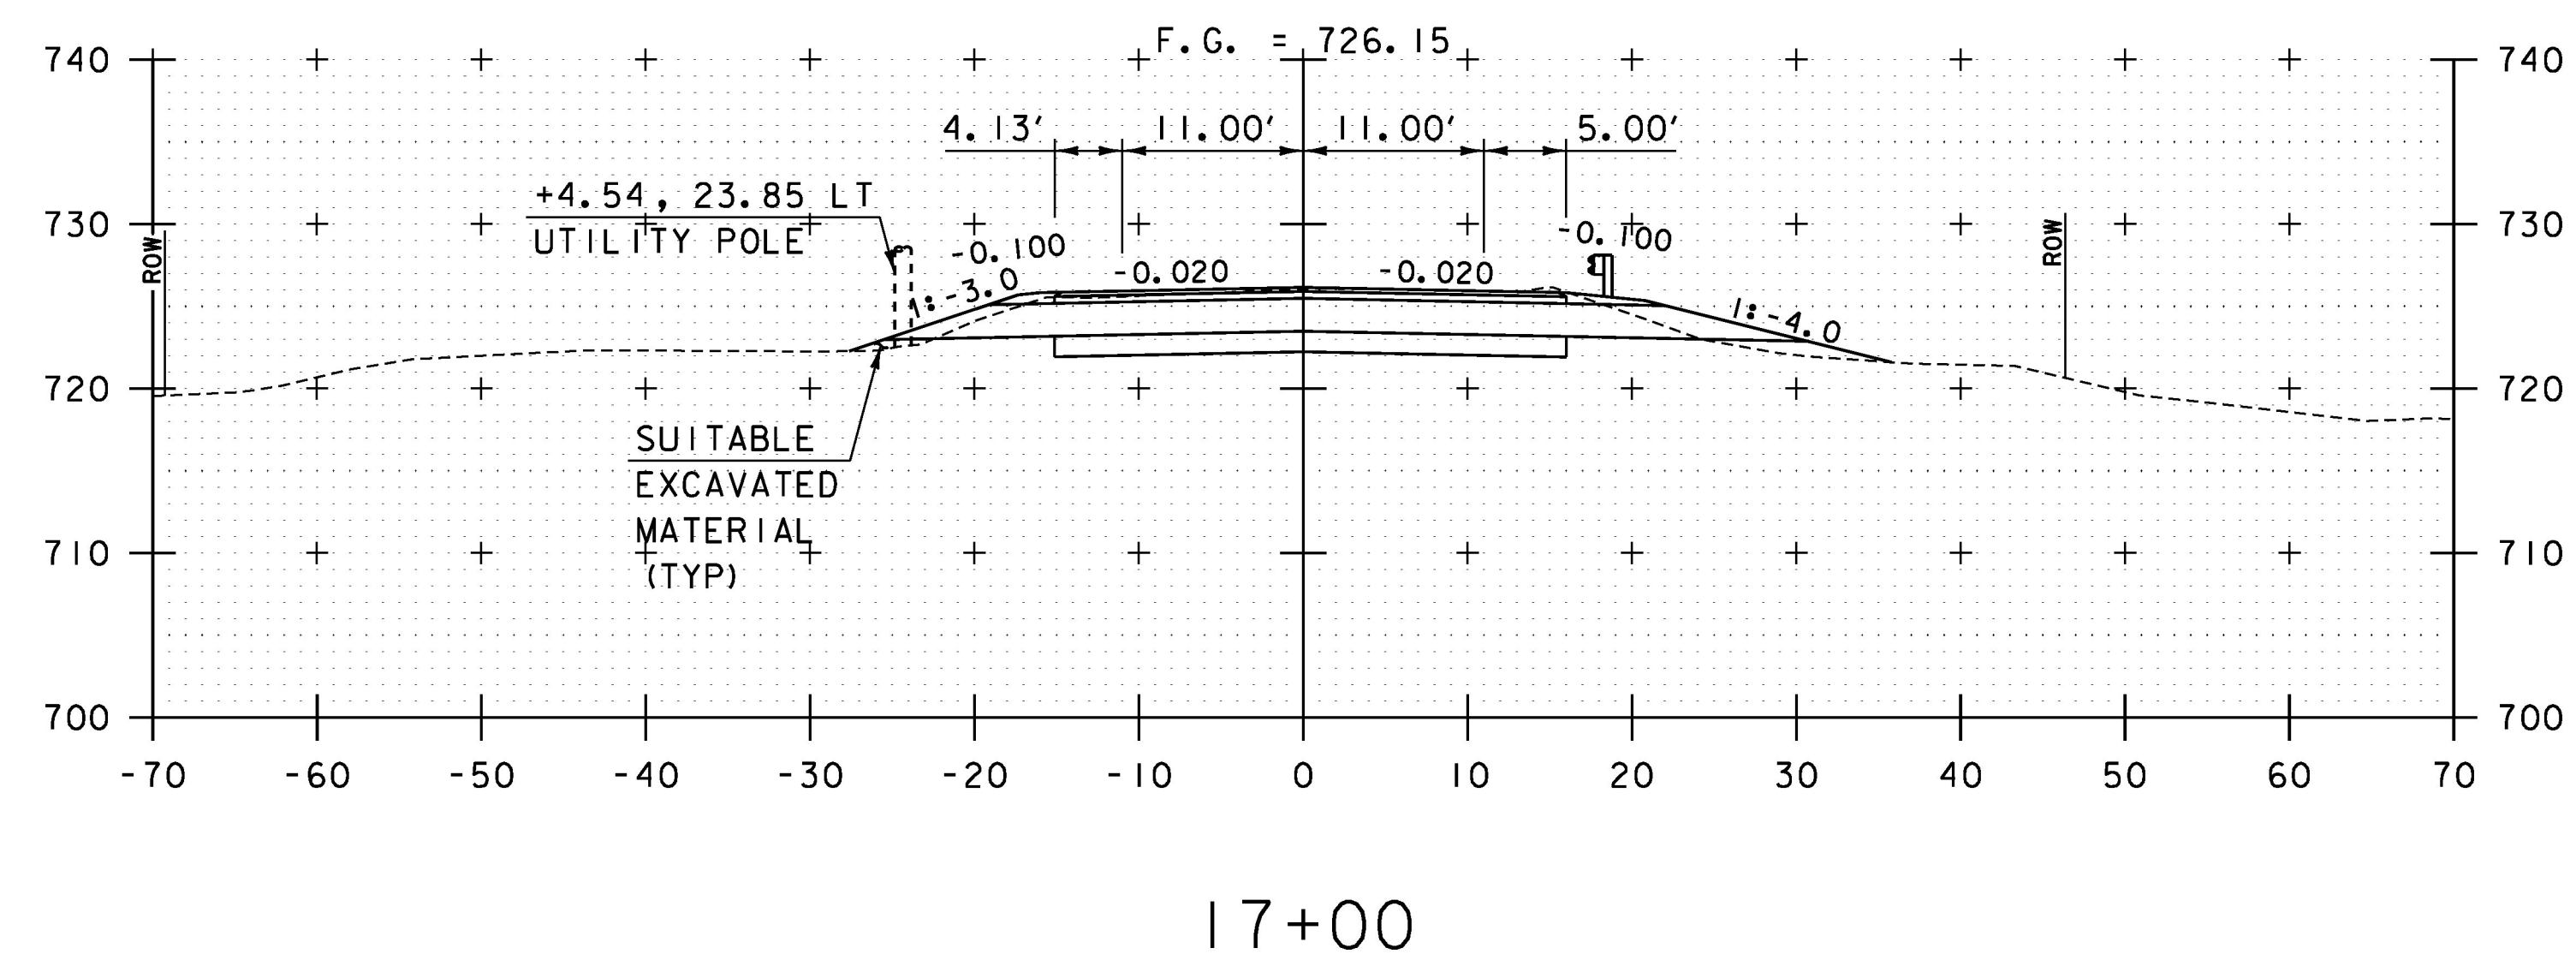

SCALE 1" = 10' - 0"

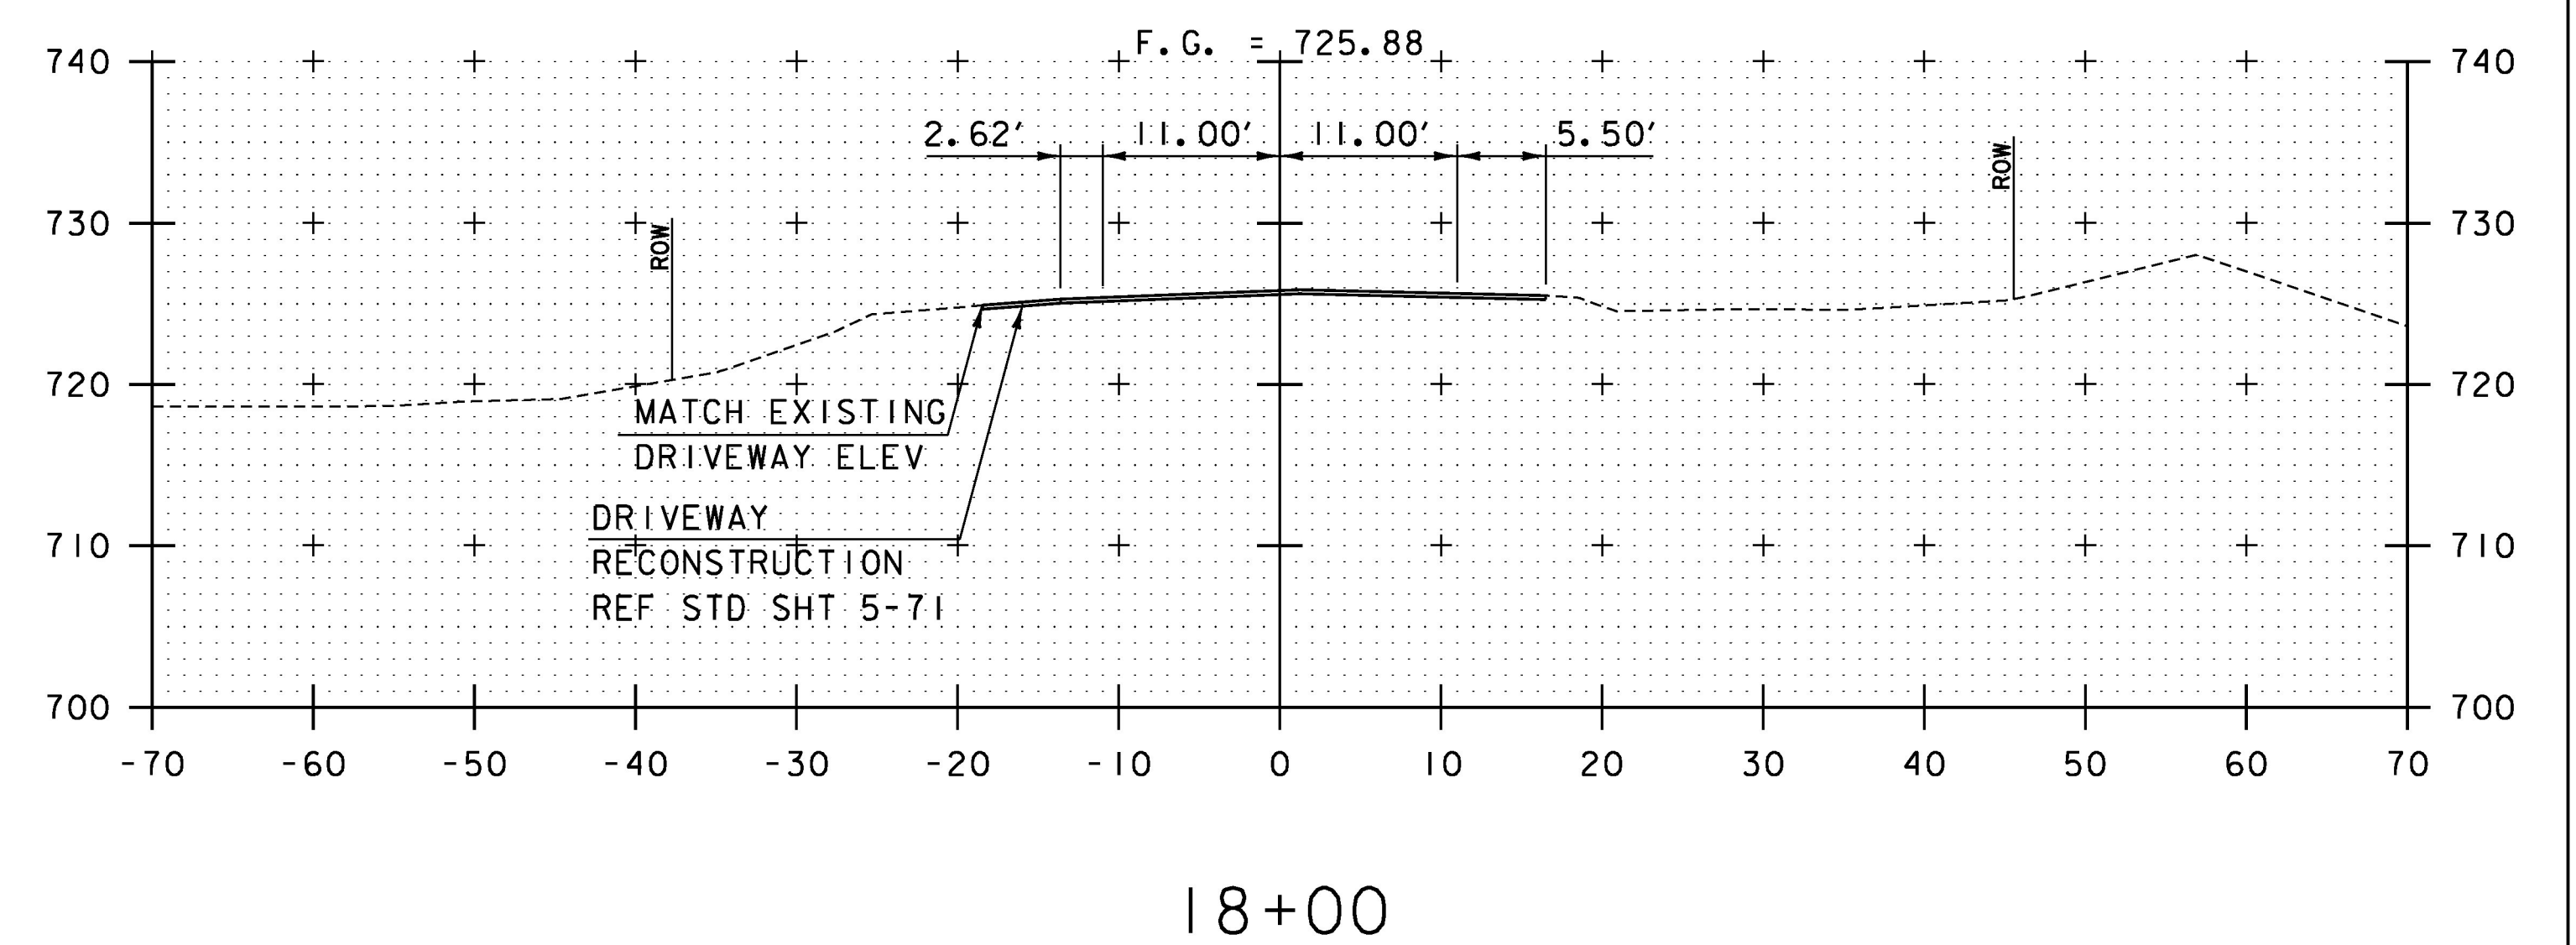

STA. 16+75 TO STA. 18+00

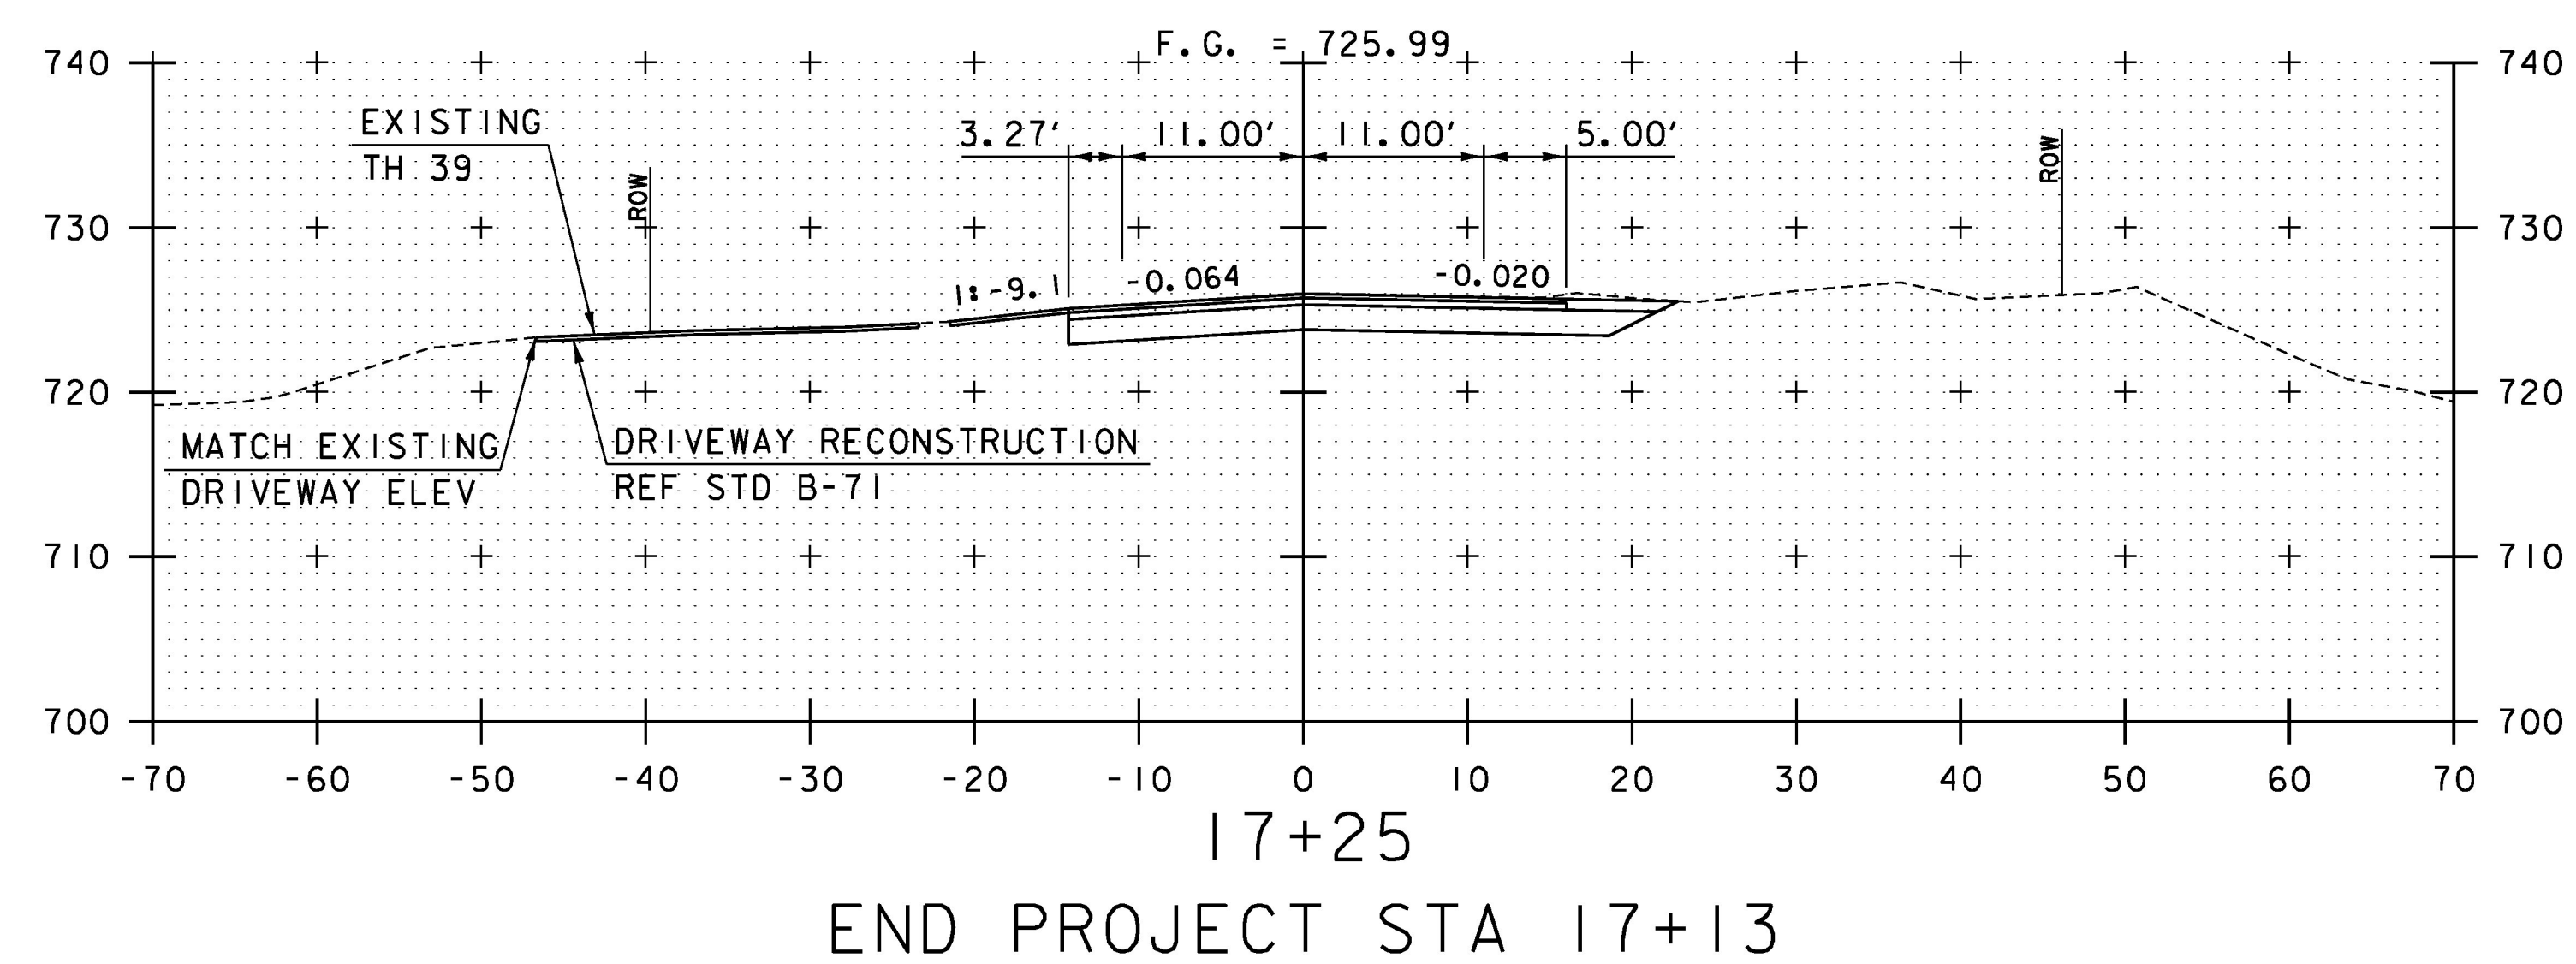

PROJECT NAME:	WAITSFIELD
PROJECT NUMBER:	BRF 013-4(39)

FILE NAME: z12bl36xsl.dgn
PROJECT LEADER: R. YOUNG
DESIGNED BY: D. KULL
VT 100 CROSS SECTION SHEET 5

PLOT DATE: 8/24/2015
DRAWN BY: S. MERKWAN
CHECKED BY: T. KENDRICK
SHEET 55 OF 69