

Approved

Rejected

X

Approved As Noted

This review is only for general conformance with the design concept and the information given in the Construction Documents. Corrections or comments made on the shop drawings during the review do not relieve the Contractor from compliance with the requirements of the Plans and Specifications. Review of a specific item shall not include review of an assembly of which an item is a component. The Contractor is responsible for dimensions to be confirmed and corrected at the job site; information that pertains solely to the fabrication process or to the means, methods, techniques, sequences and procedures of construction; coordination of the Work with that of other trades and performing all Work in a safe and satisfactory manner.

McFarland Johnson

Date

4/7/2016

By

D. Kull

Vermont Agency of Transportation


RECEIVED

CK'D BY OK'D BY Rob Young


April 4, 2016

RESUBMIT NO Approved AsNoted

BY Rob Young DATE 04/08/2016

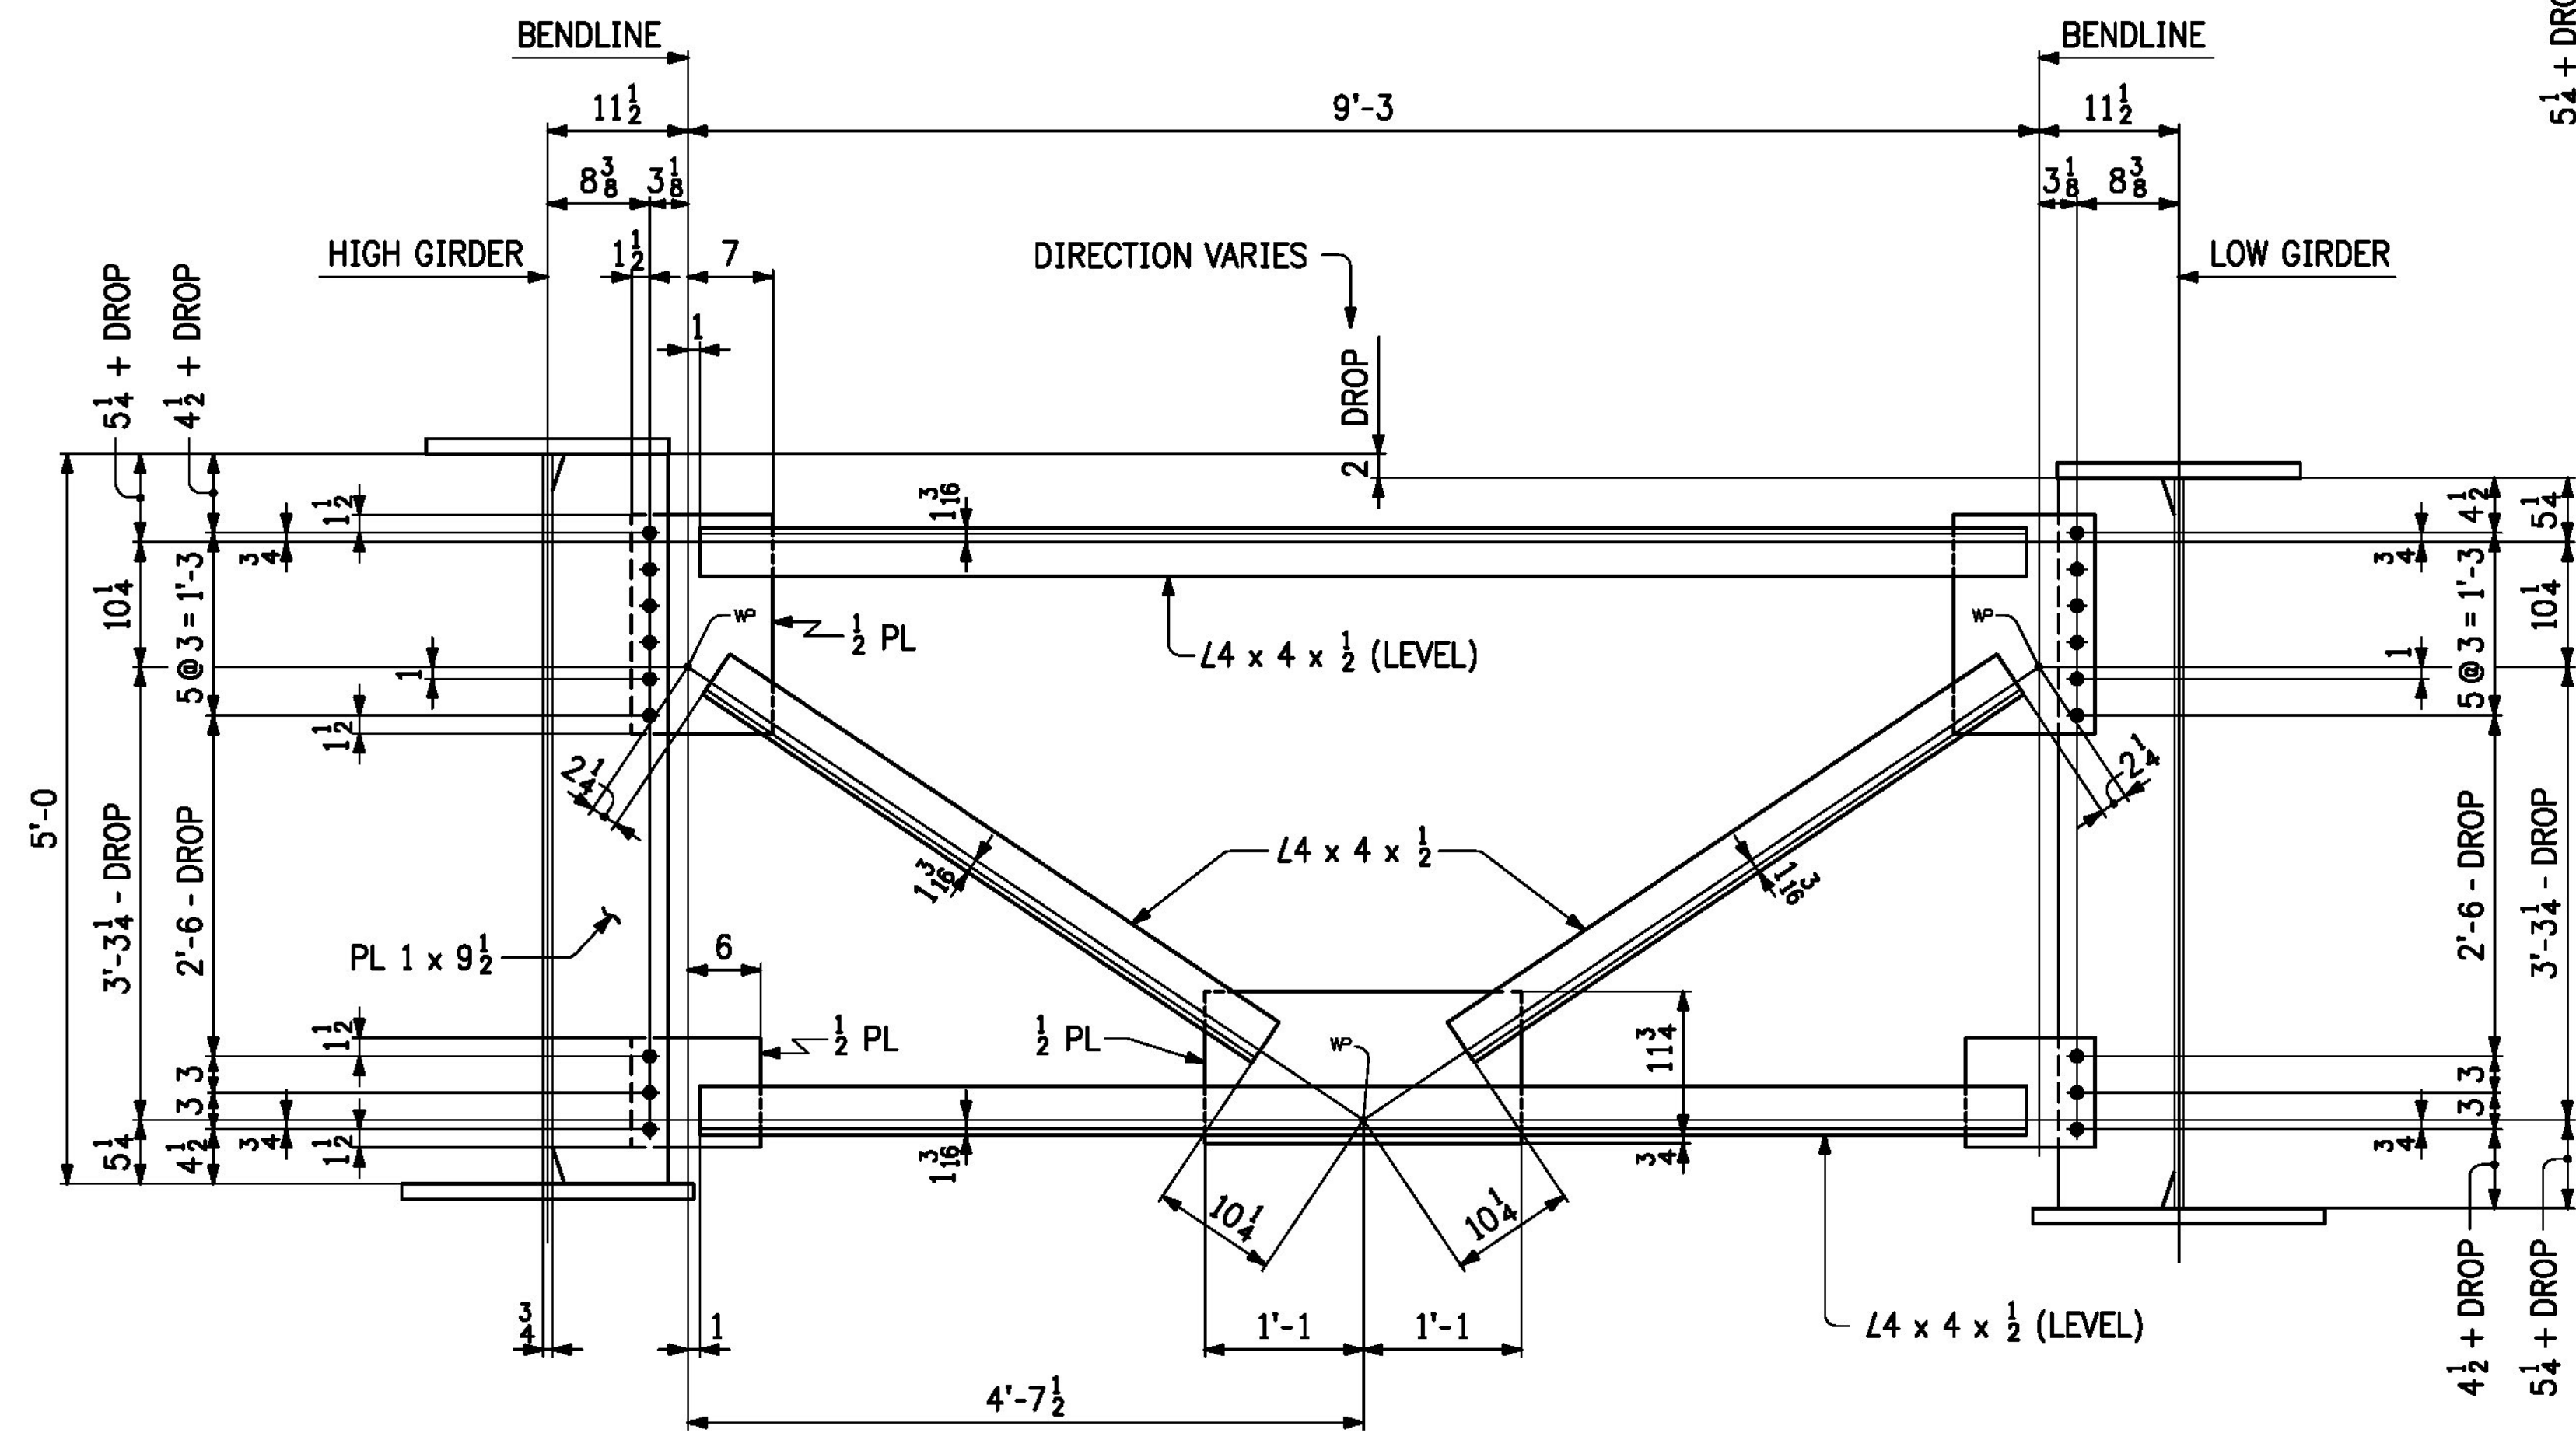

Ref. Sheet E1 for naming convention

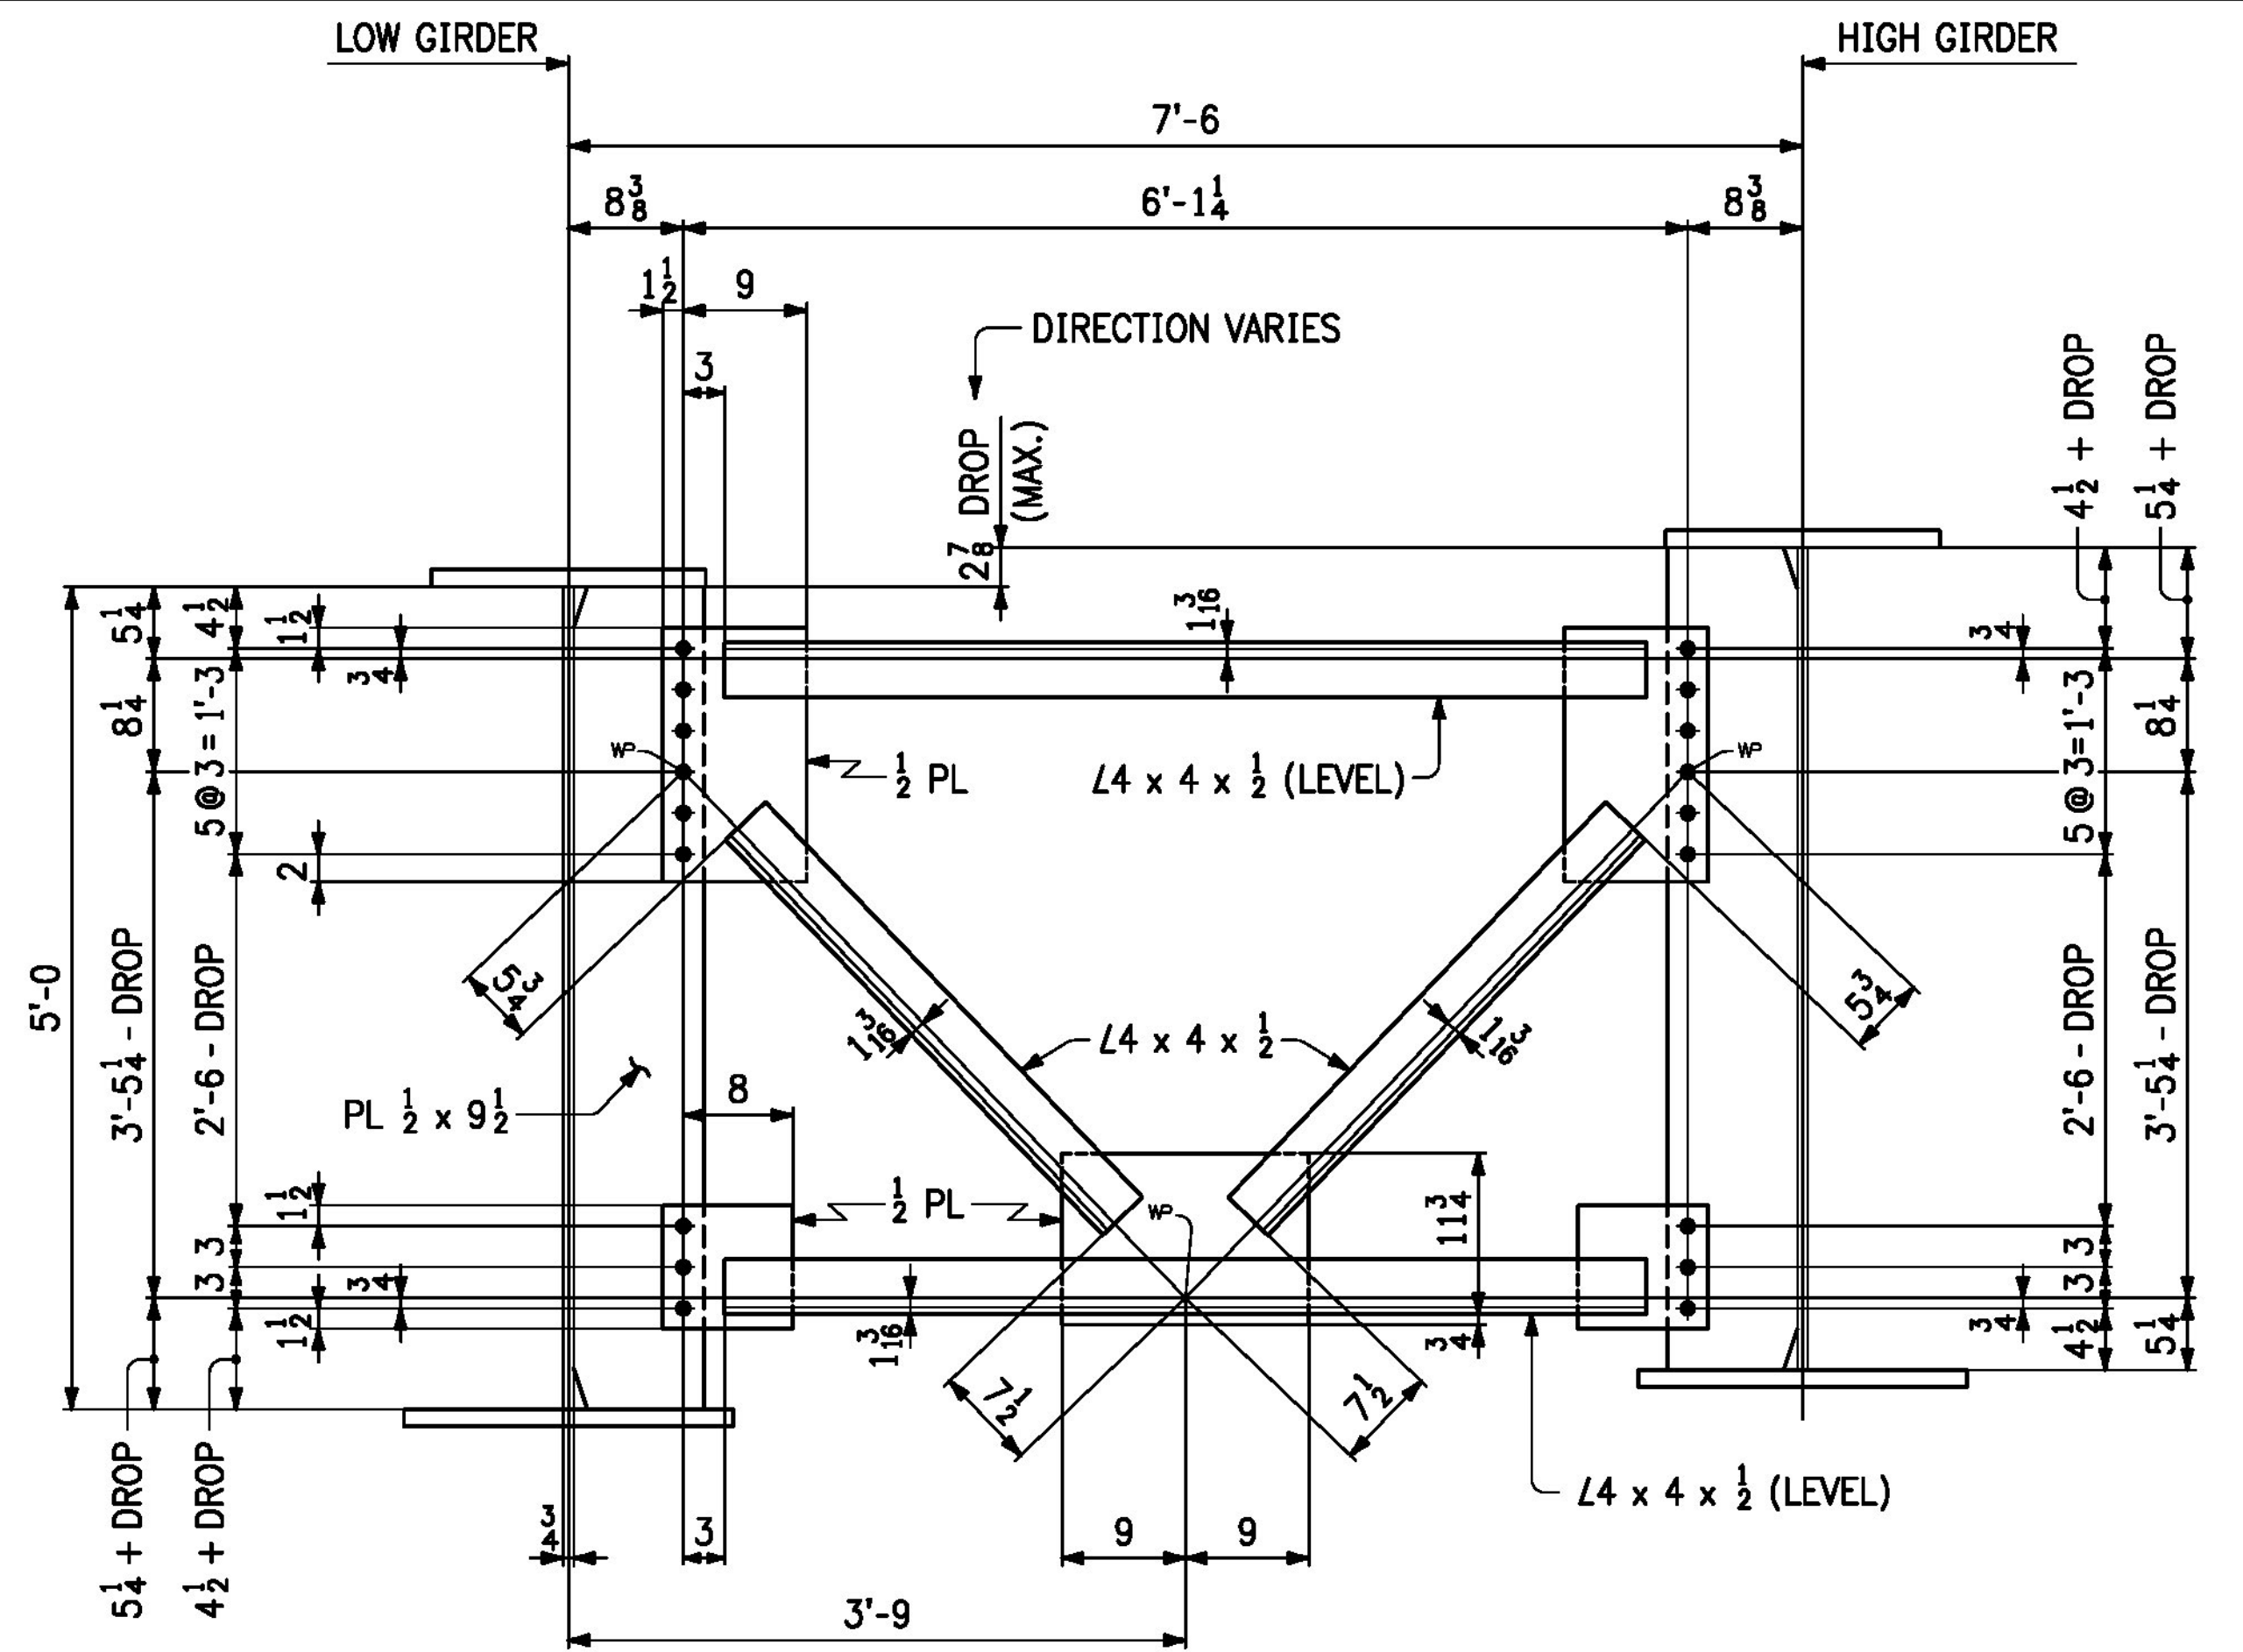

Ref Sheet E1 for naming convention

THIS IS A WORK DRAWING. ITS FUNCTION IS TO PROVIDE BASIC DIMENSIONS AND CONCEPTS FOR USE IN THE PREPARATION OF THE SHOP DETAILS. IT IS NOT INTENDED TO BE USED FOR ERECTION OR FABRICATION.

NO.		DATE	REMARKS	BY
REVISIONS				
		CASCO BAY STEEL STRUCTURES ONE WALLACE AVENUE SOUTH PORTLAND, ME 04106 PHONE: 207-780-6722 FAX: 207-780-6726		
STRUCTURE		VT 100 OVER MAD RIVER		
LOCATION		TOWN OF WAITSFIELD, VERMONT		
PROJECT NO.		PROJECT NO. BR 013-4(39) BRIDGE NO. 177		
ENGINEER		MCFARLAND JOHNSON		
CUSTOMER		A.L. ST. ONGE CONTRACTOR, INC.		
ITEM		LAYOUT		
SURFACE PREP.		OPEN HOLES 1/8"		
PAINT				
APPROVAL	DRAWN WCG	1-20-16	SHEET NO.	JOB NO.
SHOP	CHECKED	1-27-16	TD1	651

1500-3

LYOT-1500A