


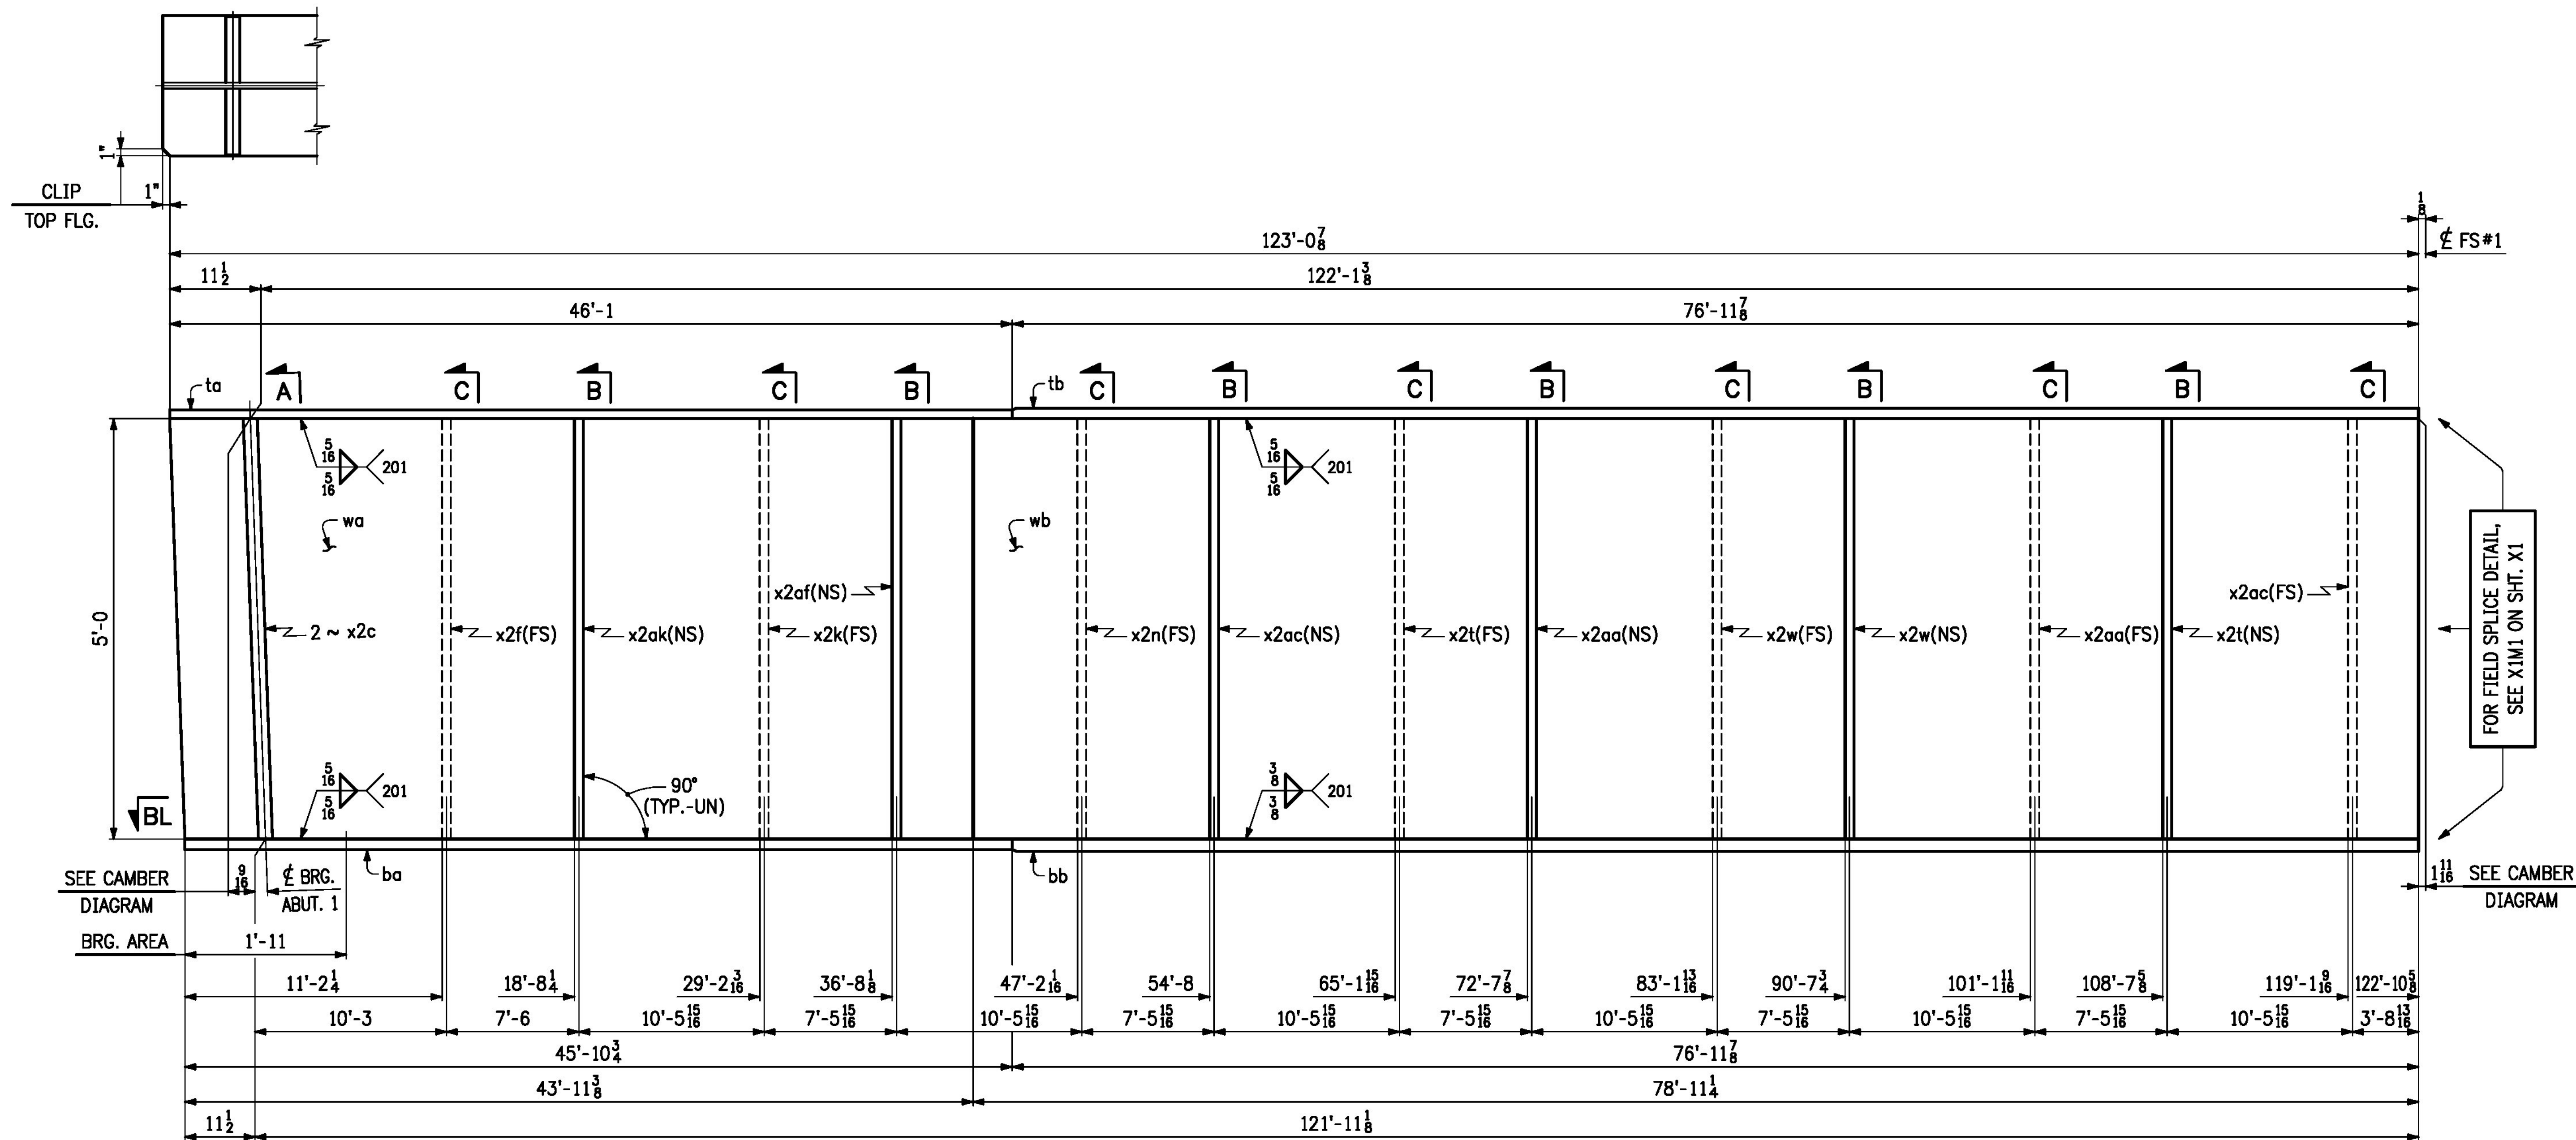

ONE ~ GIRDER ~ 3G3A

- FOR GIRDER STANDARD DETAILS, SEE SHT. X2.
- FOR WEB CUTTING DIAGRAM, SEE SHT. C2.
- FOR FLANGE CUTTING DIAGRAMS, SEE SHT. C2.
- FOR GENERAL NOTES, SEE SHT. GN1.
- "BRG. AREA" INDICATES AREA THAT MUST BE FLAT TO PROVIDE A UNIFORM EVEN CONTACT WITH SOLE PLATE.

Vermont Agency of Transportation
RECEIVED

CK'D BY _____ OK'D BY Rob Young

April 4, 2016

RESUBMIT NO Approved AsNoted
BY Rob Young DATE 04/08/2016

____ Approved _____ X _____ Approved As Noted
____ Rejected

This review is only for general conformance with the design concept and the information given in the Construction Documents. Corrections or comments made on the shop drawings during the review do not relieve the Contractor from compliance with the requirements of the Plans and Specifications. Review of a specific item shall not include review of an assembly of which an item is a component. The Contractor is responsible for dimensions to be confirmed and corrected at the job site; information that pertains solely to the fabrication process or to the means, methods, techniques, sequences and procedures of construction; coordination of the Work with that of other trades and performing all Work in a safe and satisfactory manner.

McFarland Johnson

Date 4/7/2016

By D. Kull

NO.	DATE	REMARKS	BY
REVISIONS			
		CASCO BAY STEEL STRUCTURES ONE WALLACE AVENUE SOUTH PORTLAND, ME 04106 PHONE: 207-780-6722 FAX: 207-780-6726	
STRUCTURE VT 100 OVER MAD RIVER			
LOCATION TOWN OF WAITSFIELD, VERMONT			
PROJECT NO. PROJECT NO. BR 013-4(39) BRIDGE NO. 177			
ENGINEER MCFARLAND JOHNSON			
CUSTOMER A.L. ST. ONGE CONTRACTOR, INC.			
ITEM GIRDER ~ 3G3A			
SURFACE PREP. SSPC-SP10 OPEN HOLES 1 1/2"			
PAINT NONE			
APPROVAL	DRAWN VHM	1-27-16	SHEET NO. 3AB
SHOP	CHECKED FM	3-8-16	JOB NO. 651

1500-9

G3A-1500AB